

INDEX OF SHEETS

SHEET NO.	DESCRIPTION
1.	TITLE SHEET
2.	TYPICAL SECTIONS AND DETAILS - SHEET 1 OF 2
3.	TYPICAL SECTIONS AND DETAILS - SHEET 2 OF 2
4.	SUMMARY OF QUANTITIES/EARTHWORK SCHEDULES
5.	QUANTITY SHEET
6.	PLAN LAYOUT SHEET 1 OF 3
7.	PLAN LAYOUT SHEET 2 OF 3
8.	PLAN LAYOUT SHEET 3 OF 3
9.	PROFILE - RIVER ROAD
10.	PROFILE - GRASS LINED SWALE
11.	PROFILE - COMMERCE PARK
12.	EROSION & SEDIMENT CONTROL PLAN SHEET 1 OF 3
13.	EROSION & SEDIMENT CONTROL PLAN SHEET 2 OF 3
14.	EROSION & SEDIMENT CONTROL PLAN SHEET 3 OF 3
15.	TRAFFIC CONTROL/SIGNING/PAVEMENT MARKINGS SHEET 1 OF 3
16.	TRAFFIC CONTROL/SIGNING/PAVEMENT MARKINGS SHEET 2 OF 3
17.	TRAFFIC CONTROL/SIGNING/PAVEMENT MARKINGS SHEET 3 OF 3
18.	TRAFFIC SIGN SUMMARY SHEET
19.	RIGHT-OF-WAY SHEET 1 OF 3
20.	RIGHT-OF-WAY SHEET 2 OF 3
21.	RIGHT-OF-WAY SHEET 3 OF 3
22.	CROSS SECTIONS - COMMERCE PARK/GRASS LINED SWALE SHEET 1 OF 2
23.	CROSS SECTIONS - COMMERCE PARK SHEET 2 OF 2
24.	CROSS SECTIONS - RIVER ROAD (TH3)
25.	SIGNAL PLAN
26.	SIGNAL POWER DISTRIBUTION DIAGRAM
27.	SIGNAL CRTU DIAGRAM
28.	SIGNAL CONTROL UNIT DIAGRAM
29.	CROSSING SIGNAL CIRCUITS DIAGRAM
30.	CROSSING CONTROLLER CIRCUITS DIAGRAM
31.	CROSSING GATE MECHANISM DIAGRAM
32.	SIGNAL HOUSE LAYOUT (WALLS A & B)
33.	SIGNAL HOUSE LAYOUT (WALLS C & D)
34.	SIGNAL CABLE INSTALLATION PLAN
35.	SIGNAL GATE & FLASHER DETAILS

VDOT STANDARDS

B-5	EMBANKMENT ON EARTH SLOPE... TYPICAL SLOPE ROUNDINGS	G-01-94
E-100	CONSTRUCTION APPROACH SIGNS	1-06-97
E-100A	SIDE ROAD CONSTRUCTION - APPROACH SIGNS	1-06-97
E-102	CONSTRUCTION SIGN DETAILS	8-08-95
E-102A	CONSTRUCTION SIGN DETAILS	8-08-95
E-106	TRAFFIC CONTROL - MISCELLANEOUS DETAILS	8-08-95
E-107	DELINEATION, BARRICADES AND DETOURS FOR CONSTRUCTION AREA	8-08-95
E-111	MINOR MAINTENANCE OPERATION	3-11-95
E-121	STANDARD SIGN PLACEMENT CONVENTIONAL ROAD	8-08-95
E-123	GUIDE SIGN PLACEMENT MISCELLANEOUS DETAILS	8-08-95
E-131	GUIDE SIGN DETAILS	8-08-95
E-143	REGULATORY SIGN DETAILS	9-20-95
E-154	WARNING SIGN DETAILS	8-08-95
E-160	FLANGED CHANNEL STEEL SIGN POST	5-20-99
E-164	SQUARE STEEL SIGN POST	5-20-99
E-190	RAILROAD CROSSING SIGNS AND PAVEMENT MARKINGS	8-18-95
E-193	PAVEMENT MARKING DETAILS	8-18-95
G-4	PLANK RAIL GUIDE POSTS, WOOD MARKER POSTS, STEEL MARKER POSTS	6-01-94

CONVENTIONAL SYMBOLS


COUNTY LINE	— — — — —	COUNTY LINE
TOWN LINE	— — — — —	TOWN LINE
LIMITS OF ACCESS	— o — o — o — o —	
POINT OF ACCESS	X	
FENCE LINE	X — X — X — X —	
STONE WALL	o — o — o — o — o — o — o — o —	
TRAVELED WAY	— — — — —	
GUARD RAIL	o — o — o — o — o — o — o — o —	
RAILROAD	— — — — —	
SURVEY LINE	— — — — —	
CULVERT	— — — — —	
POWER POLE	□	
TELEPHONE POLE	○	
TREES	⊙	
CONTROL OF ACCESS	— // — // — // — // —	
PROPERTY LINE	— — — — —	
R.O.W. TAKING LINE	— — — — —	
SLOPE RIGHTS	— SR — SR — SR —	
TOP OF CUT	— Δ — Δ — Δ —	
TOE OF SLOPE	— ○ — ○ — ○ —	

PB Parsons, Brinckerhoff, Quade and Douglas, Inc.
75 Arlington St. Boston, MA 02116
PH. (617)426-7330 FAX (617)482-8487





SURVEYED BY : SUMMIT ENGINEERING, INC.
SURVEYED DATE : 2000

DATUM
VERTICAL NAVD88 ± 0.5 FT.
HORIZONTAL SPC1 983

STATE OF VERMONT AGENCY OF TRANSPORTATION

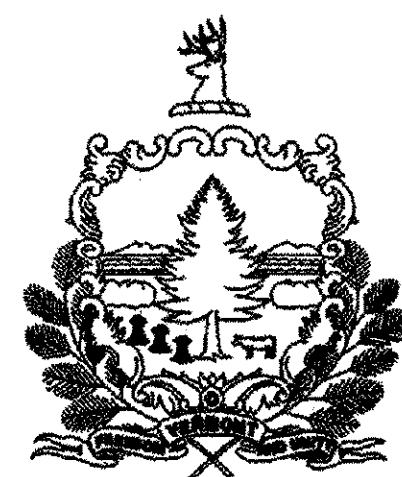

PROPOSED GRADE CROSSING IMPROVEMENTS TOWN OF SHARON

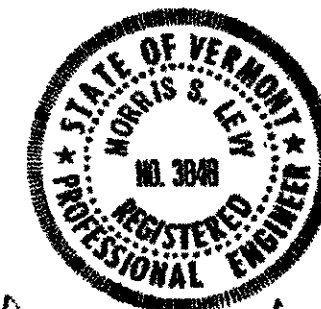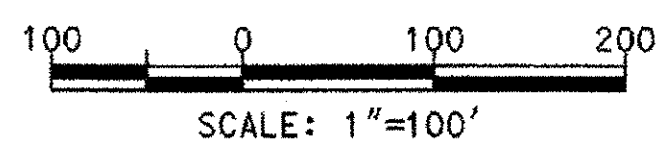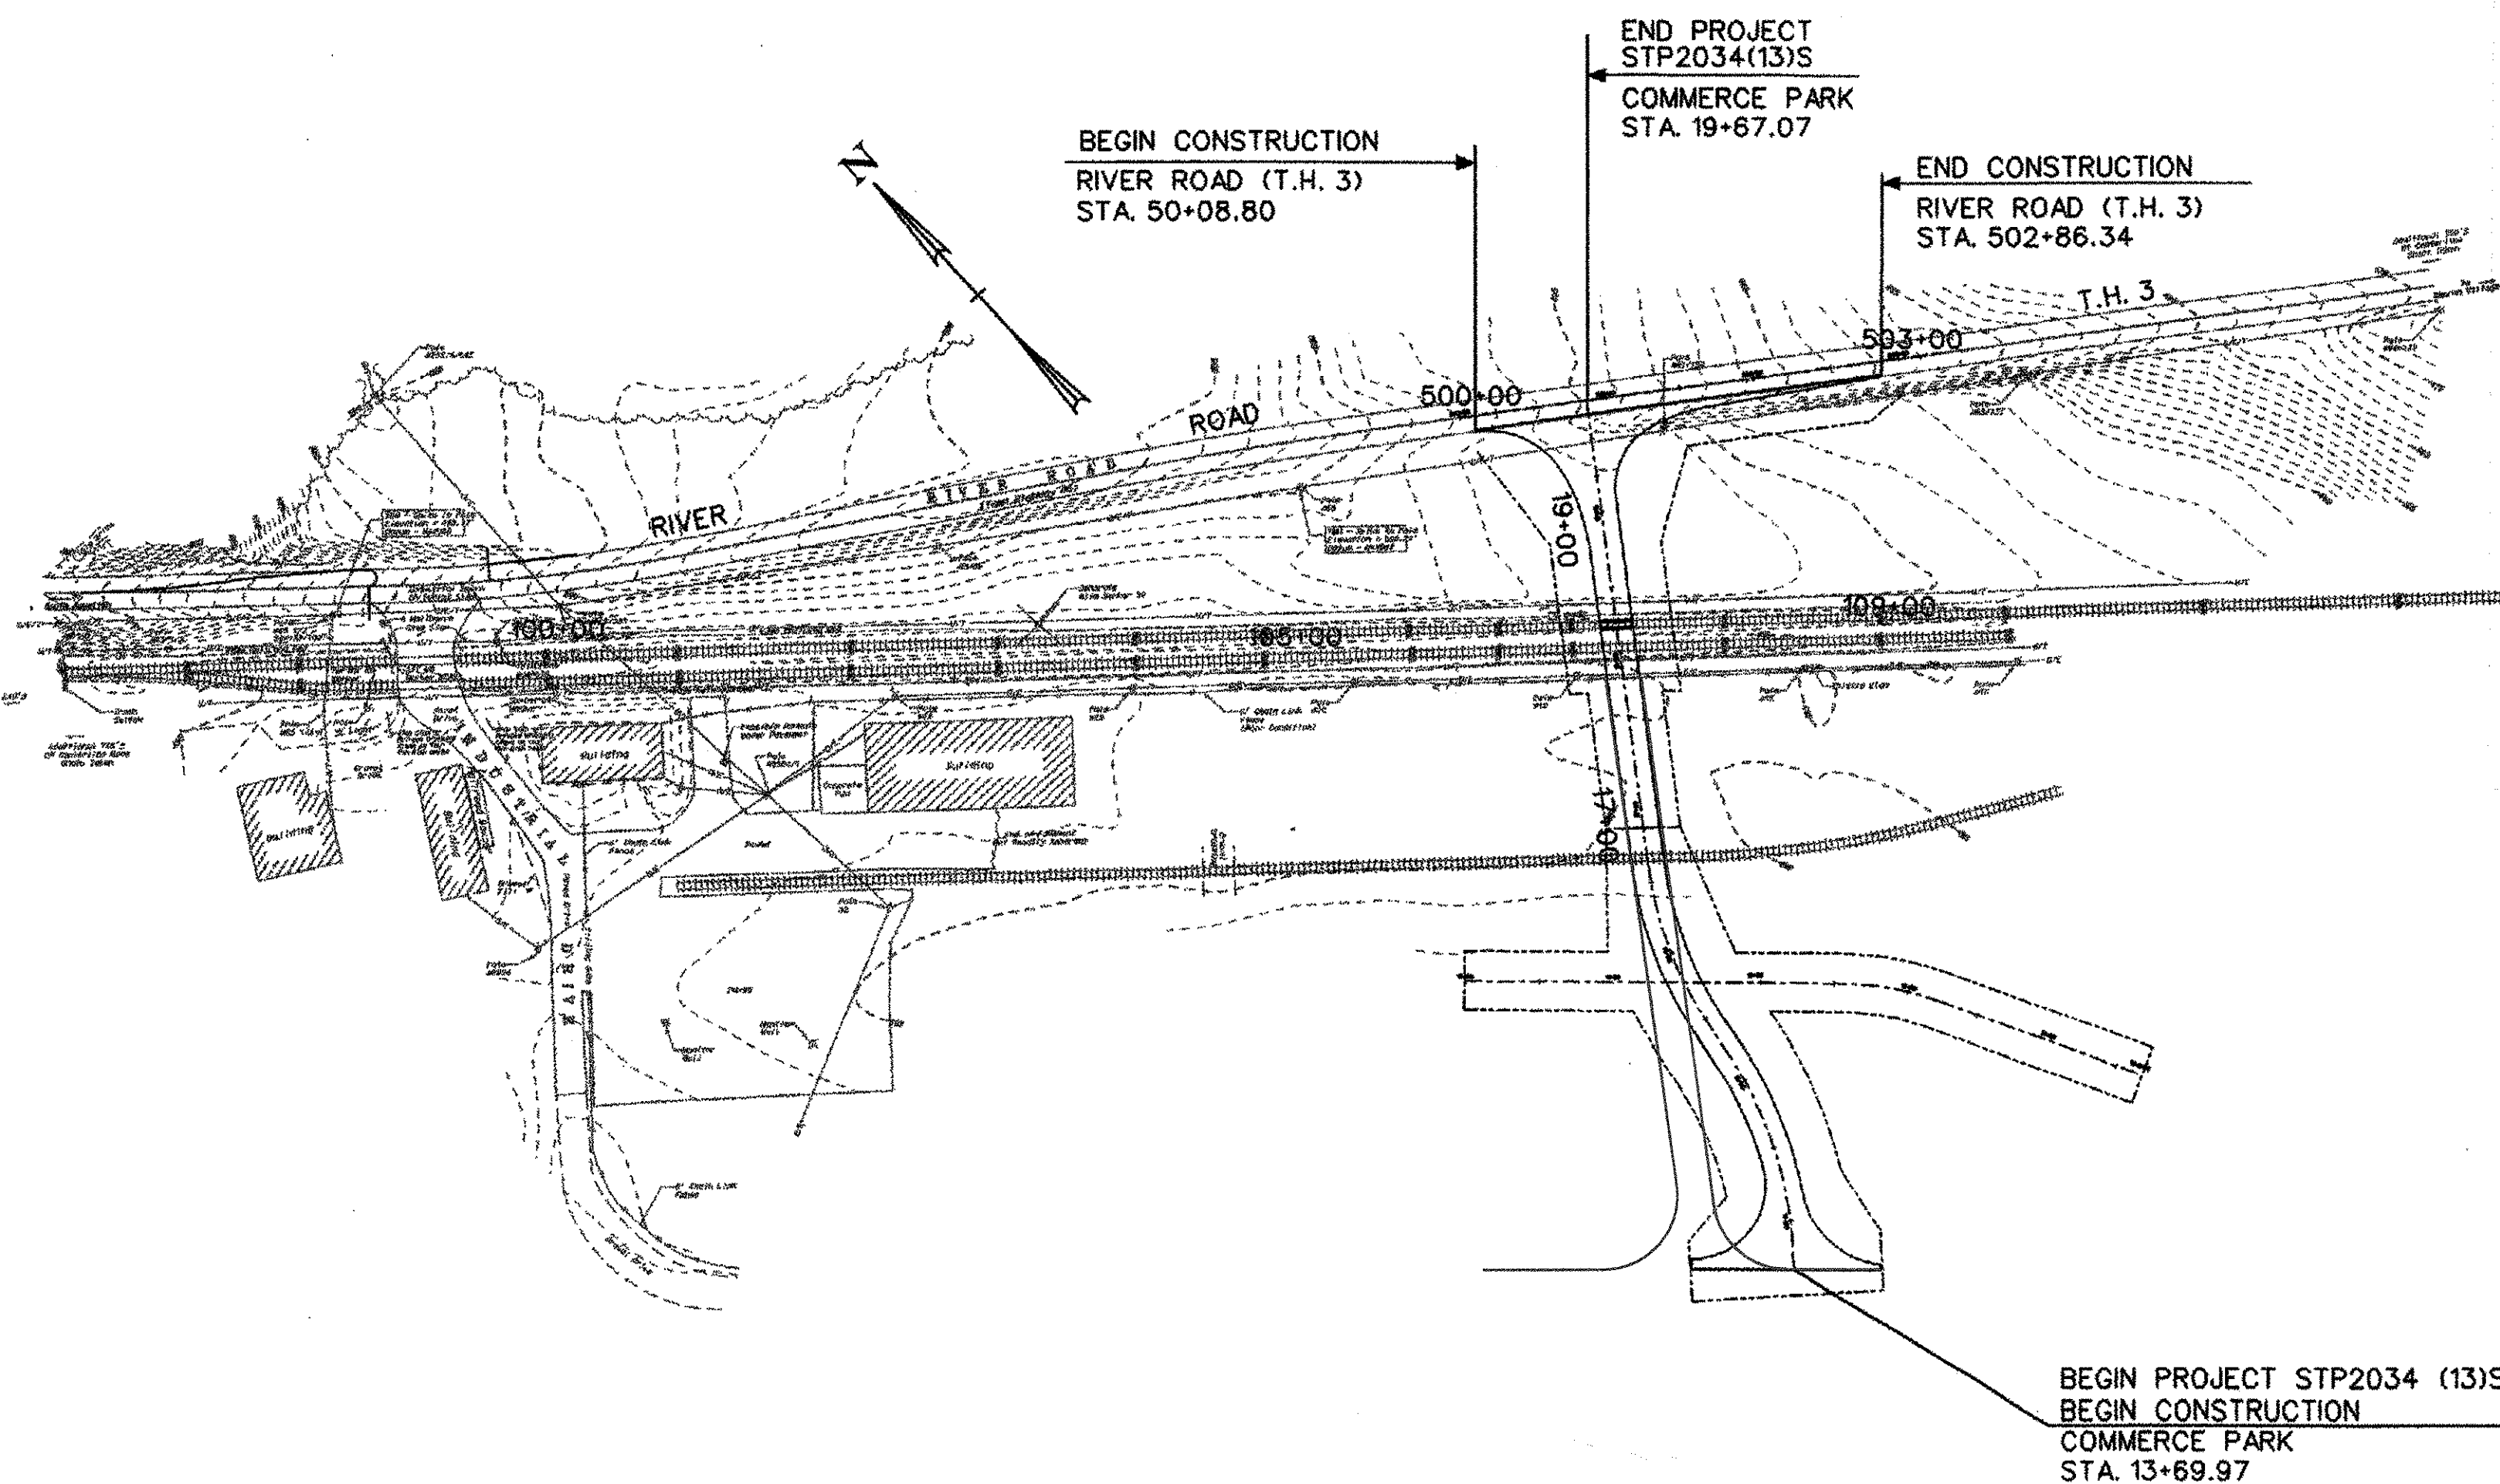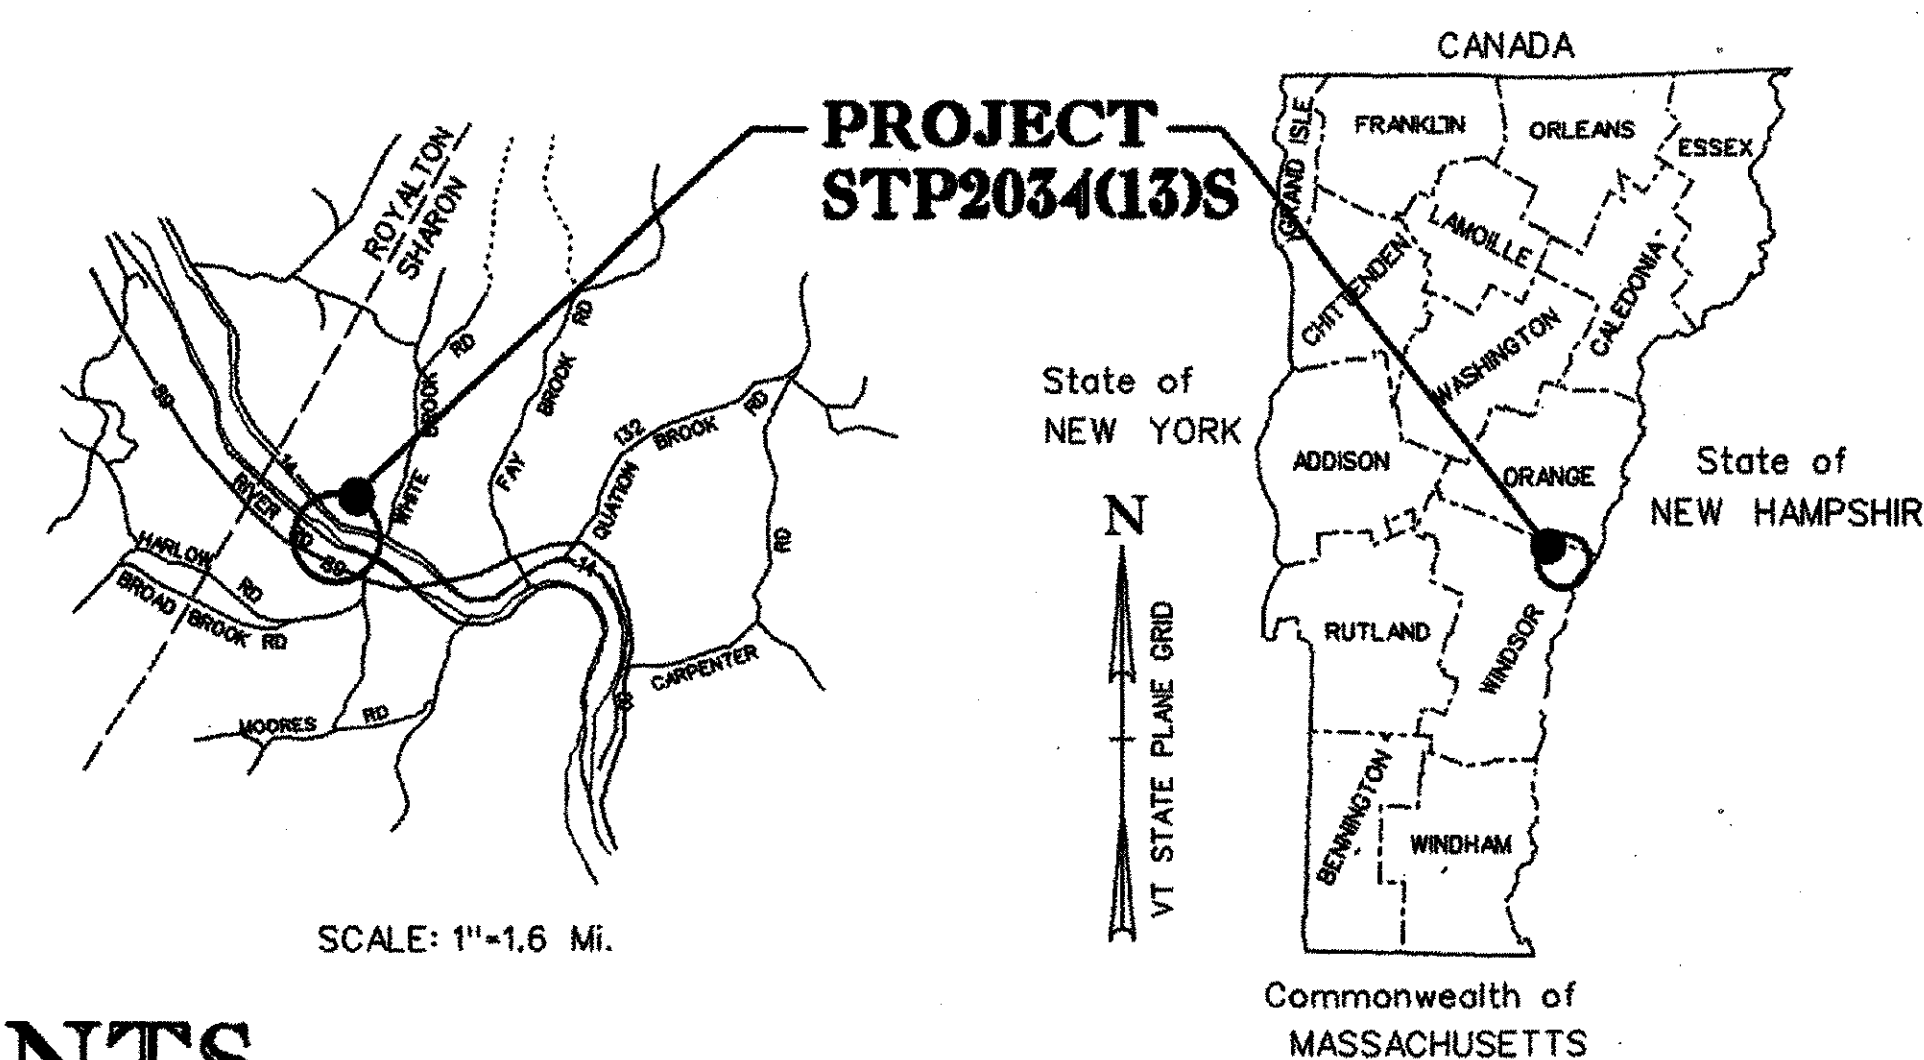

THESE PLANS ARE SUBJECT TO SUCH ENGINEERING CHANGES AS MAY BE REQUIRED BY THE FEDERAL HIGHWAY ADMINISTRATION OR THE DIRECTOR OF PROJECT DEVELOPMENT.
CONSTRUCTION IS TO BE CARRIED ON IN ACCORDANCE WITH THESE PLANS AND THE STANDARD SPECIFICATIONS FOR CONSTRUCTION DATED 2001, AS APPROVED BY THE FEDERAL HIGHWAY ADMINISTRATION ON JANUARY 4, 2001 FOR USE ON THIS PROJECT, INCLUDING ALL SUBSEQUENT REVISIONS AND SUCH REVISED SPECIFICATIONS AND SPECIAL PROVISIONS AS ARE INCORPORATED IN THESE PLANS.

RECORD PLANS	
CONTRACTOR:	DON WESTON EXCAVATING - WILLISTON, VT
RESIDENT ENGINEER:	W. STODDARD
CONSTRUCTION BEGAN:	OCTOBER 11, 2003
CONSTRUCTION COMPLETE:	MAY 20, 2004
RECORD PLANS BY:	W. STODDARD
I HEREBY CERTIFY THAT ALL THE CONSTRUCTION REQUIRED BY THIS SET OF DRAWINGS HAS BEEN ACCOMPLISHED AS INDICATED HEREIN.	
BY:	<i>W. Stoddard</i> RESIDENT ENGINEER
DATE:	12-8-05
NOTE: Any further information concerning final quantities, amounts or other details relative to this project may be found at Central Files in the electronic archives.	


TRAFFIC DATA	
2002 ADT	= 1630
2022 ADT	= 2210
2022 ADTT	= 200

APPROVED: *W. Stoddard* DATE 6/30/02
DIRECTOR OF PROJECT DEVELOPMENT


PROJECT: STP2034 (13)S
SHARON GRADE CROSSING
SHEET 1 OF 35

TYPICAL SECTIONS


- 1/2" BITUMINOUS CONCRETE PAVEMENT SURFACE COURSE (TYPE III)
- 2" BITUMINOUS CONCRETE PAVEMENT BINDER COURSE (TYPE II)
- 4" BITUMINOUS CONCRETE PAVEMENT BASE COURSE (TYPE I)
- 12" SUBBASE OF DENSE GRADED CRUSHED STONE
- 12" SAND BORROW

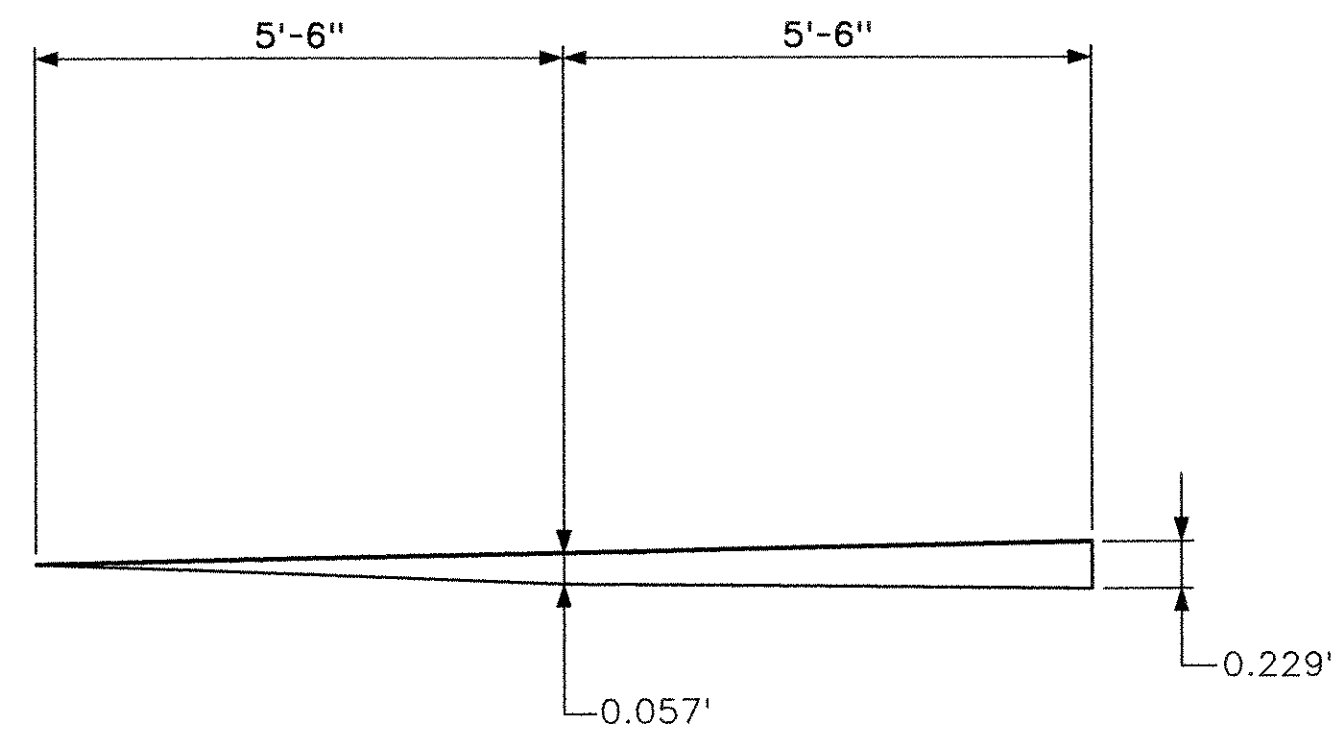


PARABOLIC DETAIL
NOT TO SCALE

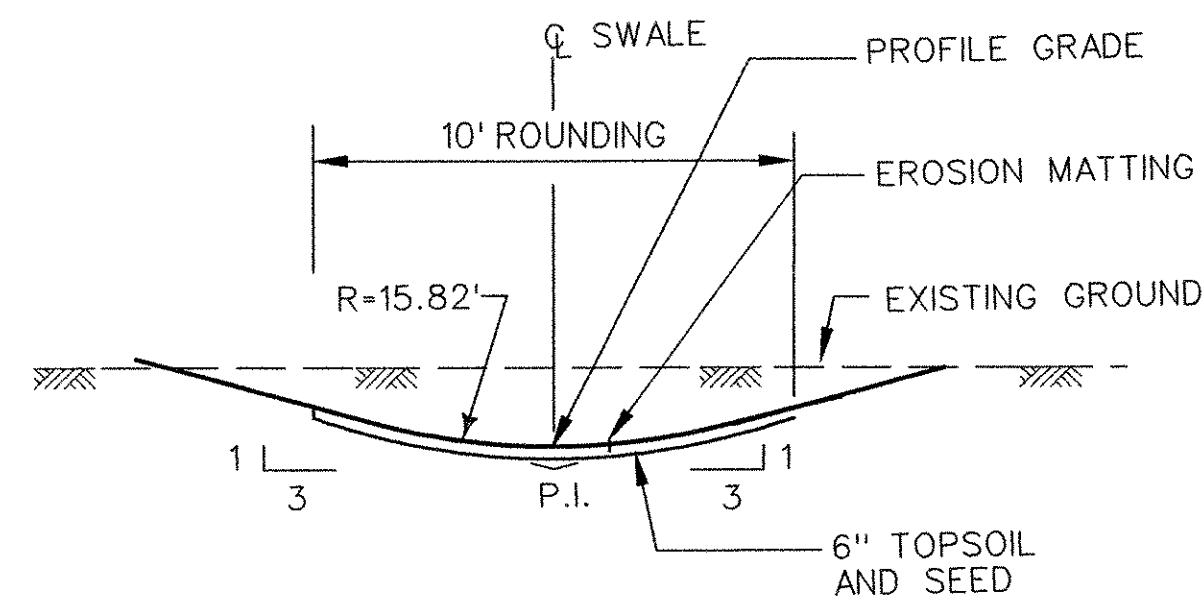

TYPICAL GRASS LINED SWALE

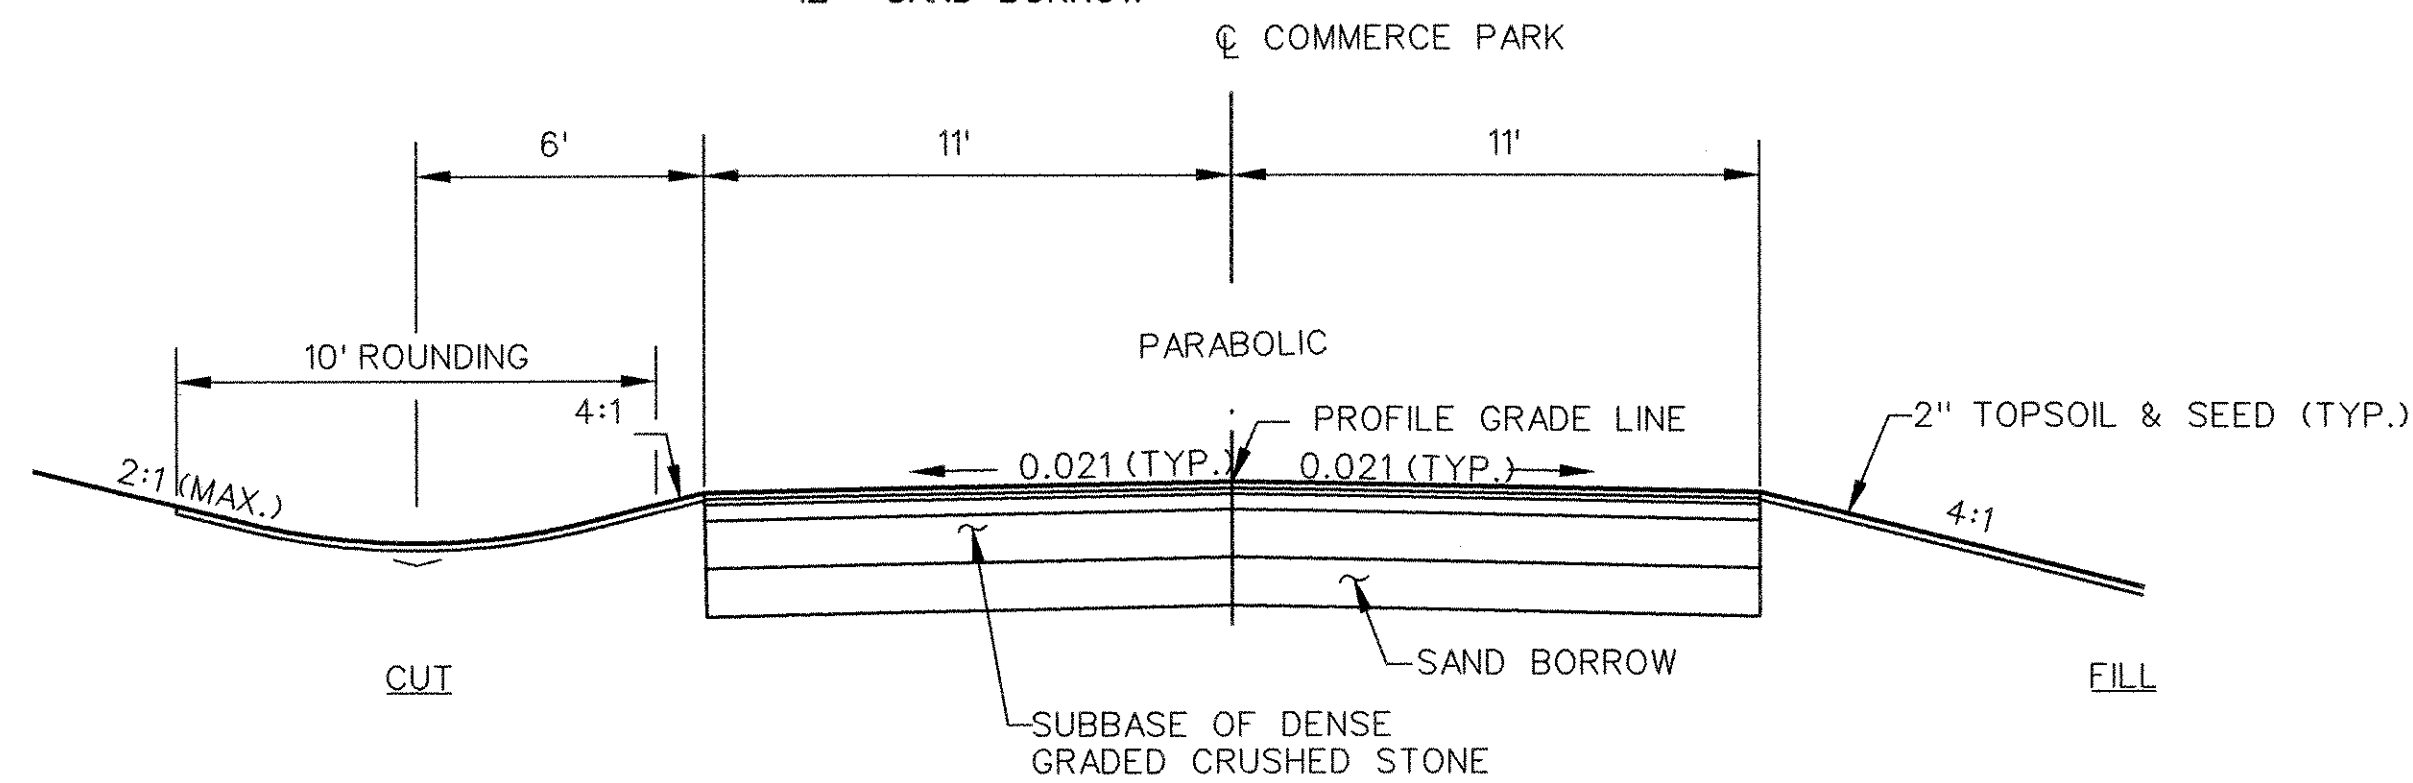


COMMERCE PARK PAVED SECTION
(STA. 16+87.21 TO STA. 19+67.07)

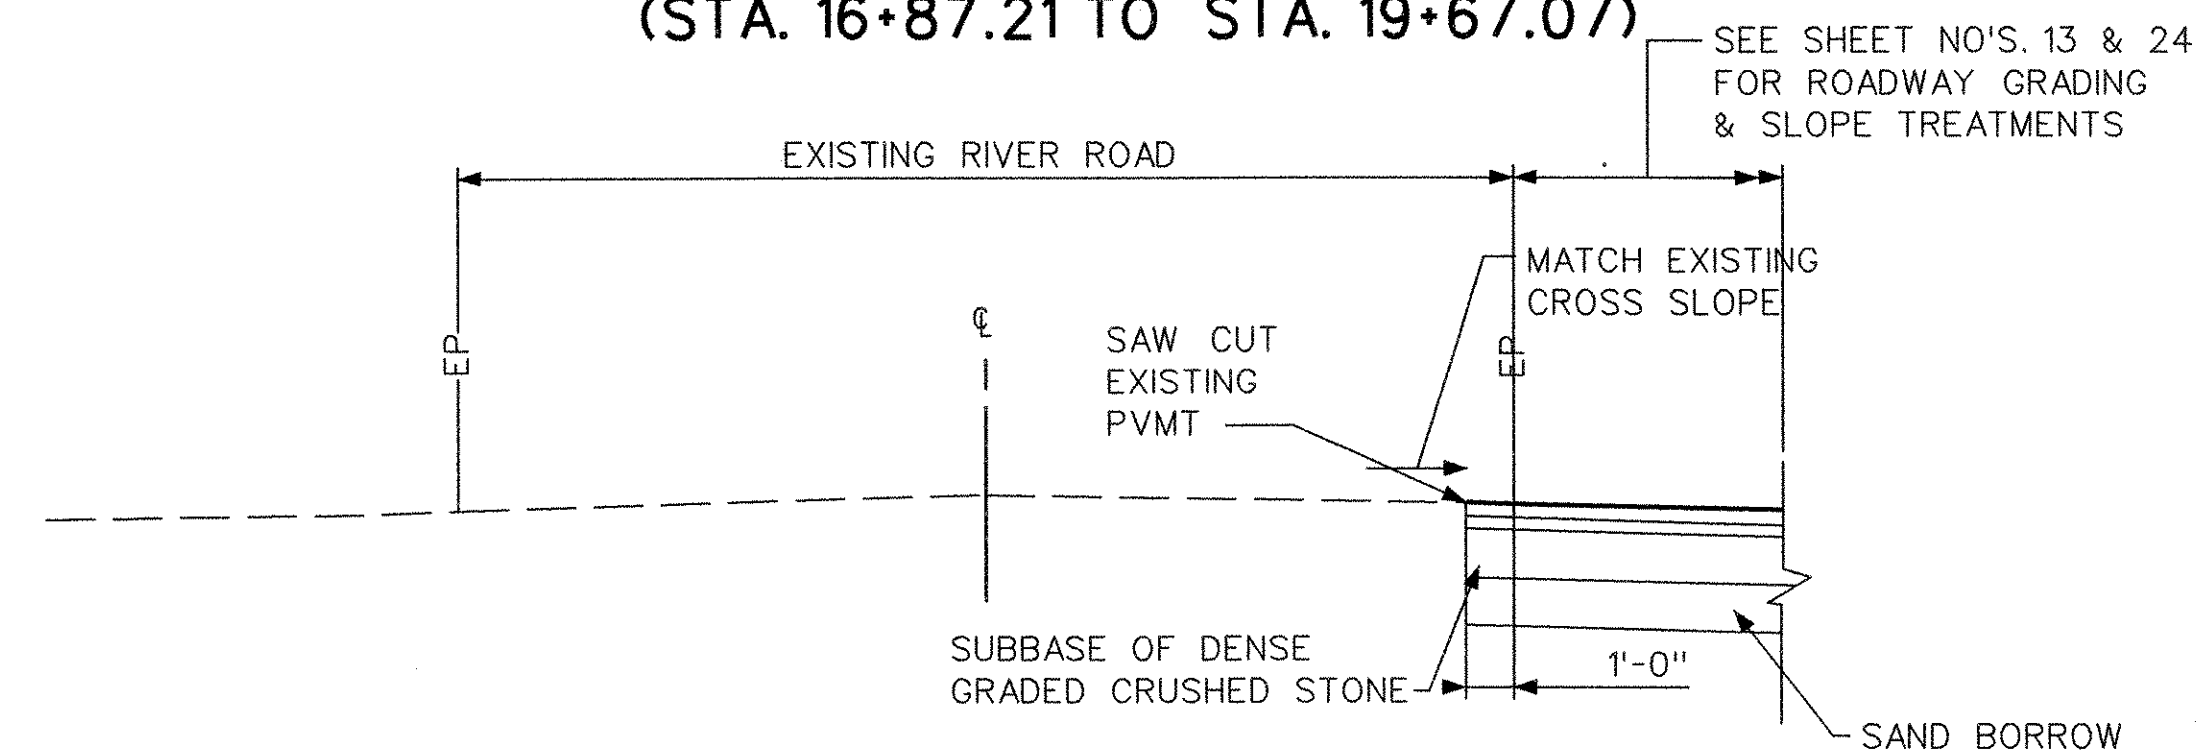

RIVER ROAD

- 7" AGGREGATE SURFACE COURSE
- 12" SUBBASE OF DENSE GRADED CRUSHED STONE
- 12" SAND BORROW

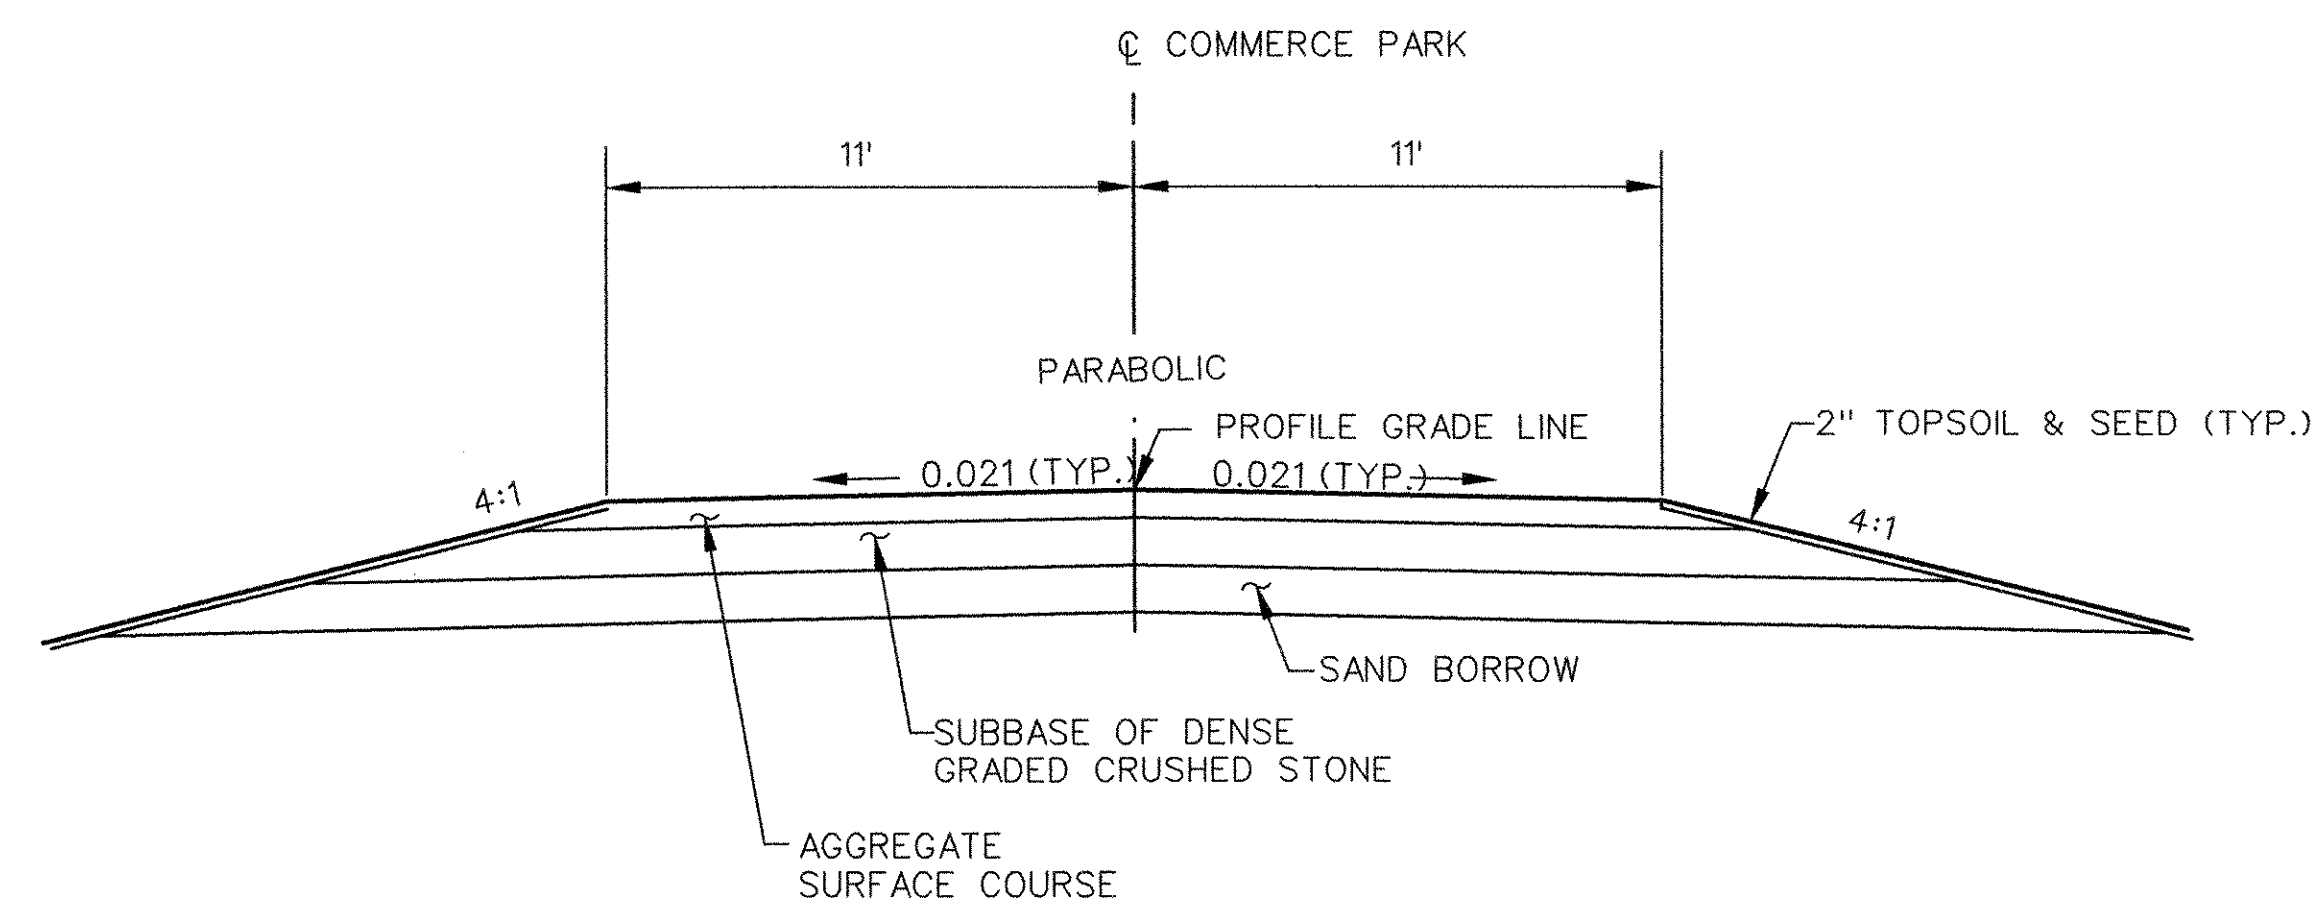

COMMERCE PARK AGGREGATE SECTION
(STA. 13+69.97 TO STA. 16+87.21)

GENERAL NOTES:

- SEED MIXTURE: SHALL NOT HAVE A WEED CONTENT EXCEEDING 0.40% BY WEIGHT AND SHALL BE FREE OF ALL NOXIOUS SEED.
- SEED: TO BE APPLIED PER SEEDING FORMULAS OR AS DIRECTED BY THE ENGINEER.
- FERTILIZER: FORMULA 10-20-10, TO BE USED WITH SEED, APPLIED AT THE RATE OF 500lb/AC (HYDRO SEEDERS MAY USE 19-19-19 FORMULA).
- AGRICULTURAL LIMESTONE: TO BE APPLIED AT THE RATE OF 2 TONS/AC OR AS DIRECTED BY THE ENGINEER.
- SLOPE ROUNDING: ALL CUT SLOPES TO BE ROUNDED IN ACCORDANCE WITH STANDARD SHEET B-5.
- TACK COAT: EMULSIFIED ASPHALT IS TO BE APPLIED AT THE RATE OF 0.015 GAL PER SY BETWEEN SUCCESSIVE COURSES OF PAVEMENT AS DIRECTED BY THE ENGINEER.
- LIMITS OF CLEARING AND GRUBBING OF UNDISTURBED AREAS SHALL BE A MIN. OF 5' OFF PROPOSED ROADWAY SLOPE LIMITS.

MATERIAL ITEM	THICKNESS	TOLERANCE
PAVEMENT (TOTAL DEPTH)	3 1/8"	
AGGREGATE	1 7/8"	
SUBBASE	1 3/8"	
SAND	1 3/8"	

09:02:53 AM 06/13/03 M:\18737s\vt_rail_xing\SHARON_CROSSING.dgn_sht2.dgn

DATUM

VERTICAL	NAVD88 ± 0.5 FT.
HORIZONTAL	SPC 1983


ORIGINAL PREPARED:		
DATE	REVISIONS	BY

NOT TO SCALE


SHEET 1 OF 2

PROJECT NAME:	SHARON GRADE CROSSING	
PROJECT NUMBER:	STP2034 (13)S	
FILE NAME:	SHT2.DGN	PLOT DATE: 06/13/03
PROJECT LEADER:	R. O'BLENIS	DRAWN BY: J. DEROSIER
DESIGNED BY:	C. GLOVER	CHECKED BY: R. ORO
		SHEET 2 OF 35

TYPICAL SECTIONS

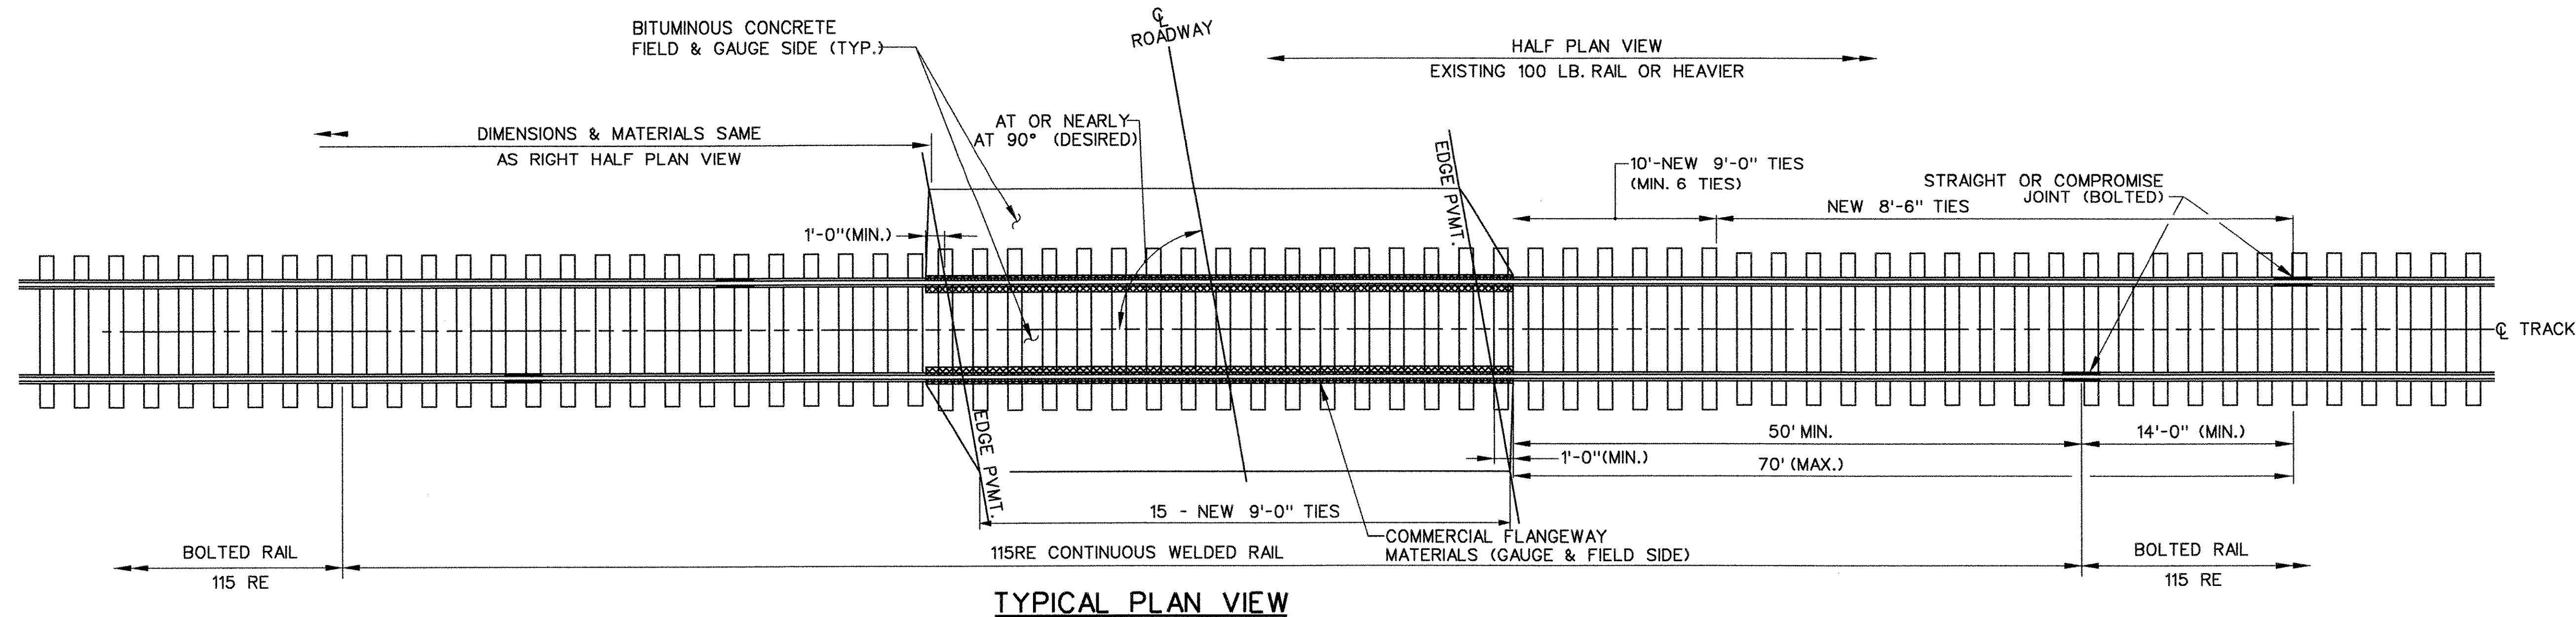


NOTE:
TRANSITION RAIL ON
EXISTING RAIL SECTION
(MIN. RAIL LENGTH 19'-6")

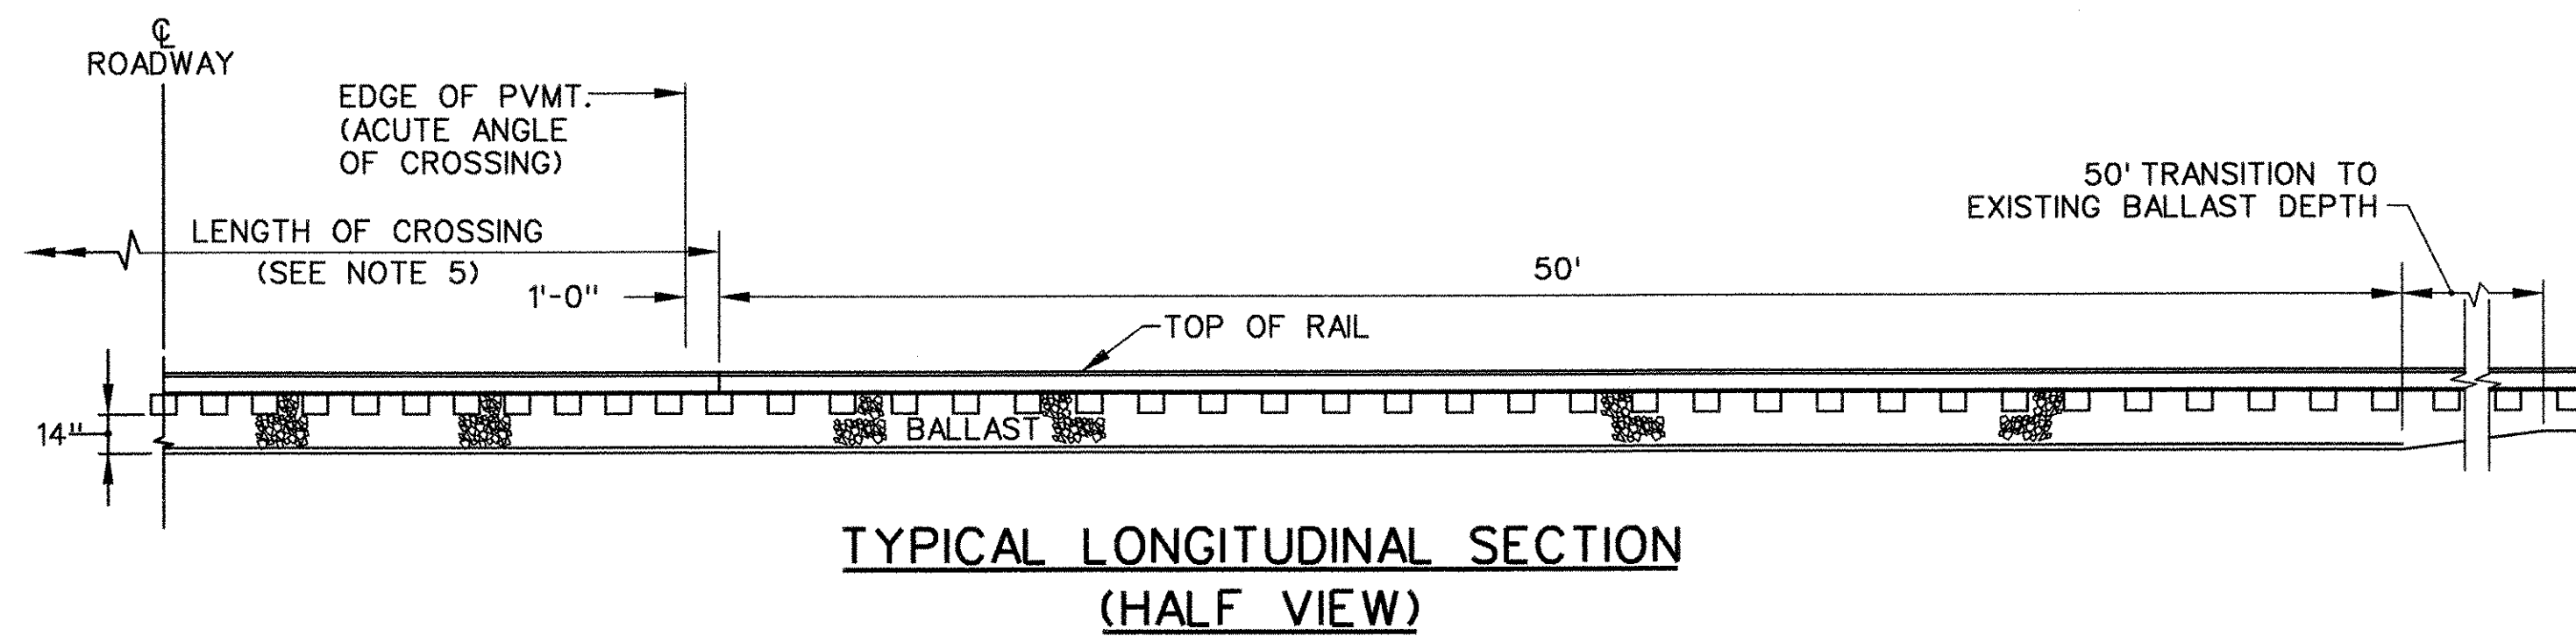

GENERAL NOTES:

1. SIGNAL CONDUIT (SCHEDULE 80 PVC) TO BE INSTALLED WITH SECURED ENDS IN LOCATIONS DIRECTED BY THE ENGINEER. PAYMENT FOR ITEM TO BE INCLUDED IN CROSSING LINEAR FOOT COST.
2. THE USE OF GEOTEXTILE FABRIC SHALL BE DETERMINED UPON INSPECTION OF FIELD CONDITIONS BY THE RAILROAD AND THE ENGINEER.
3. ALL RAIL JOINTS WITHIN THE CROSSING AREA AND 50'-0" BEYOND WILL BE CROPPED AND WELDED IN ACCORDANCE WITH THE LATEST REVISION OF A.R.E.A. SPECIFICATIONS AT AN OFF-SITE ELECTRIC WELDING PLANT. WELDING CAN BE DONE IN FIELD UTILIZING THERMITE WELDING WITH ADVANCE APPROVAL FROM THE STATE OF VERMONT AGENCY OF TRANSPORTATION. WELDED JOINTS SHALL BE GROUND TO CONFORM TO THE SHAPE OF THE RAIL ON GAUGE AND FIELD SIDES.
4. TIE SPACING UNDER CWR SHALL BE 18 INCHES ON CENTER.
5. NEW 7"x9"x9'-0" AND 7"x9"x8'-6" TIES SHALL BE USED IN CROSSING AREA AS SHOWN. TIES IN APPROACH AREAS SHALL BE REPLACED AS RECOMMENDED BY THE RAILROAD AND APPROVED BY THE ENGINEER.
6. TIE PLATES SHALL BE NEW 14 INCH PLATES MANUFACTURED FOR THE RAIL USED. PLATES SHALL BE INSPECTED AND APPROVED BY THE RAILROAD AND THE ENGINEER. RAIL FASTENERS SHALL BE EITHER CUT TRACK SPIKES OR PANDROL TYPE CLIPS AND LOCK SPIKES. SPECIFIC RAIL FASTENING SYSTEM SHALL BE RECOMMENDED BY THE RAILROAD AND APPROVED BY THE STATE OF VERMONT AGENCY OF TRANSPORTATION DURING FINAL DESIGN.
7. BALLAST IN APPROACH AREAS SHALL EXTEND 6" BEYOND END OF TIES AND SLOPED 1:2 TO THE ROADBED. (SEE DETAIL).
8. RAIL WEIGHTS SHALL BE DETERMINED BY THE RAILROAD AND APPROVED BY THE ENGINEER. MINIMUM RAIL WEIGHT SHALL BE 115 LB. RE.

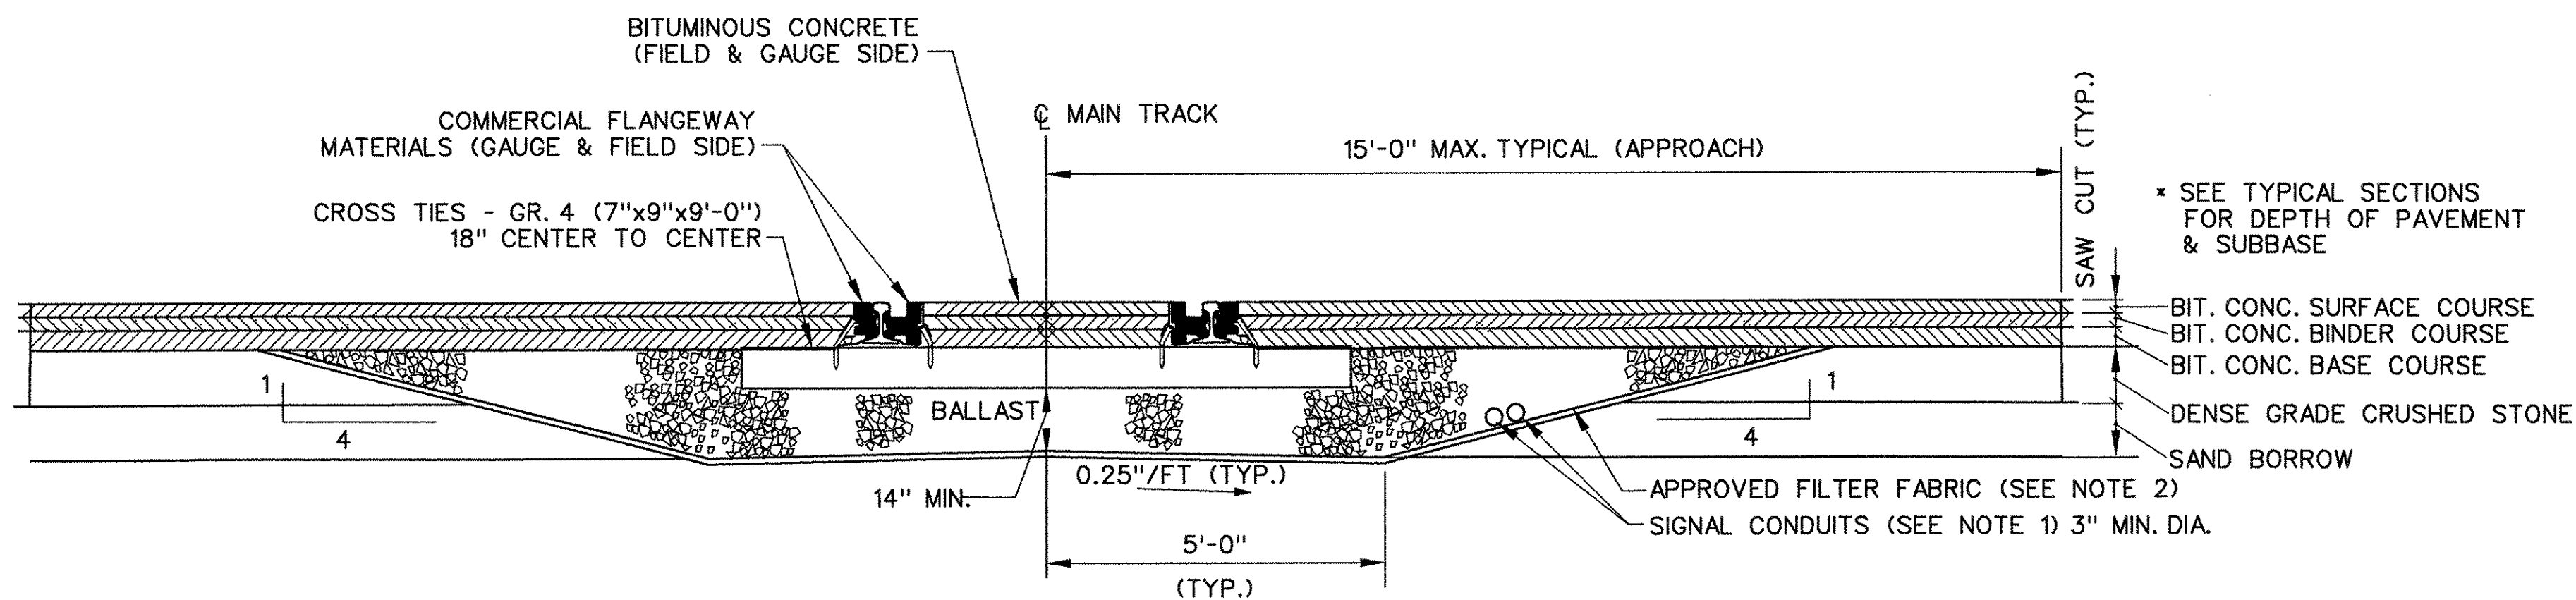

TYPICAL TRANSVERSE SECTION
(HALF VIEW)

ORIGINAL PREPARED:		
DATE	REVISIONS	BY

NOT TO SCALE

SHEET 2 OF 2

PROJECT NAME: SHARON GRADE CROSSING

PROJECT NUMBER: STP2034 (13)S

FILE NAME: SHT3.DGN
PROJECT LEADER: R. O'BLENIS
DESIGNED BY: C. GLOVER

PLOT DATE: 06/13/03
DRAWN BY: J. DEROSIER
CHECKED BY: R. ORO
SHEET 3 OF 35

DATUM	
VERTICAL	NAVD88 ± 0.5 FT.
HORIZONTAL	SPC 1983

QUANTITY SHEET

STATE OF VERMONT
AGENCY OF TRANSPORTATION

SUMMARY OF ESTIMATED QUANTITIES					
ROADWAY	QUANTITIES GRAND TOTAL	UNIT	ITEMS	ITEM NO.	ROUNDING
1	1	LS	CLEARING AND GRUBBING (INCLUDING INDIVIDUAL TREES & STUMPS)	201.10	EST
1650	1650	CY	COMMON EXCAVATION	203.15	-
20	20	CY	EXCAVATION OF SURFACES AND PAVEMENTS	203.28	EST
730	730	CY	SAND BORROW	203.31	5
1900	1900	SY	FINE GRADING - SUBGRADE	203.40	20
45	45	CY	TRENCH EXCAVATION OF EARTH	204.20	2
680	680	CY	SUBBASE OF DENSE GRADED CRUSHED STONE	301.35	4
200	200	CY	AGGREGATE SURFACE COURSE	401.10	EST
1.3	1.3	CWT	EMULSIFIED ASPHALT	404.65	EST
400	400	TON	BITUMINOUS CONCRETE PAVEMENT (PG 58-34)	406.25	-
70	70	LF	18" CPEP (SL)	601.2615	EST
66	66	LF	30" CPEP (SL)	601.2625	EST
2	2	EACH	18" CPEPES	601.7015	-
2	2	EACH	30" CPEPES	601.7025	-
0.50	0.50	MGAL	DUST CONTROL WITH WATER	609.10	EST
75	75	CY	STONE FILL, TYPE 1	613.10	.3
1	1	EACH	RELOCATE MAIL BOX SINGLE SUPPORT	617.10	-
4	4	EACH	BRACING ASSEMBLY FOR CHAIN-LINK FENCE, 6 FEET	620.21	-
170	170	LF	REMOVAL OF EXISTING FENCE	620.55	EST
48	48	LF	PLANK RAIL	621.15	-
50	50	LF	DUCTS, DIRECT BURIAL (PVC)	624.25	EST
1	1	LS	MOBILIZATION	635.10	-
1	1	LS	TRAFFIC CONTROL	641.10	-
520	520	LF	DURABLE 4" YELLOW LINE	646.41	EST
126	126	LF	DURABLE 24" STOP BAR	646.46	EST
2	2	EACH	DURABLE RAILROAD CROSSING SYMBOL	646.52	-
690	690	SY	GEOTEXTILE FOR SILT FENCE	649.51	4
100	100	LB	SEED	651.15	EST
200	200	LB	FERTILIZER	651.18	EST
2	2	TON	AGRICULTURAL LIMESTONE	651.20	EST
260	260	CY	TOP SOIL	651.35	10
75	75	SF	TRAFFIC SIGN, TYPE A	675.20	2.67


SUMMARY OF ESTIMATED QUANTITIES					
QUANTITIES	QUANTITIES GRAND TOTAL	UNIT	ITEMS	ITEM NO.	ROUNDING
			ITEMS		
			ITEMS		
			BEGIN SIGN POST OPTION		
66.15	66.15	LF	FLANGED CHANNEL SIGN POST	675.301	
66.15	66.15	LF	SQUARE STEEL SIGN POSTS	675.341	EST
9	9	EACH	REMOVING SIGNS	675.50	-
			***** ITEMS LISTED OUT OF ORDER		
50	50	SY	GEOTEXTILE FOR FILTER CURTAIN	649.61	
25	25	LB	SEED-WINTER RYE	651.17	
2	2	TON	HAY MULCH	651.25	
45	45	EACH	HAY BALES EROSION CONTROL	651.26	
1	1	LS	EROSION AND SEDIMENT CONTROL PLAN	652.10	
35	35	HR	MONITORING EROSION CONTROL PLAN	652.20	
1	1	LU	FIELD MAINTENANCE OF EROSION AND SEDIMENT CONTROL PLAN	652.30	
800	800	SY	EROSION MATTING (EXCELSIOR)	654.10	

DETAILED SUMMARY OF QUANTITIES		
QUANTITIES	UNIT	ITEMS
		COMMON EXCAVATION
308	CY	RIVER ROAD (T.H. 3)
876	CY	COMMERCE PARK
288	CY	GRASS LINED SWALE
160	CY	EXIST. CROSSING TO RIVER ROAD
18	CY	ROUNDING
1650	CY	TOTAL
		BITUMINOUS CONCRETE PAVEMENT RIVER ROAD & COMMERCE PARK STA. 16+87.21 TO STA. 19+67.07
86	TON	SURFACE COURSE (TYPE III)
86	TON	BINDER COURSE (TYPE II)
227	TON	BASE COURSE (TYPE I)
1	TON	ROUNDING
400	TON	TOTAL
		AGGREGATE SURFACE COURSE
198	CY	COMMERCE PARK STA. 13+69.97 TO STA. 16+87.21
2	CY	ROUNDING
200	CY	TOTAL
		SUBBASE
676	CY	DENSE GRADED CRUSHED STONE
4	CY	ROUNDING
680	CY	TOTAL
725	CY	SAND BORROW
5	CY	ROUNDING
730	CY	TOTAL

PROJECT NAME: **SHARON GRADE CROSSING**
 PROJECT NUMBER: STP2034 (13)S
 FILE NAME: SHT5.DGN PLOT DATE: 01/16/03
 PROJECT LEADER: R. O'BLENIS DRAWN BY: D. LOCKS
 DESIGNED BY: C. GLOVER CHECKED BY: R. ORO
 SHEET 5 OF 35

10:11:56 AM
1/16/03 11:27:25 AM
01/16/03

09:05:45 AM
06/13/03
M:\187378_vt_rail\sharon_crossing\dm\sh16.dgn

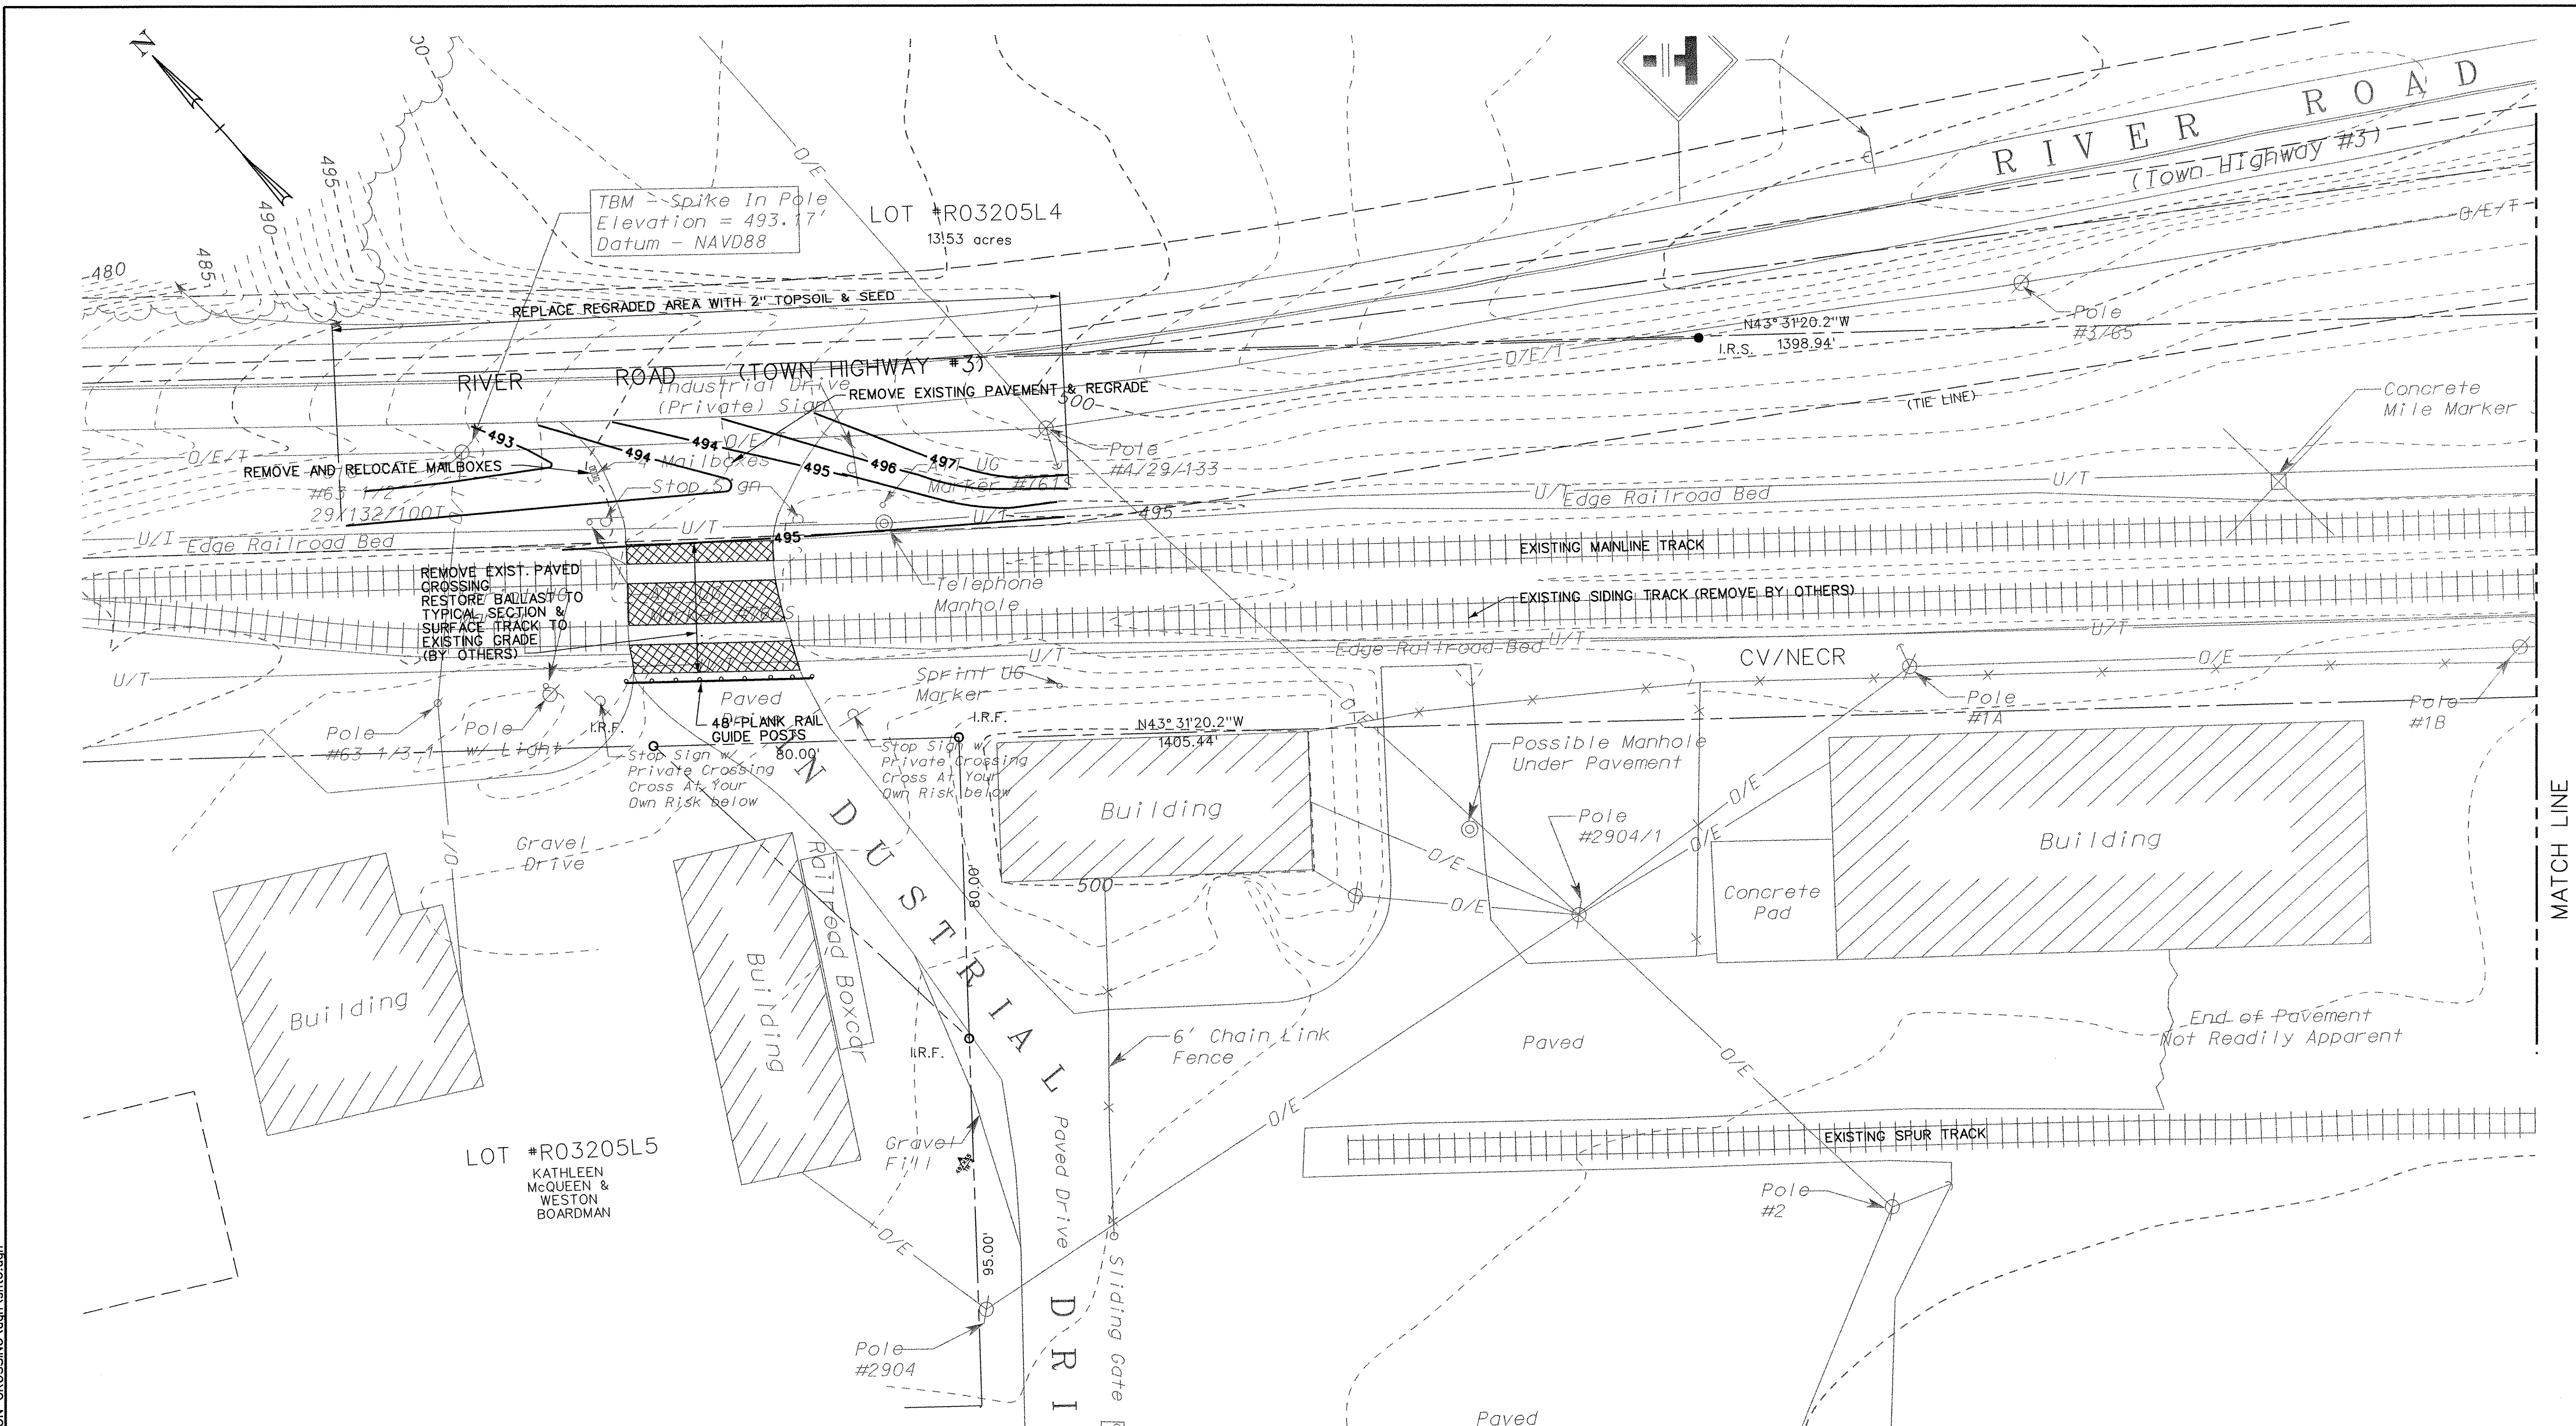

TBM - Spike In Pole
Elevation = 493.17'
Datum - NAVD88


LOT #R03205L4
13153 acres

LOT #R03205L5
KATHLEEN
MCQUEEN &
WESTON
BOARDMAN

DATUM


VERTICAL	NAVD88 ± 0.5 FT.
HORIZONTAL	SPC 1983

ORIGINAL PREPARED:		
DATE	REVISIONS	BY

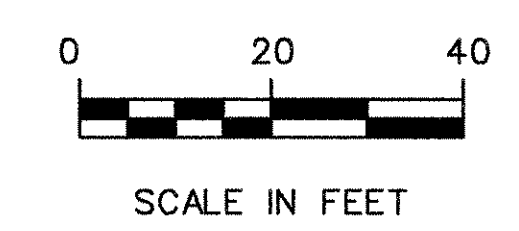

PLAN LAYOUT - SHEET 1 OF 3

PROJECT NAME:	SHARON GRADE CROSSING	
PROJECT NUMBER:	STP2034 (13)S	
FILE NAME:	SHT6.DGN	PLOT DATE: 06/13/03
PROJECT LEADER:	R. O'BLENIS	DRAWN BY: J. DEROSIER
DESIGNED BY:	C. GLOVER	CHECKED BY: R. ORO
		SHEET 6 OF 35

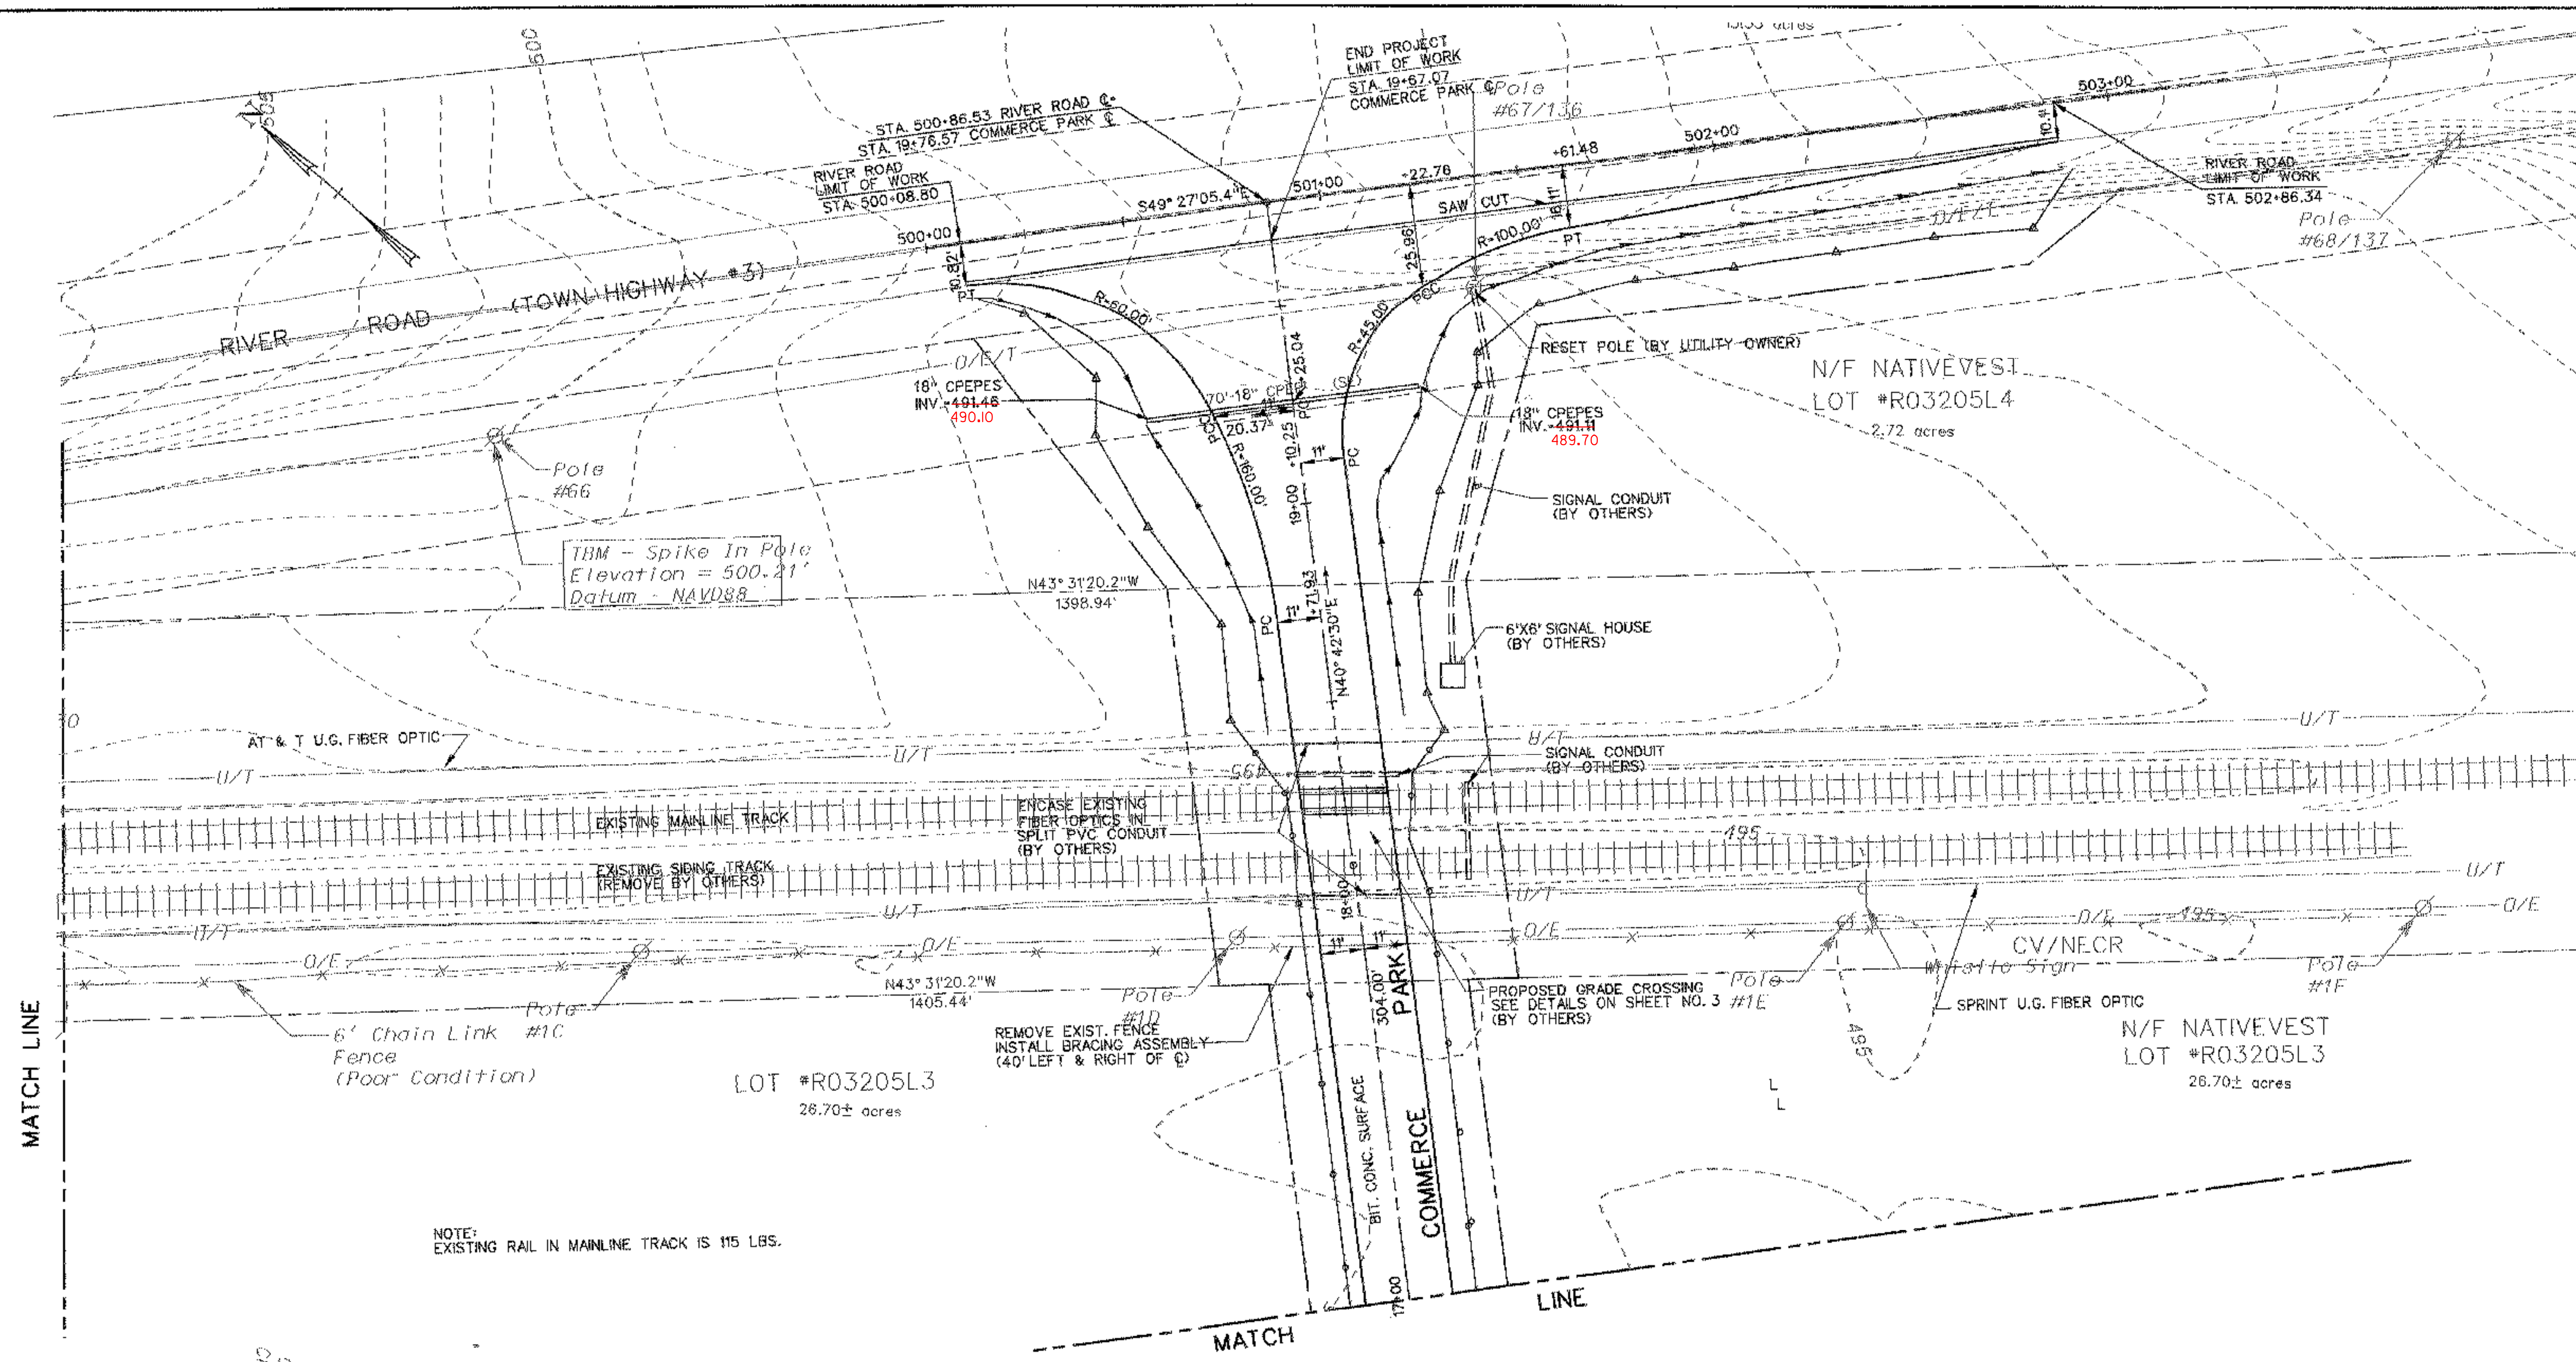

NOTE:
EXISTING RAIL IN MAINLINE TRACK IS 115 LBS.

PLAN LAYOUT - SHEET 2 OF 3

DATUM


VERTICAL	NAVD88 ± 0.5 FT.
HORIZONTAL	SPC 1983

ORIGINAL PREPARED:

DATE	REVISIONS	BY




PROJECT NAME:	SHARON GRADE CROSSING		
PROJECT NUMBER:	STP2034 (13)S		
FILE NAME:	SHT7.DGN	PLOT DATE:	06/13/03
PROJECT LEADER:	R. O'BLENIS	DRAWN BY:	J. DEROSIER
DESIGNED BY:	C. GLOVER	CHECKED BY:	R. ORO
		SHEET	7 OF 36

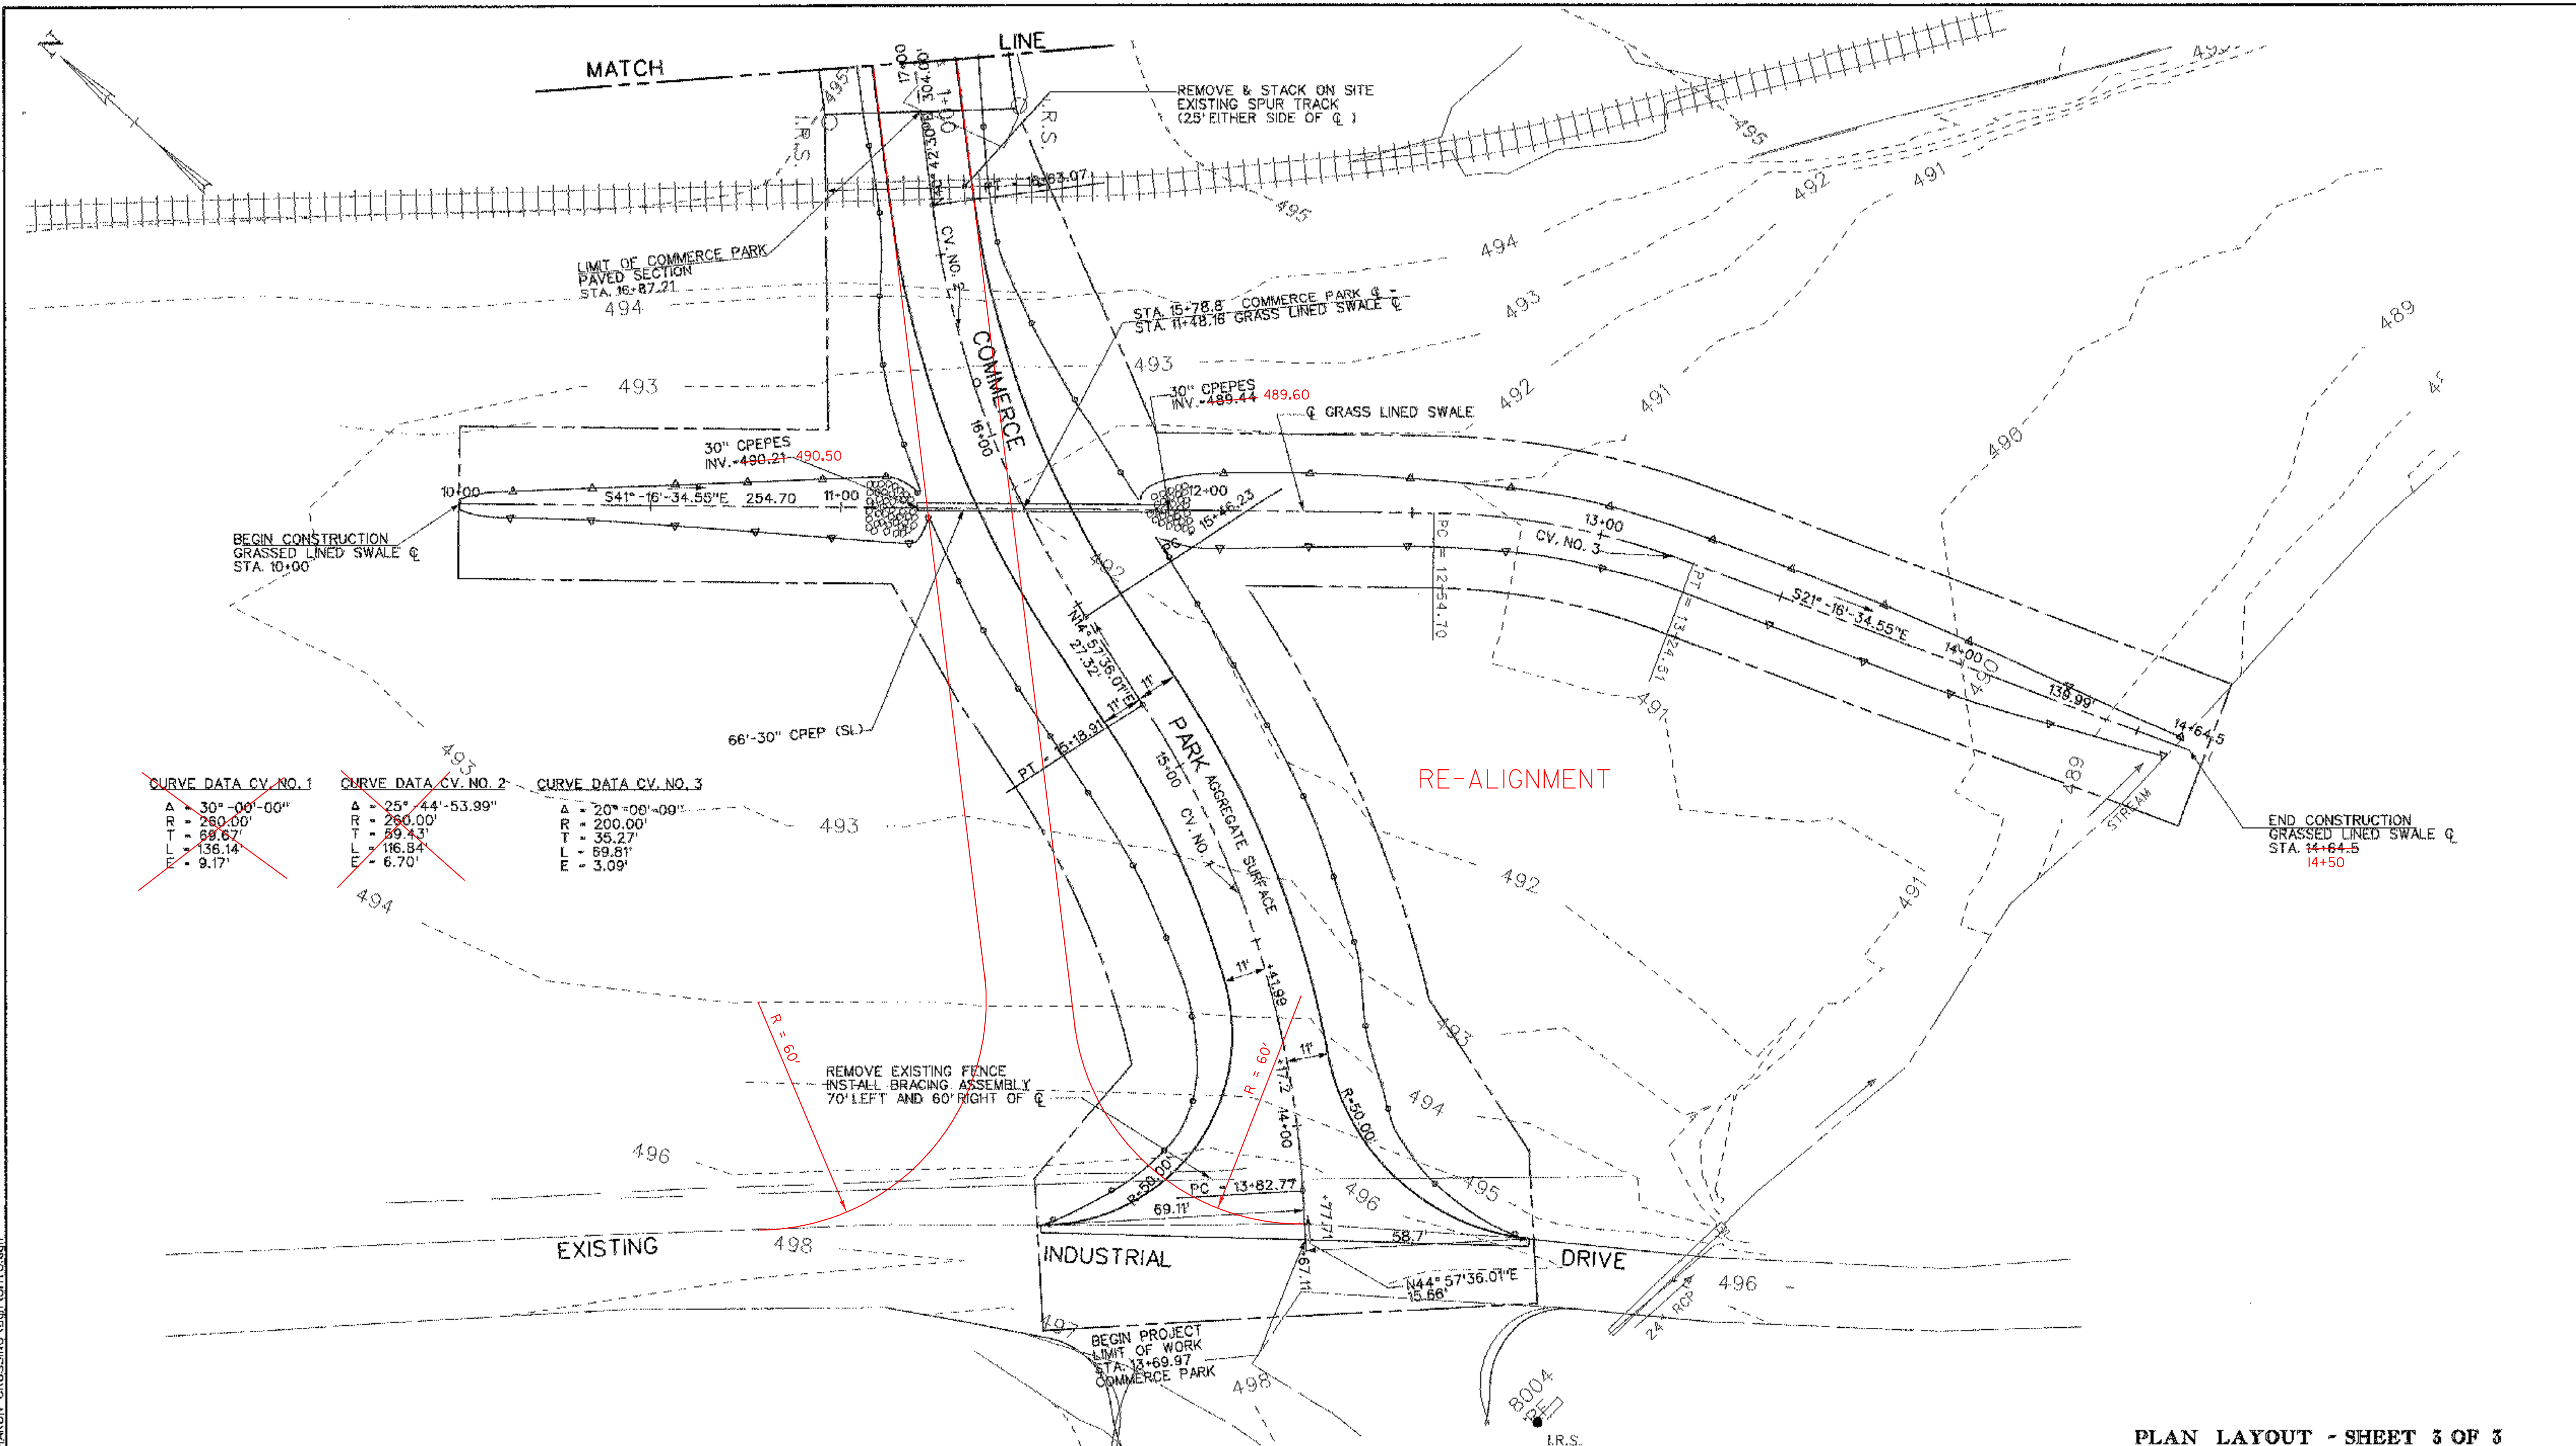

CURVE DATA CV. NO. 1	CURVE DATA CV. NO. 2	CURVE DATA CV. NO. 3
Δ = 30°-00'-00"	Δ = 25°-44'-53.99"	Δ = 20°-00'-00"
R = 260.00'	R = 260.00'	R = 200.00'
T = 69.67'	T = 59.43'	T = 35.27'
L = 136.14'	L = 116.84'	L = 69.81'
E = 9.17'	E = 6.70'	E = 3.09'


DATUM	
VERTICAL	NAVD88 ± 0.5 FT.
HORIZONTAL	SPC 1983

ORIGINAL PREPARED:		
DATE	REVISIONS	BY

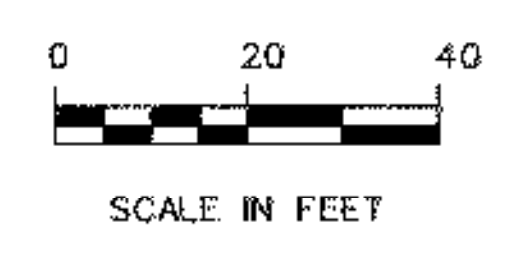

PLAN LAYOUT - SHEET 3 OF 3

PROJECT NAME: SHARON GRADE CROSSING	
PROJECT NUMBER: STP2034 (13)S	
FILE NAME: SHT8.DGN	PLOT DATE: 06/13/03
PROJECT LEADER: R. O'BLENIS	DRAWN BY: J. DEROSIER
DESIGNED BY: C. GLOVER	CHECKED BY: R. ORO
SHEET 8 OF 35	

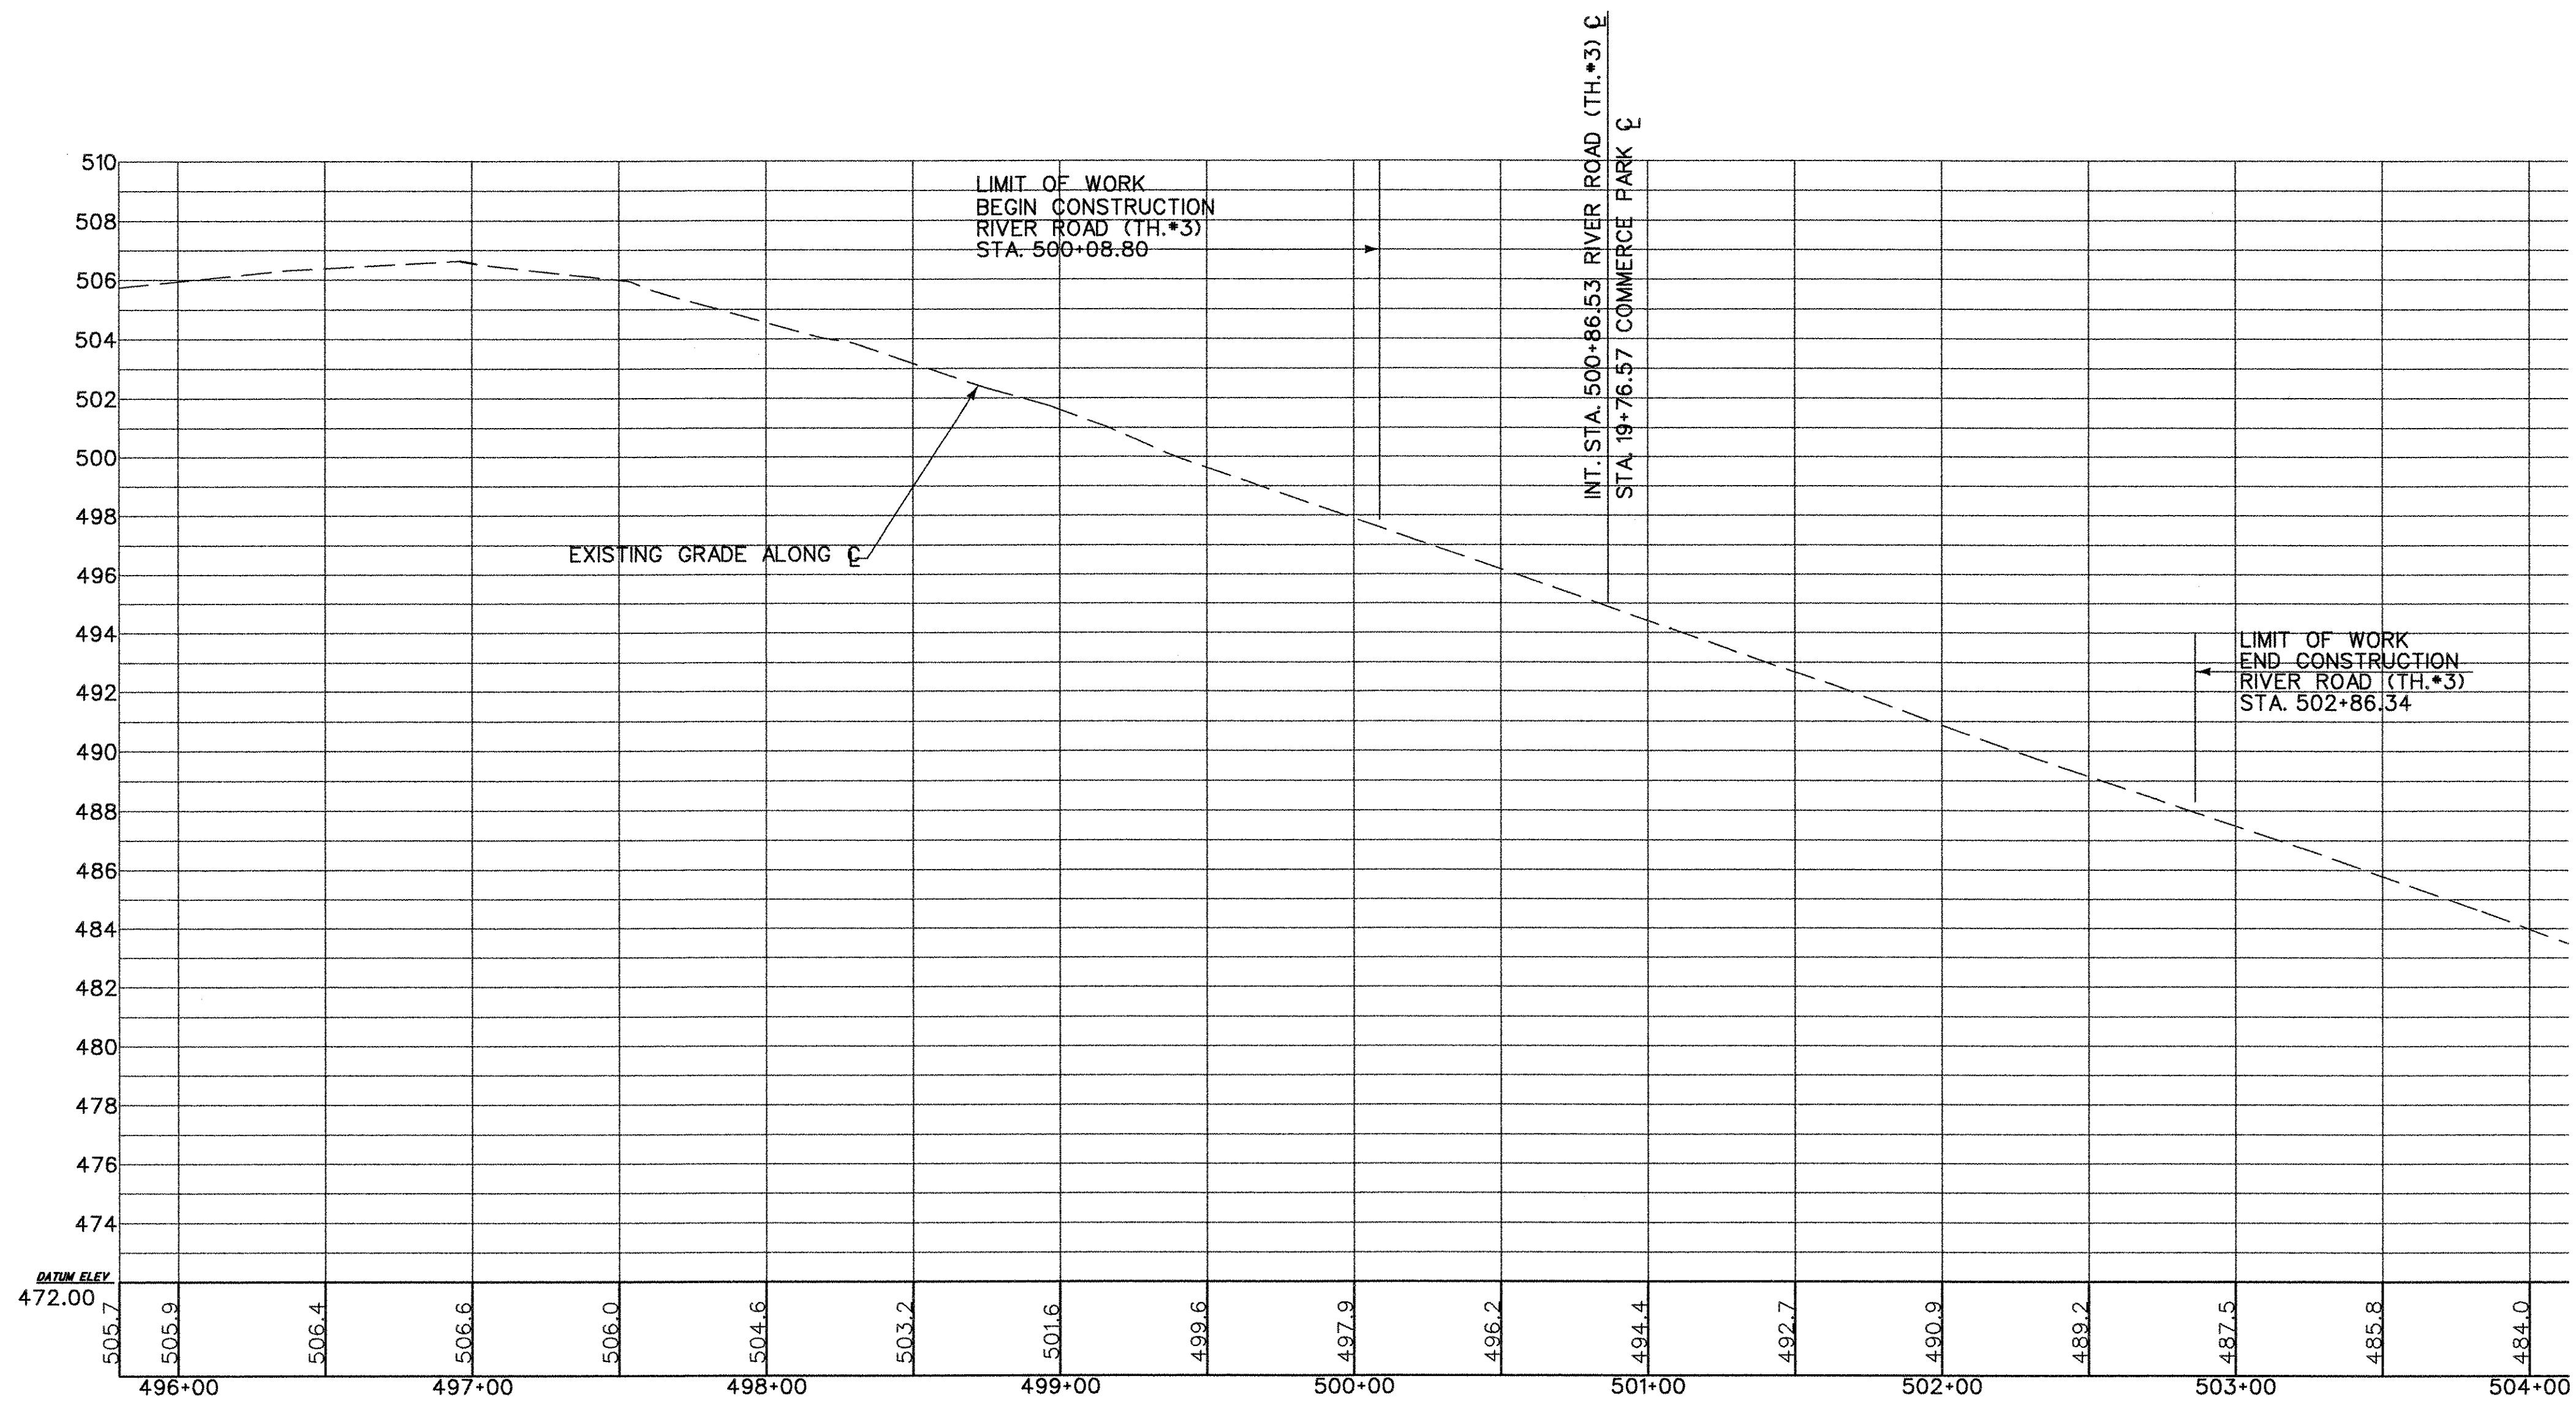


PROFILE - RIVER ROAD

PROFILE - RIVER ROAD


DATUM
 VERTICAL NAVD88 ± 0.5 FT.
 HORIZONTAL SPC 1983

ORIGINAL PREPARED:		
DATE	REVISIONS	BY

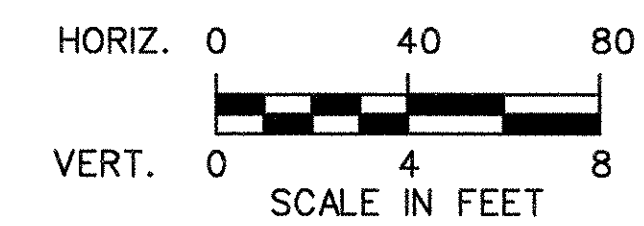

PROJECT NAME:	SHARON GRADE CROSSING	
PROJECT NUMBER:	STP2034 (13)S	
FILE NAME:	SHT9.DGN	PLOT DATE: 06/13/03
PROJECT LEADER:	R. O'BLENIS	DRAWN BY: J. DEROSIER
DESIGNED BY:	C. GLOVER	CHECKED BY: R. ORO
		SHEET 9 OF 35

06/13/03 AM
 M:\1817379_vt_rail_xing\SHARON_CROSSING.dgn_sht9.dgn

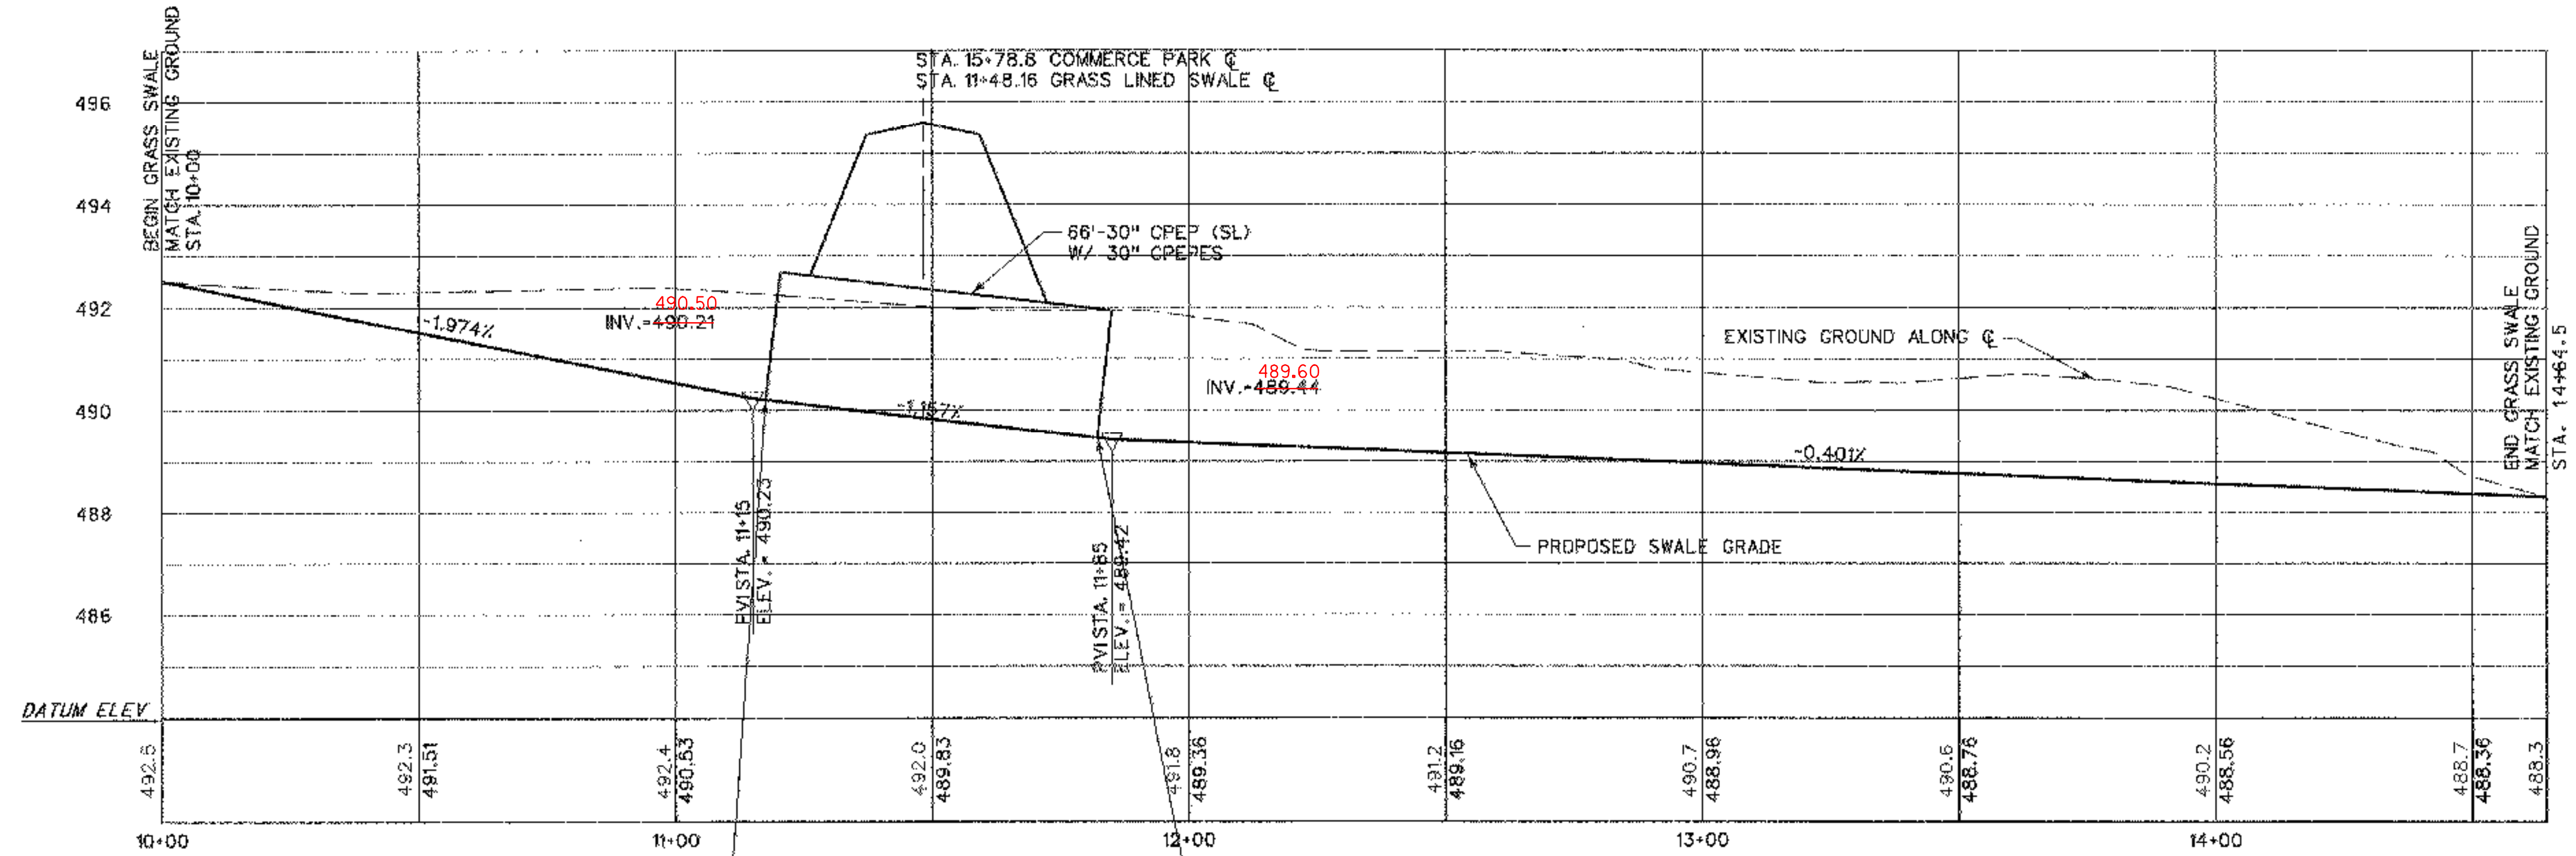

PROFILE - GRASS LINED SWALE

PROFILE - GRASS LINED SWALE


PROJECT NAME: SHARON GRADE CROSSING

PROJECT NUMBER: STP2034 (13)S

FILE NAME: SHT10.DGN	PLOT DATE: 06/13/03
PROJECT LEADER: R. O'BLENIS	DRAWN BY: J. DEROSIER
DESIGNED BY: C. GLOVER	CHECKED BY: R. ORO
	SHEET 10 OF 35


DATUM
 VERTICAL NAVD88 ± 0.5 FT.
 HORIZONTAL SPC 1983

ORIGINAL PREPARED:		
DATE	REVISIONS	BY

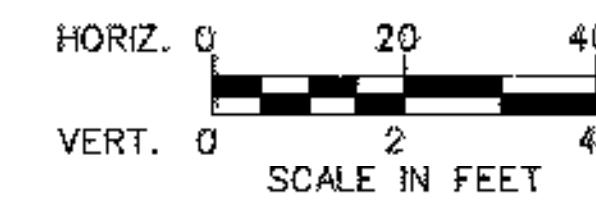


06/13/03 10:22 AM \\s:\data\sharon_crossing\dgn\sh10.dgn

09:10:41 AM
 06/13/03
 M:\18737s_vt_rail_xing\SHARON_CROSSING\ dgn\ SHT11.dgn

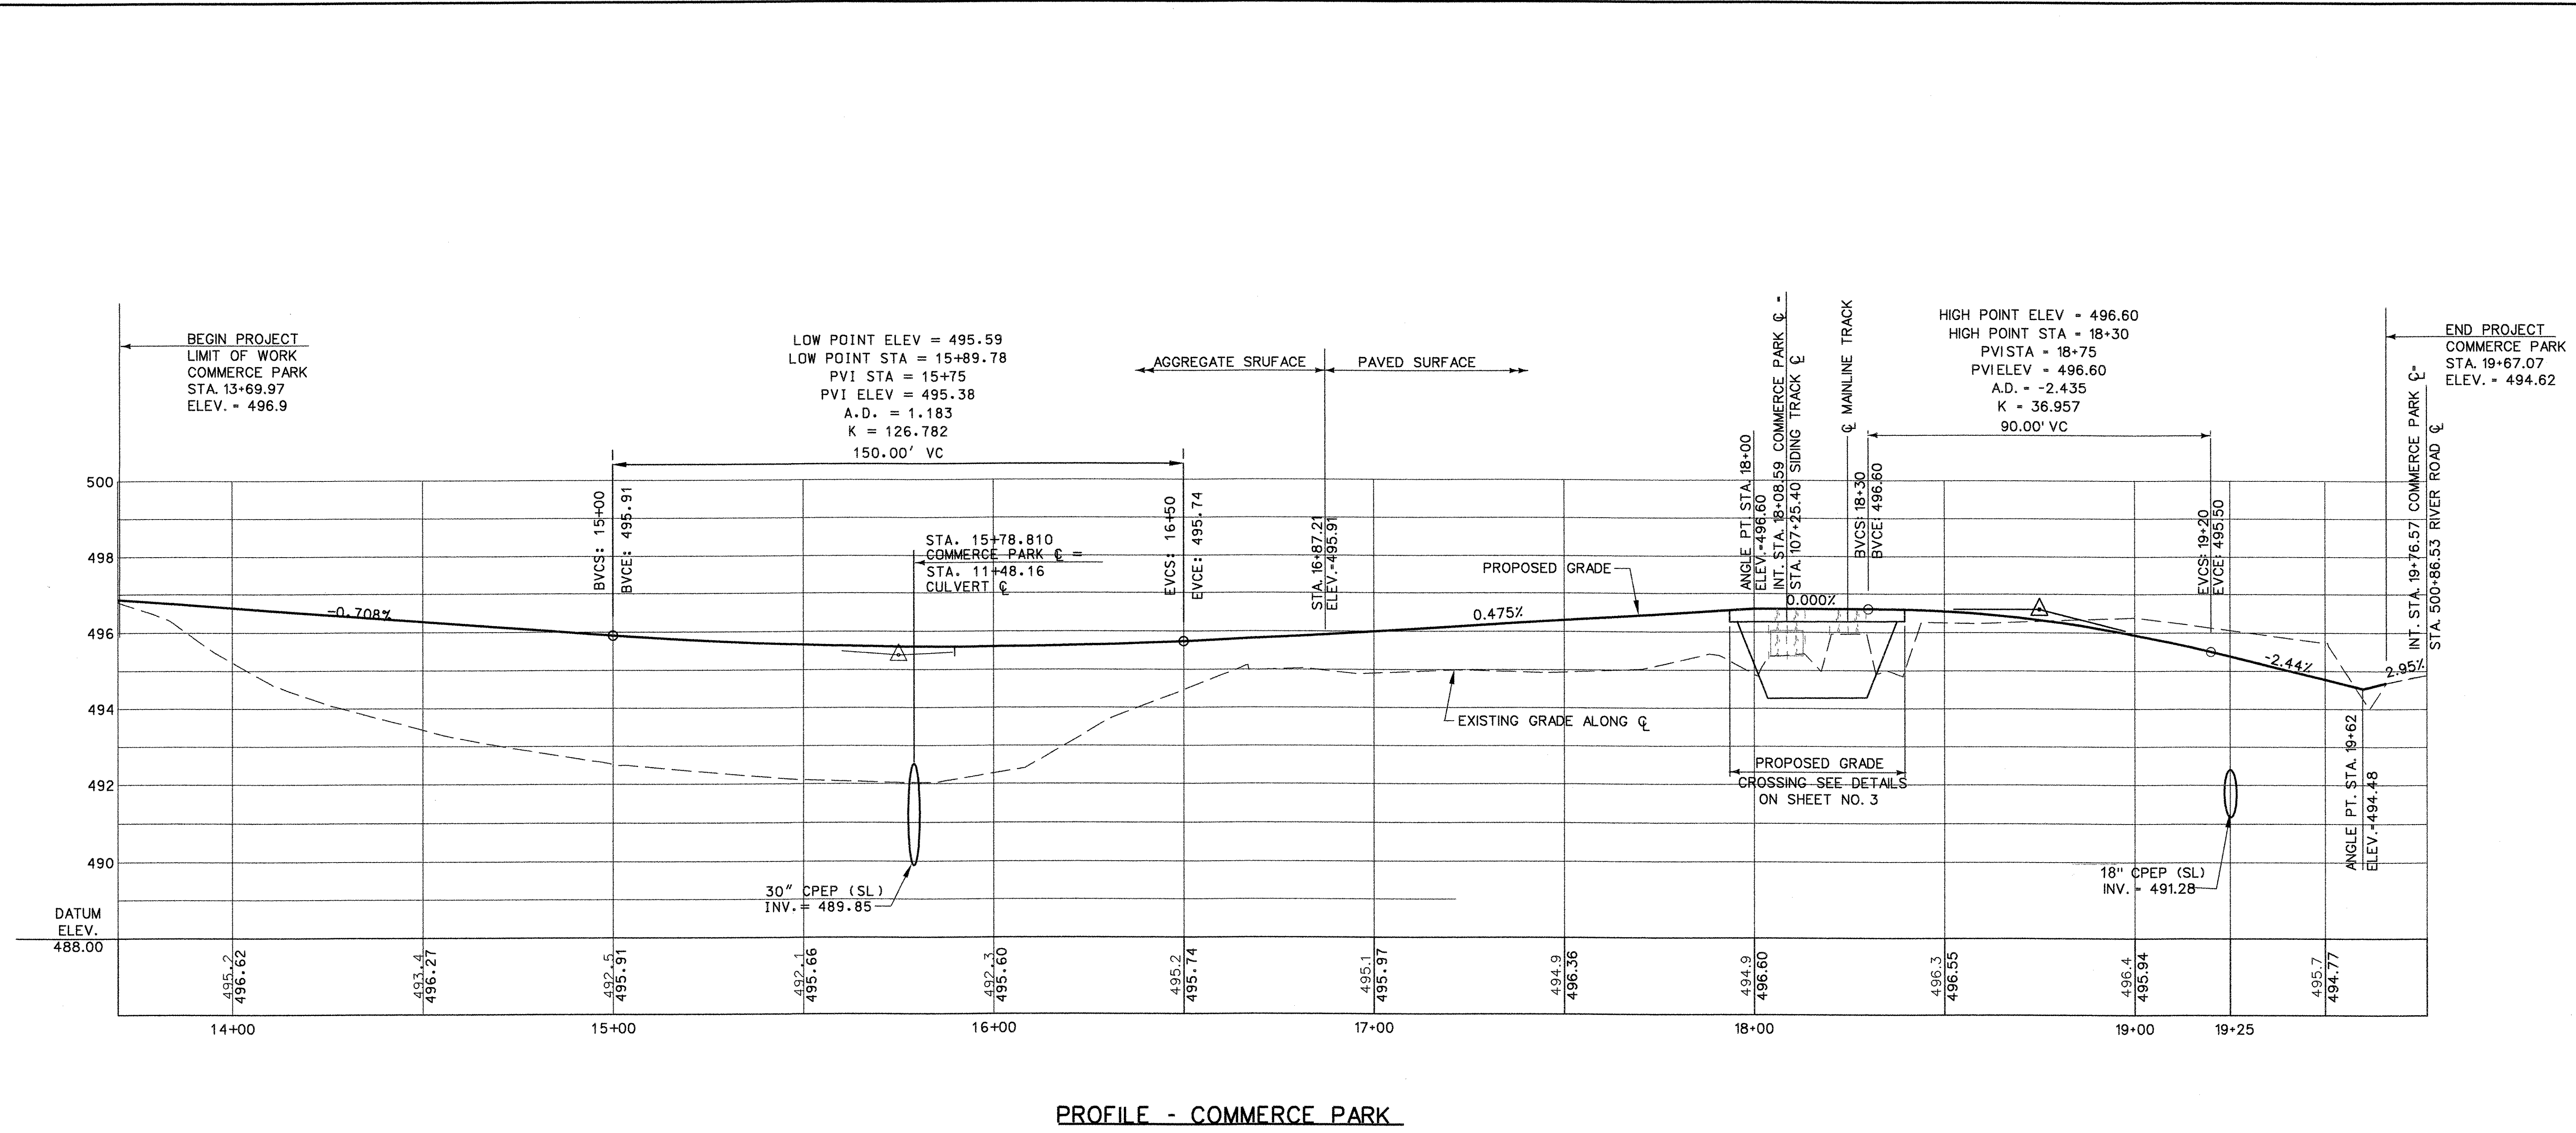

DATUM
 VERTICAL NAVD88 ± 0.5 FT.
 HORIZONTAL SPC 1983

ORIGINAL PREPARED:		
DATE	REVISIONS	BY

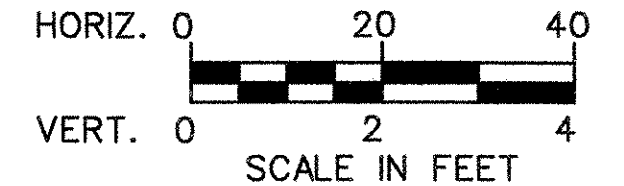

PROFILE - COMMERCE PARK


PROJECT NAME: **SHARON GRADE CROSSING**
 PROJECT NUMBER: STP2034 (13)S

FILE NAME: SHT11.DGN
 PROJECT LEADER: R. O'BLENIS
 DESIGNED BY: C. GLOVER

PLOT DATE: 06/13/03
 DRAWN BY: J. DEROSIER
 CHECKED BY: R. ORO

SHEET 11 OF 35

09:07:58 AM
06/13/03
M:\187379_vt_rail_xing\SHARON_CROSSING.dgn_sht12.dgn

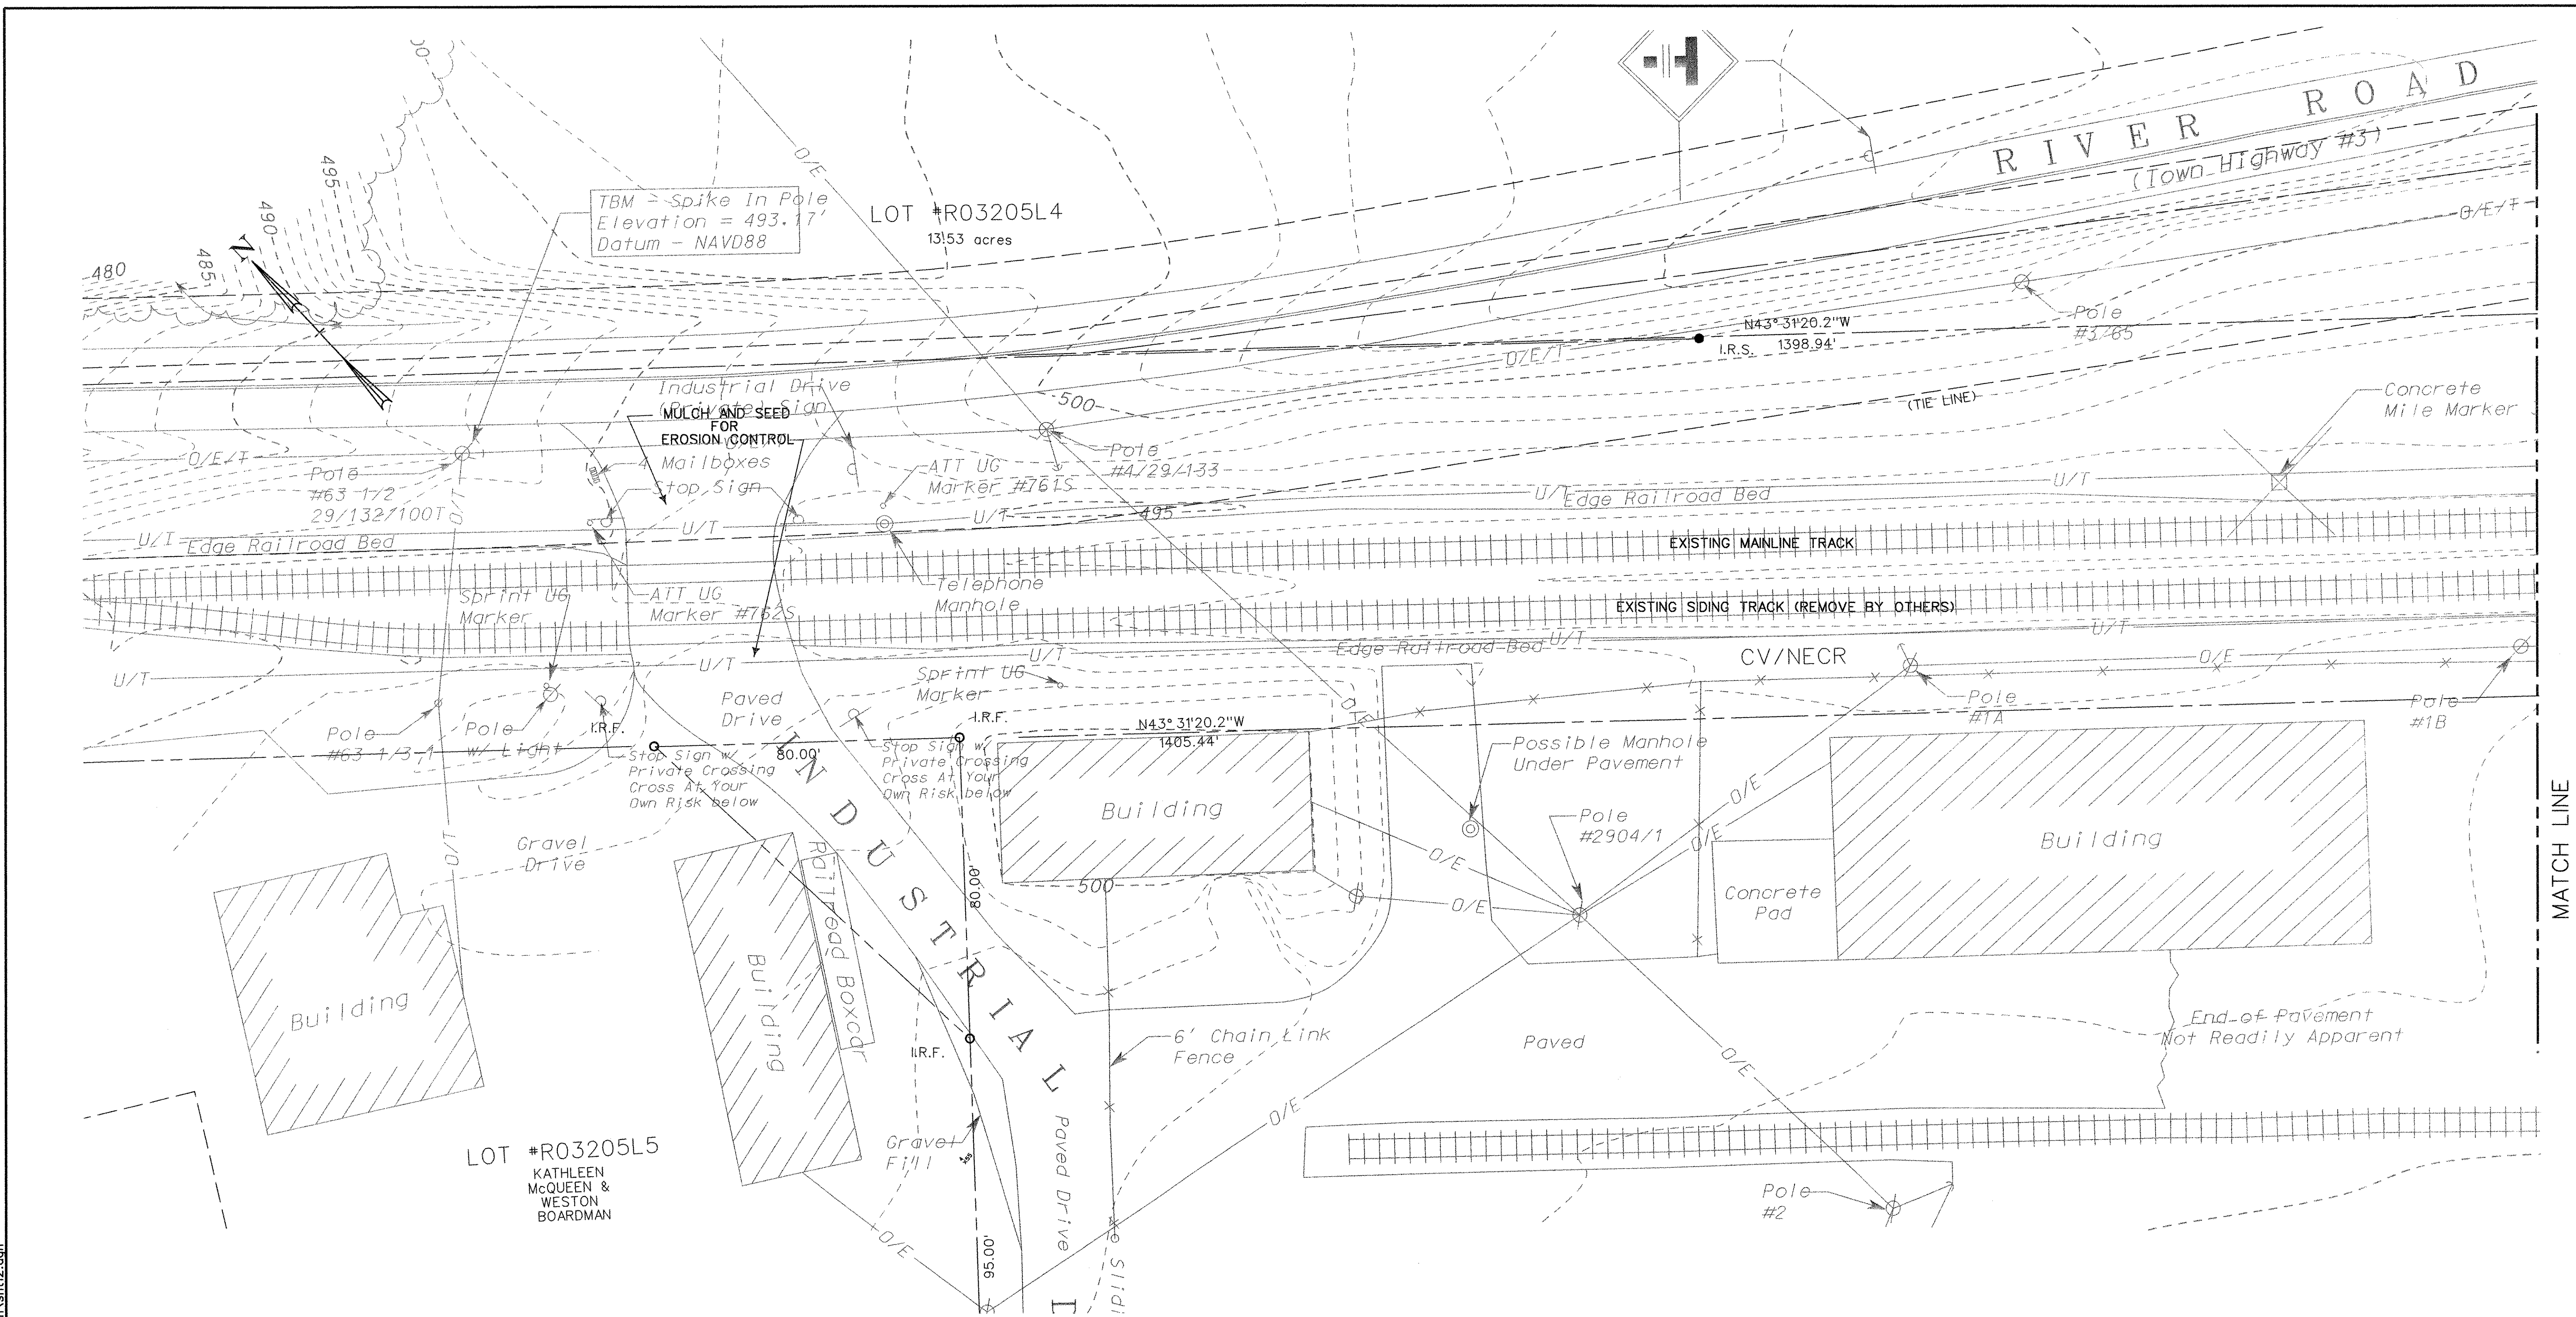


TBM = Spike In Pole
Elevation = 493.17'
Datum - NAVD88

LOT #R03205L4
13.53 acres

LOT #R03205L5
KATHLEEN
MCQUEEN &
WESTON
BOARDMAN



DATUM
VERTICAL NAVD88 ± 0.5 FT.
HORIZONTAL SPC 1983

ORIGINAL PREPARED:		
DATE	REVISIONS	BY

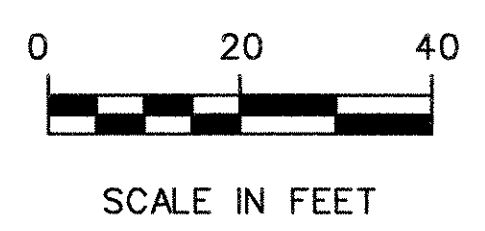


EROSION & SEDIMENT CONTROL PLAN
SHEET 1 OF 3


PROJECT NAME:	SHARON GRADE CROSSING	
PROJECT NUMBER:	STP2034 (13)S	
FILE NAME:	SHT12.DGN	PLOT DATE: 06/13/03
PROJECT LEADER:	R. O'BLENIS	DRAWN BY: J. DEROSIER
DESIGNED BY:	C. GLOVER	CHECKED BY: R. ORO
		SHEET 12 OF 35

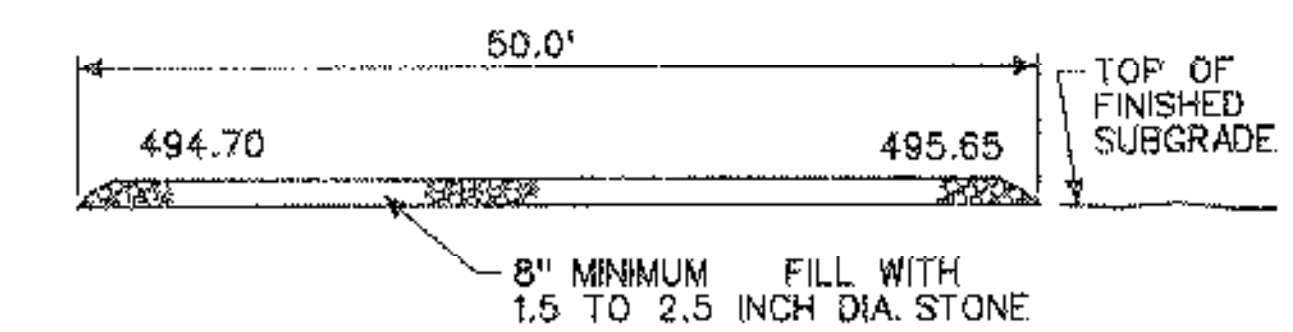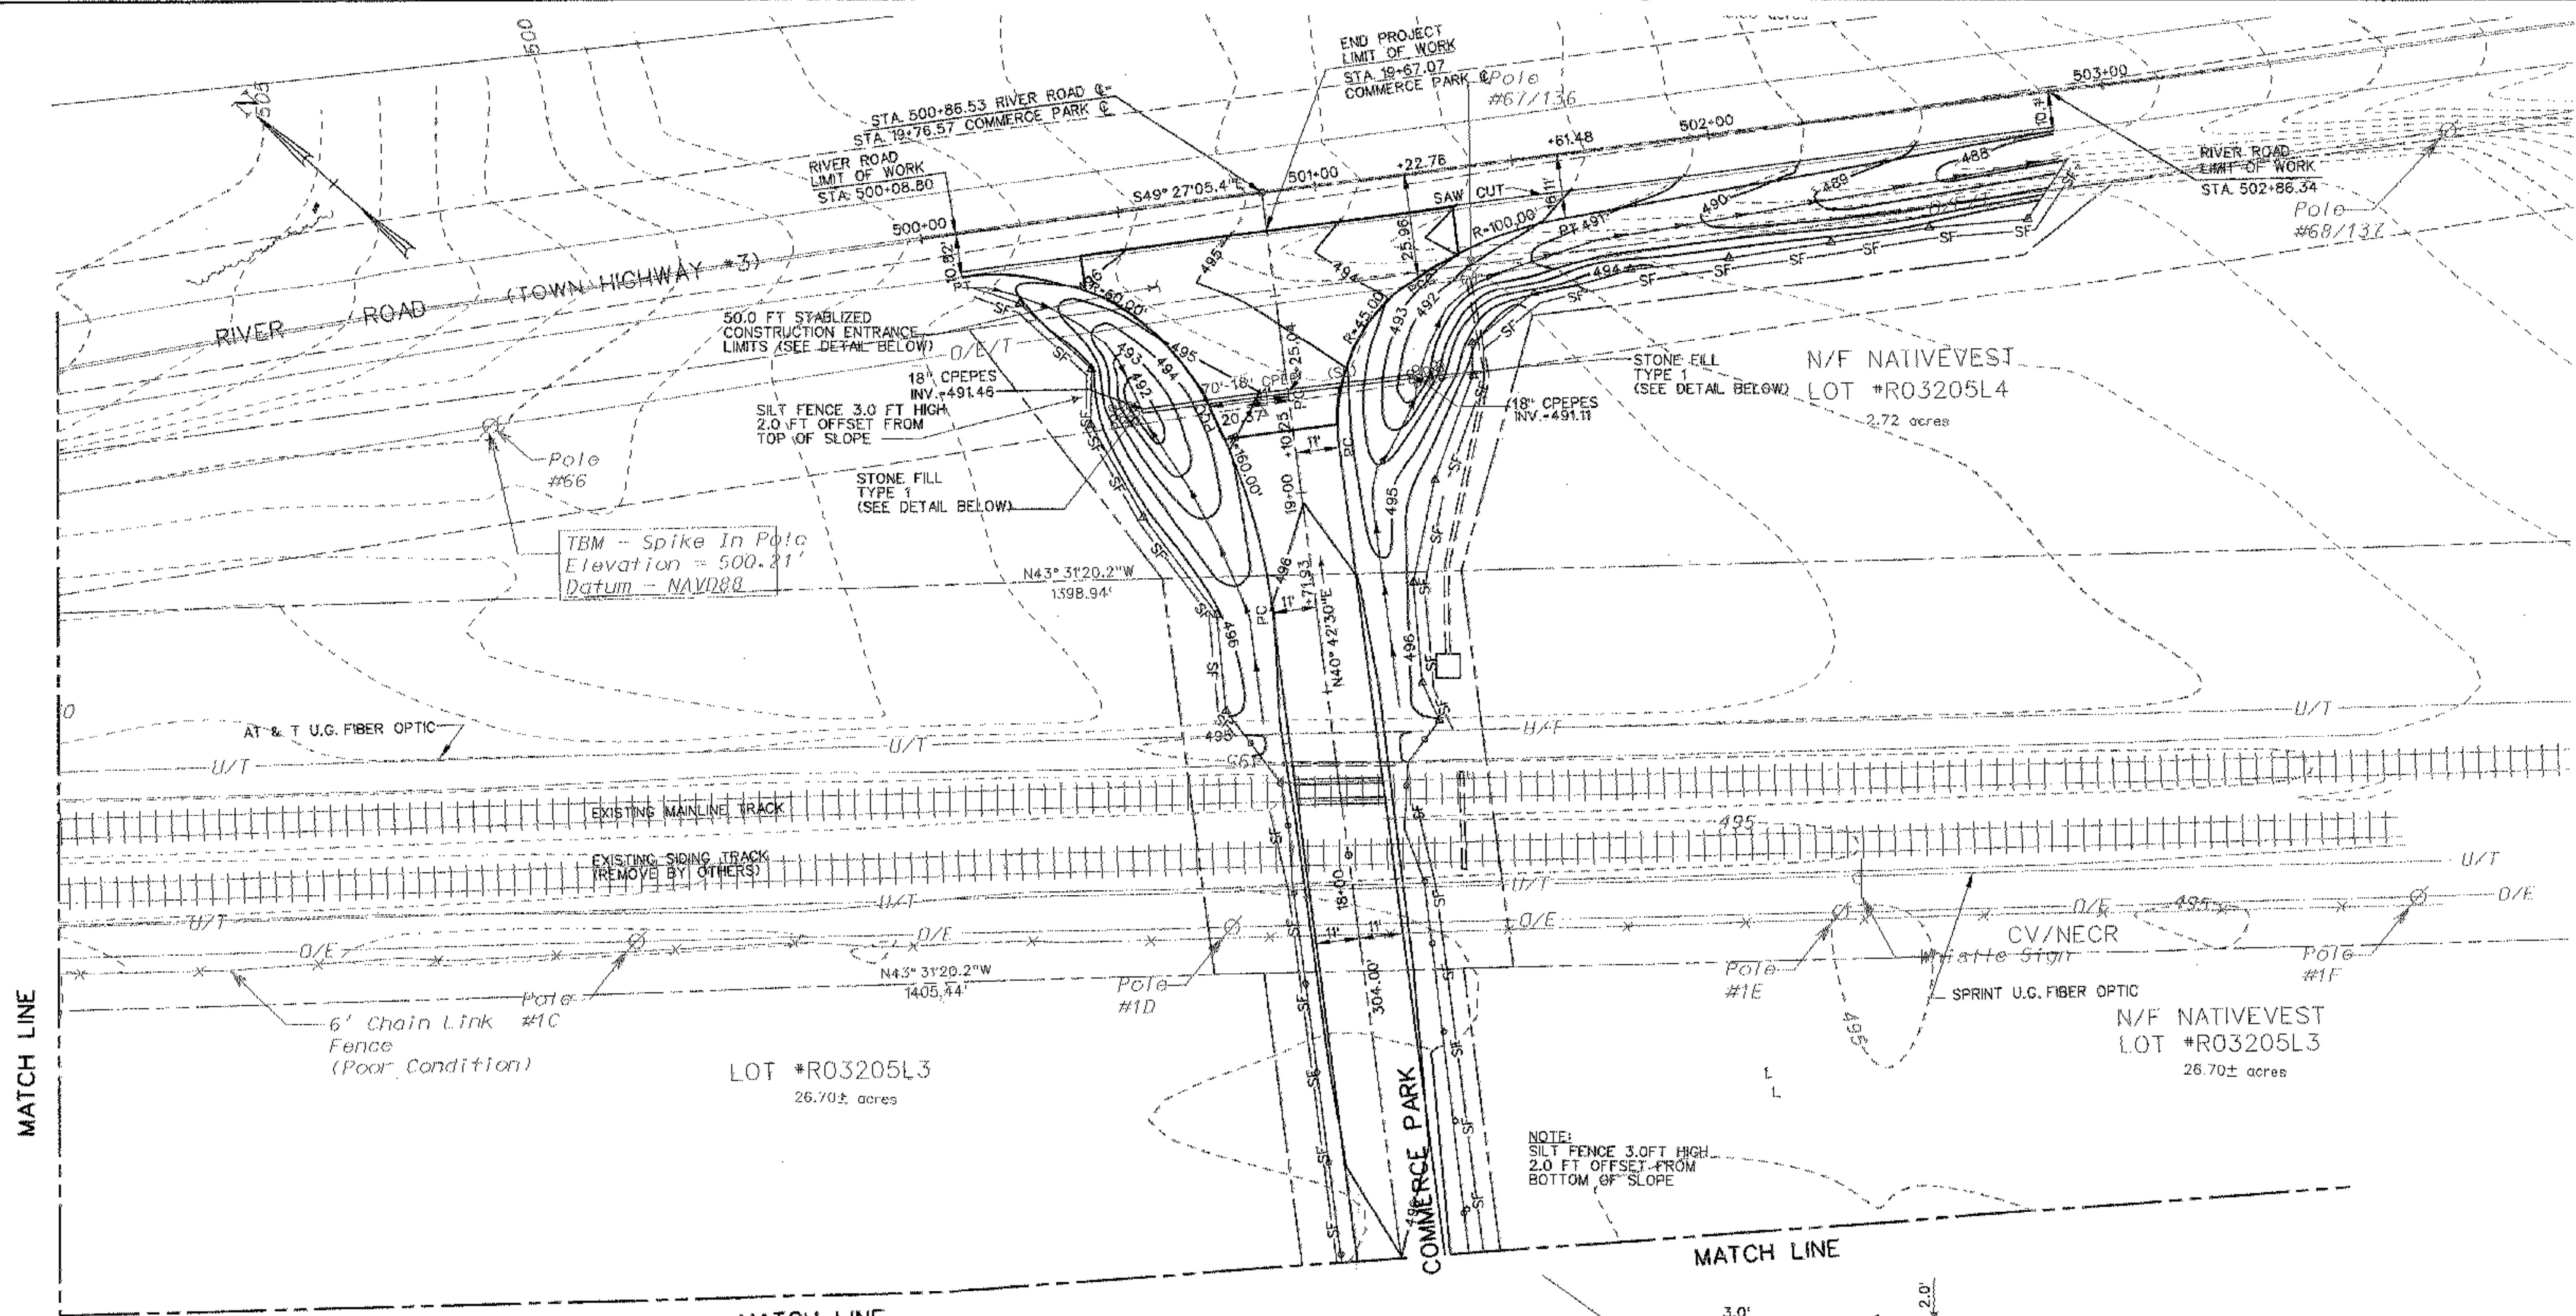


STABILIZED CONSTRUCTION ENTRANCE

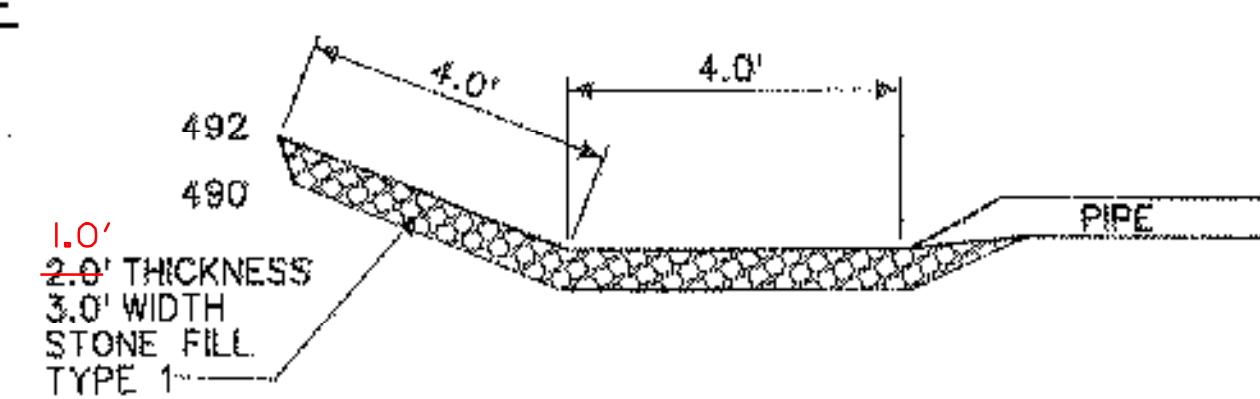

INLET DETAIL
STA. 19+25 LEFT

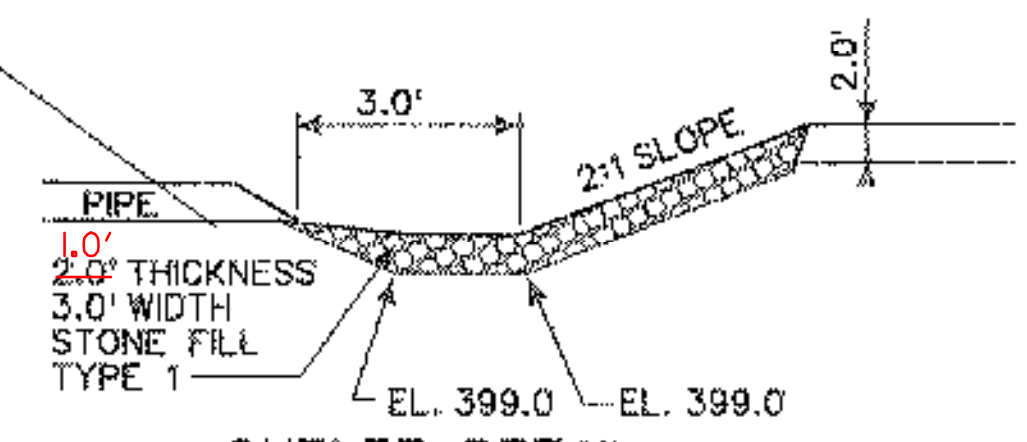

OUTLET DETAIL
STA. 19+25 RIGHT

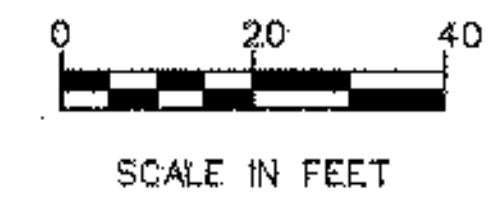

SCALE IN FEET




**EROSION & SEDIMENT CONTROL PLAN
SHEET 2 OF 3**

PROJECT NAME:	SHARON GRADE CROSSING	
PROJECT NUMBER:	STP2034 (13)S	
FILE NAME:	SH13.DGN	PLOT DATE: 06/13/03
PROJECT LEADER:	R. O'BLENIS	DRAWN BY: J. DEROSIER
DESIGNED BY:	C. GLOVER	CHECKED BY: R. ORO
		SHEET 13 OF 35

DATUM	
VERTICAL	NAVD88 ± 0.5 FT.
HORIZONTAL	SPC 1983

ORIGINAL PREPARED:		
DATE	REVISIONS	BY

09:05:14 AM C:\P\13\13-1\roll\sharon\sharon_crossing.dgn

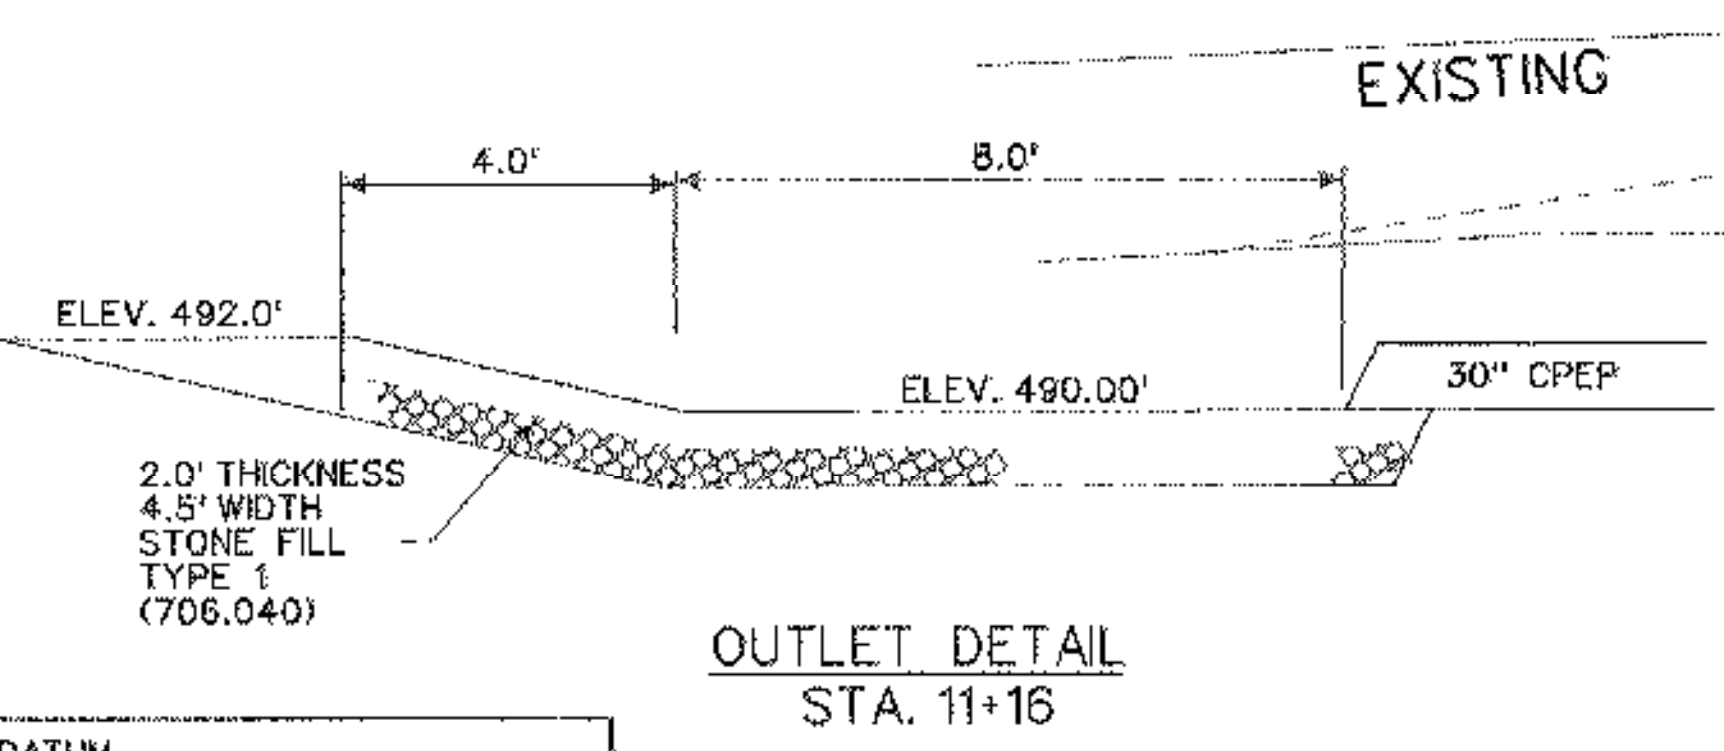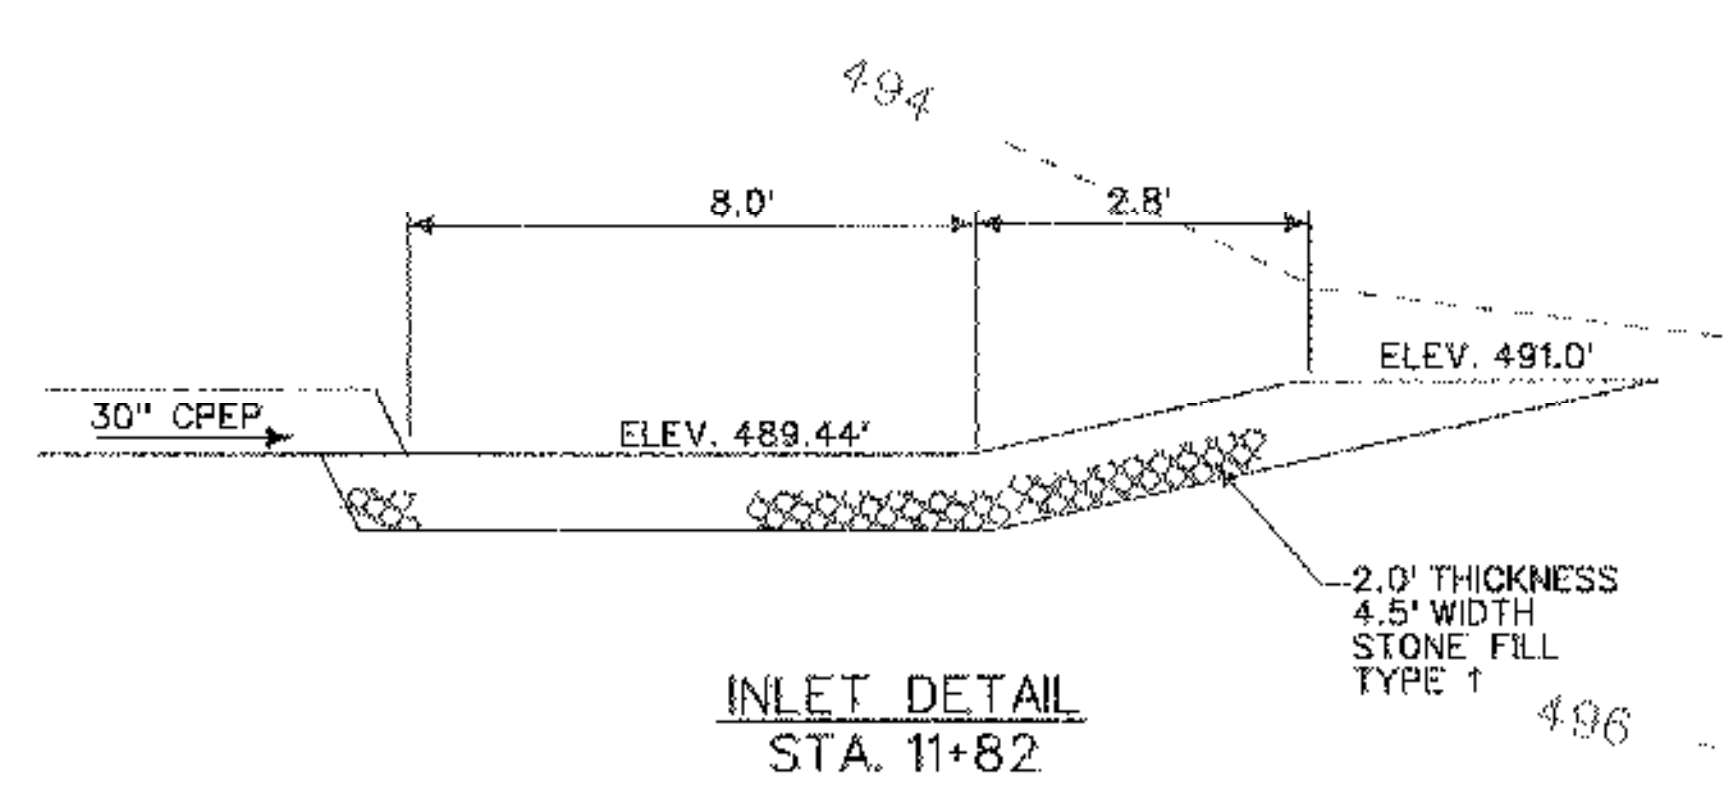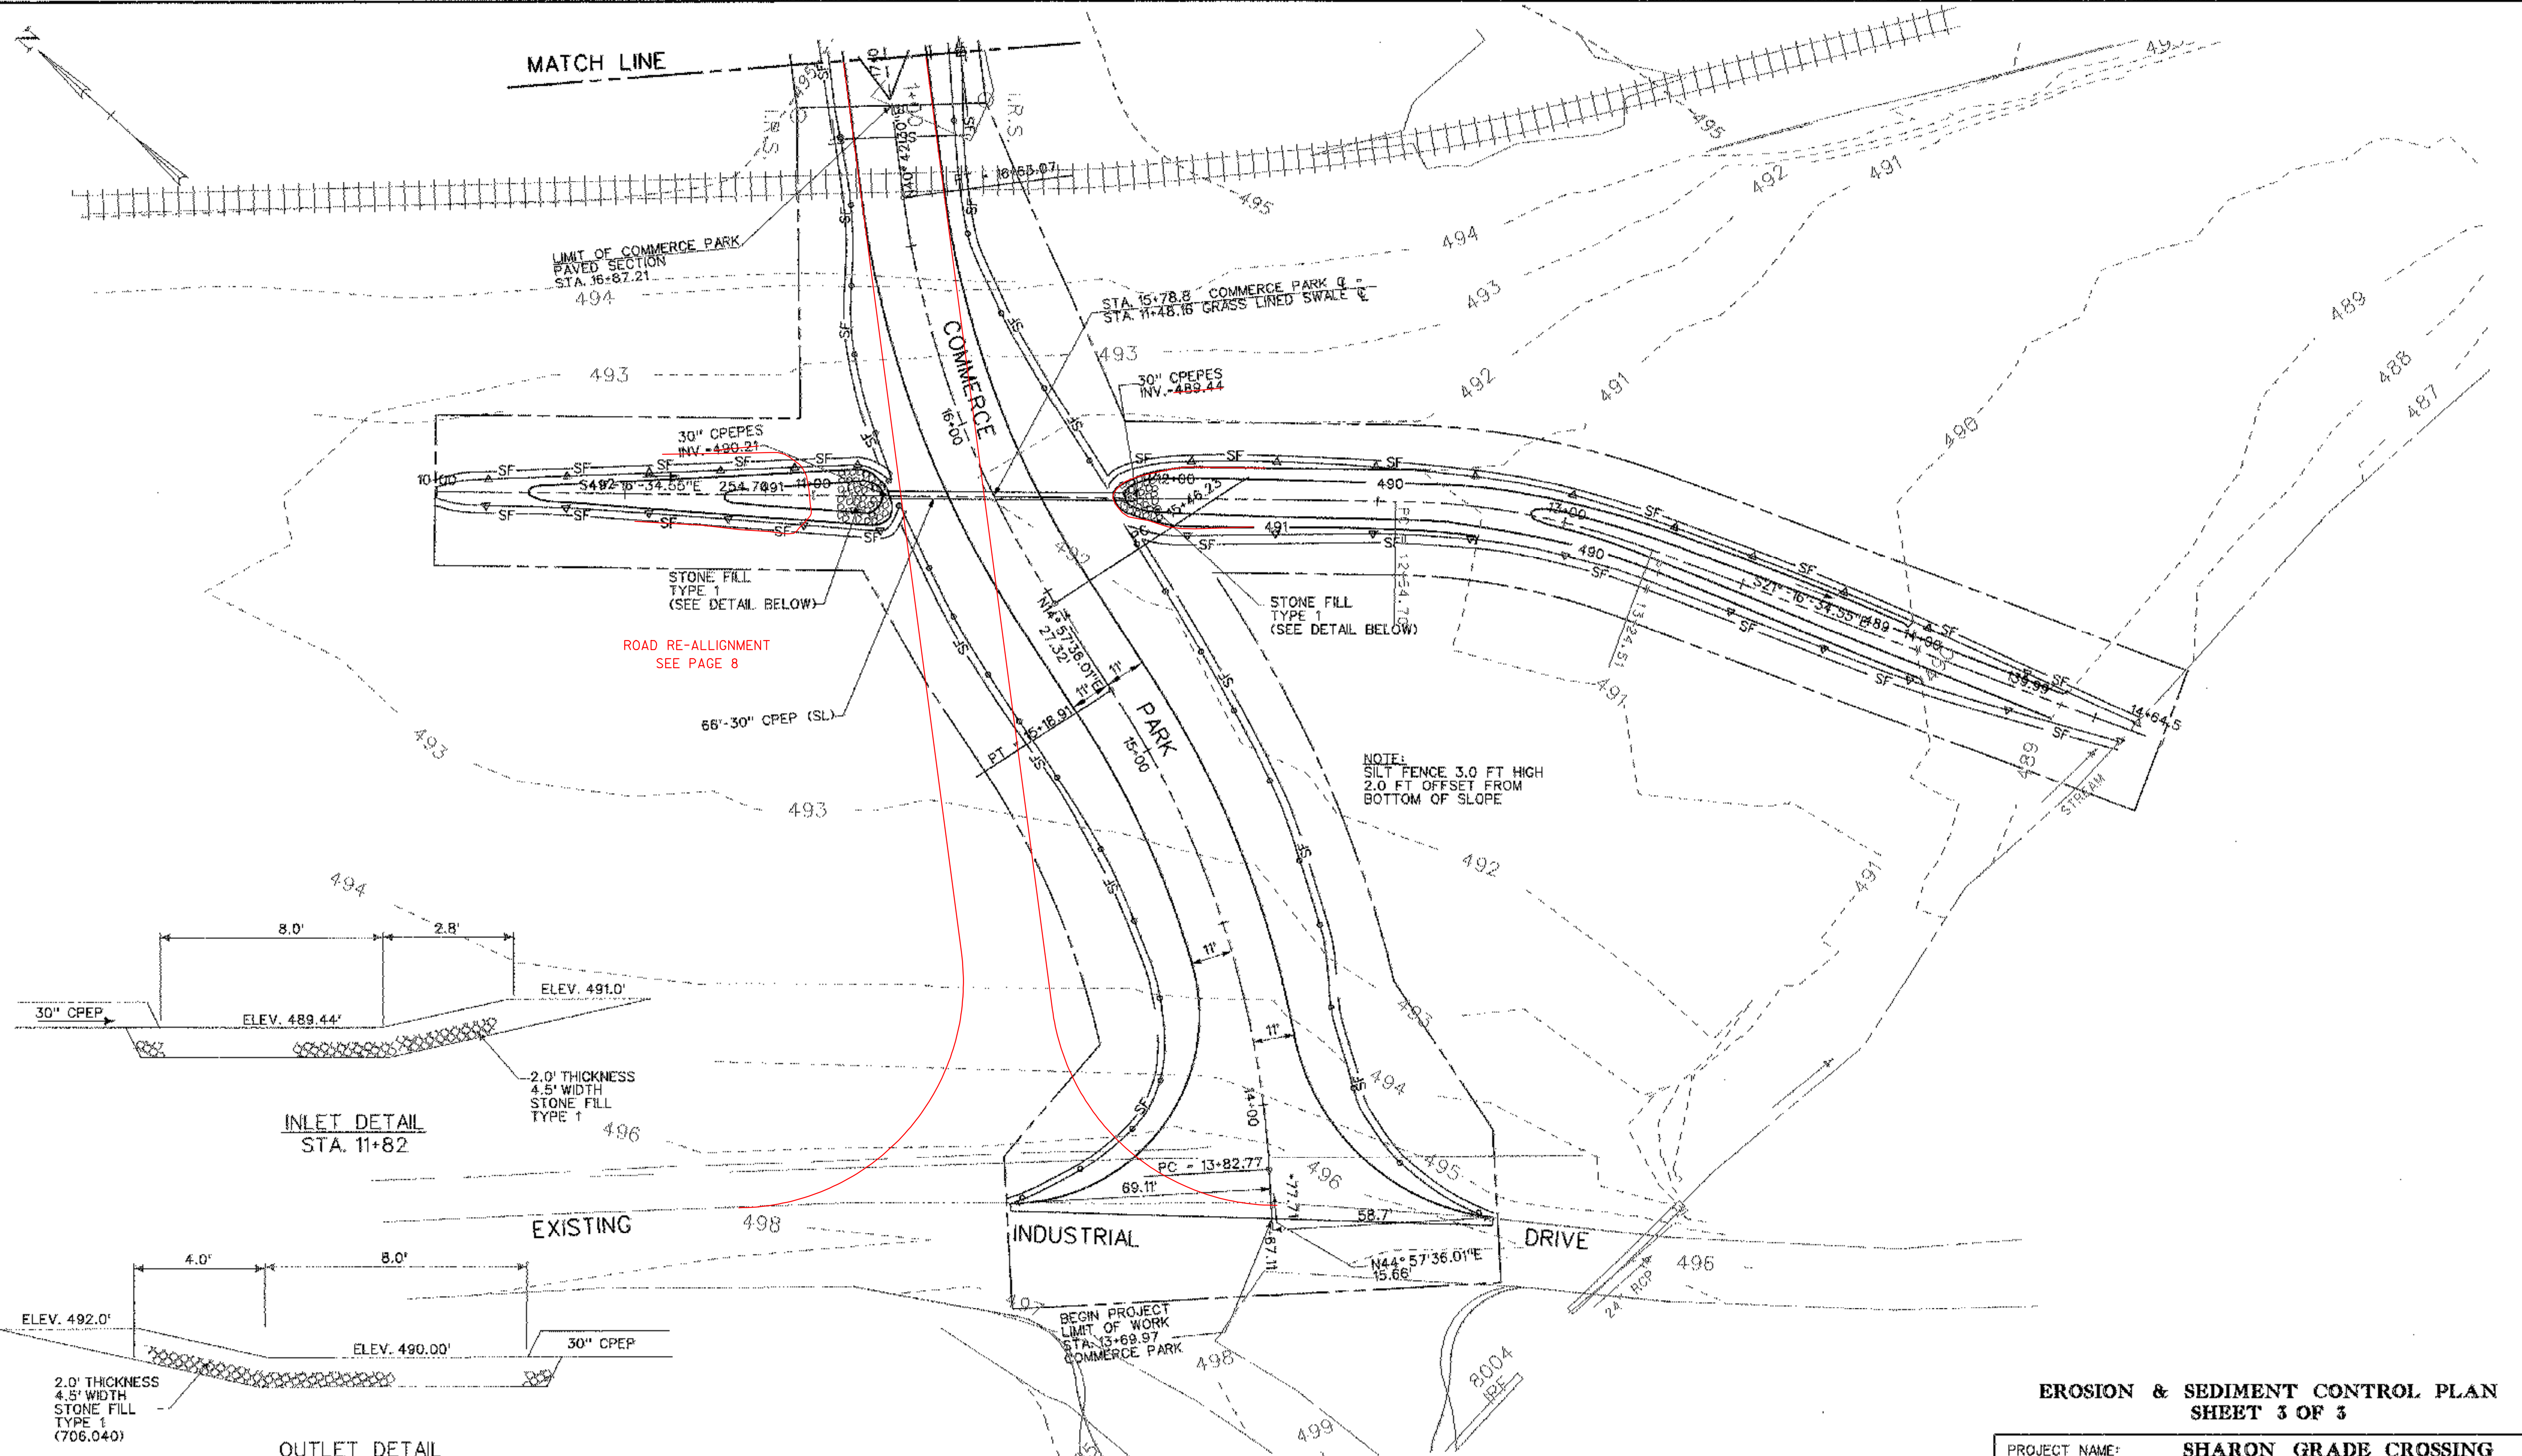

DATUM


VERTICAL	NAVD88 ± 0.5 FT.
HORIZONTAL	SPC 1983

ORIGINAL PREPARED:		
DATE	REVISIONS	BY



EROSION & SEDIMENT CONTROL PLAN
SHEET 3 OF 3

PROJECT NAME:	SHARON GRADE CROSSING	
PROJECT NUMBER:	STP2034 (13)S	
FILE NAME:	SHT14.DGN	PLOT DATE: 06/13/03
PROJECT LEADER:	R. O'BLENIS	DRAWN BY: J. DEROSIER
DESIGNED BY:	C. GLOVER	CHECKED BY: R. ORO
		SHEET 14 OF 35

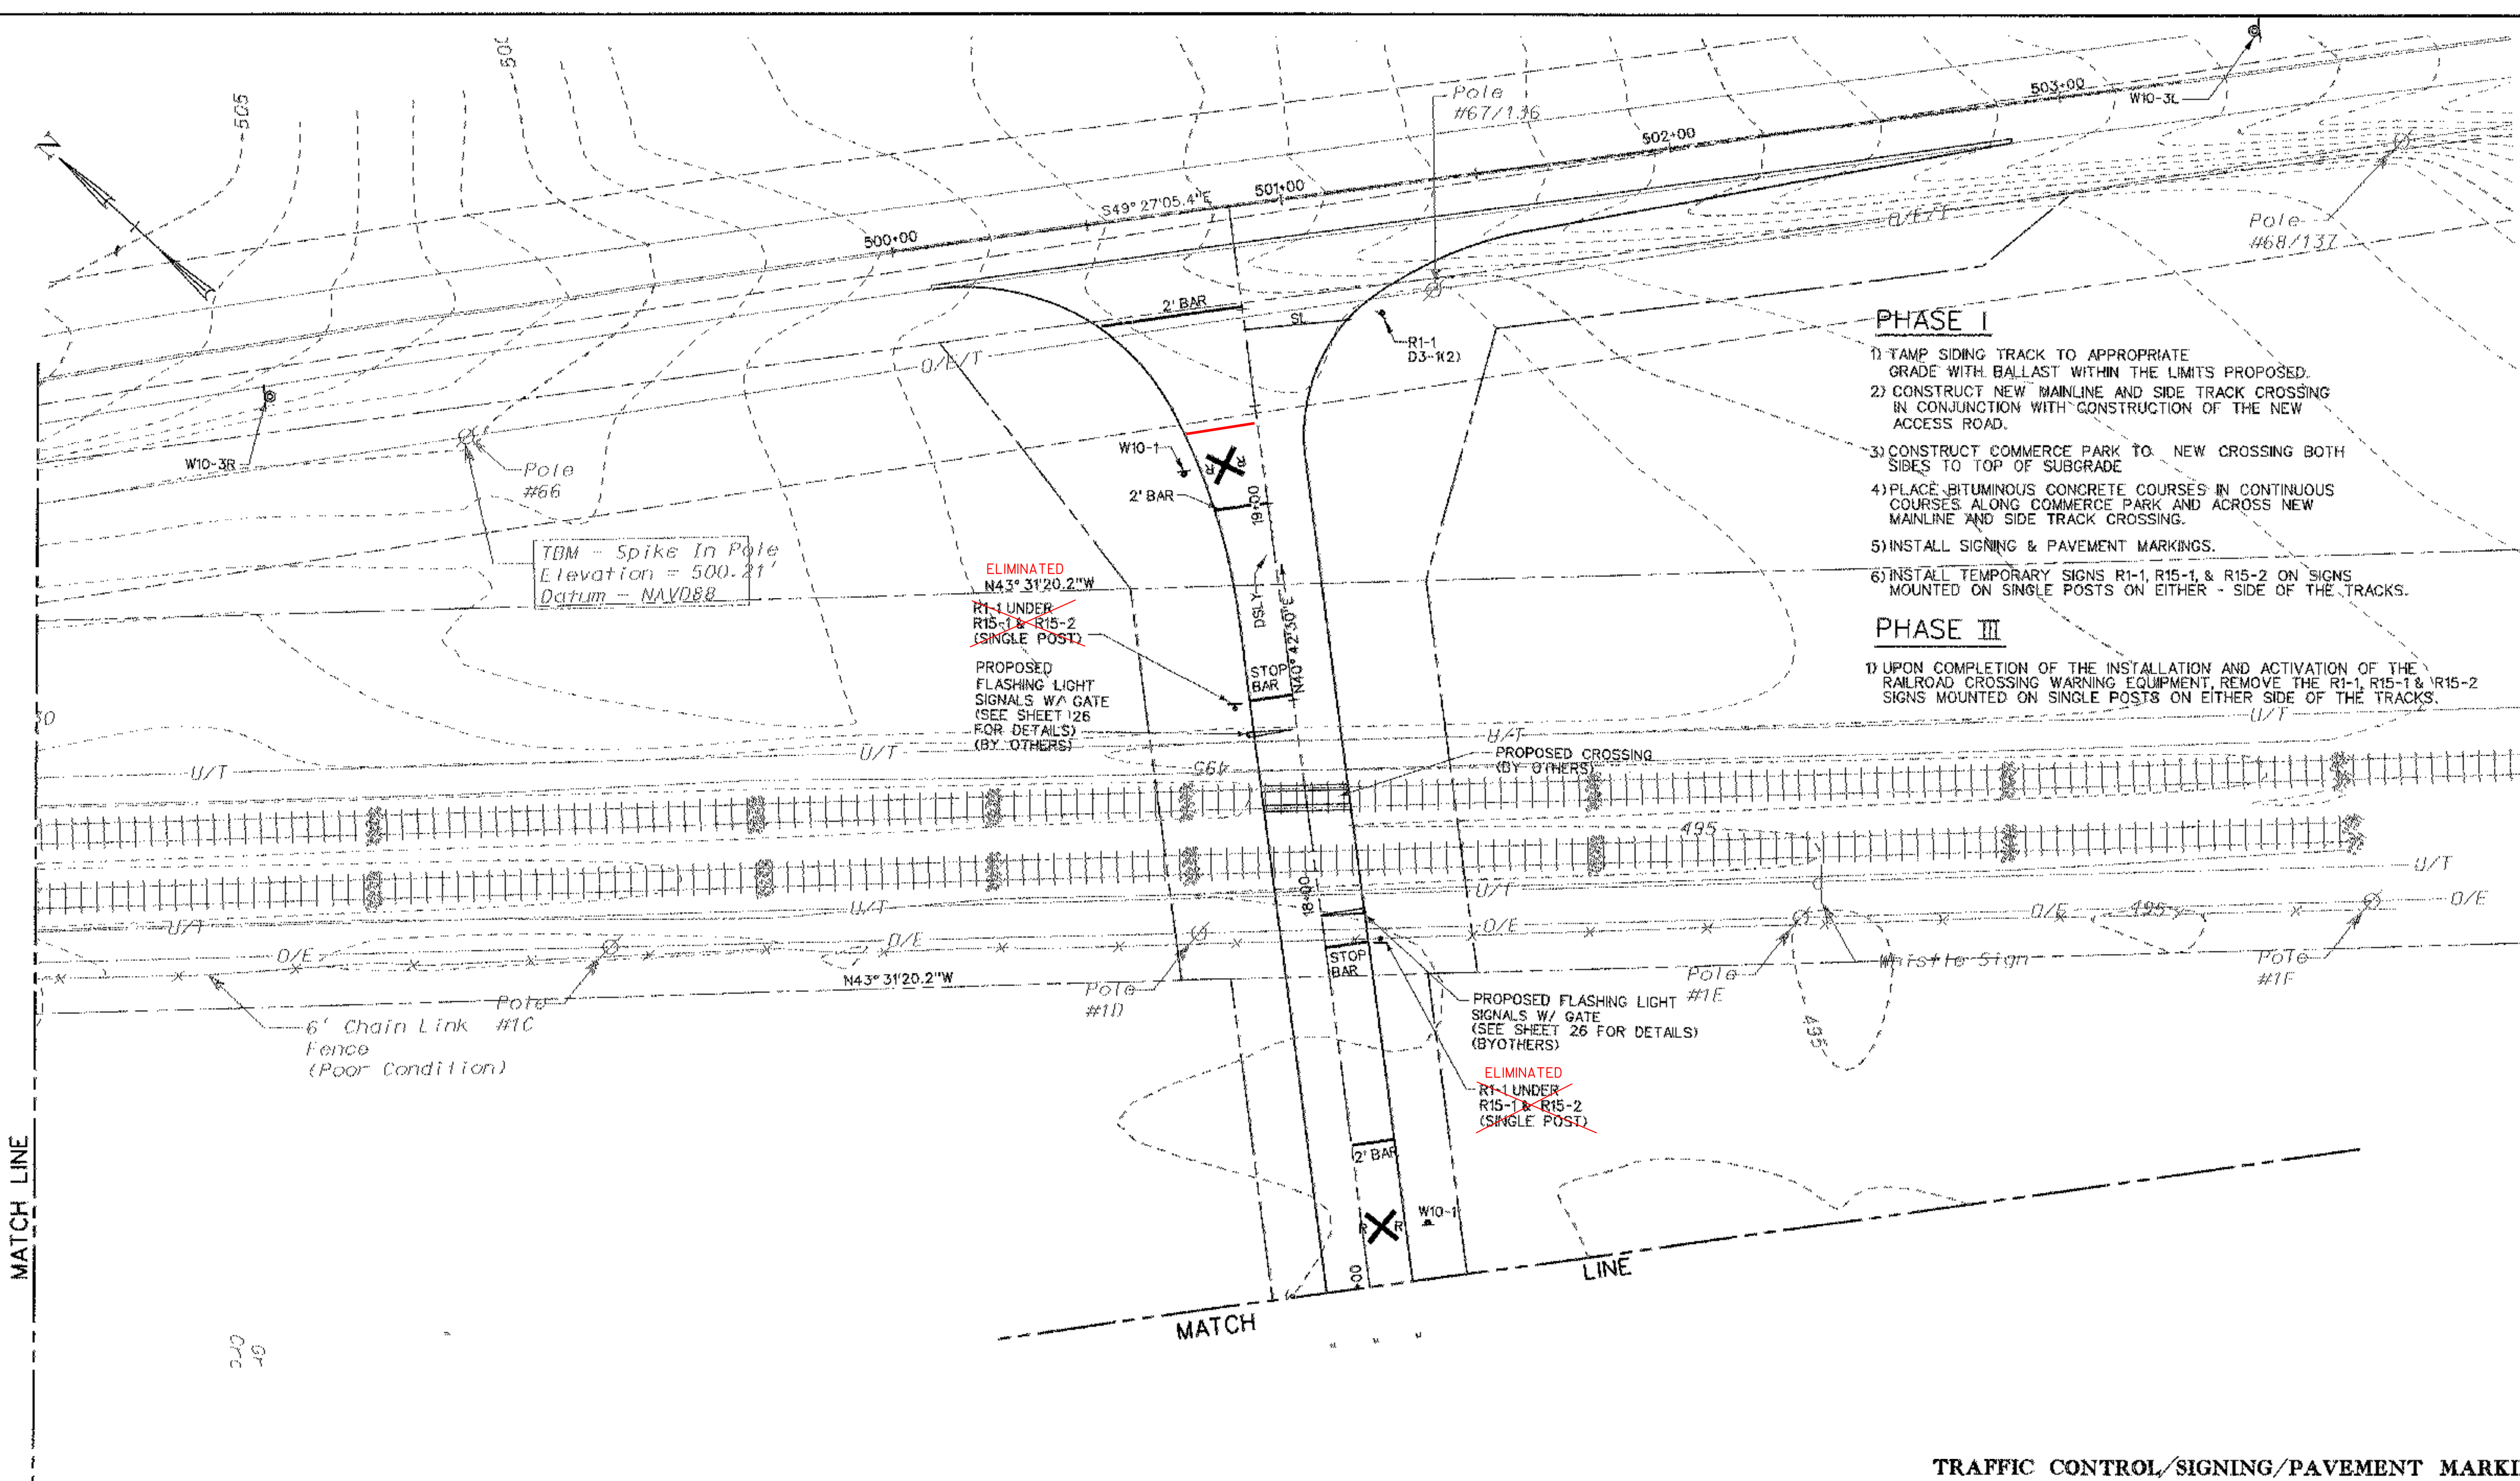

PHASE I

- 1) TAMP SIDING TRACK TO APPROPRIATE GRADE WITH BALLAST WITHIN THE LIMITS PROPOSED.
- 2) CONSTRUCT NEW MAINLINE AND SIDE TRACK CROSSING IN CONJUNCTION WITH CONSTRUCTION OF THE NEW ACCESS ROAD.
- 3) CONSTRUCT COMMERCE PARK TO NEW CROSSING BOTH SIDES TO TOP OF SUBGRADE
- 4) PLACE BITUMINOUS CONCRETE COURSES IN CONTINUOUS COURSES ALONG COMMERCE PARK AND ACROSS NEW MAINLINE AND SIDE TRACK CROSSING.
- 5) INSTALL SIGNING & PAVEMENT MARKINGS.
- 6) INSTALL TEMPORARY SIGNS R1-1, R15-1, & R15-2 ON SIGNS MOUNTED ON SINGLE POSTS ON EITHER SIDE OF THE TRACKS.

PHASE III

- 1) UPON COMPLETION OF THE INSTALLATION AND ACTIVATION OF THE RAILROAD CROSSING WARNING EQUIPMENT, REMOVE THE R1-1, R15-1 & R15-2 SIGNS MOUNTED ON SINGLE POSTS ON EITHER SIDE OF THE TRACKS.

DATUM

VERTICAL	NAVD88 ± 0.5 FT.
HORIZONTAL	SPC 1983


ORIGINAL PREPARED:		
DATE	REVISIONS	BY



TRAFFIC CONTROL/SIGNING/PAVEMENT MARKINGS
SHEET 1 OF 3

PROJECT NAME: SHARON GRADE CROSSING	
PROJECT NUMBER: STP2034 (13)S	
FILE NAME: SHT16.DGN	PLOT DATE: 06/13/03
PROJECT LEADER: R. O'BLENIS	DRAWN BY: J. DEROSIER
DESIGNED BY: C. GLOVER	CHECKED BY: R. ORO
SHEET 15 OF 35	

06/13/03 AM
 M:\187377-rt-rail\sharon\CROSSING\dgn\sh15.dgn

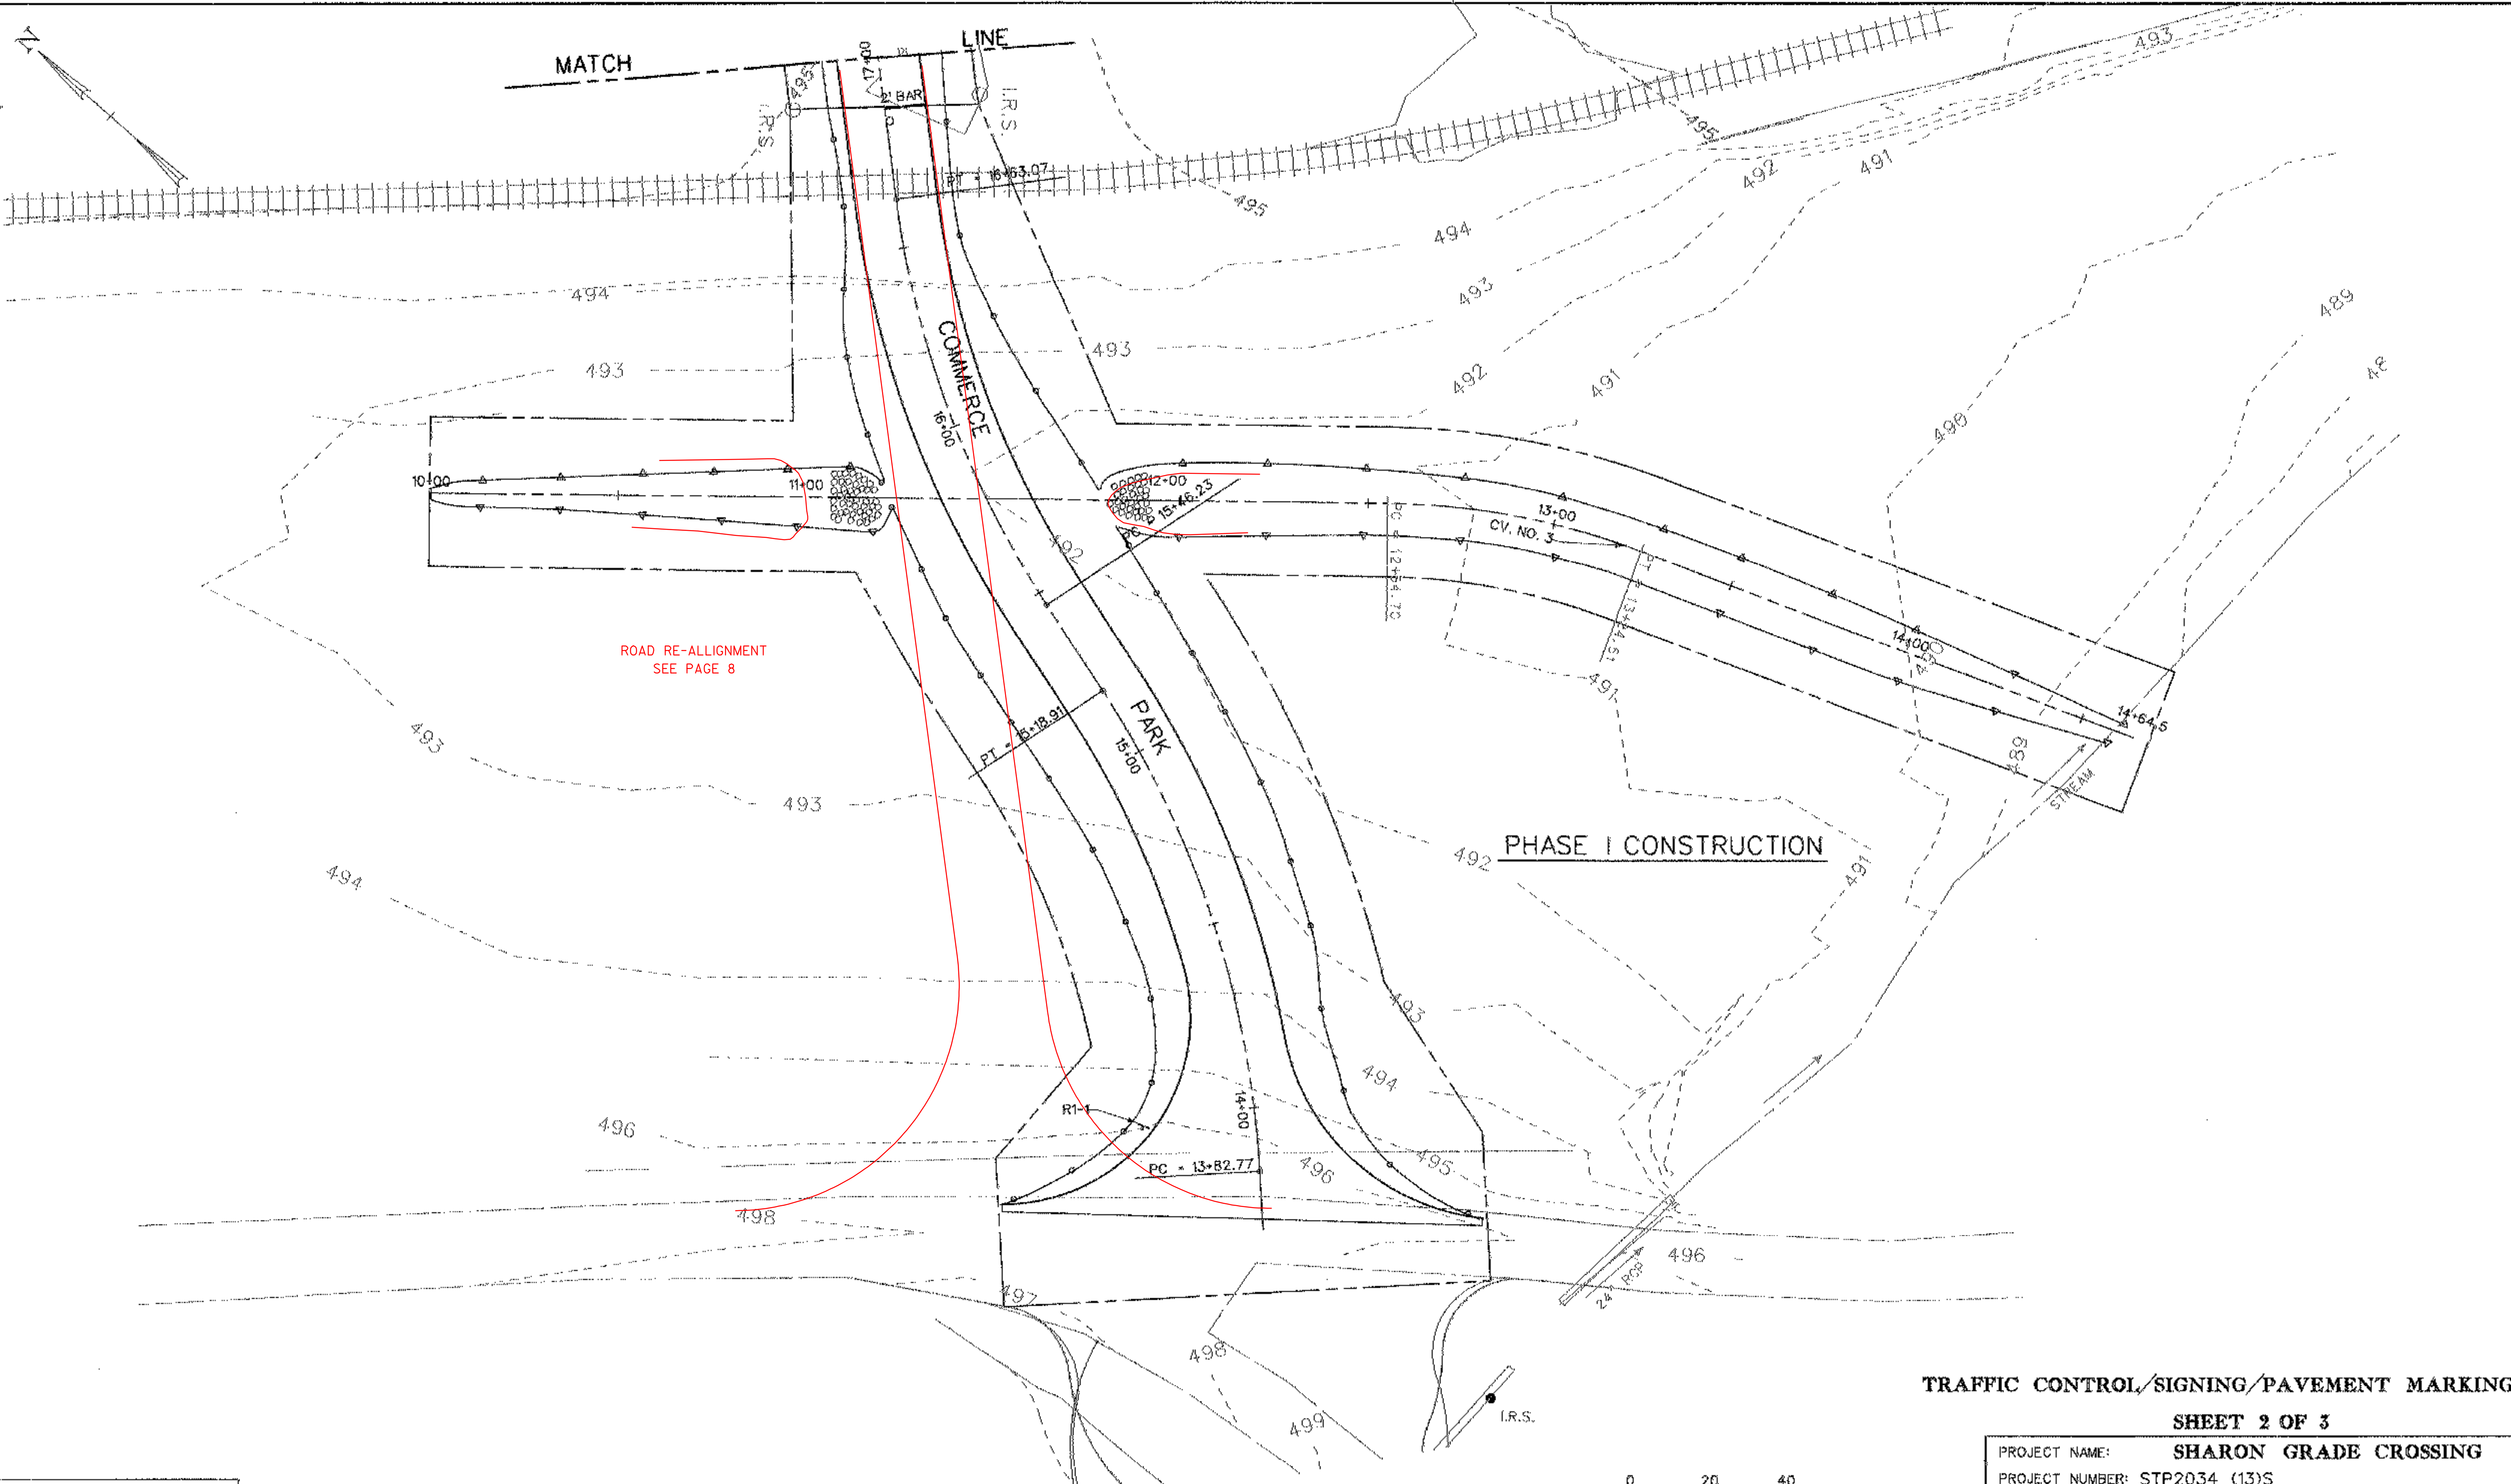

ROAD RE-ALIGNMENT
SEE PAGE 8

PHASE I CONSTRUCTION

TRAFFIC CONTROL/SIGNING/PAVEMENT MARKINGS

SHEET 2 OF 3

DATUM
VERTICAL NAVD88 ± 0.5 FT.
HORIZONTAL SPC 1083

ORIGINAL PREPARED:		
DATE	REVISIONS	BY



PROJECT NAME:	SHARON GRADE CROSSING	
PROJECT NUMBER:	STP2034 (13)S	
FILE NAME:	SHT17.DGN	PLOT DATE: 06/13/03
PROJECT LEADER:	R. O'BLENS	DRAWN BY: J. DEROSIER
DESIGNED BY:	C. GLOVER	CHECKED BY: R. ORO
		SHEET 16 OF 35

U:\10700\10700.dwg - c:\winnt\sharon_crossing\vert16.dwg

TRAFFIC SIGN SUMMARY SHEET


MILEMARKER, STATION, OR SIGN NUMBER	SIGN LEGEND	SIGN DIMENSIONS		NEW & SALVAGED SIGNS				EXISTING POST RETAIN	NO. OF POSTS	NEW SIGN POSTS					ANCHOR	S.F. FEET	REMARKS	SIGN DETAIL											
		EA	WIDTH (in)	HEIGHT (in)	"A"	"B"	SALV SIGN			SALV TIS	FLANGED CHANNEL		SQUARE STEEL (in)					TUBULAR ALUMINUM Ø (in)			TUBULAR STEEL Ø (in)				W-SHAPE STEEL	POST SIZE	DETAIL ON SHEET NUMBER	STD. SHEET NUMBER	
											1.75	2.0	2.5	3.0				4.0	4.0 MOD	3.0	3.5	4.0	5.0	FTG. SIZE					WEIGHT
R1-1		2	30	30	12.50				2		12.67															AS SHOWN ON SHEET NOS. 15 & 16	F-14.3		
W10-1		2	36	36	9.00				2		13.25															AS SHOWN ON SHEET NO. 15	E-190		
W10-3R		1	36	36	9.00				2		14.75															IN ACCORDANCE W/ MUTED 2001 LOCATED ON RIVER RD., 250' RT. NORTH OF COMMERCE PARK, C.	C-154		
W10-3L		1	36	36	9.00				2		14.75															IN ACCORDANCE W/ MUTED 2001 LOCATED ON RIVER ROAD STA. 50.5+50, L.	L-154		
D3-1	COMMERCE PARK	2	42	8	4.69						10.83															IN ACCORDANCE W/ MUTED 2001 BACK TO BACK MOUNTED ABOVE R1-1 COMMERCE PARK STA. 19+35, RT.	F-131		
R15-1		2			6.00																					AS SHOWN ON SHEET NO. 16 IN ACCORDANCE W/ MUTED 2001	E-190		
R15-2		2	27	18	4.50																					AS SHOWN ON SHEET NO. 16 IN ACCORDANCE W/ MUTED 2001	E-190		

FINAL POST LENGTHS ARE TO BE DETERMINED IN THE FIELD. POST SIZES ARE COMPUTED BASED ON INFORMATION FURNISHED ON THE STANDARD SHEETS AND THE TRAFFIC & SAFETY DIVISION'S "SIGN POST DESIGN GUIDELINE."

TOTALS	SF	SF	EA	SF	FT	FT	EA	LB	EA	LB	EA	LB	EA	LB
	72.33				66.15									


PROJECT NAME: SHARON GRADE CROSSING
 PROJECT NUMBER: SIP20.54 (13)S
 FILE NAME: SH18.DGN
 PROJECT LEADER: R. O'LENS
 DESIGNED BY: C. GLOVER
 PLOT DATE: 01/14/03
 DRAWN BY: D. LOCKS
 CHECKED BY: R. ORO
 SHEET 18 OF 35

06/13/03 06:13:03 AM
 M:\18737.s_vt_rail_xing\SHARON_CROSSING.dgn\SHT19.dgn

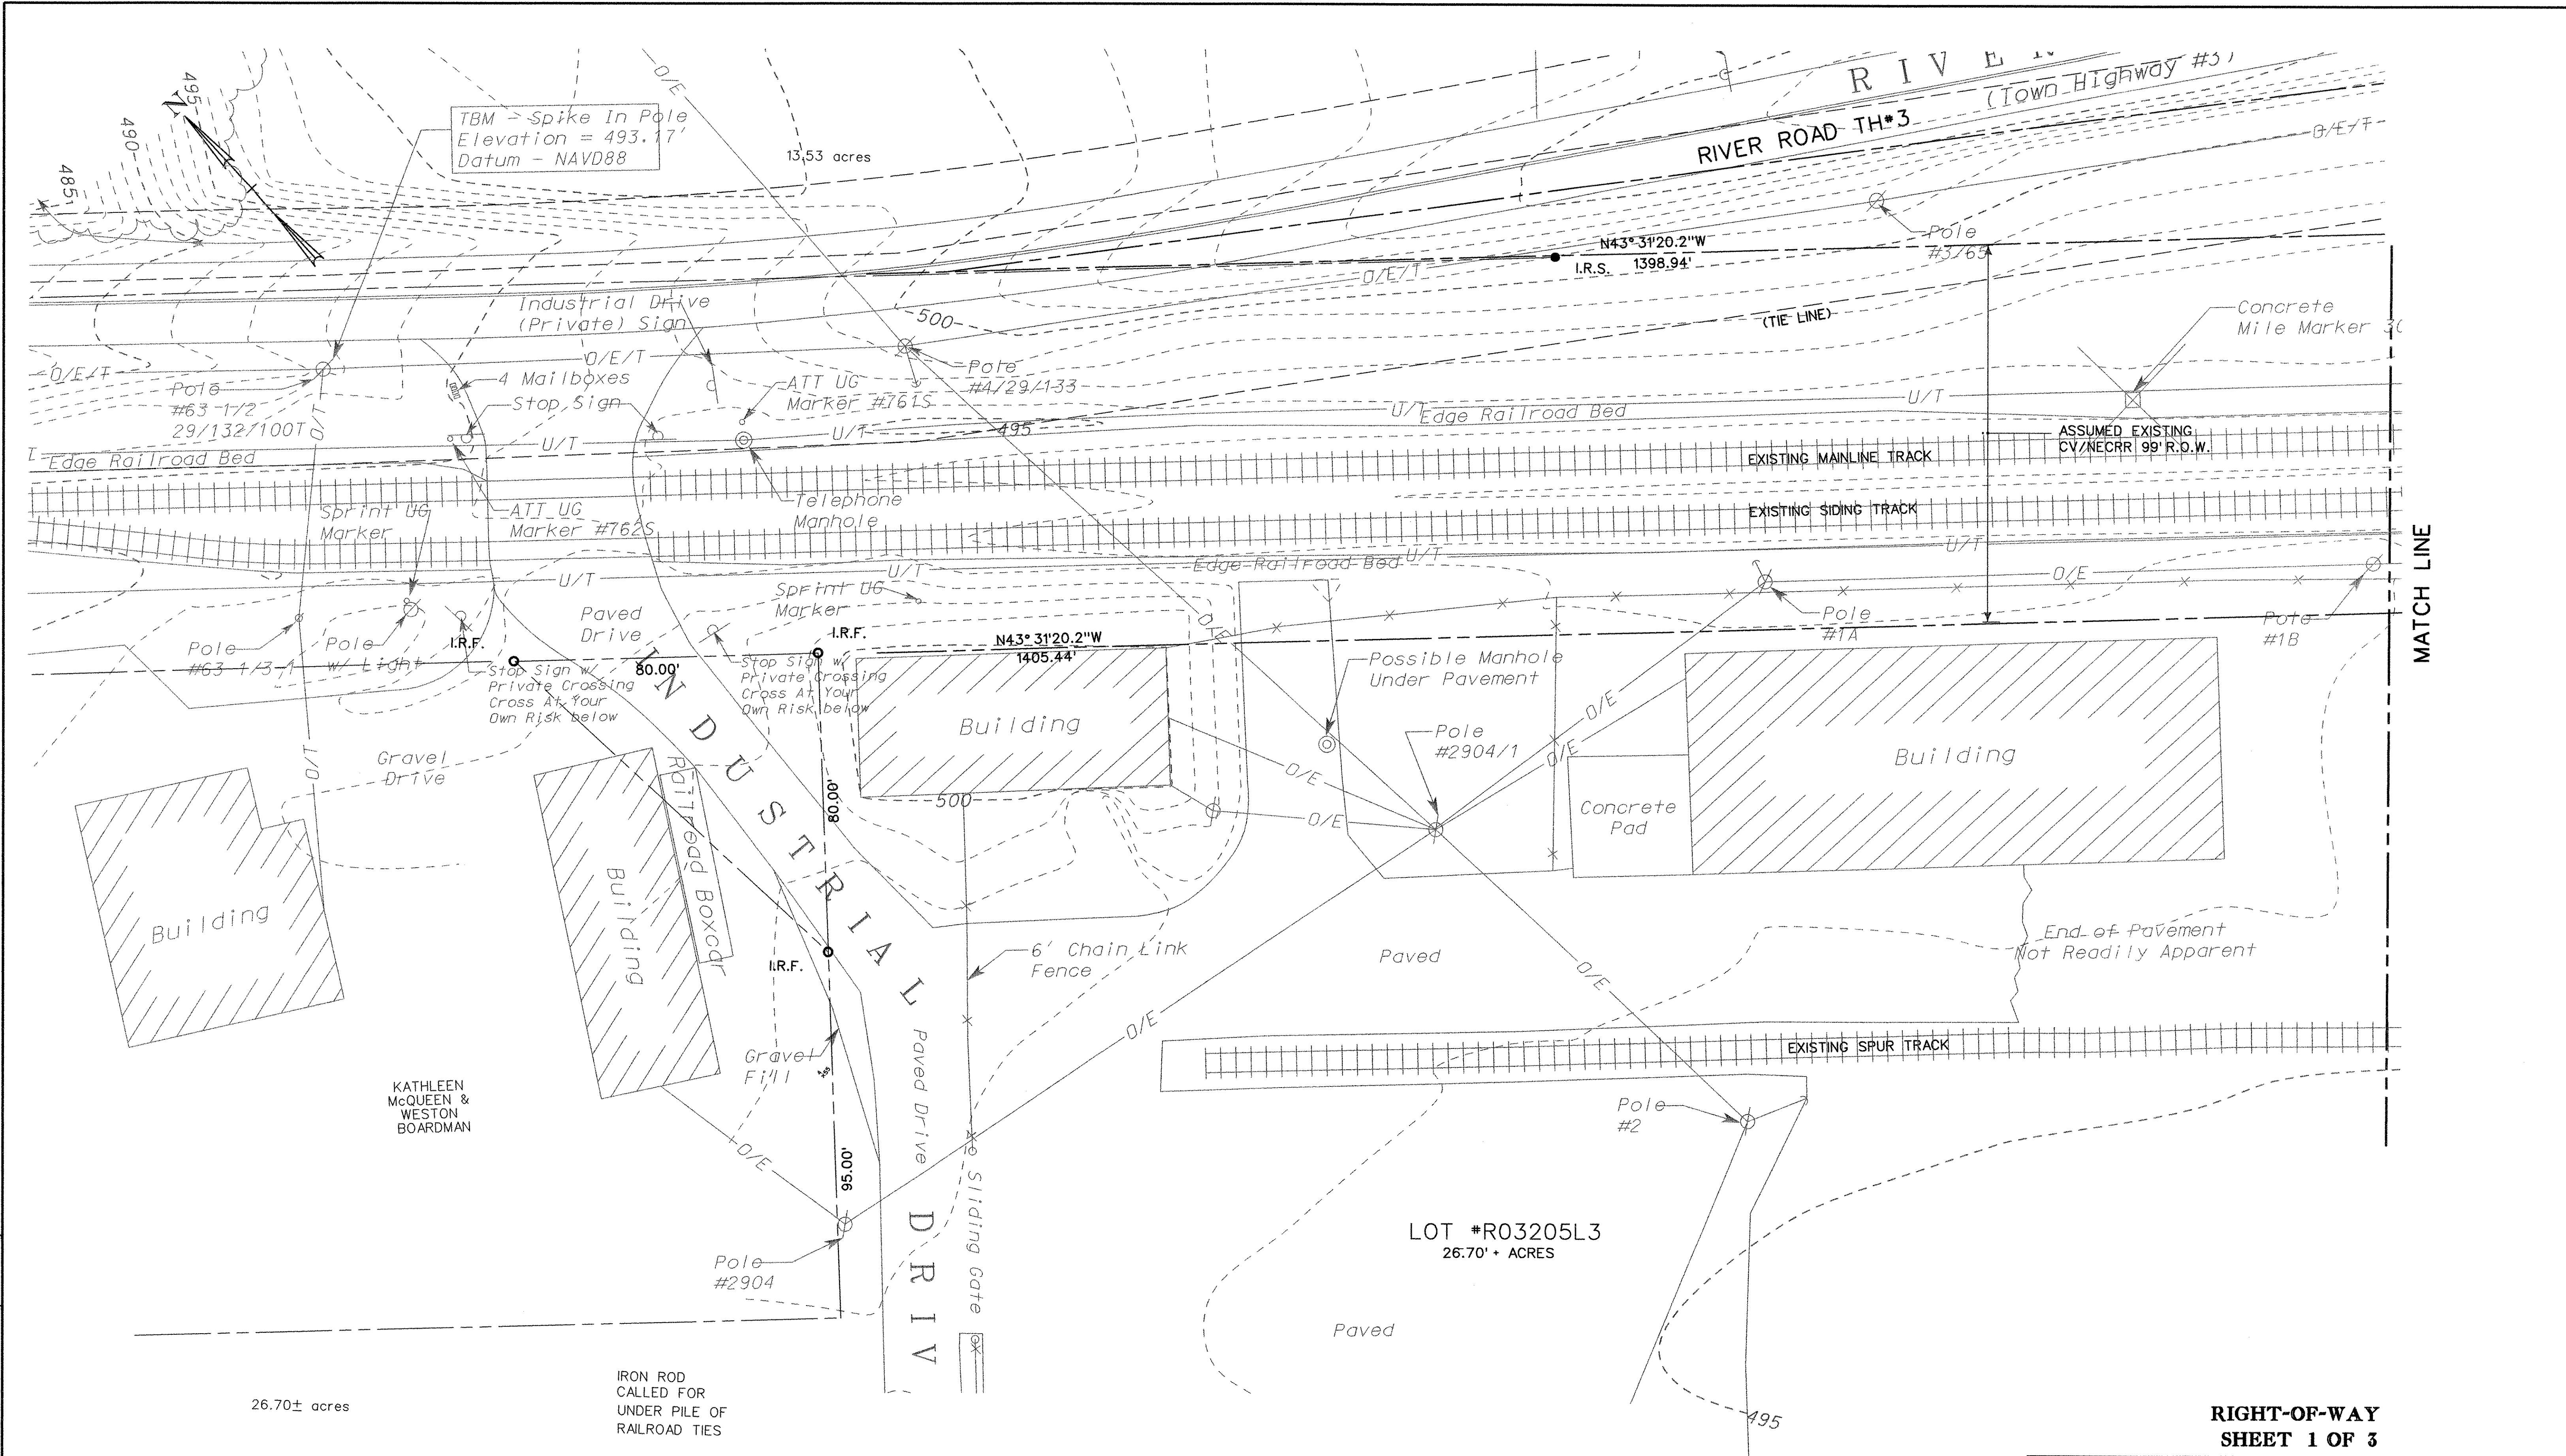

DATUM	
VERTICAL	NAVD88 ± 0.5 FT.
HORIZONTAL	SPC 1983

ORIGINAL PREPARED:		
DATE	REVISIONS	BY

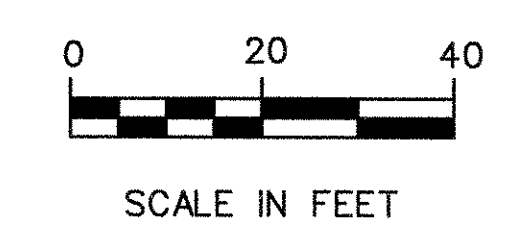

**RIGHT-OF-WAY
SHEET 1 OF 3**


PROJECT NAME:	SHARON GRADE CROSSING	
PROJECT NUMBER:	STP2034 (13)S	
FILE NAME:	SHT19.DGN	PLOT DATE: 06/13/03
PROJECT LEADER:	R. O'BLENIS	DRAWN BY: J. DEROSIER
DESIGNED BY:	C. GLOVER	CHECKED BY: R. ORO
		SHEET 19 OF 35

26.70± acres

IRON ROD CALLED FOR UNDER PILE OF RAILROAD TIES

LOT #R03205L3
26.70± ACRES

MATCH LINE

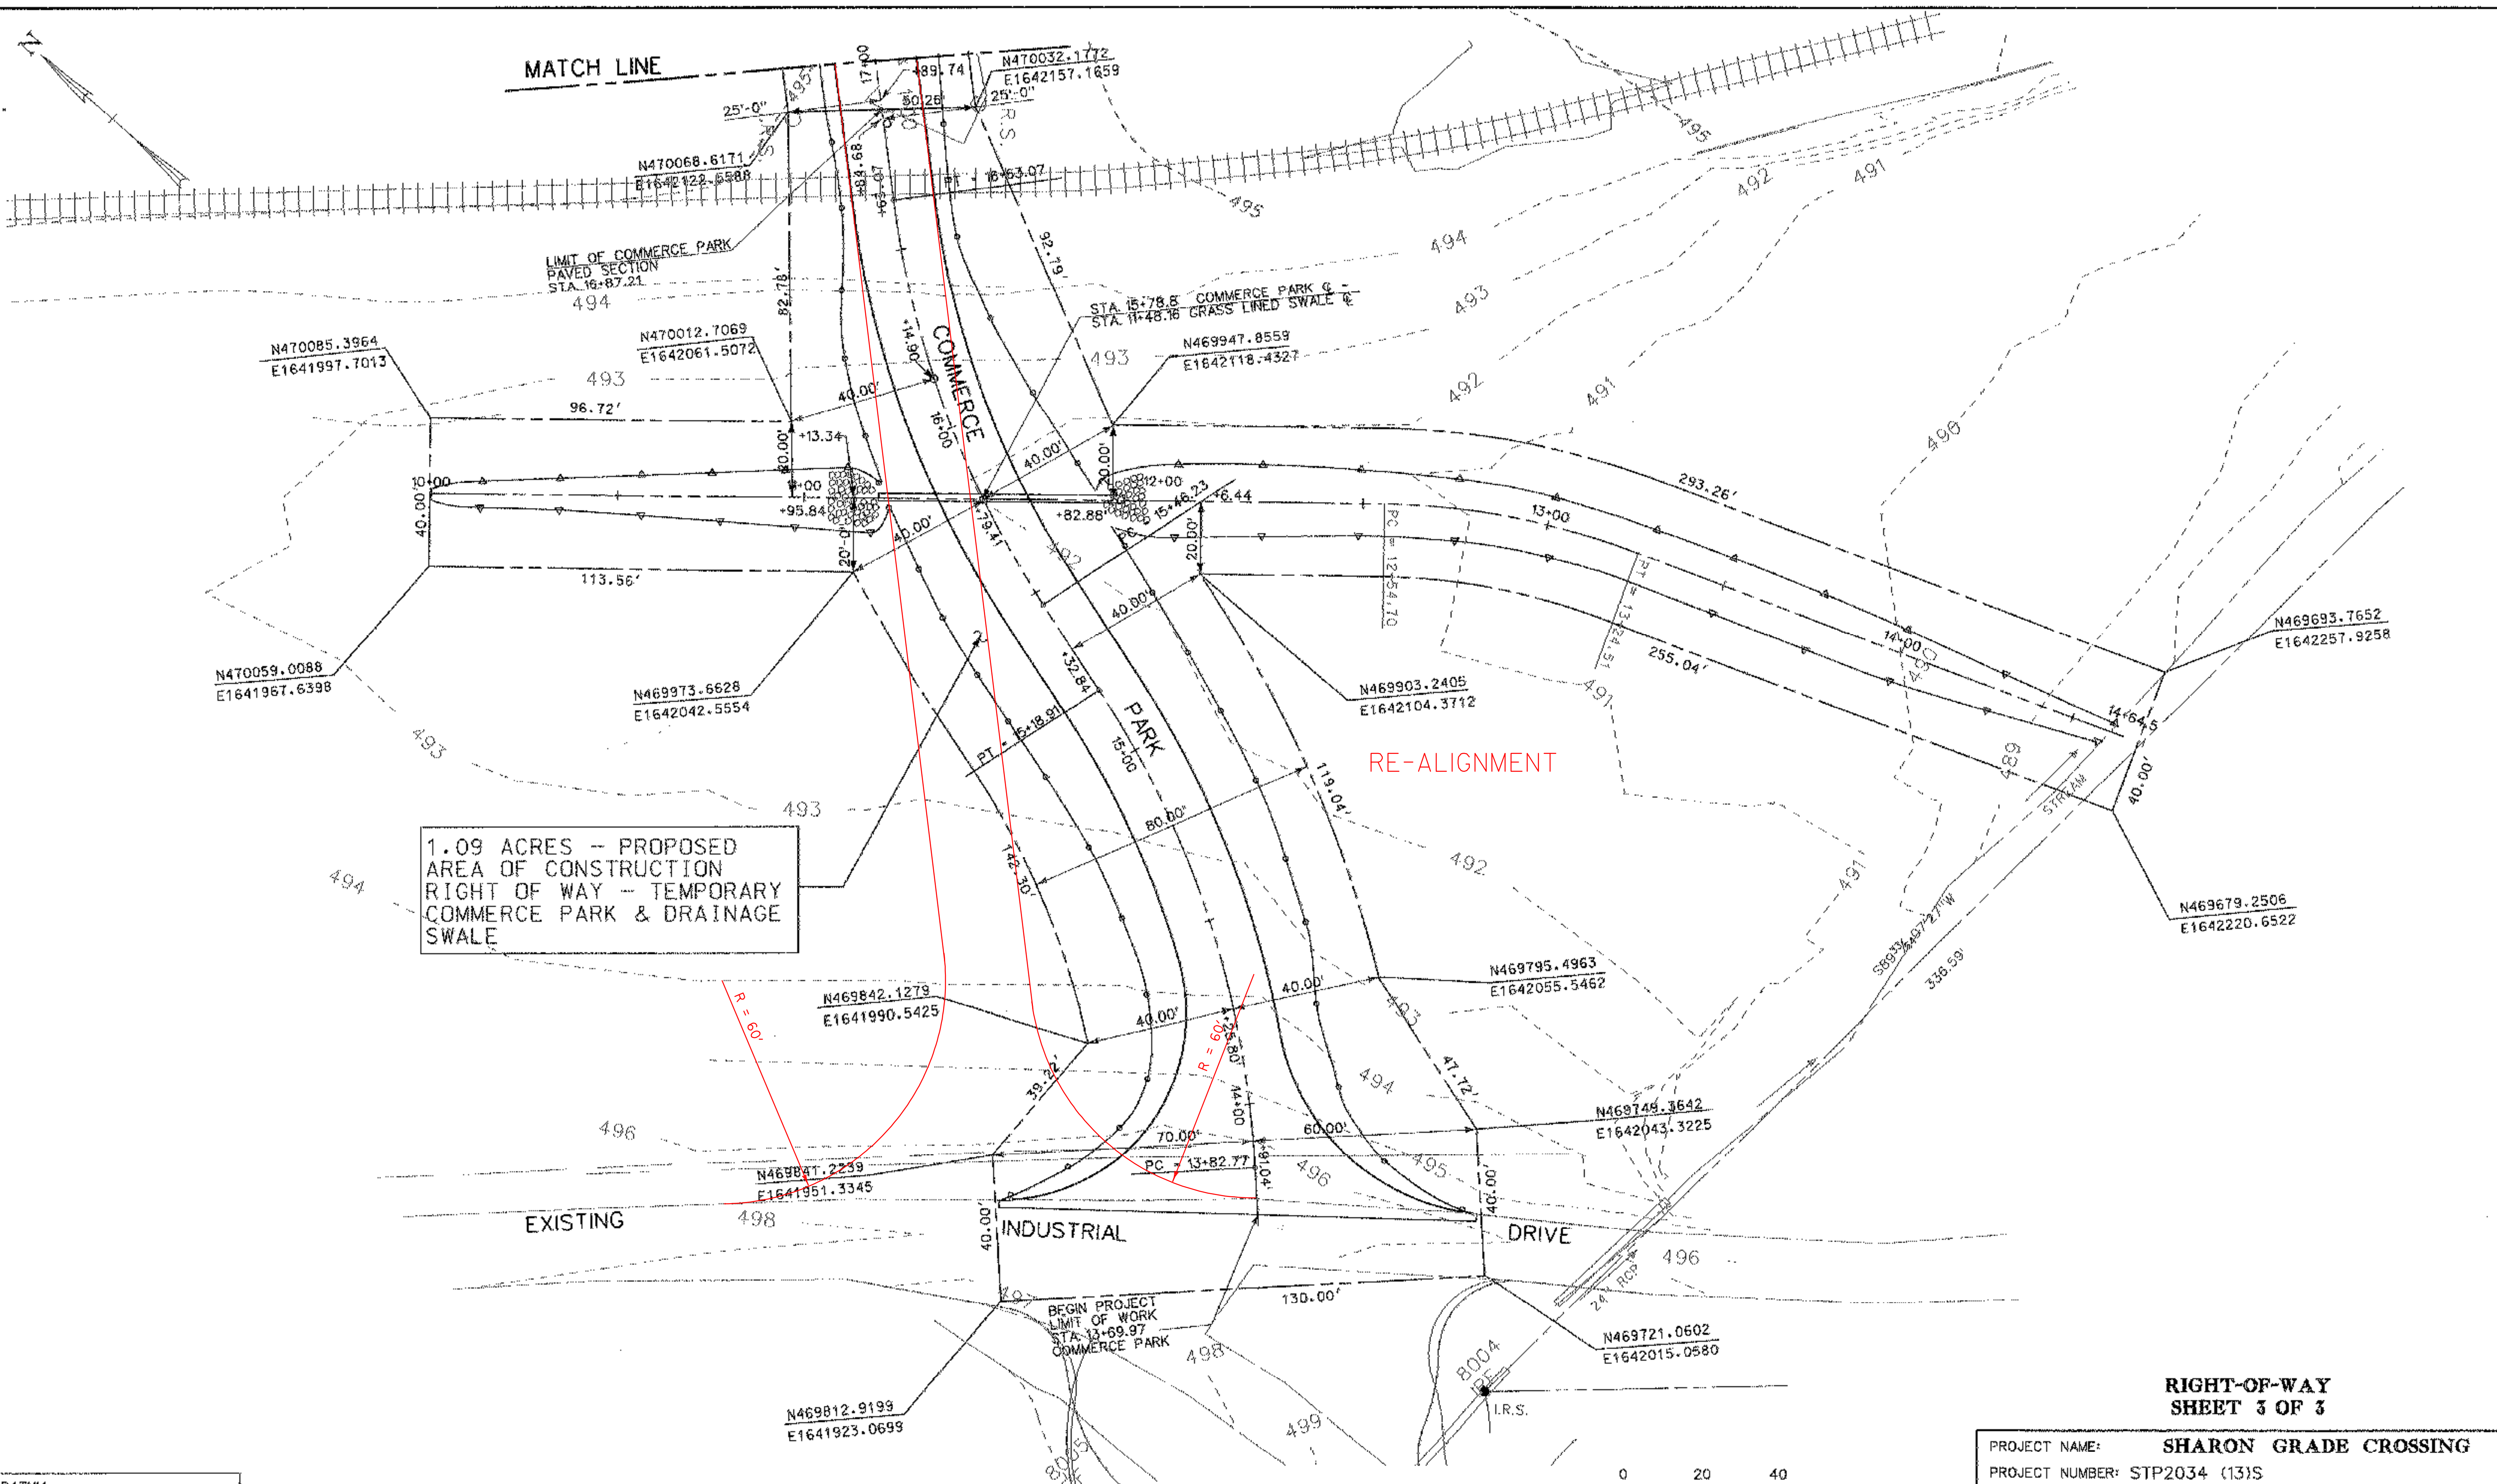


1.09 ACRES - PROPOSED
 AREA OF CONSTRUCTION
 RIGHT OF WAY - TEMPORARY
 COMMERCE PARK & DRAINAGE
 SWALE

RE-ALIGNMENT







DATUM
 VERTICAL NAVD88 ± 0.5 FT.
 HORIZONTAL SPC 1983

ORIGINAL PREPARED:		
DATE	REVISIONS	BY










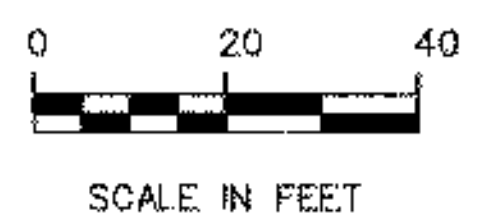


**RIGHT-OF-WAY
 SHEET 3 OF 3**


PROJECT NAME:	SHARON GRADE CROSSING	
PROJECT NUMBER:	STP2034 (13)S	
FILE NAME:	SHT21.DGN	PLOT DATE: 06/13/03
PROJECT LEADER:	R. O'BLENS	DRAWN BY: J. DEROSIER
DESIGNED BY:	C. GLOVER	CHECKED BY: R. ORO
		SHEET 21 OF 35

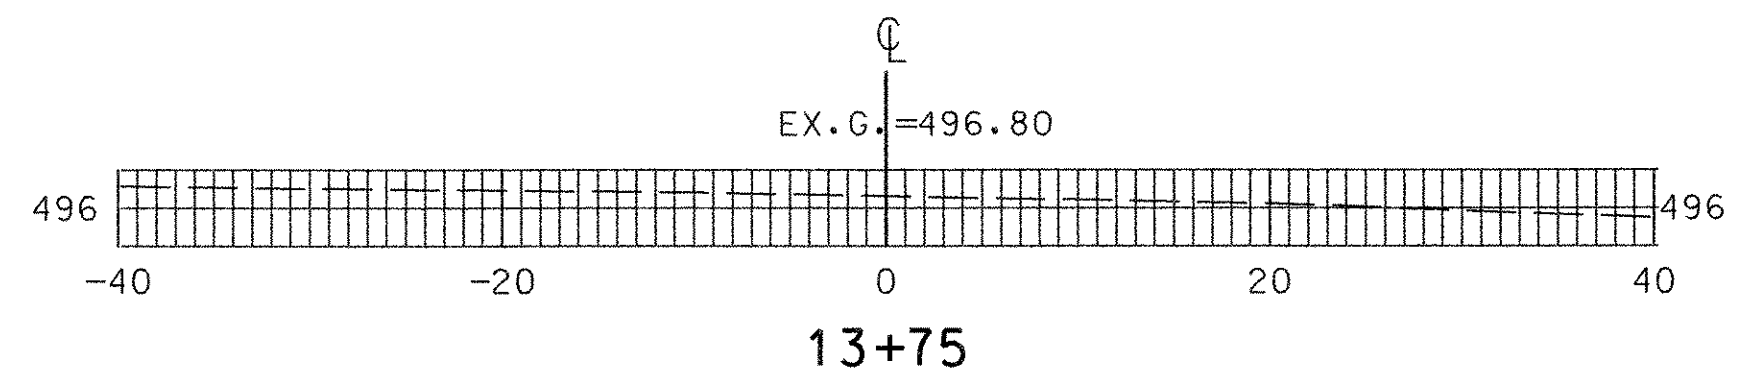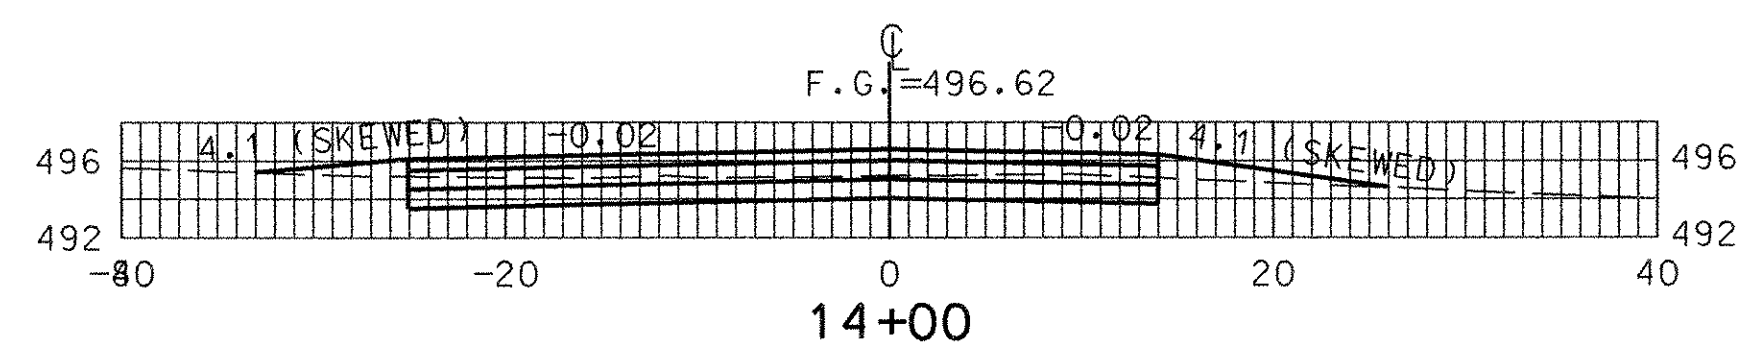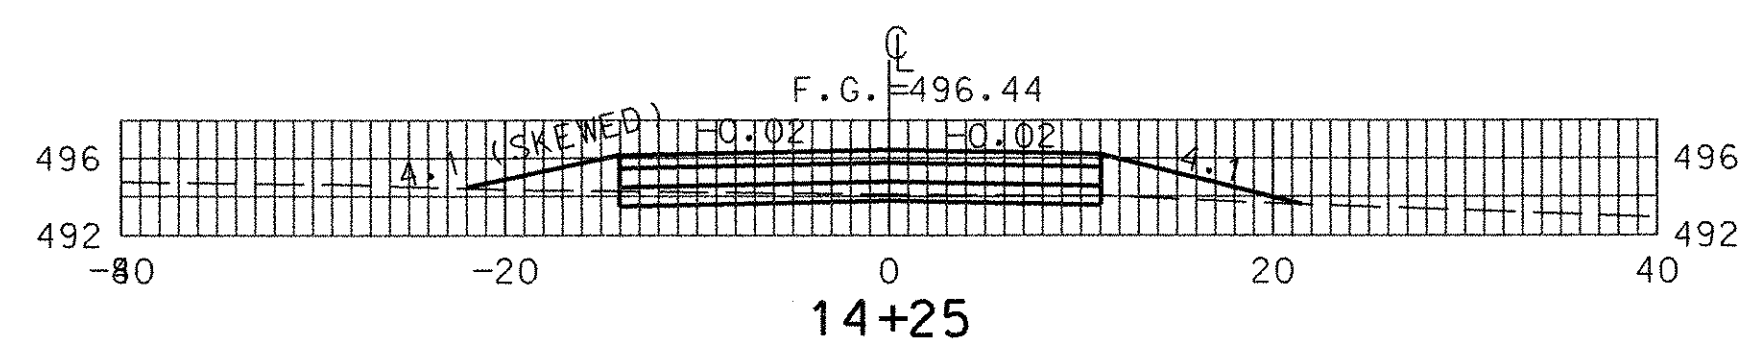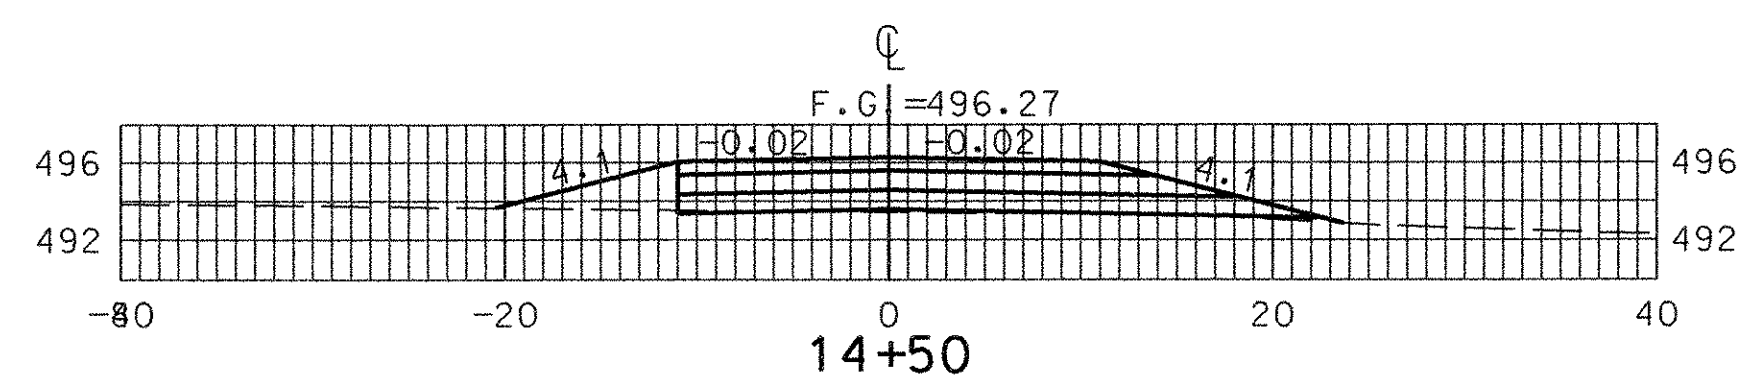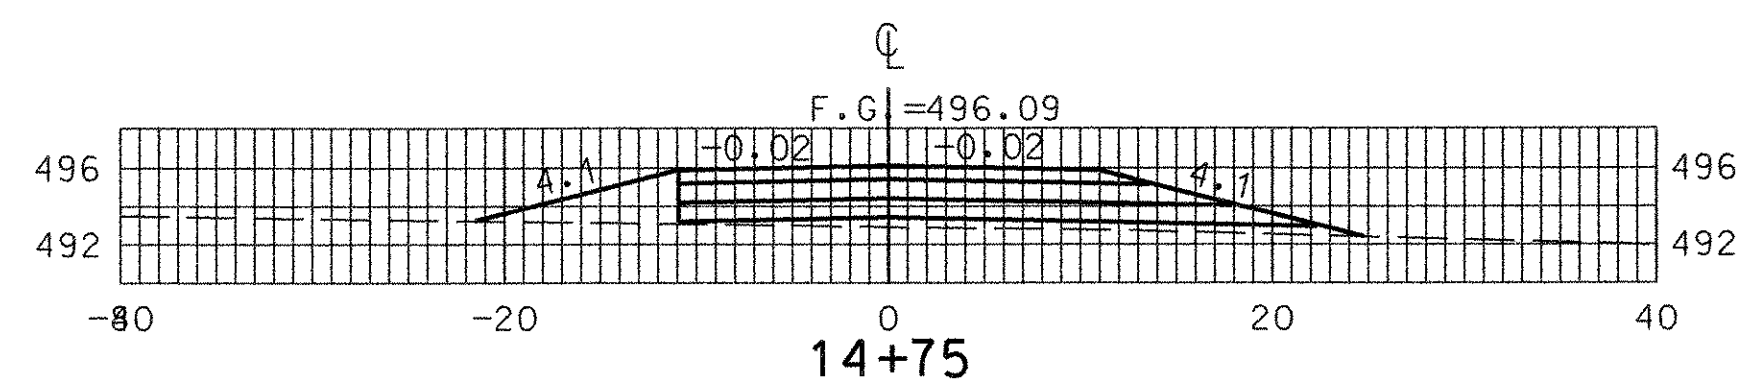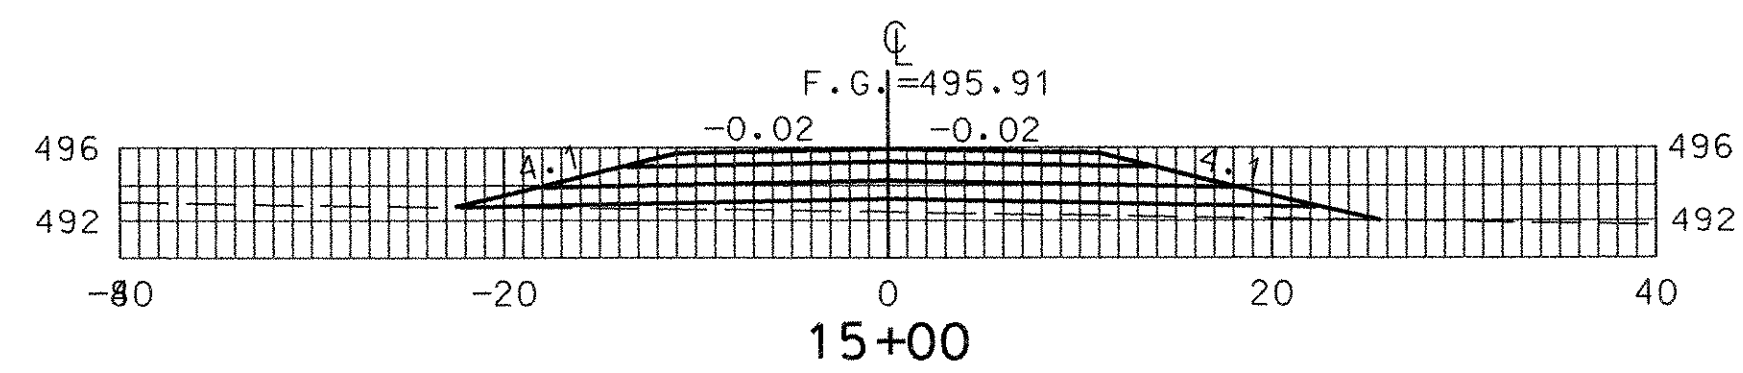

COMMERCE PARK

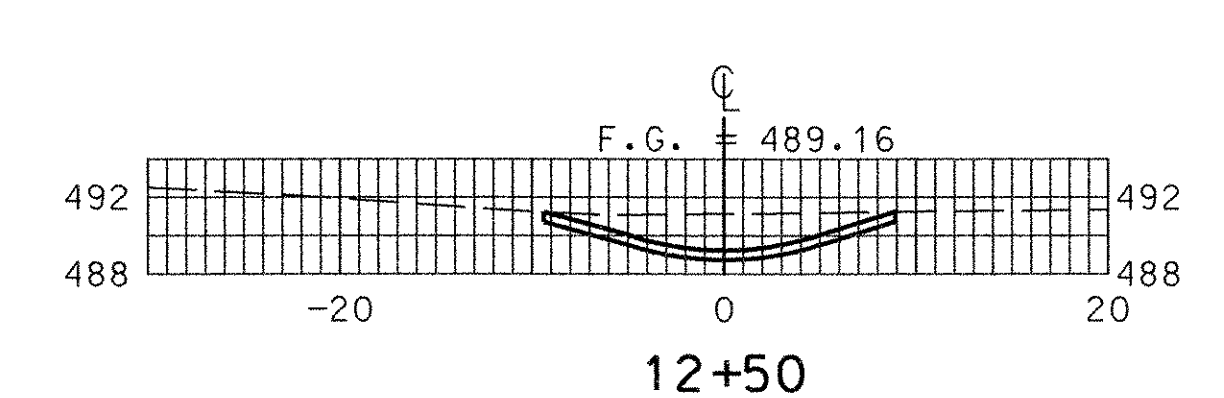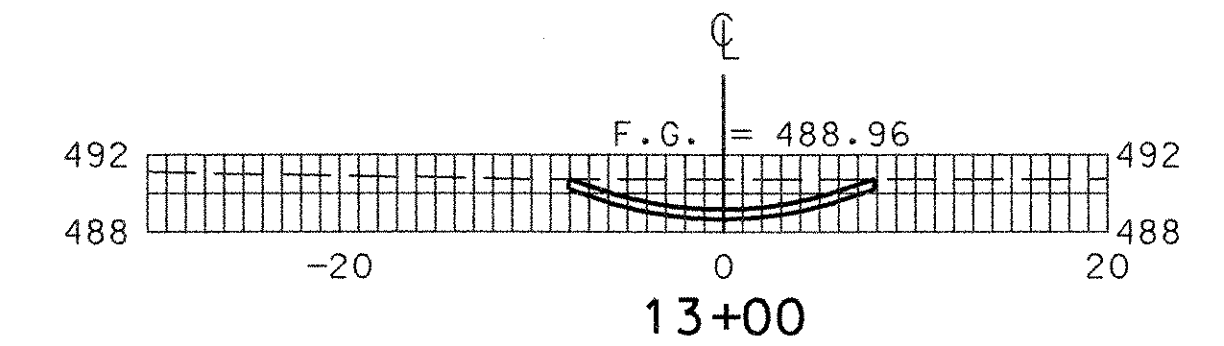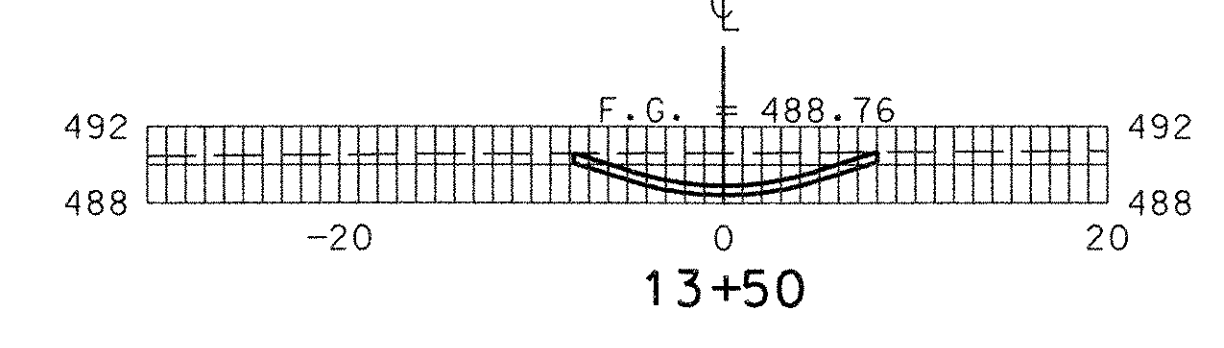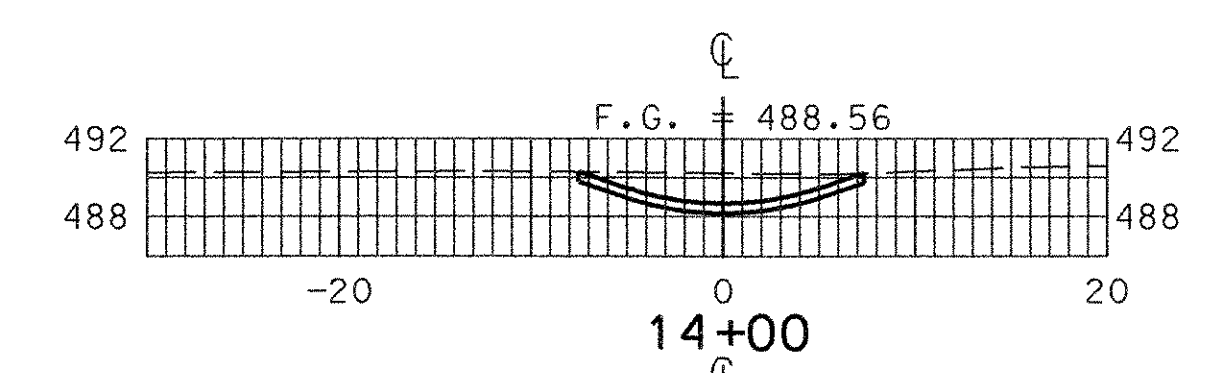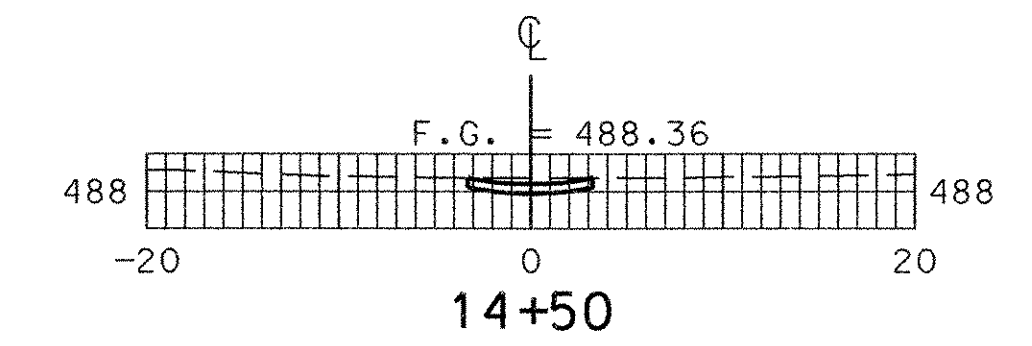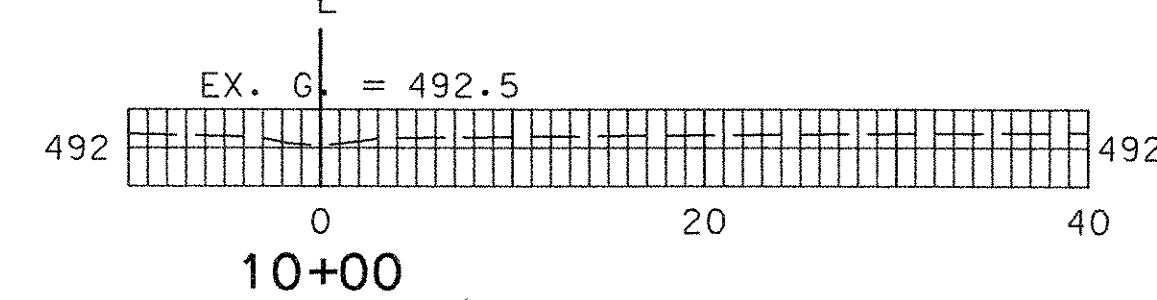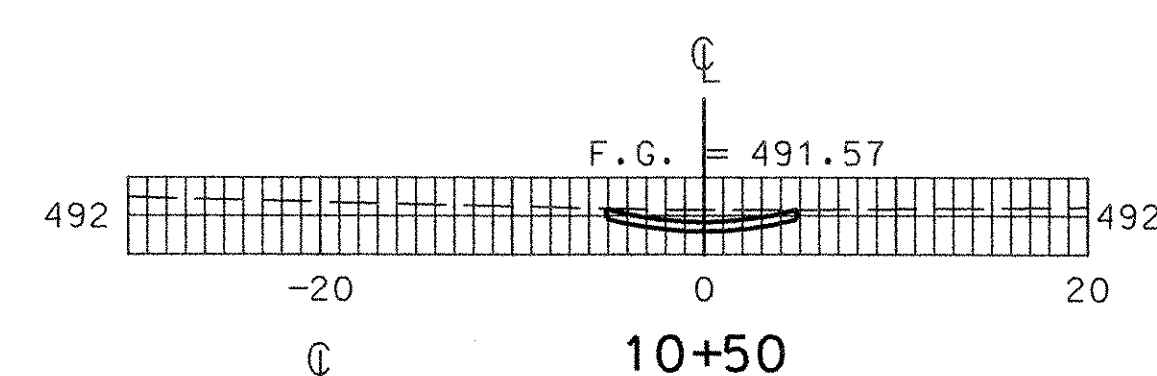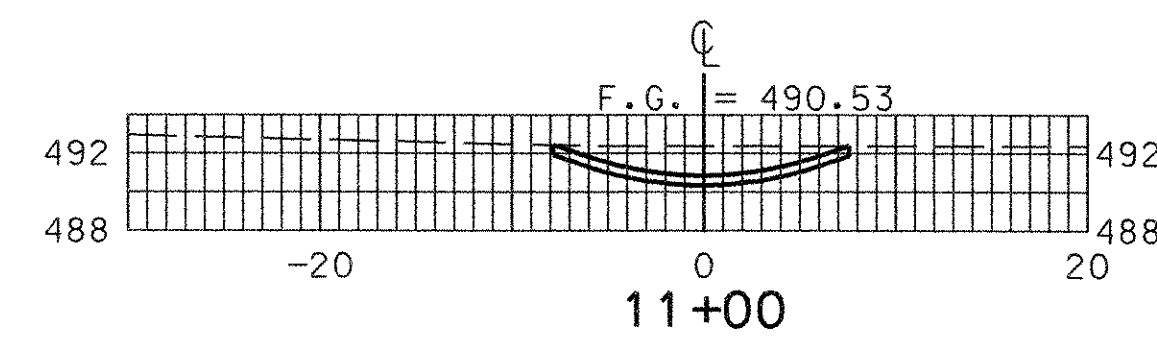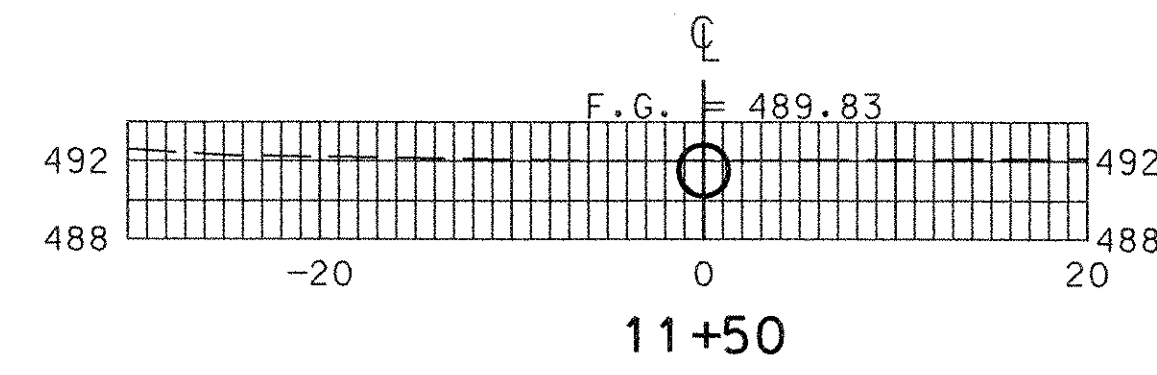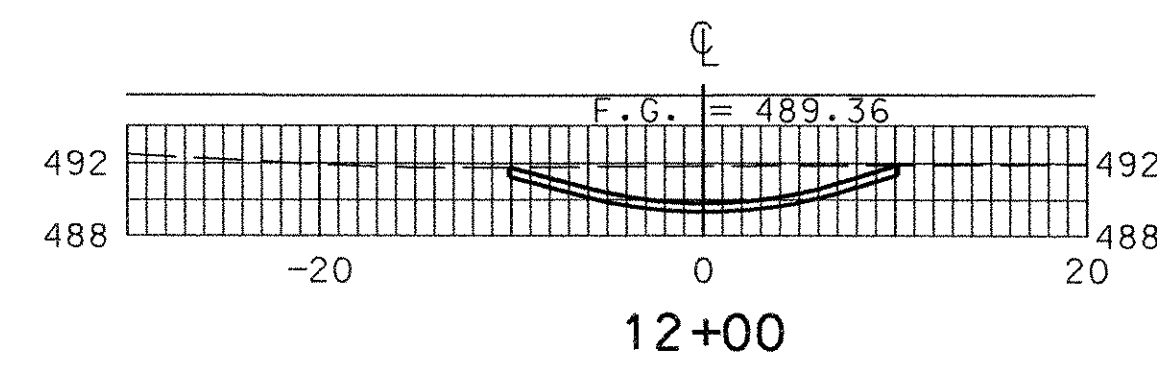

GRASS LINED SWALE

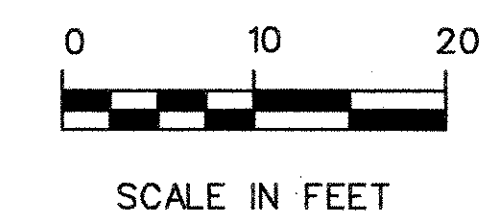



**CROSS SECTIONS
COMMERCE PARK / GRASS LINED SWALE
SHEET 1 OF 2**

PROJECT NAME:	SHARON GRADE CROSSING	
PROJECT NUMBER:	STP2034 (13)S	
FILE NAME:	SHT22.DGN	PLOT DATE: 06/13/03
PROJECT LEADER:	R. O'BLENIS	DRAWN BY: J. DEROSIER
DESIGNED BY:	C. GLOVER	CHECKED BY: R. ORO
		SHEET 22 OF 35

ORIGINAL PREPARED:		
DATE	REVISIONS	BY

DATUM	
VERTICAL	NAVD88 ± 0.5 FT.
HORIZONTAL	SPC 1983


06/13/03
 M:\18737s_v1.rail\sharon_crossing.dgn\SH122.dgn

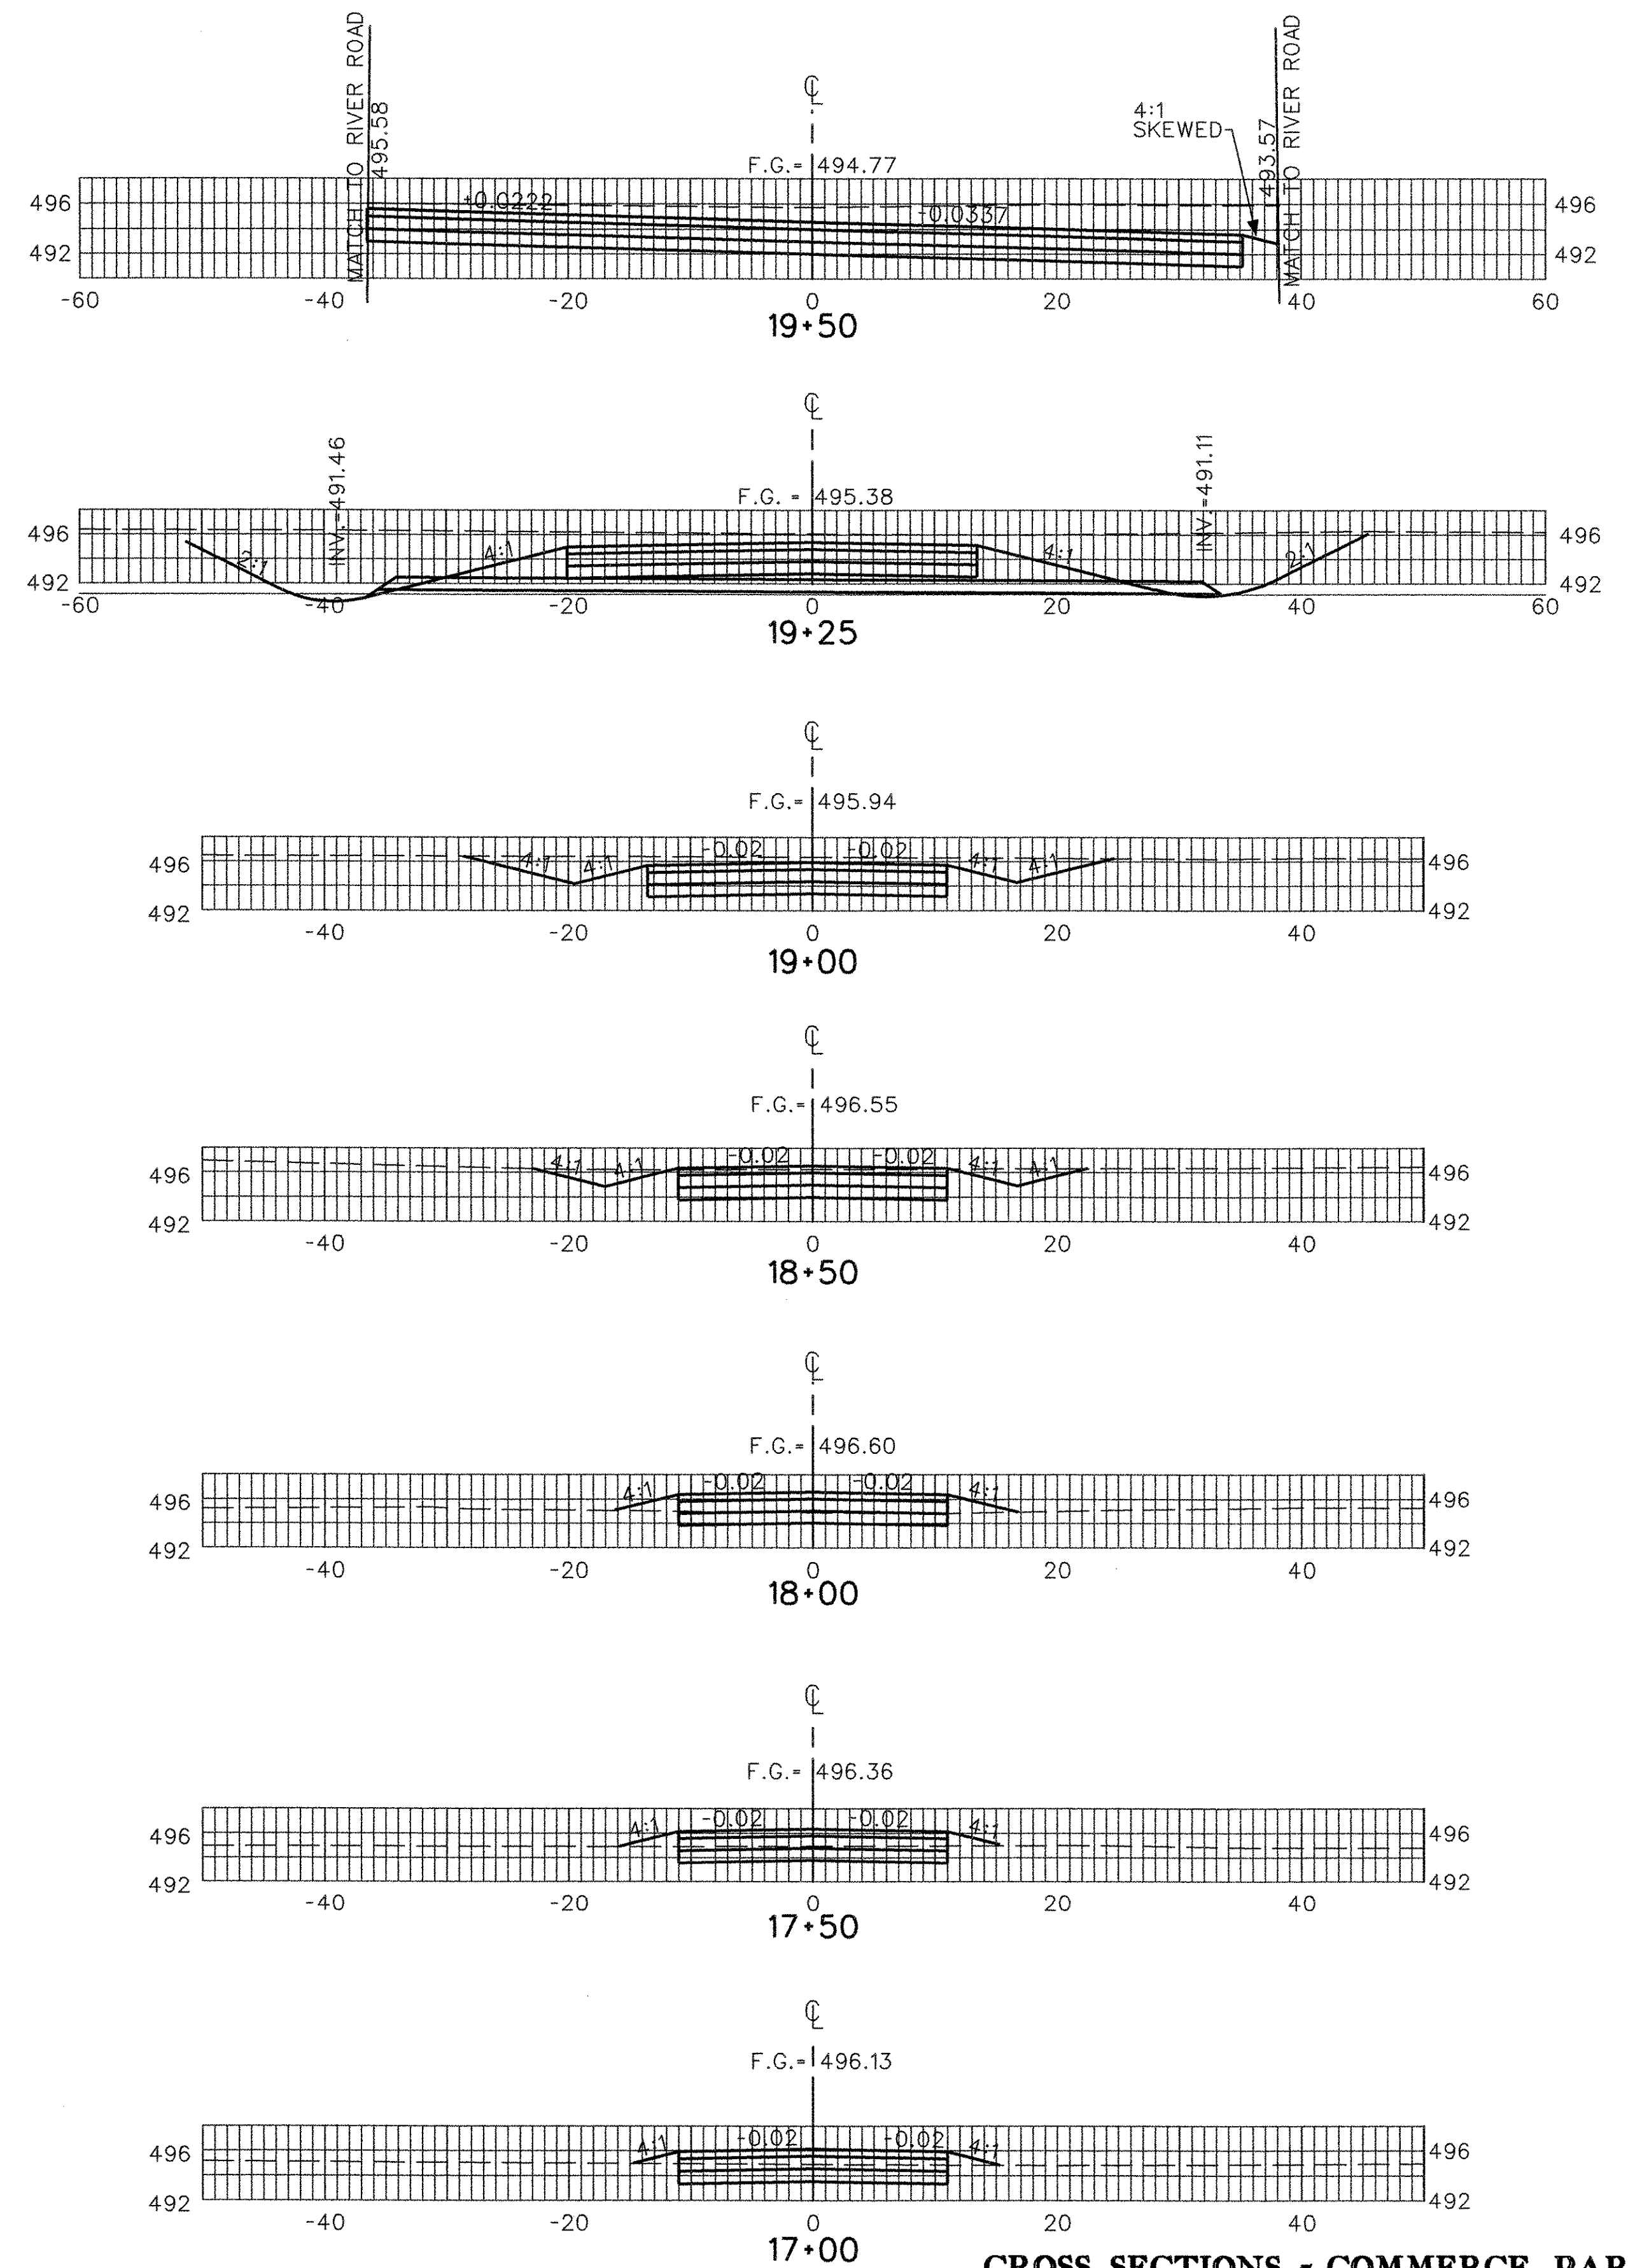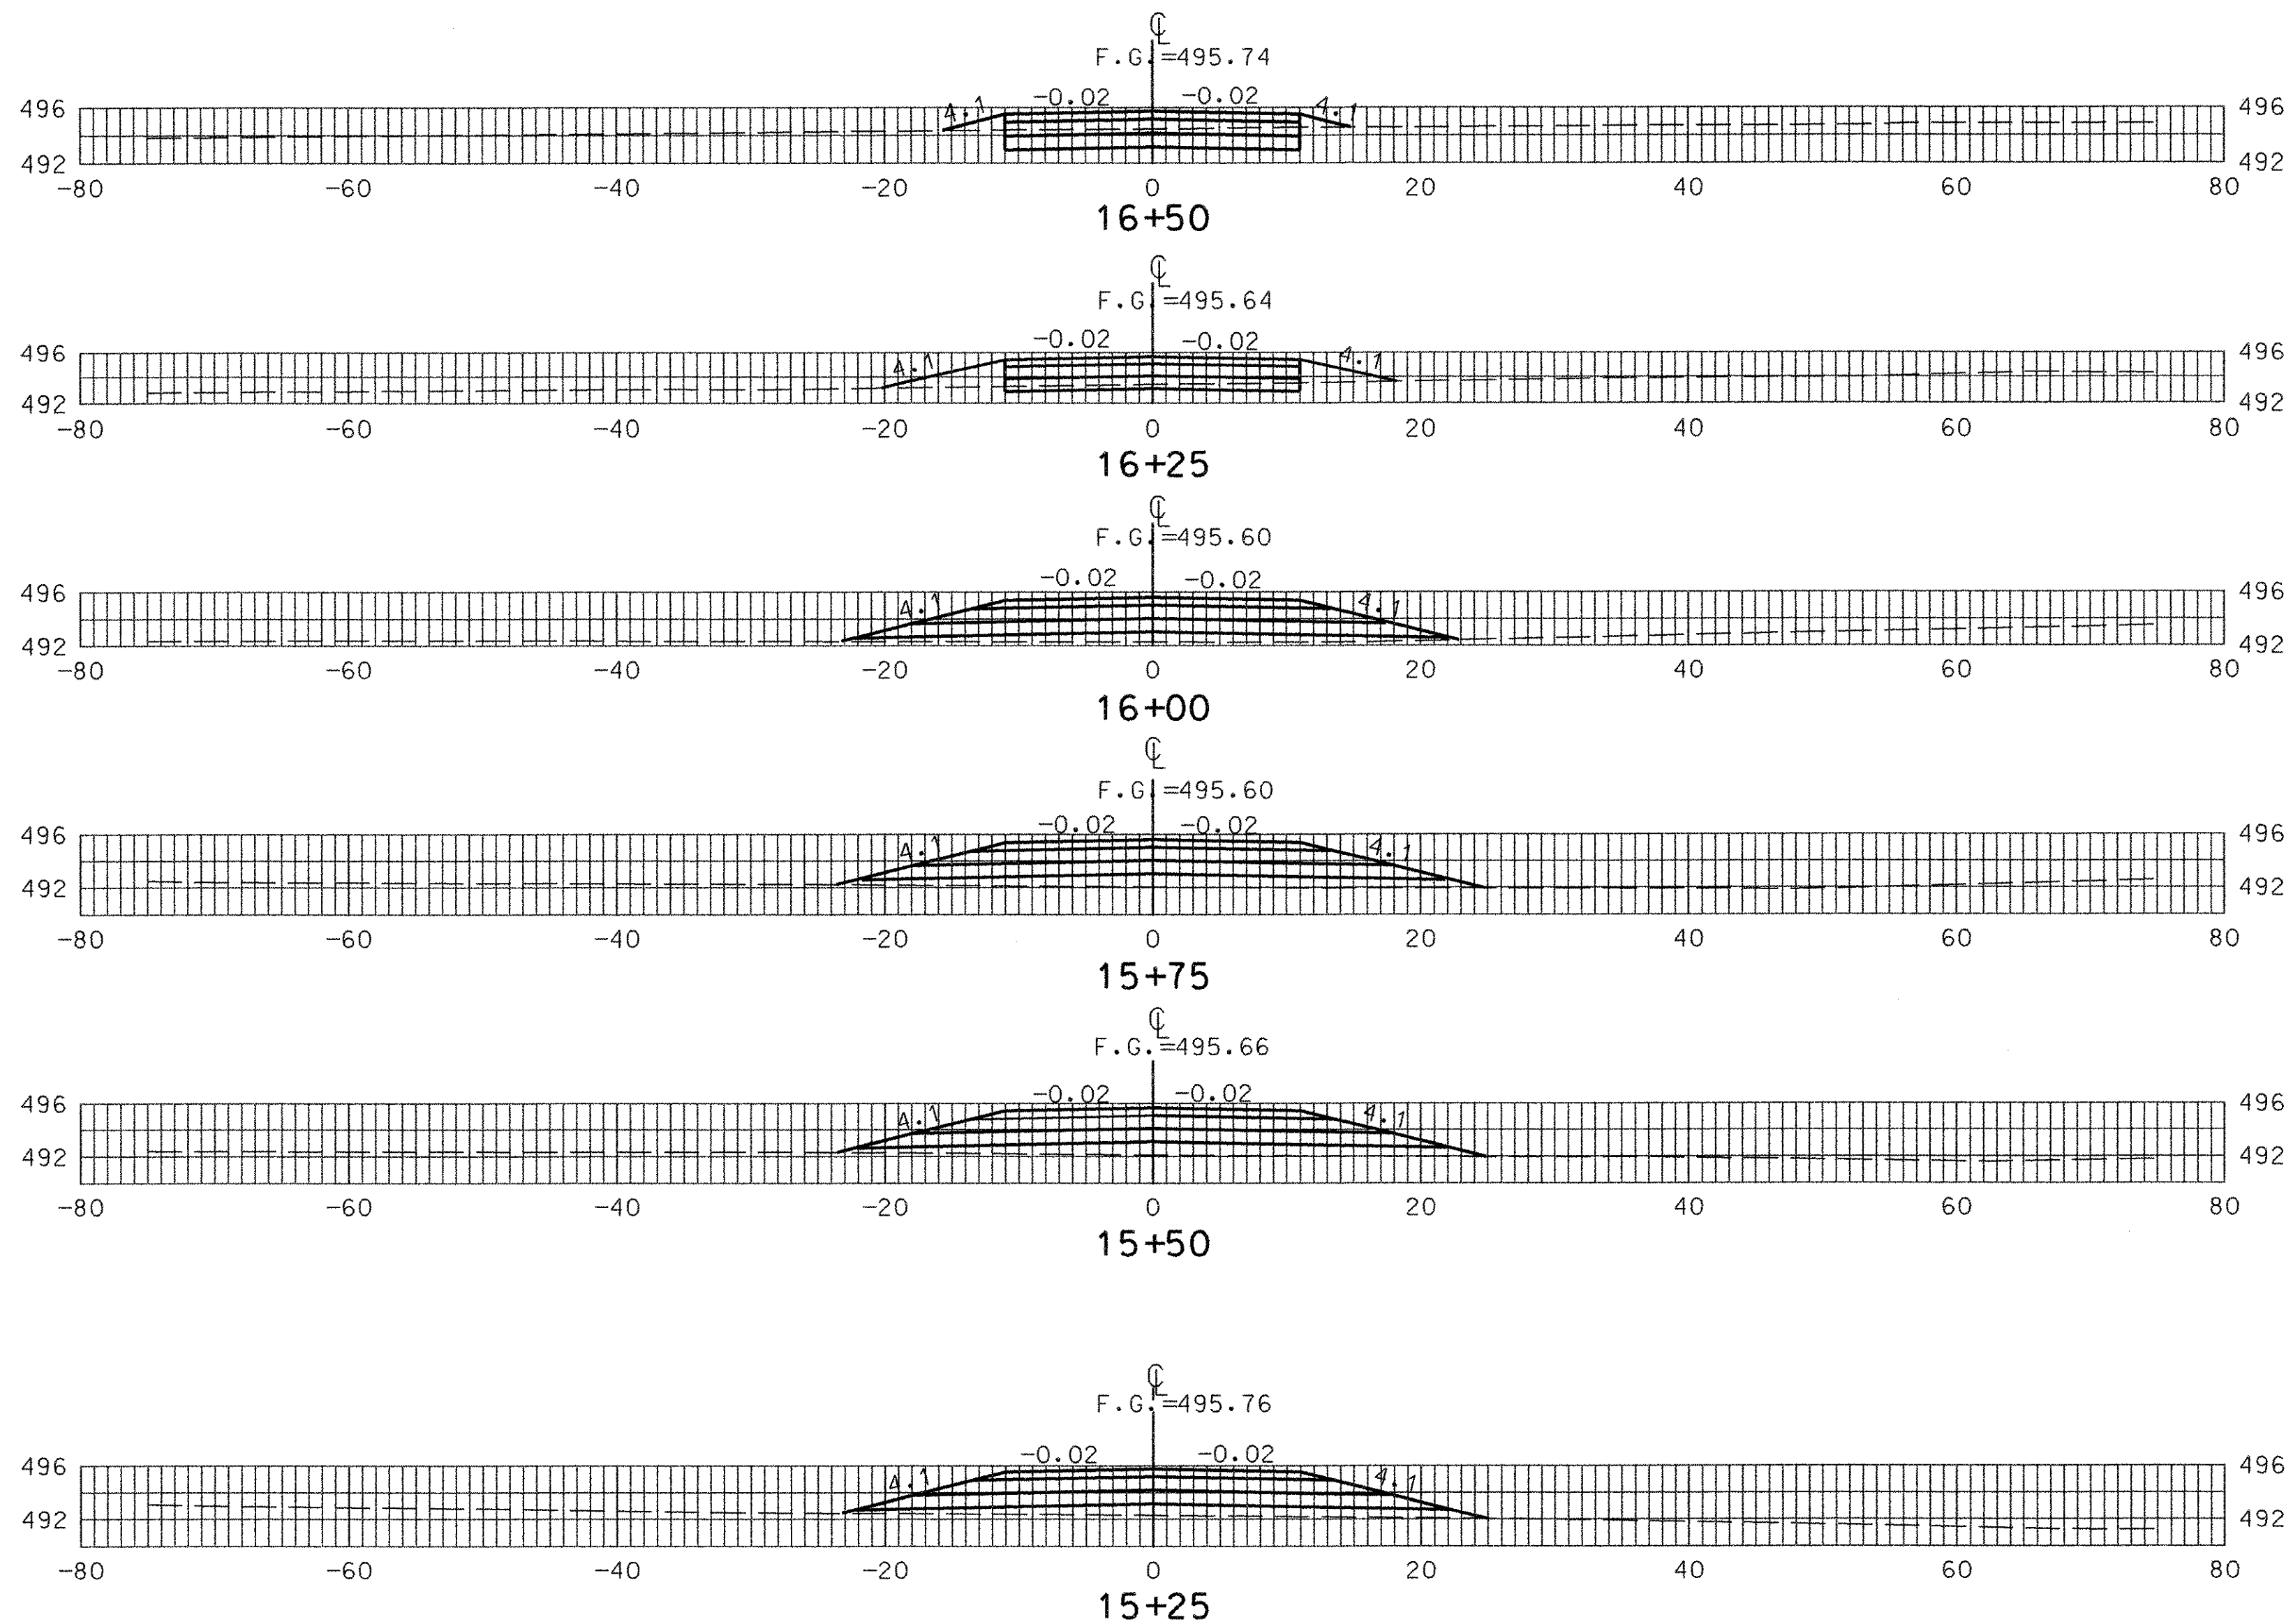

CROSS SECTIONS - COMMERCE PARK SHEET 2 OF 2

DATUM
 VERTICAL NAVD88 ± 0.5 FT.
 HORIZONTAL SPC 1983












ORIGINAL PREPARED:		
DATE	REVISIONS	BY

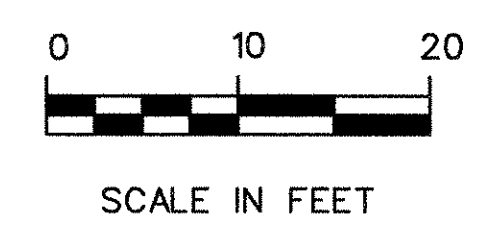

PROJECT NAME: **SHARON GRADE CROSSING**
 PROJECT NUMBER: STP2034 (13)S
 FILE NAME: SHT23.DGN
 PROJECT LEADER: R. O'BLENIS
 DESIGNED BY: C. GLOVER
 PLOT DATE: 06/13/03
 DRAWN BY: J. DEROSIER
 CHECKED BY: R. ORO
 SHEET 23 OF 35


06/13/03 11:14 AM
 M:\18737s_v1_rail\sharon_crossing\sharon_sht23.dgn

06/13/03
 M:\18737s_vl_rdl\sharon_crossing.dgn\sh24.dgn

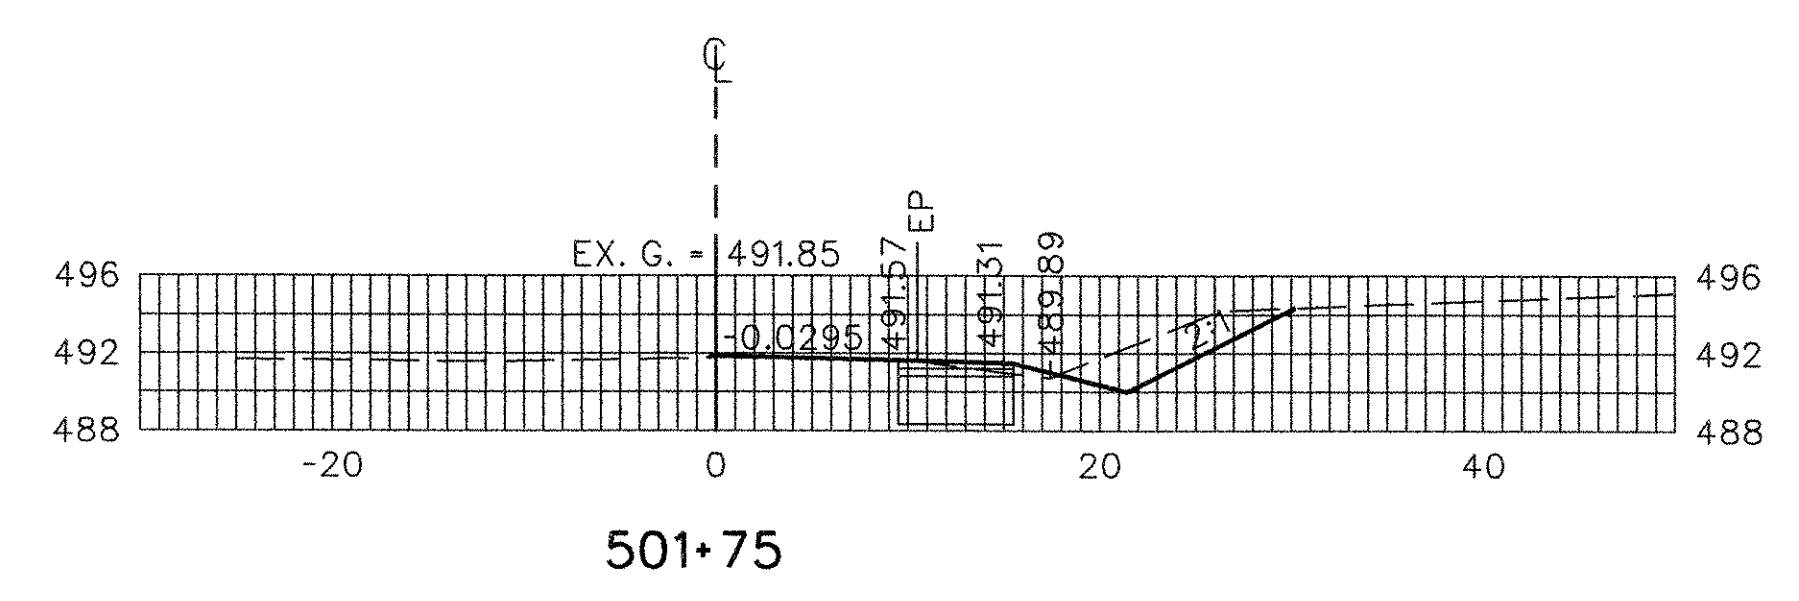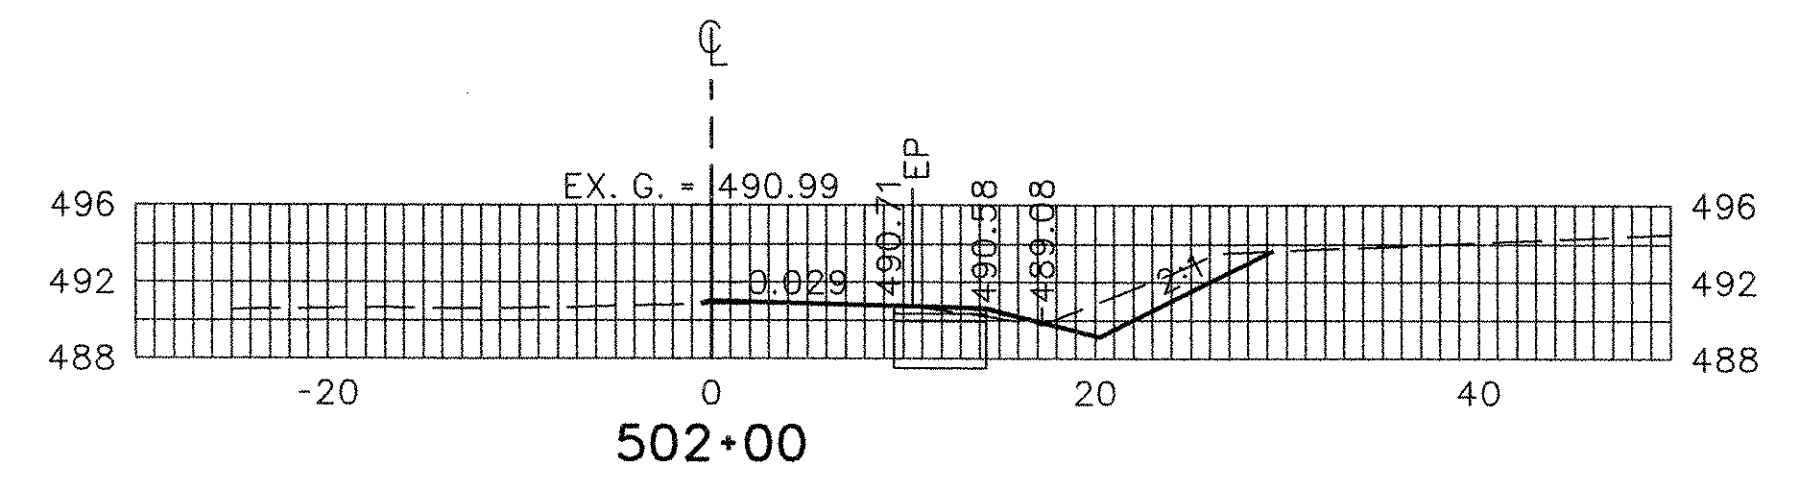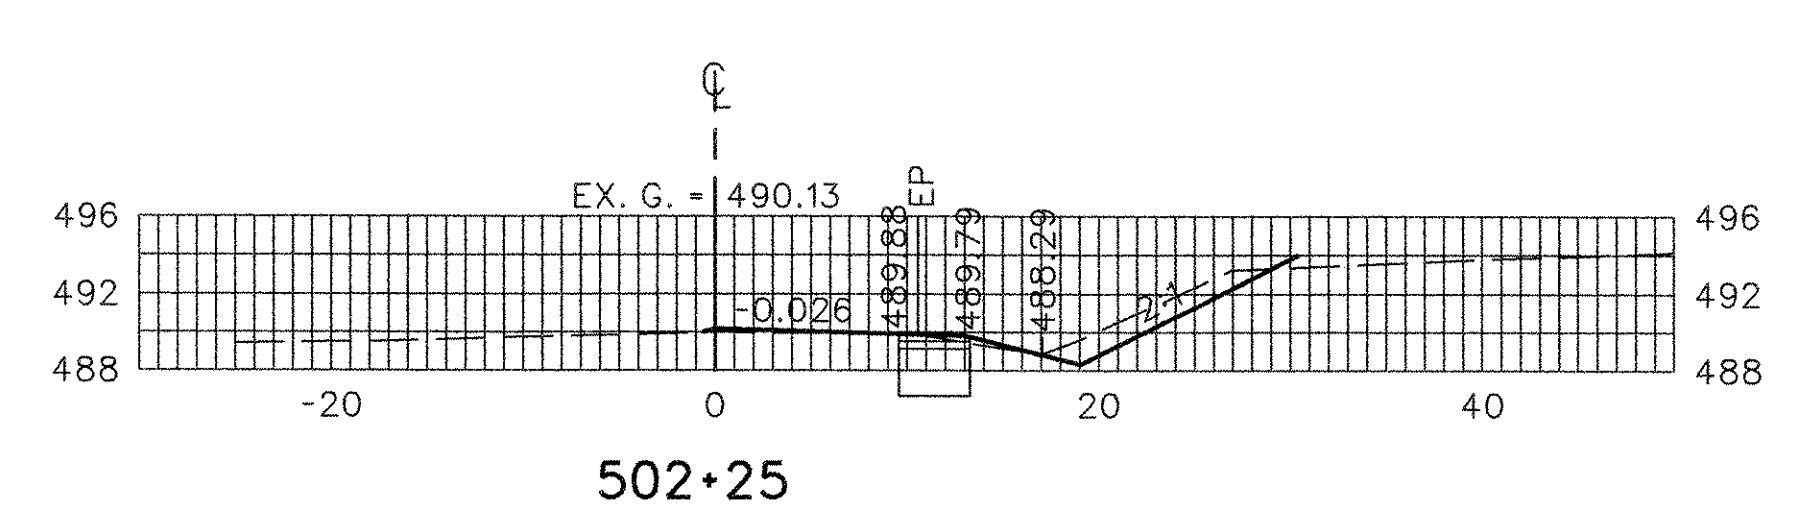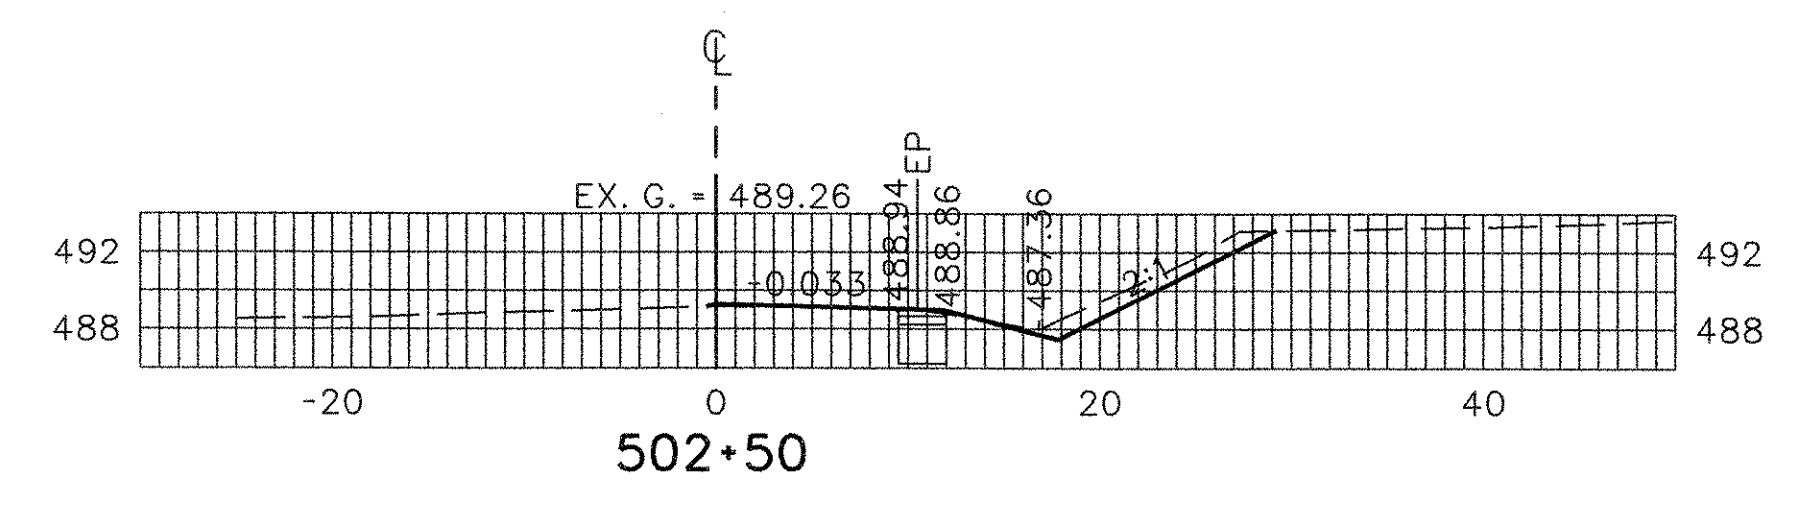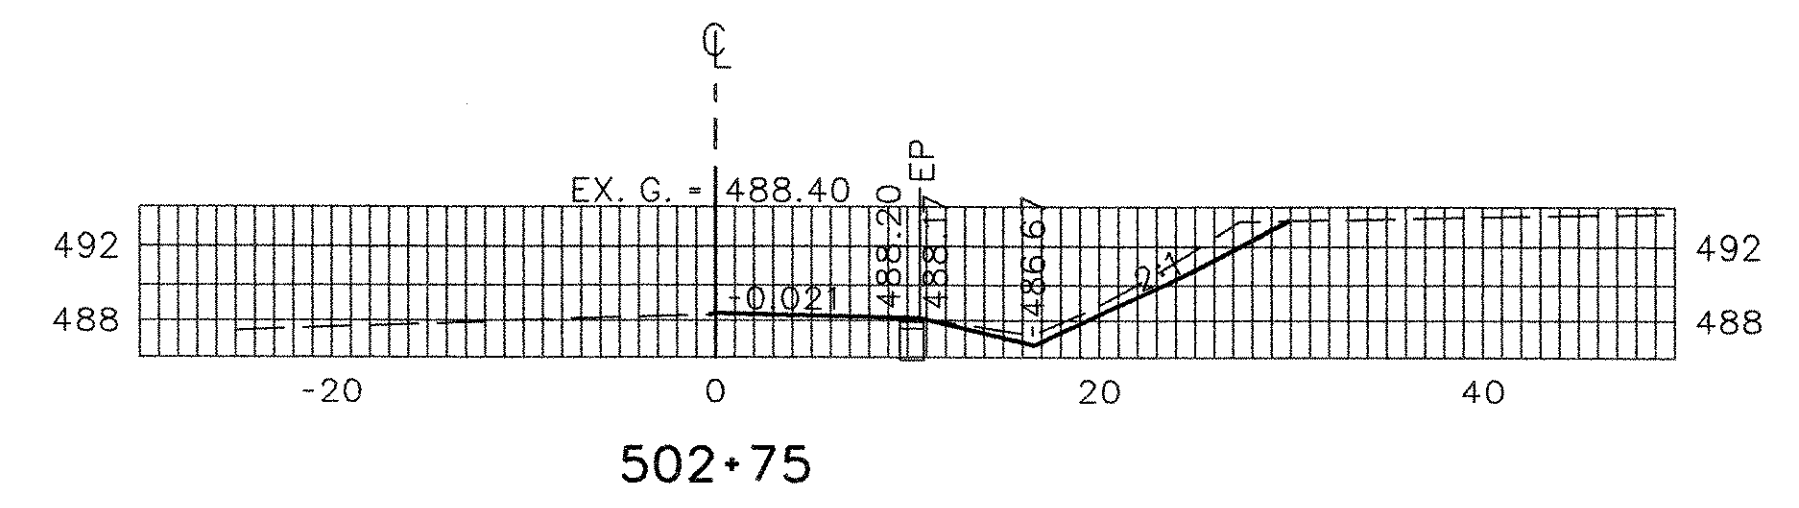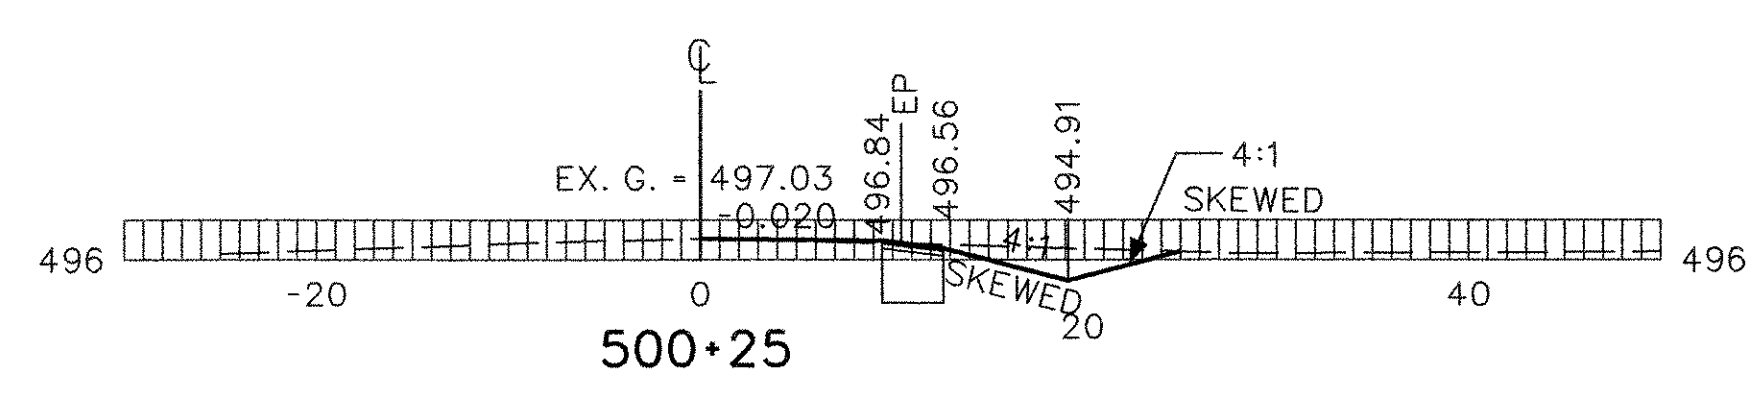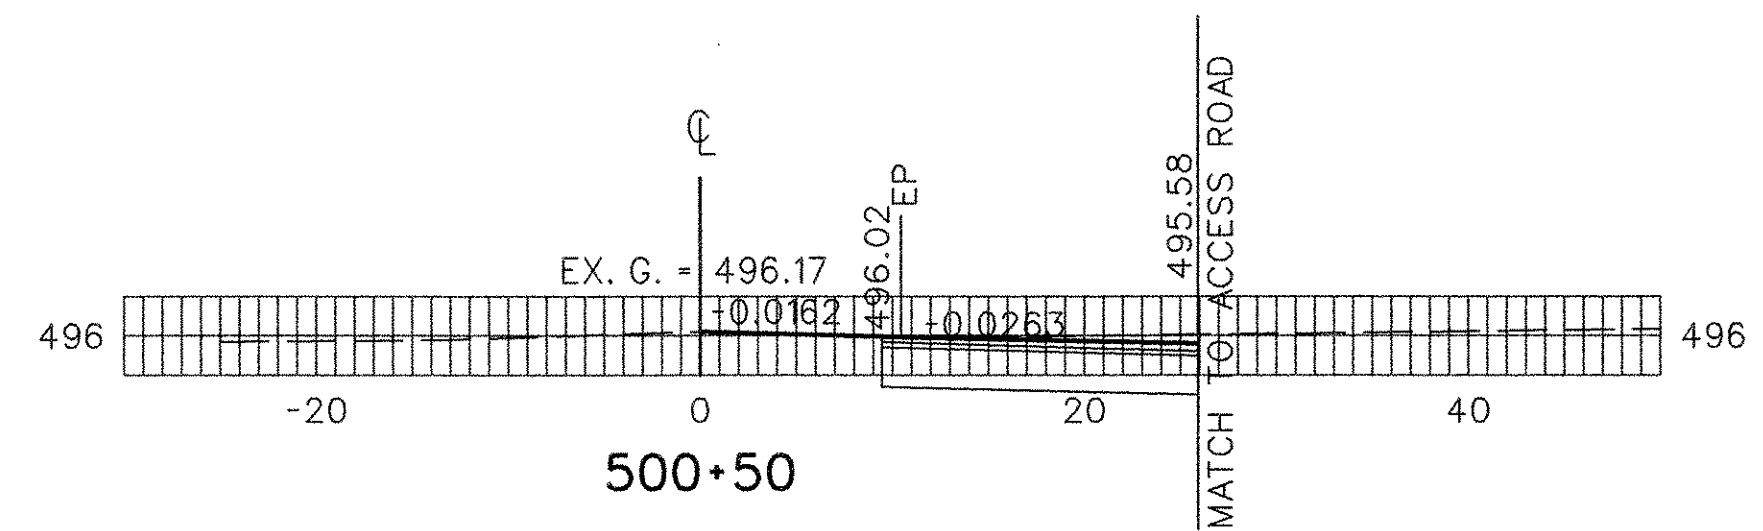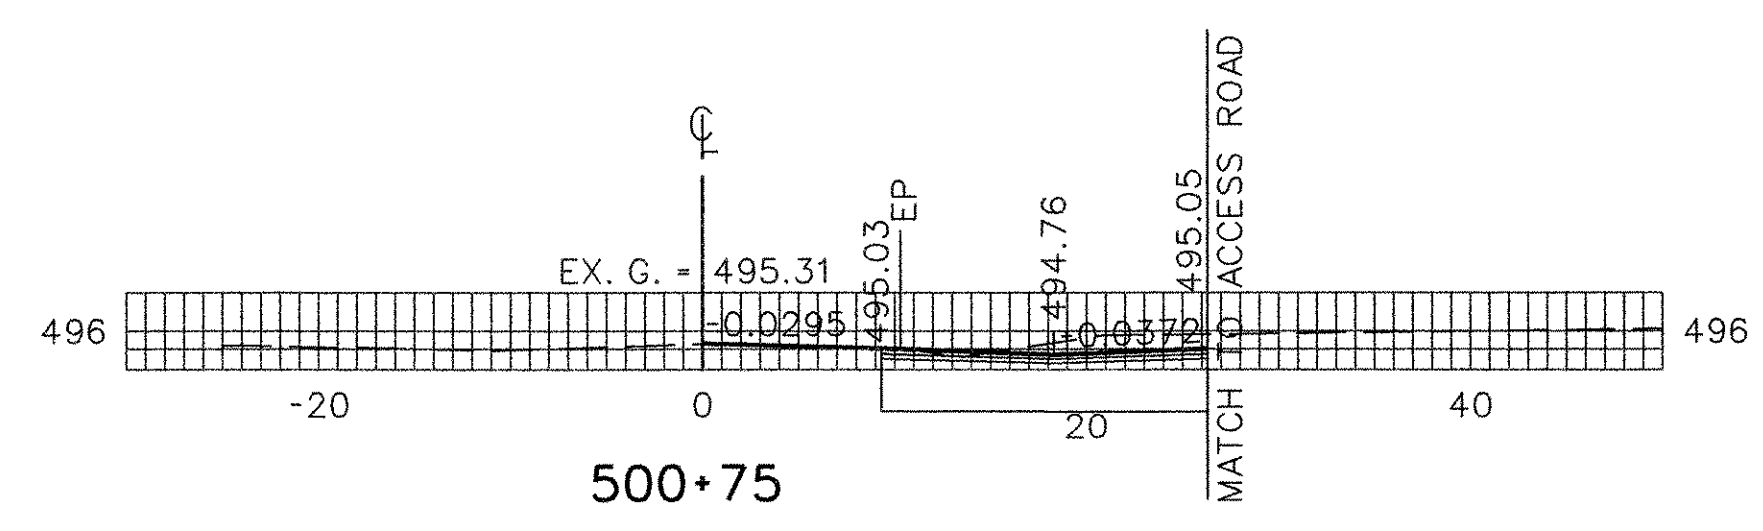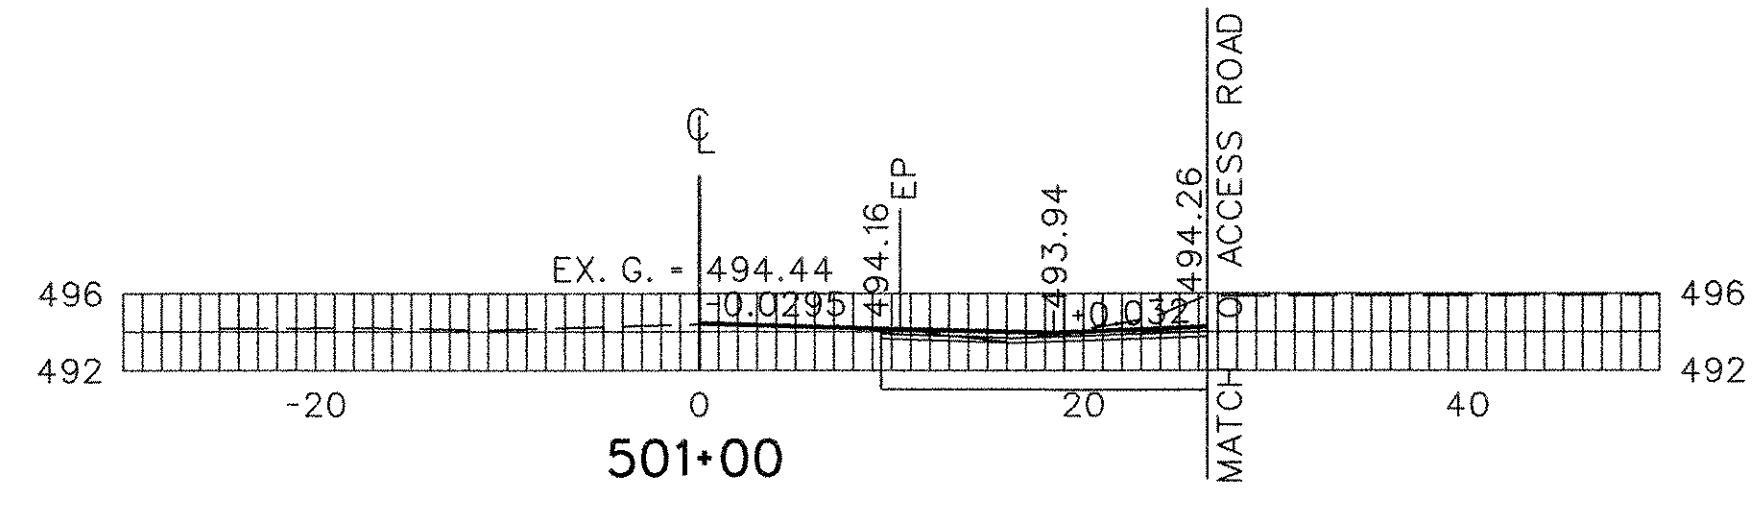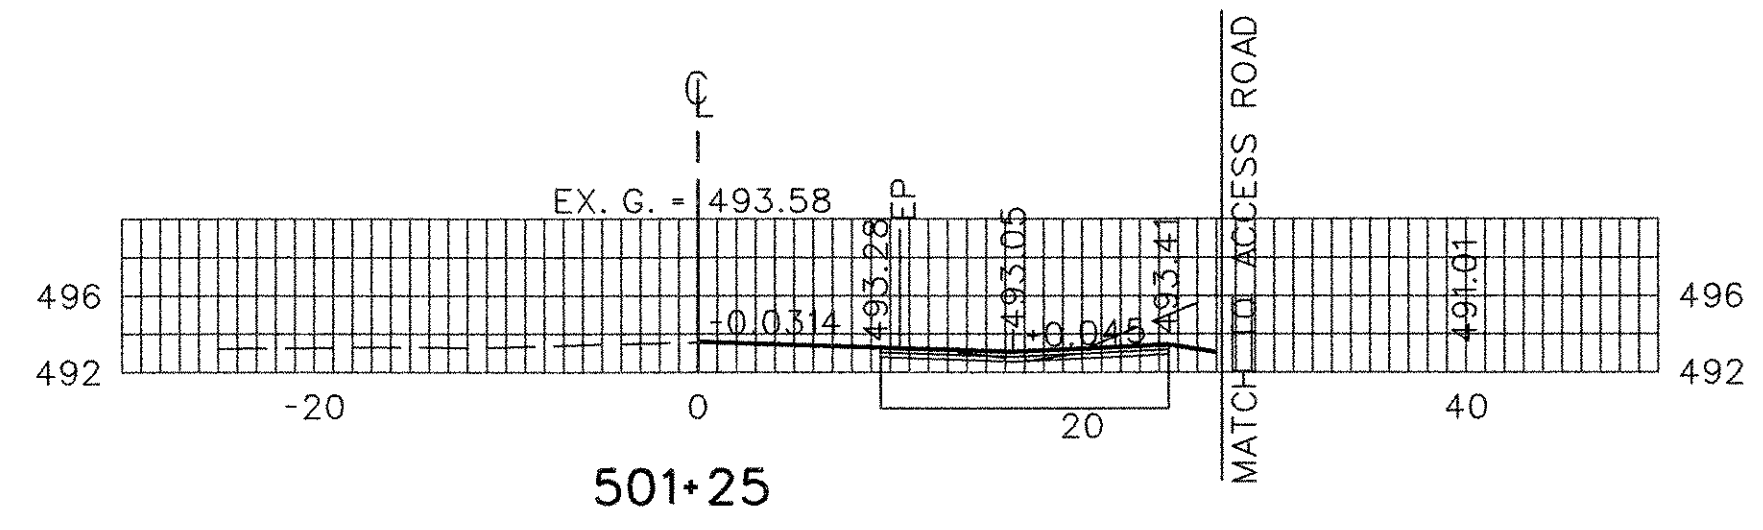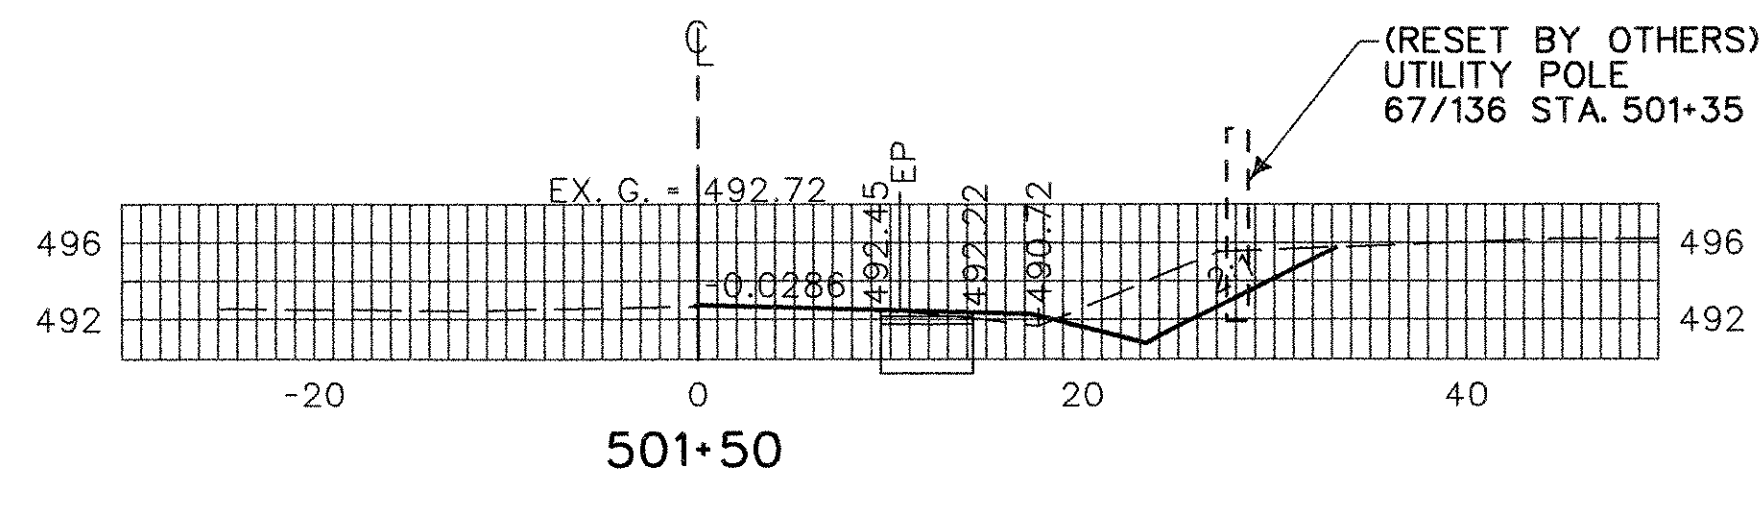

DATUM
 VERTICAL NAVD88 ± 0.5 FT.
 HORIZONTAL SPC 1983


ORIGINAL PREPARED:		
DATE	REVISIONS	BY

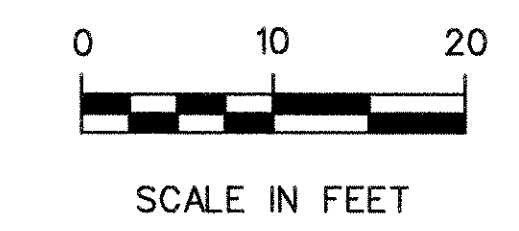

CROSS SECTIONS - RIVER ROAD (TH3)
 PROJECT NAME: SHARON GRADE CROSSING
 PROJECT NUMBER: STP2034 (13)S
 FILE NAME: SHT25.DGN
 PROJECT LEADER: R. O'BLENIS
 DESIGNED BY: C. GLOVER
 PLOT DATE: 06/13/03
 DRAWN BY: J. DEROSIER
 CHECKED BY: R. ORO
 SHEET 24 OF 35

TO WHITE RIVER JCT.

TO MONTPELIER

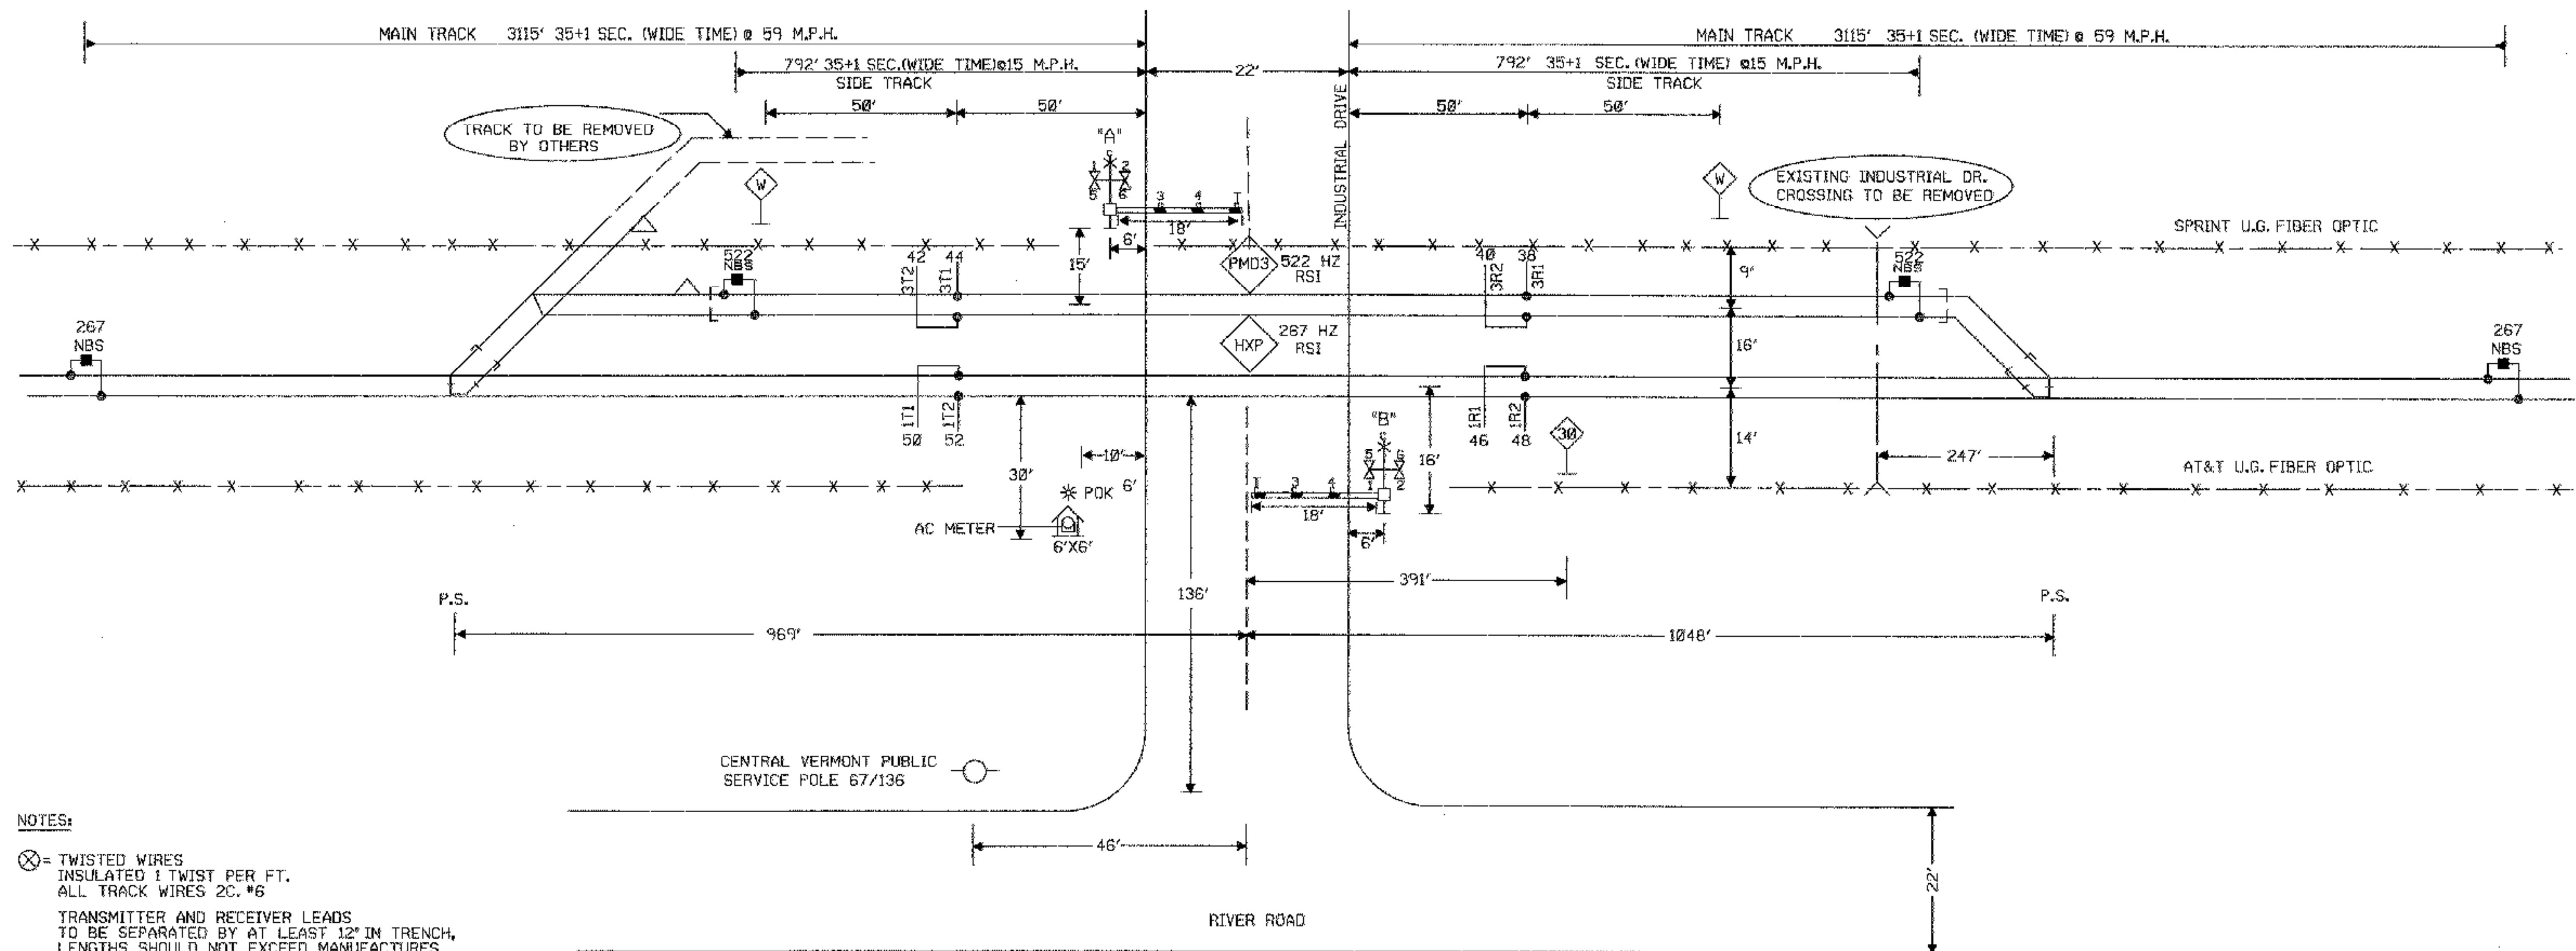

NOTES:

- ⊗ = TWISTED WIRES INSULATED 1 TWIST PER FT. ALL TRACK WIRES 2C. #6
- TRANSMITTER AND RECEIVER LEADS TO BE SEPARATED BY AT LEAST 12" IN TRENCH, LENGTHS SHOULD NOT EXCEED MANUFACTURERS RECOMMENDATION.
- TOP OF FOUNDATION TO BE AT SAME ELEVATION AS THE SURFACE OF THE TRAVELED WAY & NO MORE THAN 4" ABOVE THE SURFACE OF THE GROUND.
- ALL BUNGALOW WIRING TO BE #16 AWG FLEX UNLESS OTHERWISE SPECIFIED EXCEPT ALL GROUND WIRE TO BE #6 AWG FLEX OR LARGER.
- ALL WIRING IN GATE MECHANISM TO BE #10 AWG FLEX.
- DISTANCES SHOWN HEREIN ARE APPROXIMATE AND ARE NOT TO BE USED FOR CROSSING CONSTRUCTION SURVEYING.

DO NOT USE 7 CELLS OF B14 BATTERY UNLESS REQUIRED TO MAINTAIN MINIMUM LAMP VOLTAGE.

==== 4" X 80' CONDUIT

LIGHTS: 12" LED LIGHTS

GATE A: 18'

GATE B: 18'

ALL THE FOLLOWING WORK WAS DONE BY ECI
NOT PART OF CONTRACT

CONNECTS TO DRAWING

CONNECTS TO DRAWING

DATUM

VERTICAL	NAVD88 ± 0.5 FT.
HORIZONTAL	SFC 1983


ORIGINAL PREPARED:		
DATE	REVISIONS	BY

NOT TO SCALE

DOT# 247-536R

SIGNAL PLAN

PROJECT NAME:	SHARON GRADE CROSSING		
PROJECT NUMBER:	STP2034 (13)S		
FILE NAME:	SHT26.DGN	PLOT DATE:	06/13/03
PROJECT LEADER:	H. PAIEL	DRAWN BY:	A. BOSE
DESIGNED BY:	R. CARROLL	CHECKED BY:	C. SERGOT
		SHEET	25 OF 35

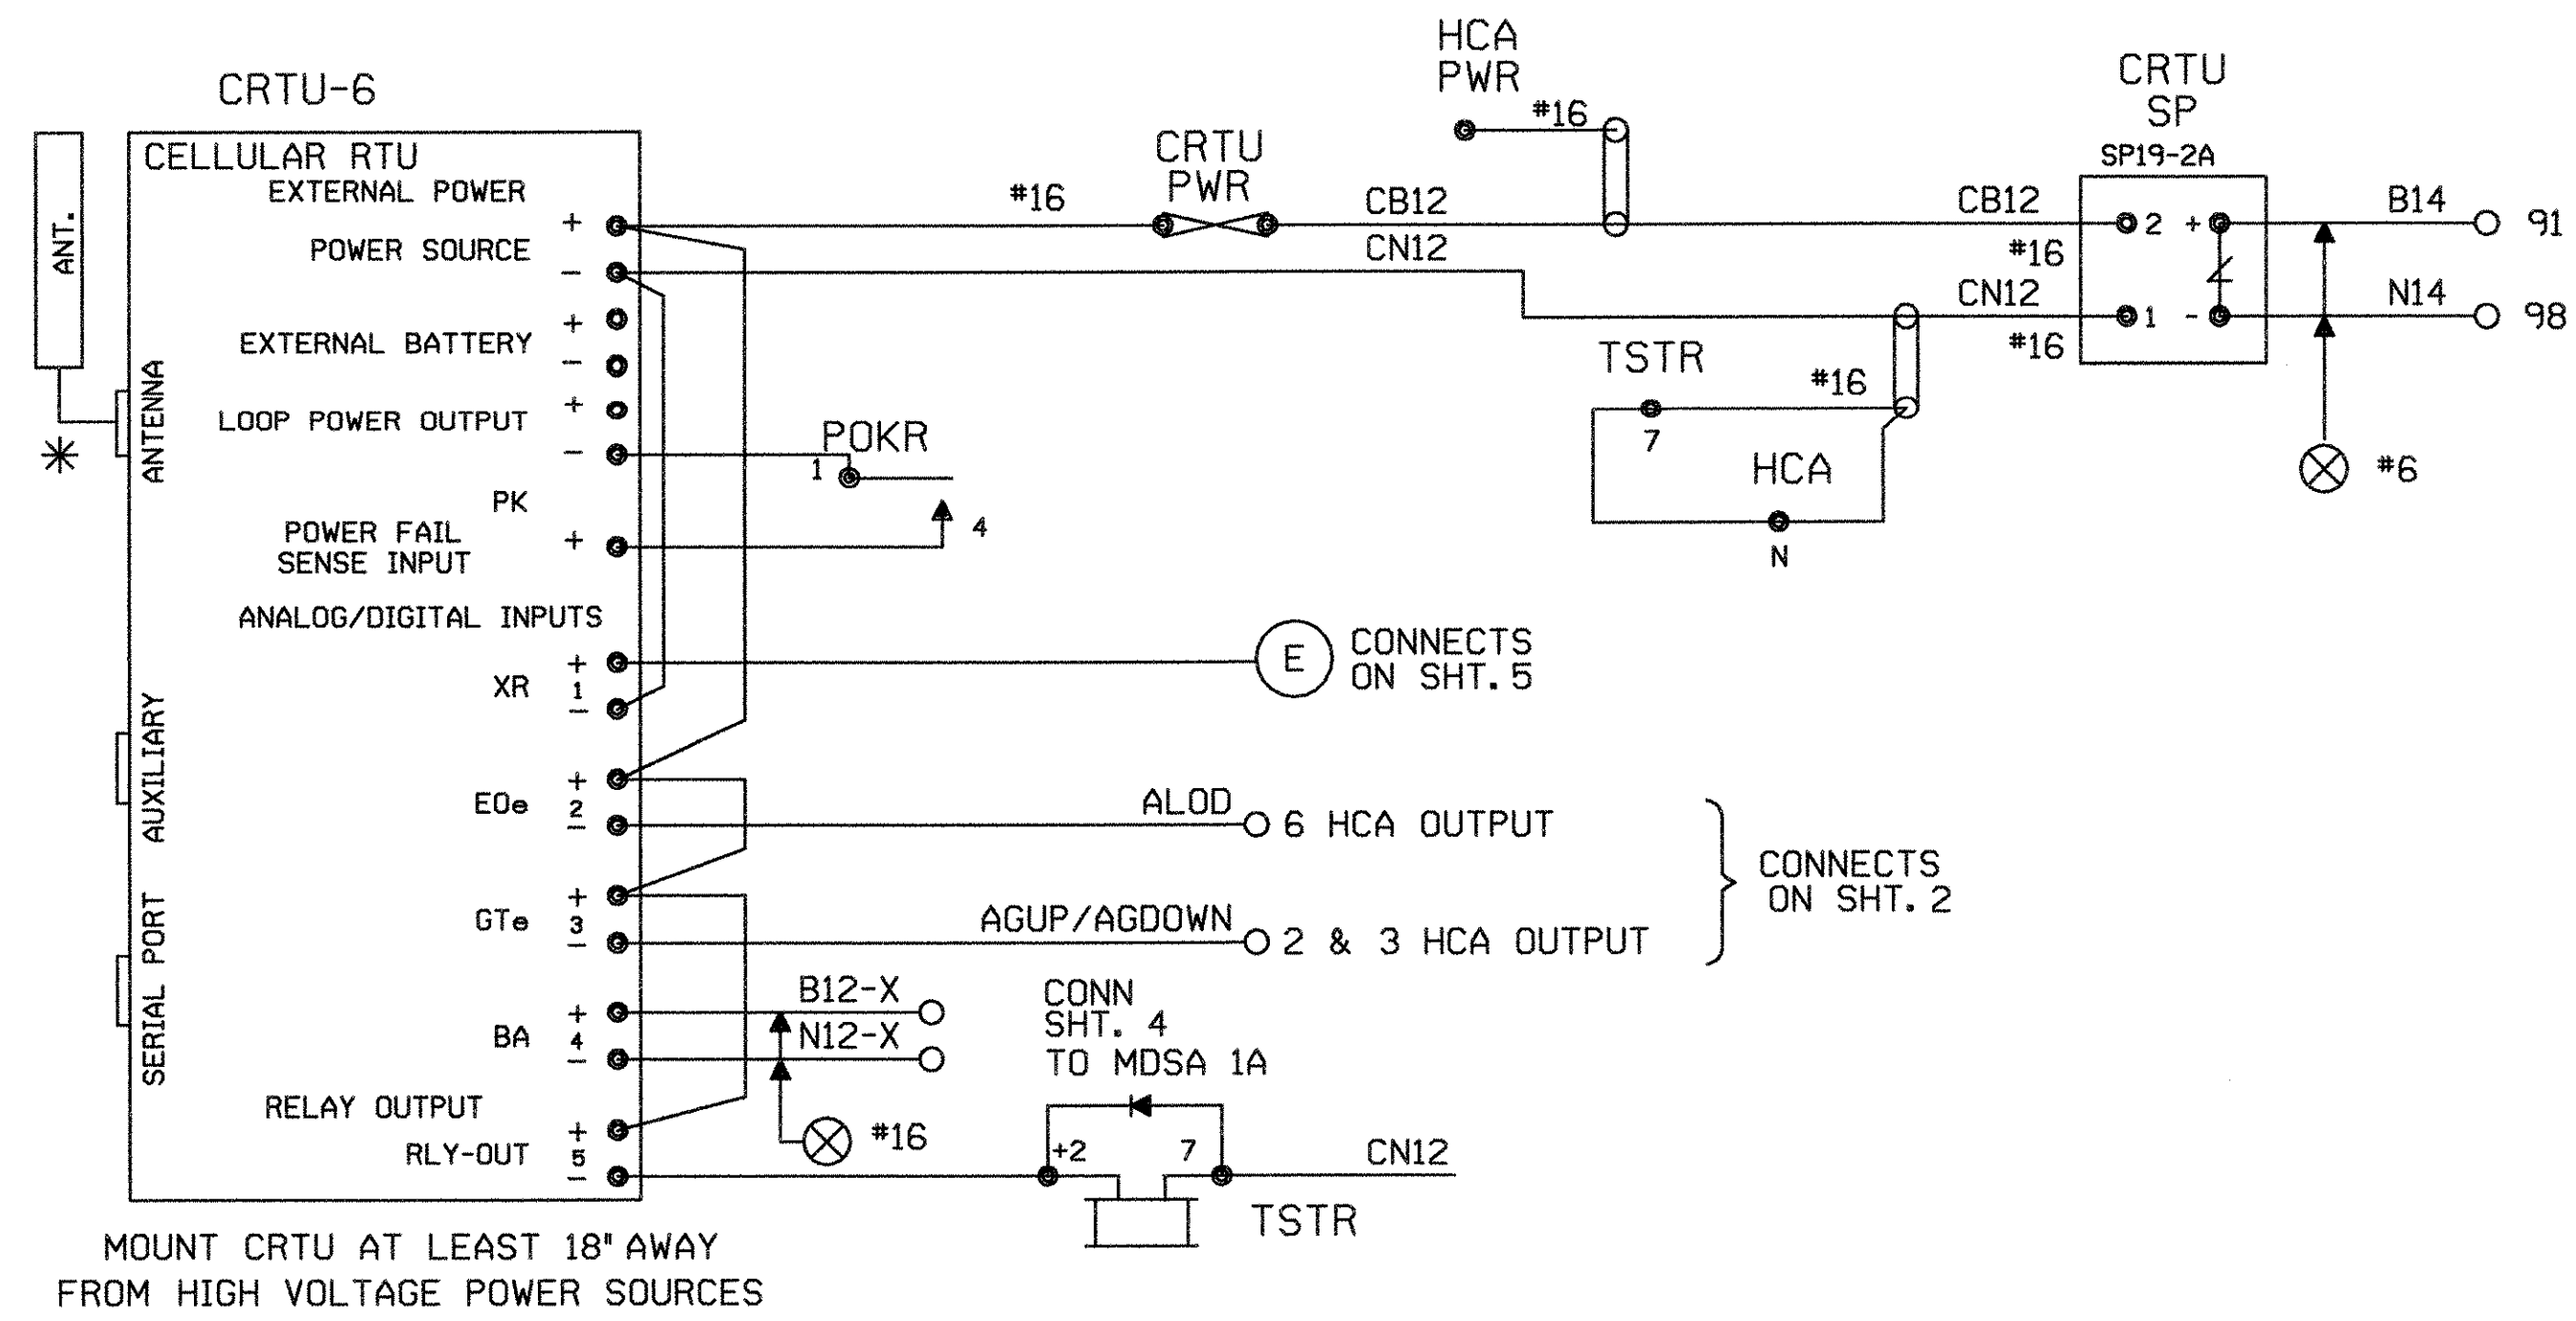

MOUNT CRTU AT LEAST 18" AWAY FROM HIGH VOLTAGE POWER SOURCES

NOTES:
 ALL DIODES 1N5060 OR 1N4004 UNLESS OTHERWISE NOTED.
 * MOUNT ANTENNA ON TOP OF HOUSE.
 ALL WIRES #18 UNLESS OTHERWISE NOTED.
 ALL UNUSED 'NC' INPUTS MUST BE TIED HIGH TO BATTERY
 ALL UNUSED ANALOG INPUTS MUST BE TIED HIGH TO BATTERY
 ALL UNUSED 'NO' INPUTS MUST BE DISCONNECTED
 NORMAL STATE FOR ANALOG CHANNELS IS EQUAL TO THE STORED NOMINAL VOLTAGE +120% OR -81%
 CRTU FRONT PANEL DISPLAY CHART INDICATES NORMAL STATE
 DIGITAL INPUT HIGH, OR DIGITAL INPUT LOW, OR
 POWER FAIL INPUT CLOSED POWER FAIL INPUT OPEN
 L LATCH IS SET BECAUSE CRTU DETECTED AN ALARM CONDITION
 12.06V L
 'sRUN MODE' 'sRUN MODE-SILENT'
 CRTU RADIO IS DISABLED. REPROGRAM CRTU WITH LAPTOP.
 ANALOG AND AC INPUT MODULES MUST BE MOUNTED LESS THAN 12' FROM CRTU

UNIT INSTALLATION AND SETUP

R.R. SITE ID WHERE; SSSS = 4 CHARACTER SUBDIVISION ID. FILL WITH PRECEDING ZEROS AS REQUIRED. THE MAIN TRACK SUBDIVISION ID* IS IN THE CURRENT TIMETABLE. INDUSTRIAL LEADS, LEASED, AND LEAD TRACKS LISTED WITHIN THE SUBDIVISION MAY HAVE THEIR OWN UNIQUE SUBDIVISION ID*. ALWAYS REFER TO CURRENT PRINTED COPY OF THE TIMETABLE. LLLLLLLL = 8 CHARACTERS USE DOT* AT CROSSINGS, AND WLLLLLLL = USE 'WD' THEN MP* AT WAYSIDE LOCATIONS. EXAMPLE = 0785WD1801.5UT HBLLLLLL = USE 'HB' THEN MP* AT HBD SITES. EXAMPLE = 0100-HB55.62TX THE MP* MUST USE A DECIMAL POINT TO SEPARATE NUMBERS. FILL WITH PRECEDING DASHES AS REQUIRED. AA = 2 CHARACTER STATE NAME FOR ALL LOCATIONS. MUST BE 14 CHARACTERS LONG, NO SPACES ALLOWED.	
SITE IDENTIFIER: SSSSLLLLLLLLAA	----247-536RVT
SIGNAL STRENGTH dBm	
CARRIER ID	
FIRMWARE VERSION	2.3.
SERIAL NUMBER	
MIN ASSIGNMENT	
ESN: (MICROBURST ONLY)	
CONFIGURATION NET	CELLEMETRY MICROBURST
SIGNAL STATUS	
SCADANET STATUS	
SILENCE INTERVAL	60 MINUTES
HEALTHCHECK INTERVAL	EVERY 2 DAYS
ALARM DEFER DELAY	240 MINUTES (4 HOURS)
OPERATION TO RESUME: RUN	
CALIBRATION CONSTANT	
CH4	
POWER SOURCE	
FIELD PROVIDES: SAMPLED NOMINAL VOLTAGES, SCADANET STATUS CALIBRATION CONSTANTS, SERIAL NUMBER, AND SIGNAL STATUS.	

CHANNEL SETUP - STANDARD CONFIGURATION 12:XR,EOe,GTe,BA

CHANNEL NORMAL STATE	SENSE (NO/NC)	NAME FUNCTION	RECOGNITION DELAY SECONDS		RETURN TO NORMAL	REPORTING MODE	ALARM LINKED CHANNEL	ALARM LINKED CRITERIA	EVENT LOGGING ENABLED OPTIONS
			ACTIVE	NORMAL					
POWER FAIL (CH5)	POWER FAIL DETECT NO	PF-IN-PK AC POWER FAIL	7,200 ALARM	300 NORMAL	ENABLED	ALERT	DISABLED	N/A	
CH1	DIGITAL INPUT NO	CH1-XR XR DOWN TO LONG	1,800 ALARM	1 NORMAL	ENABLED	ALERT	DISABLED	N/A	
CH2	DIGITAL INPUT NO	CH2-EOe LIGHT OUT	120 ALARM	10 NORMAL	ENABLED	ALERT	DISABLED	N/A	
CH3	DIGITAL INPUT NO	CH3-GTe GATES NOT UP/DOWN	120 ALARM	10 NORMAL	ENABLED	ALERT	DISABLED	N/A	
CH4 STORED NOMINAL VOLTAGE	ANALOG INPUT N/A	CH4-BA/V BATTERY MONITOR BATTERY LOW	300 ALARM	300 NORMAL	DISABLED	ALERT W/UPDATE	DISABLED	N/A	
POWER SOURCE (CH6)	ANALOG INPUT N/A	PS-BA/V BATTERY MONITOR BATTERY LOW	300 ALARM	300 NORMAL	DISABLED	ALERT W/UPDATE	DISABLED	N/A	
ANALOG CHANNEL	USEFUL RANGE VOLTS	DISPLAYED RANGE VOLTS	RELATIVE ALARM POINT	ABSOLUTE ALARM POINT	AUTOMATIC UPDATE INTERVAL	STORED NOMINAL VOLTAGE	SAMPLED NOMINAL VOLTAGE		
CH4	0.0 30.00	0.0 30.00	81% 120%	10.0 29.0	10 DAYS	12.69			
POWER SOURCE	0.0 30.00	0.0 30.00	81% 120%	10.0 29.0	10 DAYS	12.69			
RELAY OUTPUT	NAME RLY-OUT	ACTIVE SET-UP-OPEN	NORMAL CLR-DN-CLOSE	PULSE DURATION	15 SECONDS	CHARTS REV'D 2-1-02			

MAINTENANCE OPERATIONS

TO START OR ABORT ANY PROCEDURE	
1. PRESS THE 'CANCEL' BUTTON FIRST	
WHEN RESPONDING TO A CALL, PUT THE CRTU IN THE 'SILENCE ALARMS' MODE	
1. PRESS 'SELECT' AND THEN '+ ARROW' BUTTON UNTIL DISPLAY: ACTION? SILENCE ALARMS	
2. PRESS THE 'SELECT' BUTTON TWICE	
3. CORRECT PROBLEM AND SIMULATE NORMAL TRAIN MOVEMENT THROUGH THE LOCATION	
4. EXAMINE EACH CHANNEL ON THE CRTU	
5. PRESS THE '+/- ARROW' BUTTON	
VERIFY ALL CHANNELS INDICATE A NORMAL STATE	
NORMAL STATES ARE ON THE CHANNEL SETUP CHART	
CLEAR TIMERS, LATCHES AND SEND ALL NORMAL	
1. DO STEPS #1 - #5 ABOVE, AND PRESS 'CANCEL'.	
2. PRESS 'SELECT' AND THEN '- ARROW' BUTTON UNTIL DISPLAY: ACTION? SERVICE MODE	
3. PRESS 'SELECT' AGAIN TO RESET TIMERS, AND IF DISPLAY: SERVICE MODE ALL NORMAL	
4. PRESS 'SELECT' AGAIN TO CLEAR LATCHES, AND SEND ALL NORMAL. SKIP STEPS #5-#6.	
5. HOWEVER, IF ALARMS ARE NOT CLEARED; DISPLAY: SERVICE MODE ALARMS PENDING/PRESENT	
6. PRESS 'CANCEL', CORRECT PROBLEM AND REPEAT STEPS #2 THRU #5 UNTIL ALL NORMAL SENT.	
TO CANCEL THE 'SILENCE ALARMS' MODE	
1. PRESS 'SELECT' AND THEN '+ ARROW' BUTTON UNTIL DISPLAY: ACTION? CANCEL SILENCE	
2. PRESS THE 'SELECT' BUTTON AGAIN	
EXAMINE & SET BATTERY VOLTAGE NOMINAL VALUE	
1. PRESS THE '+ ARROW' OR '- ARROW' BUTTON UNTIL THE DESIRED CHANNEL IS DISPLAYED. DISPLAY: PS-BA 13.83V NORMAL	
2. VERIFY THE DISPLAYED READING WITH A DIGITAL VOLTMETER	
3. PRESS THE 'SELECT' BUTTON, AND THE CRTU DISPLAY WILL SWITCH BETWEEN CURRENT/SAVED NOMINAL VOLTAGE VALUES. DISPLAY: NOMINAL ON *6? (CURRENT) 13.83	
DISPLAY: SAVED NOMINAL 6 (STORED) 12.69	
4. PRESS THE 'SELECT' BUTTON AND THE CURRENT OR 'NOMINAL ON' VALUE WILL BE SAMPLED AND STORED AS THE 'SAVED NOMINAL' VALUE	
5. VERIFY THE 'NOMINAL ON' AND 'SAVED NOMINAL' VALUES ARE EQUIVALENT, REPEAT STEPS #1 THRU #3 & PRESS THE 'CANCEL' BUTTON.	


DOT* 247-536R SIGNAL CRTU DIAGRAM

PROJECT NAME:	SHARON GRADE CROSSING
PROJECT NUMBER:	STP2034 (13)S
FILE NAME:	SHT28.DGN
PROJECT LEADER:	H. PATEL
DESIGNED BY:	R. CARROLL
PLOT DATE:	06/13/03
DRAWN BY:	A. BOSE
CHECKED BY:	G. SERGOT
SHEET	27 OF 35




ORIGINAL PREPARED:	
DATE	REVISIONS
	BY

NOT TO SCALE

09:12:20 AM 06/13/03 M:\18737s_vt_rail_xina\SHARON_CROSSING\dgn_SHT27.dgn

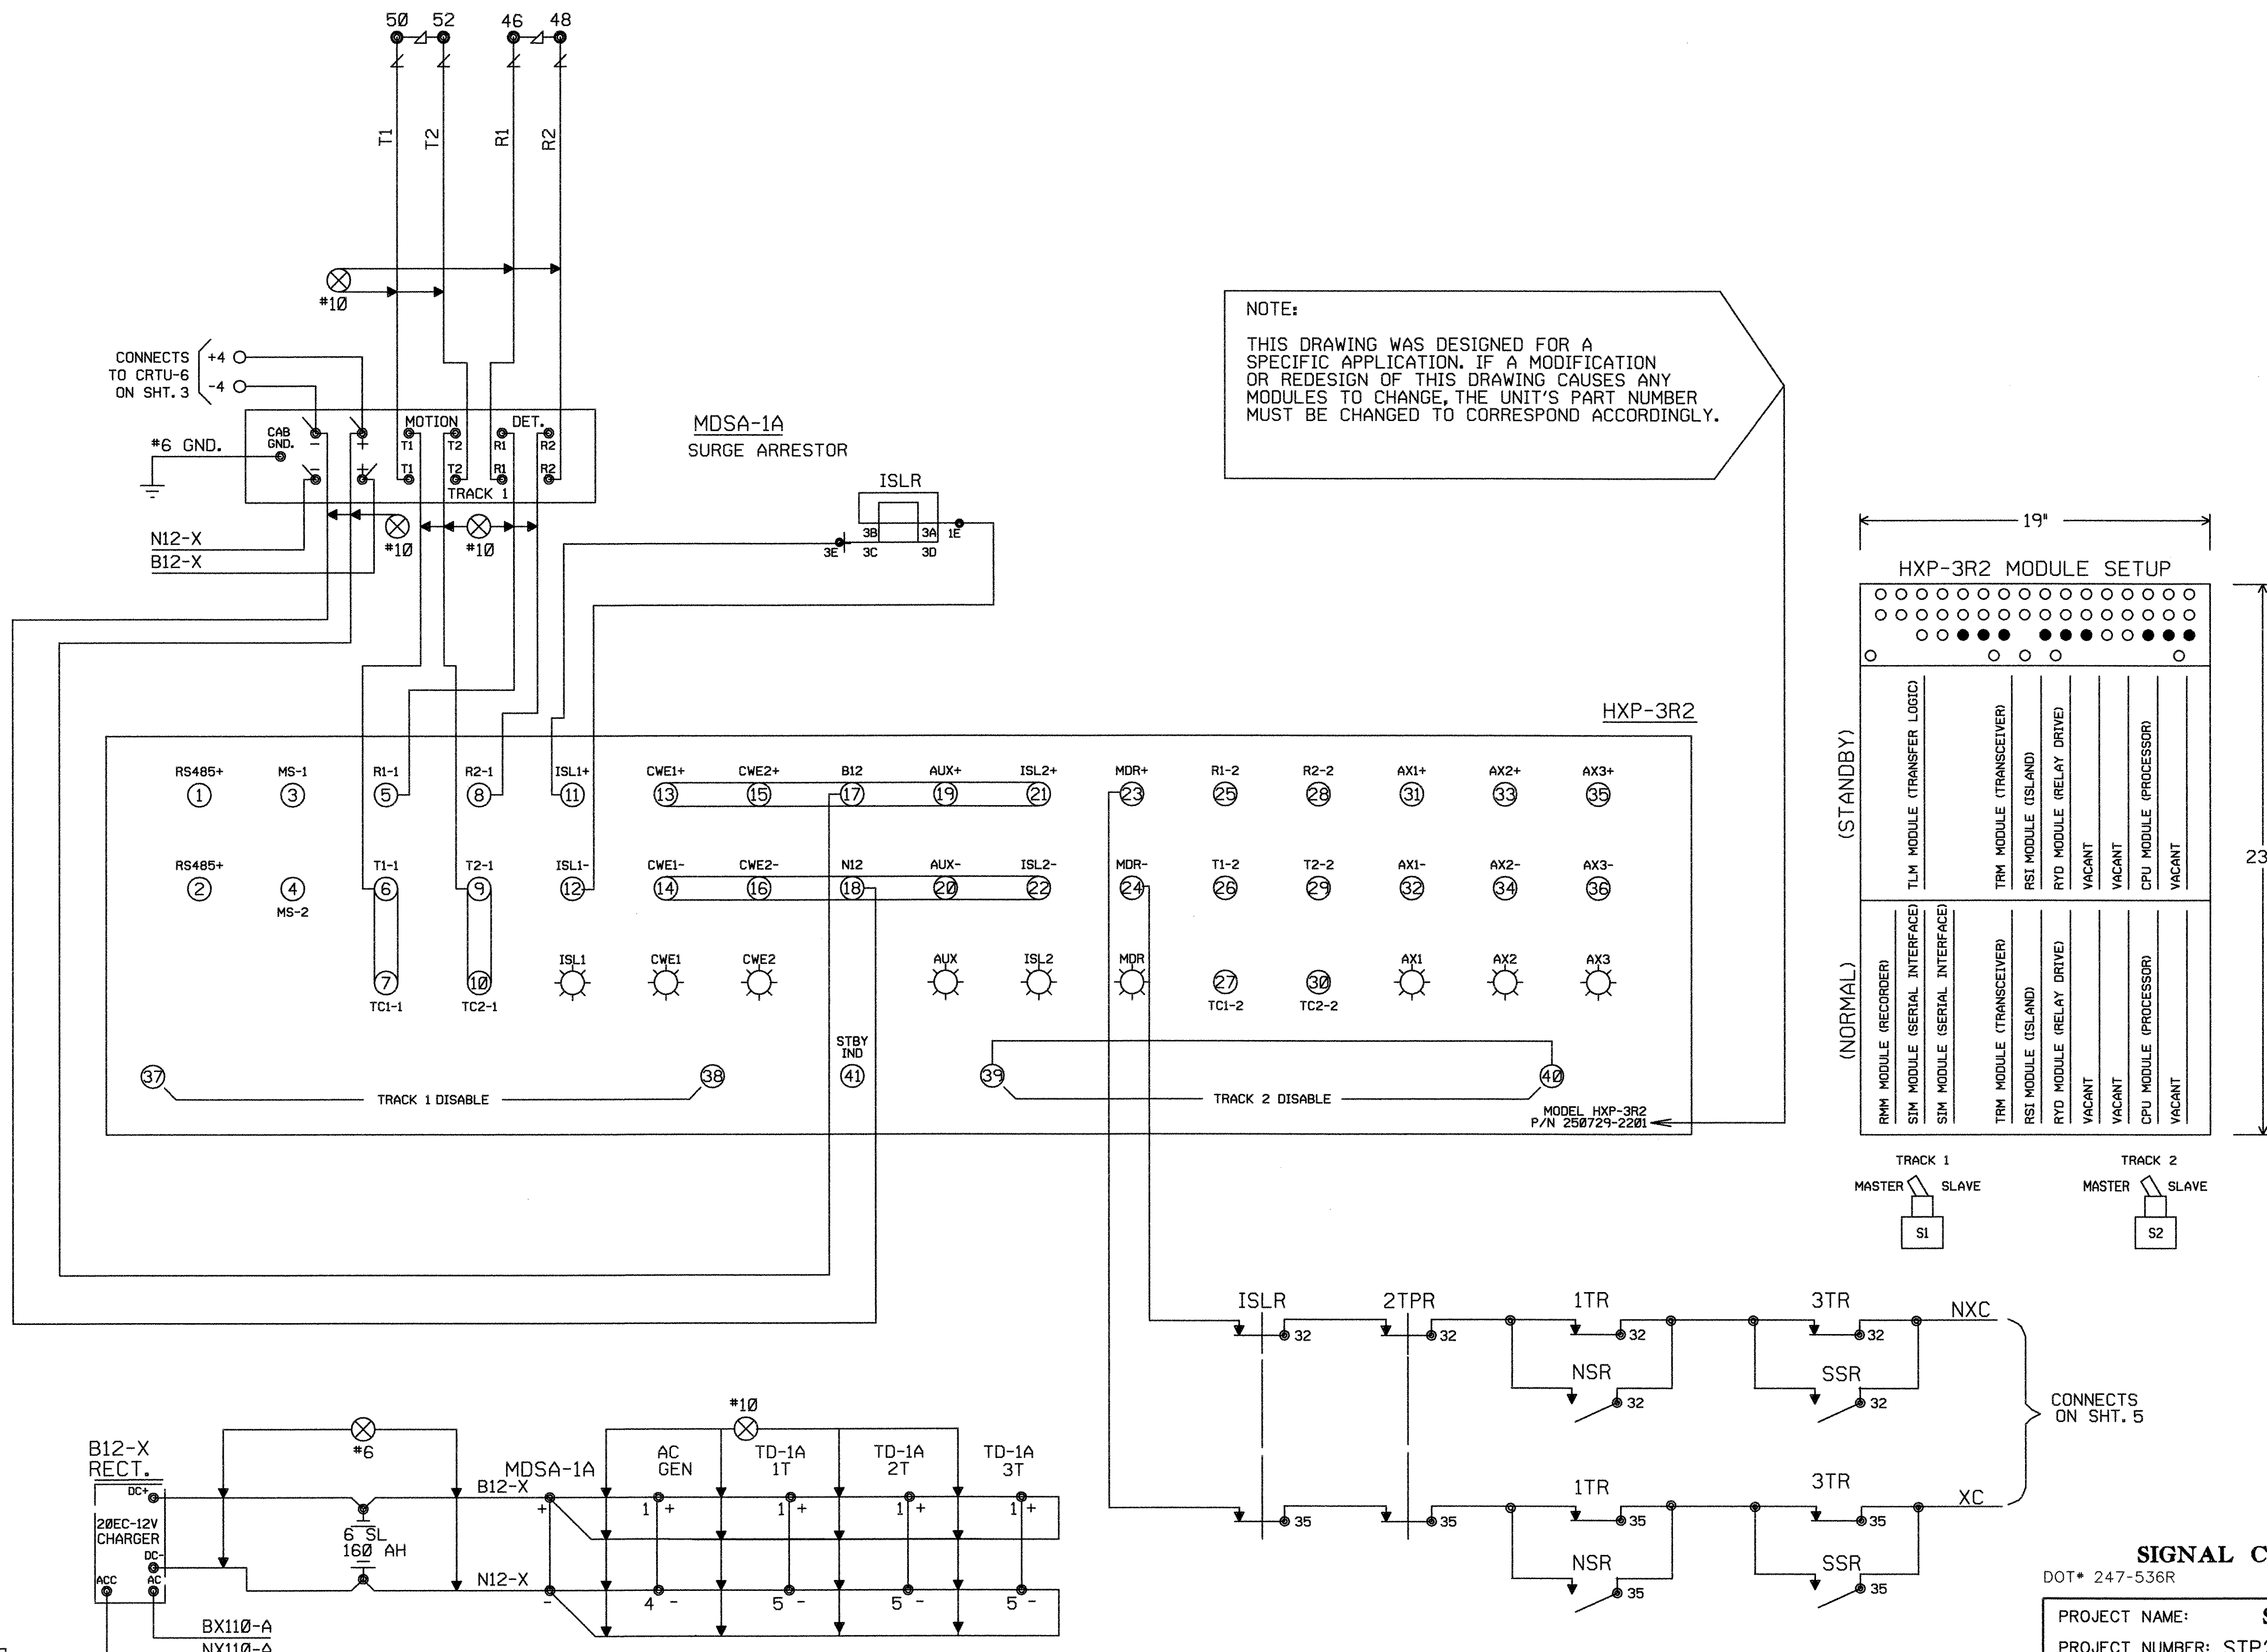

NOTE:
 THIS DRAWING WAS DESIGNED FOR A SPECIFIC APPLICATION. IF A MODIFICATION OR REDESIGN OF THIS DRAWING CAUSES ANY MODULES TO CHANGE, THE UNIT'S PART NUMBER MUST BE CHANGED TO CORRESPOND ACCORDINGLY.

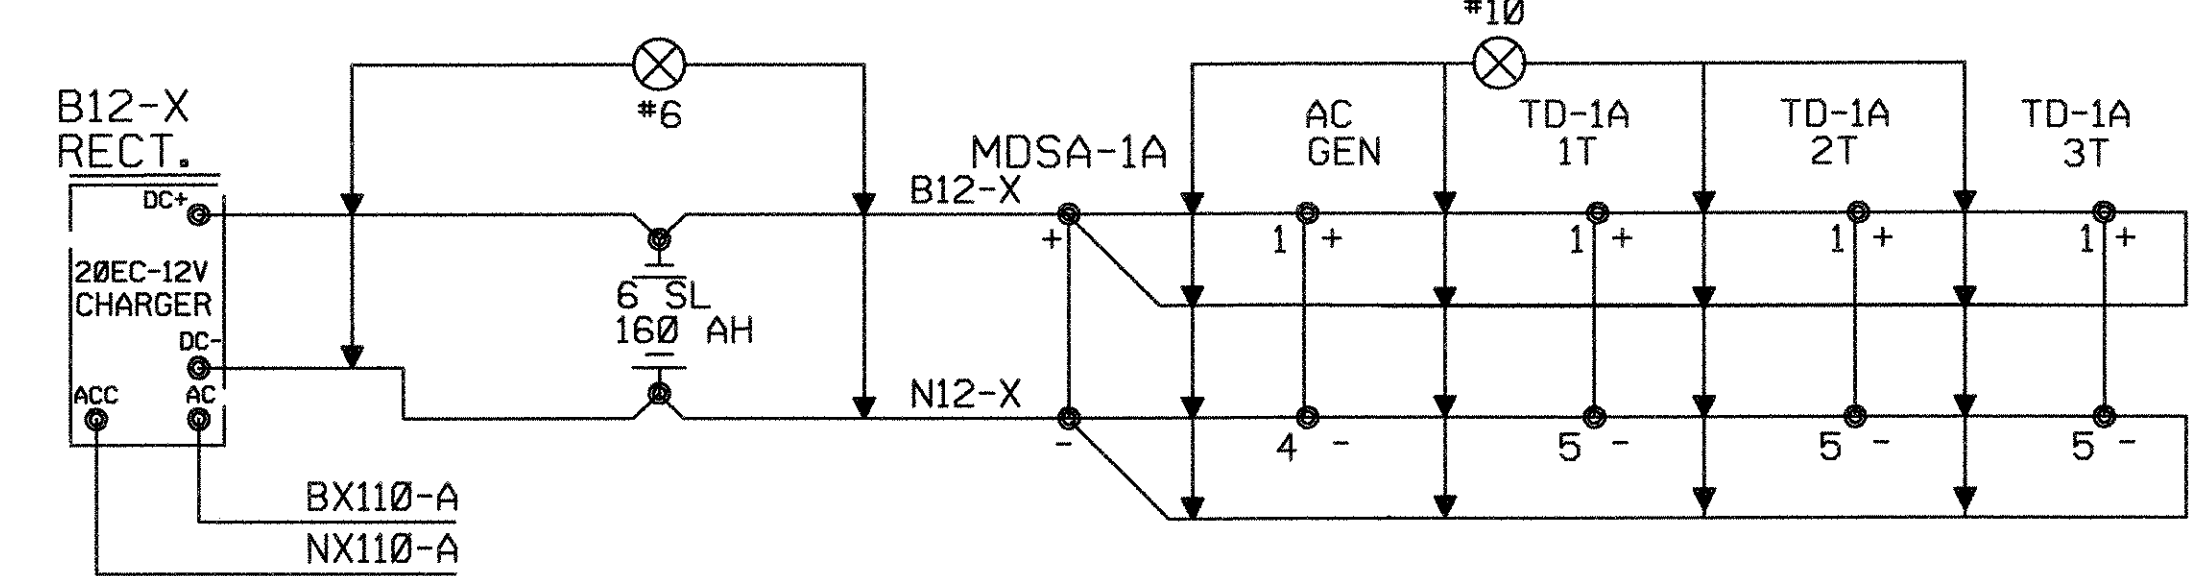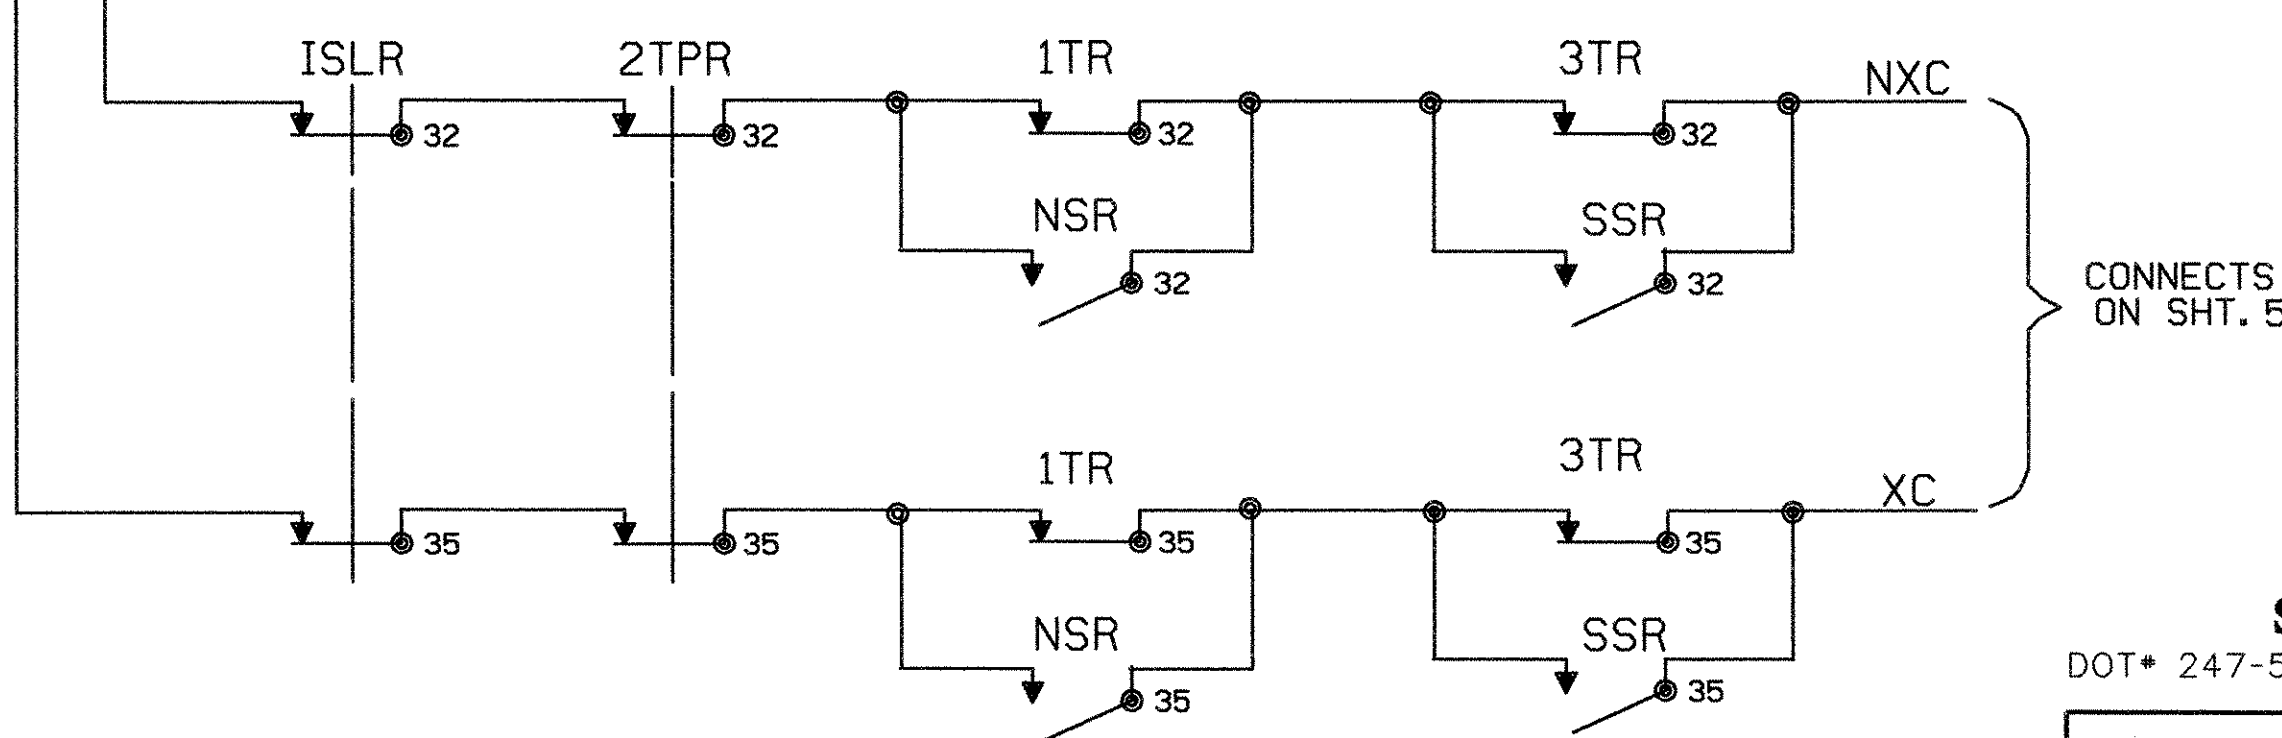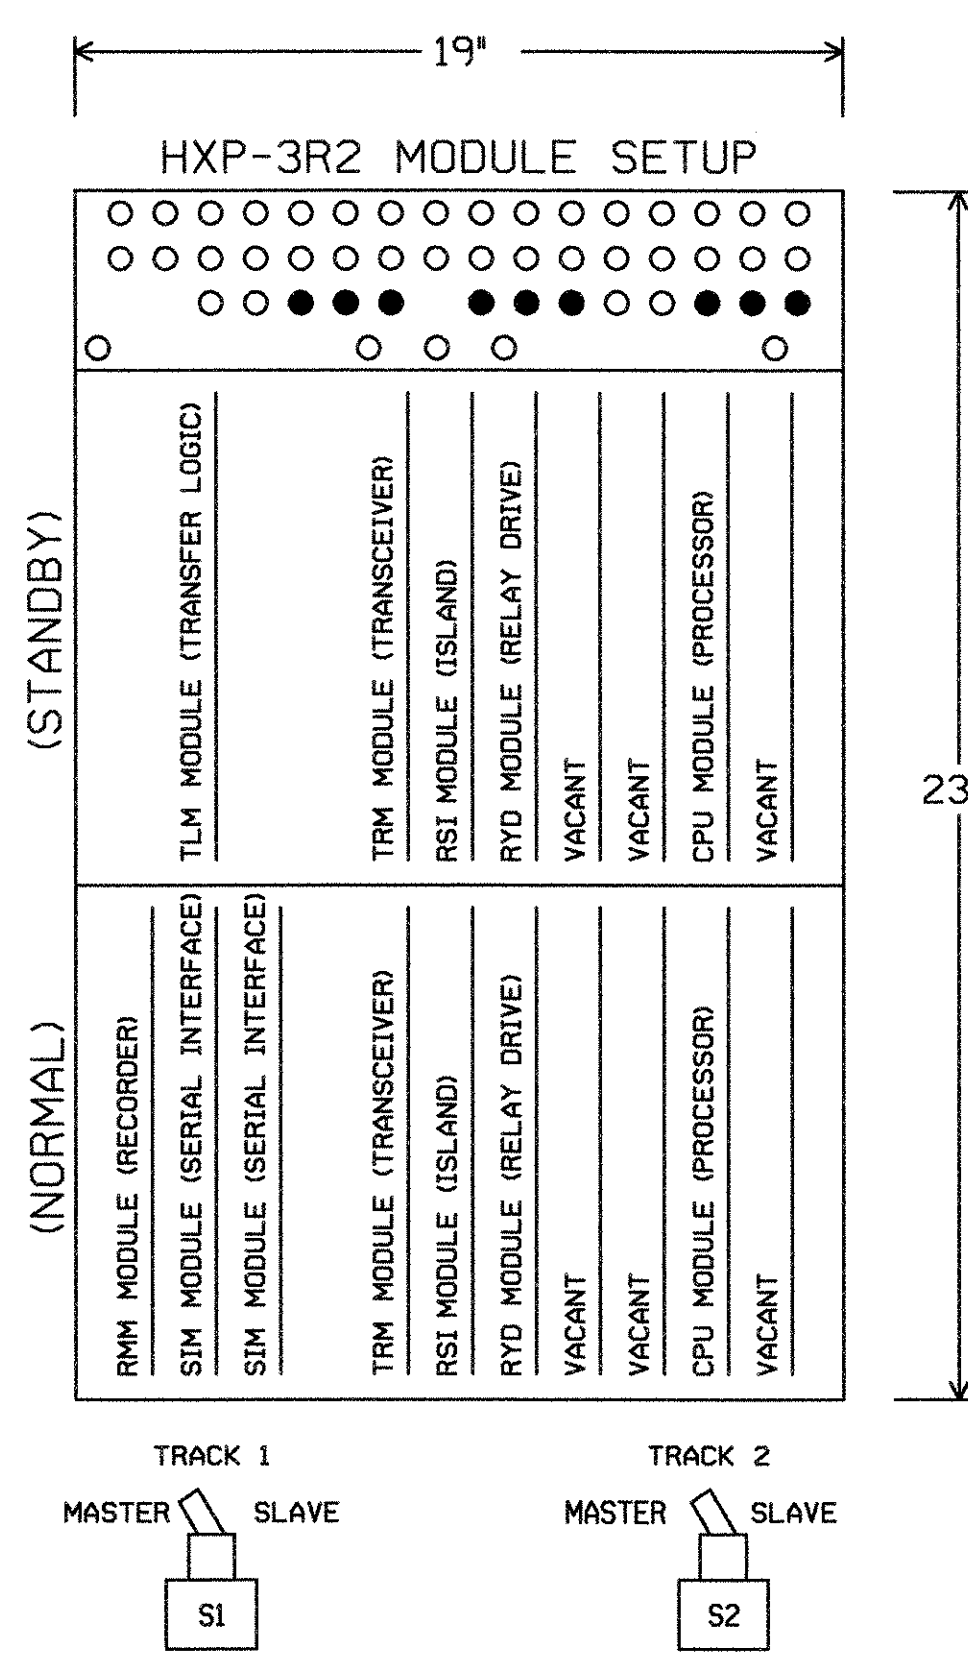



DATUM
 VERTICAL NAVD88 ± 0.5 FT.
 HORIZONTAL SPC 1983

ORIGINAL PREPARED:		
DATE	REVISIONS	BY

NOT TO SCALE

SIGNAL CONTROL UNIT DIAGRAM
 DOT# 247-536R
 PROJECT NAME: SHARON GRADE CROSSING
 PROJECT NUMBER: STP2034 (13)S
 FILE NAME: SHT29.DGN
 PROJECT LEADER: H. PATEL
 DESIGNED BY: R. CARROLL
 PLOT DATE: 06/13/03
 DRAWN BY: A. BOSE
 CHECKED BY: G. SERGOT
 SHEET 28 OF 35

08:12:56 AM
 06/13/03
 M:\187373.vt.rail\sharon_crossing.dgn\SHT28.dgn

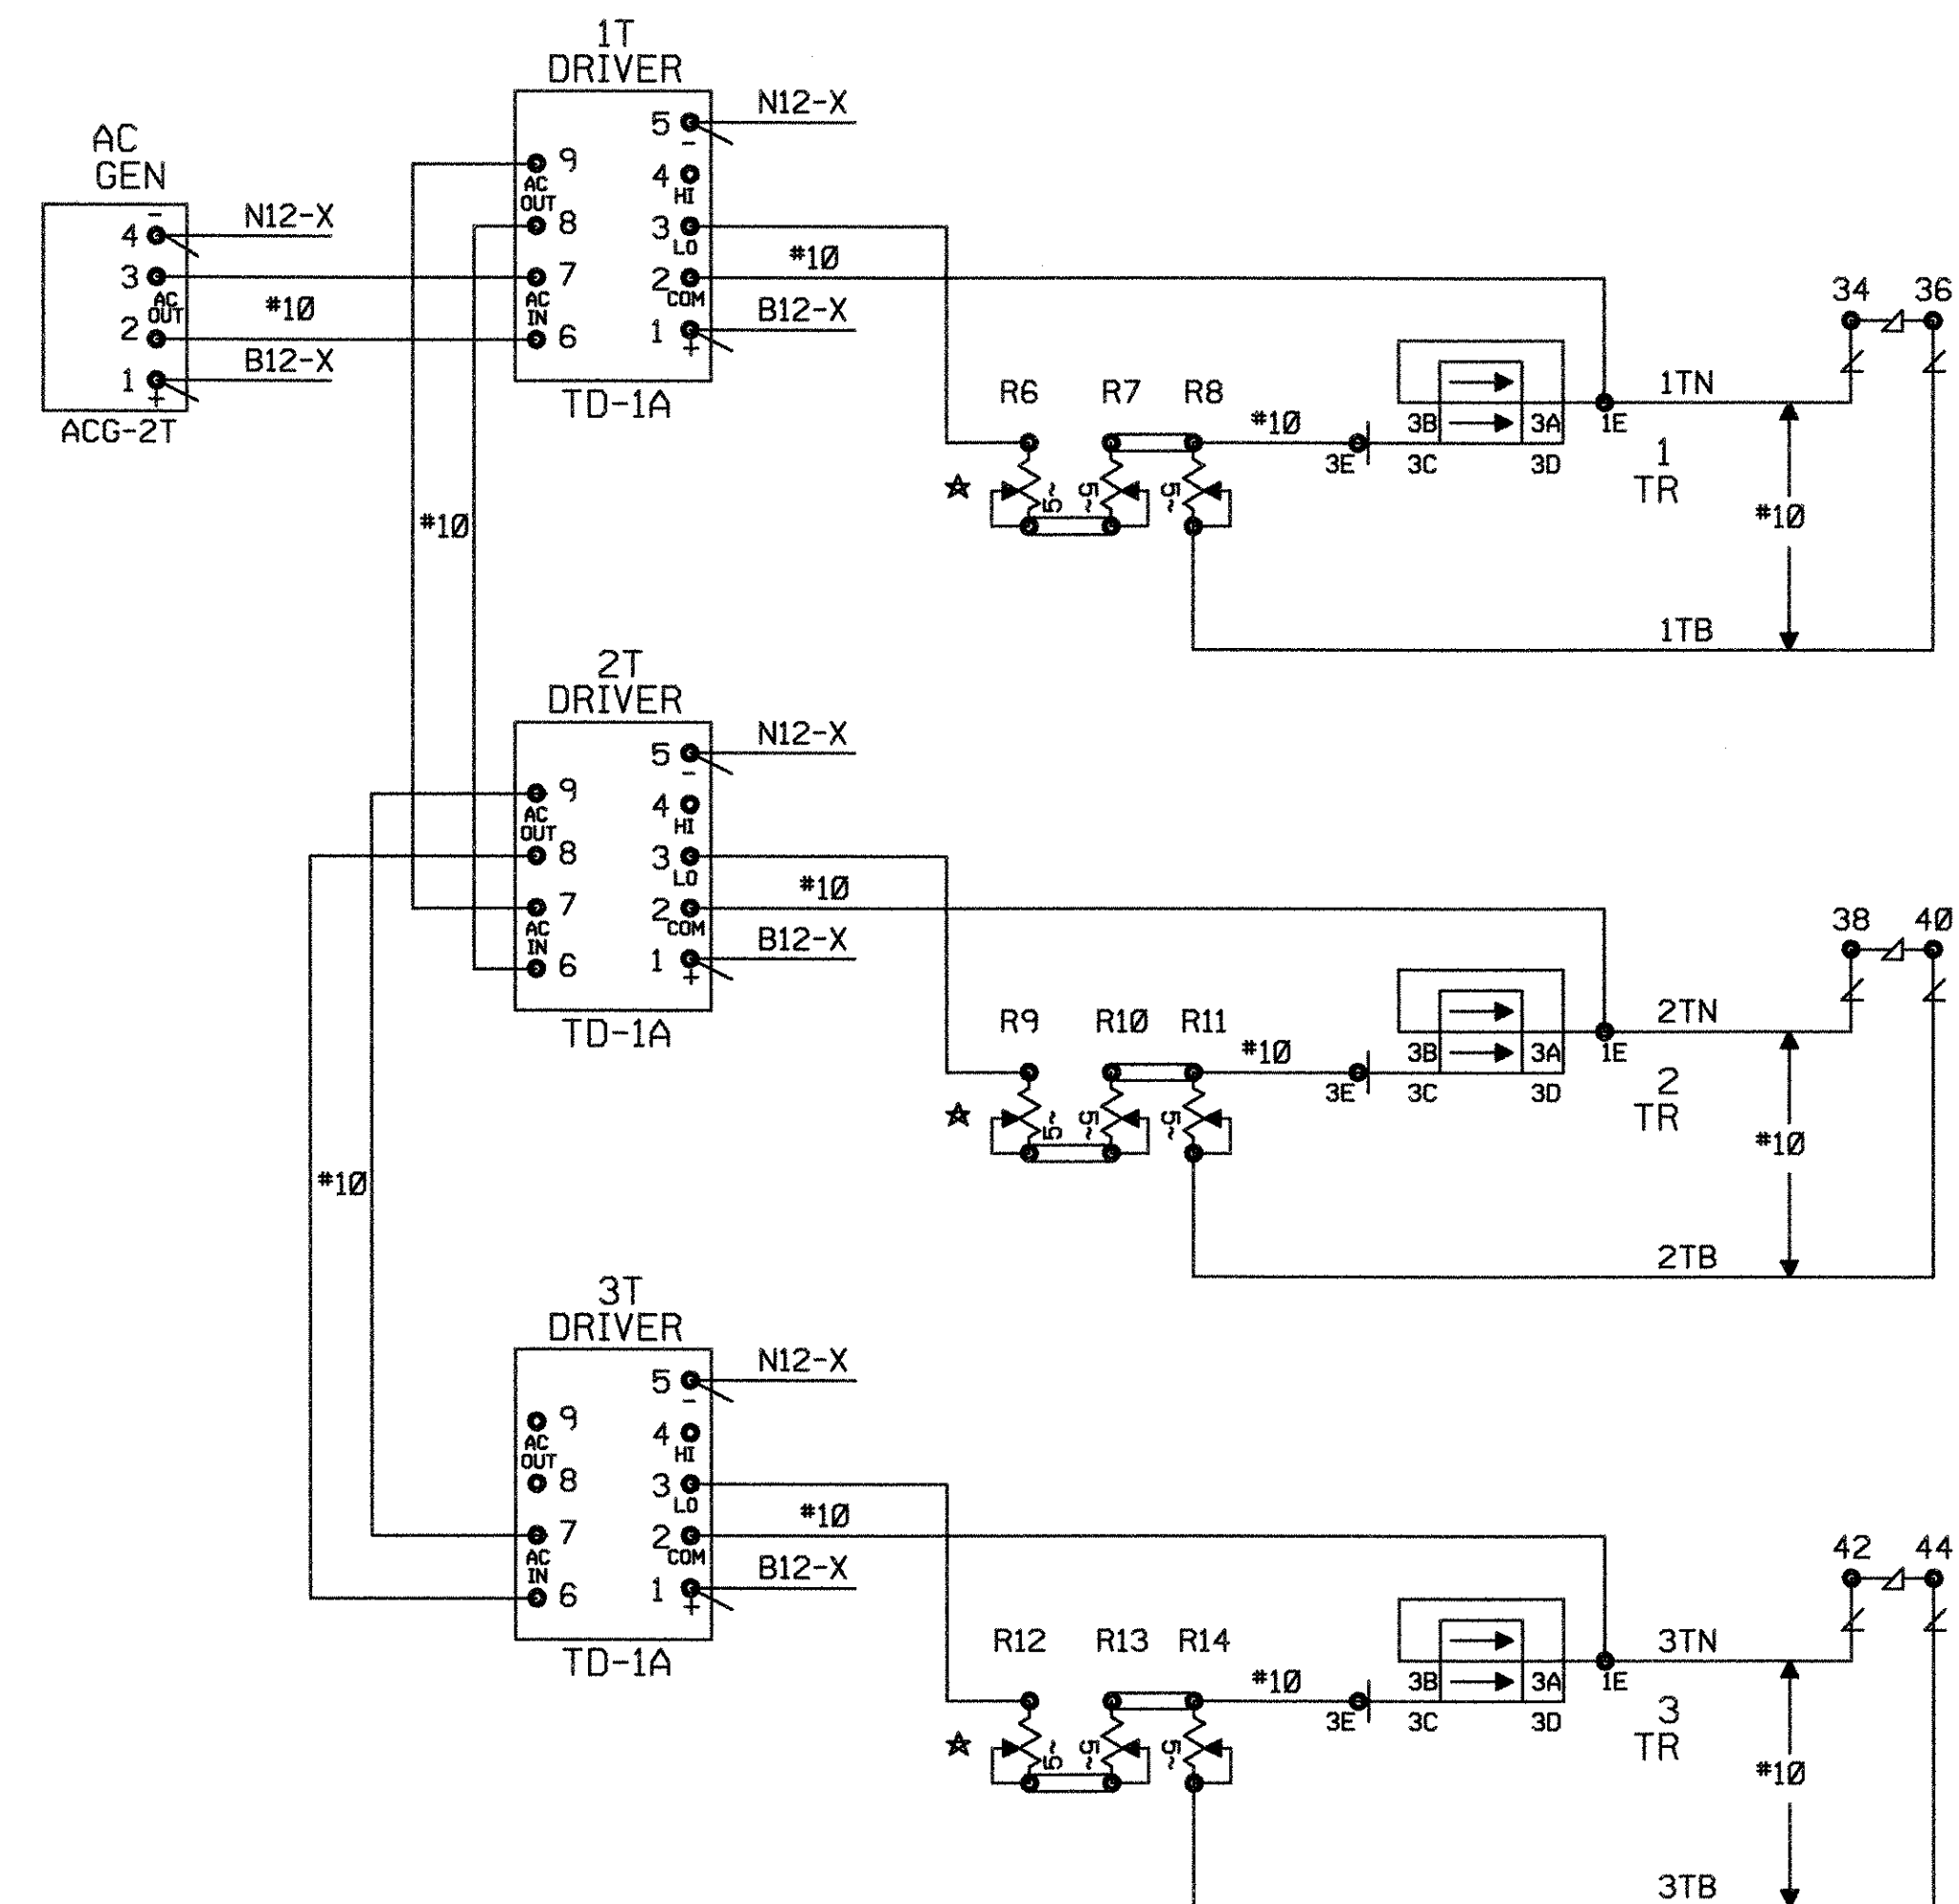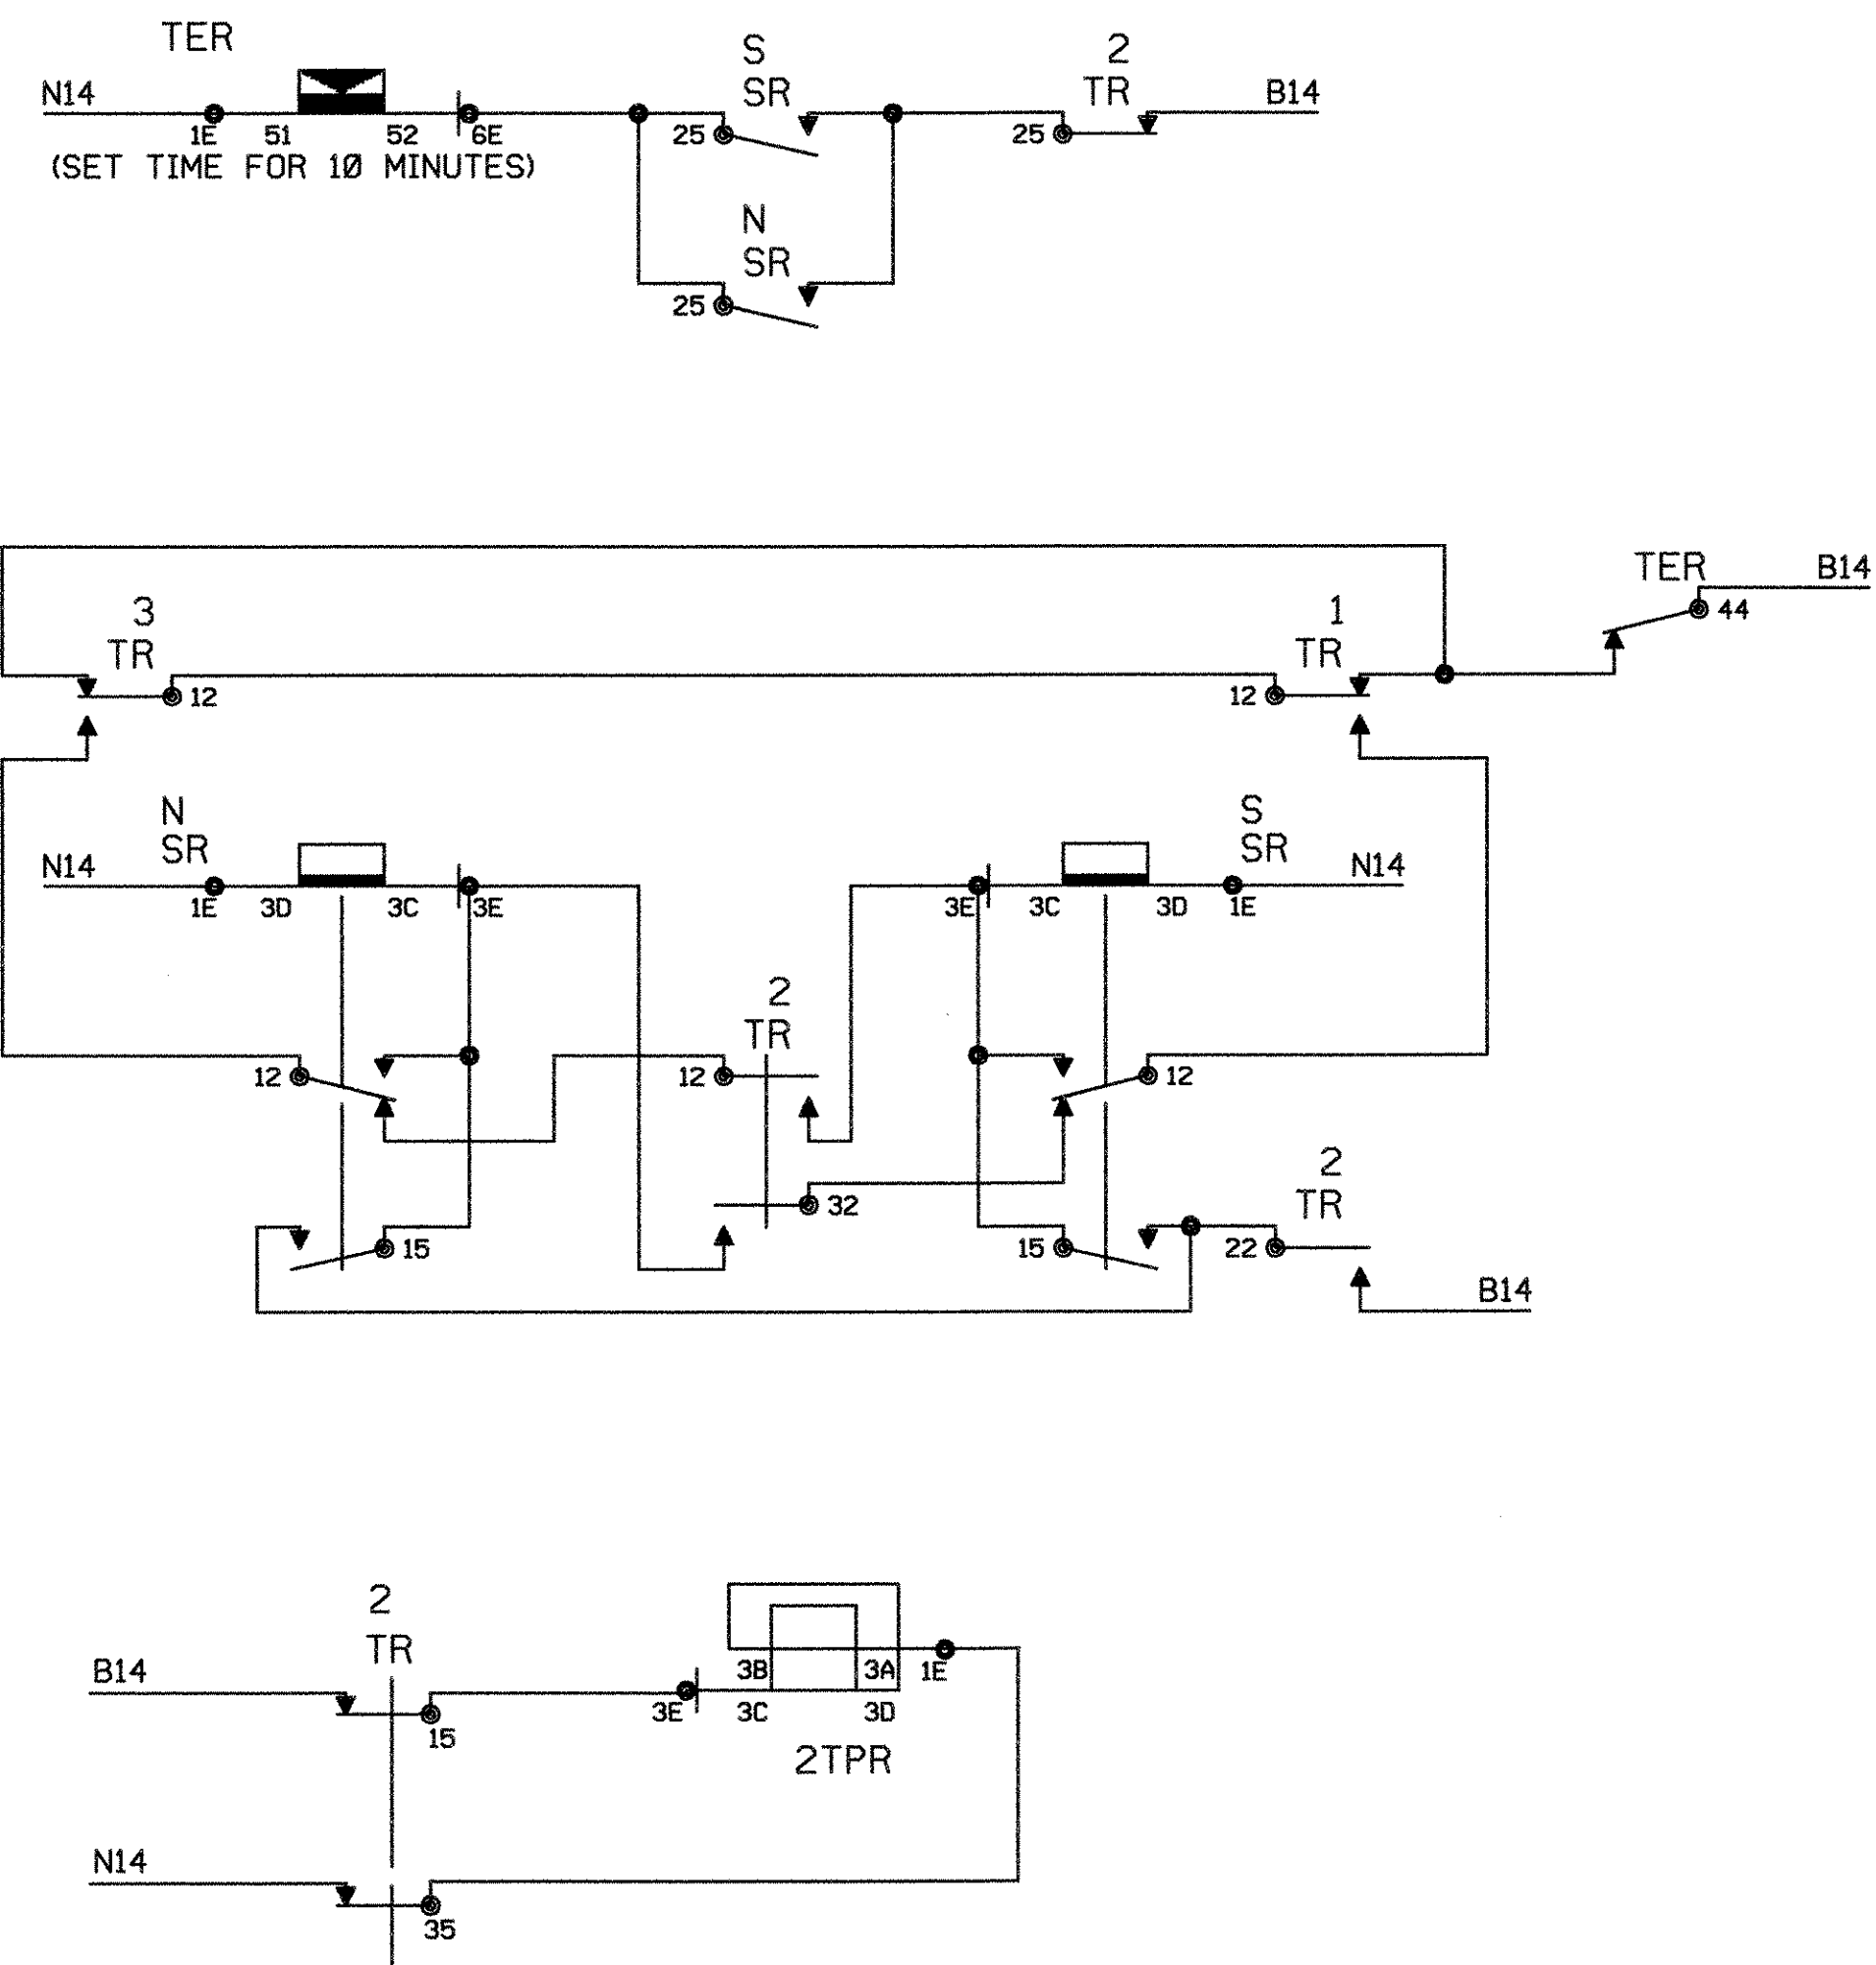

CROSSING SIGNAL CIRCUITS DIAGRAM

DOT# 247-536R


PROJECT NAME:	SHARON GRADE CROSSING	
PROJECT NUMBER:	STP2034 (13)S	
FILE NAME:	SHT30.DGN	PLOT DATE: 06/13/03
PROJECT LEADER:	H. PATEL	DRAWN BY: A. BOSE
DESIGNED BY:	R. CARROLL	CHECKED BY: G. SERGOT
		SHEET 29 OF 35

ORIGINAL PREPARED:		
DATE	REVISIONS	BY

NOT TO SCALE

06/13/03 11:51 AM
 M:\18737s_v1.rdl\SHARON_CROSSING.dgn\SH29.DGN

DATUM	
VERTICAL	NAVD88 ± 0.5 FT.
HORIZONTAL	SPC 1983

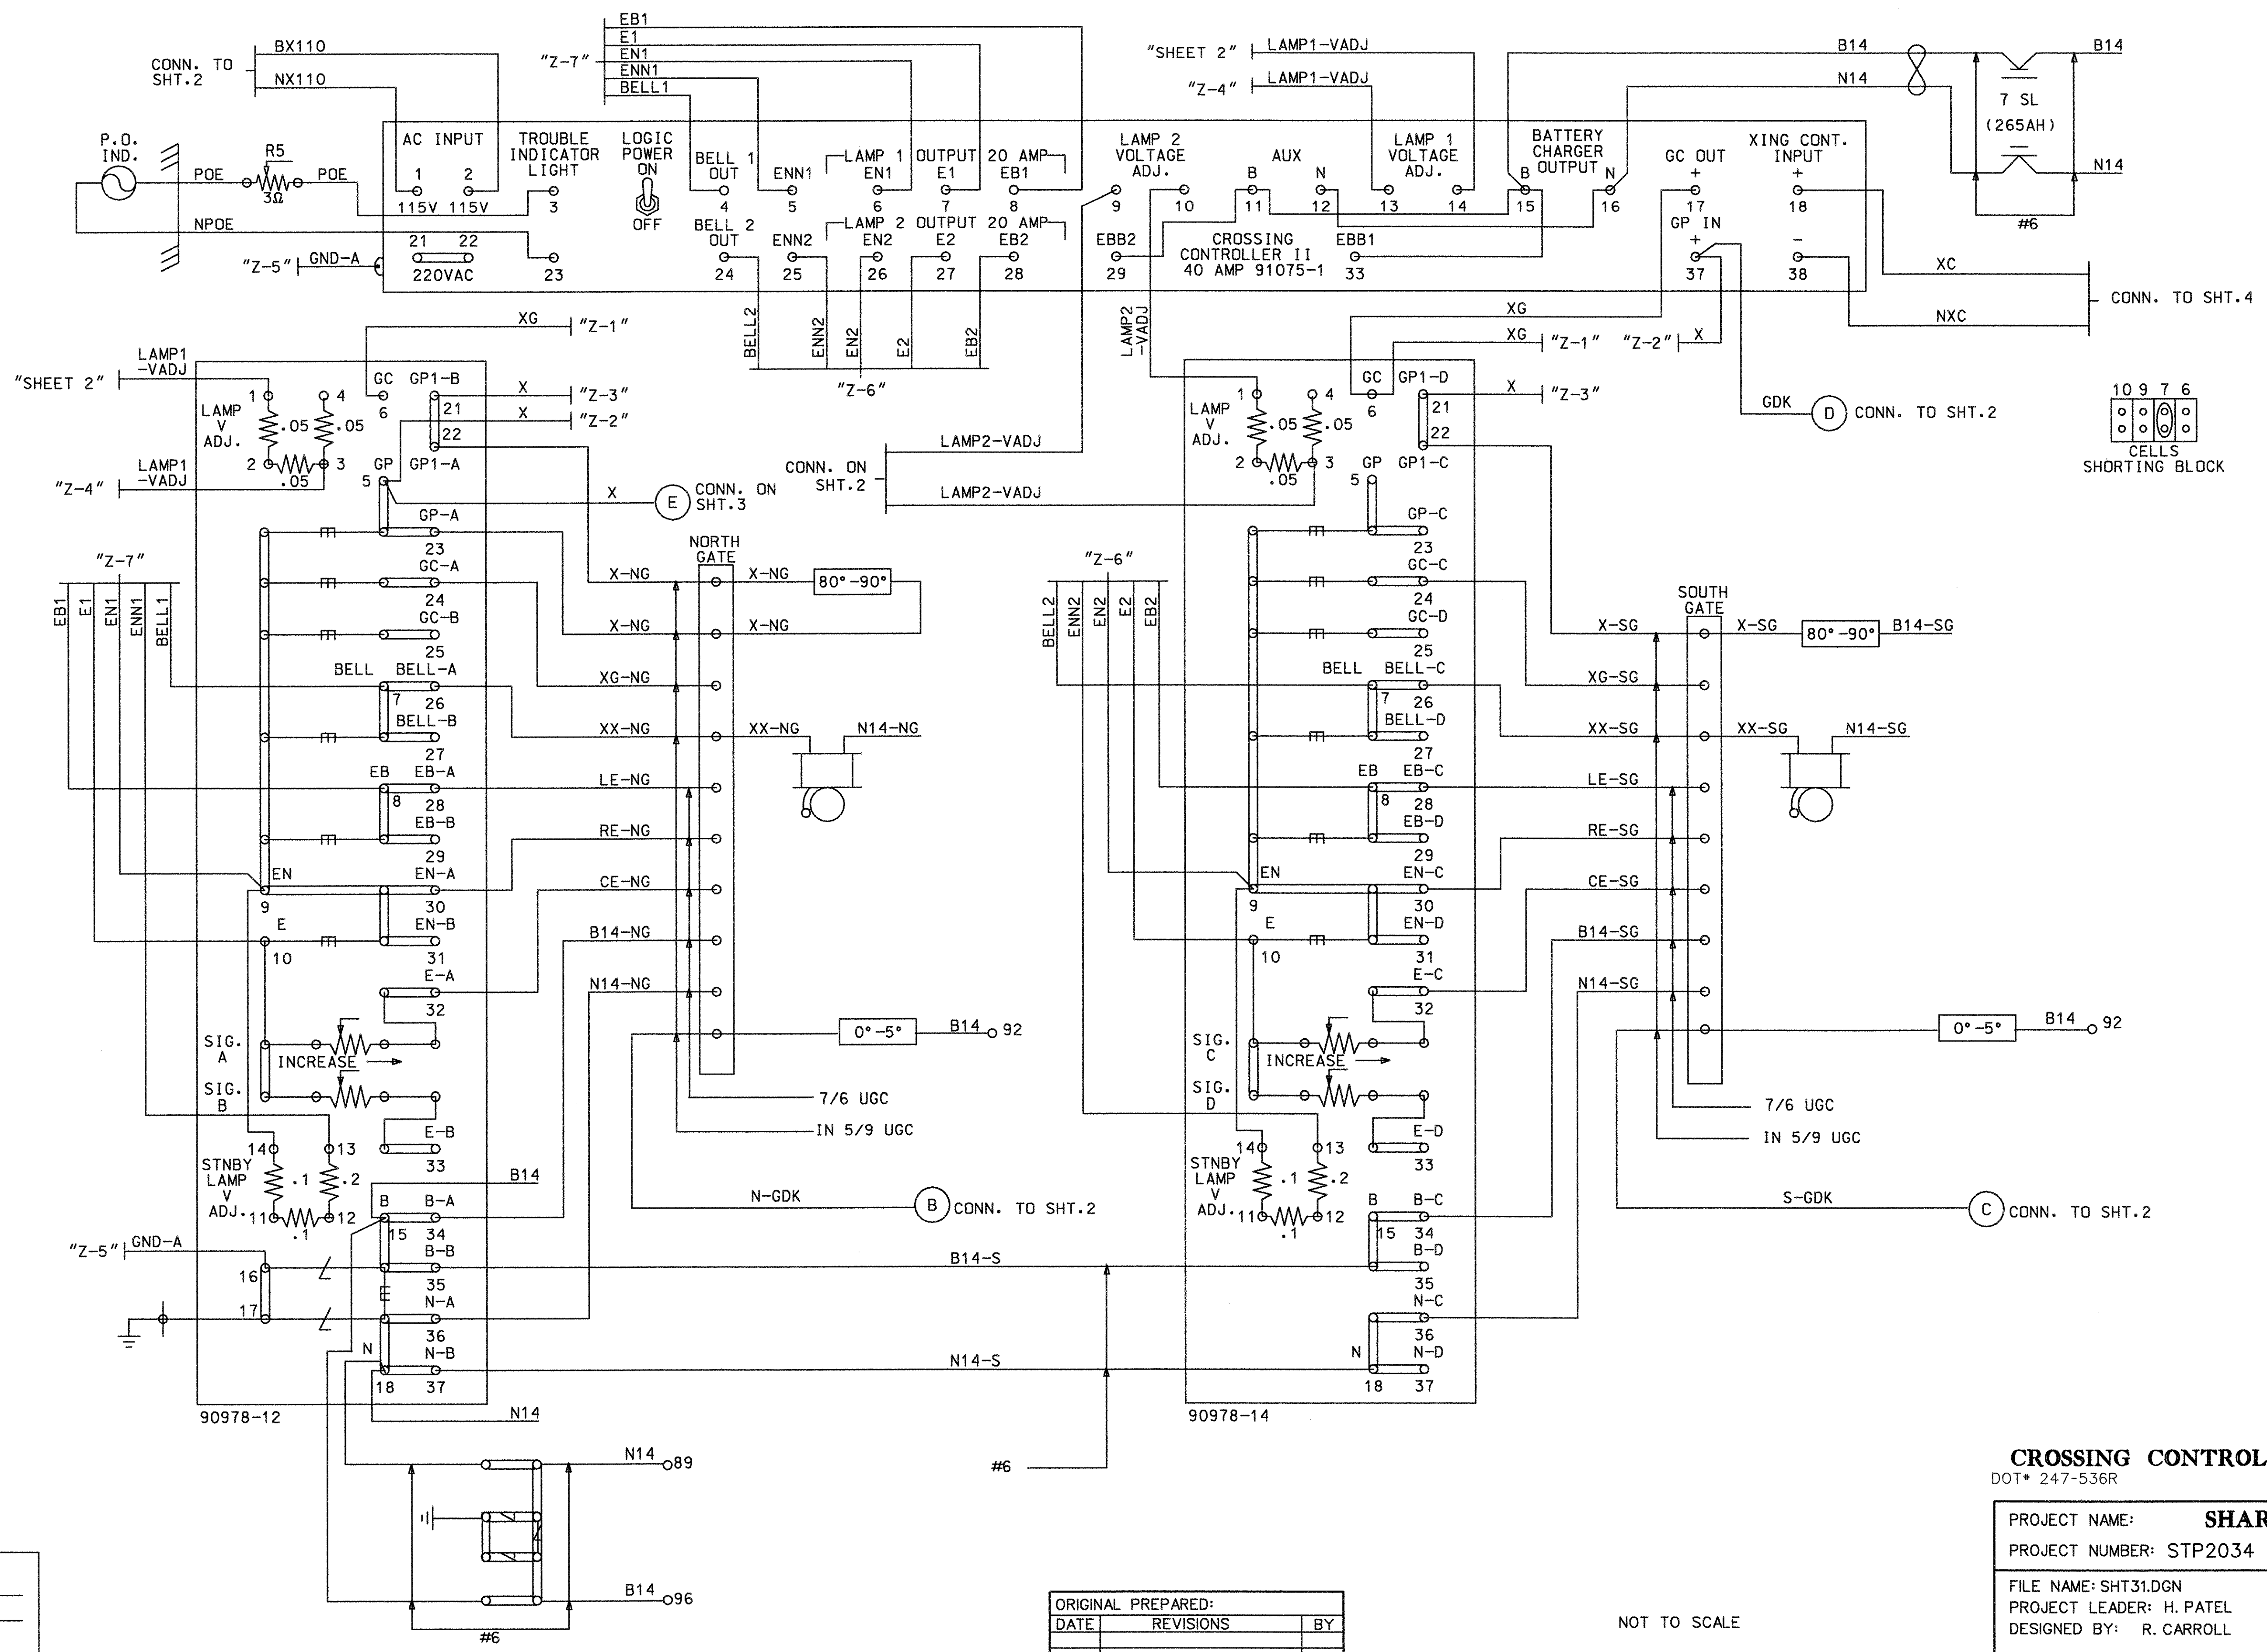

CROSSING CONTROLLER CIRCUITS DIAGRAM
DOT 247-536R

PROJECT NAME:	SHARON GRADE CROSSING	
PROJECT NUMBER:	STP2034 (13)S	
FILE NAME:	SHT31.DGN	PLOT DATE: 06/13/03
PROJECT LEADER:	H. PATEL	DRAWN BY: A. BOSE
DESIGNED BY:	R. CARROLL	CHECKED BY: G. SERGOT
		SHEET 30 OF 35


ORIGINAL PREPARED:		
DATE	REVISIONS	BY

NOT TO SCALE


DATUM
VERTICAL NAVD88 ± 0.5 FT.
HORIZONTAL SPC 1983

06/13/03 AM
 06/13/03
 M:\187378_vt_rail_xing\SHARON_CROSSING.dgn\SHT30.dgn


SAFETRAN PRODUCTS MODEL 'S' MECHANISM MOTOR & SNUB RELAY

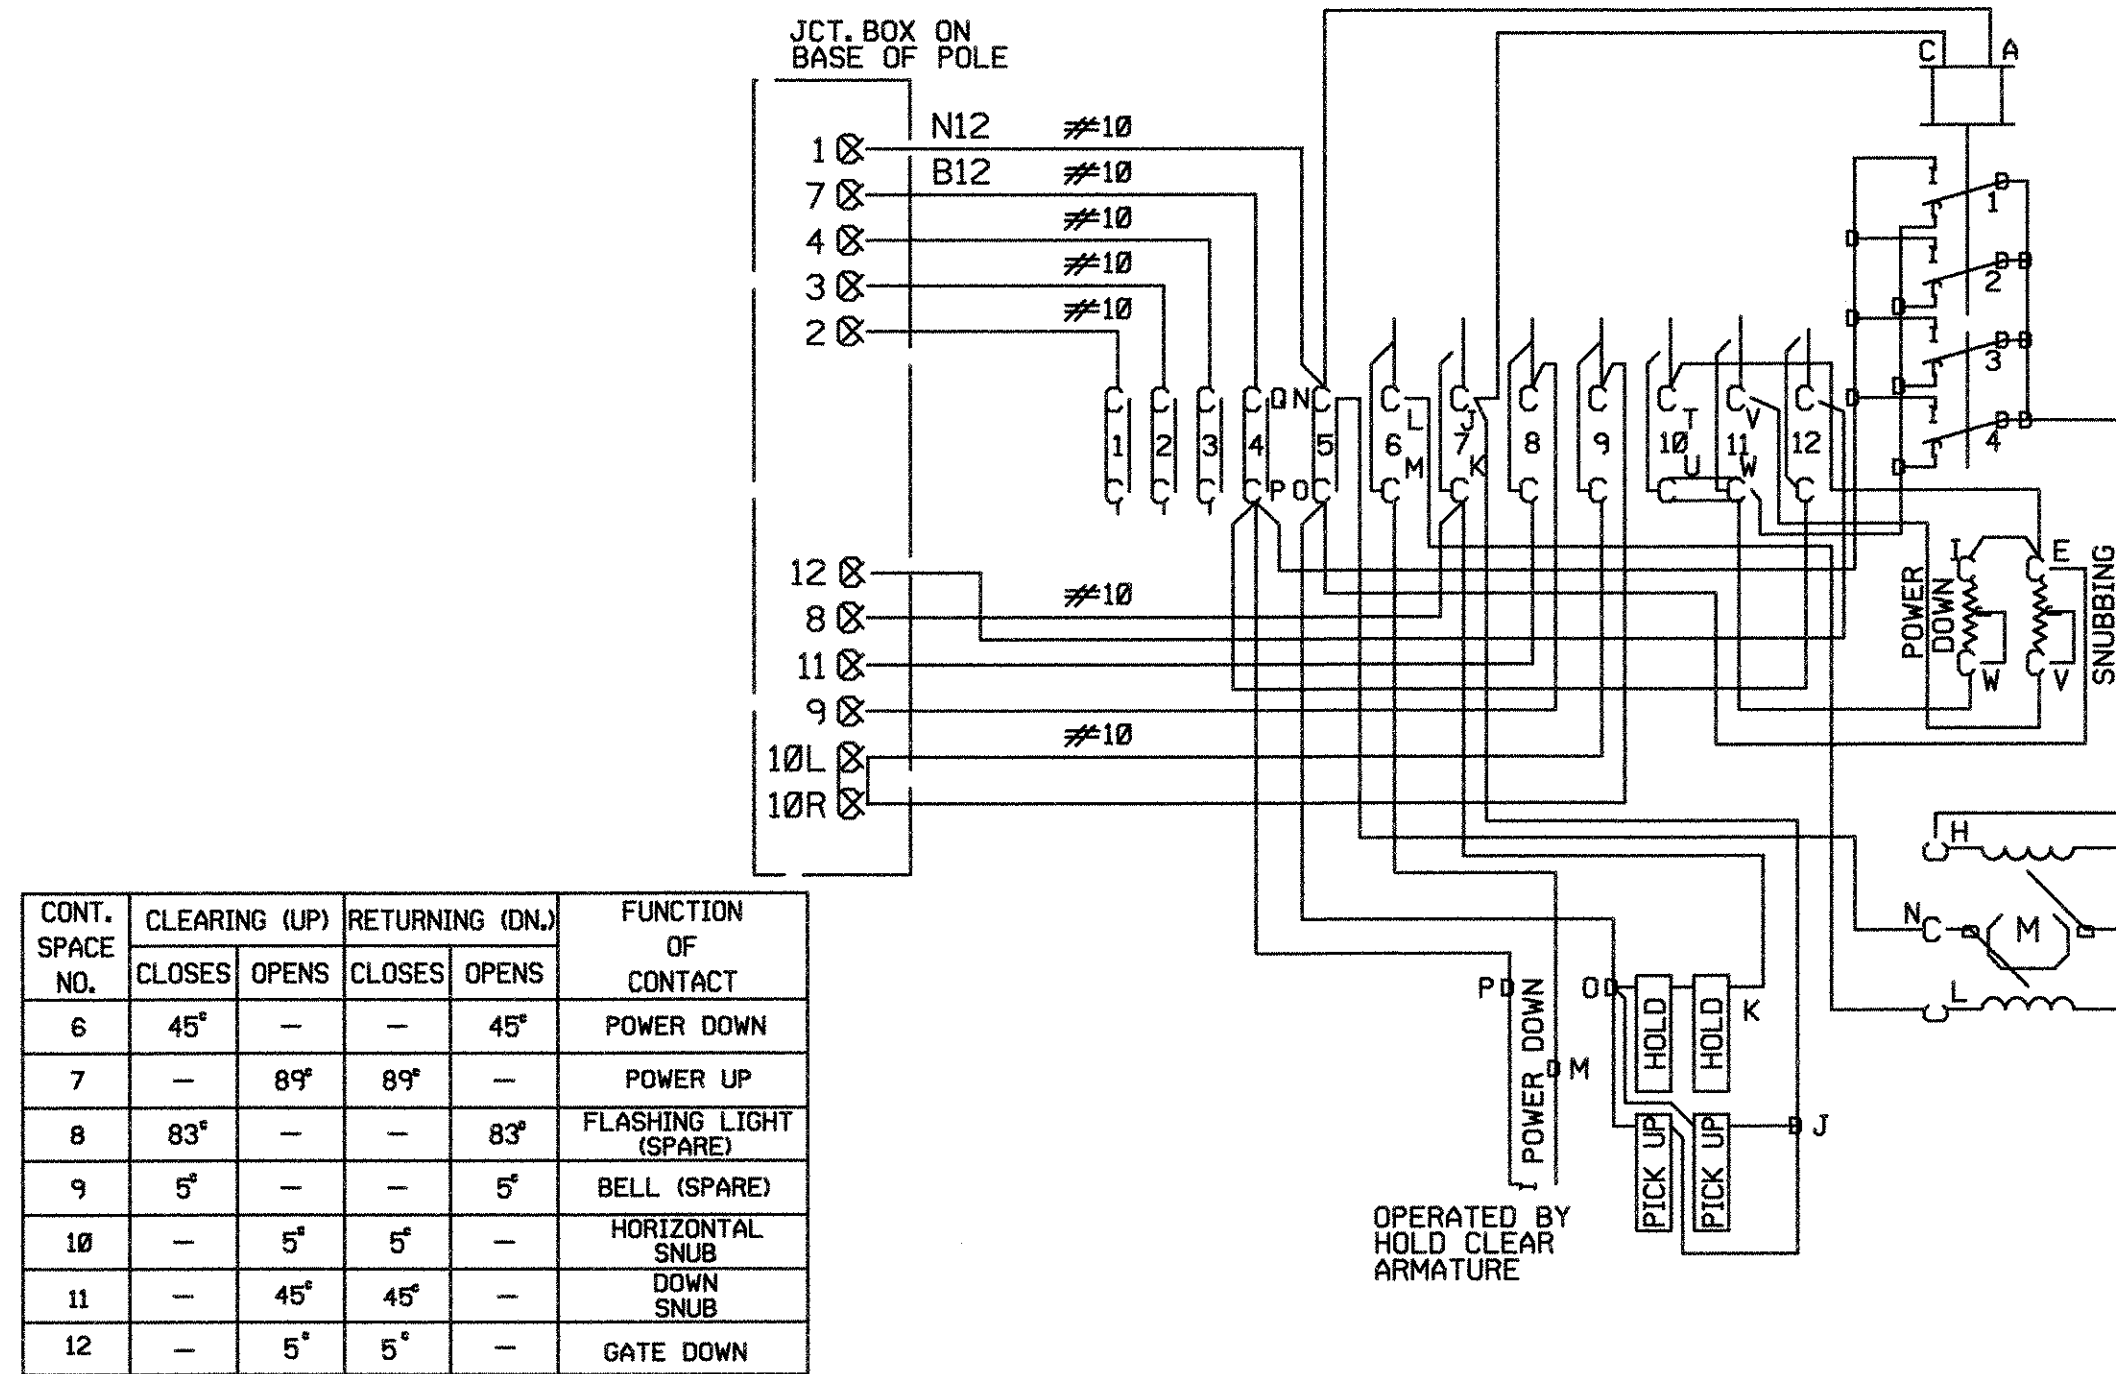


SHOW TYPE MECH. INSTALLED
ALL MECHANISMS SHOWN IN THE CLEAR POSITION

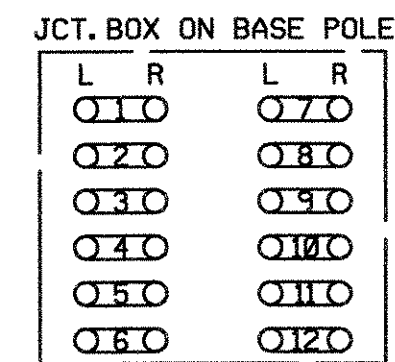

WCH 3597

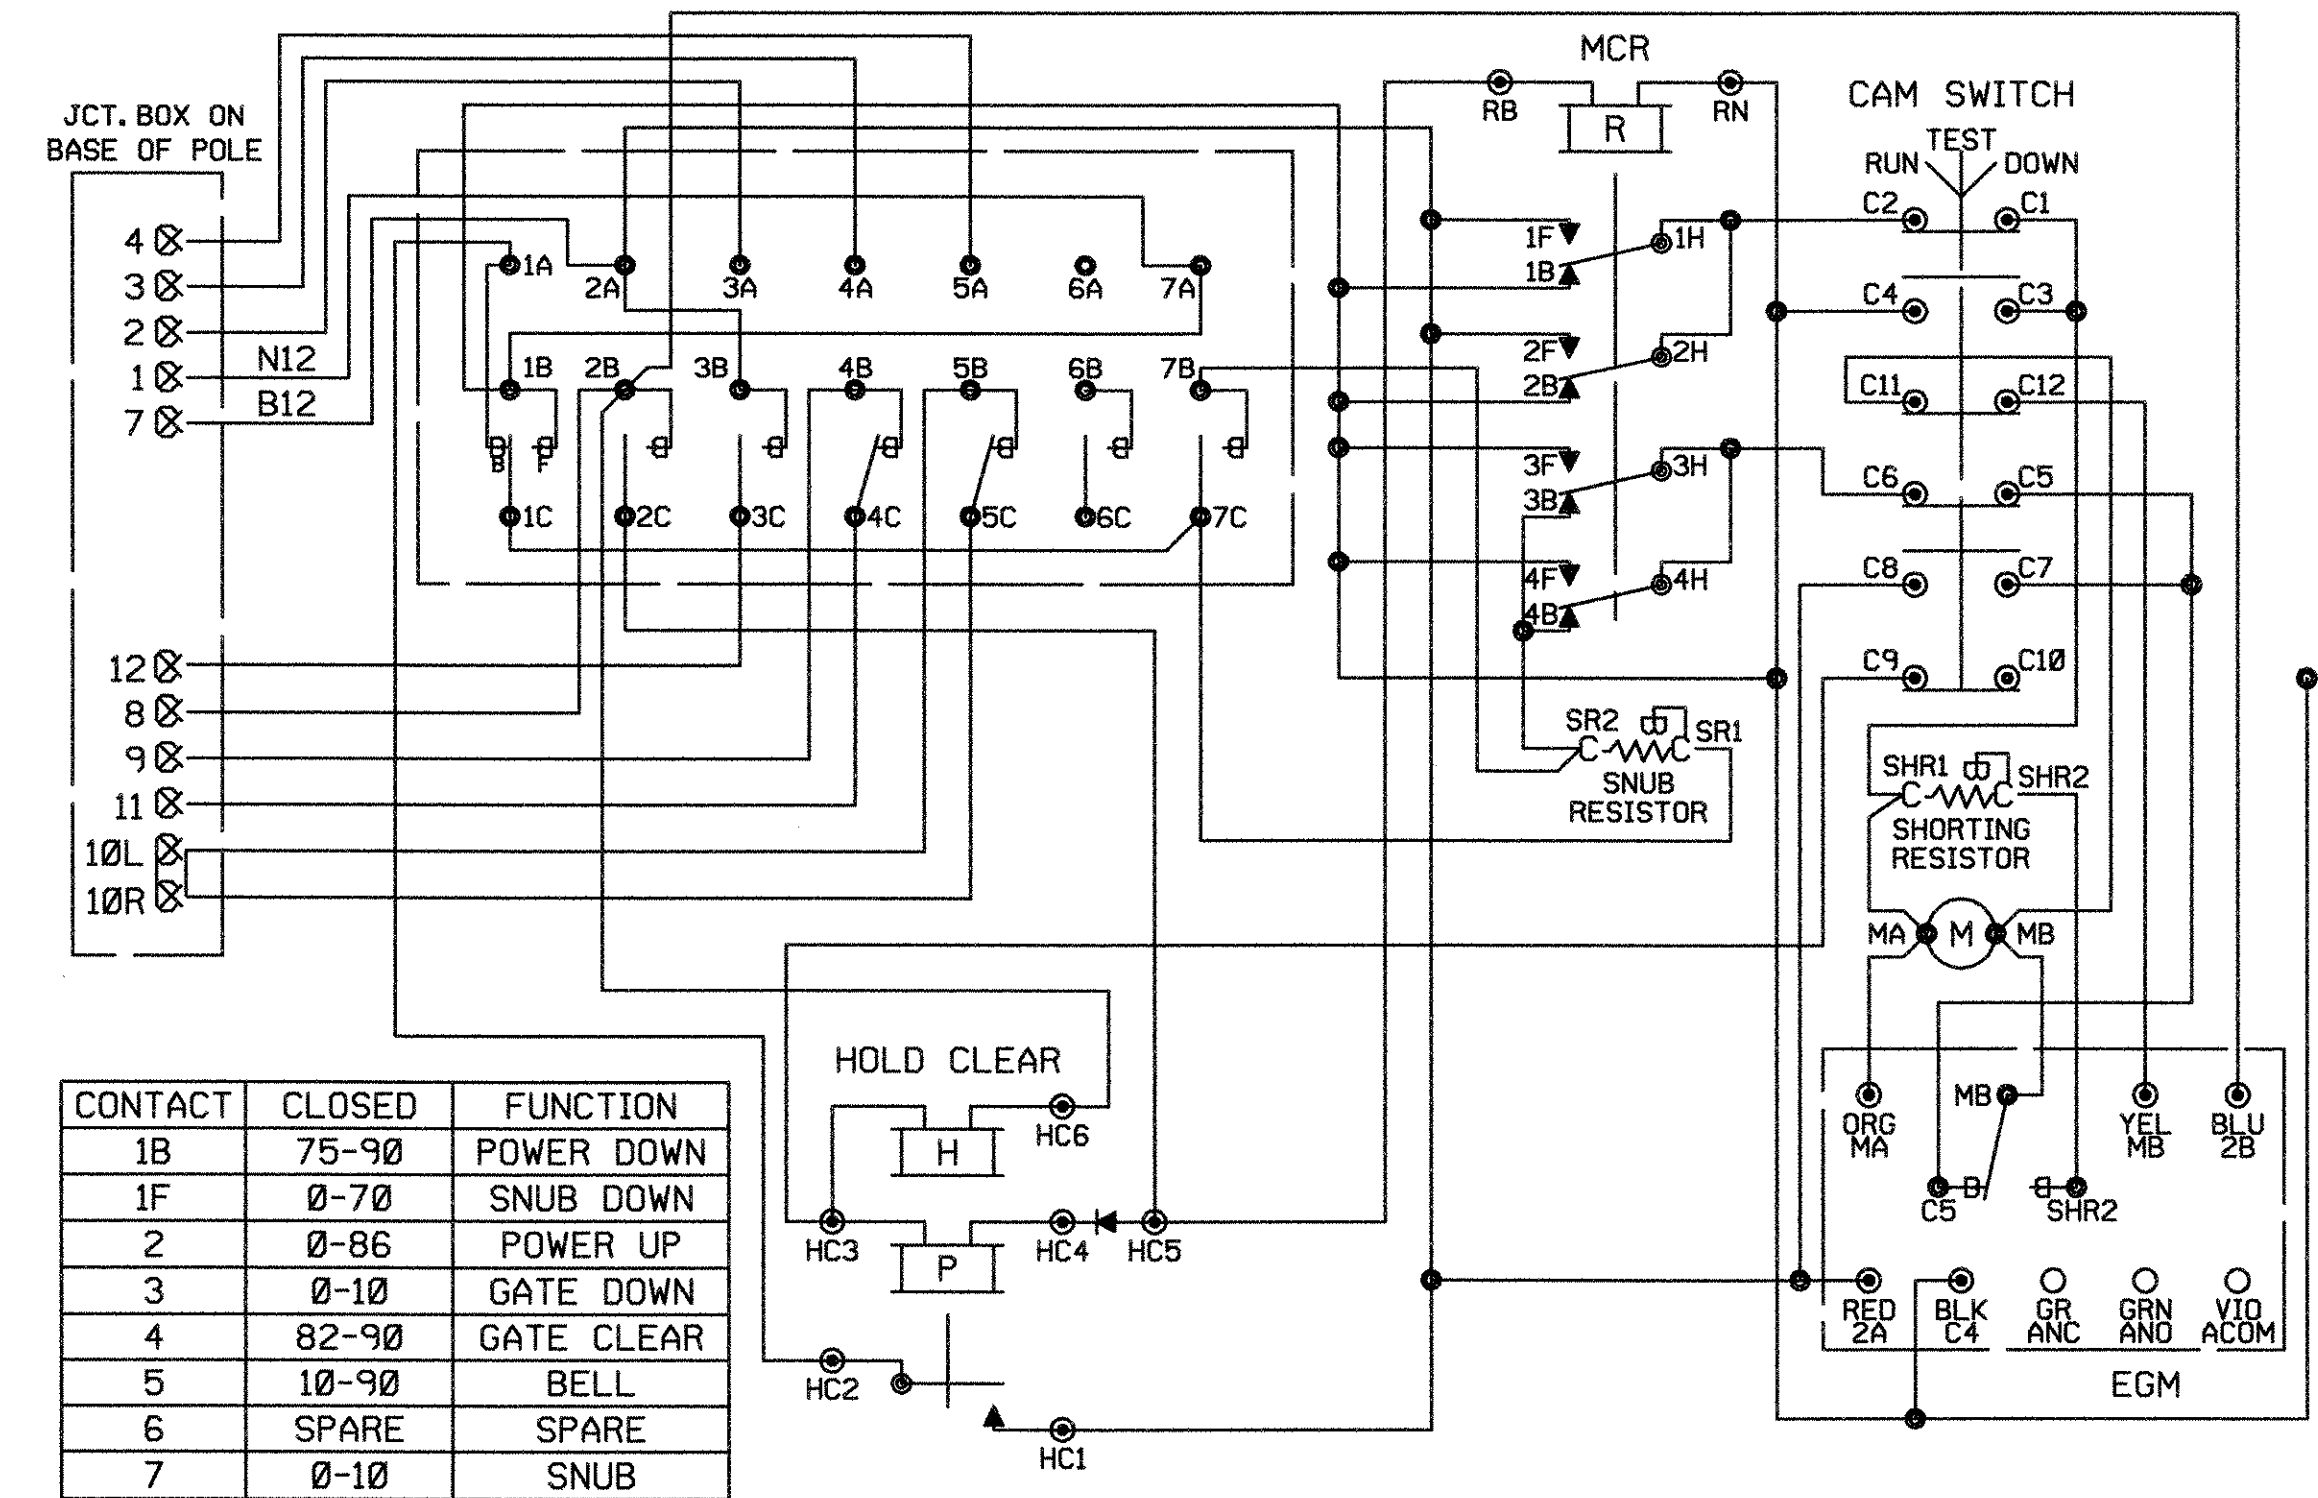

WCH 3593-E

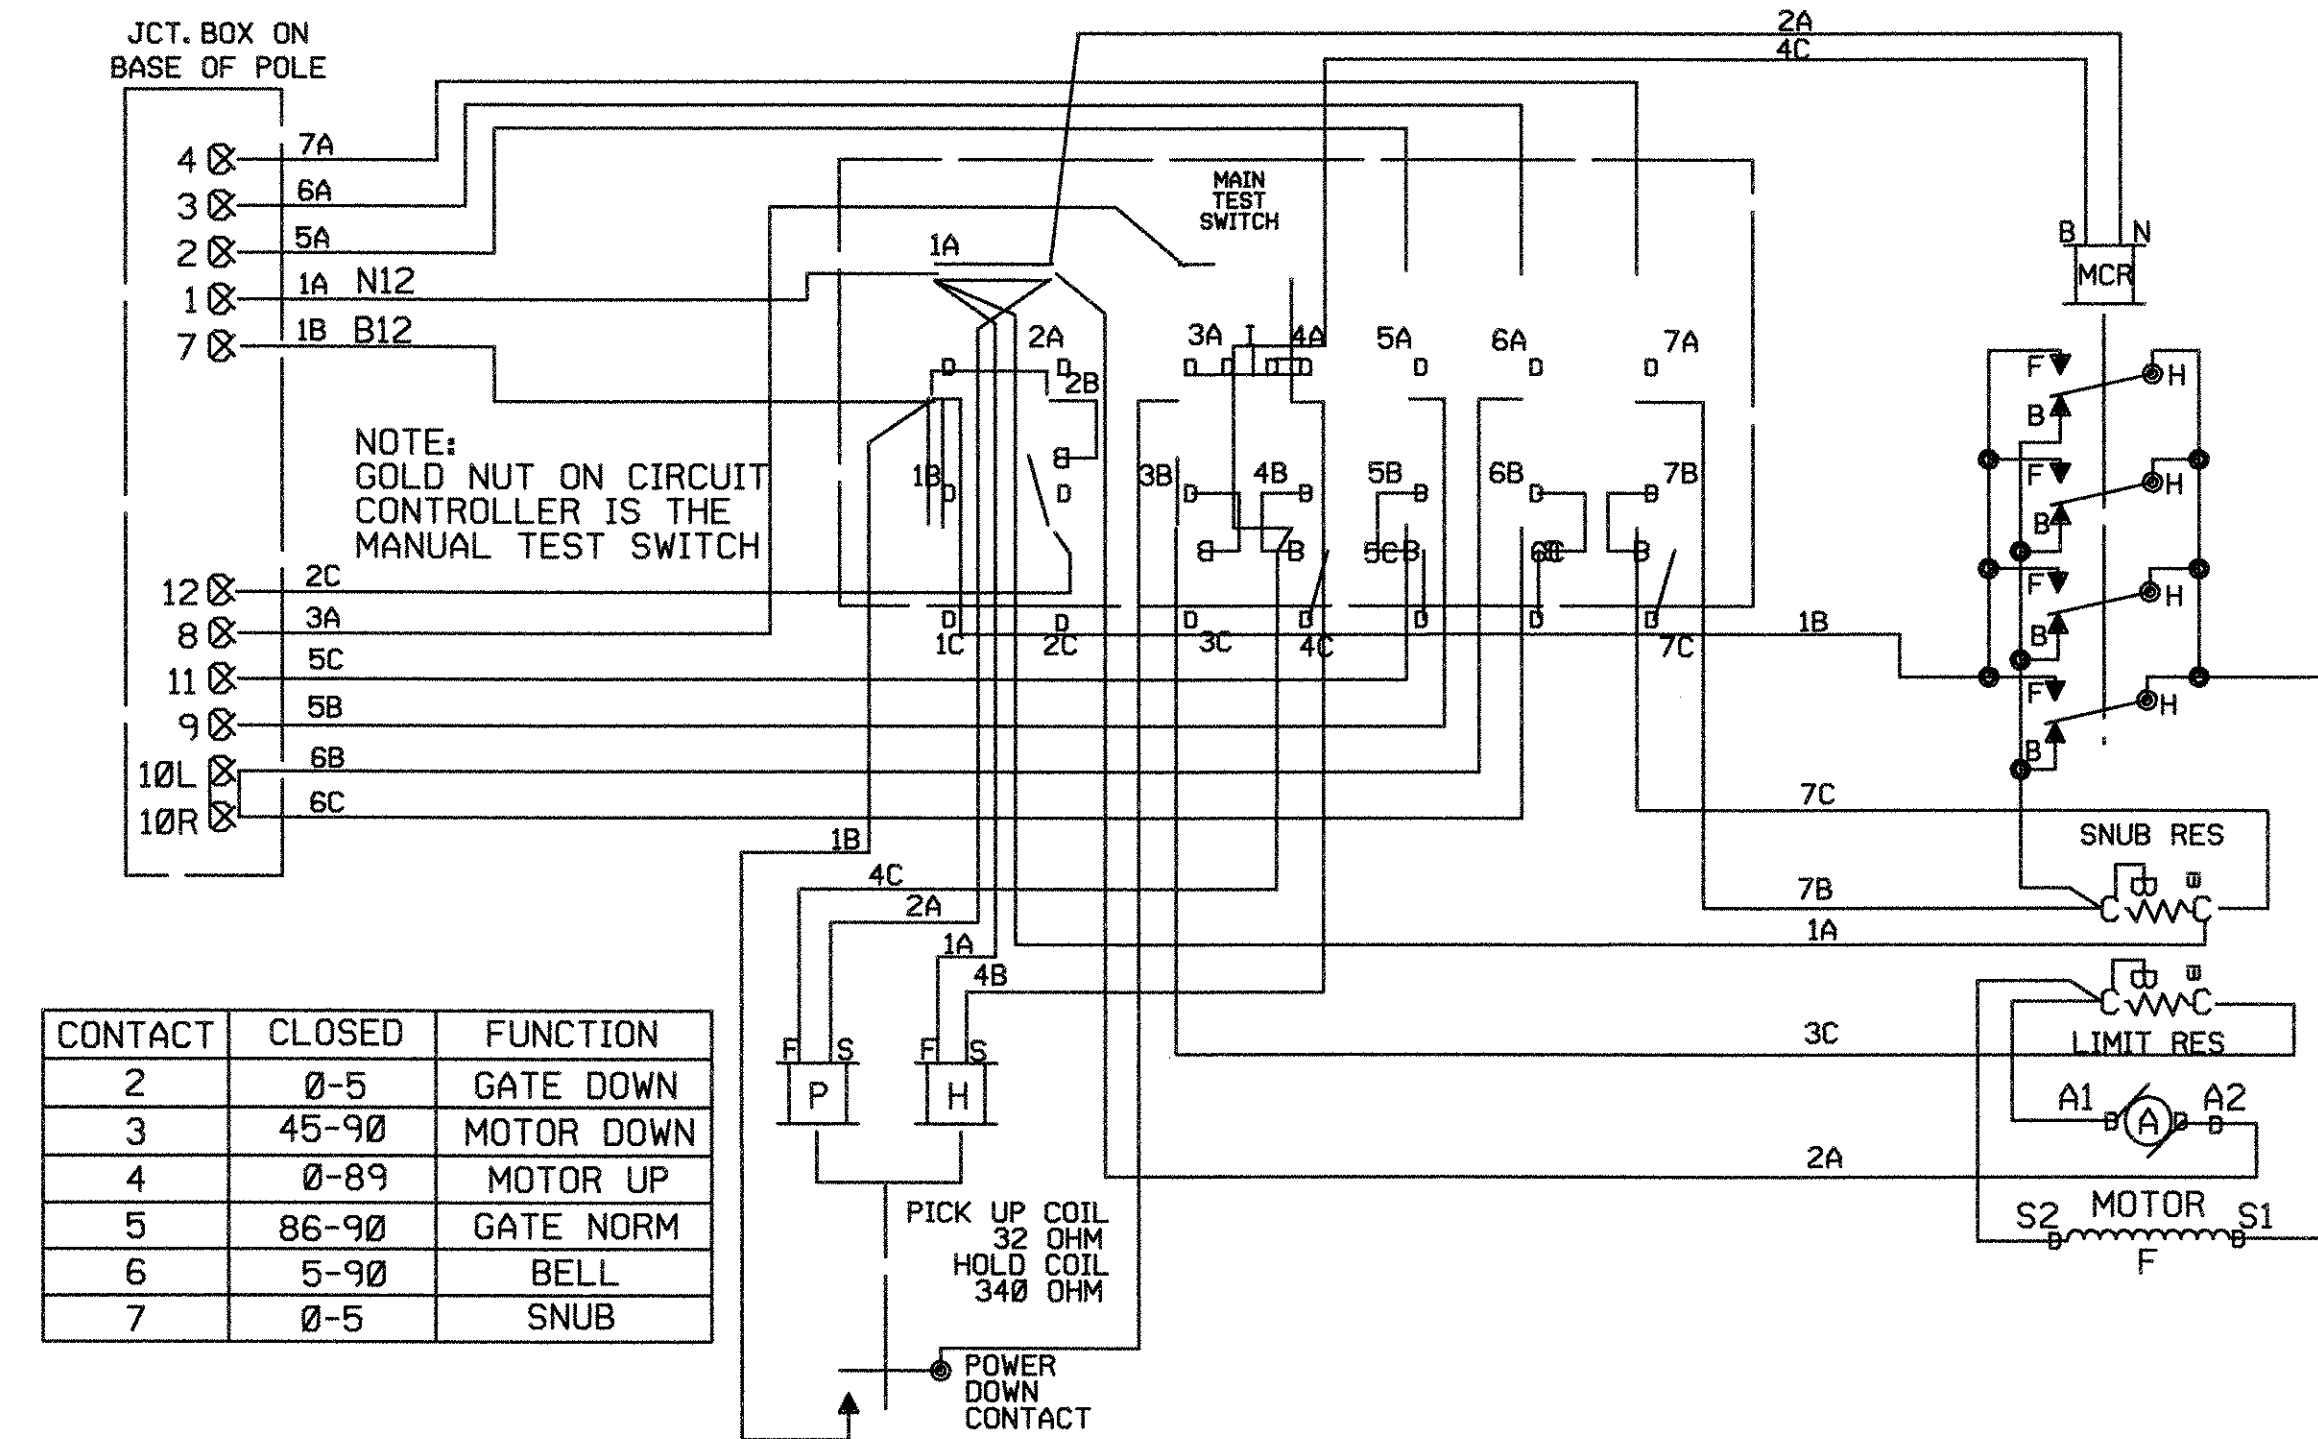

CROSSING GATE MECHANISM DIAGRAM

DOT* 247-536R

PROJECT NAME: SHARON GRADE CROSSING

PROJECT NUMBER: STP2034 (13)S

FILE NAME: SHT32.DGN

PROJECT LEADER: H. PATEL

DESIGNED BY: R. CARROLL

PLOT DATE: 06/13/03

DRAWN BY: A. BOSE

CHECKED BY: G. SERGOT

SHEET 31 OF 35



DATUM

VERTICAL NAVD88 ± 0.5 FT.

HORIZONTAL SPC 1983

ORIGINAL PREPARED:		
DATE	REVISIONS	BY

NOT TO SCALE

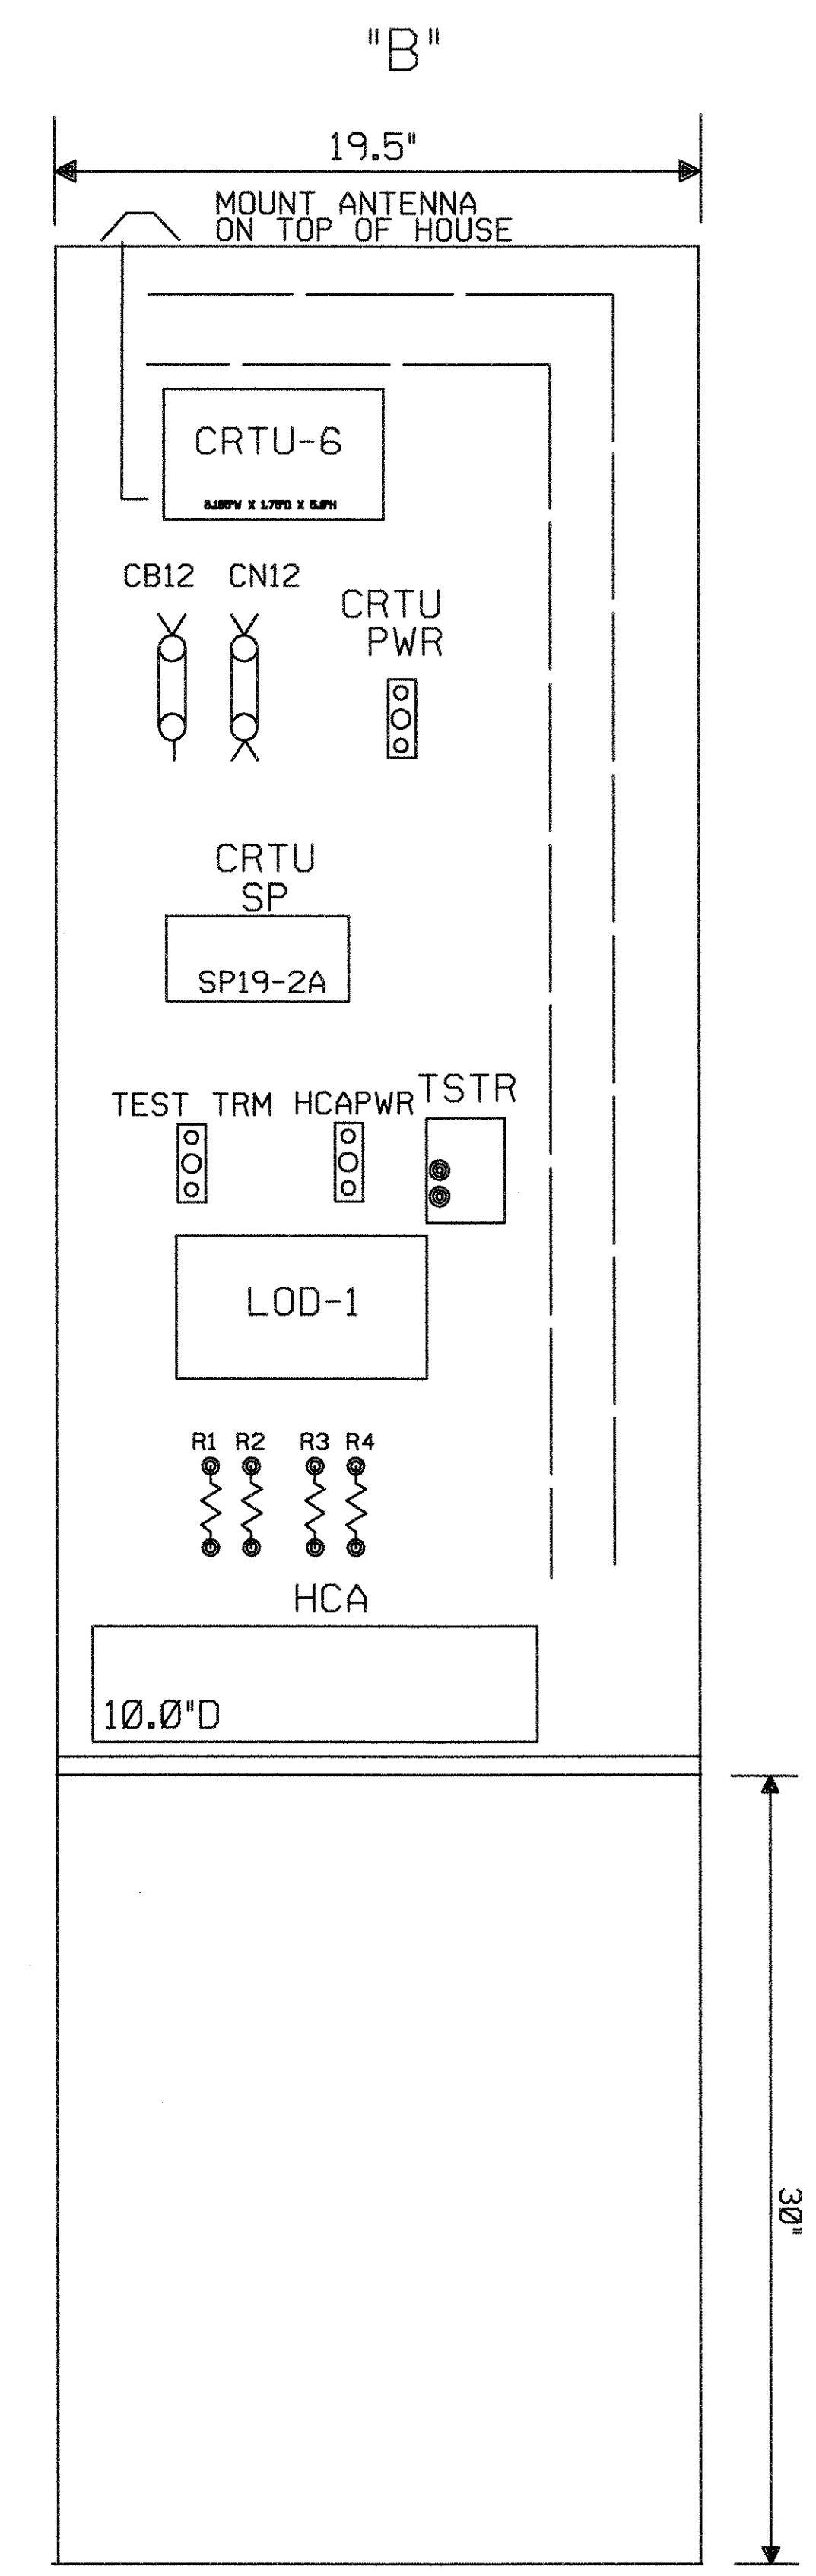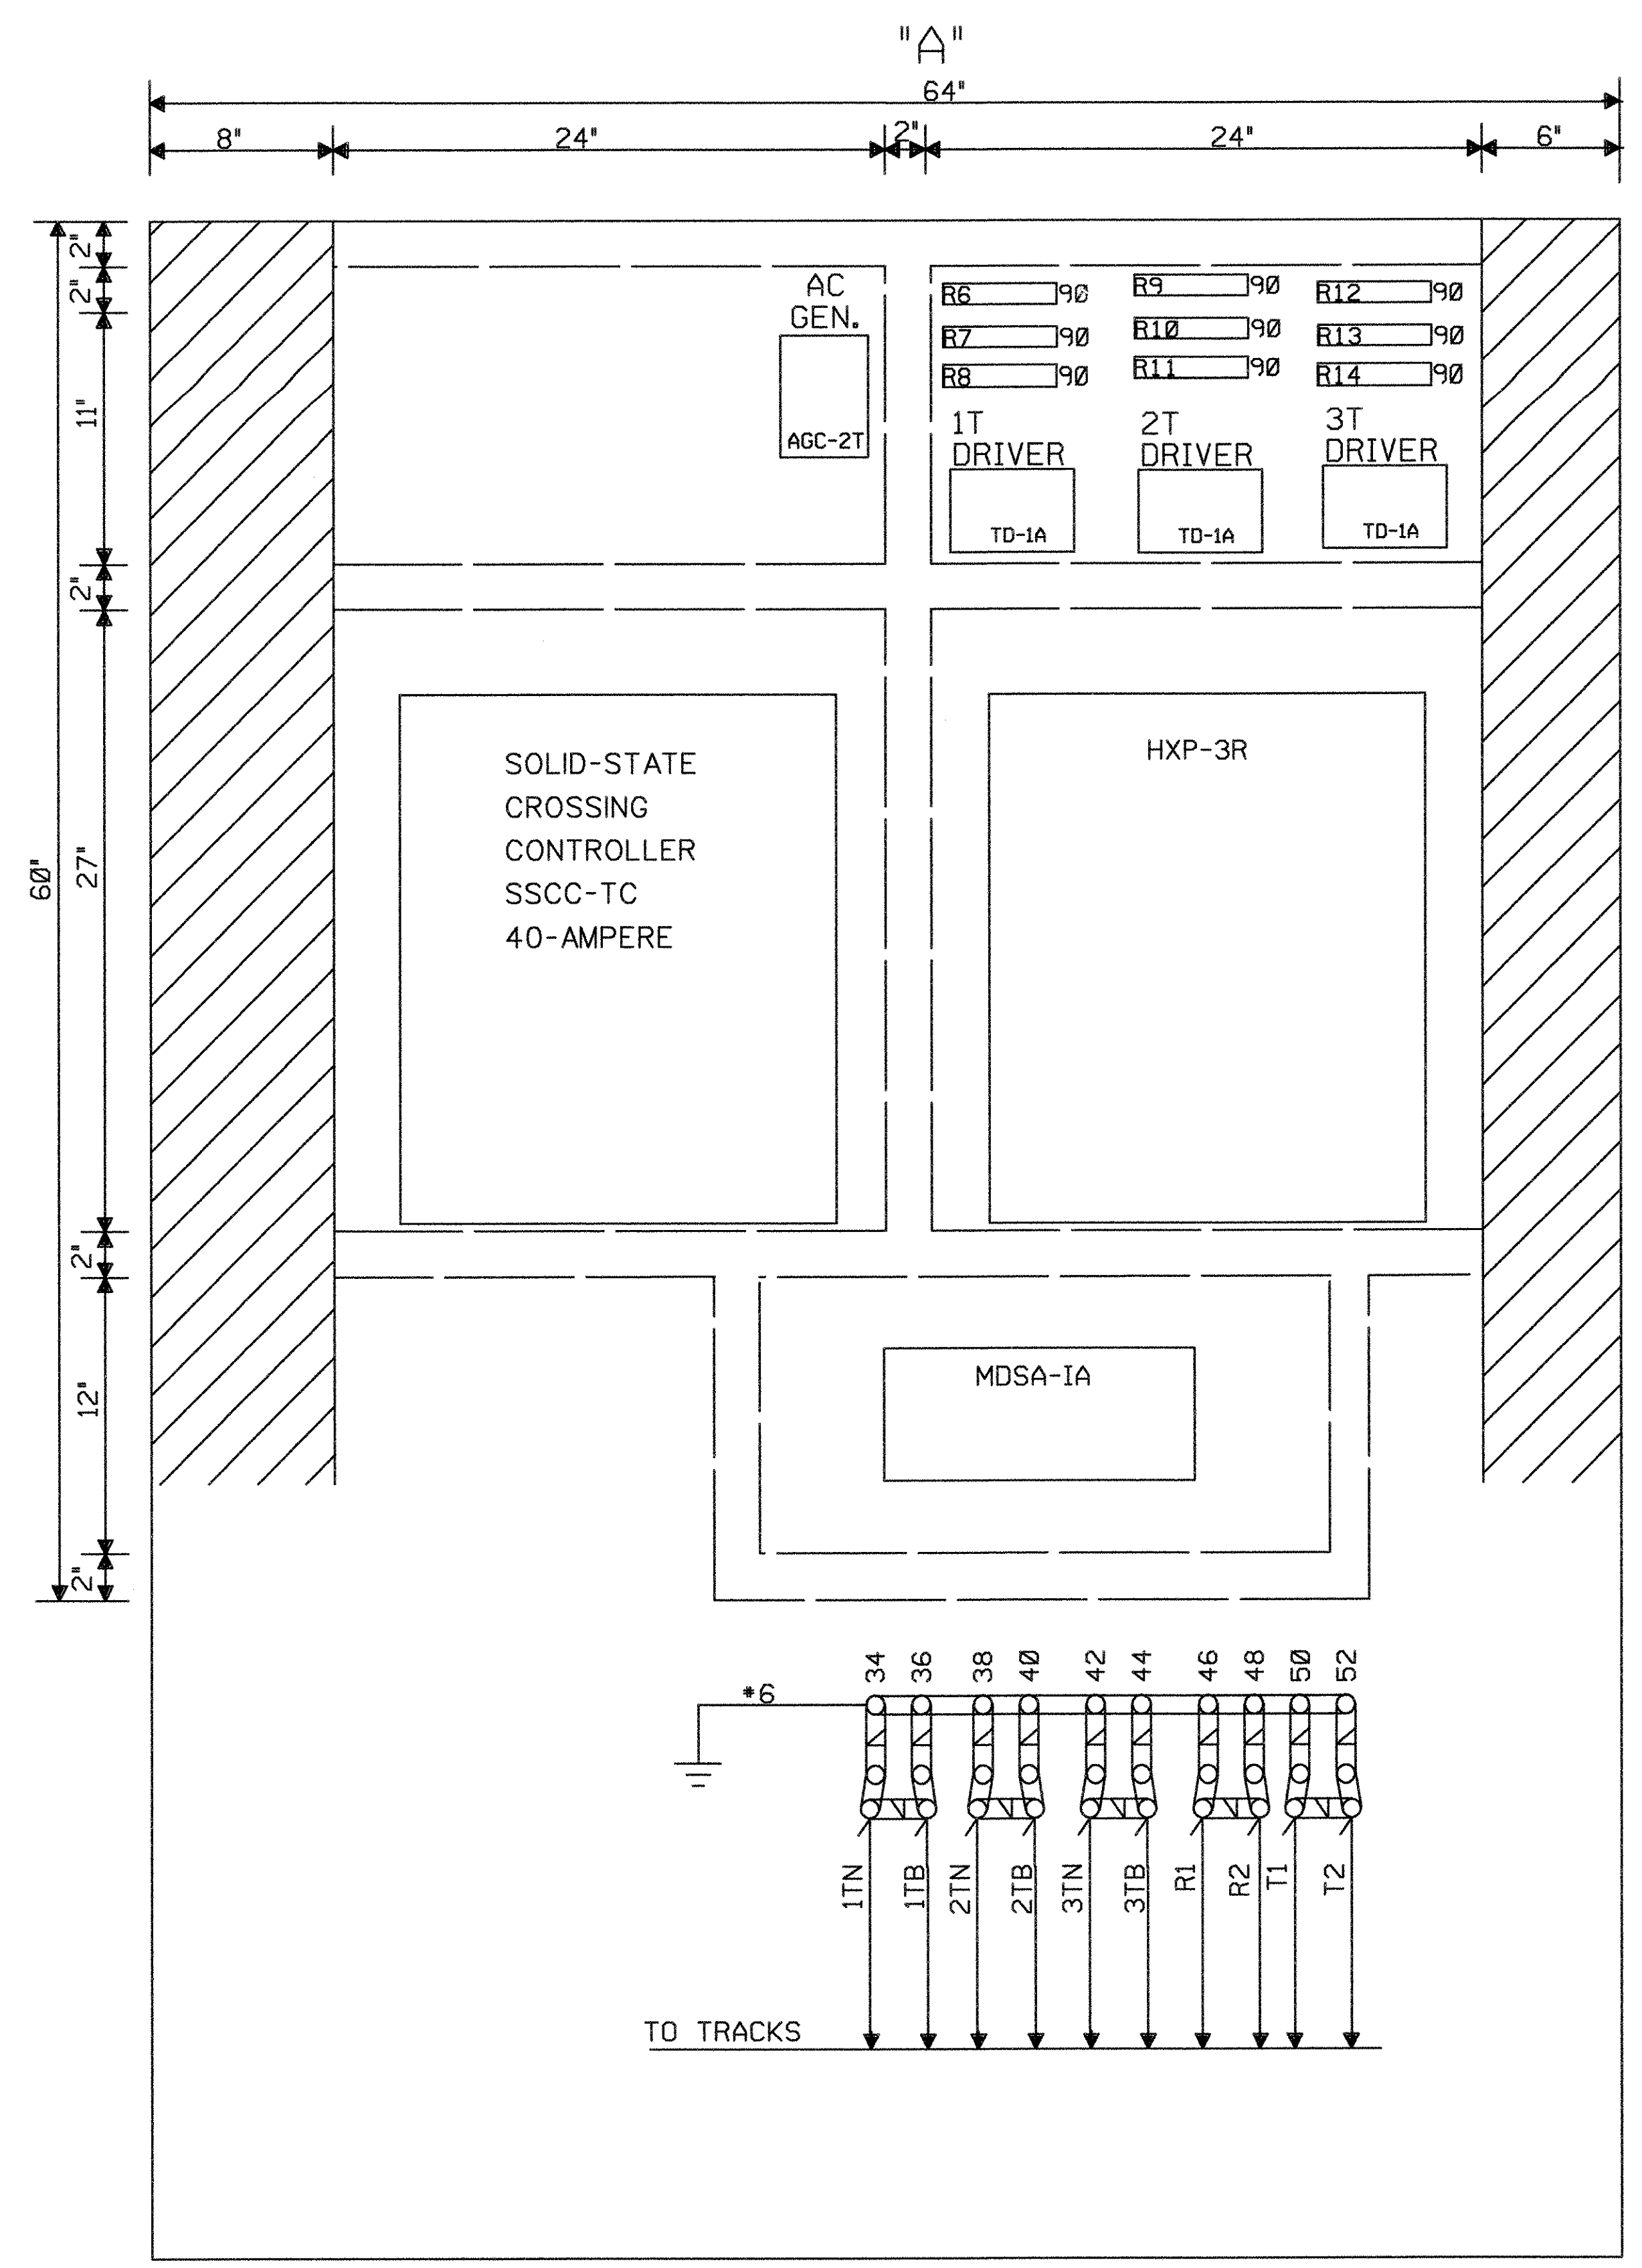

**SIGNAL HOUSE LAYOUT
(WALL A & B)**

DOT# 247-536R

PROJECT NAME: **SHARON GRADE CROSSING**
PROJECT NUMBER: STP2034 (13)S





FILE NAME: SHT33.DGN PLOT DATE: 06/13/03
PROJECT LEADER: H. PATEL DRAWN BY: A. BOSE
DESIGNED BY: R. CARROLL CHECKED BY: G. SERGOT
SHEET 32 OF 35

DATUM
VERTICAL NAVD88 ± 0.5 FT.
HORIZONTAL SPC 1983

ORIGINAL PREPARED:		
DATE	REVISIONS	BY

NOT TO SCALE

U:\14504_06\13\03
 M:\187379_vt_rail_xinda\SHARON_CROSSING.dgn\SHI32.dgn

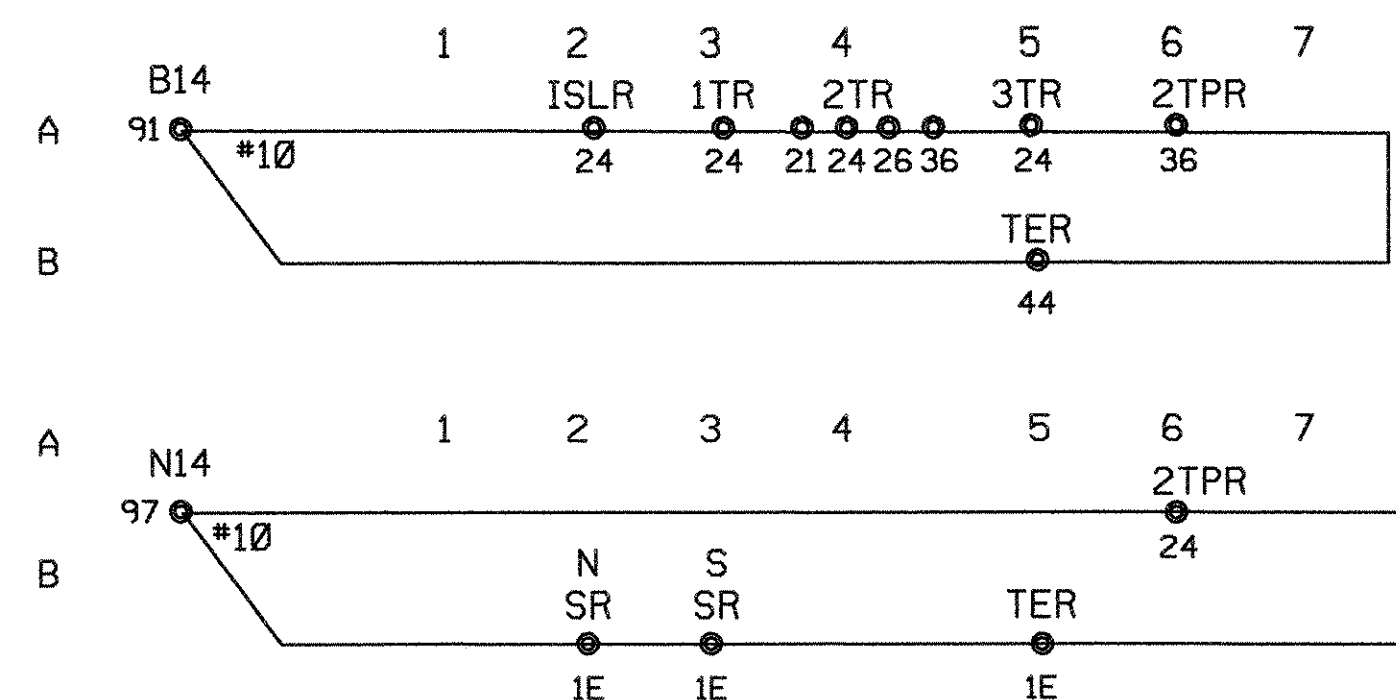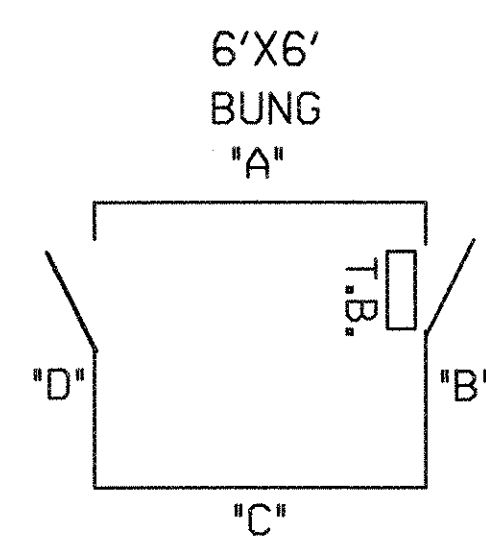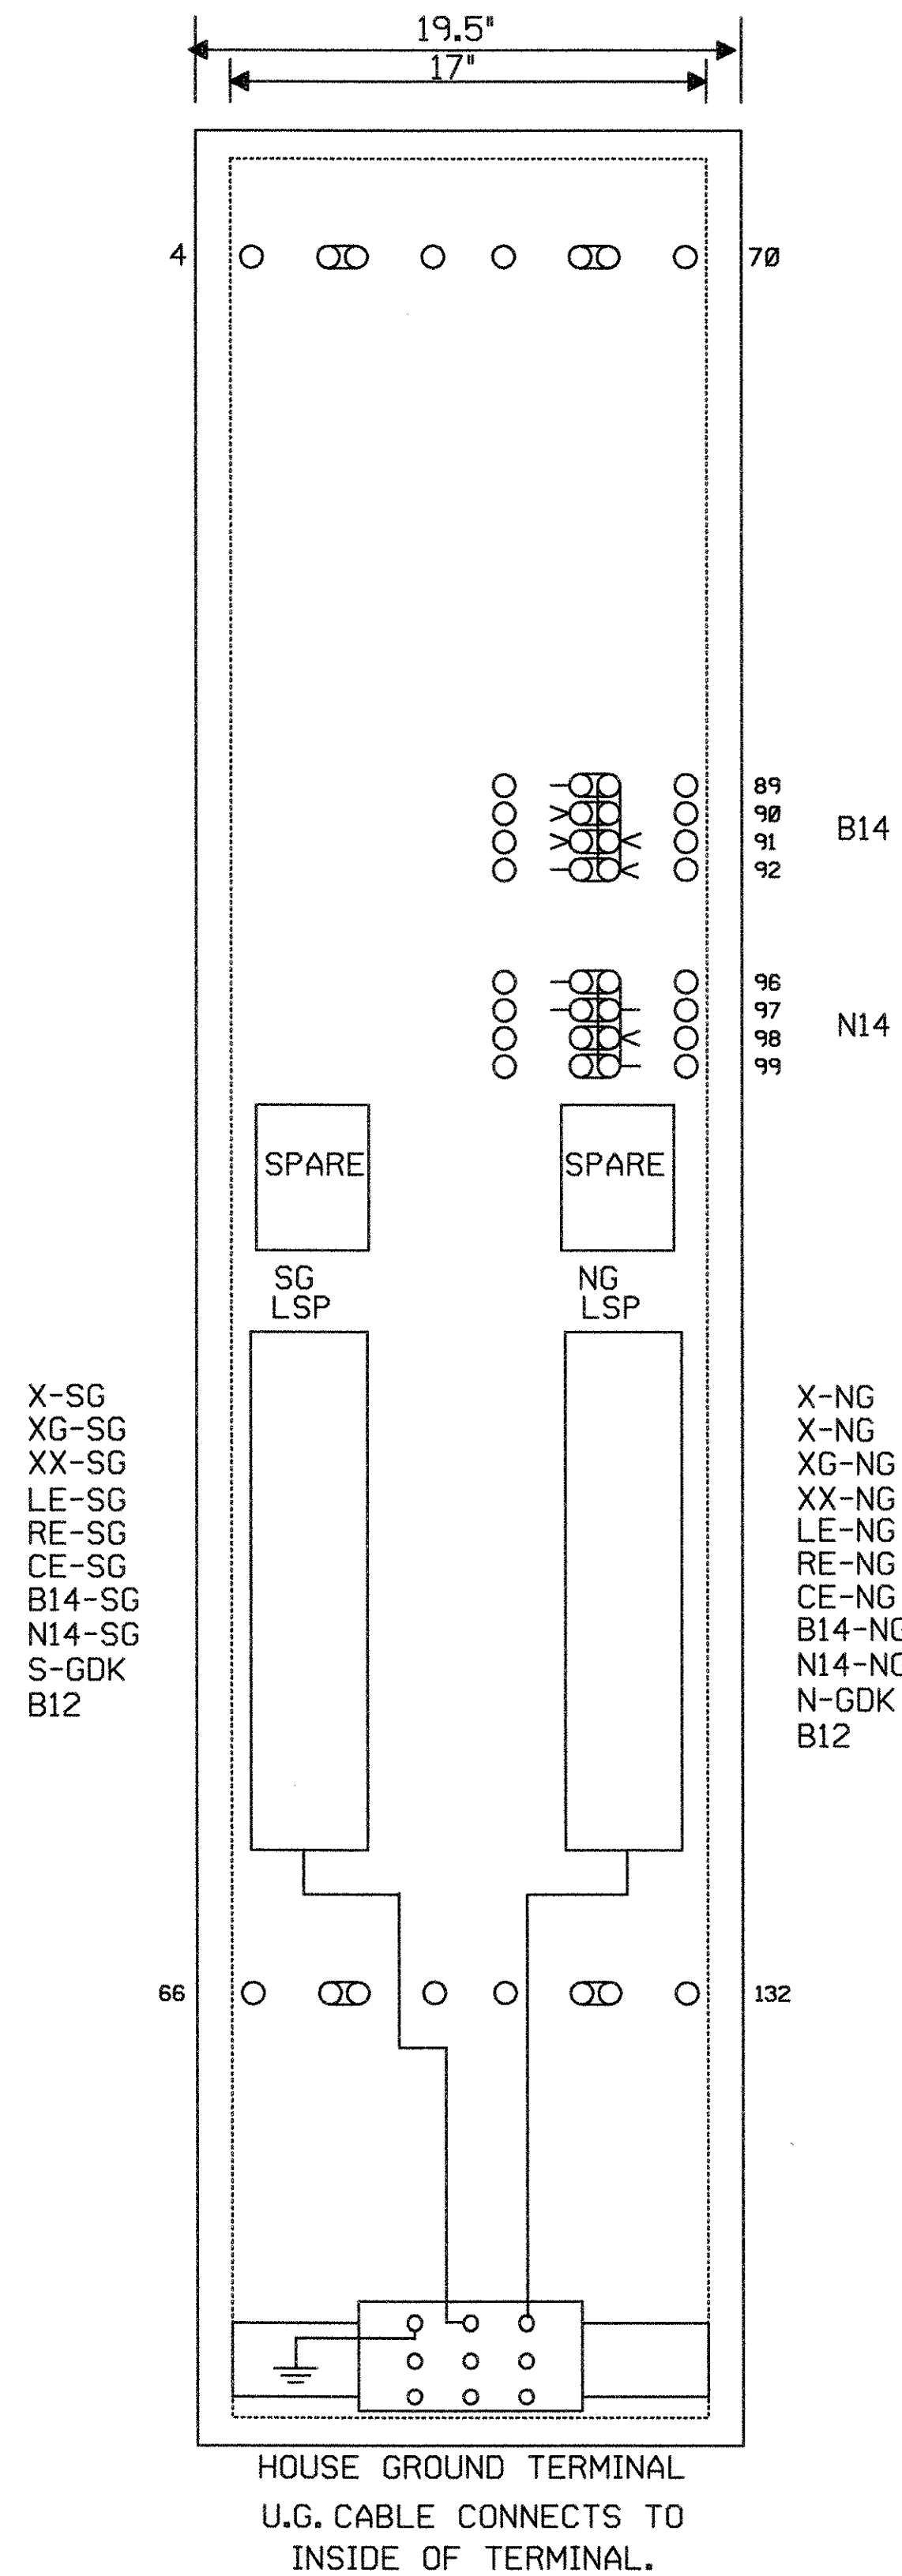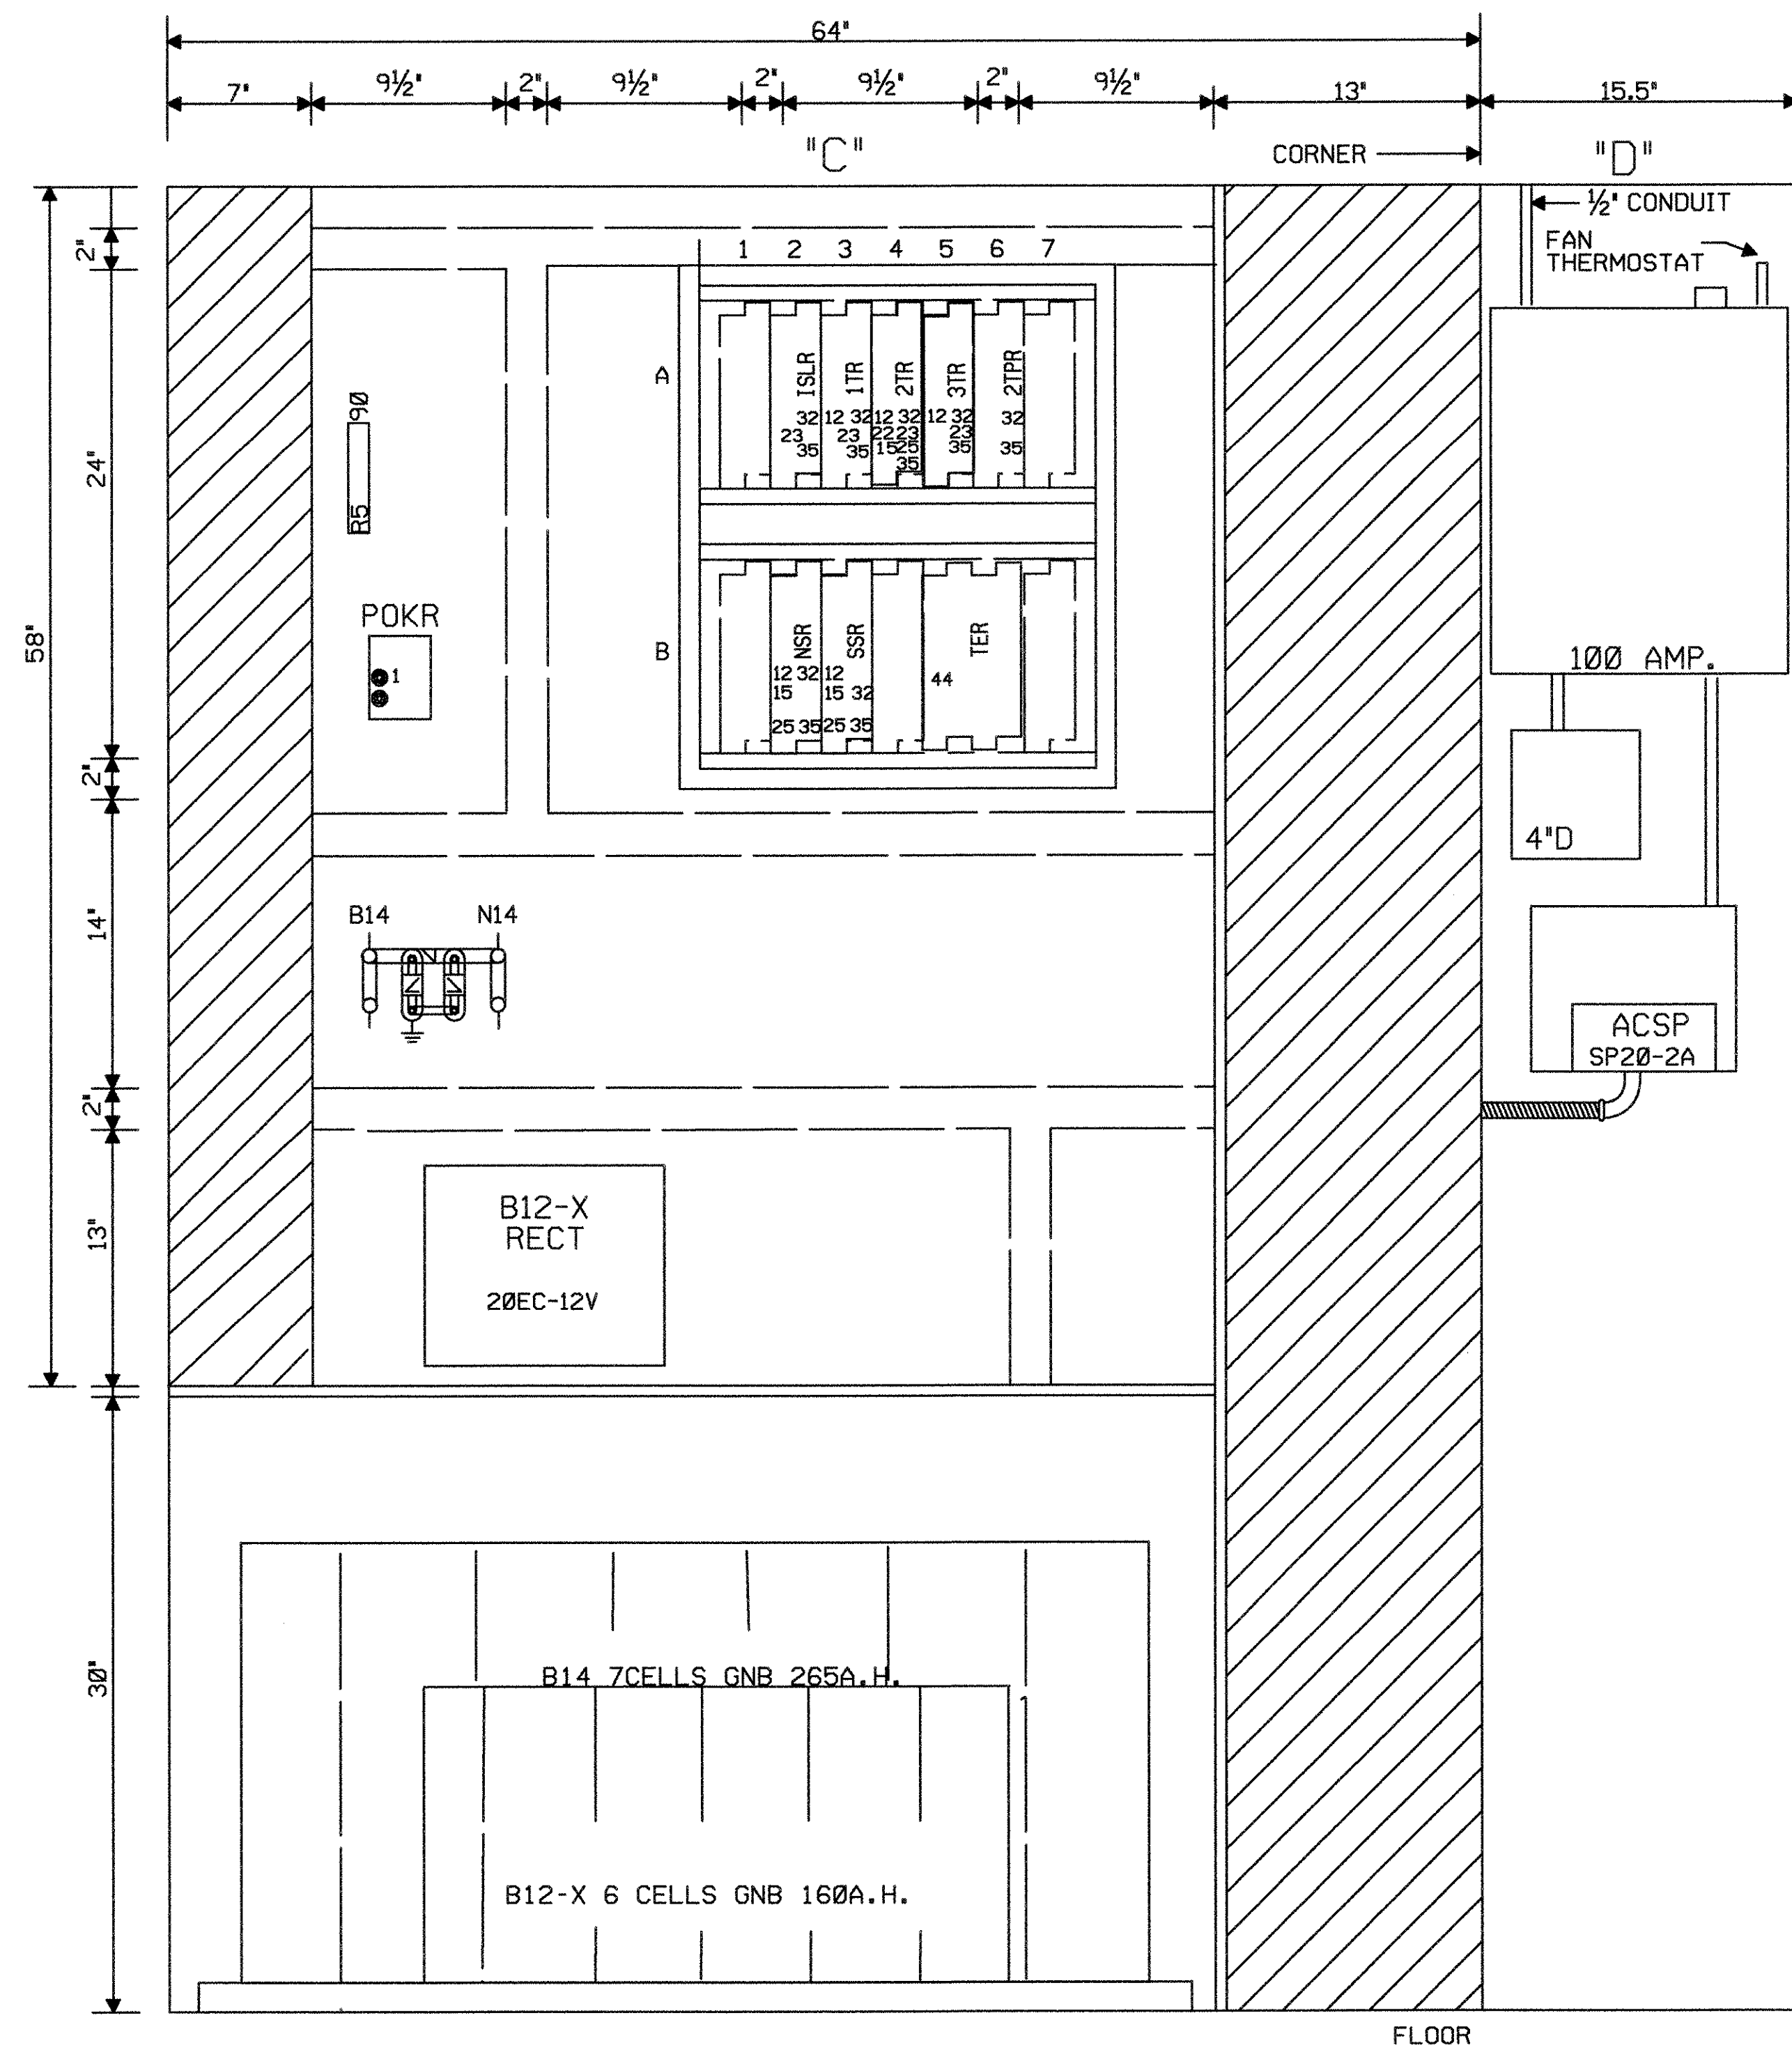

ORIGINAL PREPARED:		
DATE	REVISIONS	BY

NOT TO SCALE

**SIGNAL HOUSE LAYOUT
(WALL C & D)**

DOT# 247-536R

PROJECT NAME: **SHARON GRADE CROSSING**

PROJECT NUMBER: STP2034 (13)S

FILE NAME: SHT34.DGN

PROJECT LEADER: H. PATEL

DESIGNED BY: R. CARROLL

PLOT DATE: 06/13/03

DRAWN BY: A. BOSE

CHECKED BY: G. SERGOT


SHEET 33 OF 35

06/13/03
 M:\18737s_v1.rail.xina\SHARON_CROSSING.dgn\SH133.dgn

DATUM

VERTICAL	NAVD88 ± 0.5 FT.
HORIZONTAL	SPC 1983

← TO WHITE RIVER JCT. TO MONTPELIER →

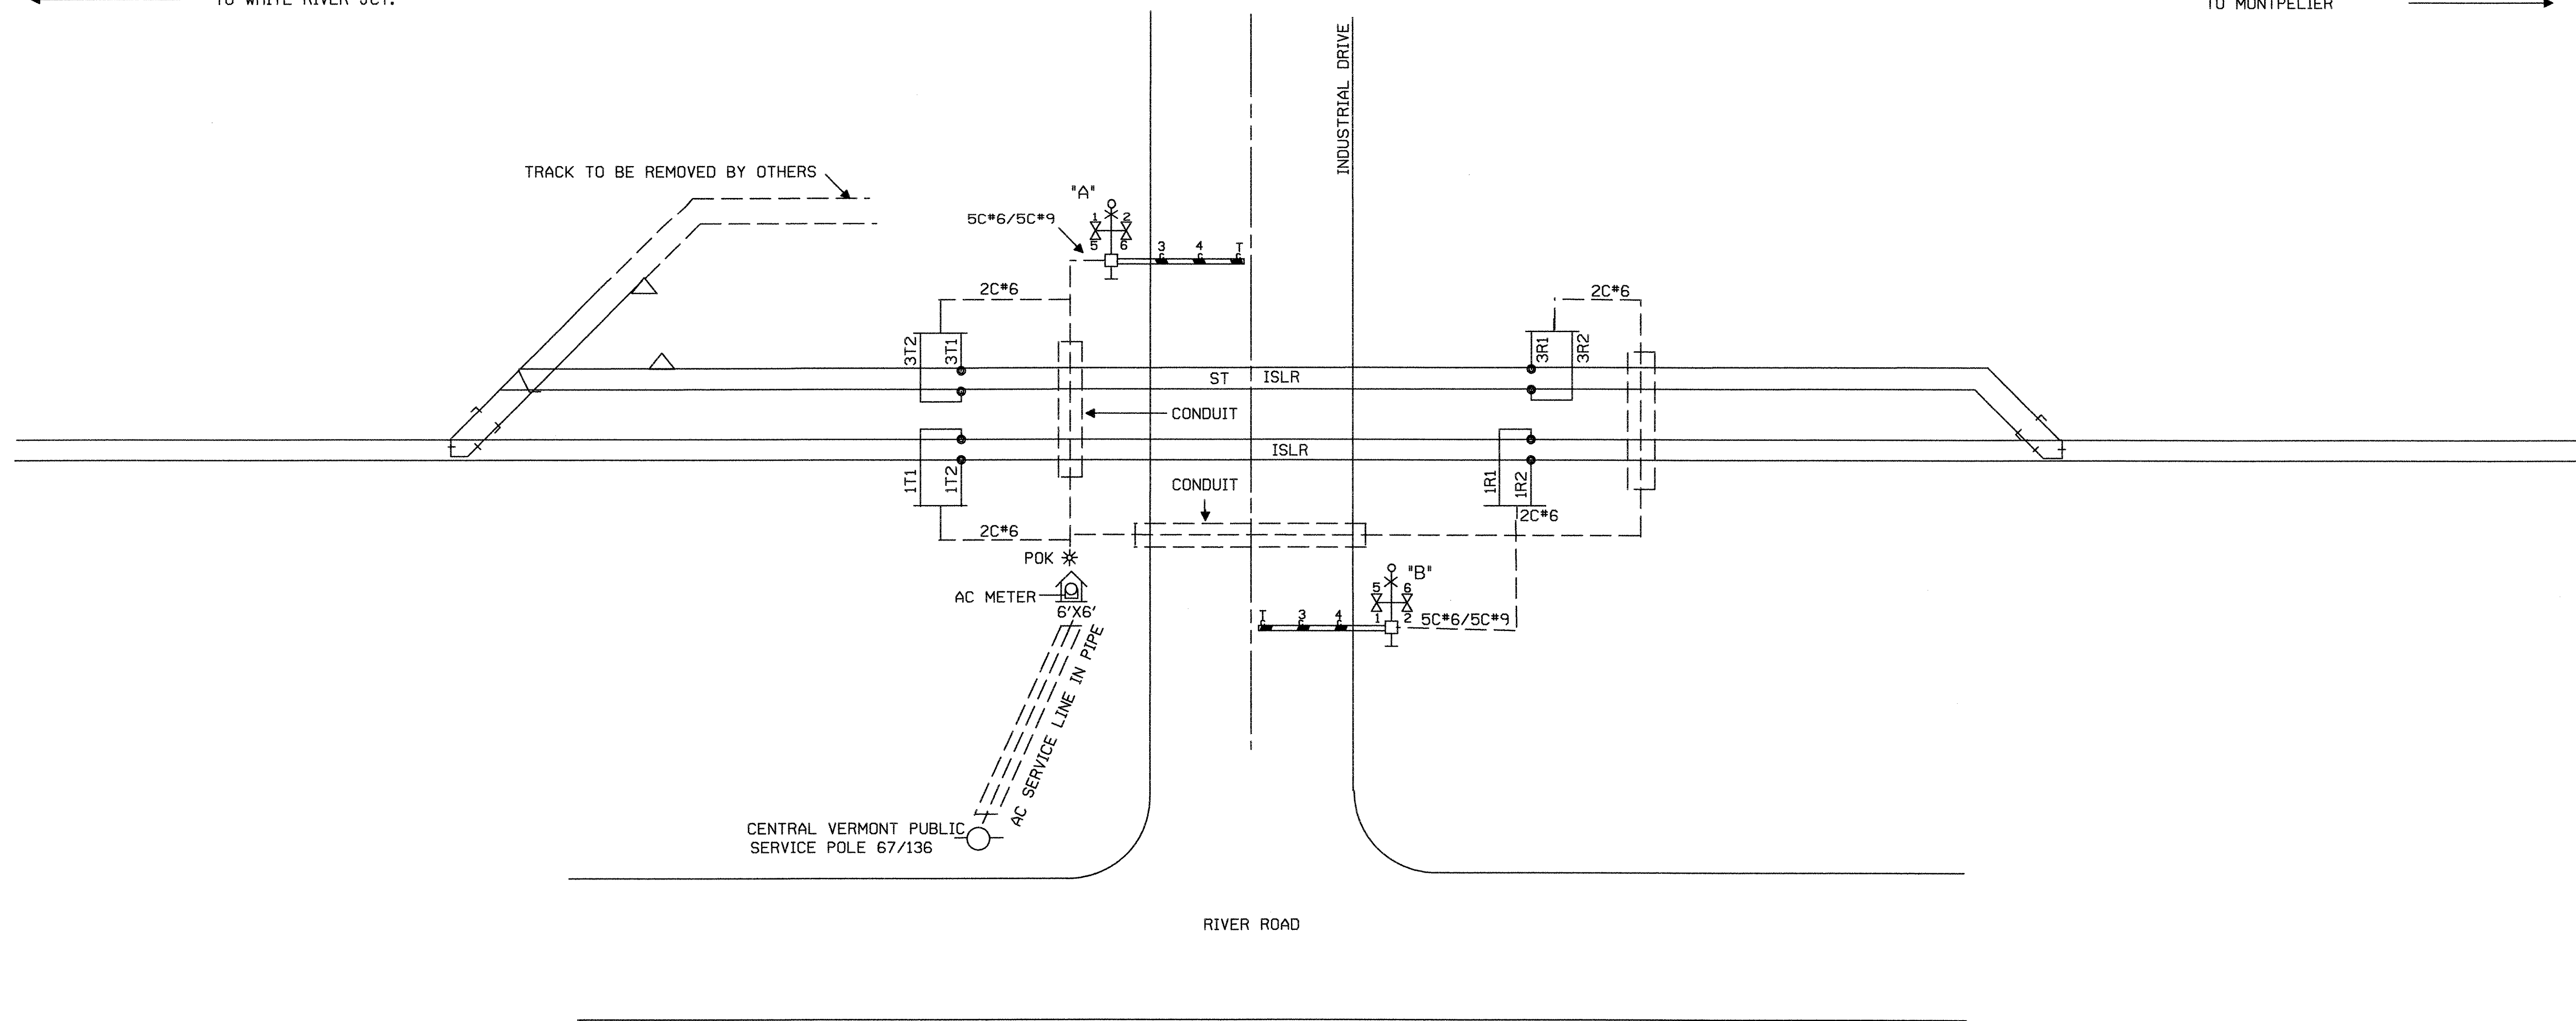

- NOTES:**
1. METER SERVICE WILL BE MOUNTED ON HOUSE
 2. CONTRACTOR TO VERIFY WITH THE CENTRAL VERMONT PUBLIC SERVICE (CVPS) THE LOCATION OF THE POWER FEED.

SIGNAL CABLE INSTALLATION PLAN

DOT* 247-536R

PROJECT NAME: SHARON GRADE CROSSING	
PROJECT NUMBER: STP2034 (13)S	
FILE NAME: SHT35.DGN	PLOT DATE: 06/13/03
PROJECT LEADER: H. PATEL	DRAWN BY: A. BOSE
DESIGNED BY: R. CARROLL	CHECKED BY: G. SERGOT
	SHEET 34 OF 35



DATUM

VERTICAL	NAVD88 ± 0.5 FT.
HORIZONTAL	SPC 1983

ORIGINAL PREPARED:		
DATE	REVISIONS	BY

NOT TO SCALE

06/13/03 09:41:36 AM M:\18737s_vt_rll\sharon_crossing\dgn\sh34.dgn

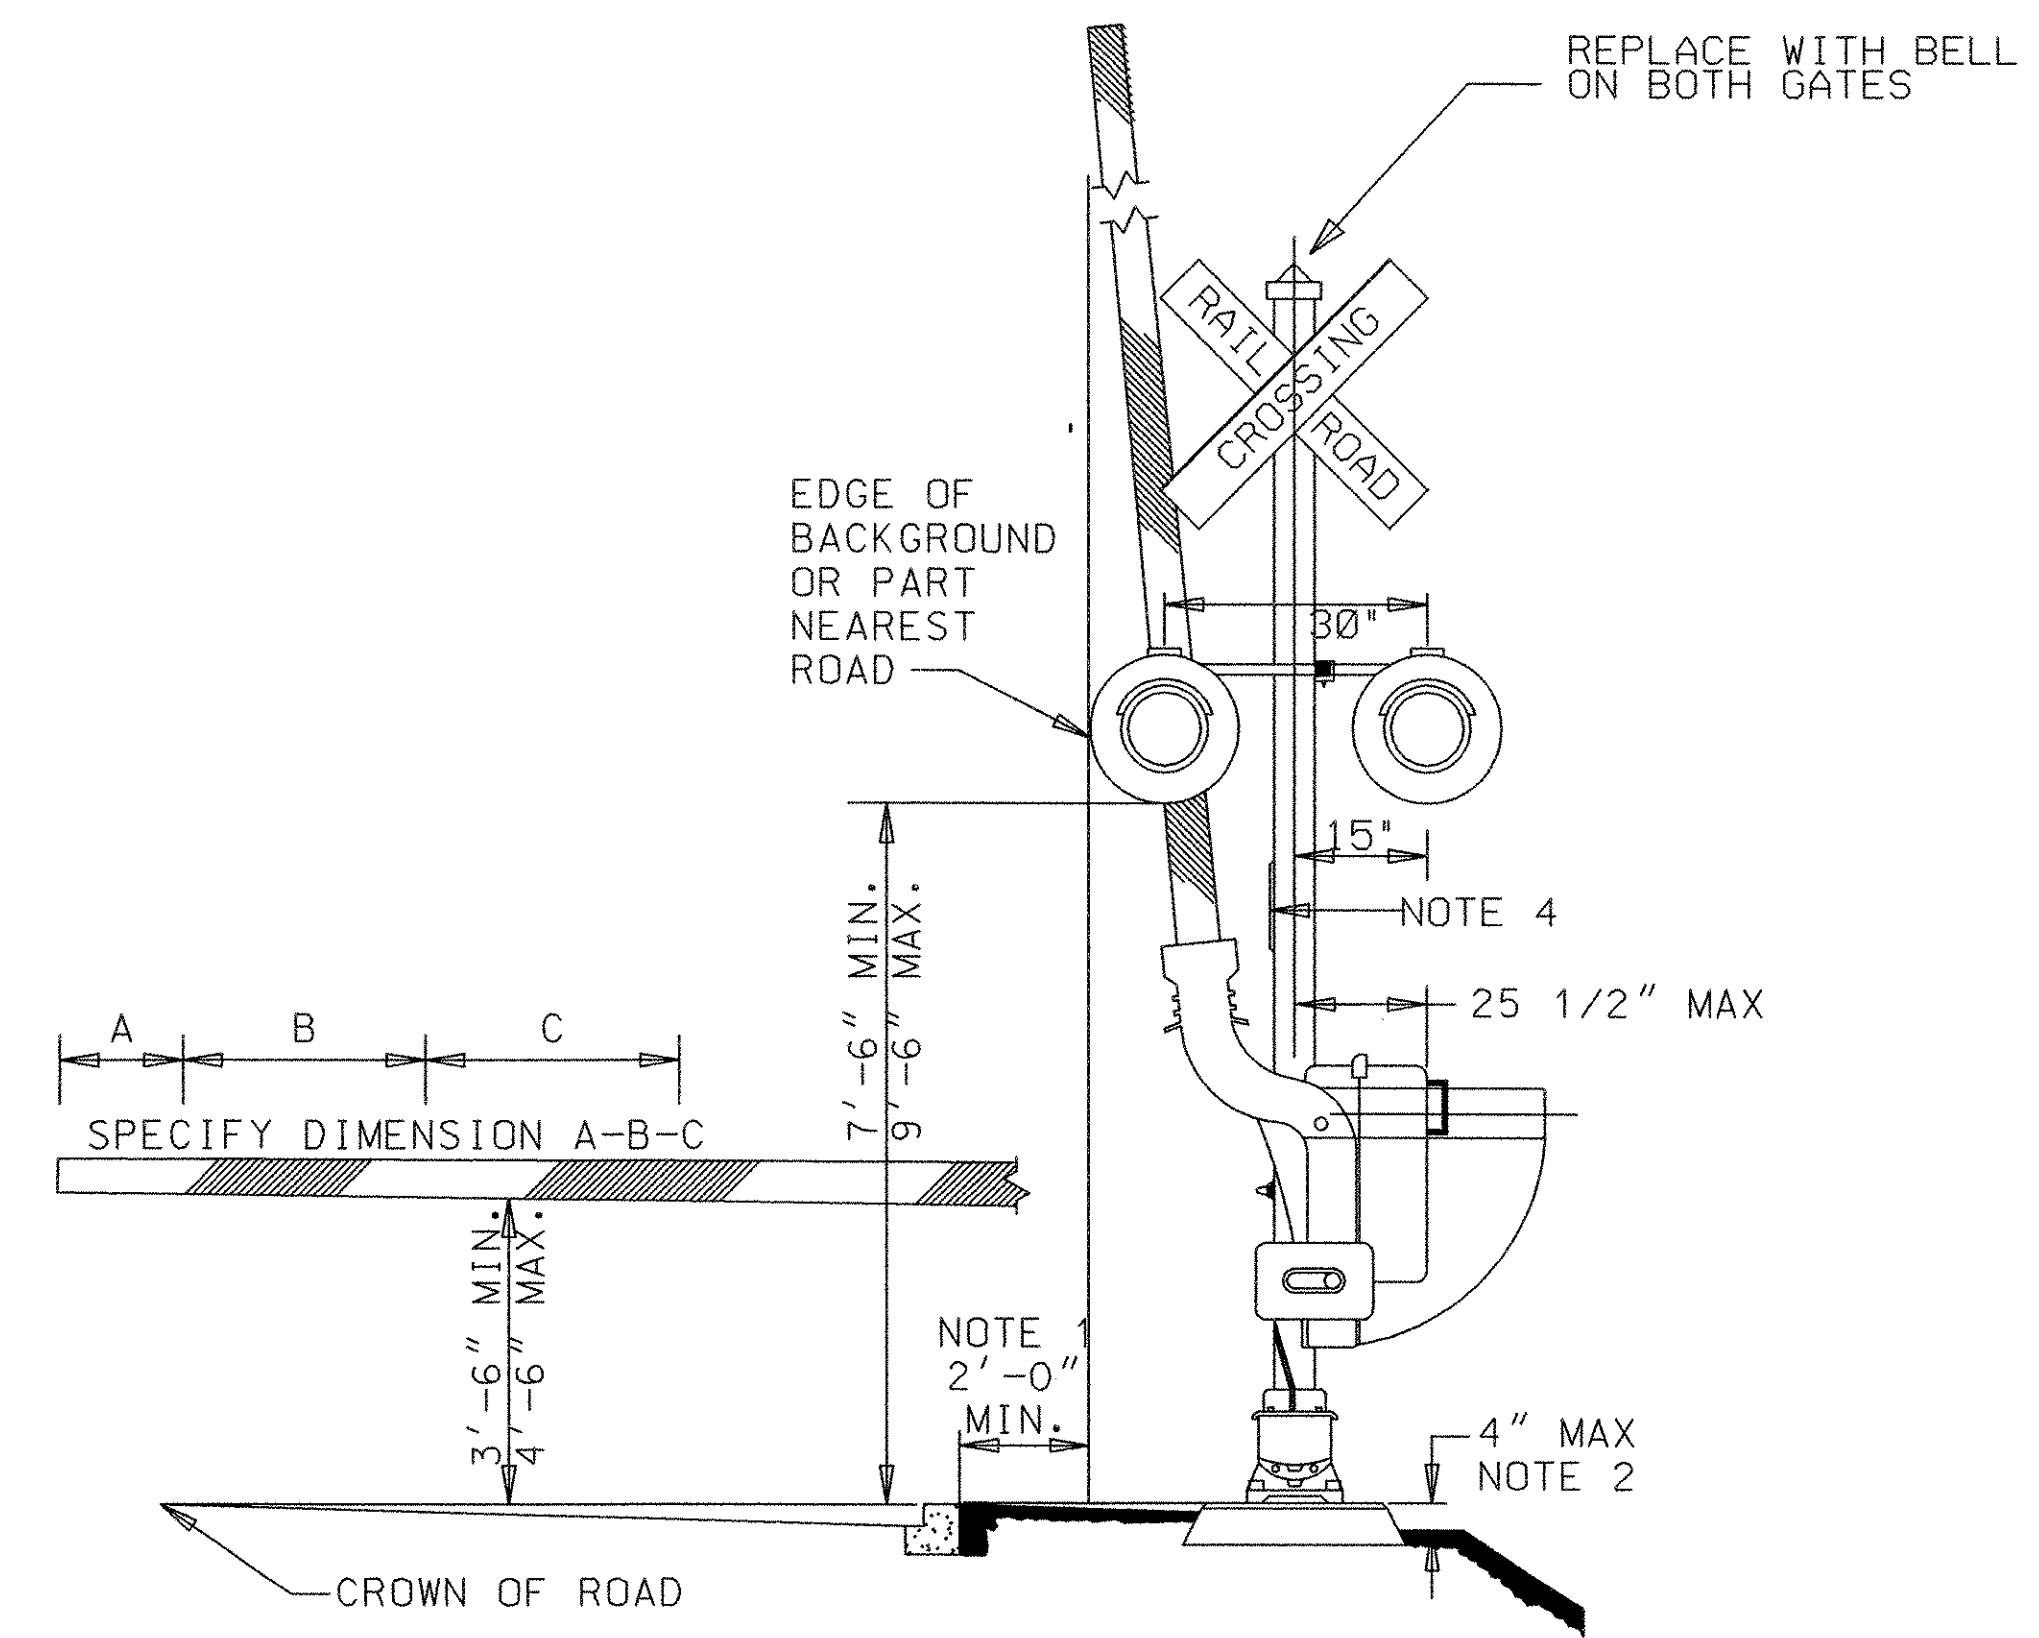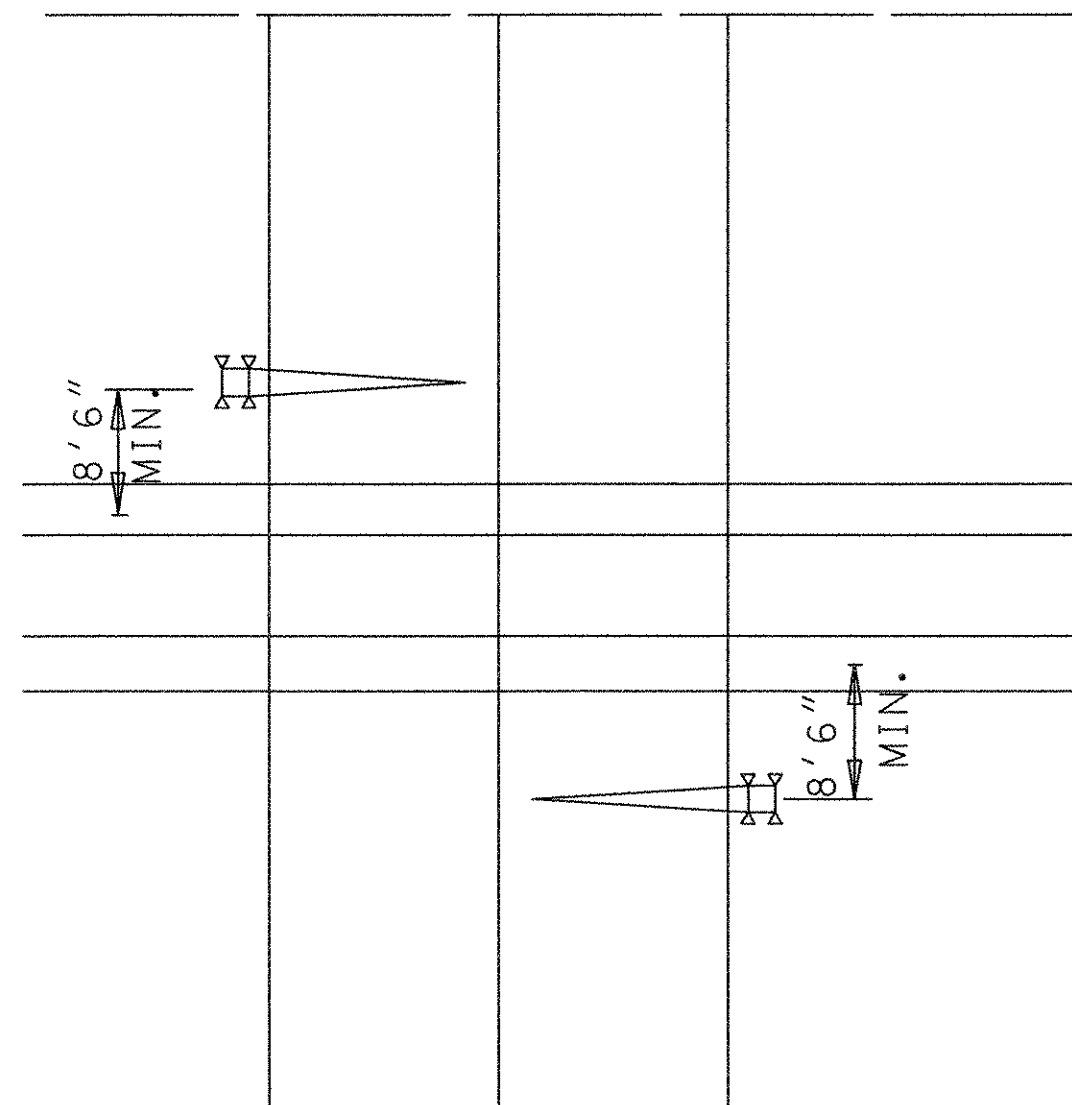

NOTES:

1. A MINIMUM CLEARANCE OF 6 FT. FROM THE EDGE OF THE TRAVELED ROADWAY.
2. TOP OF FOUNDATION TO BE AT THE SAME ELEVATION AS THE CROWN OF THE ROADWAY, WITH OR WITHOUT CURB AND NO MORE THAN 4 IN. ABOVE SURFACE OF THE GROUND. PROPER DRAINAGE SHOULD BE PROVIDED SO THAT THE ELECTRICAL CONNECTION JUNCTION BOX WILL BE FREE OF RETAINED WATER.
3. TYPICAL MINIMUM CLEARANCE IS 2 FT. FROM FACE OF VERTICAL CURB TO CLOSEST PART OF SIGNAL OR GATE ARM IN THE UPRIGHT POSITION FOR A DISTANCE OF 17 FT. ABOVE THE CROWN OF THE ROADWAY.
4. D.O.T. NUMBER OF THE NATIONAL RAILROAD-HIGHWAY CROSSING INVENTORY SHOULD BE INSTALLED ON THE SIGNAL MAST JUST ABOVE EYE LEVEL.
5. ALL HIGHWAY CROSSING EQUIPMENT TO BE INSTALLED IN ACCORDANCE WITH M.U.T.C.D.
6. GATE LIGHTS TO BE PROVIDED A, B, AND C DISTANCE FROM GATE TIP.

06/13/03 AM
 M:\18737s_vt_rgl_xind\SHARON_CROSSING\dgn\SHT35.dgn

DATUM	
VERTICAL	NAVD88 ± 0.5 FT.
HORIZONTAL	SPC 1983

ORIGINAL PREPARED:		
DATE	REVISIONS	BY

NOT TO SCALE

SIGNAL GATE & FLASHERS DETAILS	
DOT* 247-536R	
PROJECT NAME:	SHARON GRADE CROSSING
PROJECT NUMBER:	STP2034 (13)S
FILE NAME:	SHT36.DGN
PROJECT LEADER:	H. PATEL
DESIGNED BY:	R. CARROLL
PLOT DATE:	06/13/03
DRAWN BY:	A. BOSE
CHECKED BY:	G. SERGOT
SHEET	35 OF 35