
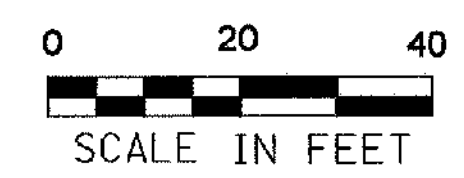


CONSTRUCTION NOTES:

COLD PLANING - BITUMINOUS PAVEMENT
 STA. 38+40 - 38+65
 CONSTRUCT DRIVE APRON
 STA. 34+00, LT. (20' WIDTH)
 STA. 36+40, LT. (22' WIDTH)
 STA. 38+00, LT. (40' WIDTH)

Matchline Sta. 32+75

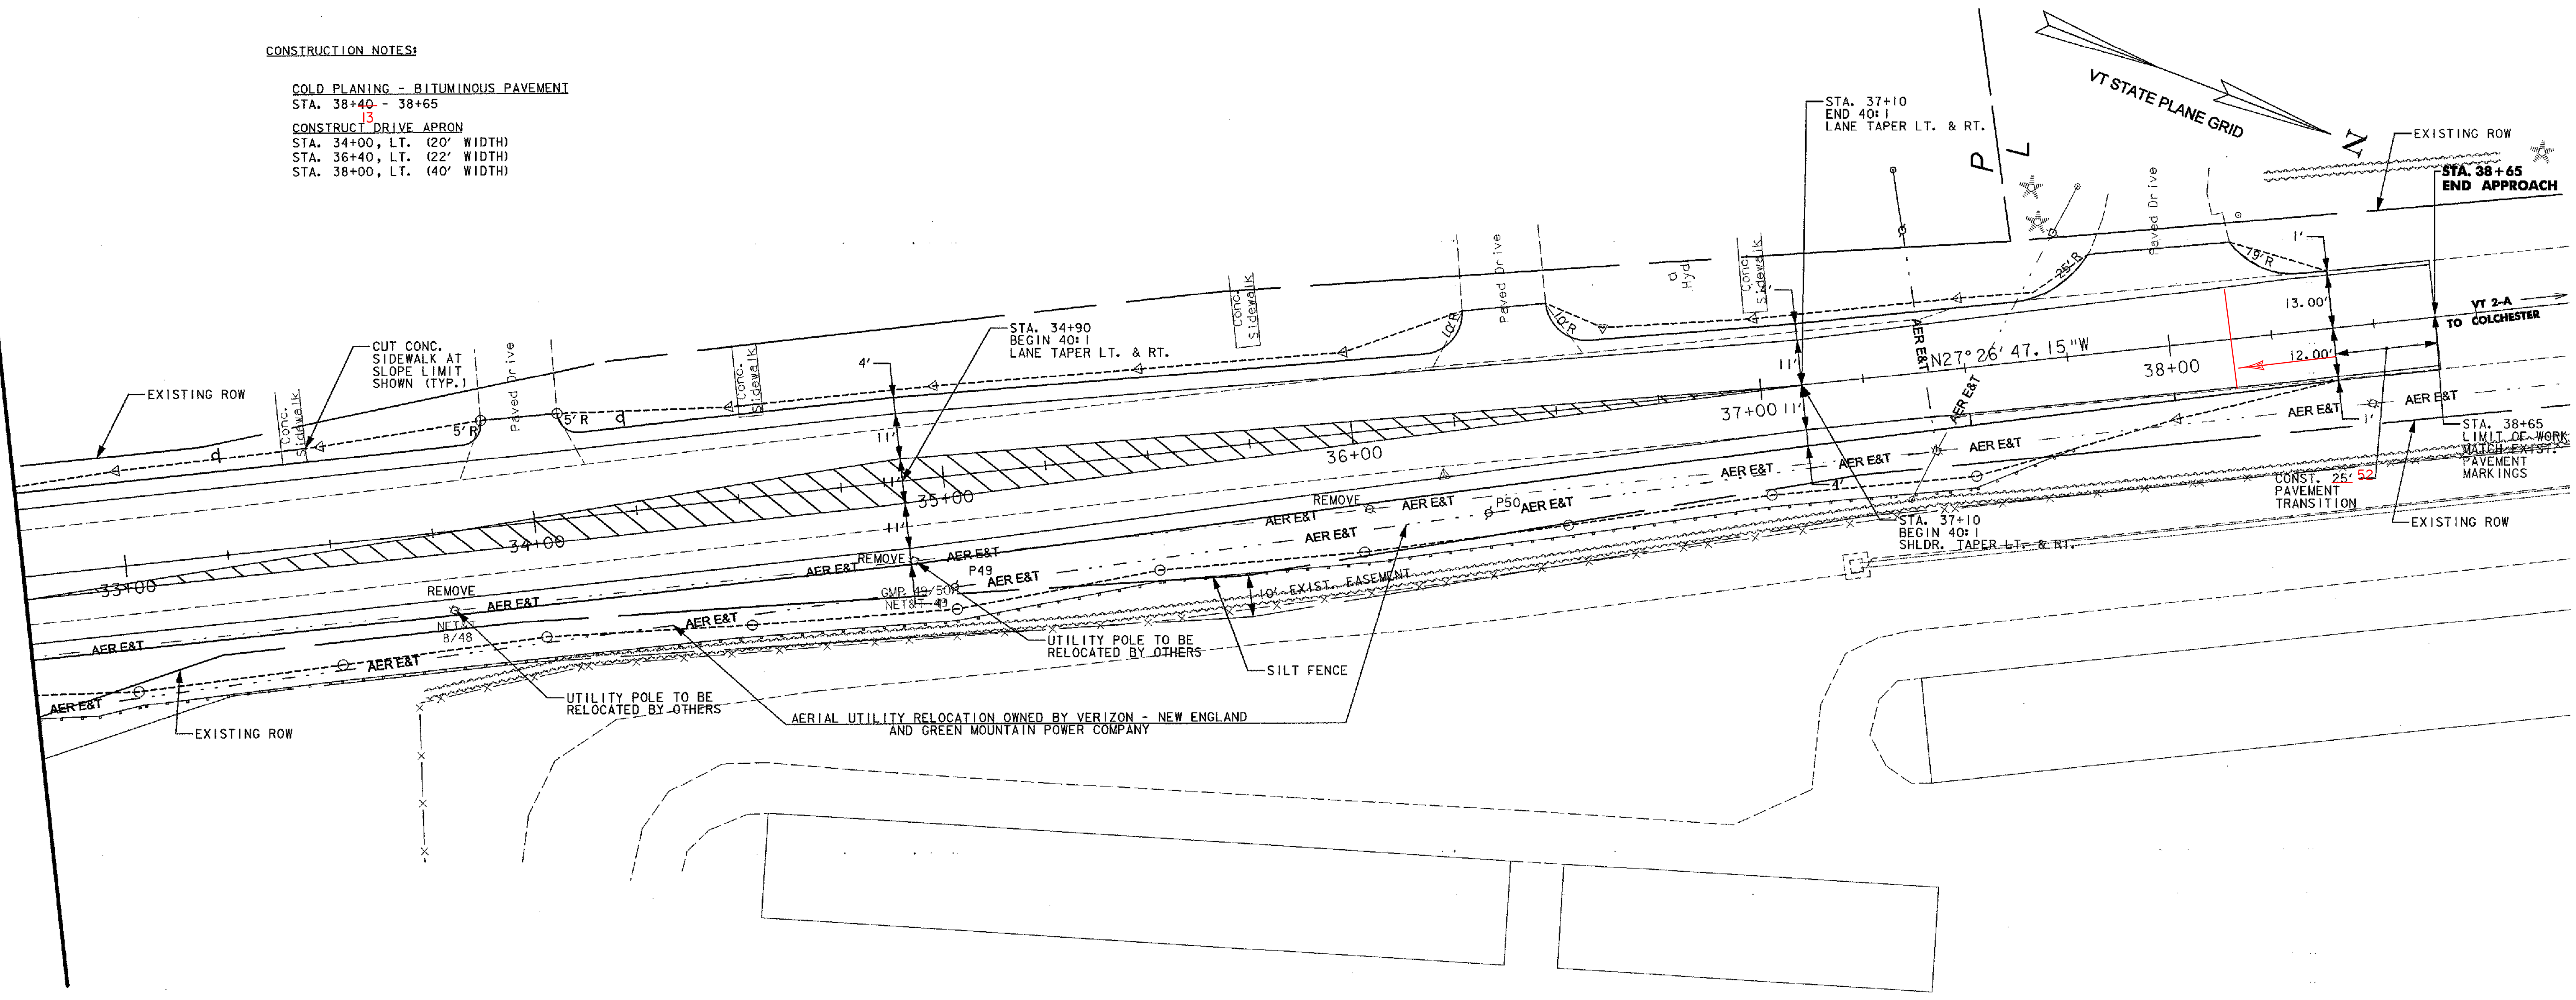

GENERAL PLANS

VT. 2A

DATUM	
VERTICAL	NAVD 88
HORIZONTAL	NAD 83 (96)

VHB Vanasse Hangen Brustlin, Inc.

PROJECT: ESSEX	PROJECT NO.: STP2035(14)S
DESIGN FILE NAME: NH-BED\PROJECTS\CAD\TEXT\51070BDR-3.DGN	PLOT DATE: 06/14/2002
IPARM FILE NAME:	SURVEY DATE: 18Sept99
SURVEYED BY:	DRAWN BY: RBN
SQUAD LEADER: GLB	SHEET: 22 OF 50