
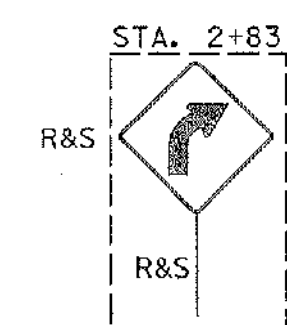


4" YELLOW LINE (DOUBLE CENTERLINE)  
 STA. 2+00 - 4+93  
 STA. 7+43 - 7+75



DURABLE CROSSWALK MARKINGS WITH DIAGONAL LINES (MOD)  
 STA. 6+25, RT.

REMOVE SIGNS  
 5

Match to Sheet 28

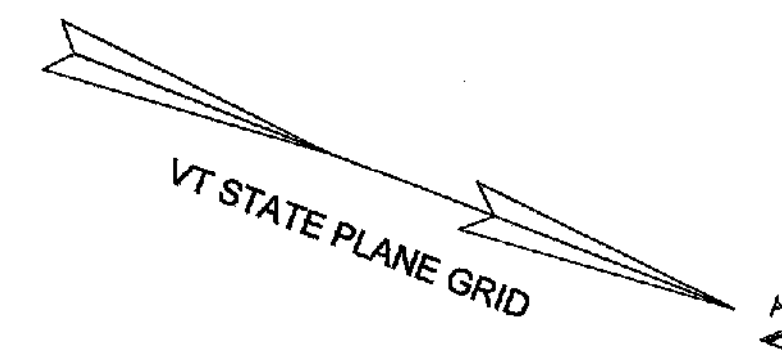

**DETAIL OF DURABLE CROSSWALK MARKINGS WITH DIAGONAL LINES (MOD) ITEM 646.51**

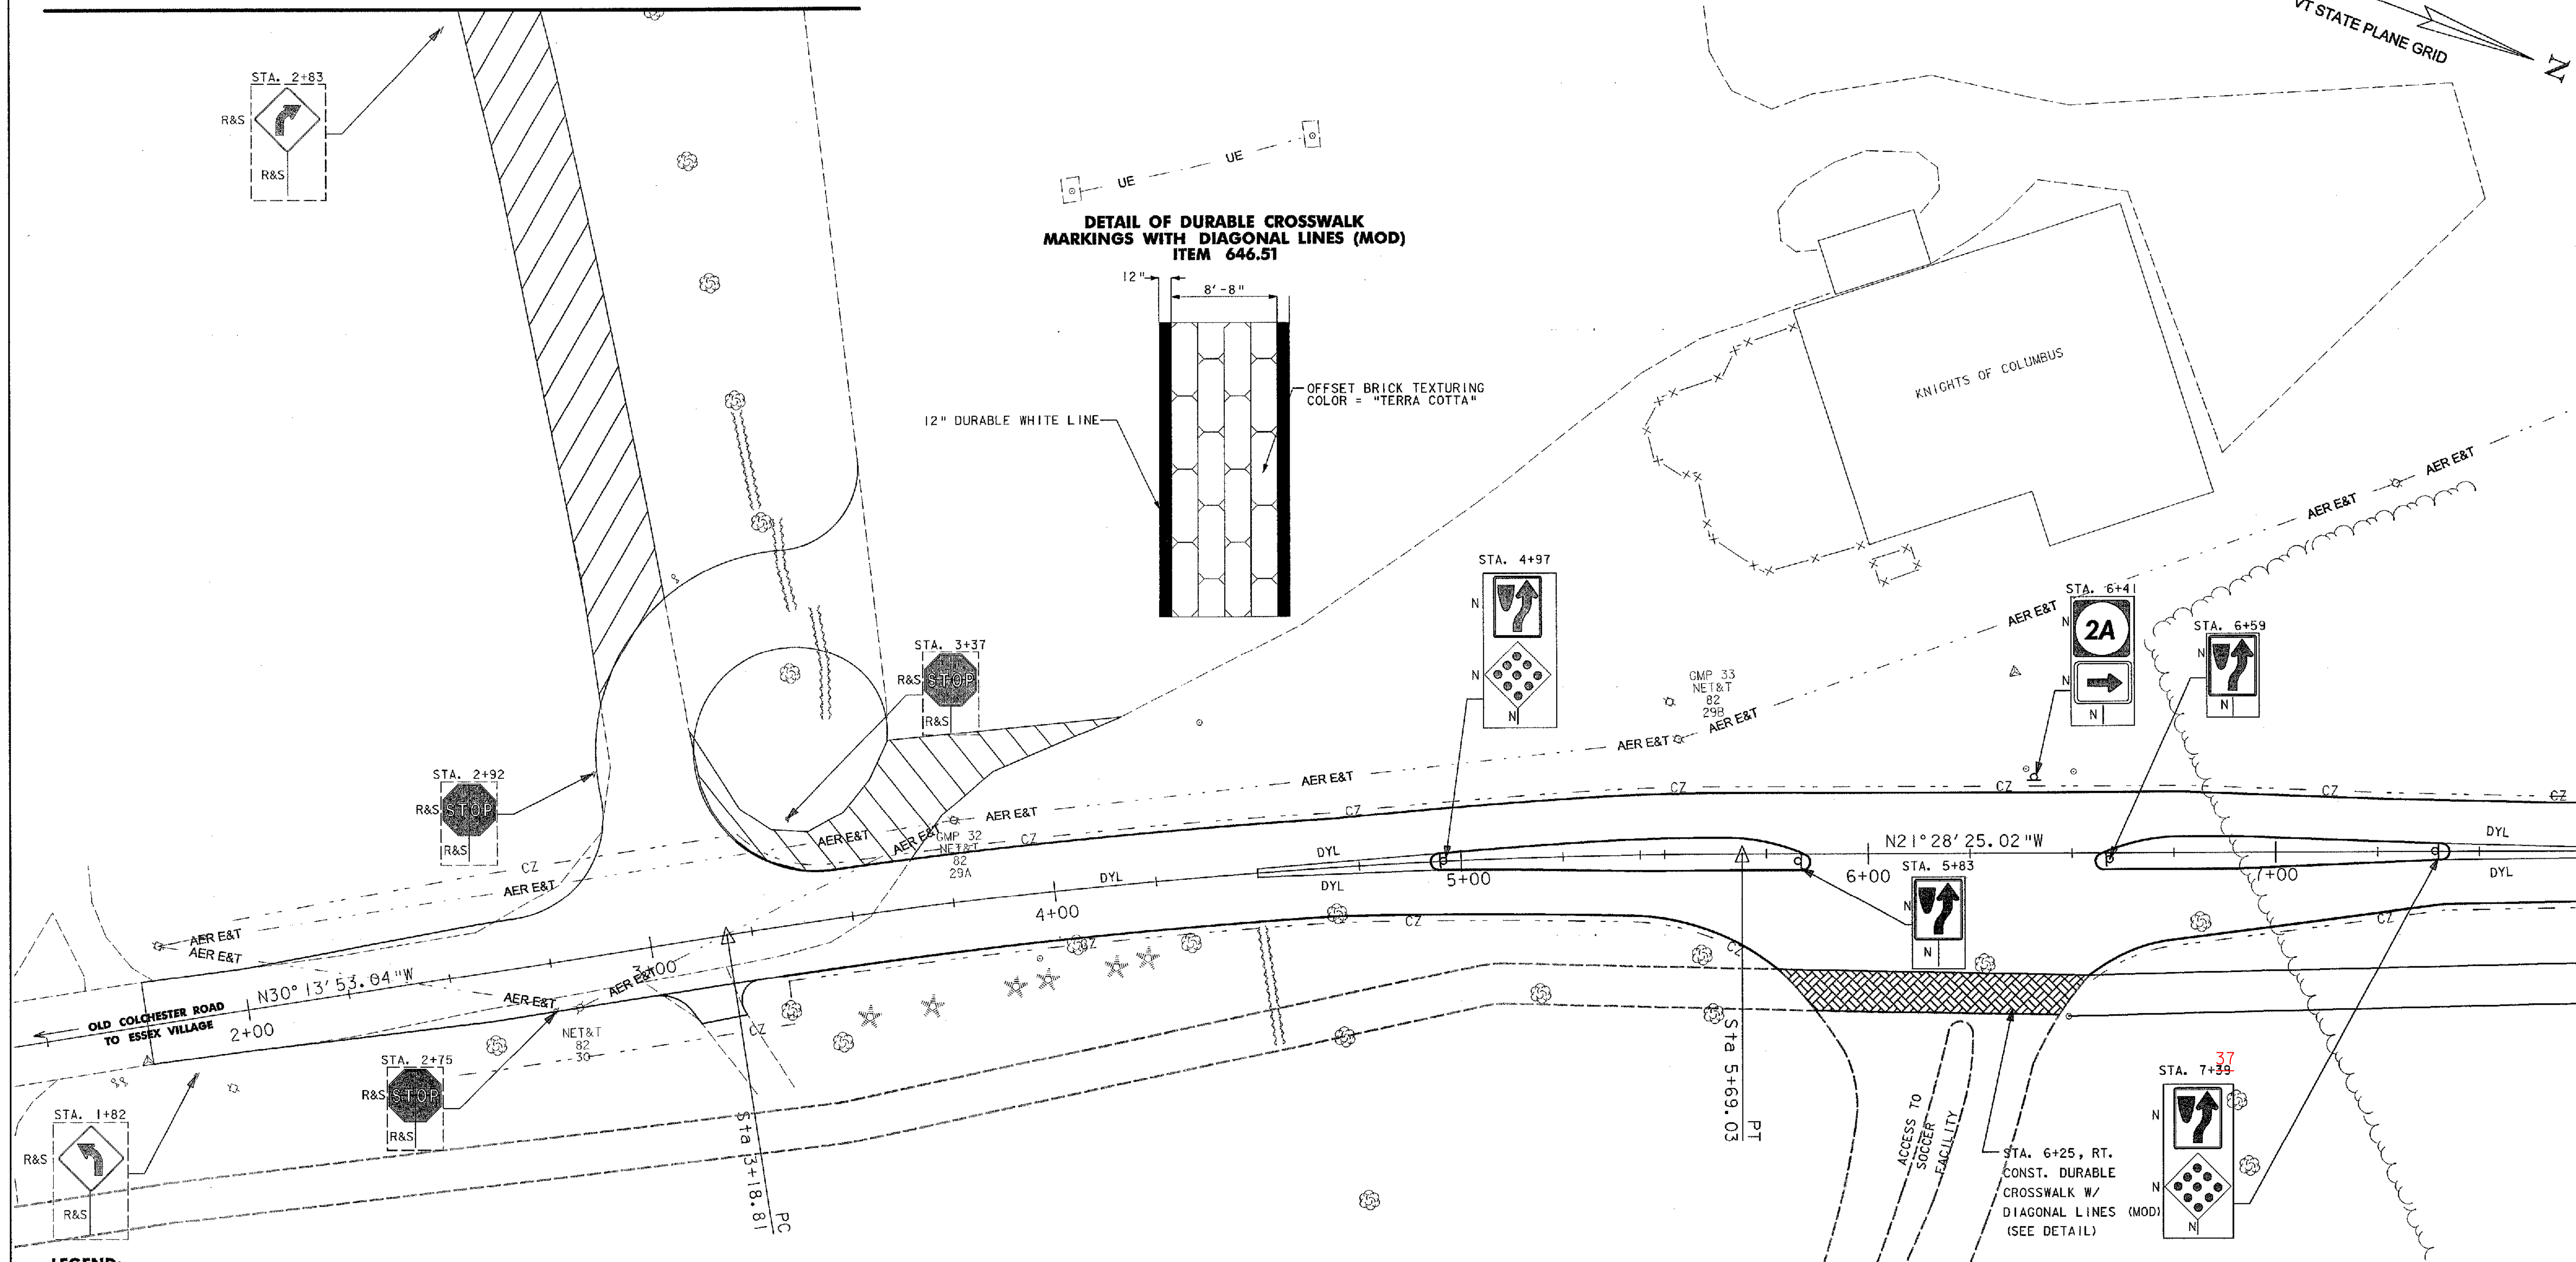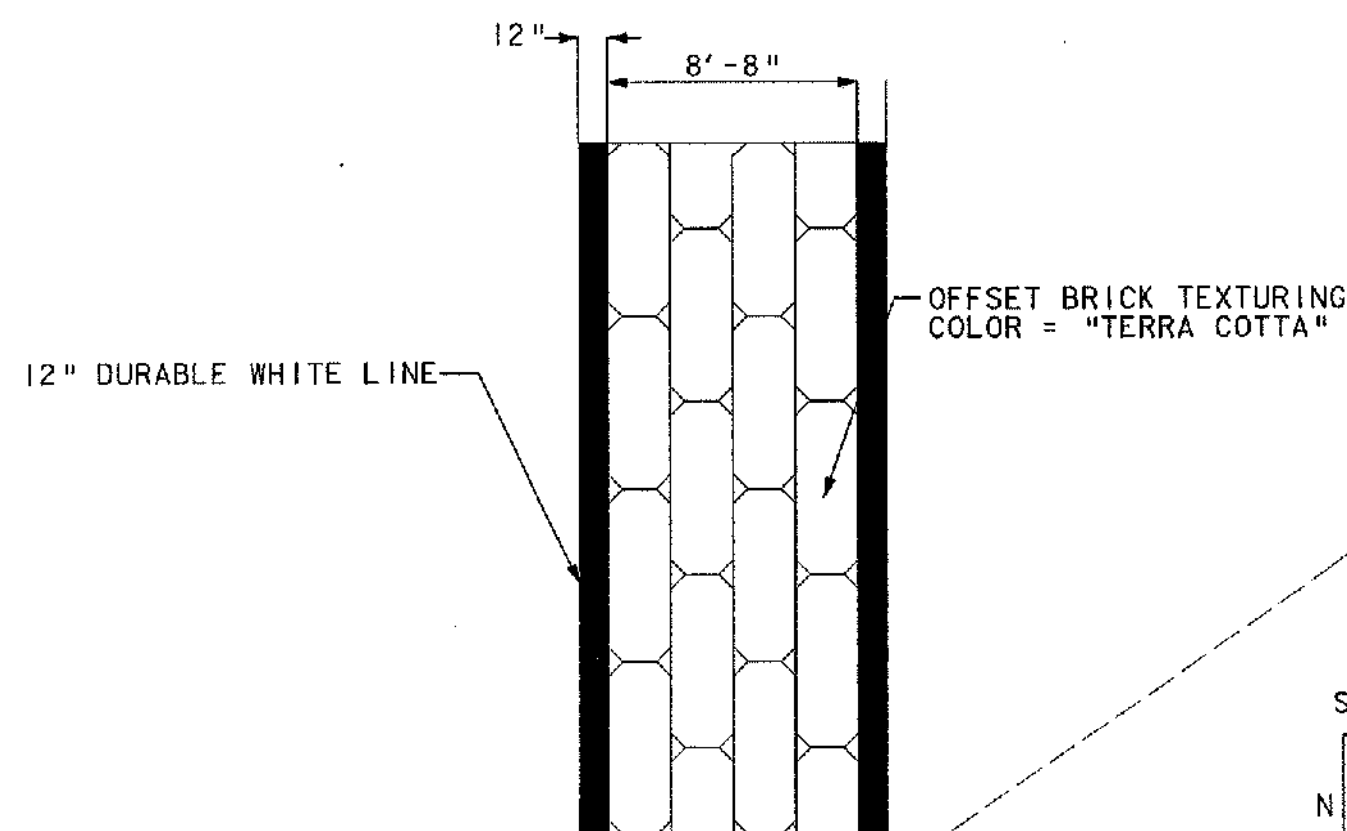


**LEGEND:**

- R&S - REMOVE AND SALVAGE
- DYL - DOUBLE SOLID YELLOW LINE (4")
- SWL - SINGLE SOLID WHITE LINE (4")
- N - NEW

**GENERAL NOTES:**

- 1) ALL SIGNS TO BE SALVAGED TO THE TOWN OF ESSEX

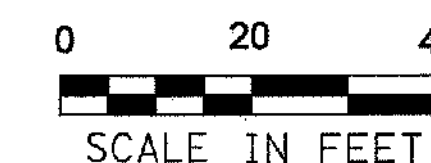

**PAVEMENT MARKING & SIGNING PLAN**

PROJECT: ESSEX	PROJECT NO.: STP2035(14)S
DESIGN FILE NAME: NH-BED\PROJECTS\CAD\TE\51070BDRPM-4.DGN	PLOT DATE: 07/24/2002
IPARM FILE NAME:	SURVEY DATE: 10Sep+99
SURVEYED BY:	DRAWN BY: RBN
SQUAD LEADER: GLB	SHEET: 31 OF 50

DATUM	
VERTICAL	NAVD 88
HORIZONTAL	NAD 83 (96)

**OLD COLCHESTER RD.**

**VHB Vanasse Hangen Brustlin, Inc.**

Matchline Sta. 7 + 75