


NOTE

REFER TO CROSS SECTIONS FOR FINAL GRADING.

EPSC FINAL CONDITIONS SITE PLAN

SCALE: 1" = 20'

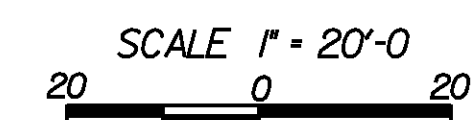

SHEET NAME: EPSC FINAL CONDITIONS SITE PLAN			
PROJECT NAME: TUNBRIDGE		PLOT DATE: 30-APR-2009	
PROJECT NUMBER: BRO 1444 (39)		DRAWN BY: P. Dustin	
FILE NAME: z99j110fnc.dgn	DESIGNED BY: N. Powelson	CHECKED BY: R. Joy	SHEET 12 OF 32