




20+75
BEGIN APPROACH - STA. 20+75

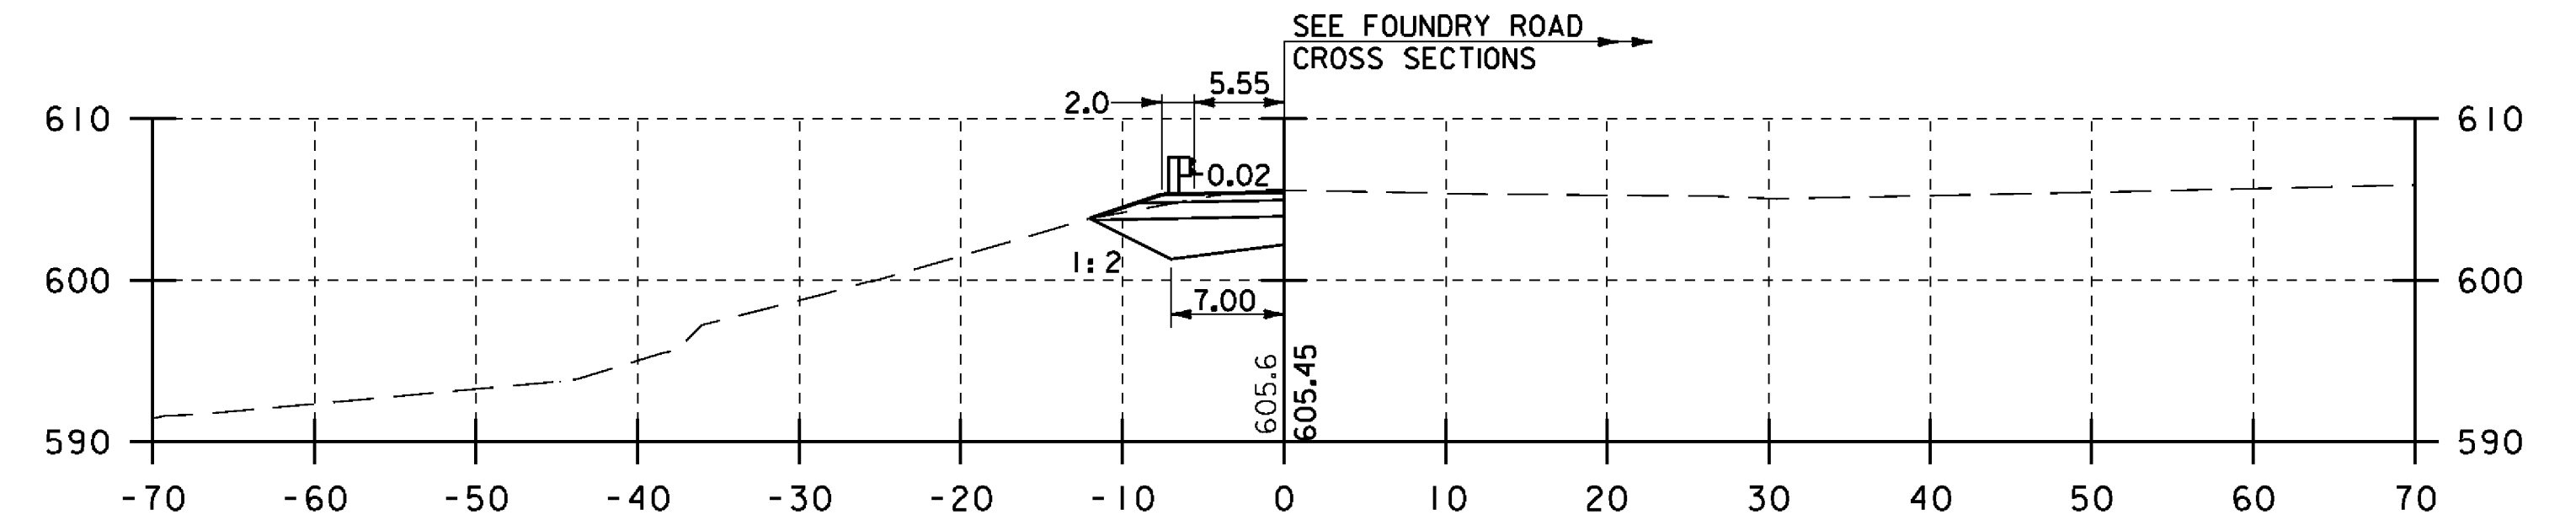


21+25

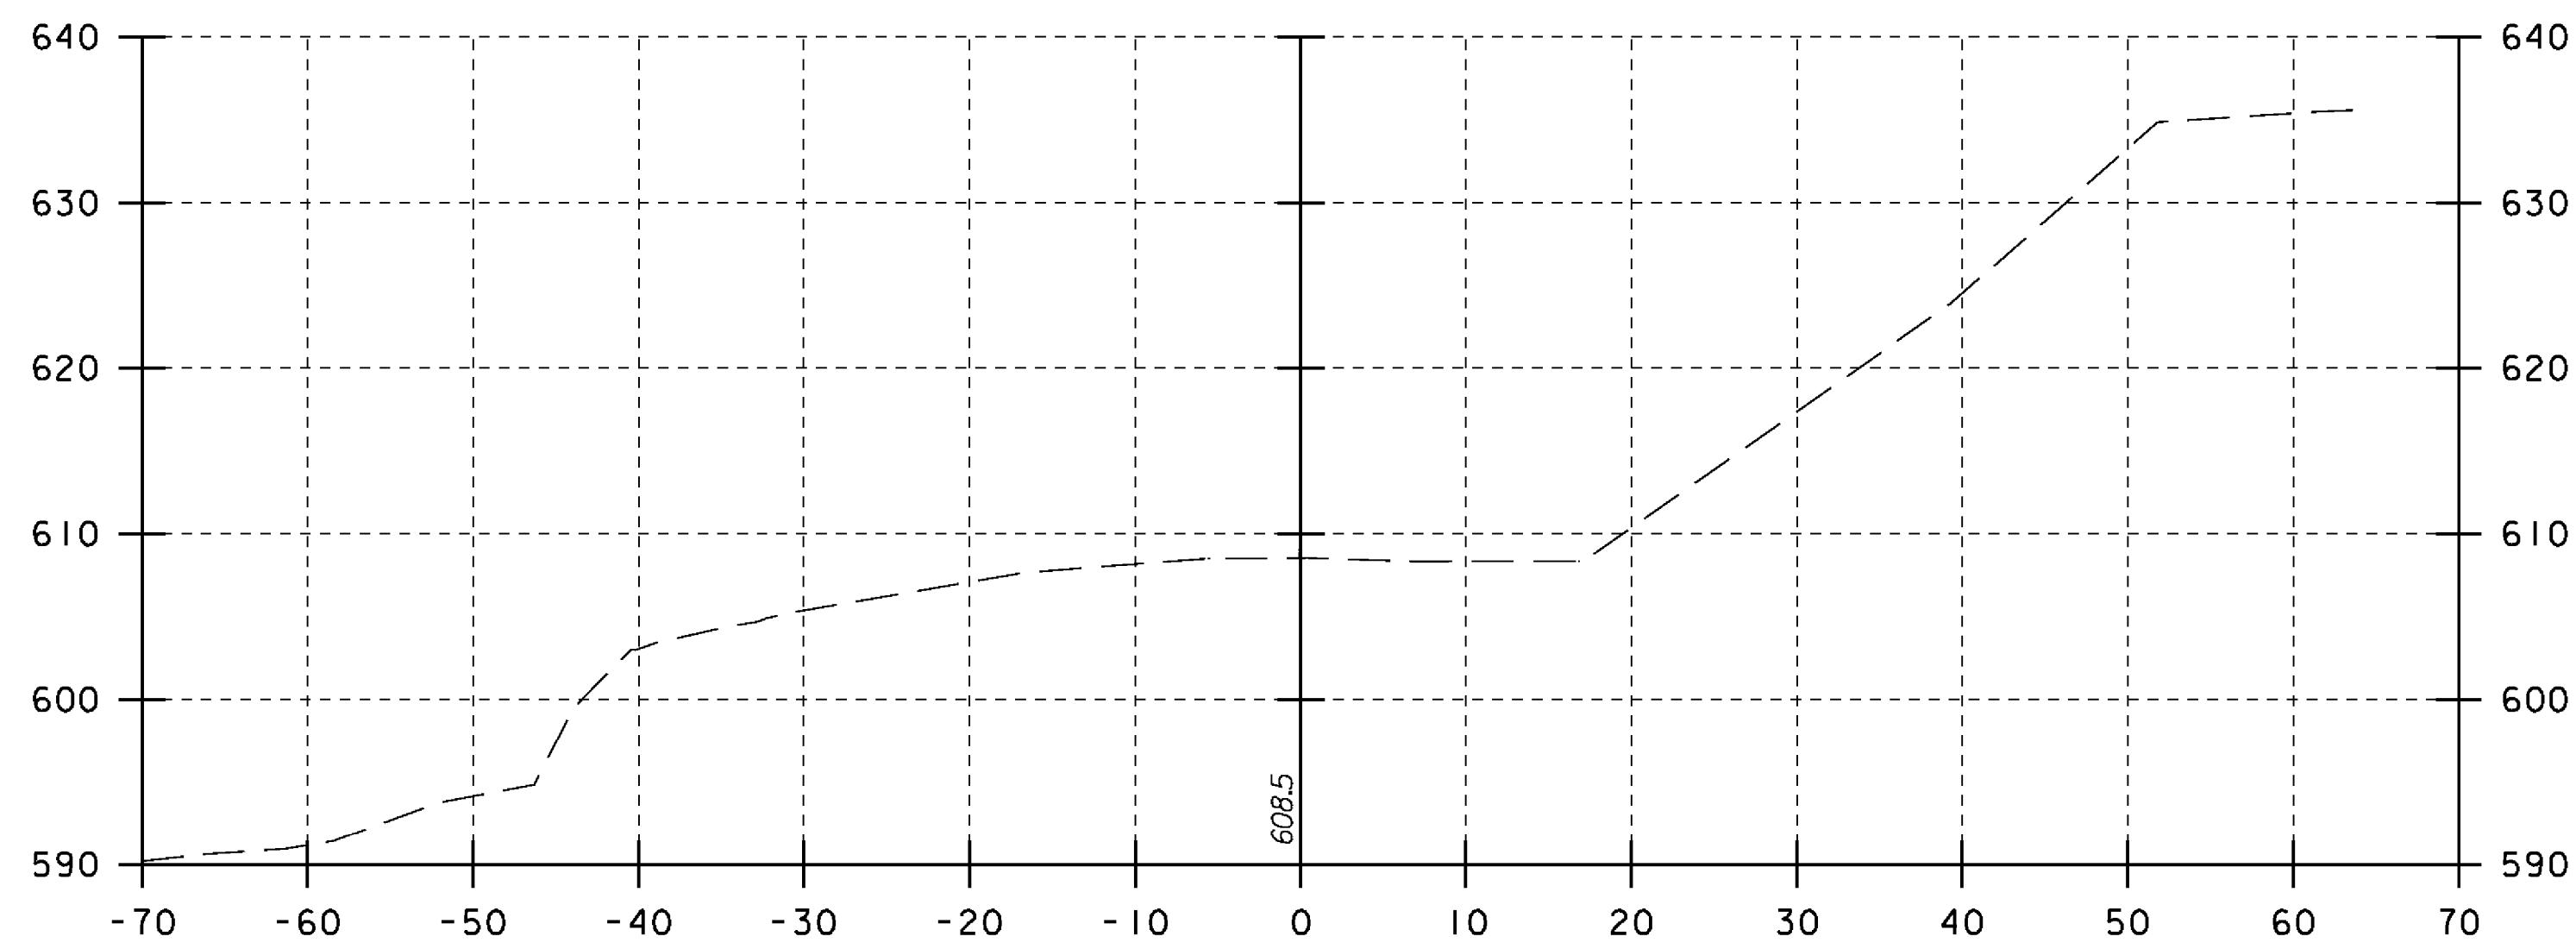

20+50

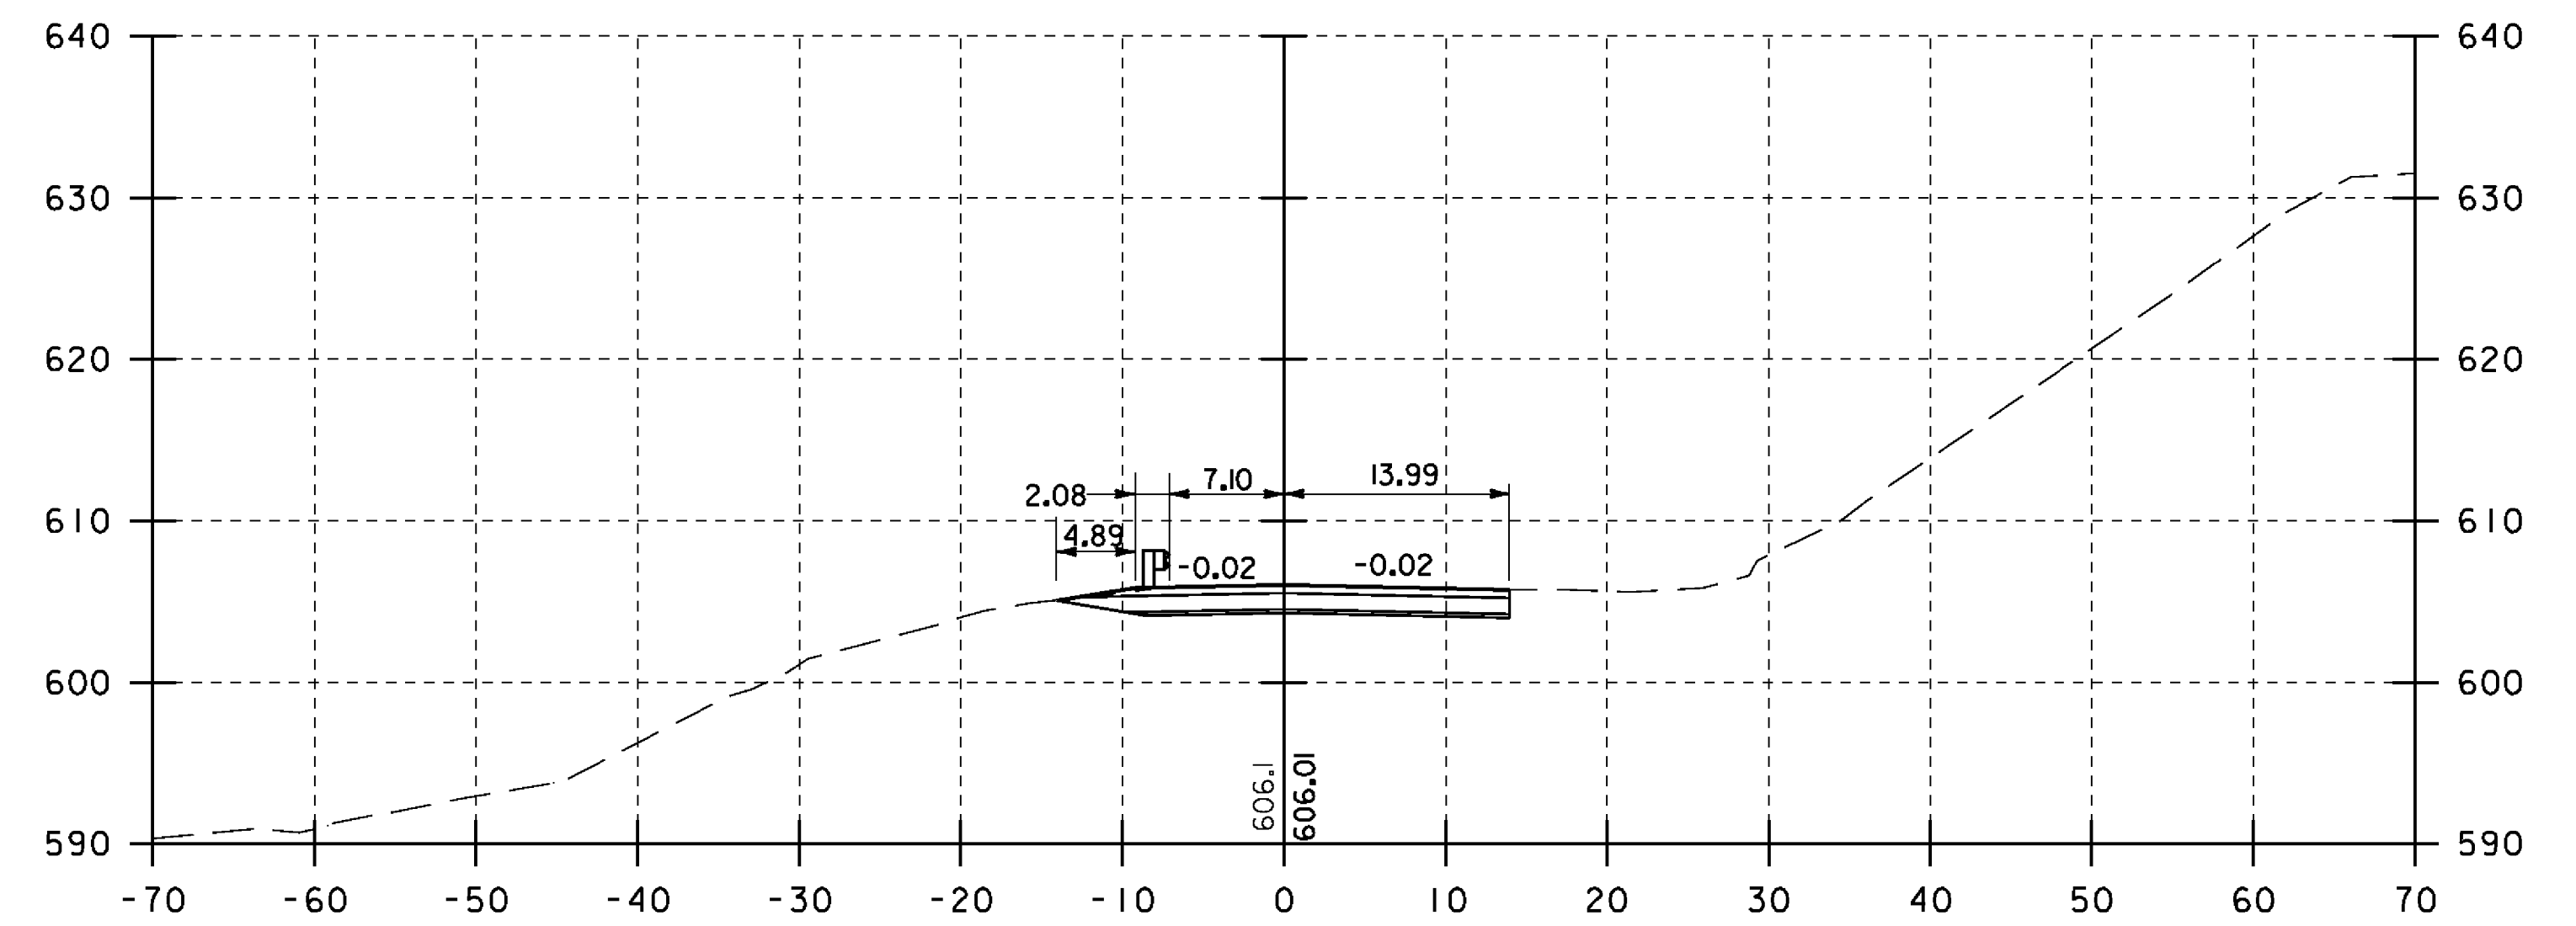

21+00

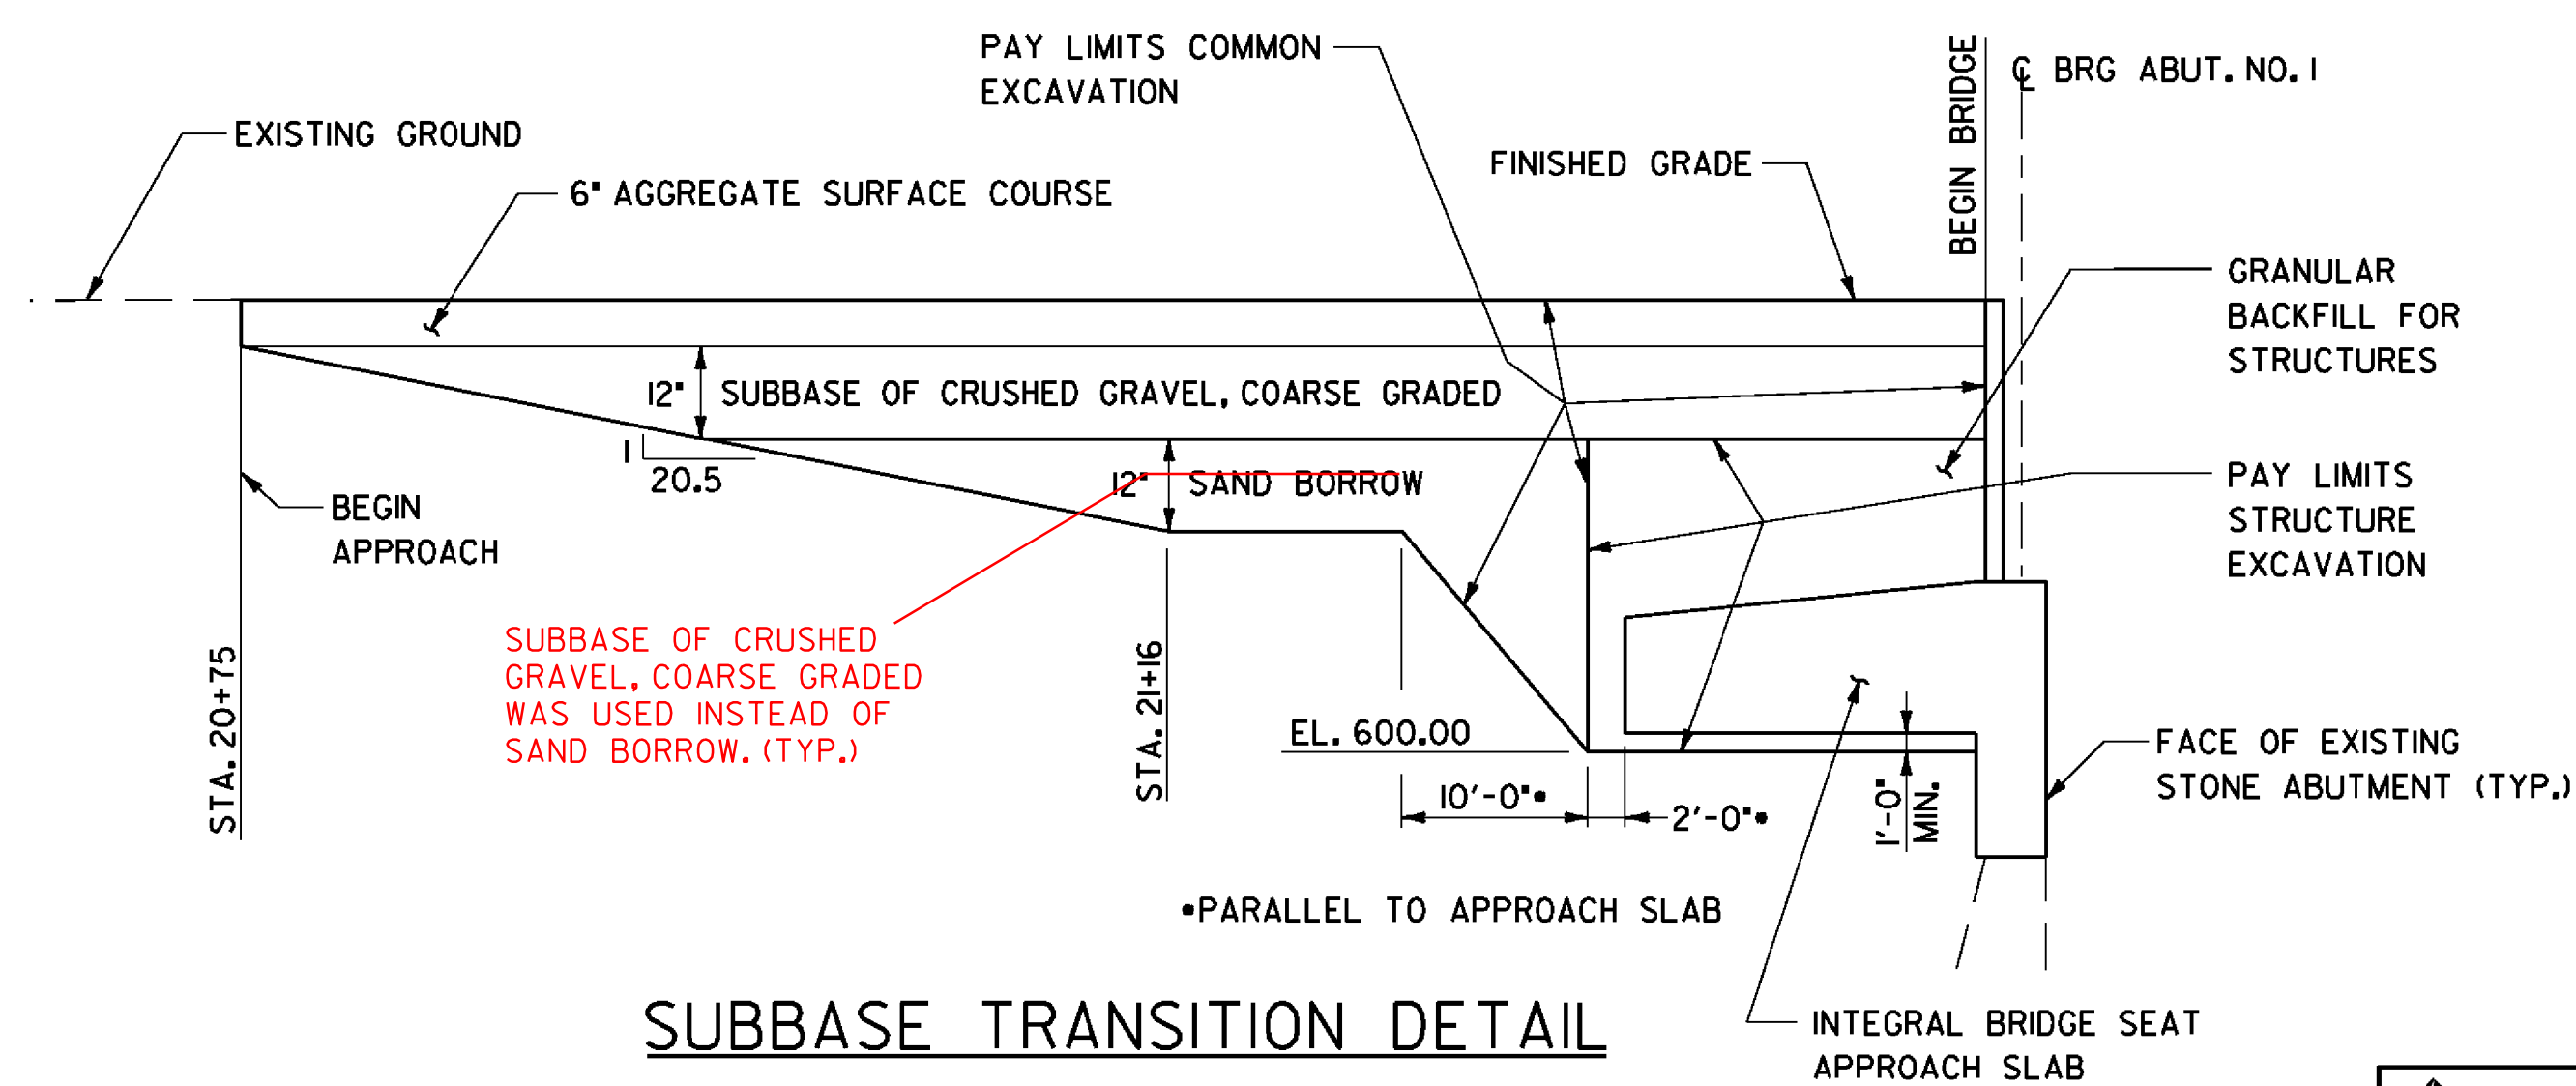

SUBBASE TRANSITION DETAIL

NOT TO SCALE

SHEET NAME: T.H. 79 CROSS SECTIONS

PROJECT NAME: TUNBRIDGE

PROJECT NUMBER: BRO 1444 (39)

FILE NAME: z99J10xs2.dgn

PLOT DATE: 29-APR-2009

PROJECT LEADER: K.M. Higgins

DRAWN BY: P. Dustin

DESIGNED BY: S. Della

CHECKED BY: R. Joy

SHEET 31 OF 32

