




30+50

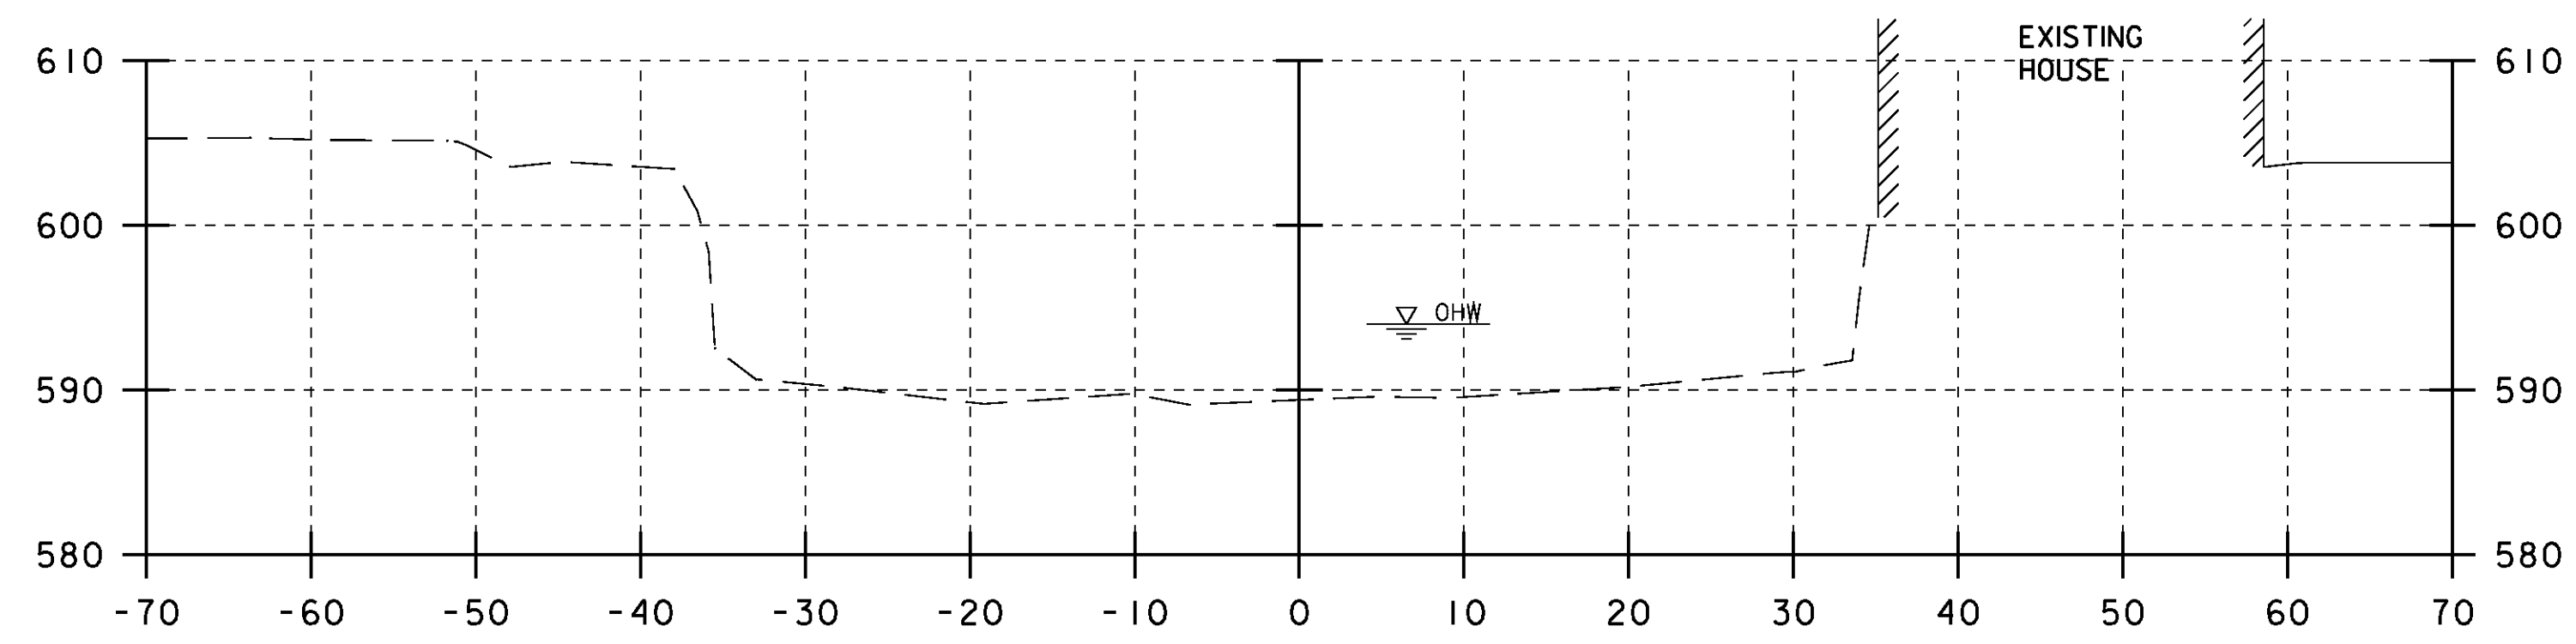


30+25

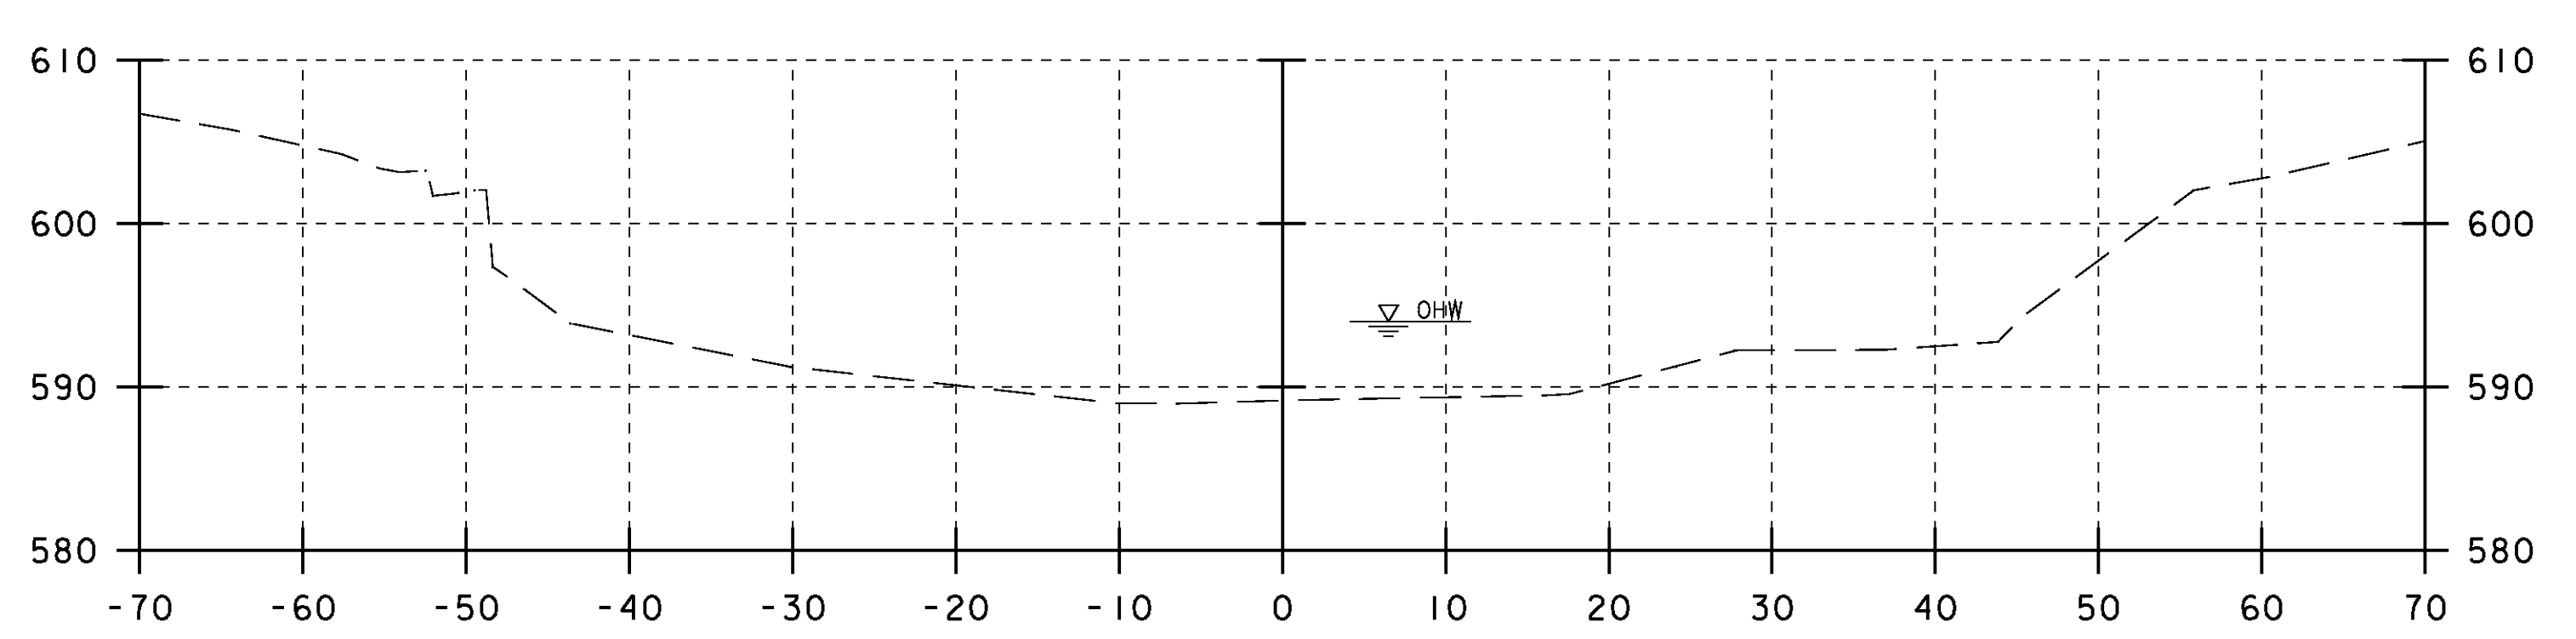

31+00

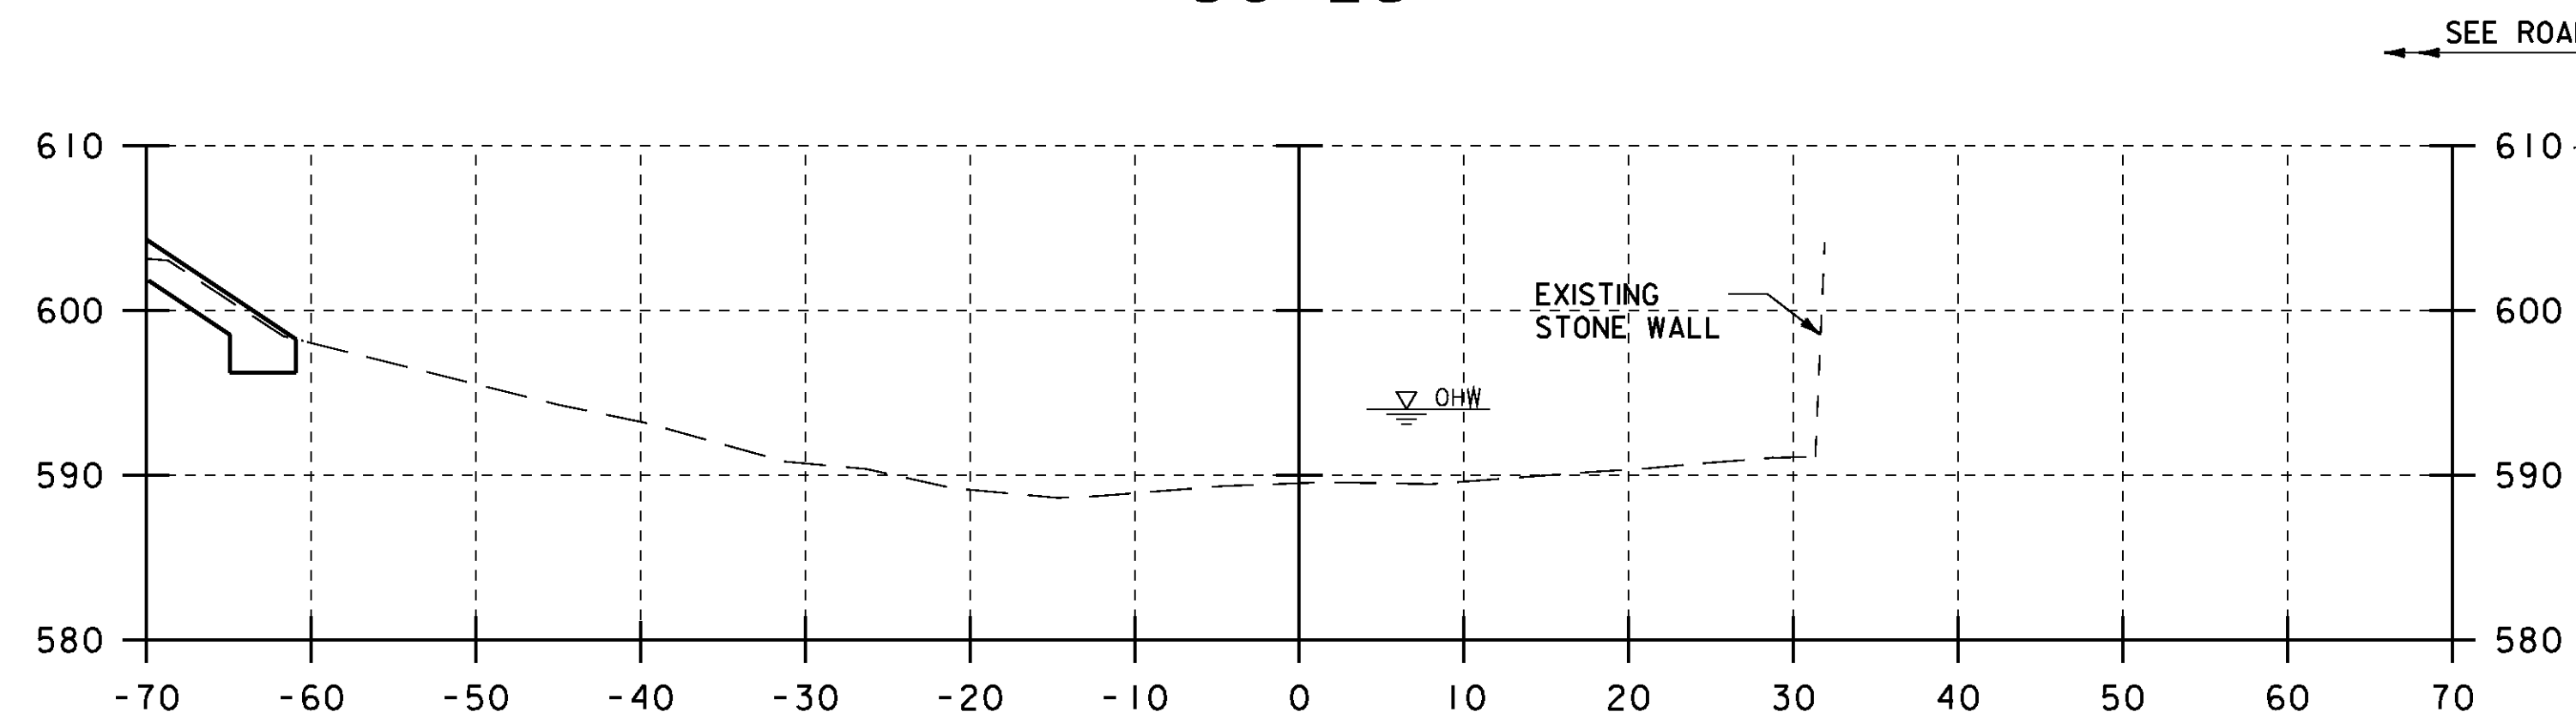

30+00

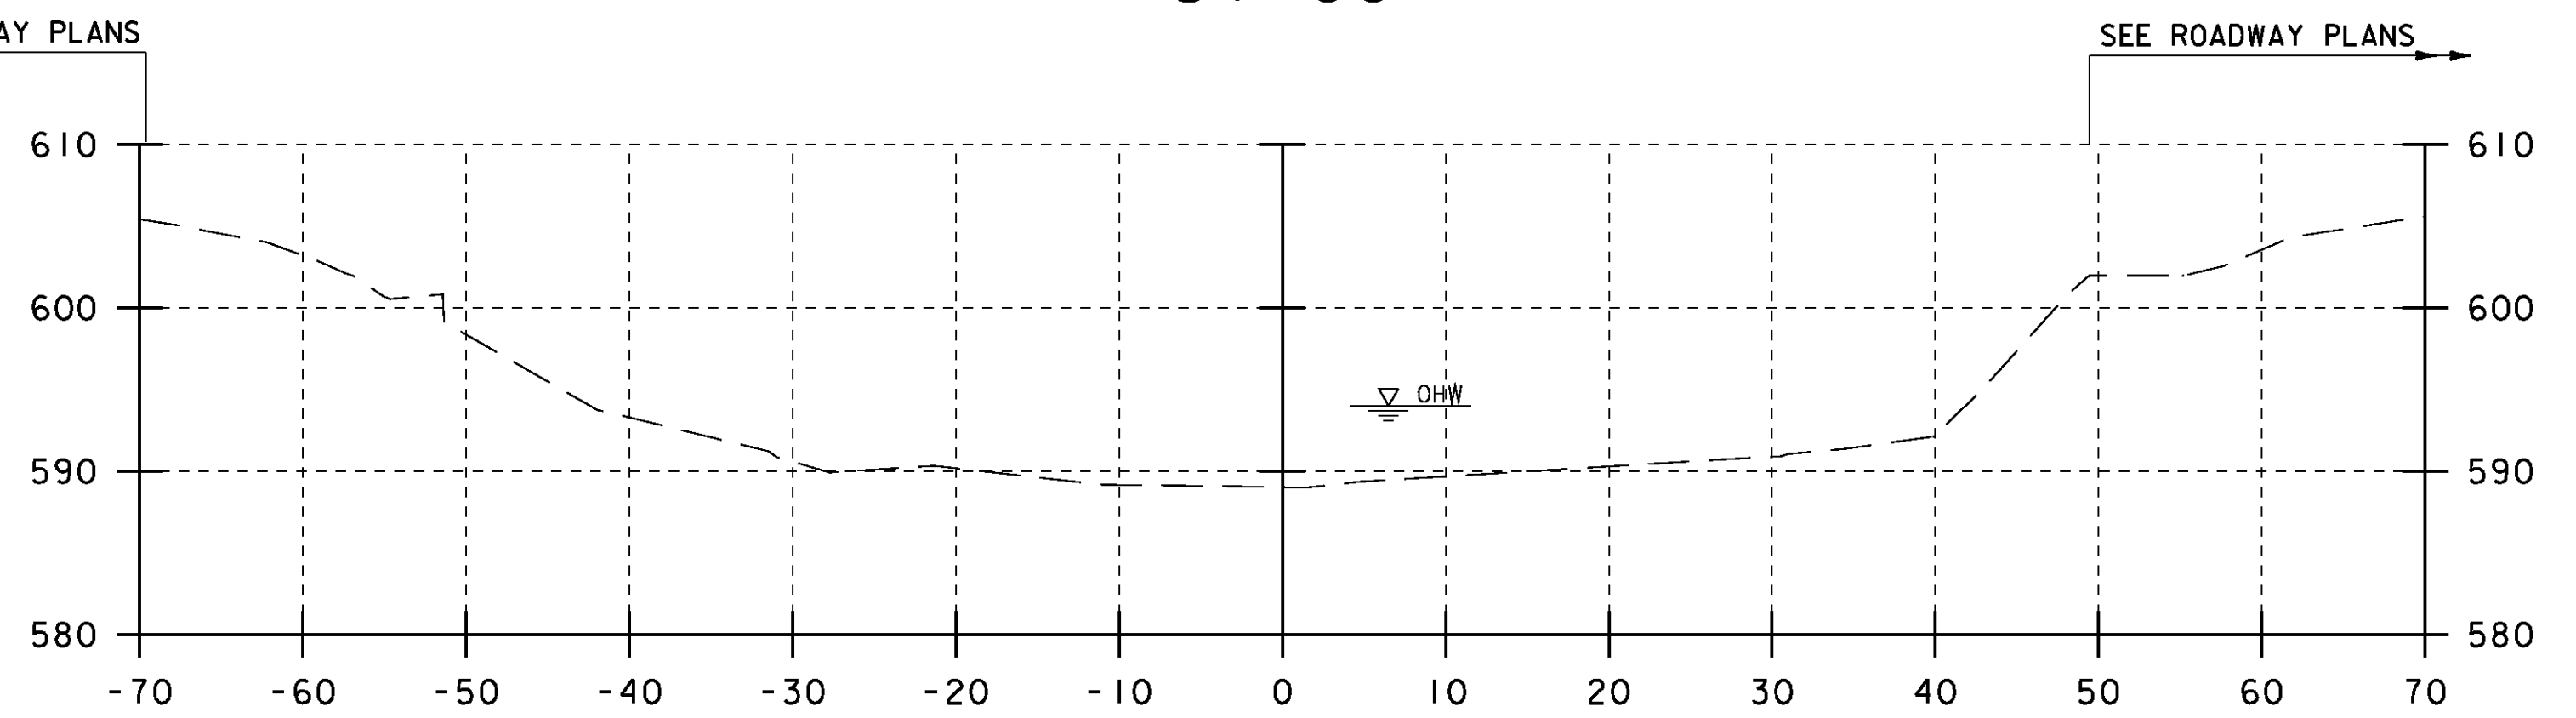

30+75

SHEET NAME: CHANNEL CROSS SECTIONS			
PROJECT NAME: TUNBRIDGE			
PROJECT NUMBER: BRO 1444 (39)			
FILE NAME:	z99J10xsc.dgn	PLOT DATE:	29-APR-2009
PROJECT LEADER:	K.M. Higgins	DRAWN BY:	P. Dustin
DESIGNED BY:	S. Della	CHECKED BY:	R. Joy
		SHEET	32 OF 32

