

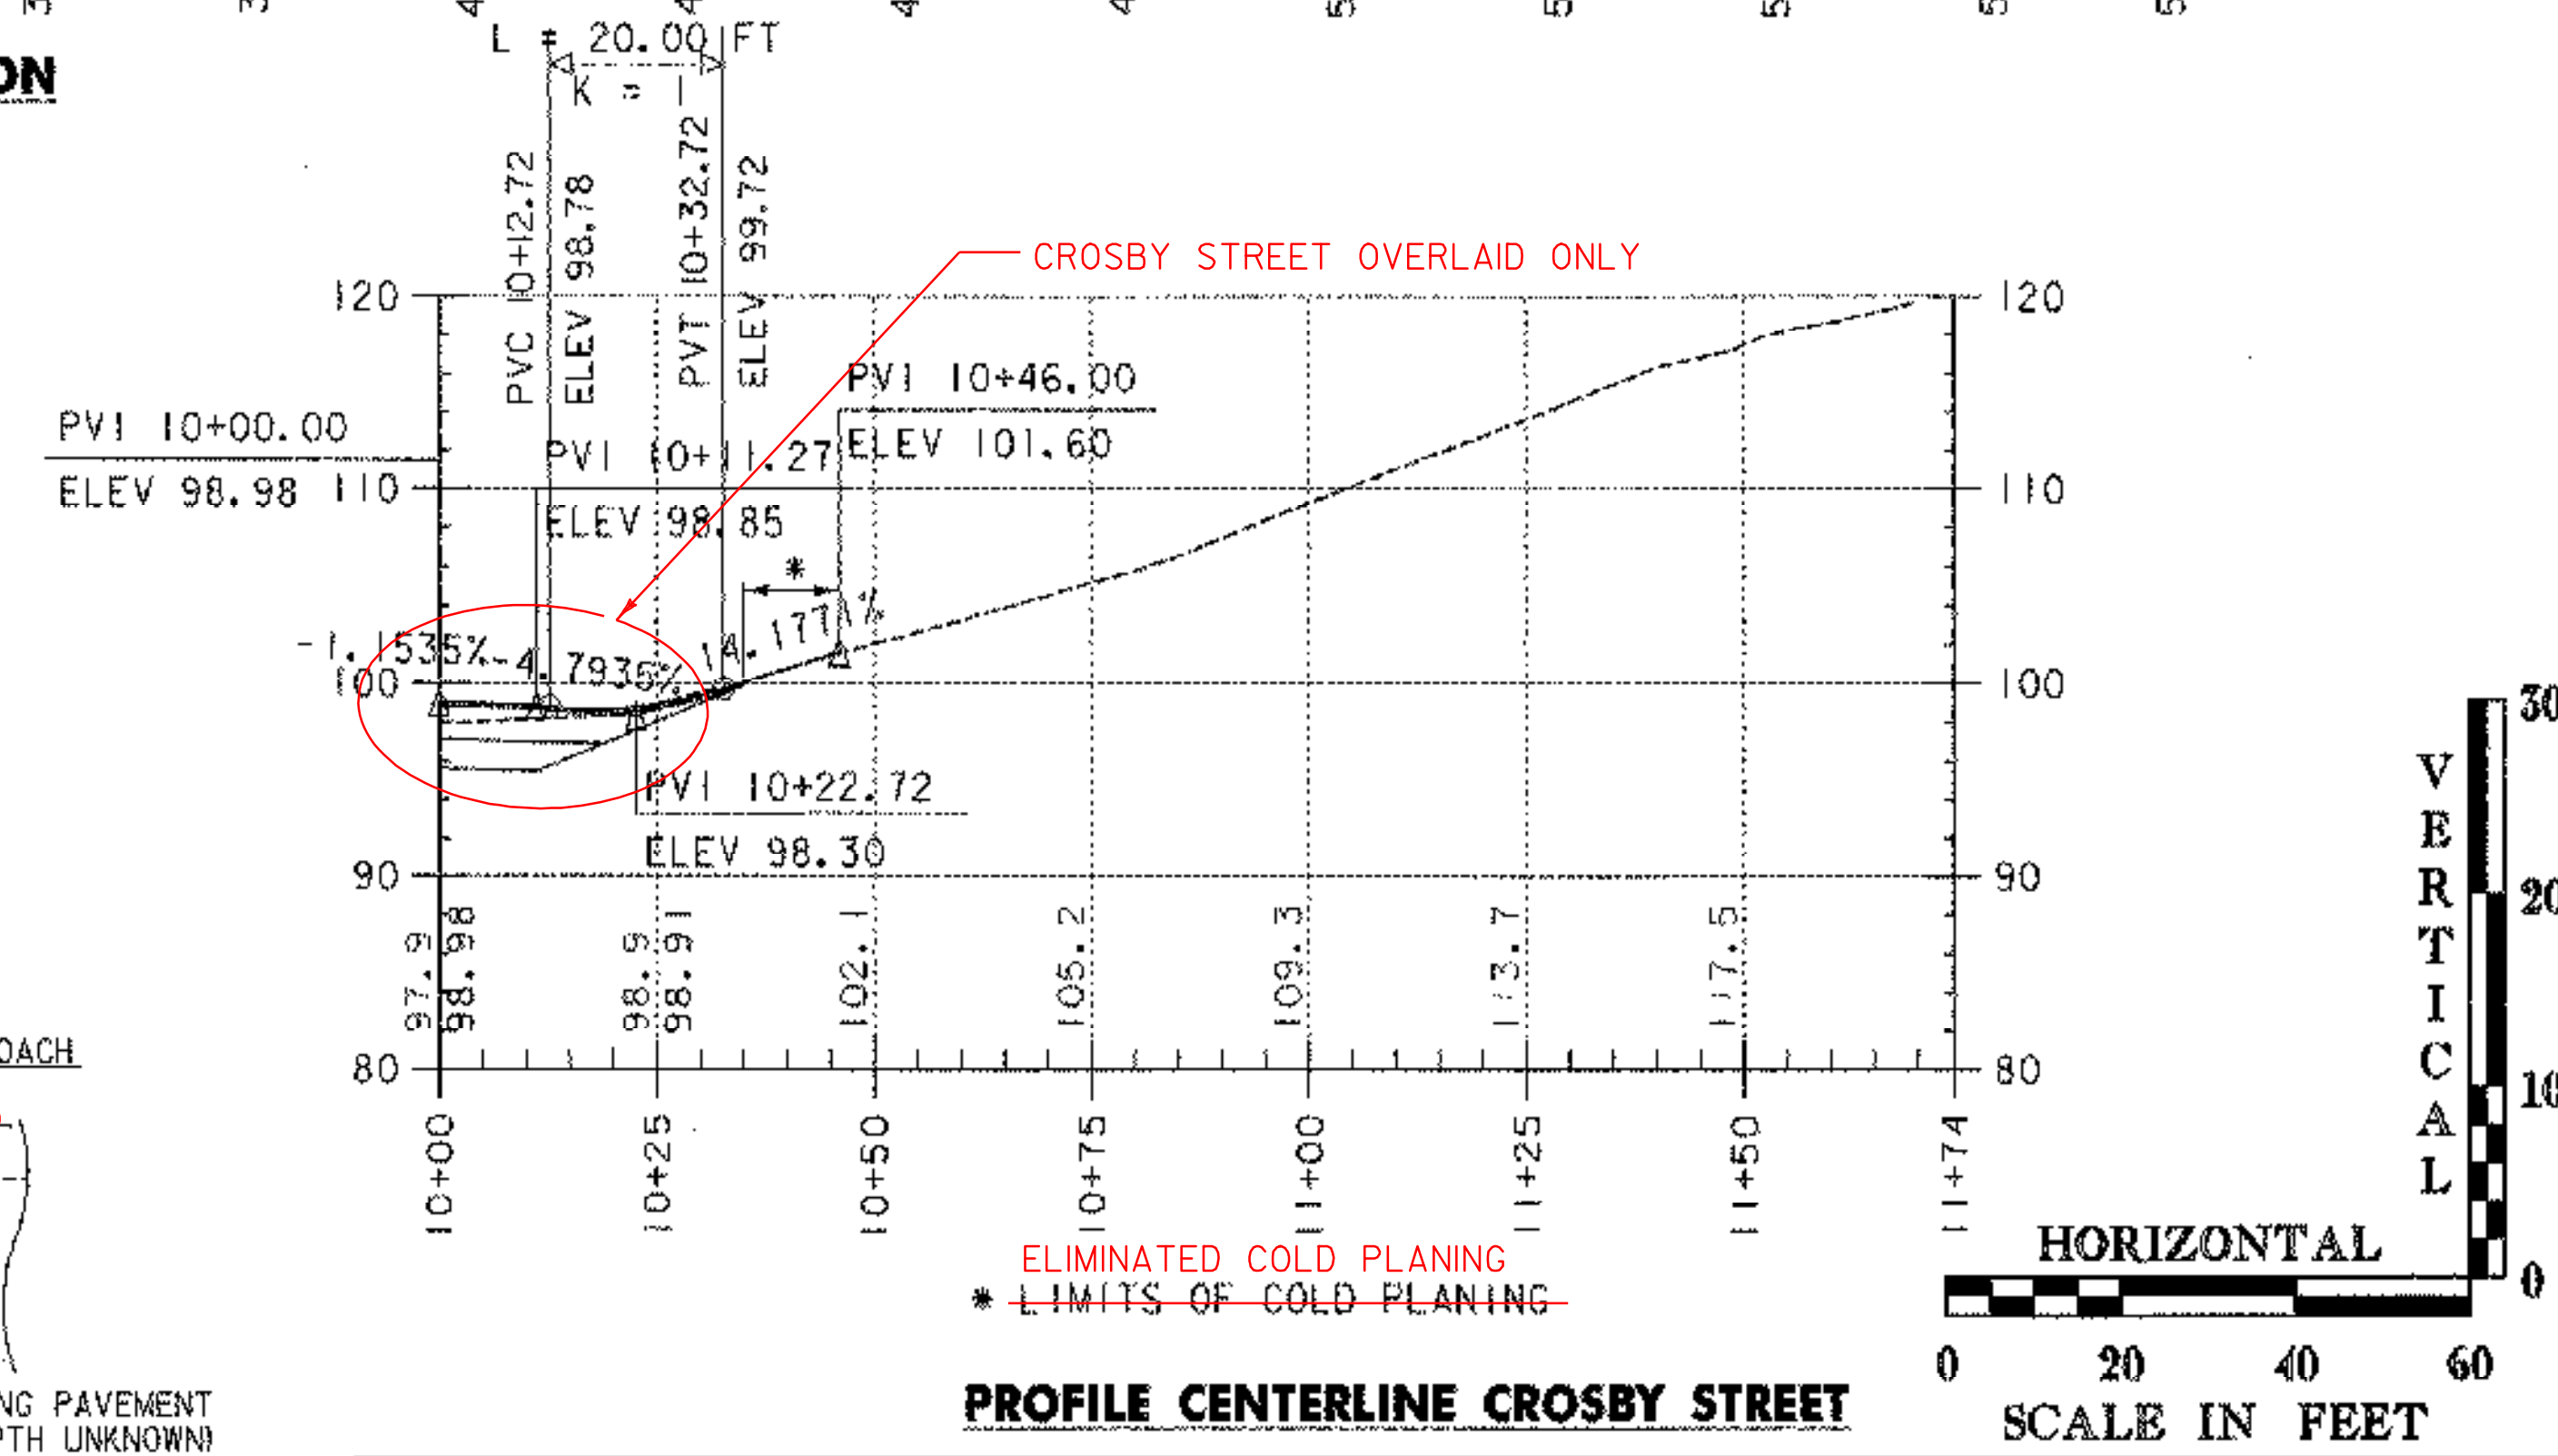


PROFILE CENTERLINE CONSTRUCTION

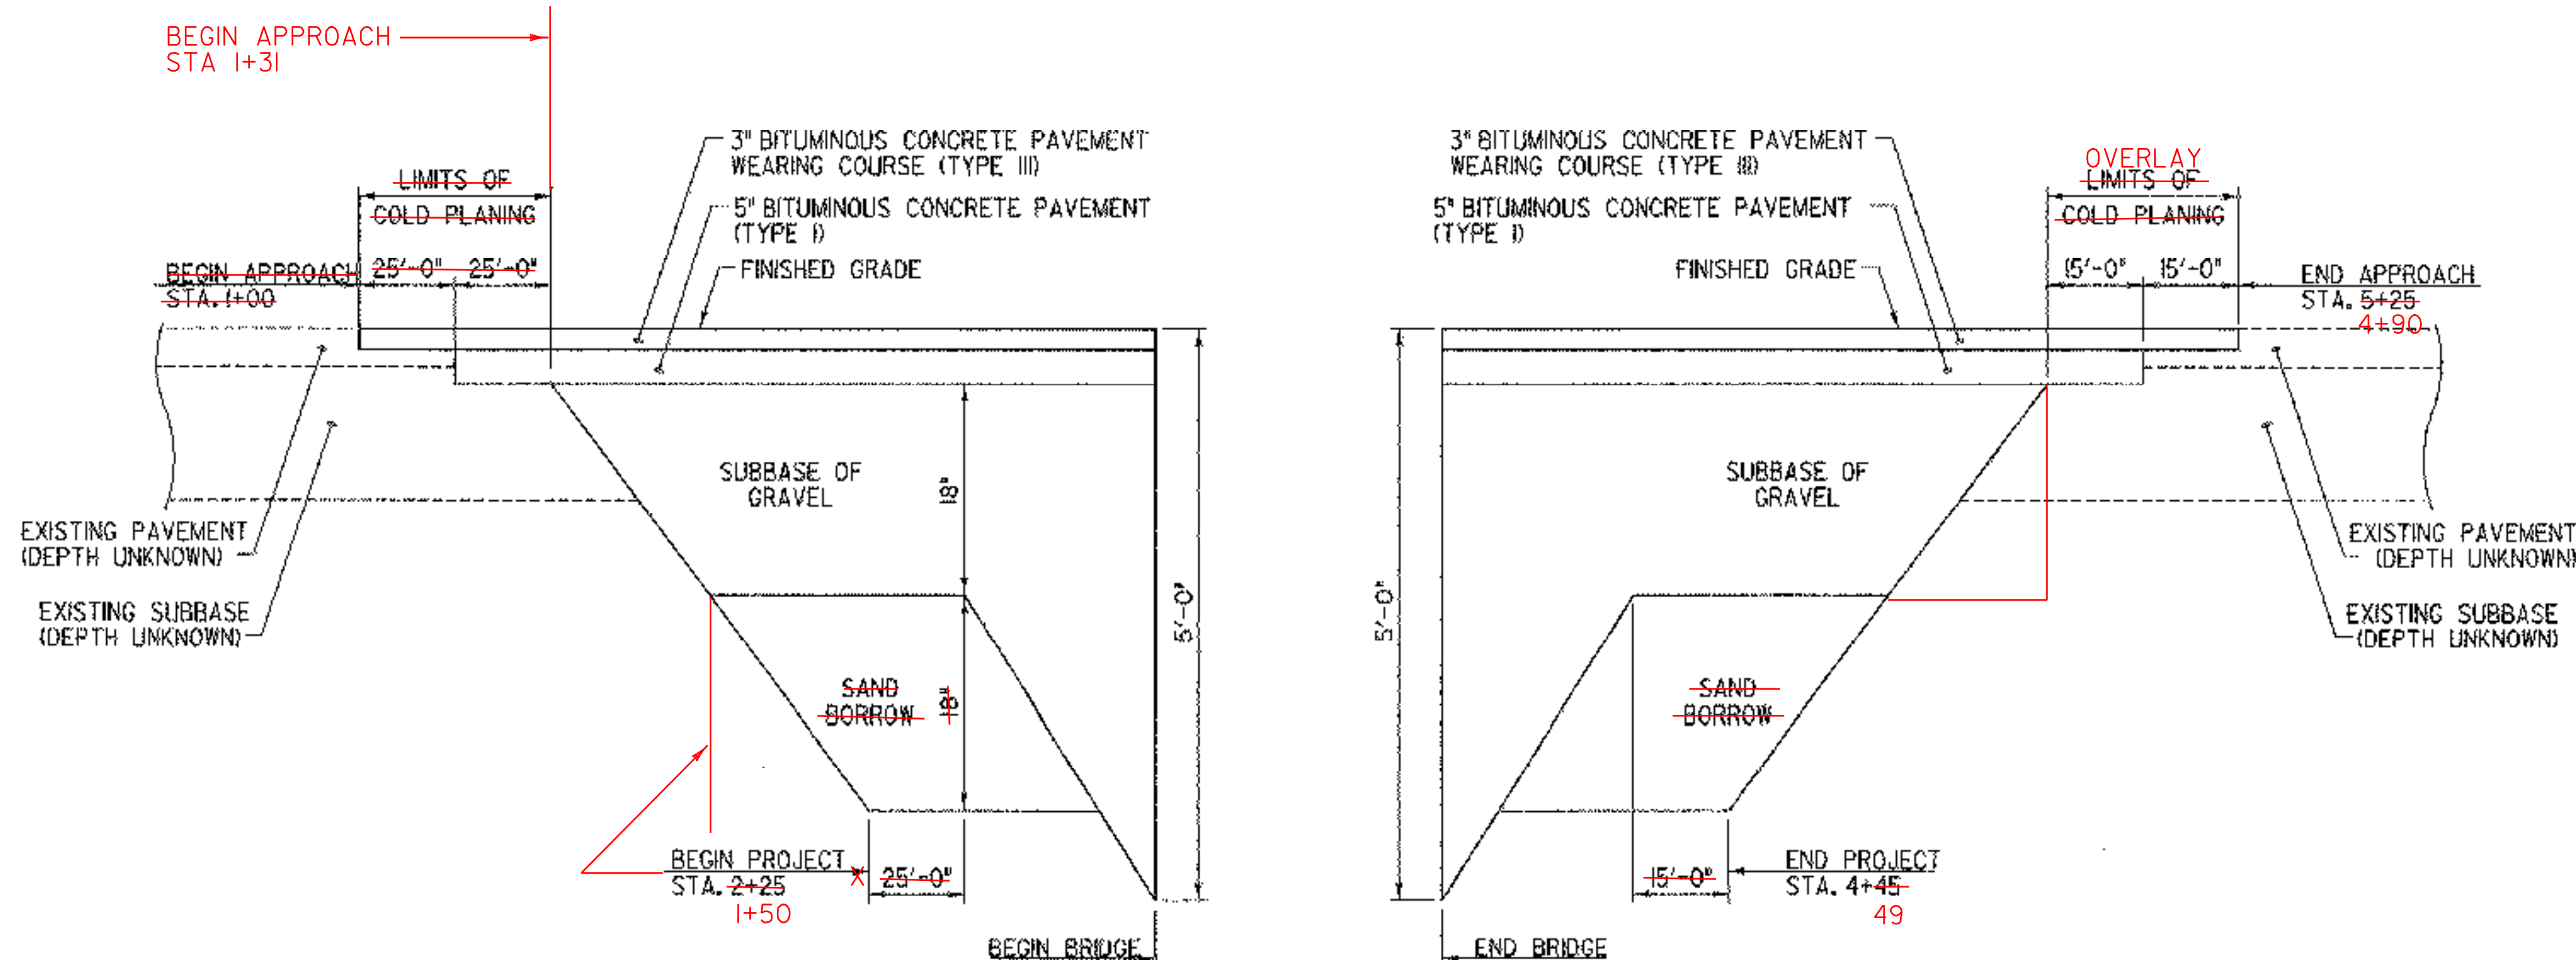

PROFILE CENTERLINE CROSBY STREET

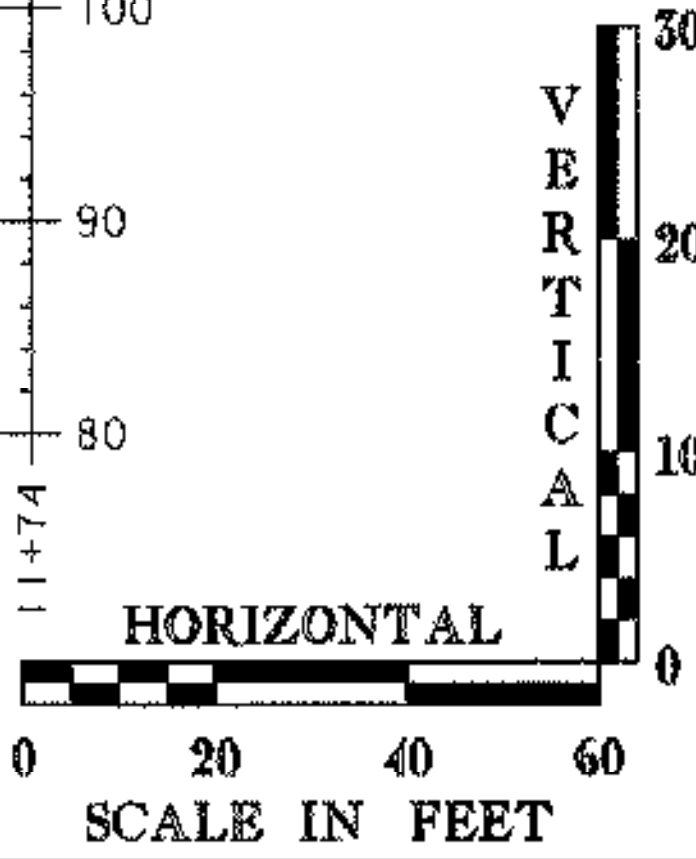

MATERIAL DEPTH TRANSITION DETAIL

NOT TO SCALE

* SEE CONSTRUCTION NOTE 10 ON SHEET 9 REGARDING EXISTING SANITARY SEWER LINE.

DATUM	
VERTICAL	ASSUMED
HORIZONTAL	ASSUMED

REVISIONS		
NO.	DESCRIPTION	BY & DATE

STATE OF VERMONT AGENCY OF TRANSPORTATION	
Town Of BRATTLEBORO	Bridge No. 34
Highway No. 378	Log Sta. Surv. Sta.
TH 378 (WILLIAMS STREET) OVER WHETSTONE BROOK	
PROFILE	
Designed By E. B. SMALL	Drawn By E. B. SMALL
Checked By J. W. TUCKER	Bridge Design Supervisor J. W. TUCKER
PROJECT BRATTLEBORO	PROJECT NO. BHF 2000(22)
I.G.C. Info. ...zj228xsl.dgn	D & K DWG NO. 11371
Sheet 6 of 20	