



STA. 2+75.00 TO STA. 2+78.00 CONSTRUCT TRENCH
SEE CONSTRUCTION NOTE 9 ON SHEET 9

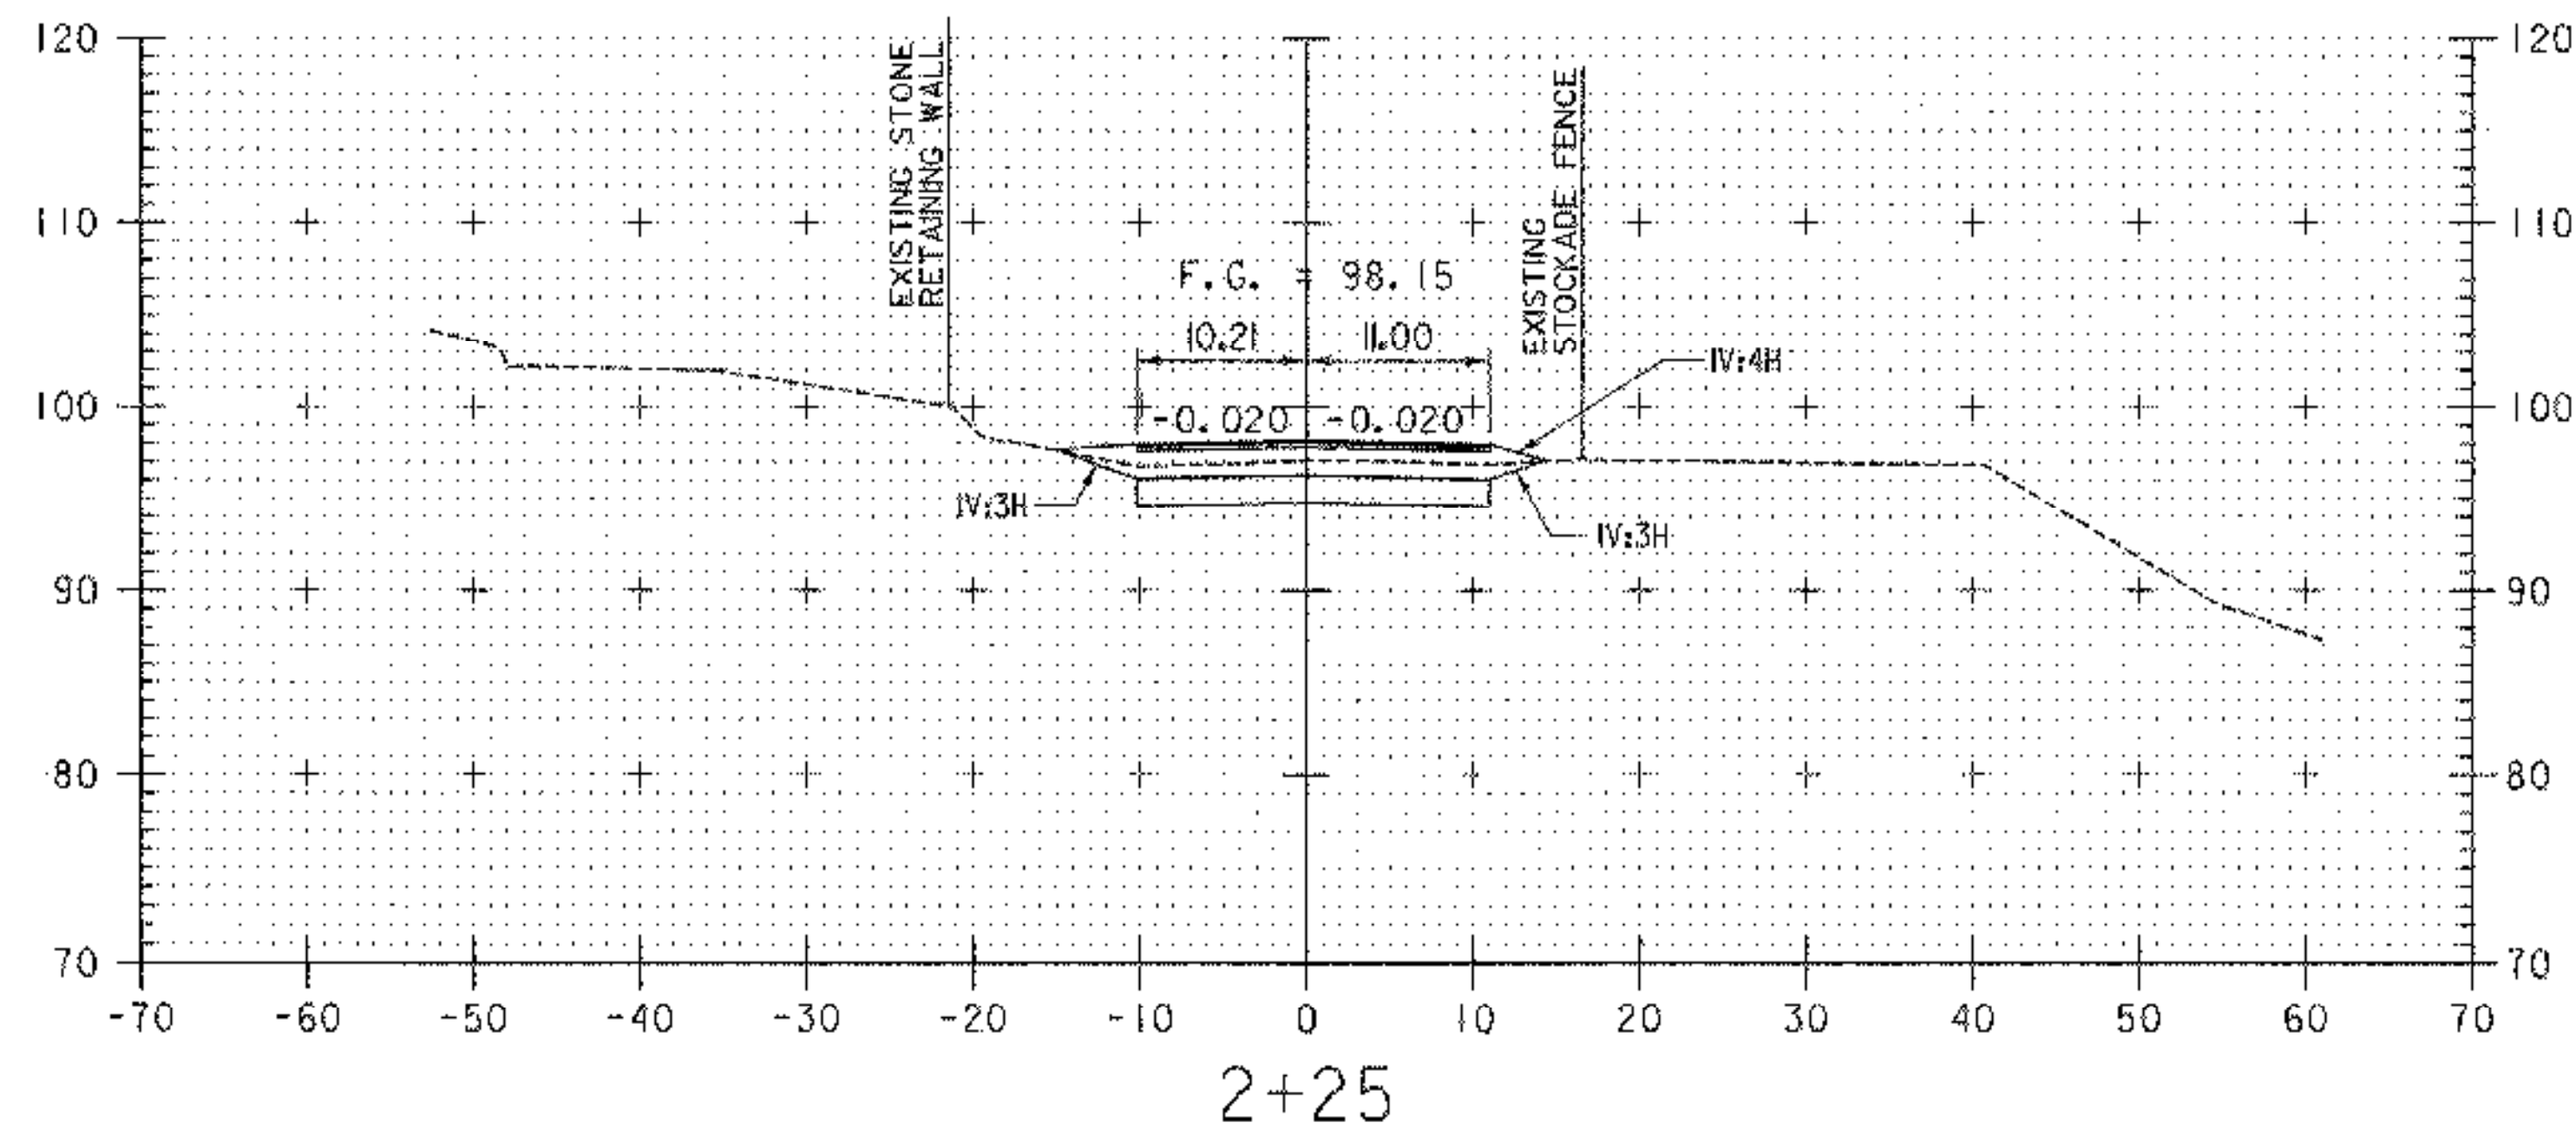


BEGIN PROJECT STA. 2+25.00
I+50.00

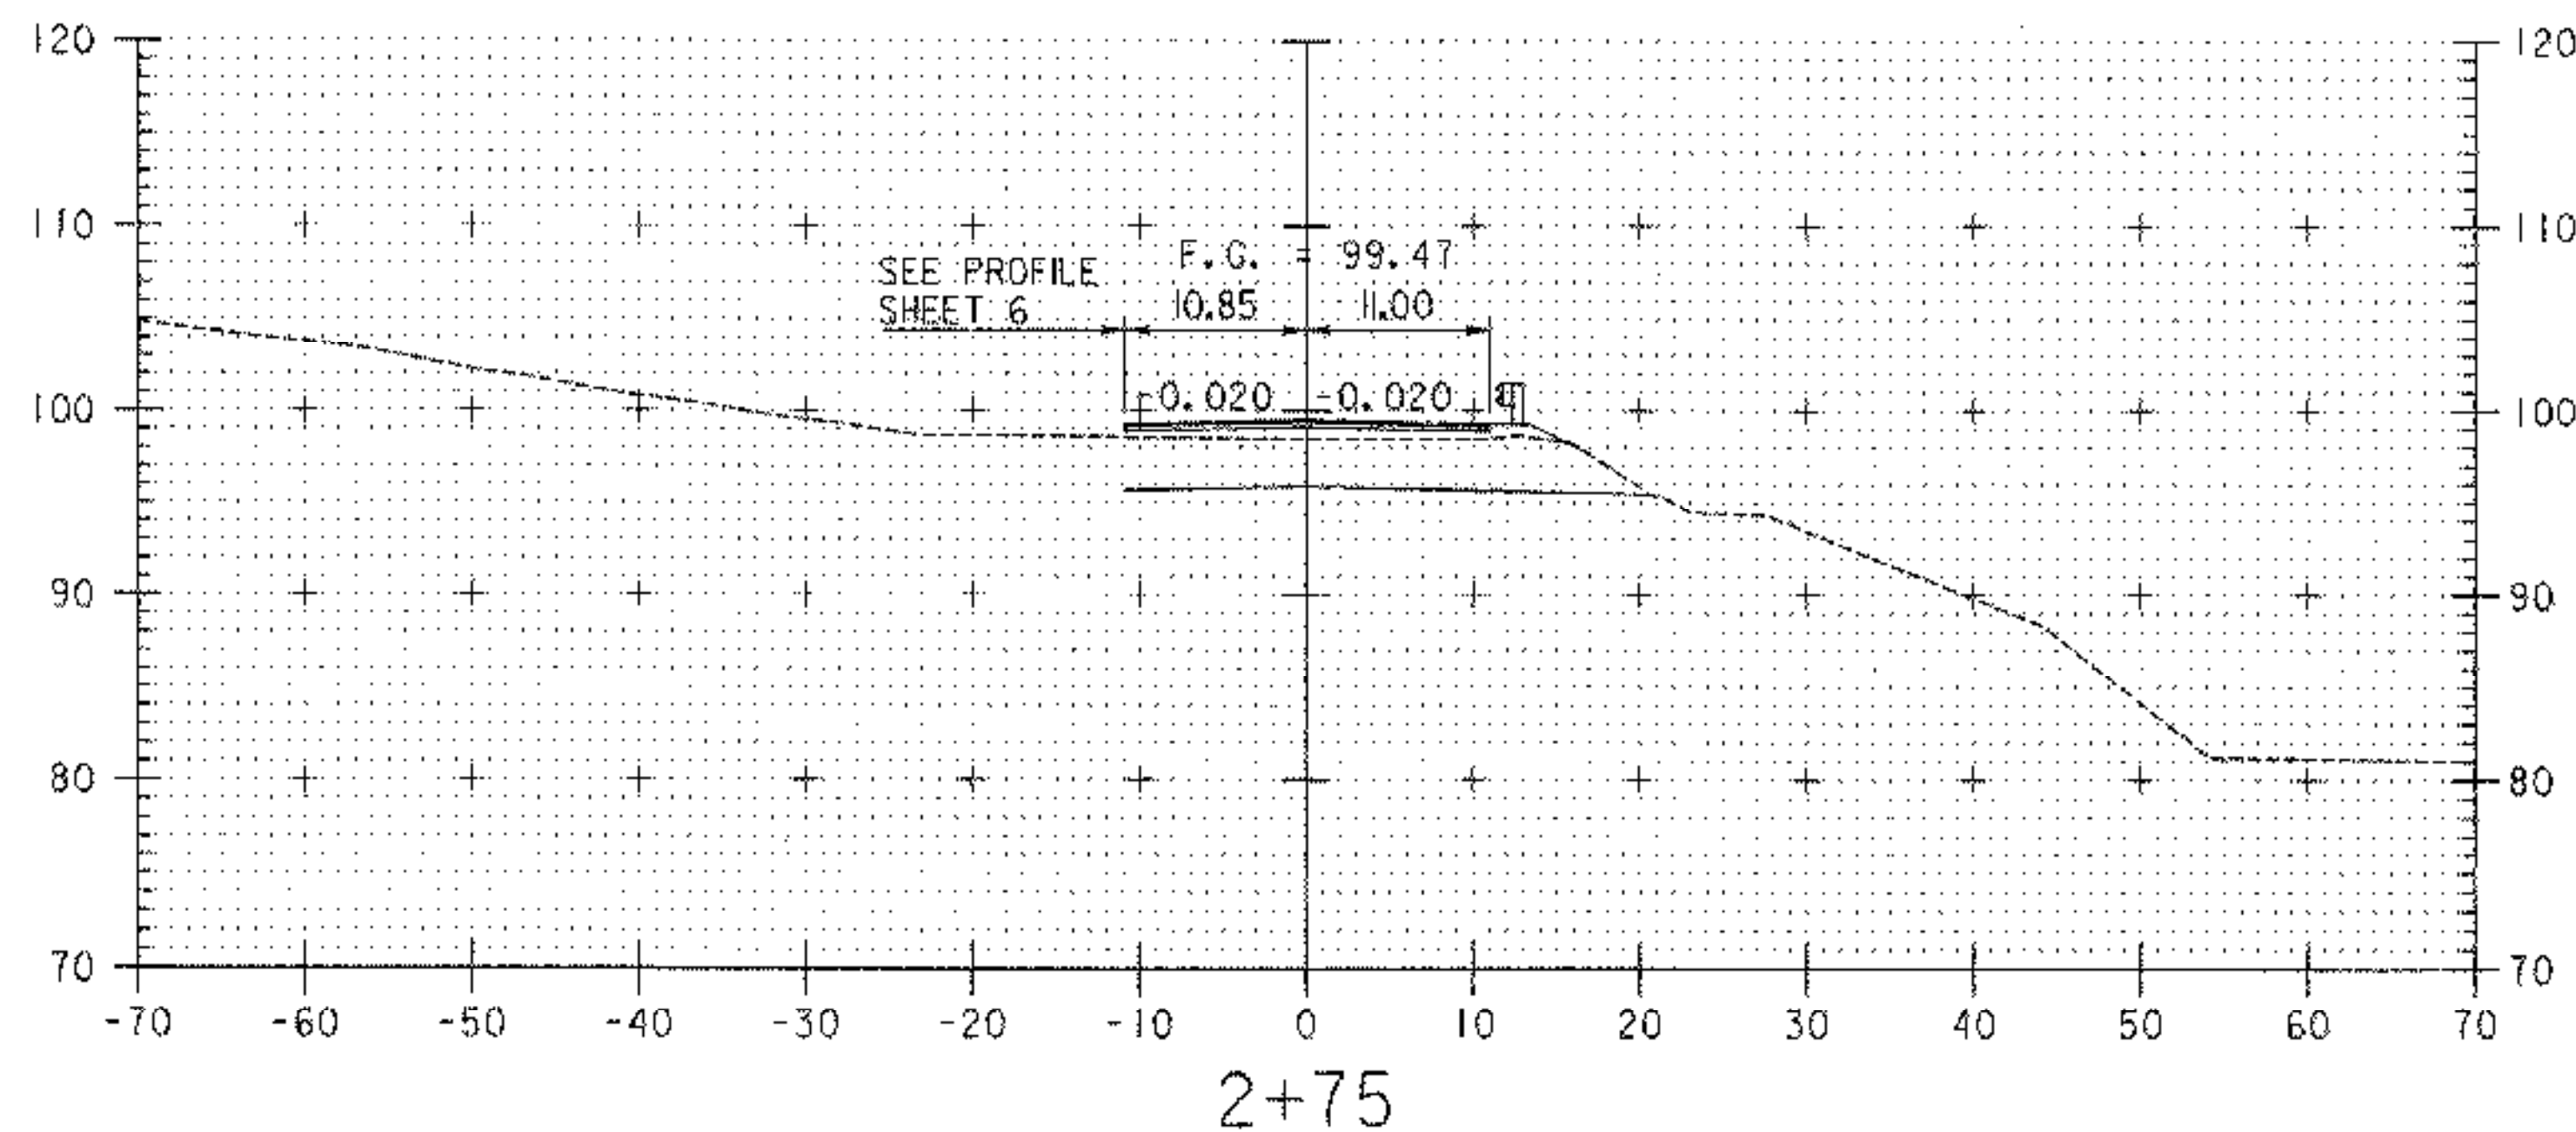

INTERSECTION WITH
CROSBY ST. STA. 2+54.62 LT

ROADWAY CROSS SECTIONS

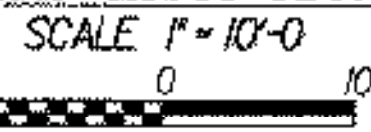

REVISIONS		
NO.	DESCRIPTION	BY & DATE

**STATE OF VERMONT
AGENCY OF TRANSPORTATION**

Town Of	BRATTLEBORO	Bridge No.	34
Highway No.	378	Log Sta.	
		Surv. Sta.	


TH 378 (WILLIAMS STREET) OVER WHETSTONE BROOK

ROADWAY CROSS SECTION

Designed By	E. B. SMALL	Drawn By	E. B. SMALL
Checked By	J. W. TUCKER	Bridge Design Supervisor	J. W. TUCKER
Date	04/01	Date	04/01

PROJECT	BRATTLEBORO	PROJECT NO.	BHF 2000(22)
---------	-------------	-------------	--------------

I.G.C. Info.	...z1228xsl.dgn	D & K DWG NO.	4382	Sheet	17	of	20
--------------	-----------------	---------------	------	-------	----	----	----

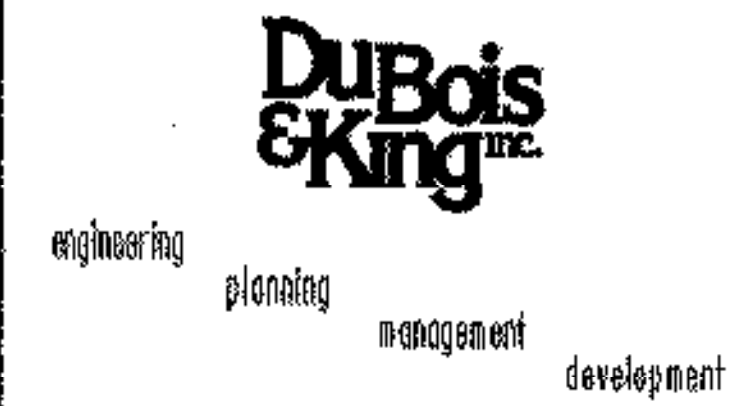

PLOTTED 02/13/2004

DATUM	
VERTICAL	ASSUMED
HORIZONTAL	ASSUMED