


ROADWAY CROSS SECTIONS
SCALE 1" = 10'-0"
10 0 10

DATUM
VERTICAL ASSUMED
HORIZONTAL ASSUMED

REVISIONS		
NO.	DESCRIPTION	BY & DATE

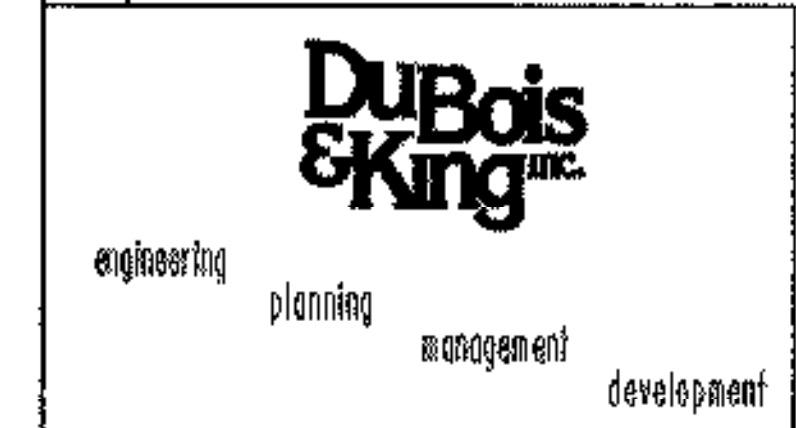

**STATE OF VERMONT
AGENCY OF TRANSPORTATION**

Town Of	BRATTLEBORO	Bridge No.	34
Highway No.	378	Log Sta.	
		Surv. Sta.	
TH 378 (WILLIAMS STREET) OVER WHETSTONE BROOK			
ROADWAY CROSS SECTION			
Designed By	E. B. SMALL	Drawn By	E. B. SMALL
Checked By	Date	Bridge Design Supervisor	Date
J. W. TUCKER	04/01	J. W. TUCKER	Date 04/01
PROJECT	BRATTLEBORO	PROJECT NO.	BHF 2000(22)
I.C.C. Info.	...zj228xsl.dgn	D & K DWG NO.	11383
		Sheet	18 of 20

PLOTTED 02/03/2004