


STA. 4+07.00 TO STA. 4+10.00 CONSTRUCT TRENCH
SEE CONSTRUCTION NOTE 9 ON SHEET 9

ROADWAY CROSS SECTIONS

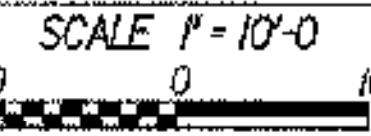

DATUM	ASSUMED
VERTICAL	ASSUMED
HORIZONTAL	ASSUMED

REVISIONS		
NO.	DESCRIPTION	BY & DATE

STATE OF VERMONT AGENCY OF TRANSPORTATION	
Town Of BRATTLEBORO	Bridge No. 34
Highway No. 378	Log Sta. Surv. Sta.
TH 378 (WILLIAMS STREET) OVER WHETSTONE BROOK	
ROADWAY CROSS SECTION	
Designed By E. B. SMALL	Drawn By E. B. SMALL
Checked By J. W. TUCKER	Bridge Design Supervisor J. W. TUCKER
Date 04/01	Date 04/01
PROJECT BRATTLEBORO	PROJECT NO. BHF 2000(22)
I.G.C. Info. ...zj228xsl.dgn	D & K DWG NO. 8384
Sheet 19 of 20	

PLOTTED 02/03/2004

