
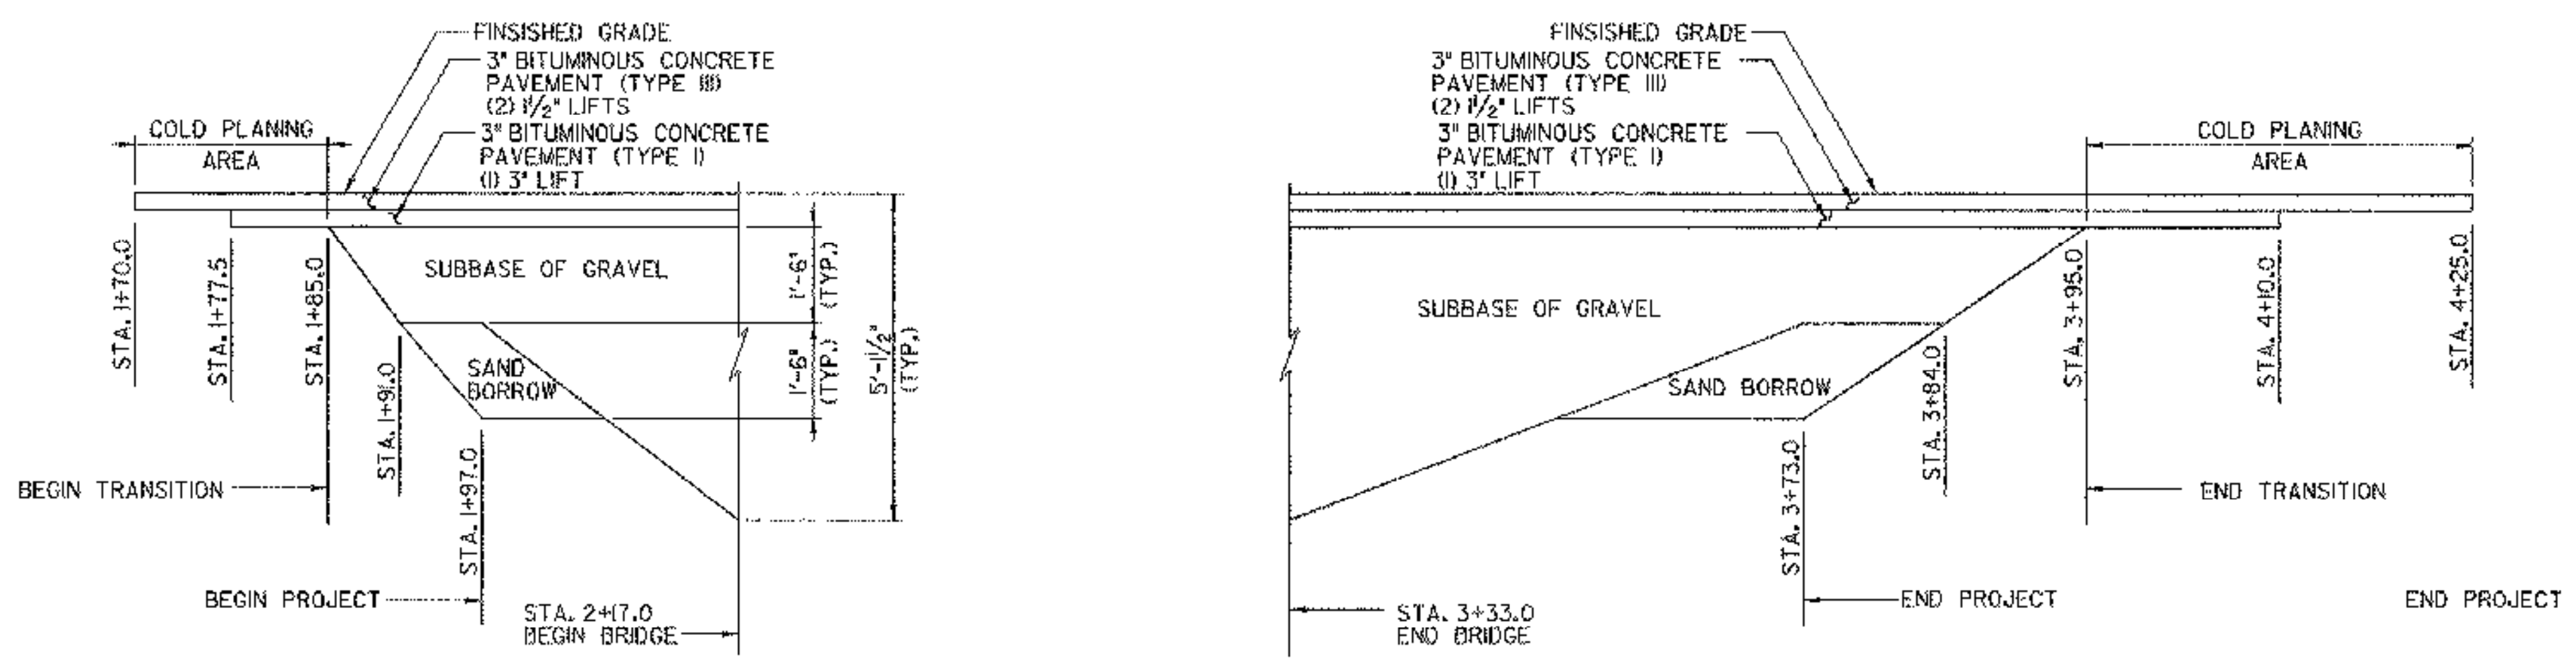


PROFILE - CHURCH STREET

SCALE: HORIZ. 1" = 10'
VERT. 1" = 5'

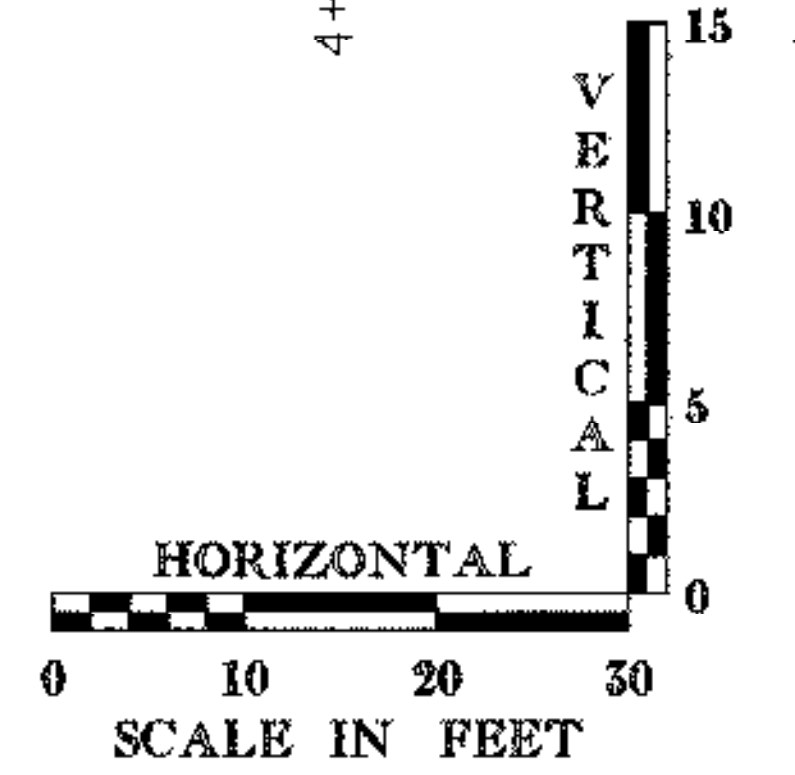

MATERIAL DEPTH TRANSITION DETAIL

N.T.S.

REVISIONS		
NO.	DESCRIPTION	BY & DATE
1	ADDED ABUTMENT CAP TO ABUTMENT NO. 11N PROFILE	APG 2/3/04

**STATE OF VERMONT
AGENCY OF TRANSPORTATION**

Town Of	CHESTER	Bridge No.	11
Highway No.	TH 5	Log. Sta.	-
CHURCH STREET OVER WILLIAMS RIVER		Surv. Sta.	-
PROFILE			
Designed By	G. J. WOJCIECHOWSKI	Drawn By	G. J. WOJCIECHOWSKI
Checked By	J. TUCKER	Bridge Design Supervisor	J. TUCKER
Date	03/01	Date	03/01
PROJECT	CHESTER	PROJECT NO.	BHO 1442 (32)
I.G.C. Info.	...zj365p#6.dgn		
D & K DWG NO.	11349	Sheet	6 of 22

DuBois & King
INC.
engineering planning management development

02/10/2004