


PLAN
SCALE 1" = 10'-0"
10 0 10

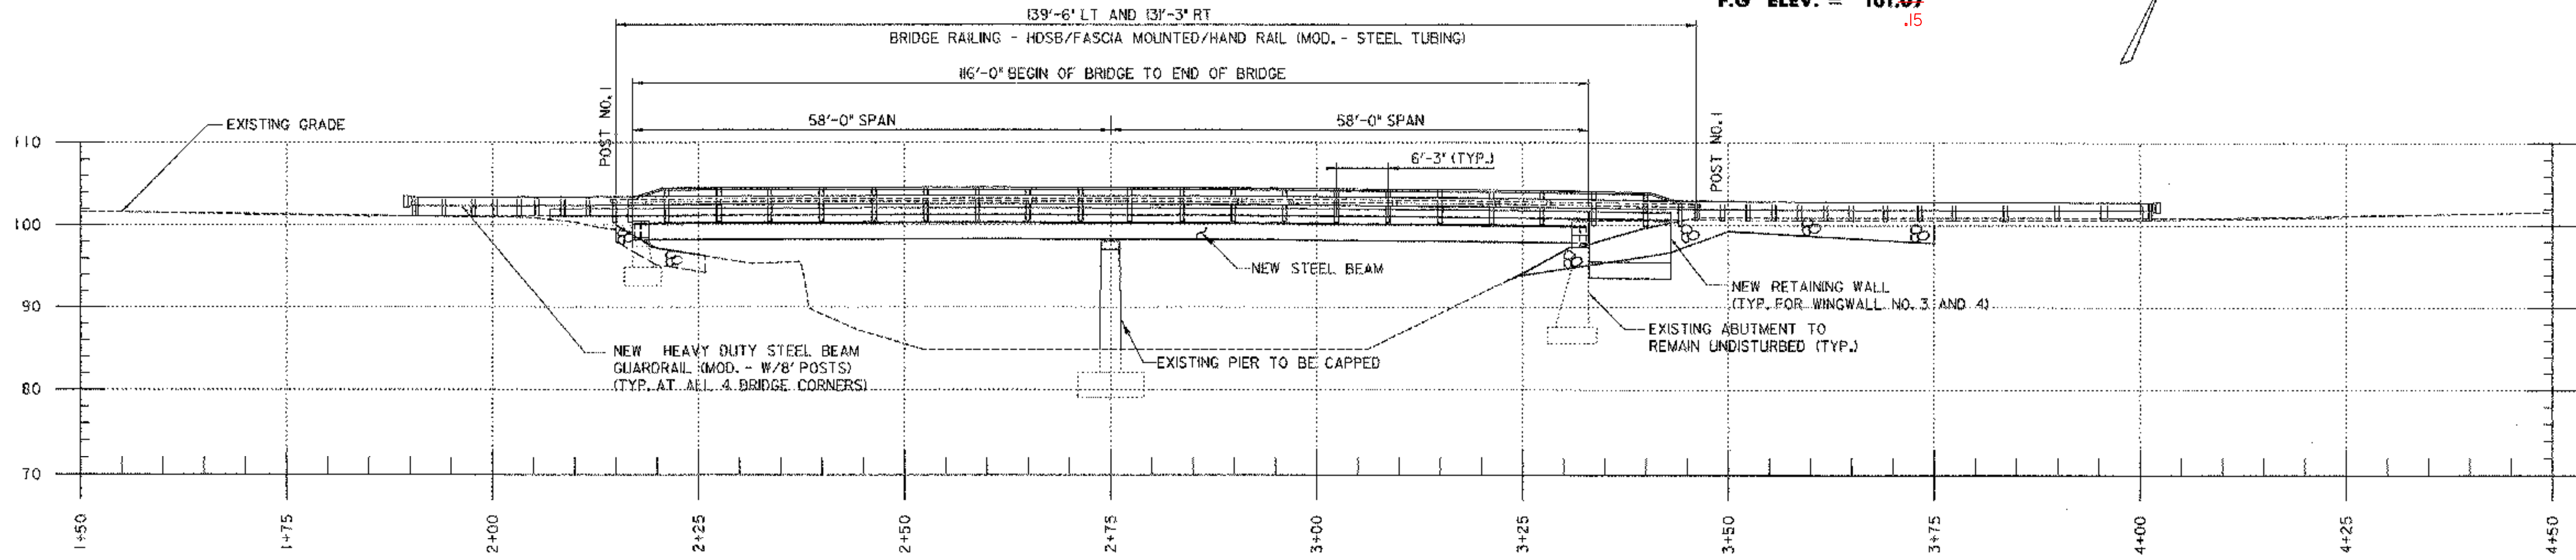

NOTES

1. THE EXISTING R.O.W. ON CHURCH STREET IS ASSUMED TO BE A 3 ROD (49.5 FEET), CENTERED ON THE EXISTING ROADWAY.
2. THE EXISTING RAILROAD R.O.W IS ASSUMED TO BE 20 FEET, CENTERED ON THE TRACK.

ELEVATION
SCALE 1" = 10'-0"
10 0 10

DATUM	
VERTICAL	LOCAL
HORIZONTAL	LOCAL

REVISIONS		
NO.	DESCRIPTION	BY & DATE

STATE OF VERMONT AGENCY OF TRANSPORTATION	
Town Of	CHESTER
Highway No.	TH 5
CHURCH STREET OVER WILLIAMS RIVER	
PLAN & ELEVATION	
Designed By	B. C. AUSTIN
Checked By	J. TUCKER
Date	03/01
Drawn By	G. J. WOJCIECHOWSKI
Bridge Design Supervisor	J. TUCKER
Date	03/01
PROJECT	CHESTER
PROJECT NO.	BHO 1442 (32)
I.O.C. Info.	...zj365pe8.dgn
D & K DWG NO.	11351

02/03/2004

DuBois & King
INC.
engineering planning management development

DATE PLOTTED: 03/01/04 10:58 AM