


REVISIONS			STATE OF VERMONT AGENCY OF TRANSPORTATION	
NO.	DESCRIPTION	BY & DATE		
			Town Of	CHESTER
			Bridge No.	11
			Highway No.	TH 5
			Log Sta.	-
			Surv. Sta.	-
CHURCH STREET OVER WILLIAMS RIVER				
ROADWAY CROSS SECTIONS				
Designed By G. J. WOJCIECHOWSKI			Drawn By G. J. WOJCIECHOWSKI	
Checked By J. TUCKER			Bridge Design Supervisor J. TUCKER	
Date 03/01			Date 03/01	
PROJECT CHESTER			PROJECT NO. BHO 1442 (32)	
I.G.C. Info. ...zj36521.dgn				
D & K DWG NO. 11364			Sheet 21 of 22	

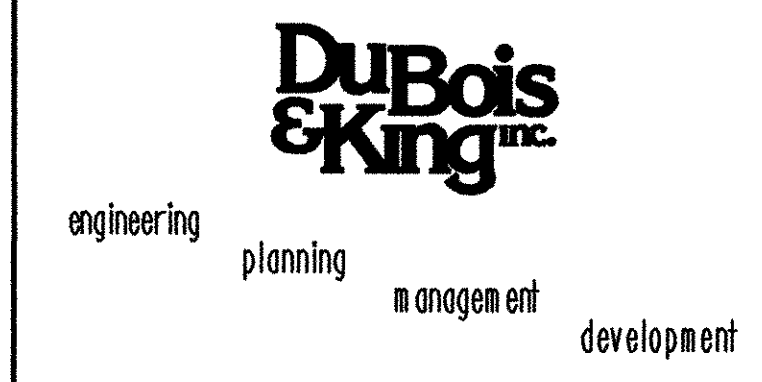

02/03/2004