




PAY LIMIT - BRIDGE RAILING HEAVY DUTY STEEL BEAM \ FASCIA MOUNTED \ STEEL TUBING WITH BOX BEAM HANDRAIL

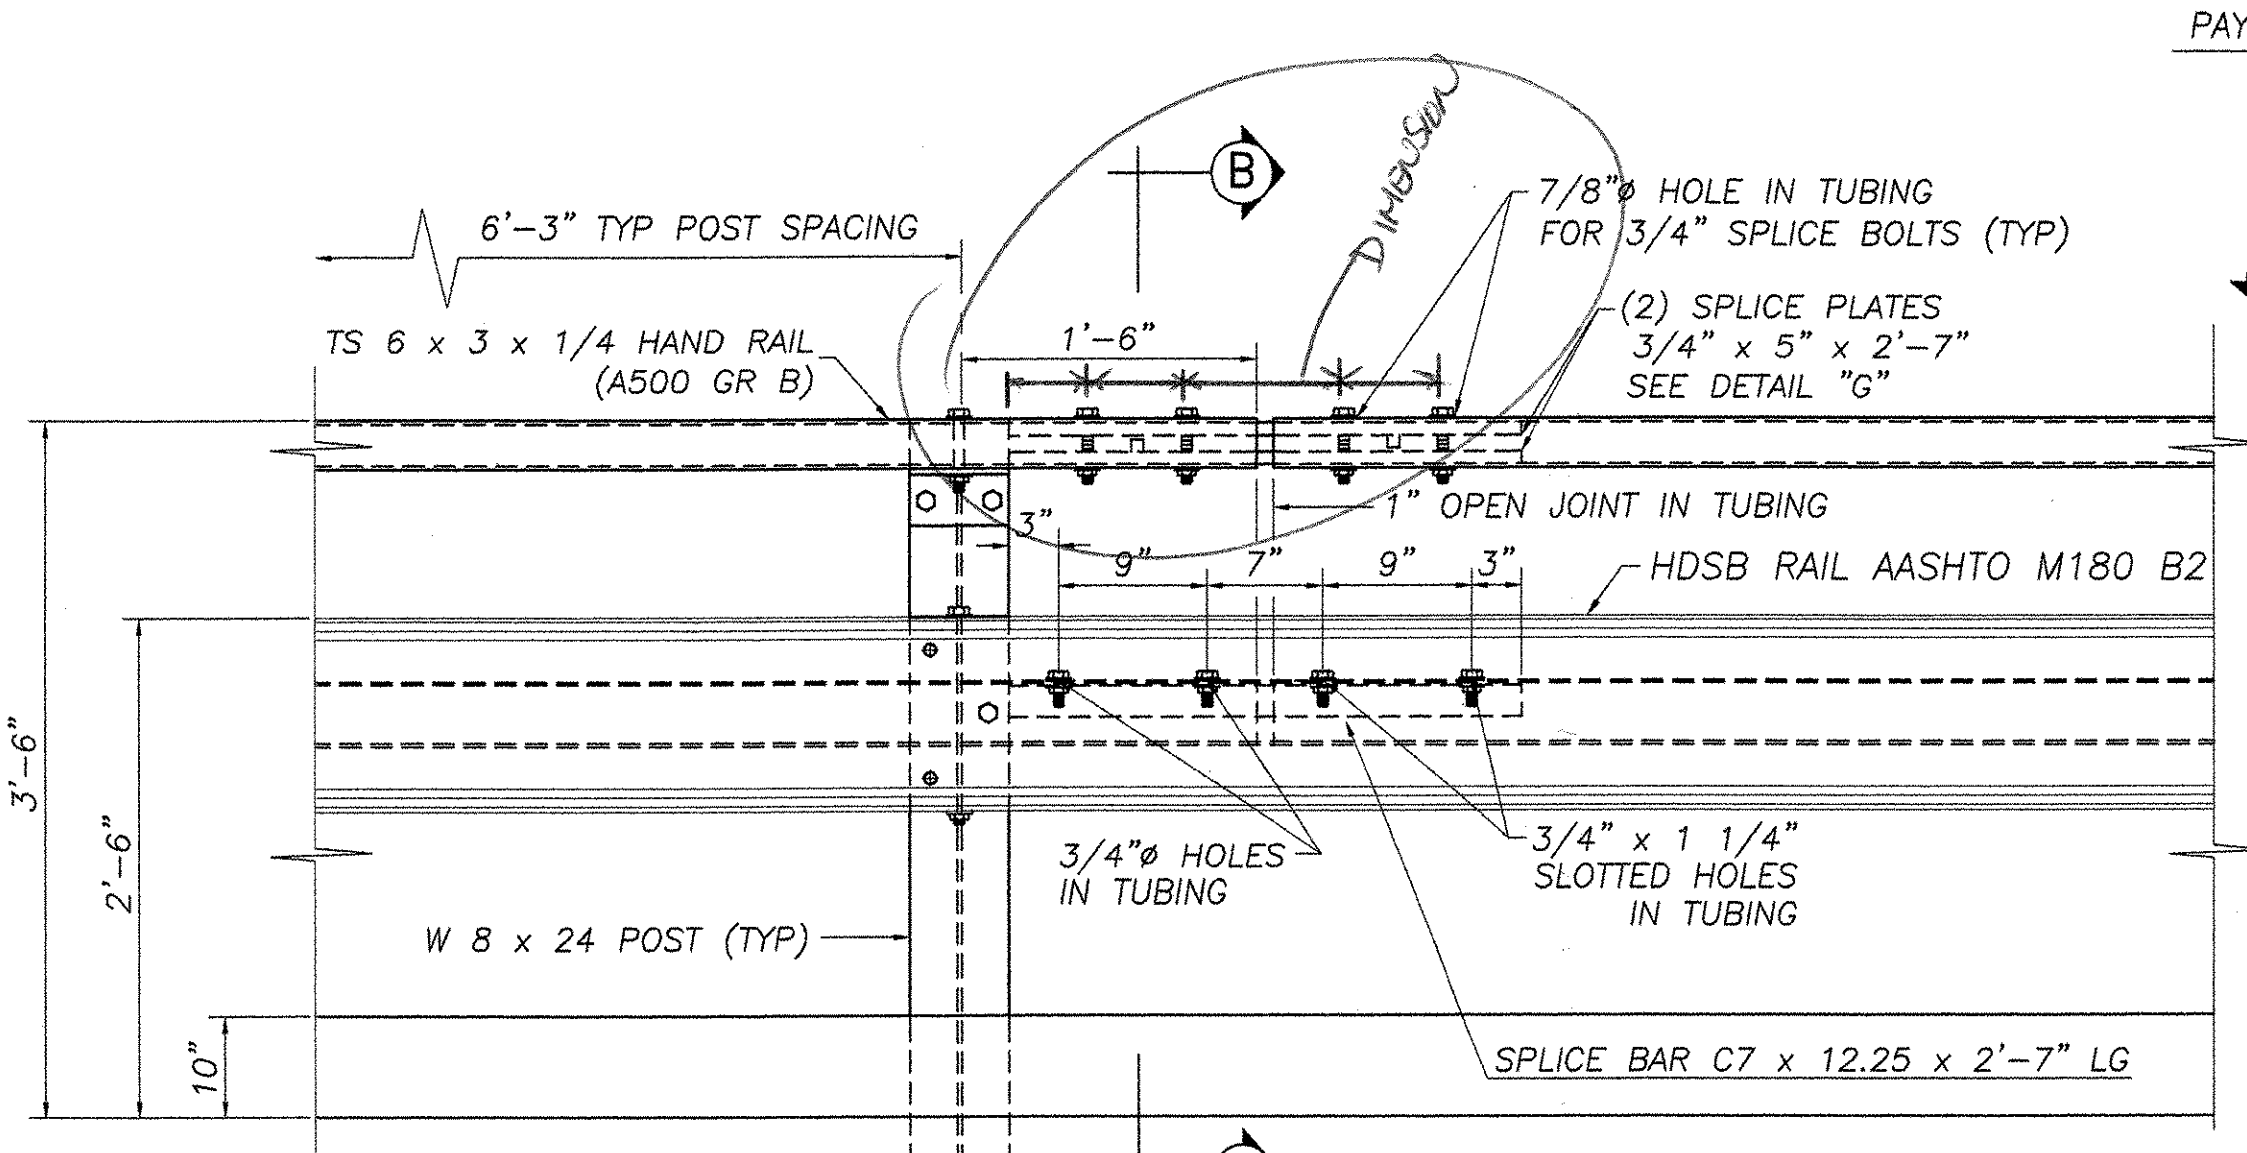


RAILING ELEVATION VIEW (SHOWN LOOKING FROM CL OF ROADWAY)

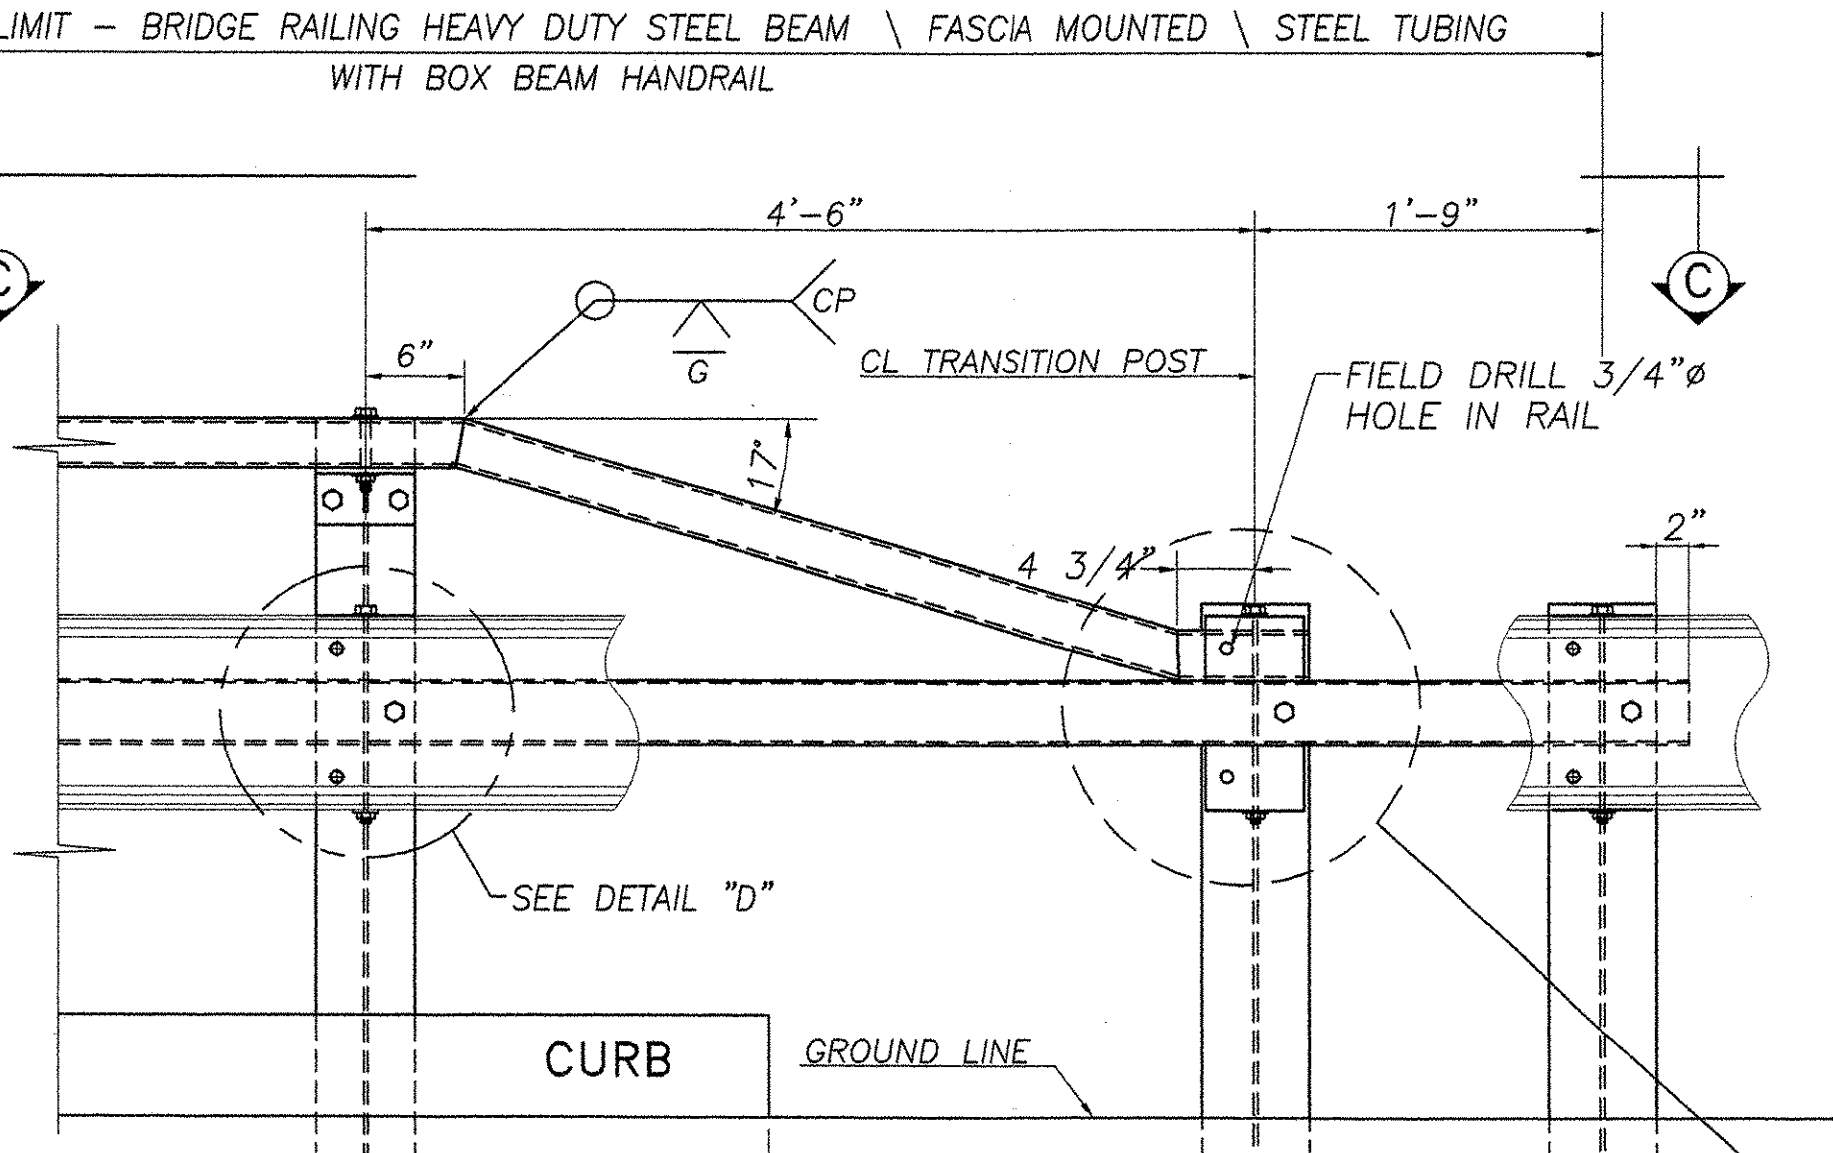


TRANSITION POST DETAIL "H" W8x24 (A572 GR 50)

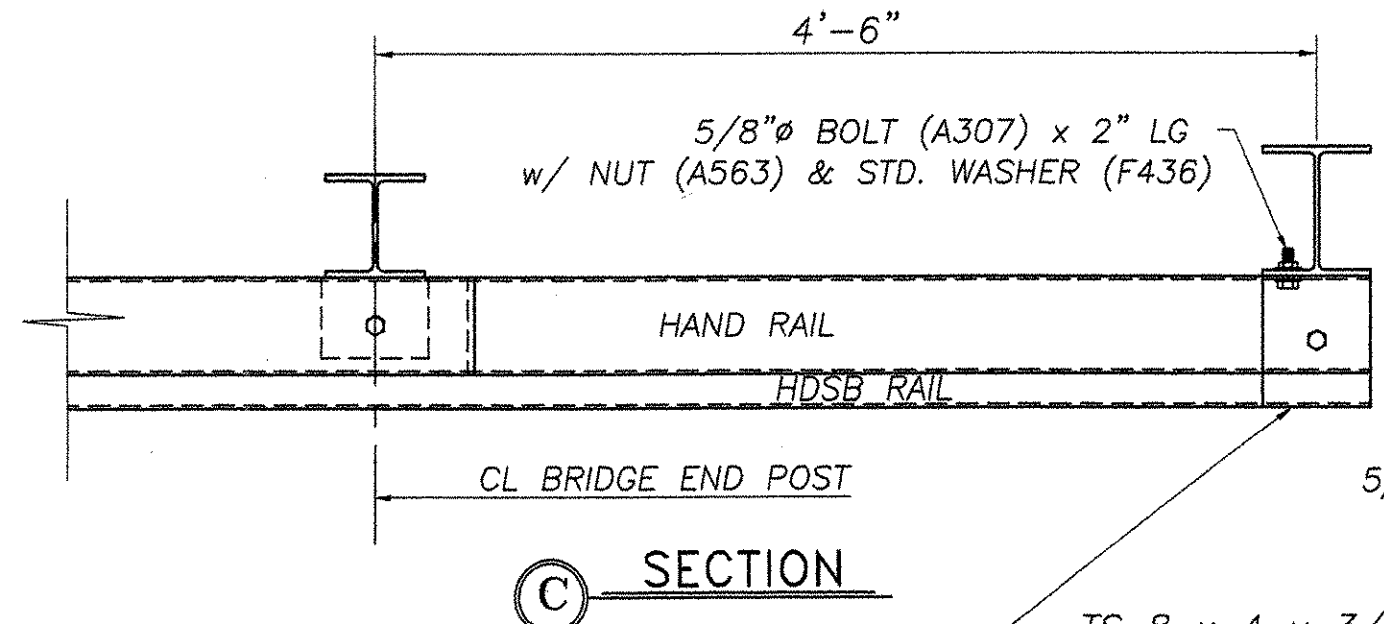


SECTION C

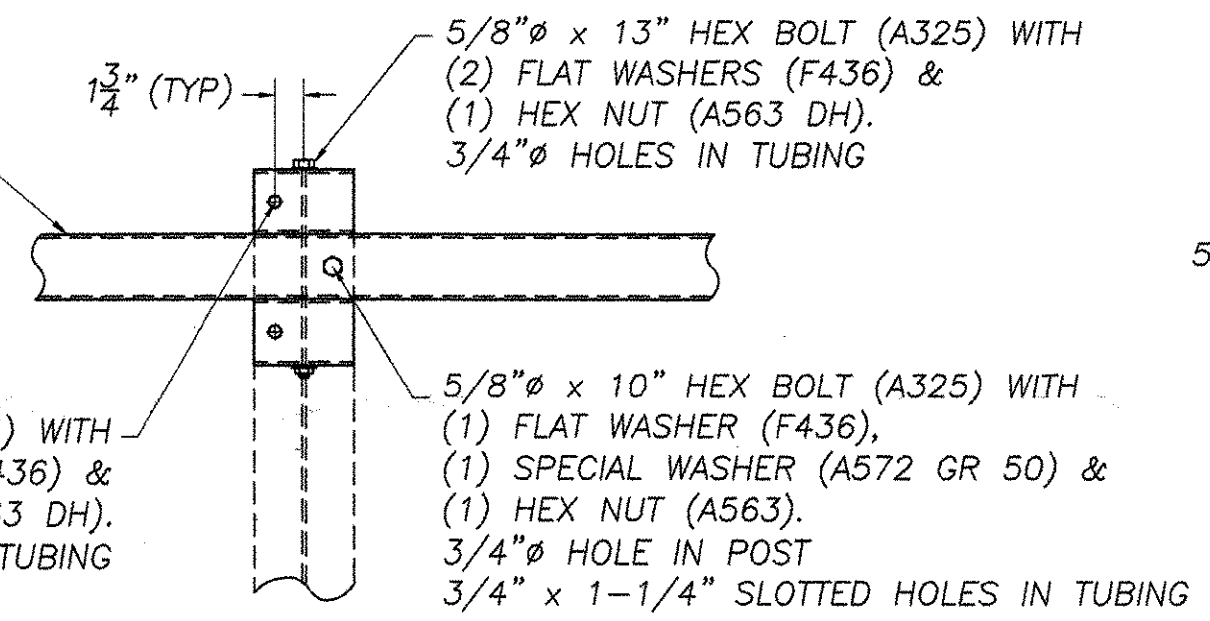

DETAIL "D" STEEL BEAM GUARD RAIL NOT SHOWN

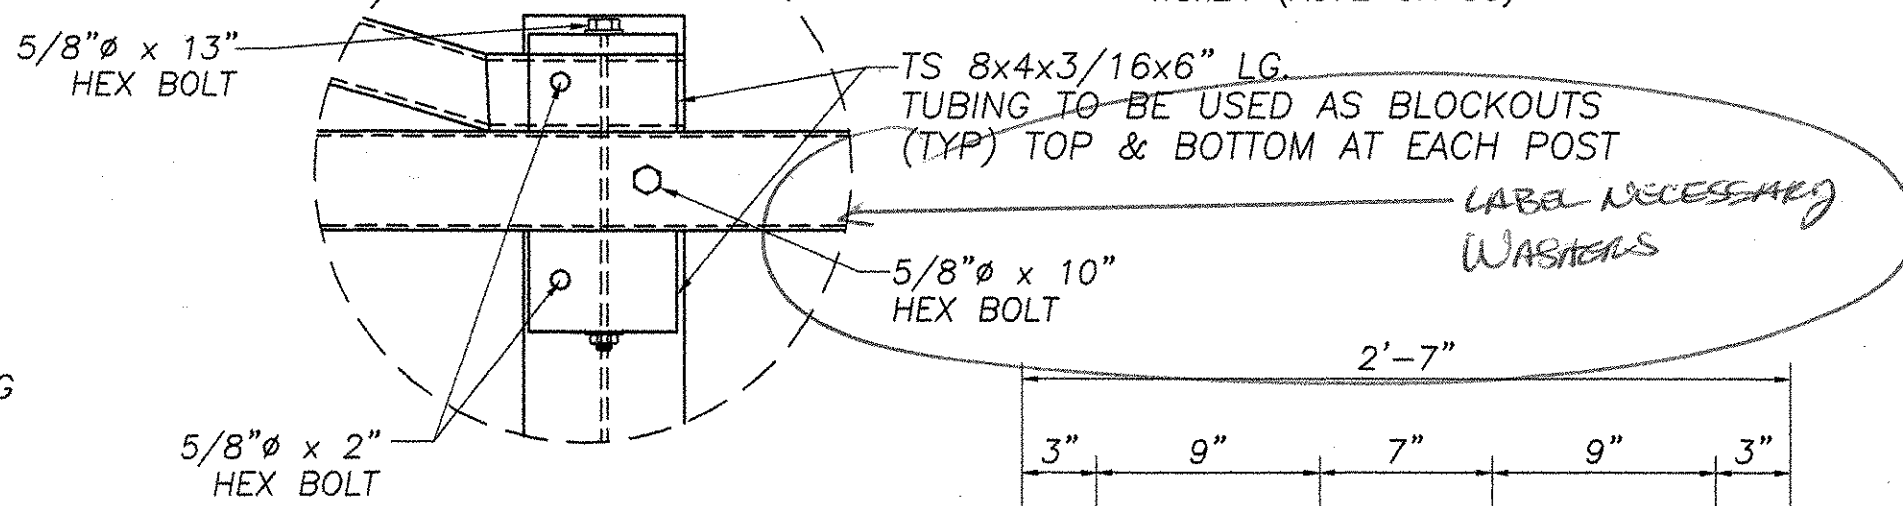


TRANSITION POST DETAIL "H" W8x24 (A572 GR 50)

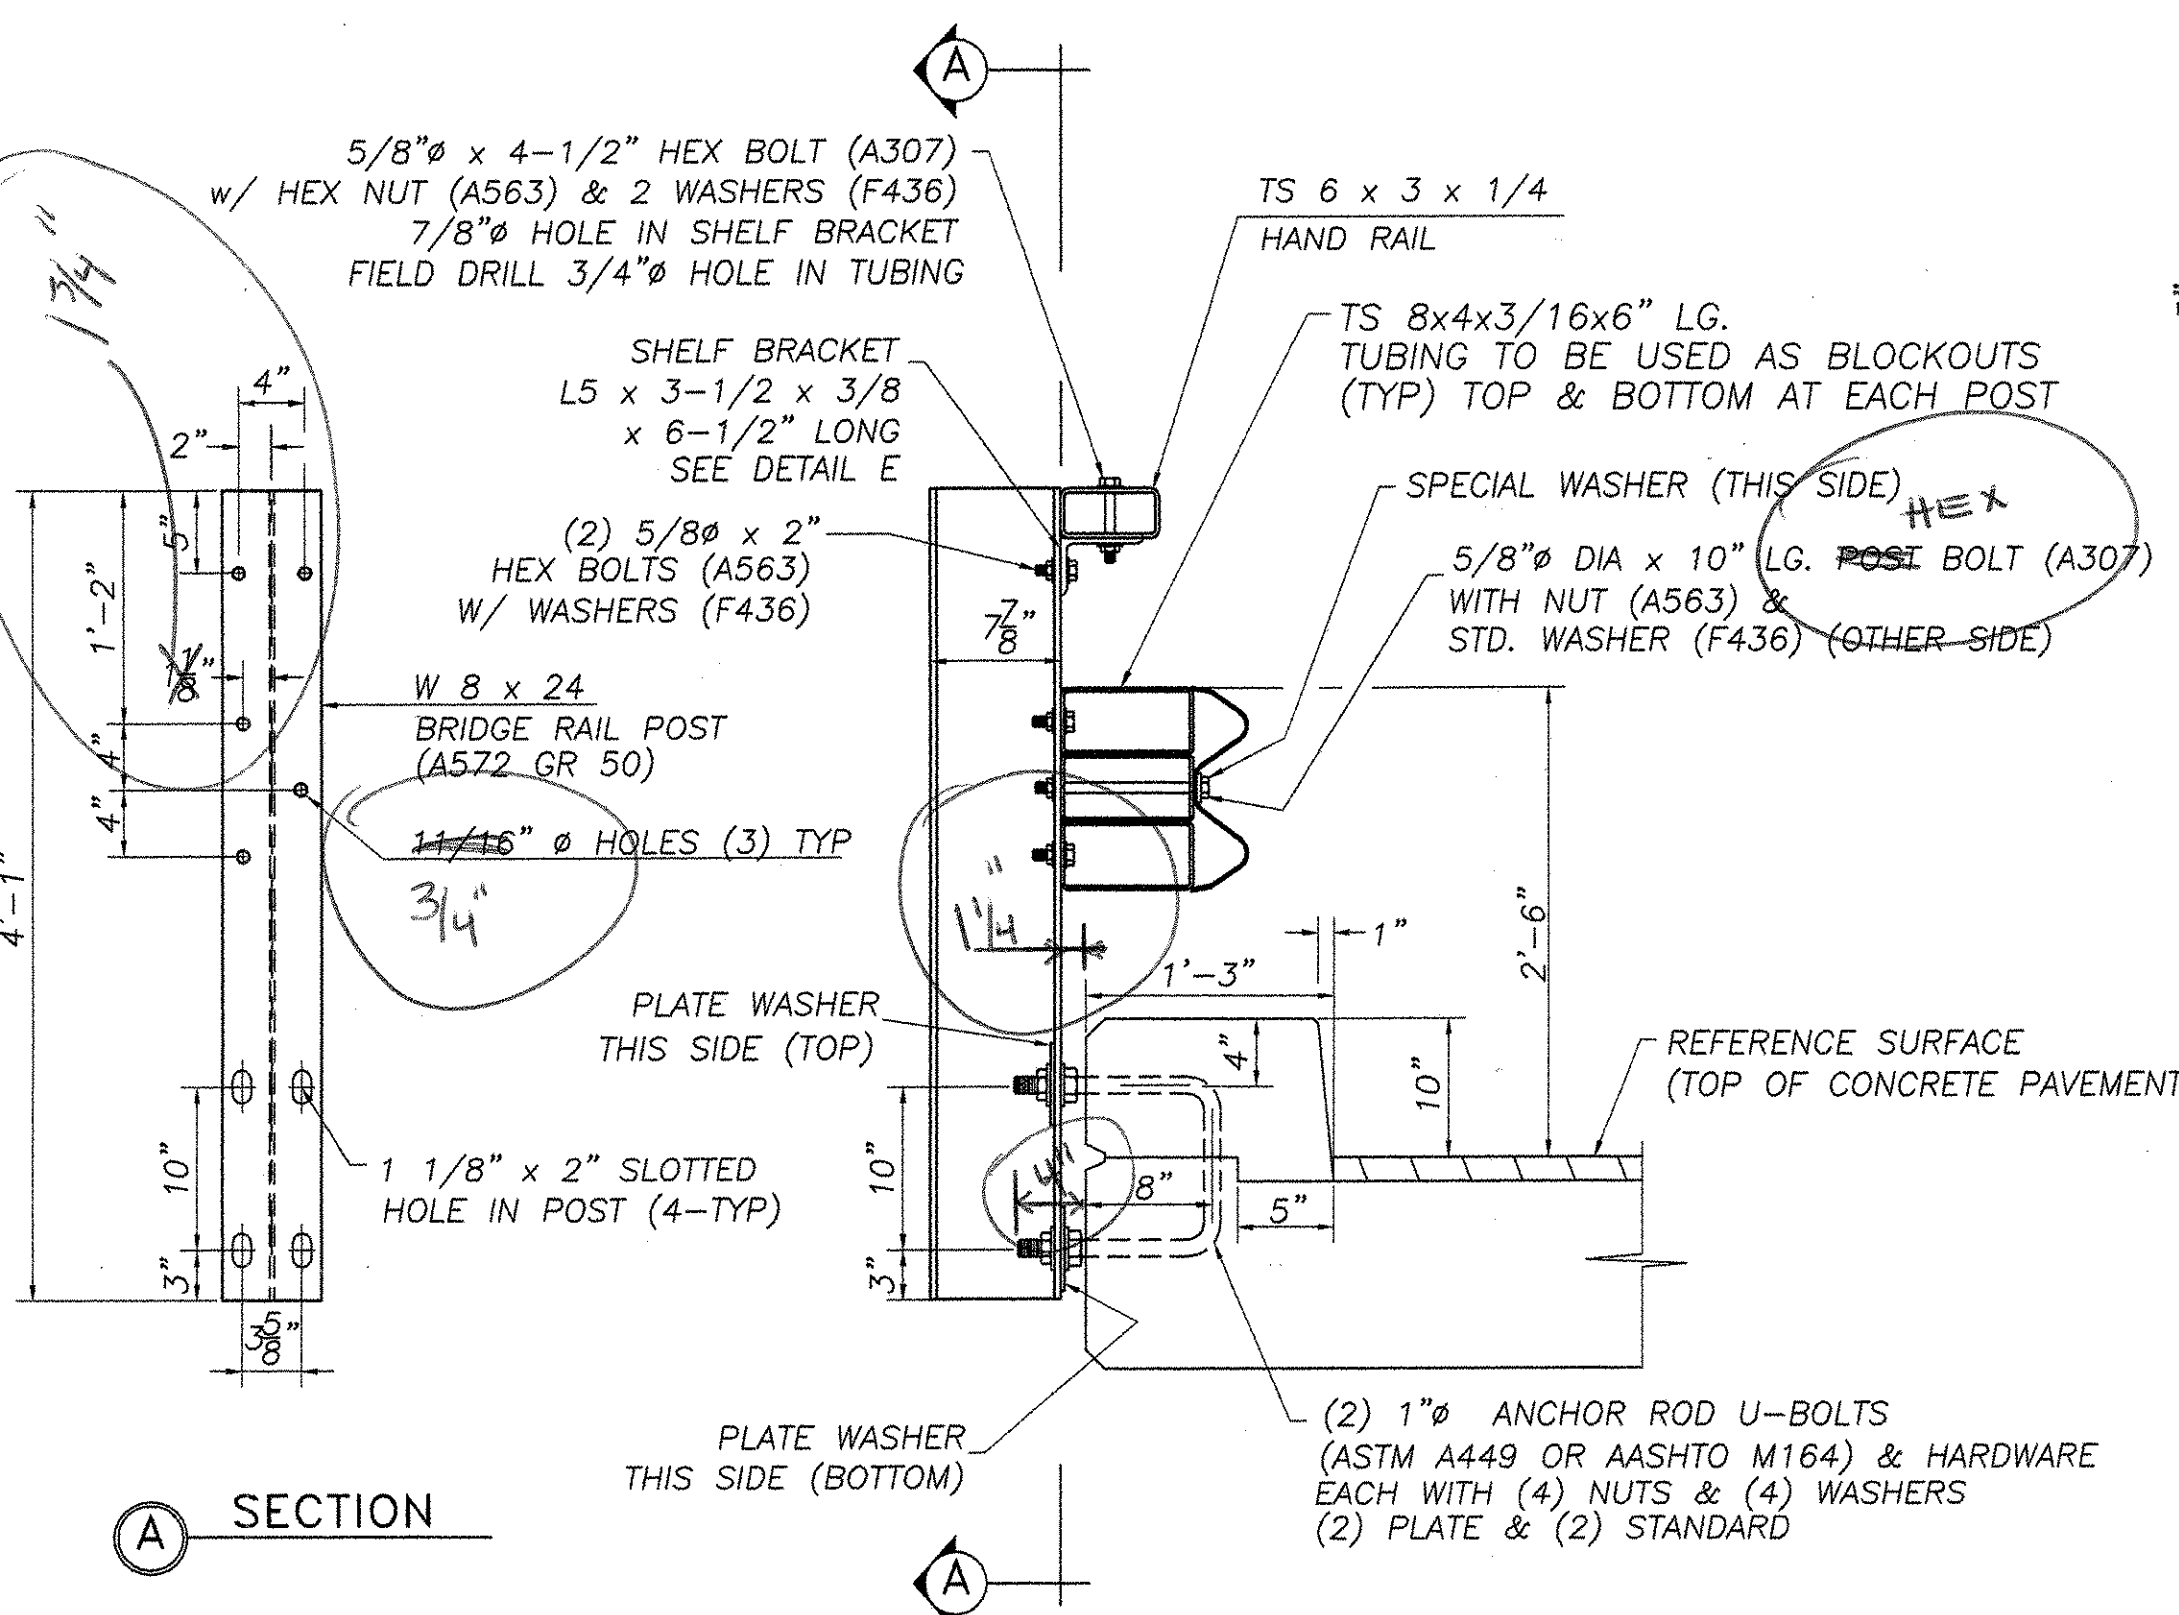


SECTION A

FASCIA MOUNTED POST WITH CURB W 8 x 24 (A572 GR 50)

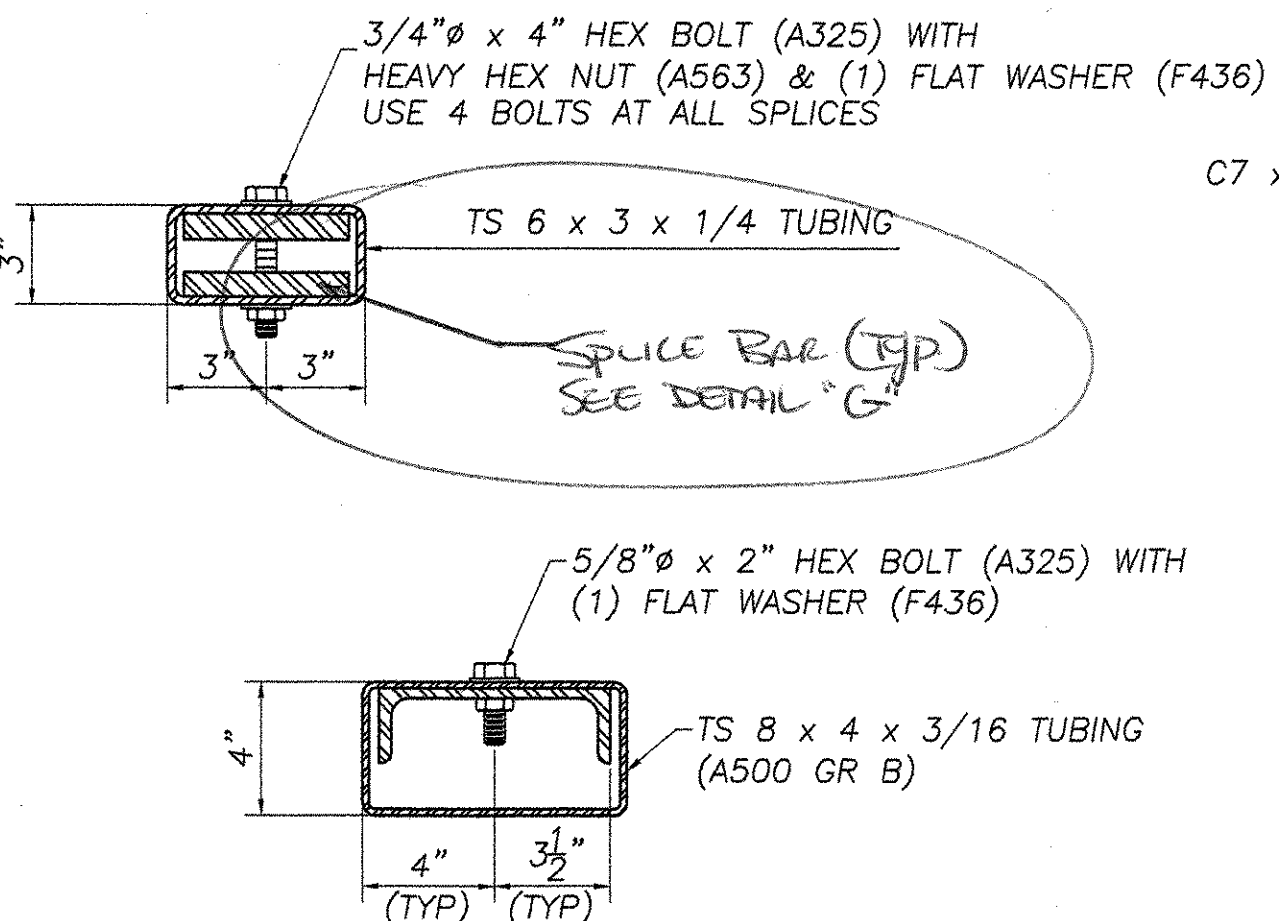

PARTIAL SECTION B SHOWING HAND RAIL TUBE, BRIDGE RAIL TUBE & SPLICE BARS

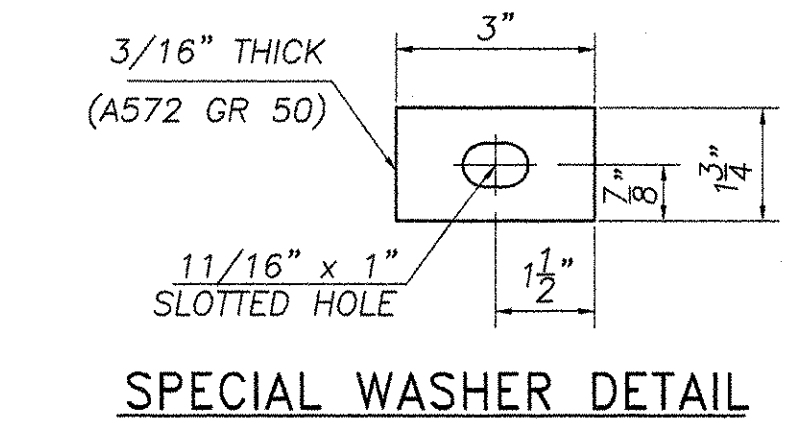

SPECIAL WASHER DETAIL



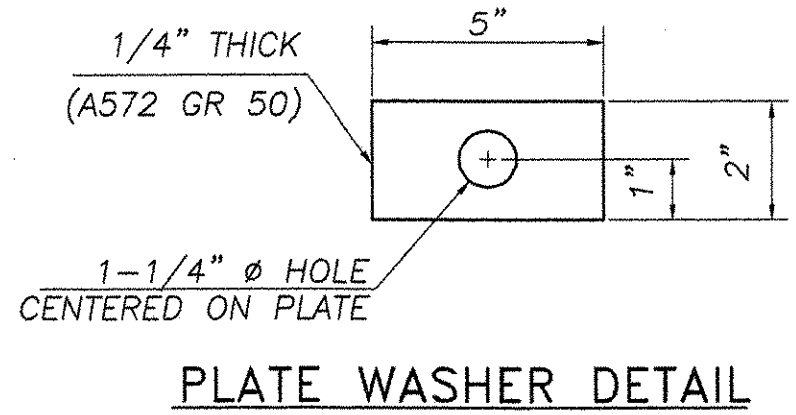


PLATE WASHER DETAIL

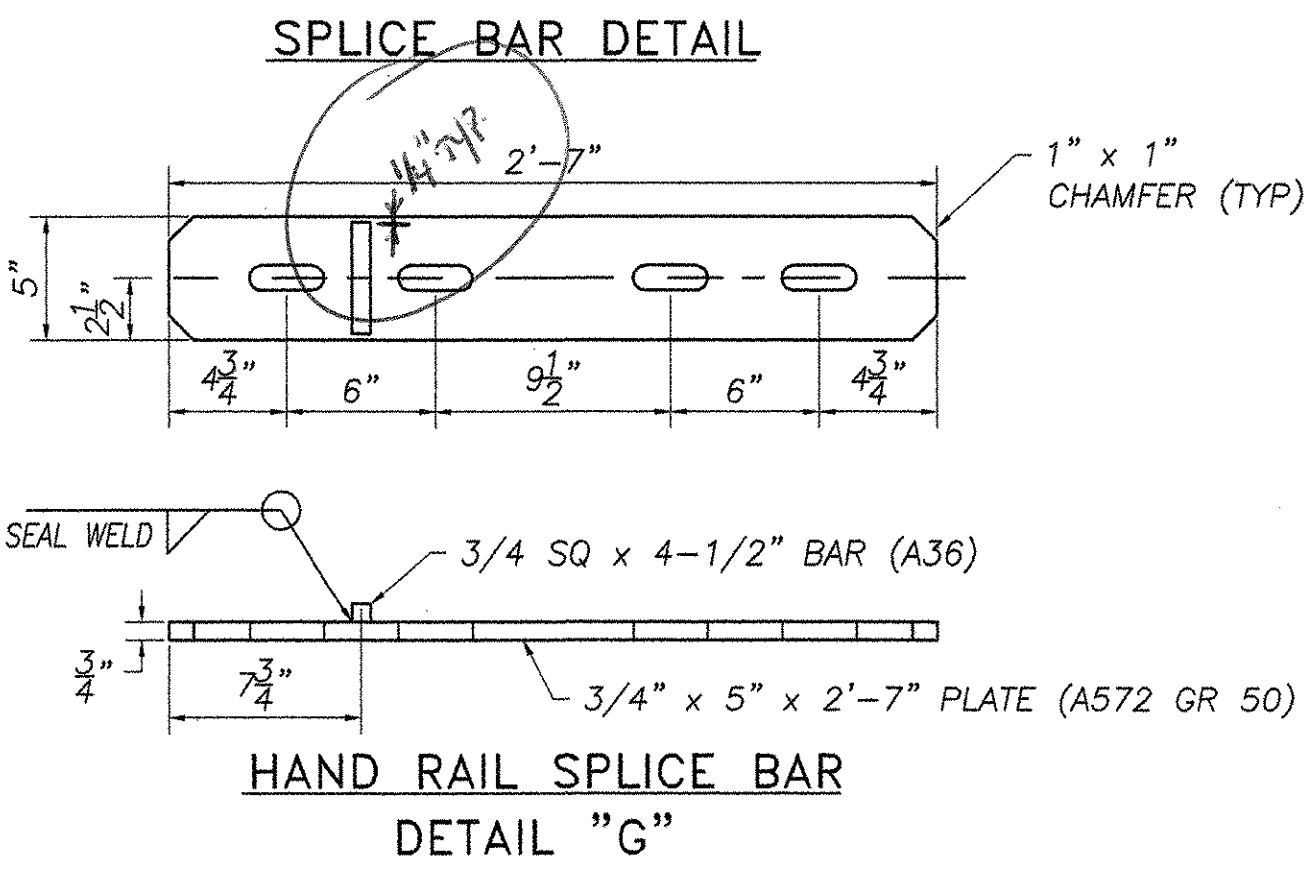

HAND RAIL SPLICE BAR DETAIL "G"

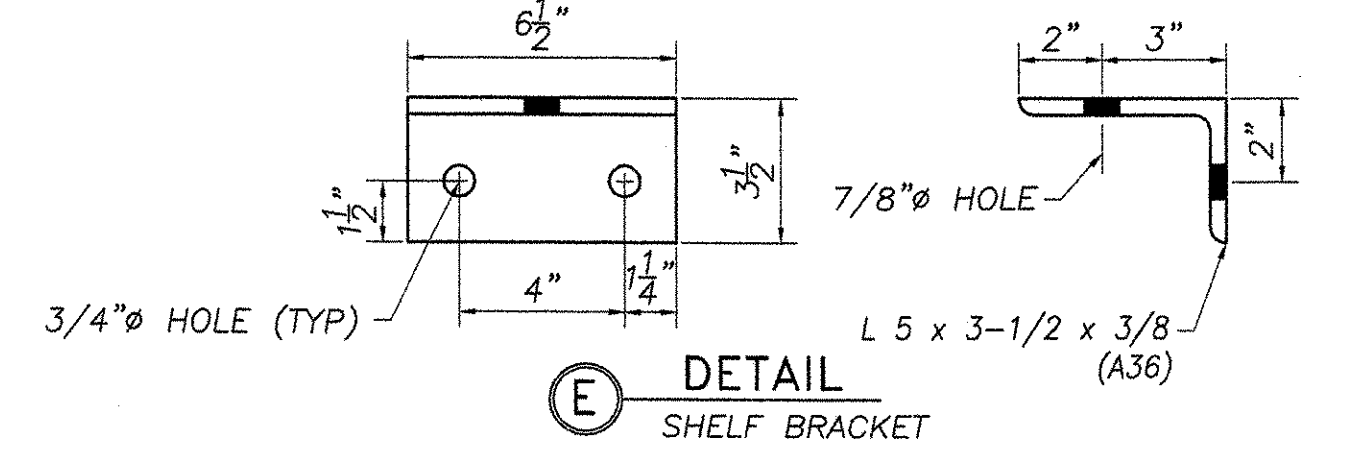

DETAIL E SHELF BRACKET

GENERAL ERECTION NOTES

1. Heavy duty steel beam guard rail shall conform to VT. specification 732. AASHTO M180 B2
2. Structural steel tubing shall conform to VT. specification 732. ASTM A500 gr B
3. Anchor bolts, nuts and washers shall be galvanized in accordance with AASHTO M 232 and shall conform to VT. specification 714 unless otherwise noted.
4. Bridge rail posts, special washers, splice bars and plate washers shall conform to AASHTO M 223 / M 223M and shall be galvanized after fabrication in accordance with AASHTO M 111. Prior to galvanizing all corners and edges of steel plates, shapes, etc., shall be ground to a 1/16" radius.
5. See standard drawing G-1 and G-1d for additional details concerning guard rail.
6. See standard drawing SB-R6-82 for approach rail details and for information relative to schedule I and schedule II. All approach rail shall be heavy duty steel beam guard rail. Also see Std. Dwg. SB-R6-82 for handrail details (except end details) if hand rail is required.
7. All posts shall be set normal to grade.
8. Splices for the steel beam guard rail shall lap in the direction of traffic.
9. See Standard drawing G-1 for details of delineators. A delineator shall be located at every fifth post. Payment shall be subsidiary to other items.
10. A railing joint splice shall be provided at each superstructure expansion joint.
11. All field cut or drilled areas shall be coated with zinc rich paint.
12. For radii less than 950 feet, the steel tubing shall be shop bent to fit the applicable curve.
13. The drop-weight tear test in section 732 shall not apply to the structural tubing on this standard.
14. All bolts and related hardware shall conform to AASHTO M164 type 1 bolts, hot dipped or mechanically galvanized per specification.

REVISIONS		
No.	Remarks	Date
0	Initial submittal	5/22/04

ACCEPTED  
 PREPARED AS CORRECTED  
 REJECTED, REVISE AND RESUBMIT  
 REJECTED UNACCEPTABLE  
 Drawing is only for conformity with the design portion of the project documents - with the information given in the contract documents. The Designer assumes no liability for errors or omissions in the contract documents. The Contractor is responsible for checking the contract documents, verifying the accuracy of the information, and obtaining the necessary permits and approvals from the appropriate authorities. The Contractor shall be responsible for obtaining the necessary permits and approvals from the appropriate authorities. The Contractor shall be responsible for obtaining the necessary permits and approvals from the appropriate authorities.  
 Date 6/15/04 By JCA

**HIGHWAY SAFETY CORP.**  
 GLASTONBURY, CT

ITEM 525.43 STEEL BRIDGE RAIL - HDSB W/HANDRAIL  
 BRIDGE NO. 11 HIGHWAY NO. TH 5  
 TOWN OF CHESTER, WINDSOR COUNTY  
 CHURCH STREET OVER WILLIAMS RIVER  
 PROJECT NO. TH 3-9637

DATE 5/15/04  
 SCALE N.T.S.  
 SHEET NO. 2 of 2

GENERAL CONTRACTOR: BHA 1442 (32)  
 SUB CONTRACTOR: F.R. LAFAYETTE, INC.

DRAWN: MHM  
 CHECKED: [Signature]  
 DATE: 5/15/04  
 SCALE: N.T.S.  
 SHEET NO.: 2 of 2

