


**ROADWAY TYPICAL SECTION**


NOT TO SCALE

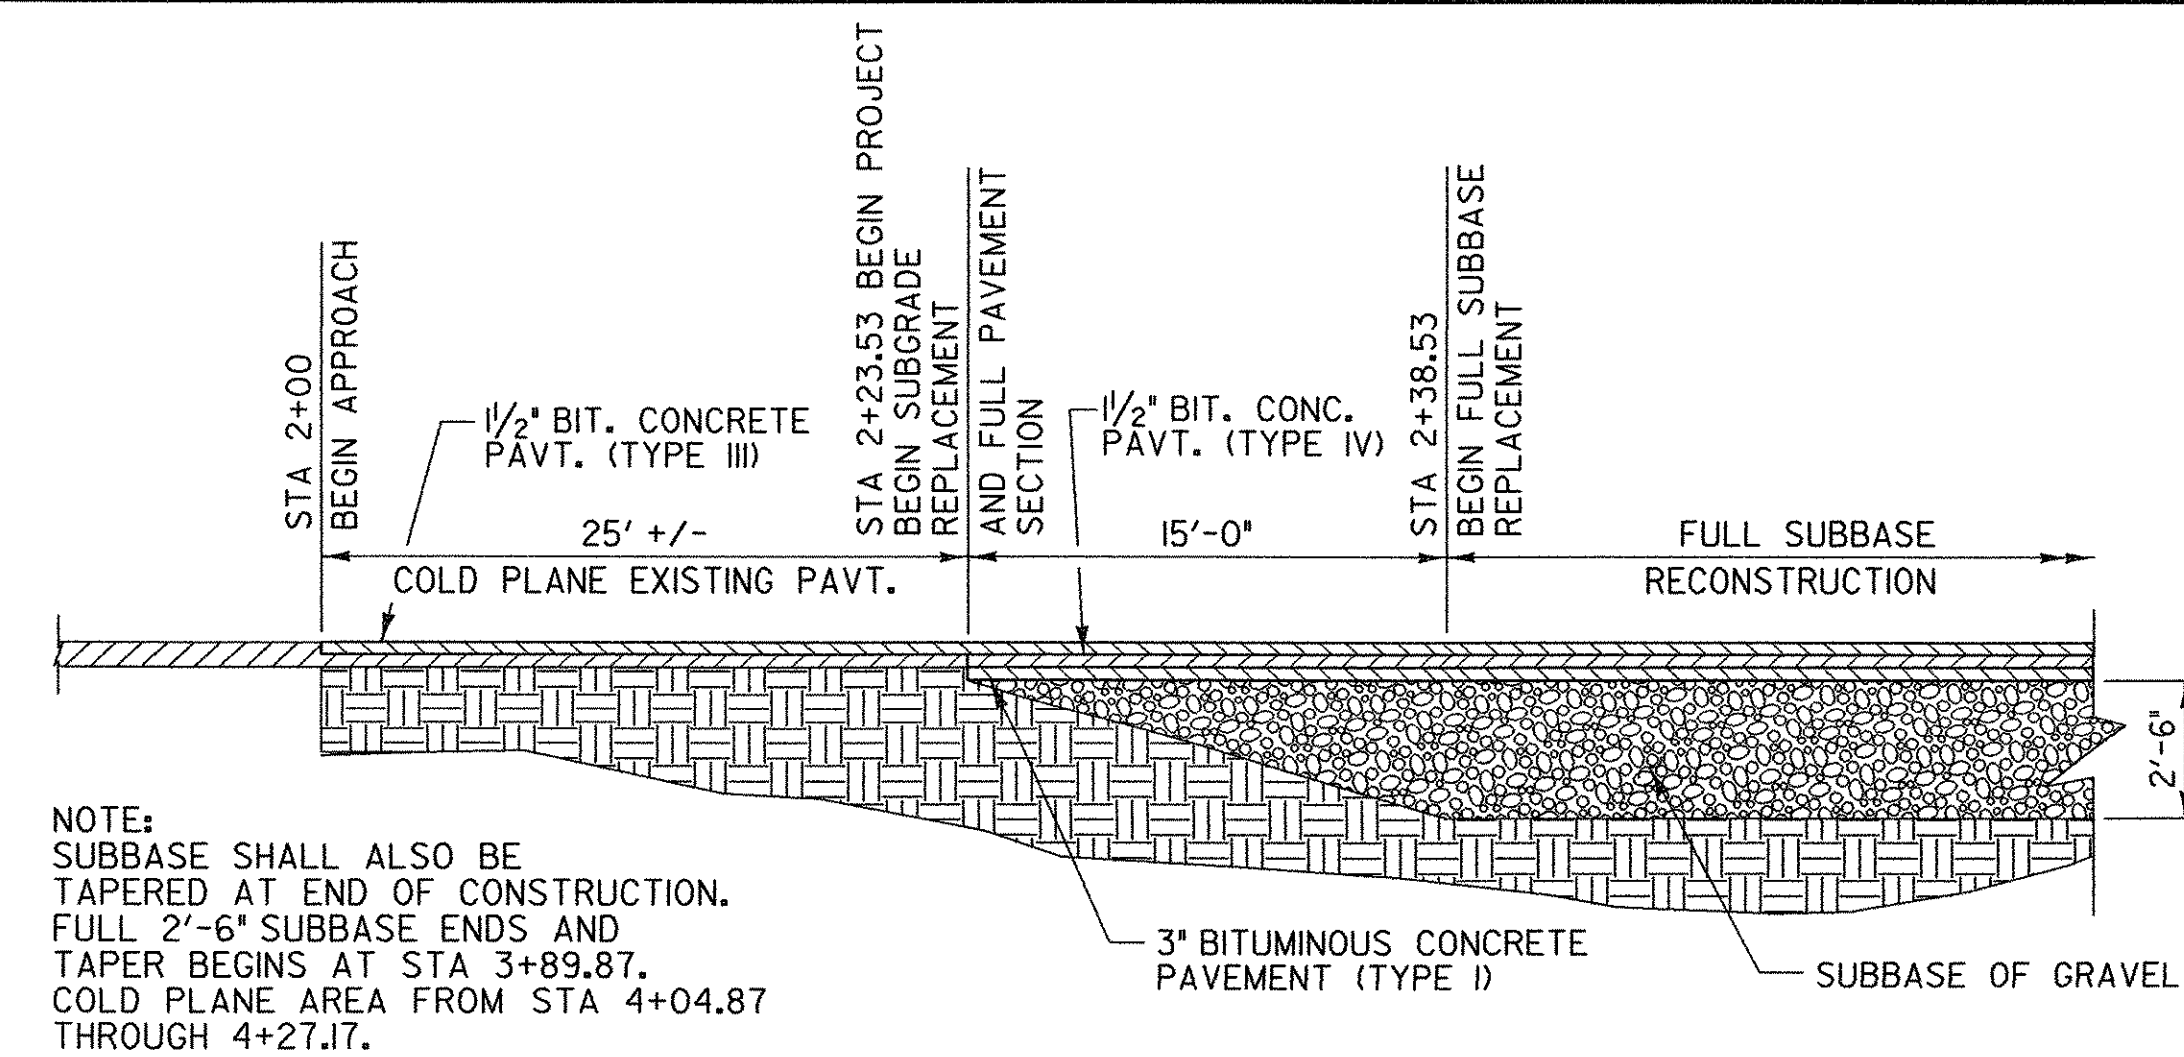

NOTE:  
 SUBBASE SHALL ALSO BE TAPERED AT END OF CONSTRUCTION. FULL 2'-6" SUBBASE ENDS AND TAPER BEGINS AT STA 3+89.87. COLD PLANE AREA FROM STA 4+04.87 THROUGH 4+27.17.


**TYPICAL APPROACH SECTION**

NOT TO SCALE

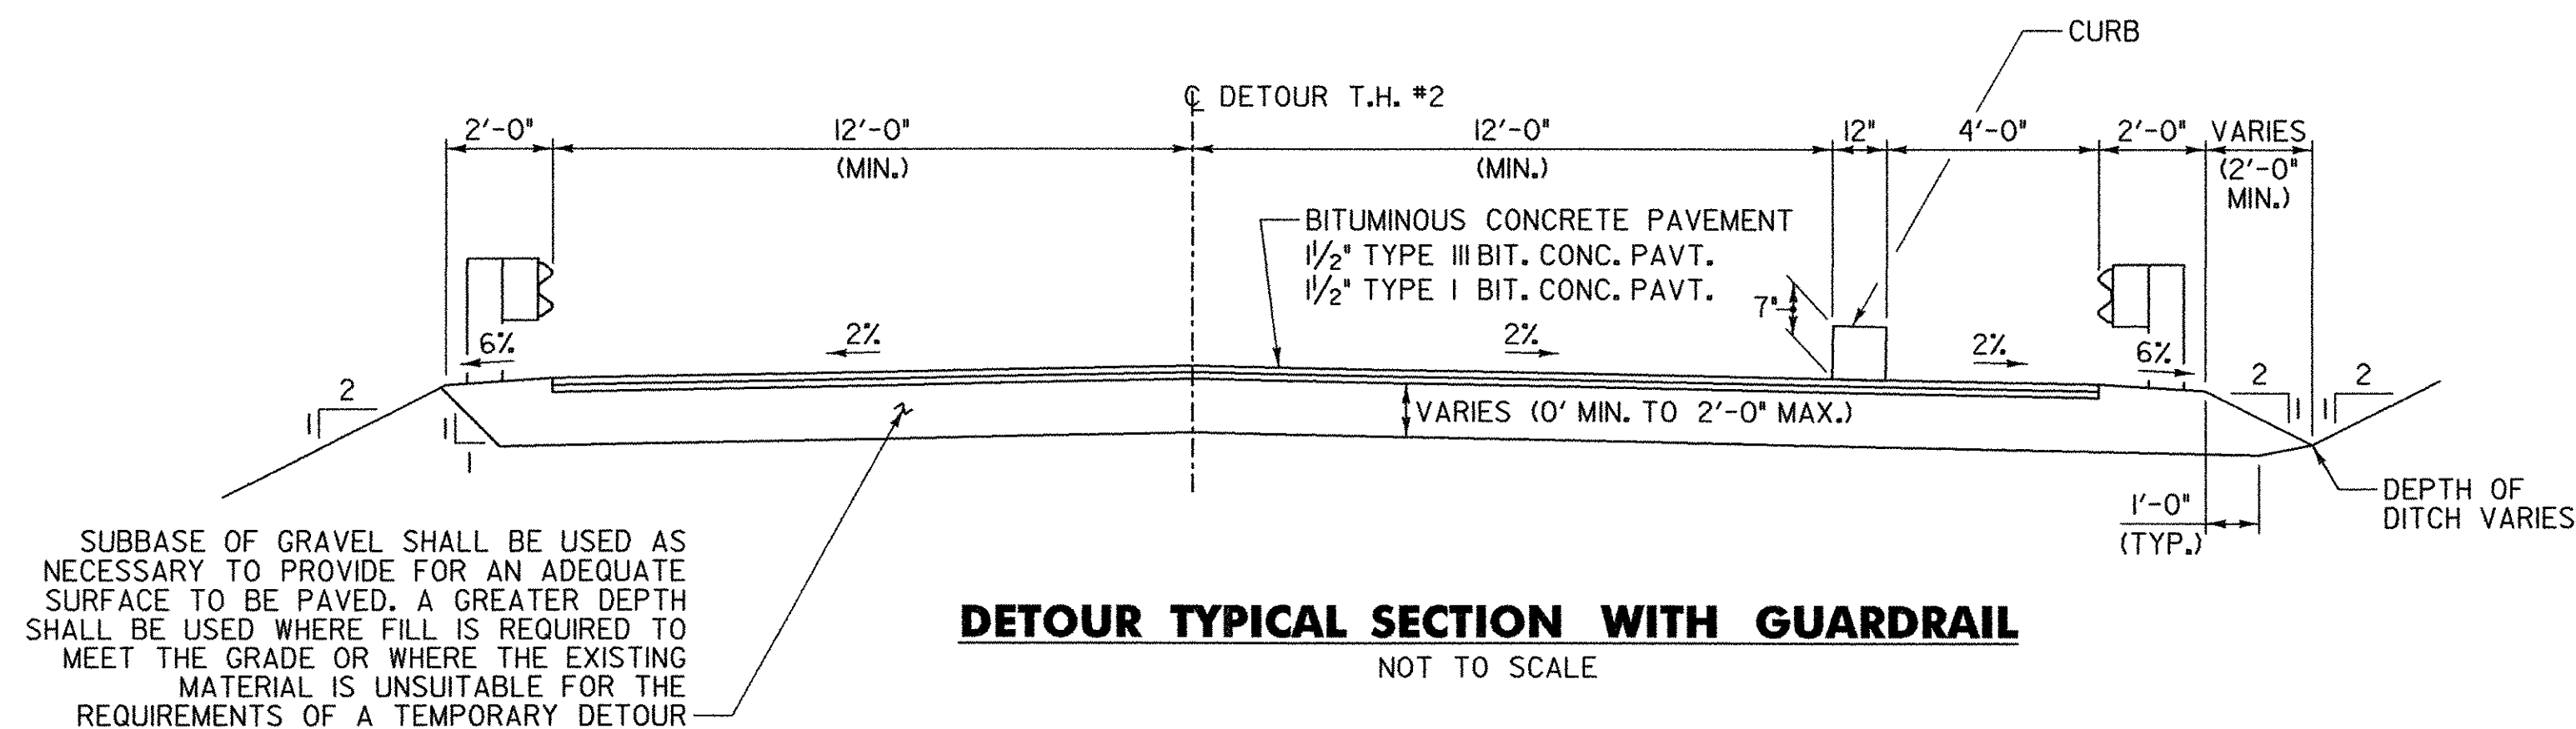

**DETOUR TYPICAL SECTION WITH GUARDRAIL**

NOT TO SCALE

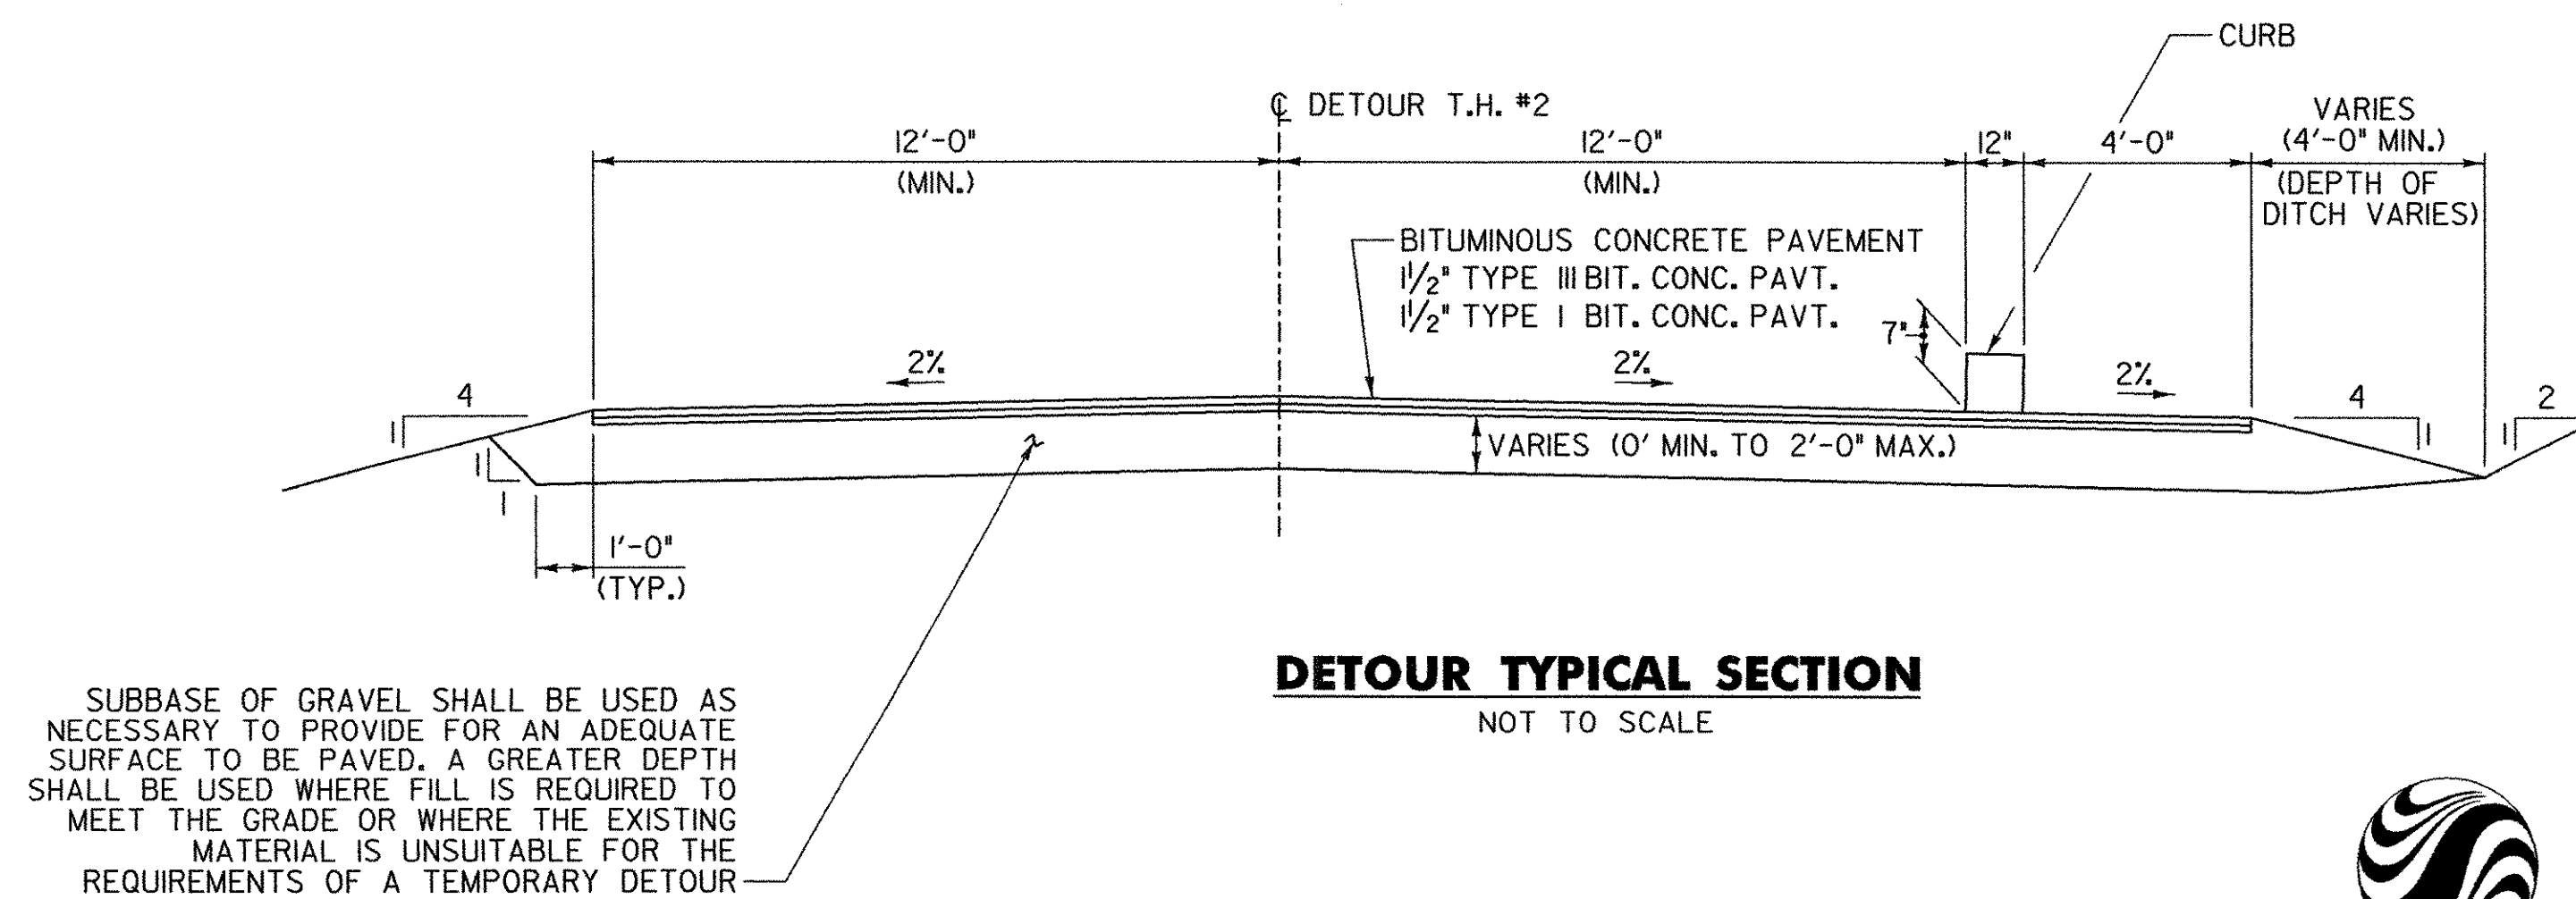

**DETOUR TYPICAL SECTION**

NOT TO SCALE



PROJECT NAME:	RICHFORD	PLOT DATE:	12/19/2007
PROJECT NUMBER:	BHF 0302 (3) S	DRAWN BY:	AET
FILE NAME:	...Design\Rich-rdwysect.dgn	CHECKED BY:	MJC
PROJECT LEADER:	MJC	TYPICAL ROADWAY SECTIONS	SHEET 4 OF 41
DESIGNED BY:	SEB		