

SOIL CLASSIFICATION
(NORTH SIDE OF RIVER)

MUNSON SILT LOAM
3% - 8% SLOPES
K FACTOR 0.49
CLASSIFIED HIGHLY ERODIBLE

SOIL CLASSIFICATION
(EAST SIDE OF RIVER)

DEERFIELD LOAMY FINE SAND
0% - 8% SLOPES
K FACTOR 0.17
CLASSIFIED LOW ERODIBLE

SOIL CLASSIFICATION
(EAST SIDE OF RIVER)

WINDSOR LOAMY FINE SAND
8% - 15% SLOPES
K FACTOR 0.17
CLASSIFIED LOW ERODIBLE

SOIL CLASSIFICATION
(SOUTHWEST SIDE OF RIVER)

ONDAWA VARIANT SILT LOAM
SLOPES NOT LISTED
K FACTOR 0.37
CLASSIFIED HIGHLY ERODIBLE


SOIL CLASSIFICATION
(SOUTHEAST SIDE OF RIVER)

RUMNEY VARIANT SILT LOAM
SLOPES NOT LISTED
K FACTOR 0.37
CLASSIFIED HIGHLY ERODIBLE

~KNOWN ARCHEOLOGICALLY SENSITIVE SITE TO BE AVOIDED~

--- LIMITS OF ARCHEOLOGICALLY SENSITIVE SITE

VERTICAL DATUM - NAVD88

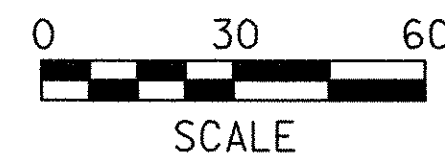

EPSC EXISTING CONDITIONS SITE PLAN

PROJECT NAME: RICHFORD
PROJECT NUMBER: BHF 0302 (3) S

FILE NAME: ...NPlotFiles\Rich-exist.ptf PLOT DATE: 12/18/2007
PROJECT LEADER: MJC DRAWN BY: JTS
DESIGNED BY: SEB CHECKED BY: MJC
EPSC EXISTING CONDITIONS SITE PLAN SHEET 10 OF 41

