


**BOTTOM CHORD SECTIONS**



**FRAMING PLAN**

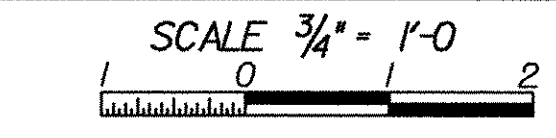

- LEGEND**
- J = JOINT
  - S = FLOOR STRINGER (NEW W16x45)
  - B = BEAM (NEW W27x94)
  - T = TRUSS BOTTOM CHORD (SEE SECTIONS AT LEFT)
  - SS = SIDEWALK STRINGER (NEW W8x10)
  - SC = EXISTING SIDEWALK CHANNEL (C7)
  - = NEW FRAMING MEMBER
  - = EXISTING FRAMING MEMBER TO BE RETAINED



PROJECT NAME: RICHFORD	PLOT DATE: 12/18/2007
PROJECT NUMBER: BHF 0302 (3) S	DRAWN BY: JJS
FILE NAME: ...Design\Rich-frame.dgn	CHECKED BY: MJC
PROJECT LEADER: MJC	SHEET 22 OF 41
DESIGNED BY: SEB	