


NOTE:
 CLEARANCE TO STEEL FRAMING AT
 BLOCKOUTS SHALL BE A MAXIMUM
 OF 2" AND A MINIMUM OF 1/2".

DECK PLAN

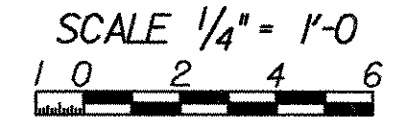

PROJECT NAME:	RICHFORD	PLOT DATE:	12/18/2007
PROJECT NUMBER:	BHF 0302 (3) S	DRAWN BY:	JTS
FILE NAME:	...Design\Rich-deck.pln.dgn	CHECKED BY:	MJC
PROJECT LEADER:	MJC	SHEET	26 OF 41
DESIGNED BY:	SEB	DECK REINFORCING PLAN	