



PLAN
SCALE 1/4" = 1'-0"
1 0 2 4 6

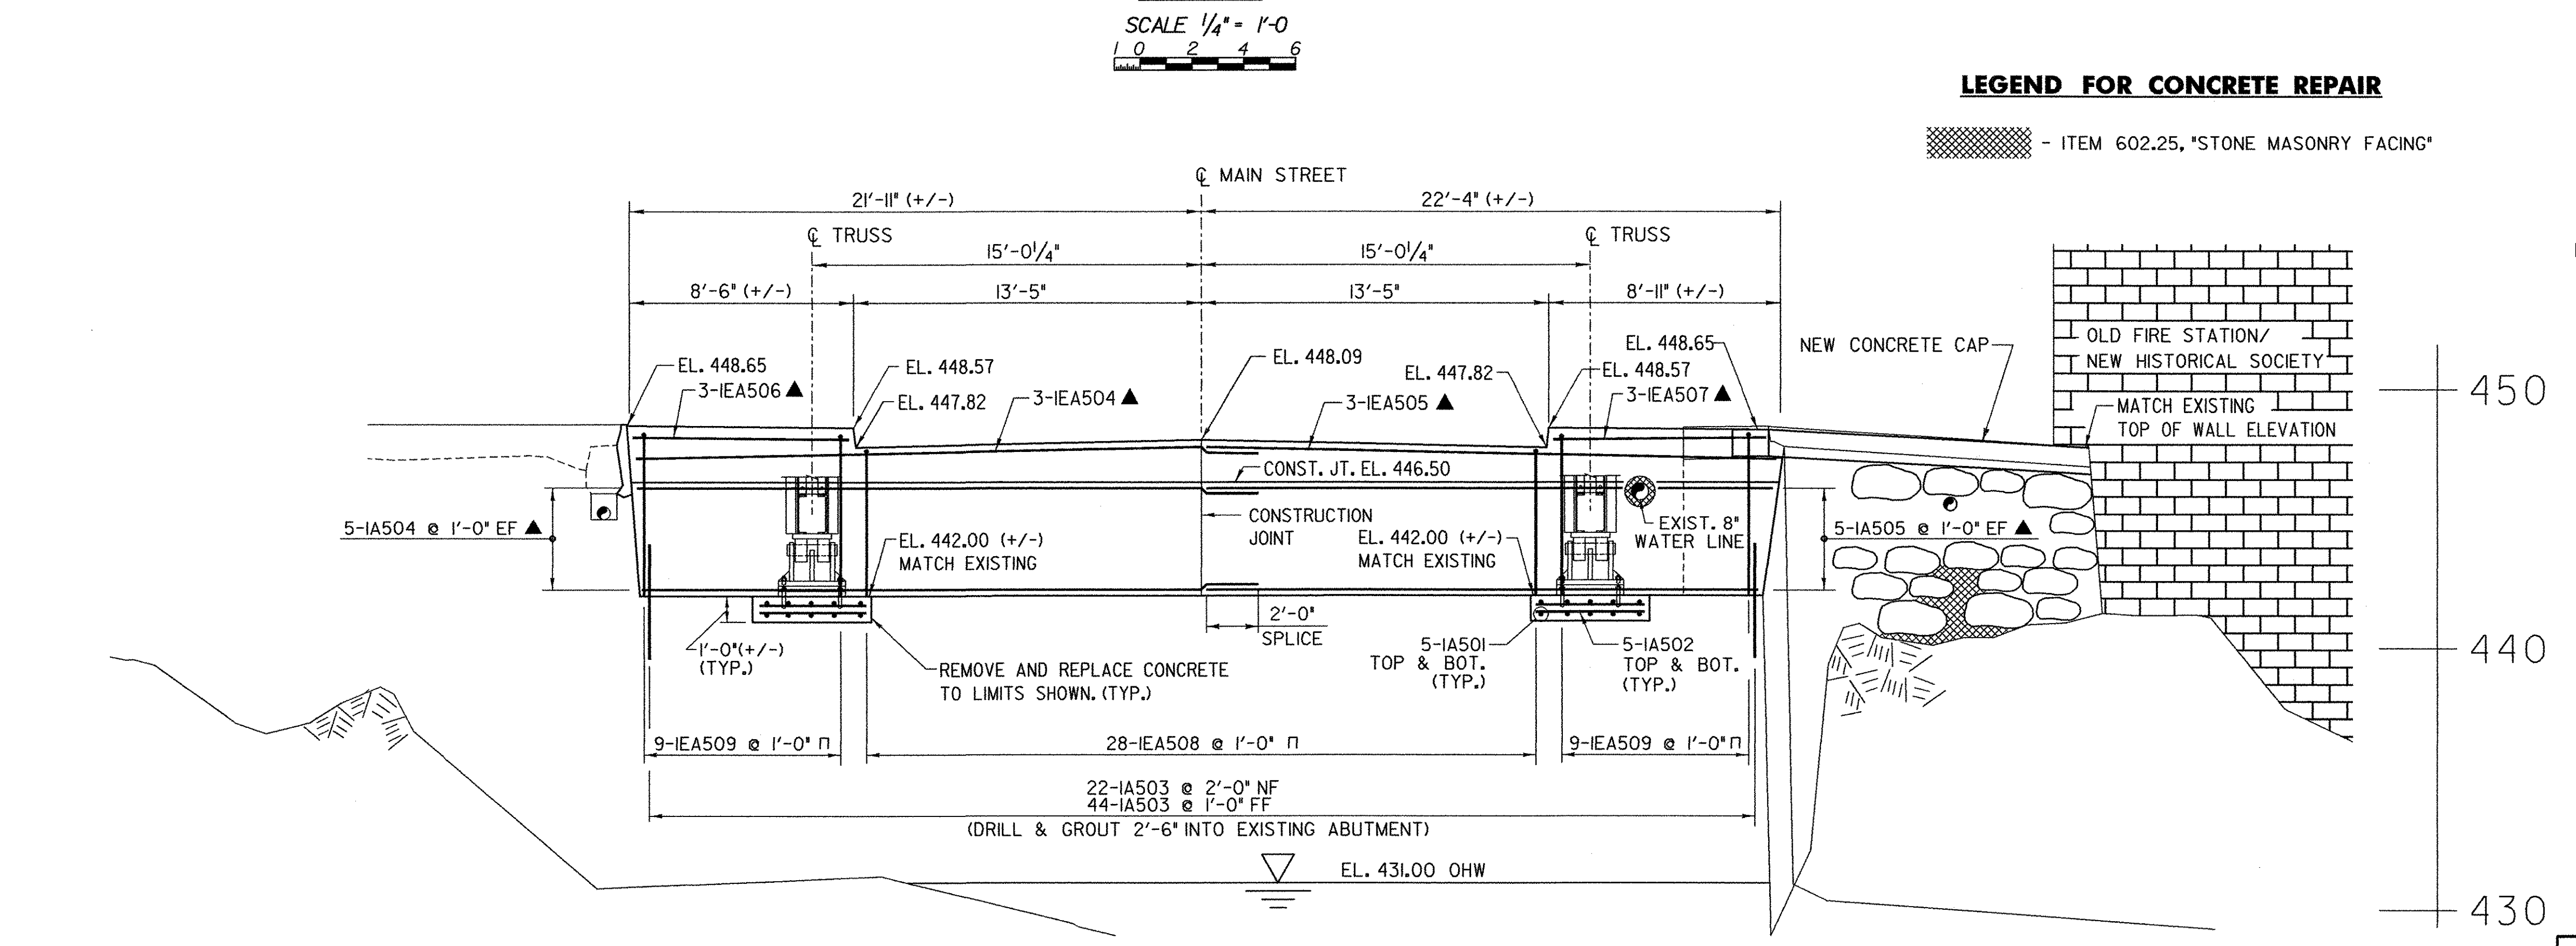


ELEVATION
SCALE 1/4" = 1'-0"
1 0 2 4 6

NOTE:
NF = NEAR FACE
FF = FAR FACE
EF = EACH FACE
▲ = CUT TO FIT IN FIELD

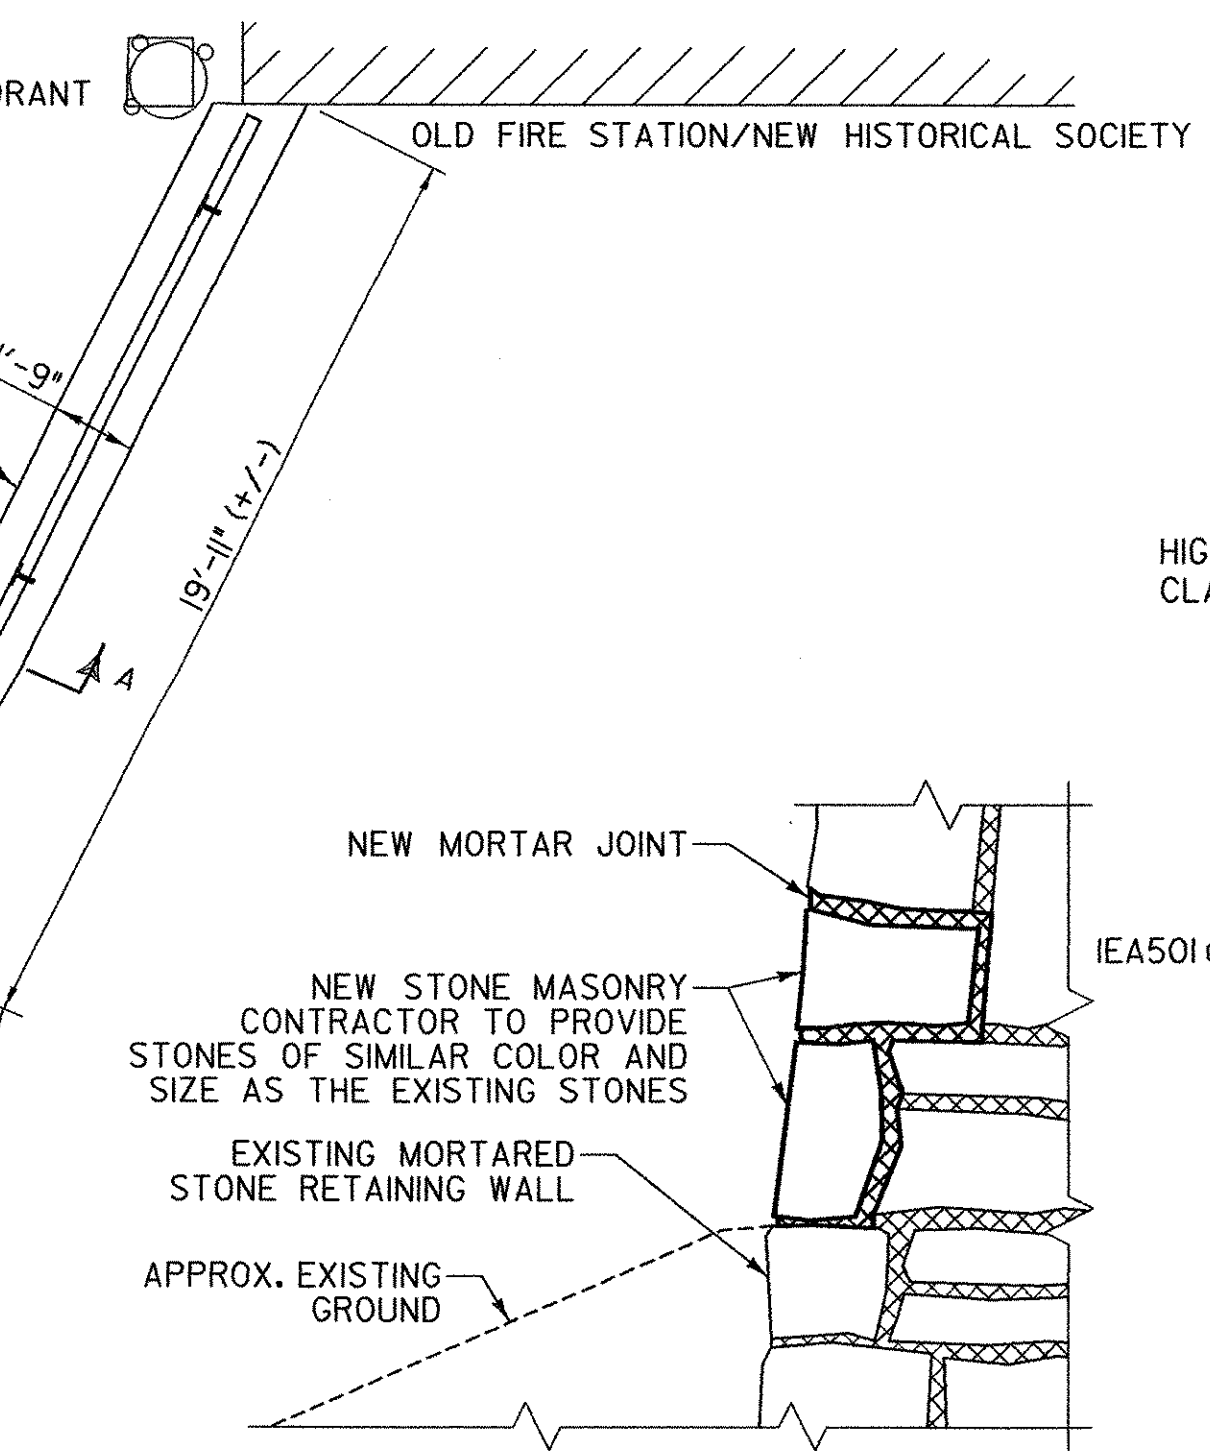


TYPICAL SECTION OF STONE MASONRY FACING
NOT TO SCALE

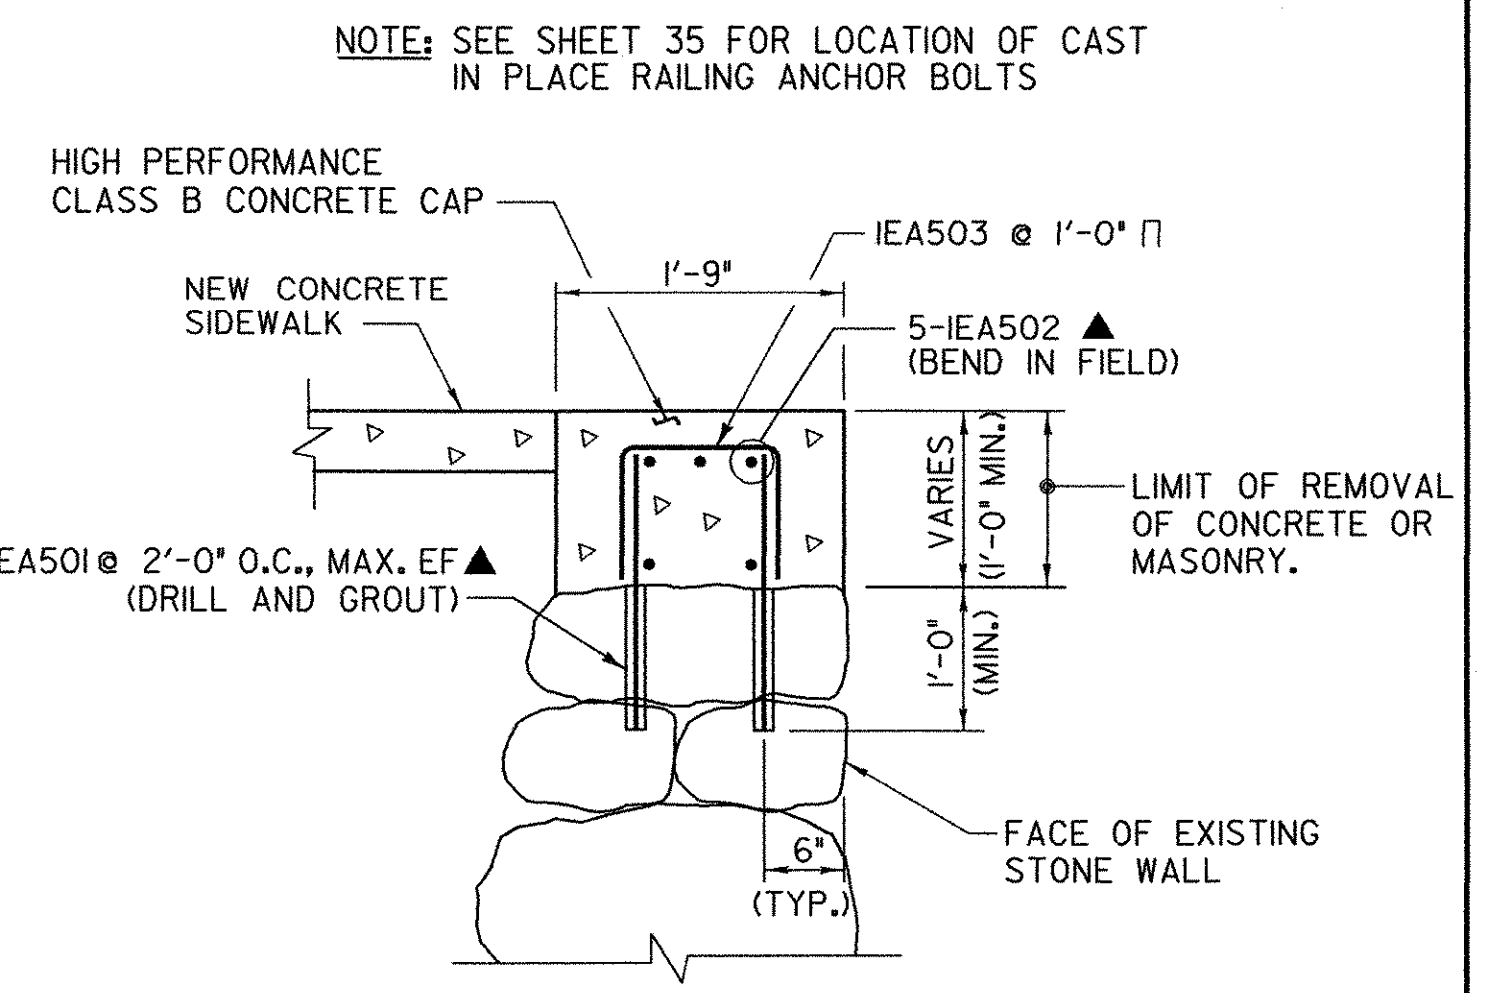

SECTION A-A
SCALE 3/4" = 1'-0"
1 0 2

LEGEND FOR CONCRETE REPAIR

■ - ITEM 602.25, "STONE MASONRY FACING"

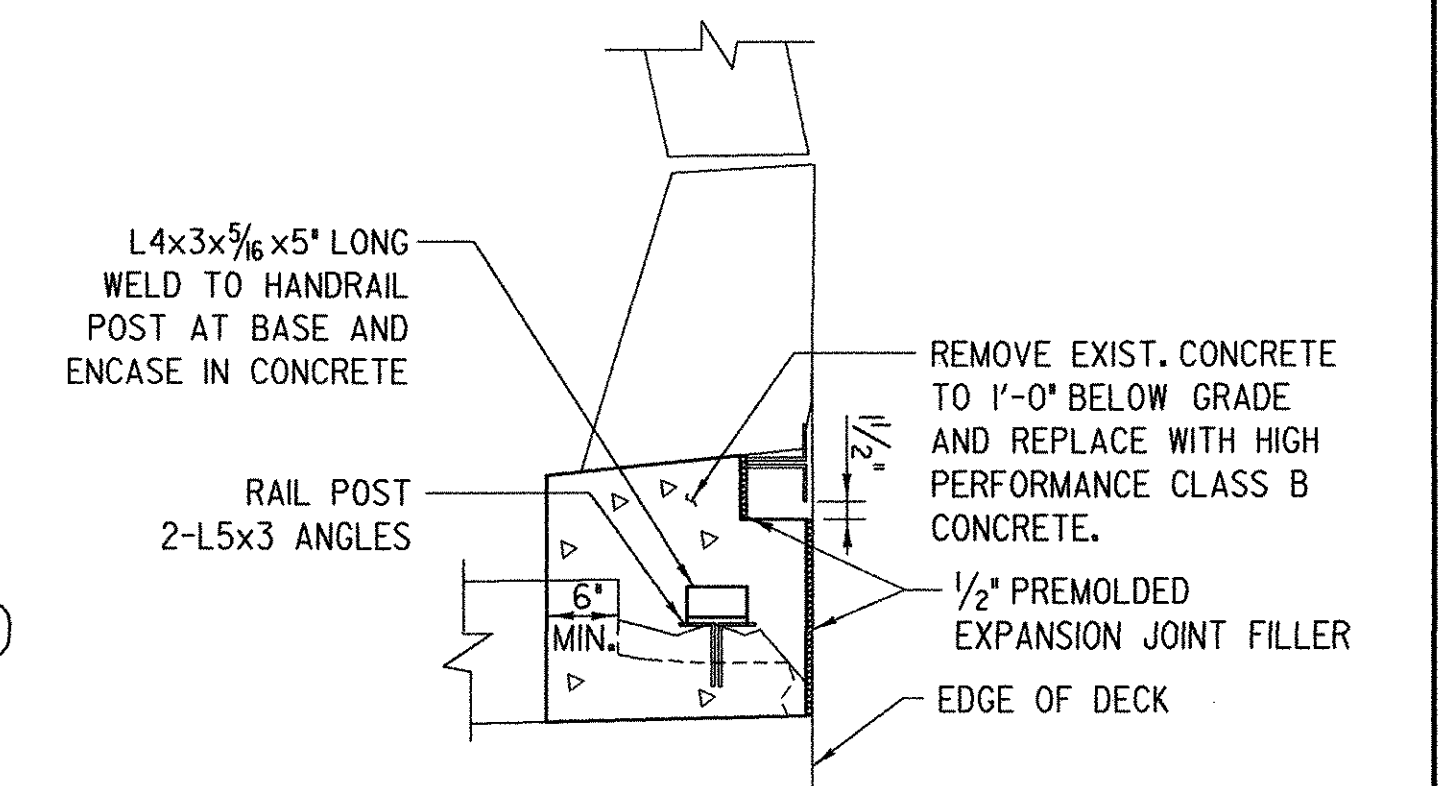

DETAIL A
SCALE 3/4" = 1'-0"
1 0 2

NOTES:
1. SEE SHEET 33 FOR ABUTMENT SECTIONS.
2. AREAS OF CONCRETE SURFACE REPAIR ON EXISTING ABUTMENTS TO BE DETERMINED IN THE FIELD BY THE ENGINEER AND PAID FOR UNDER ITEM 580.13 "REPAIR OF CONCRETE SUBSTRUCTURE SURFACE CLASS I OR 580.14 "REPAIR OF CONCRETE SUBSTRUCTURE SURFACE CLASS II.



PROJECT NAME:	RICHFORD	FILE NAME:	...Design\Rich-abut1.dgn	PLOT DATE:	12/18/2007
PROJECT NUMBER:	BHF 0302 (3) S	PROJECT LEADER:	MJC	DRAWN BY:	AET
		DESIGNED BY:	SEB	CHECKED BY:	MJC
ABUTMENT NO. 1 PLAN & ELEVATION			SHEET 31 OF 41		