




104+50

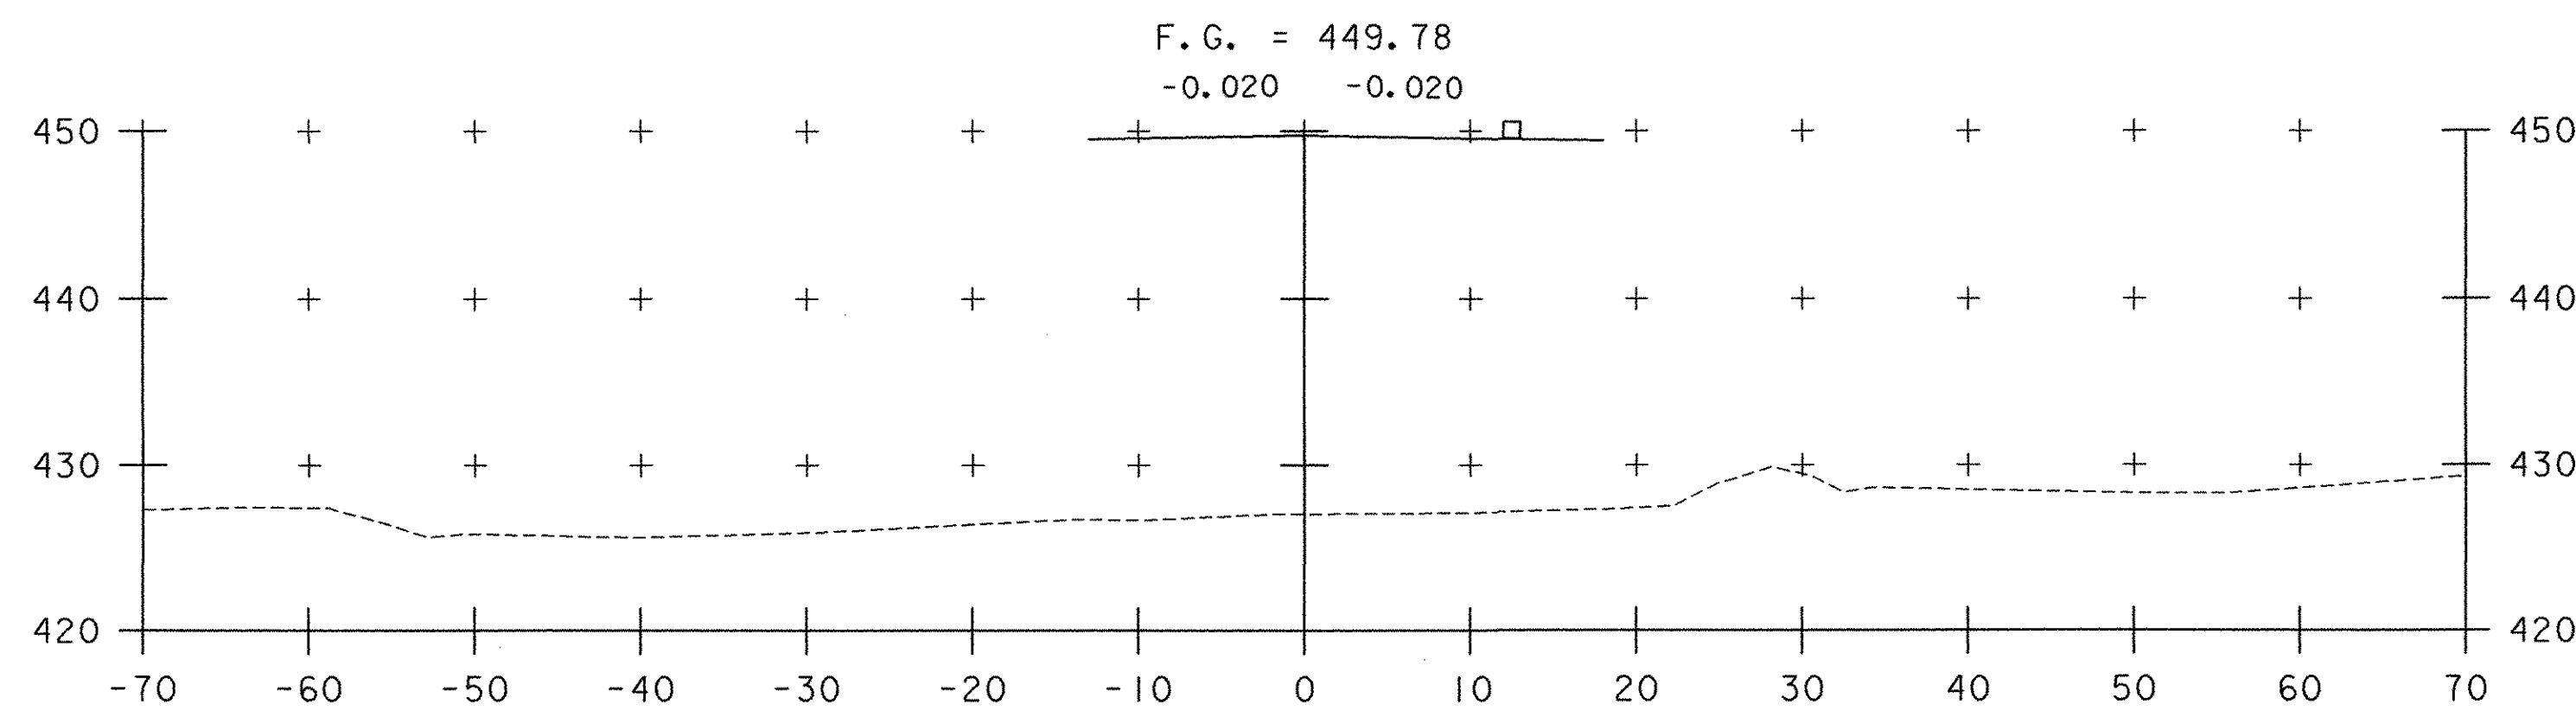


104+25

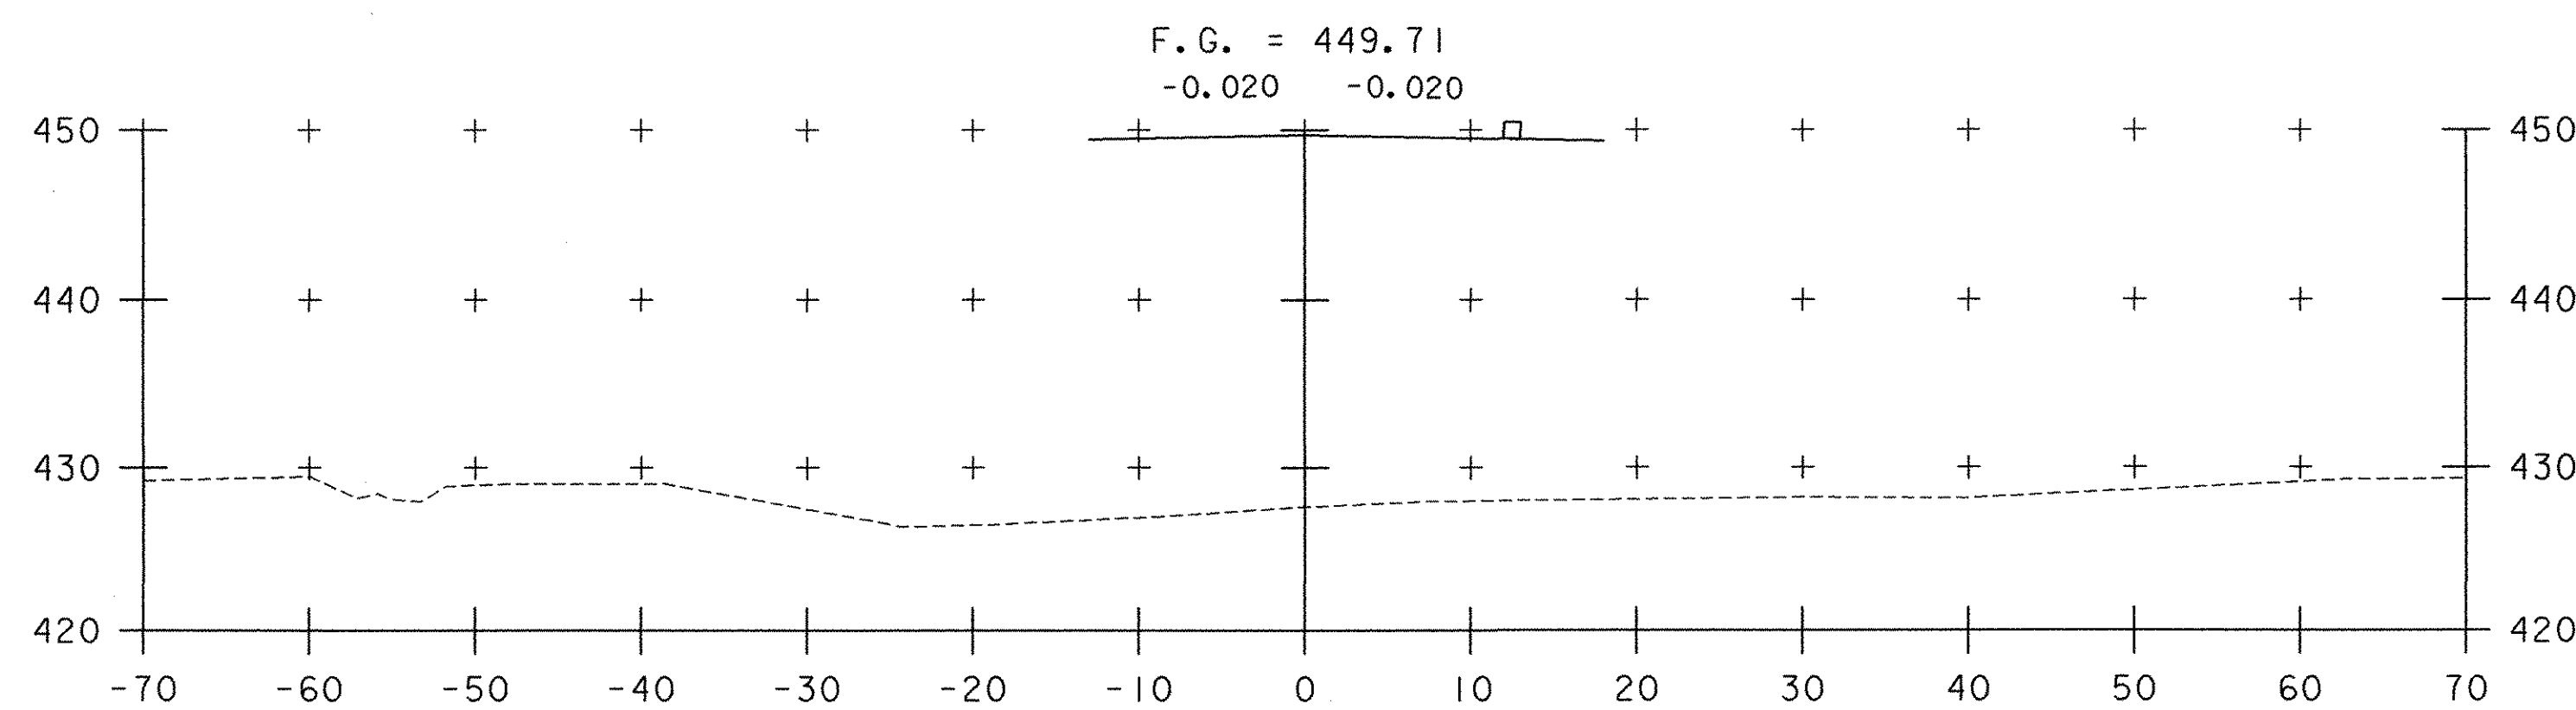


104+00

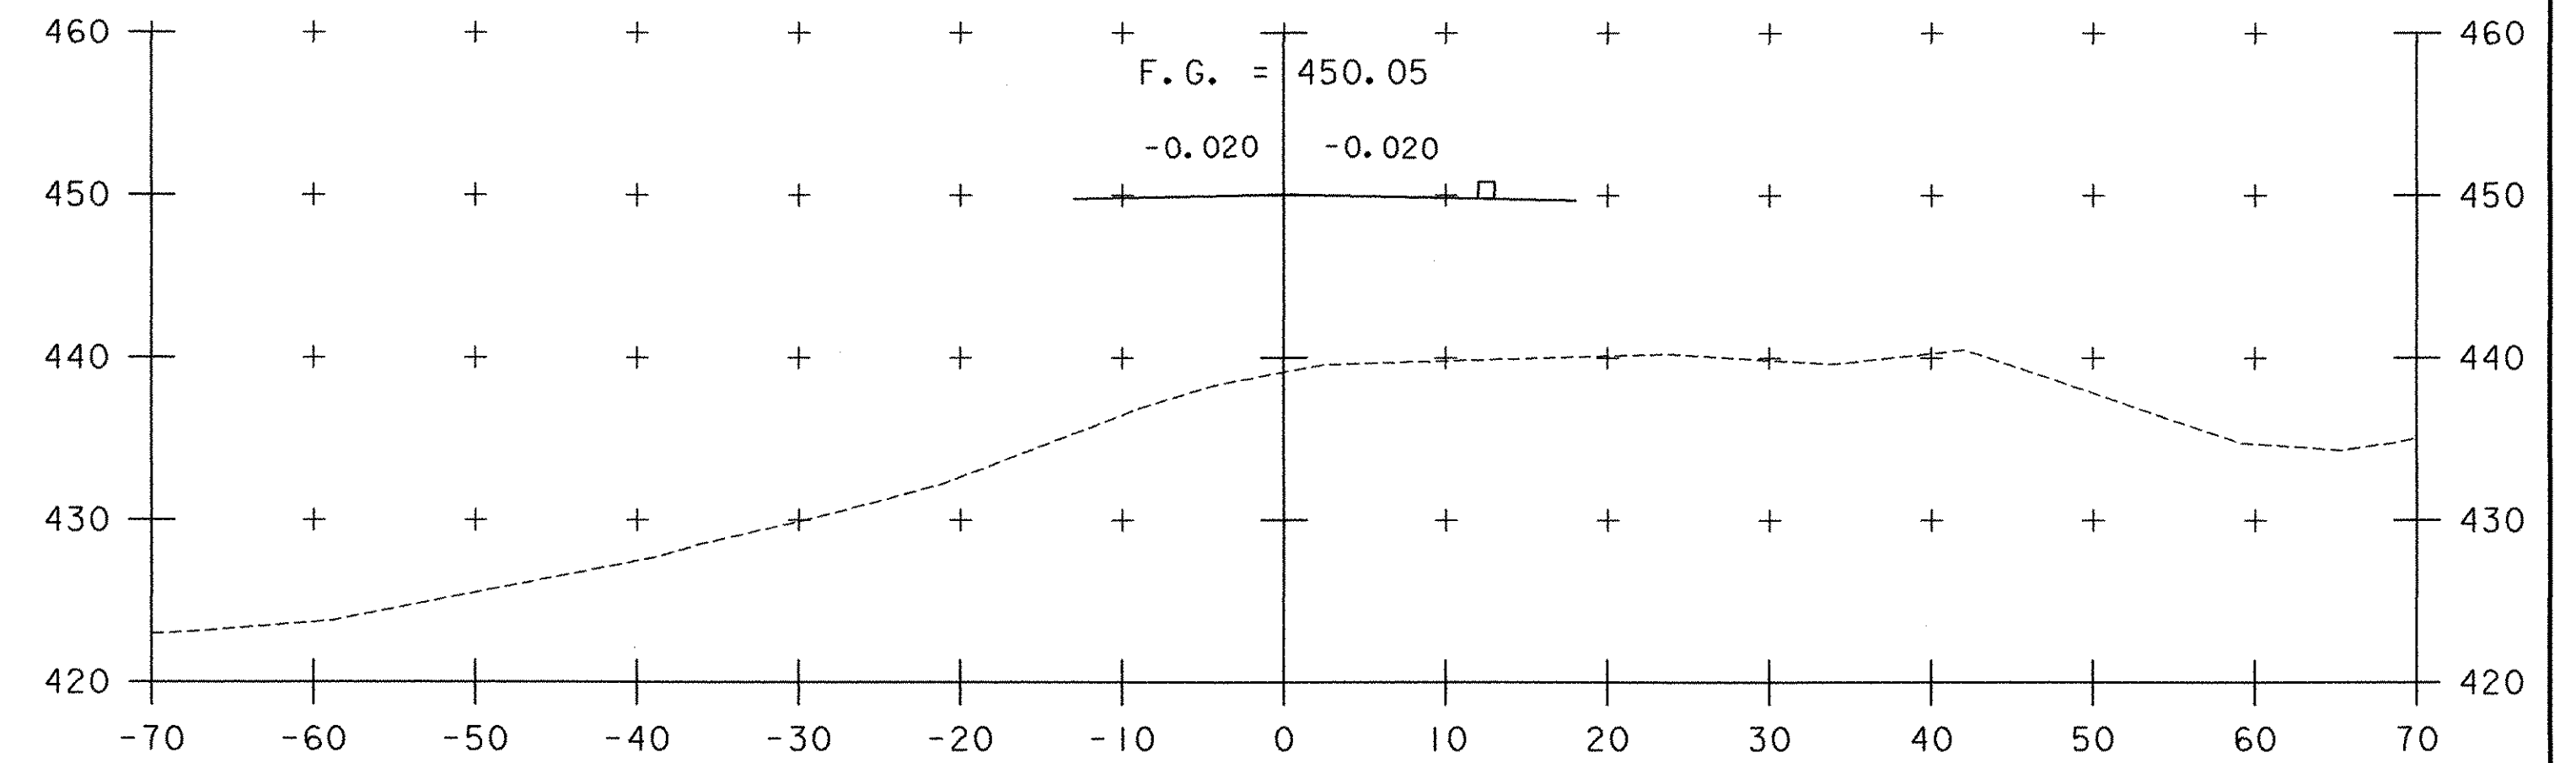

105+25

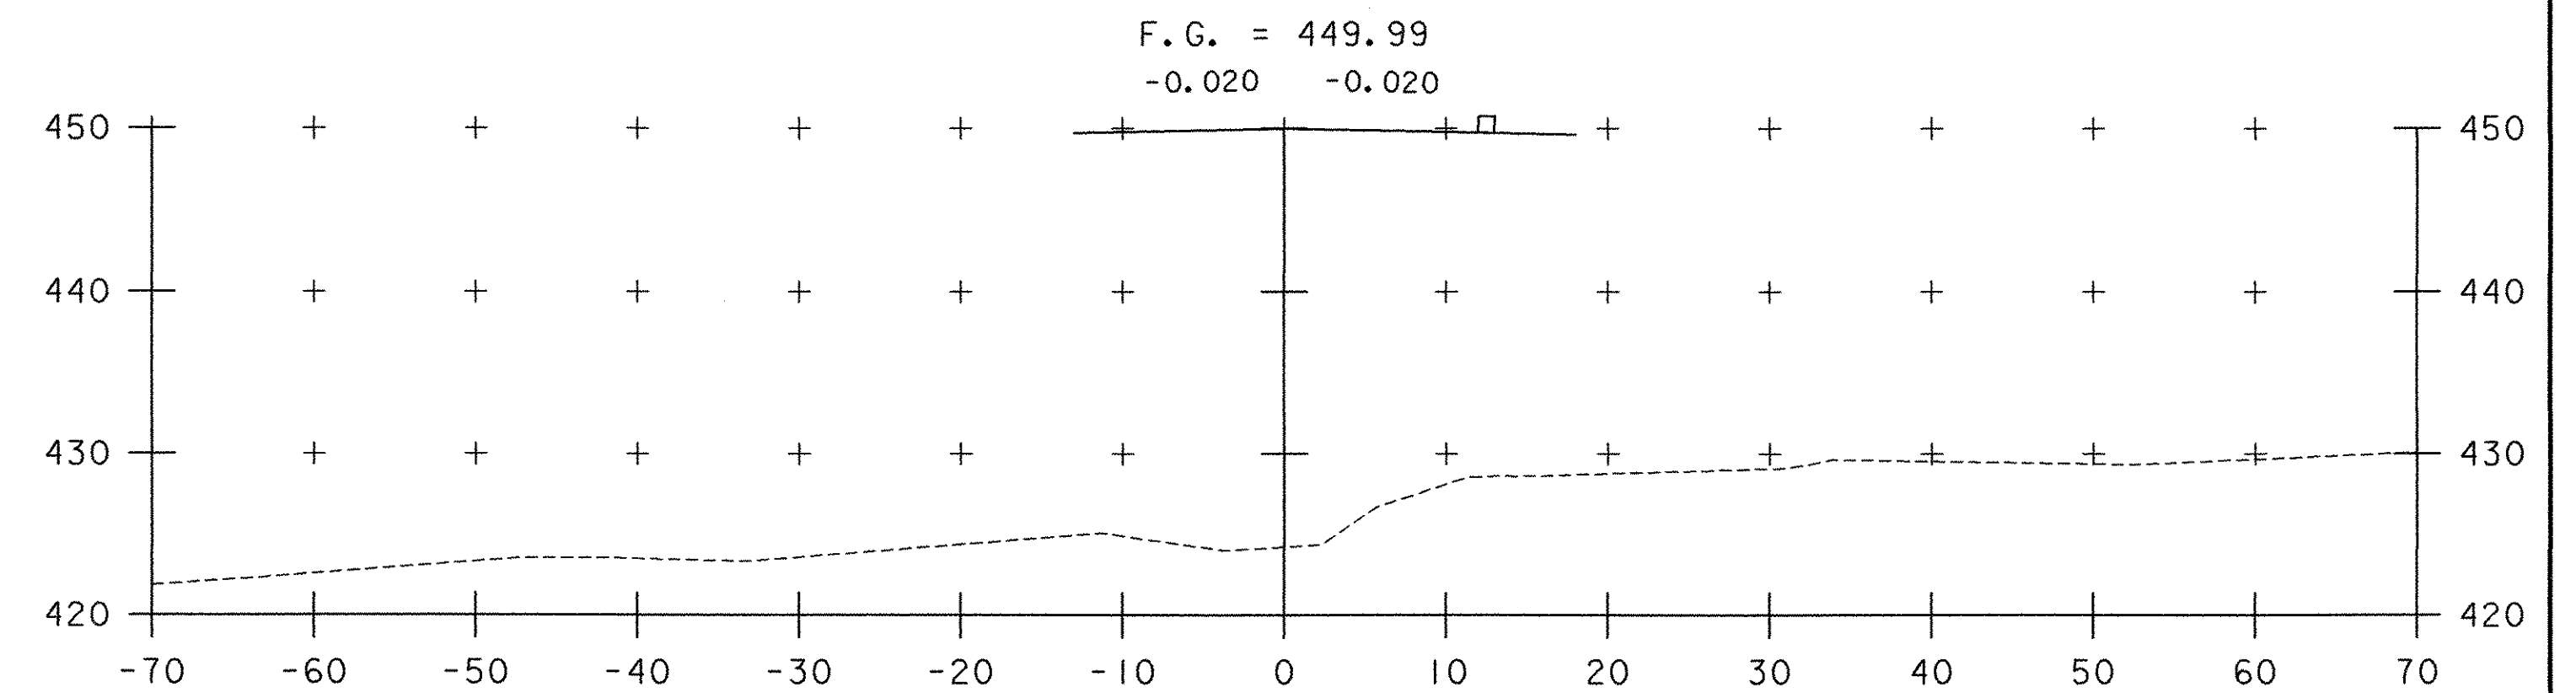

105+00

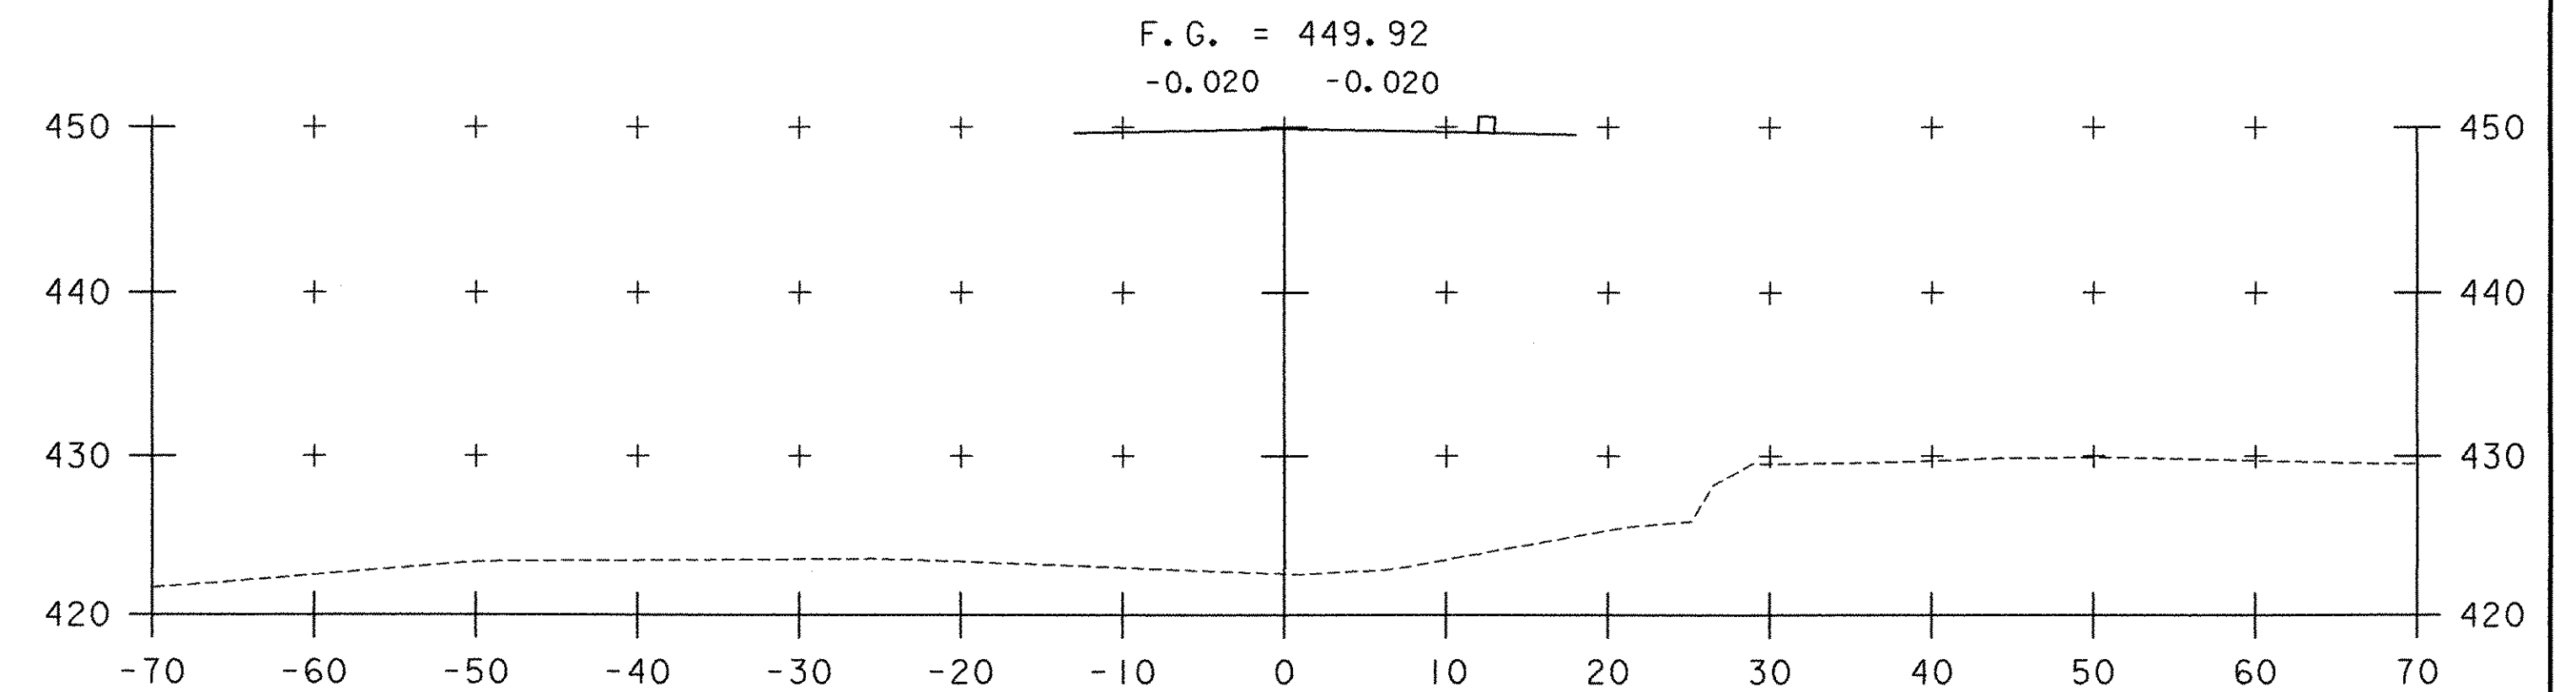

104+75

STA. 104+00 TO STA. 105+25



PROJECT NAME:	RICHFORD
PROJECT NUMBER:	BHF 0302 (3) S
FILE NAME:	...Structures\Design\Rich-xsl.dwg
PROJECT LEADER:	MJC
DESIGNED BY:	SEB
DETOUR CROSS SECTIONS - 2	
PRINT DATE:	12/18/2007
DRAWN BY:	
CHECKED BY:	MJC
SHEET	40 OF 41