




106+25

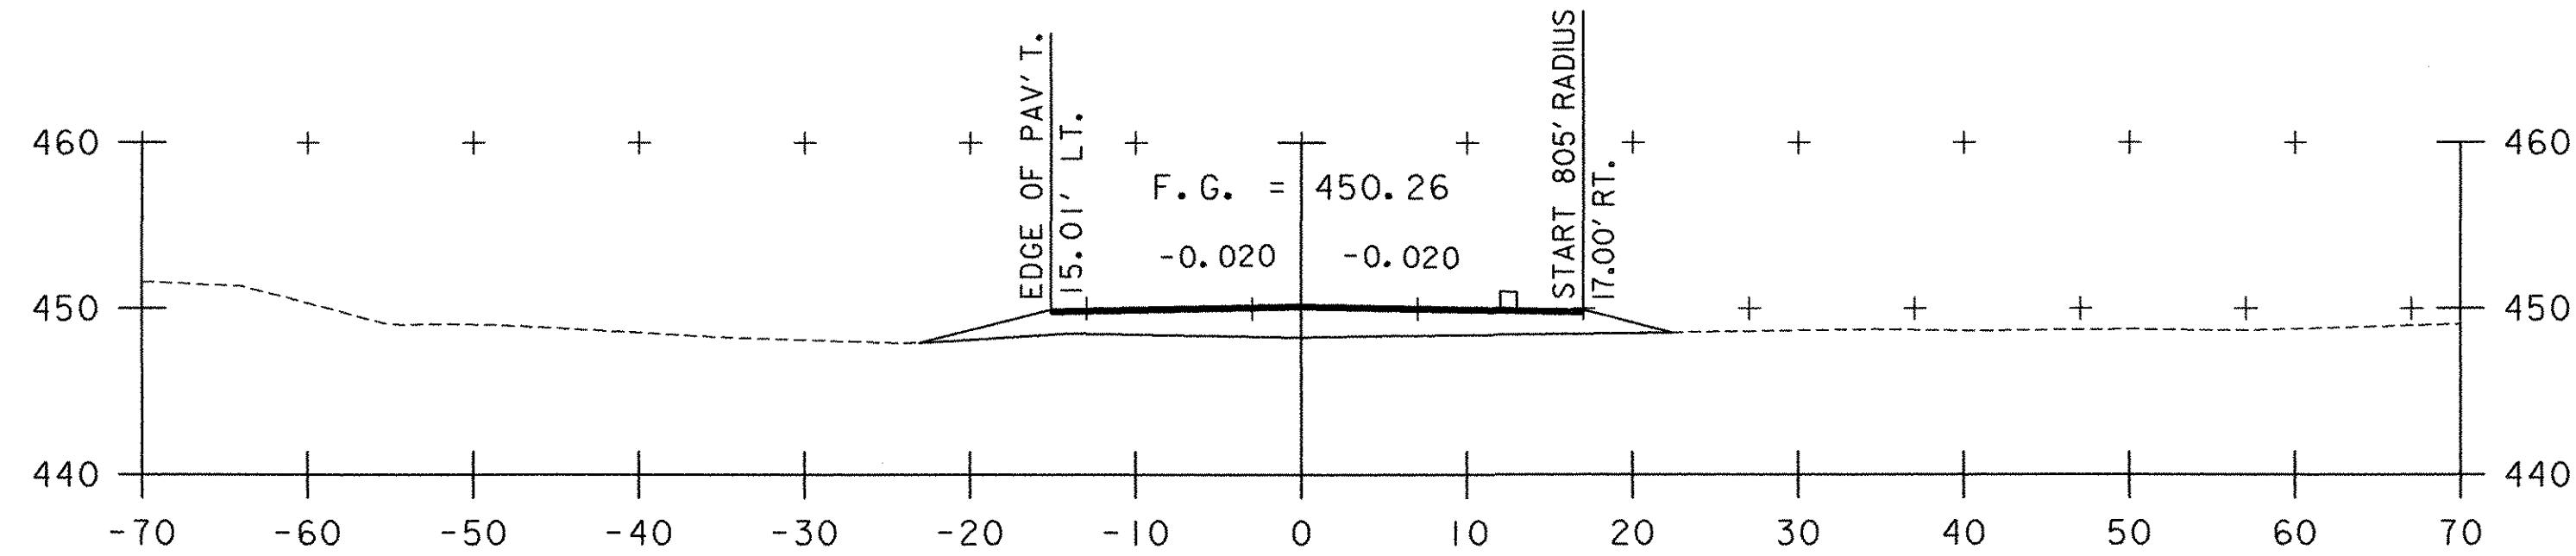


106+00

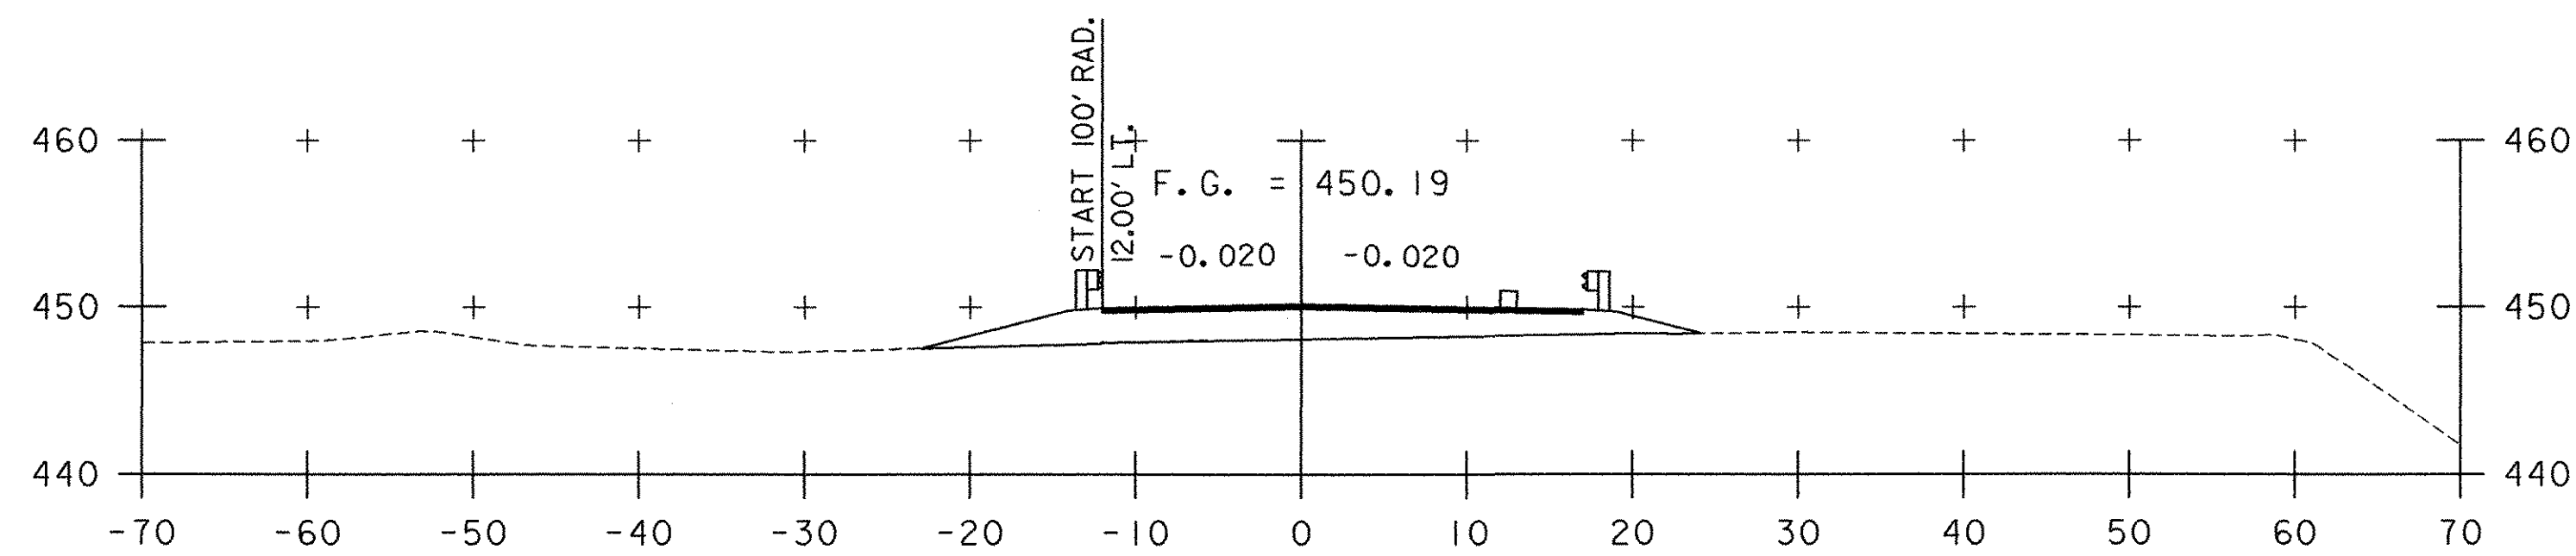


105+75

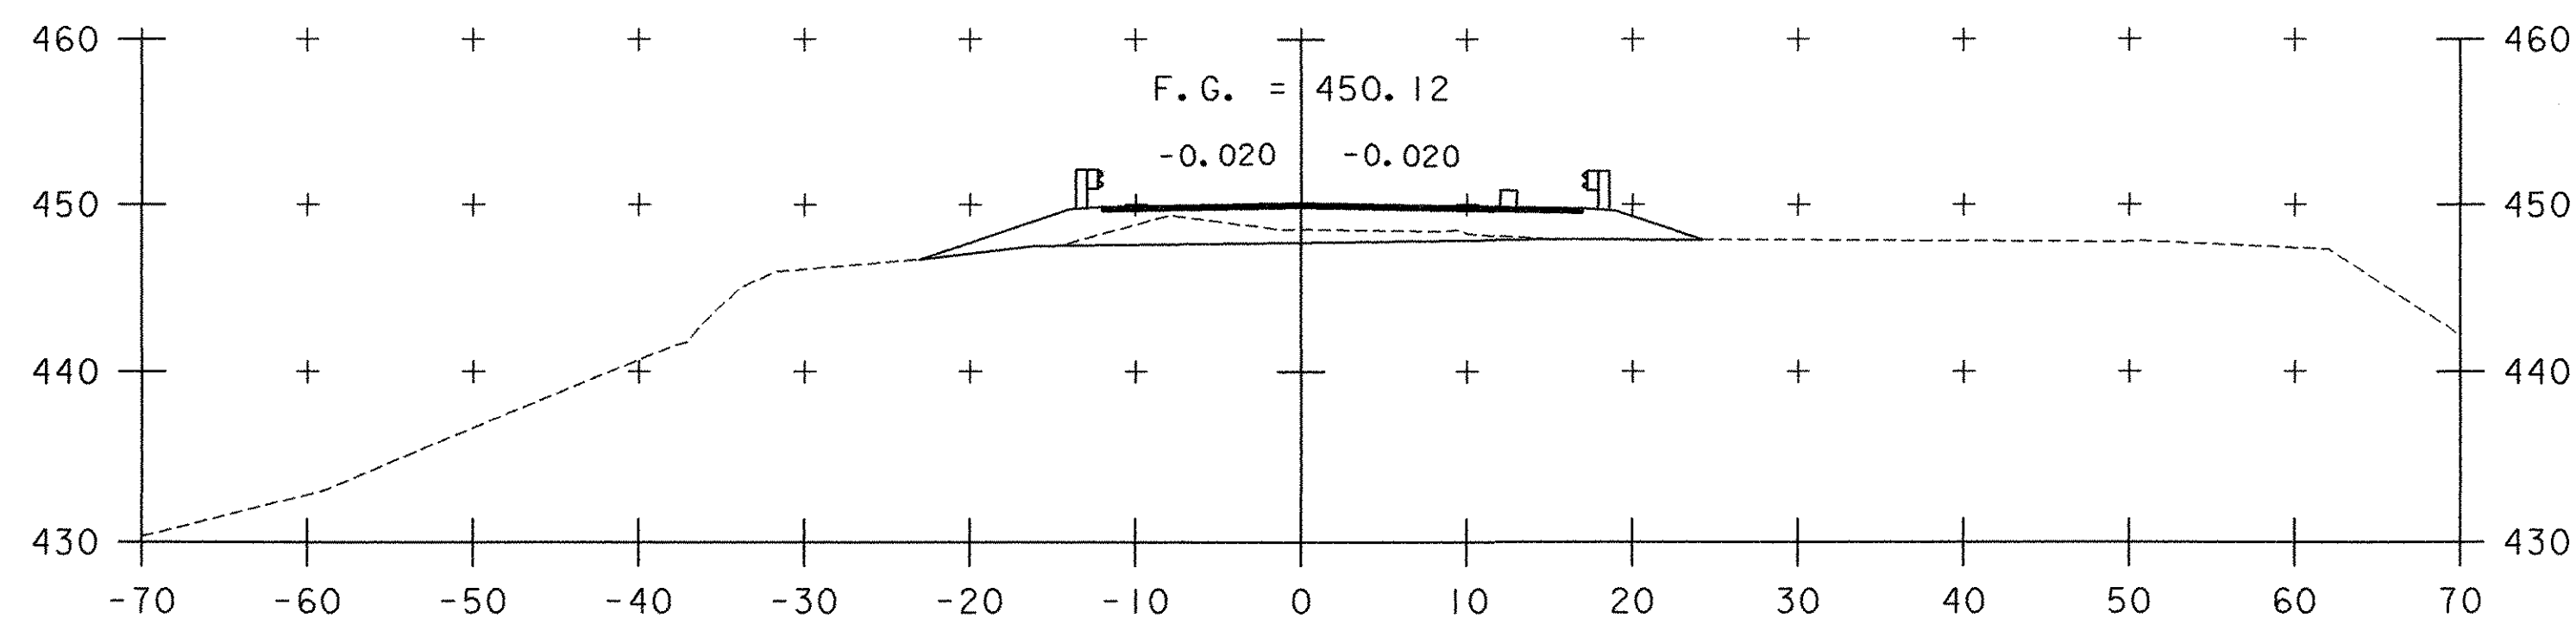


105+50

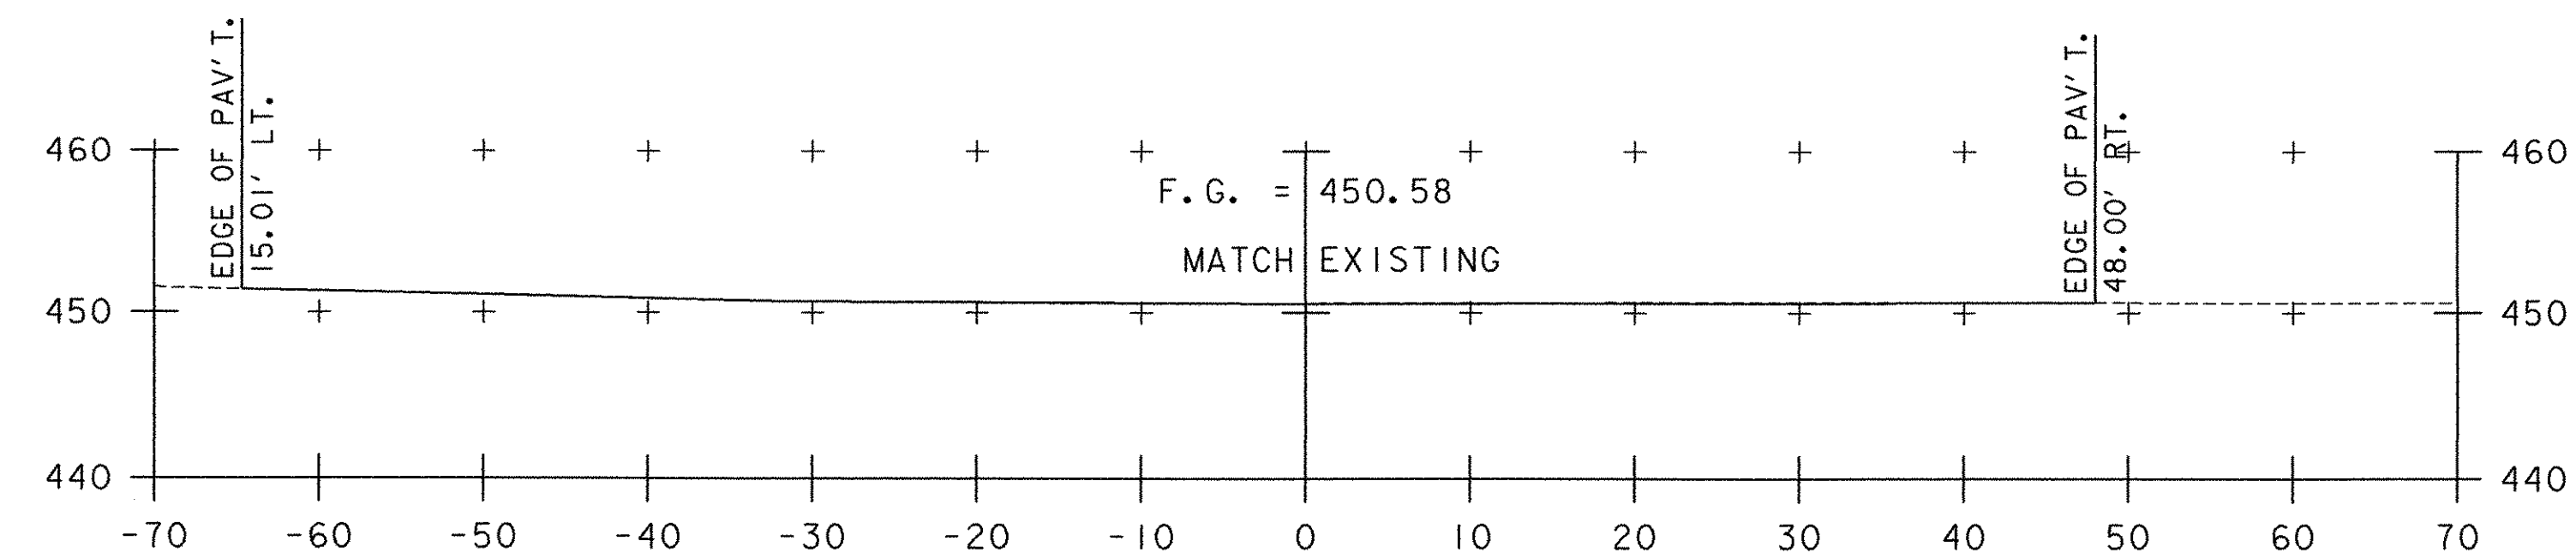


107+18.49

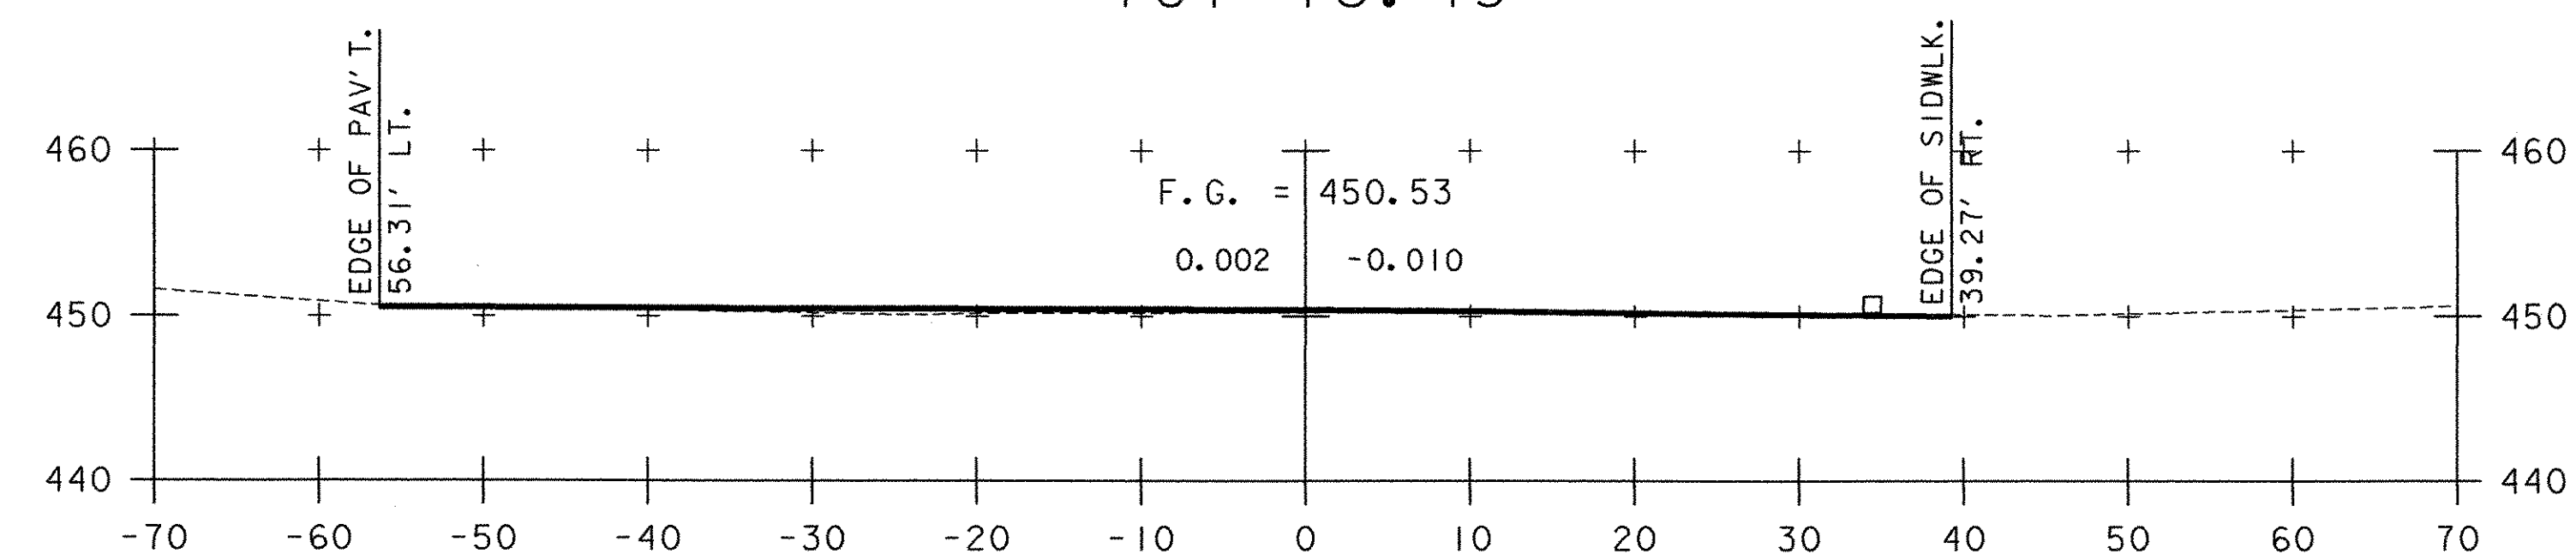

107+00

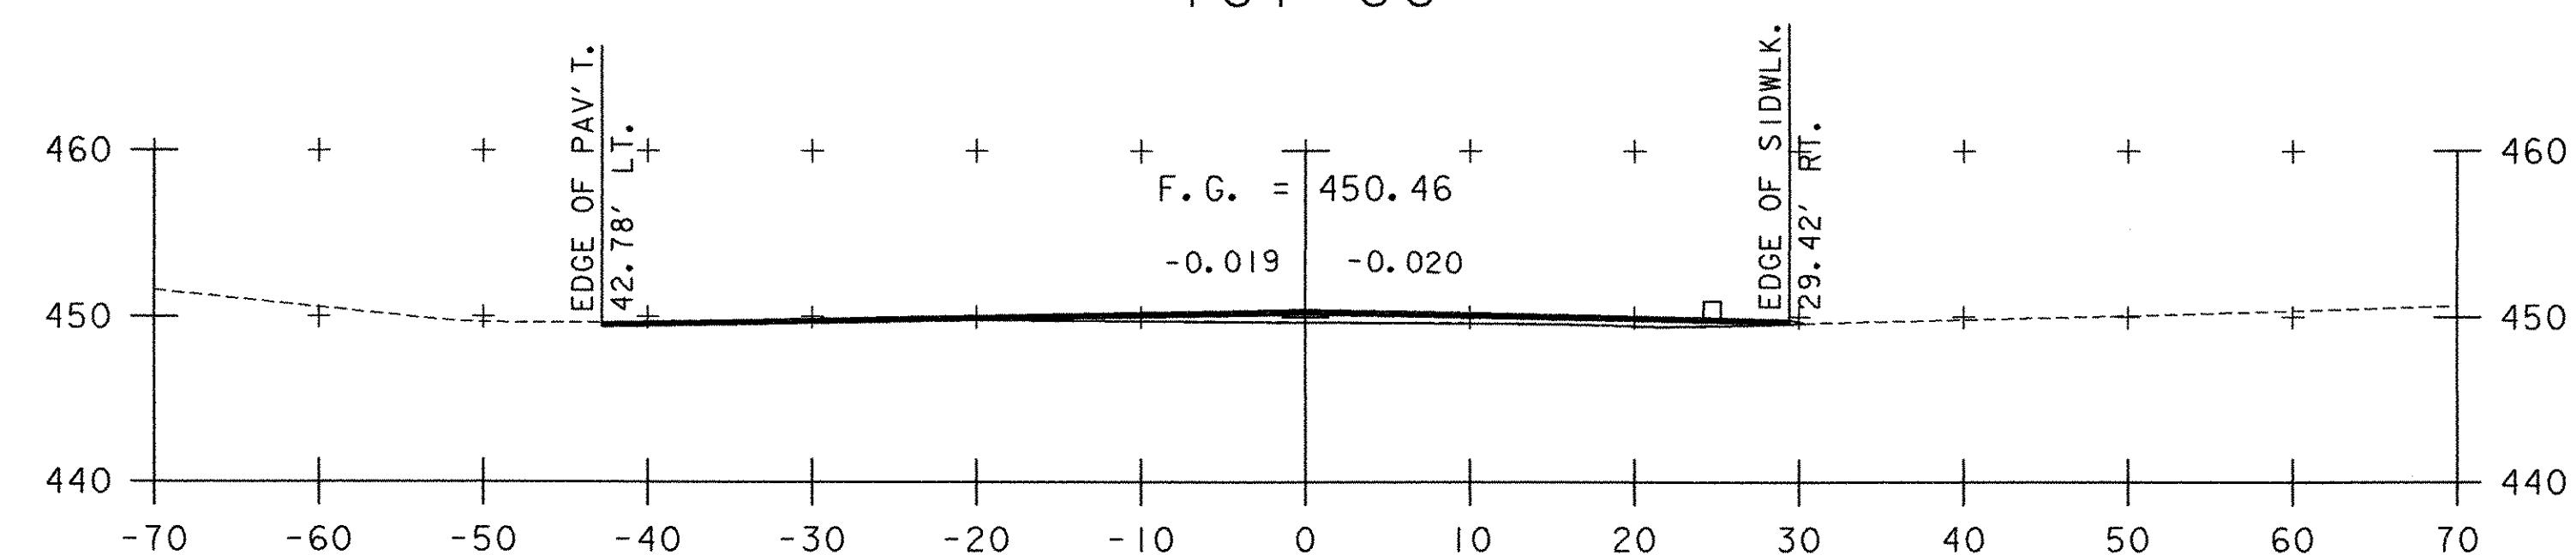

106+75

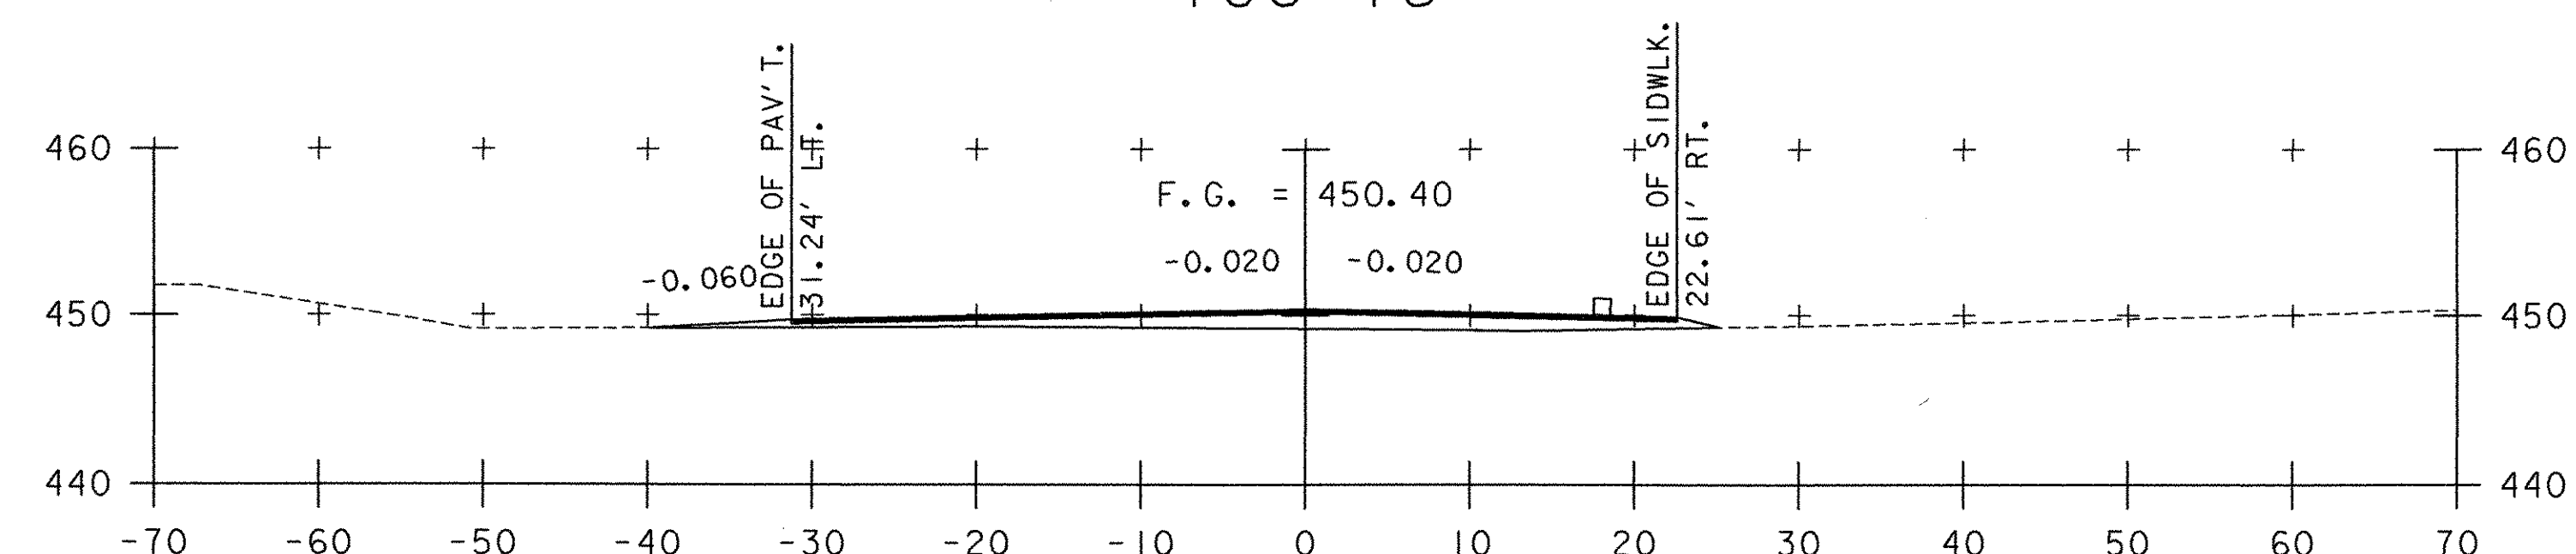

106+50



PROJECT NAME: RICHFORD
 PROJECT NUMBER: BHF 0302 (3) S
 FILE NAME: ...\Structures\Design\Rich-xsl.dwg
 PROJECT LEADER: MJC
 DESIGNED BY: SEB
 DRAWN BY:
 CHECKED BY: MJC
 DETOUR CROSS SECTIONS - 3
 SHEET 41 OF 41

STA. 105+50 TO STA. 107+18.49