


STATE OF VERMONT AGENCY OF TRANSPORTATION



PROPOSED IMPROVEMENT BRIDGE PROJECT TOWN OF RICHFORD COUNTY OF FRANKLIN BRIDGE NO. 41 ON TOWN HIGHWAY NO. 2

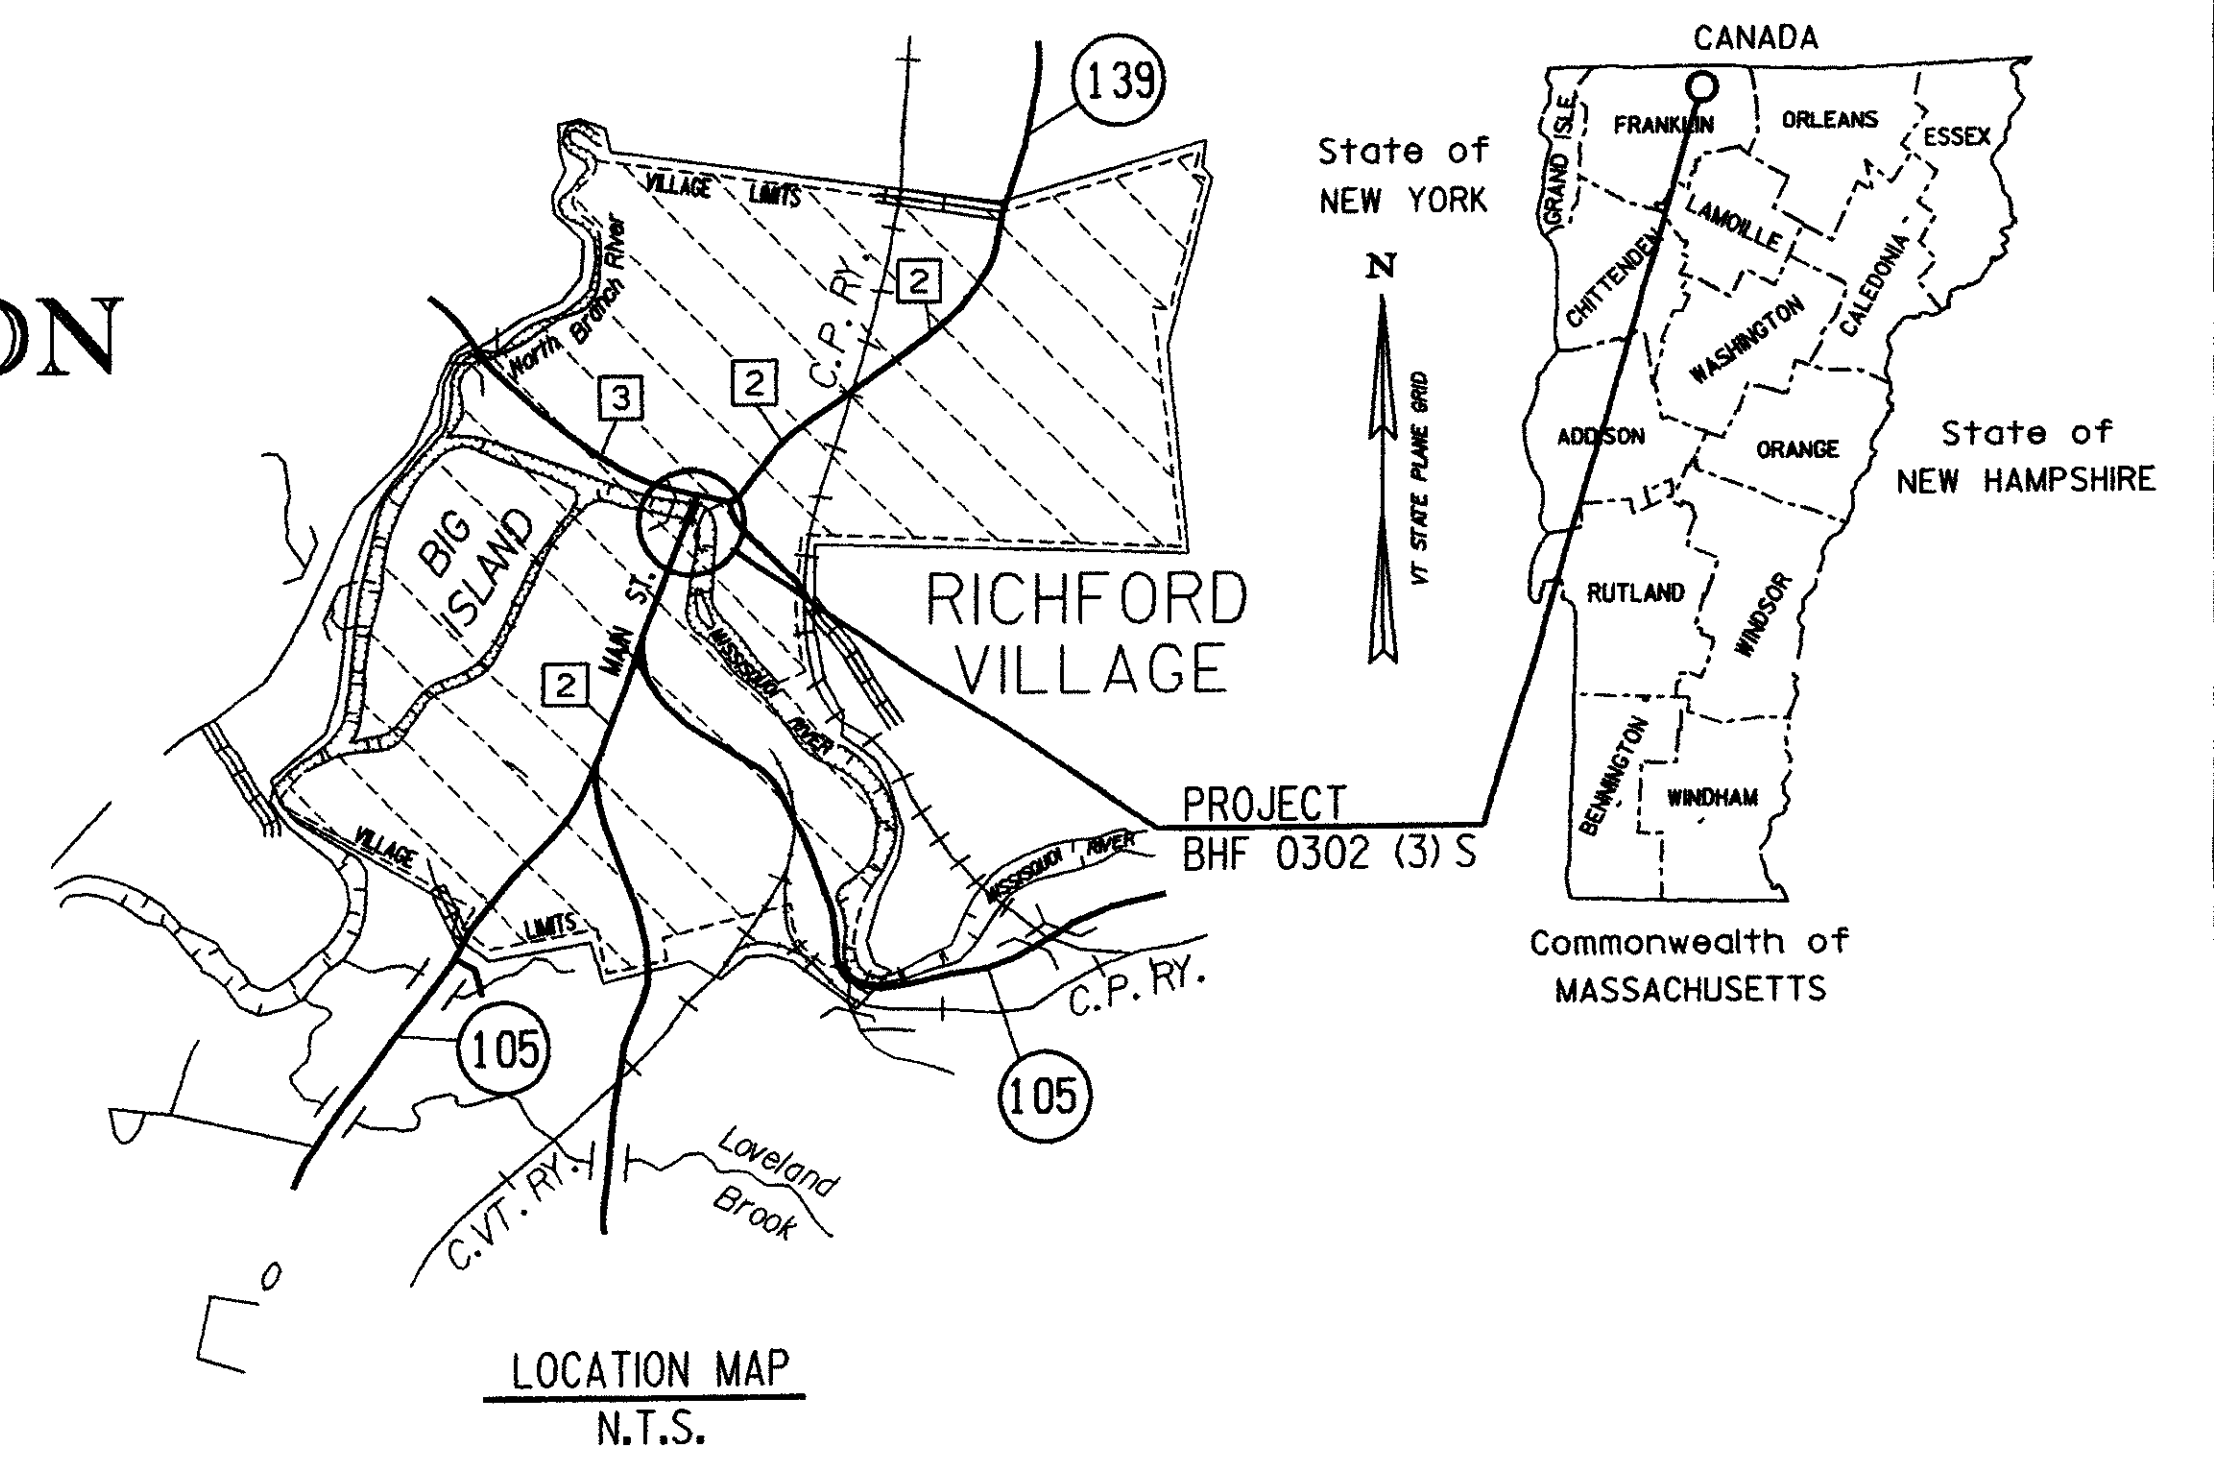

**SEE SHEET 2 FOR THE
INDEX OF SHEETS AND
THE LIST OF STANDARDS**


PROJECT LOCATION: MAIN STREET, APPROXIMATELY 0.25 MILES NORTH OF THE INTERSECTION OF VERMONT ROUTE 105 AND MAIN STREET (T.H. 2) IN THE VILLAGE OF RICHFORD.

PROJECT DESCRIPTION: THIS PROJECT INVOLVES THE REMOVAL OF THE EXISTING BRIDGE DECK, REMOVAL OF EXISTING STEEL MEMBERS, REPAIR OF THE EXISTING STEEL FRAMING, MINOR REPAIR OF EXISTING ABUTMENTS, NEW STEEL FRAMING, CONSTRUCTION OF A NEW BRIDGE DECK, PAINTING THE EXISTING STEEL SUPERSTRUCTURE, MINOR APPROACH RECONSTRUCTION AND CONSTRUCTION OF A TEMPORARY BRIDGE AND DETOUR.
 LENGTH OF STRUCTURE: 129.84 FEET (0.024 MILES)
 LENGTH OF ROADWAY: 51.50 FEET (0.010 MILES)
 LENGTH OF PROJECT: 181.34 FEET (0.034 MILES)


RECORD PLANS	
CONTRACTOR	BLOW & COTE - MORRISVILLE, VT
RESIDENT ENGINEER	CARL GLEASON
CONSTRUCTION BEGAN	MARCH 7, 2008
CONSTRUCTION COMPLETE	MAY 5, 2009
RECORD PLANS BY	CARL GLEASON
I HEREBY CERTIFY THAT ALL THE CONSTRUCTION REQUIRED BY THIS SET OF DRAWINGS HAS BEEN ACCOMPLISHED AS INDICATED HEREIN	
BY	<i>Carl Gleason</i> RESIDENT ENGINEER
DATE	6/14/10
NOTE: Any further information concerning final quantities, amounts or other details relative to this project may be found at Central Files in the electronic archives	

CONVENTIONAL SYMBOLS	
COUNTY LINE	
TOWN LINE	
LIMITS OF ACCESS	
POINT OF ACCESS	
FENCE LINE	
STONE WALL	
TRAVELED WAY	
GUARD RAIL	
RAILROAD	
SURVEY LINE	
CULVERT	
POWER POLE	
TELEPHONE POLE	
TREES	
CONTROL OF ACCESS	
PROPERTY LINE	
R.O.W. TAKING LINE	
SLOPE RIGHTS	
TOP OF CUT	
TOE OF SLOPE	

SURVEYED BY: VTRANS
 SURVEYED DATE: JUNE 2007
 DATUM
 VERTICAL NGVD 1988
 HORIZONTAL MAGNETIC 1999

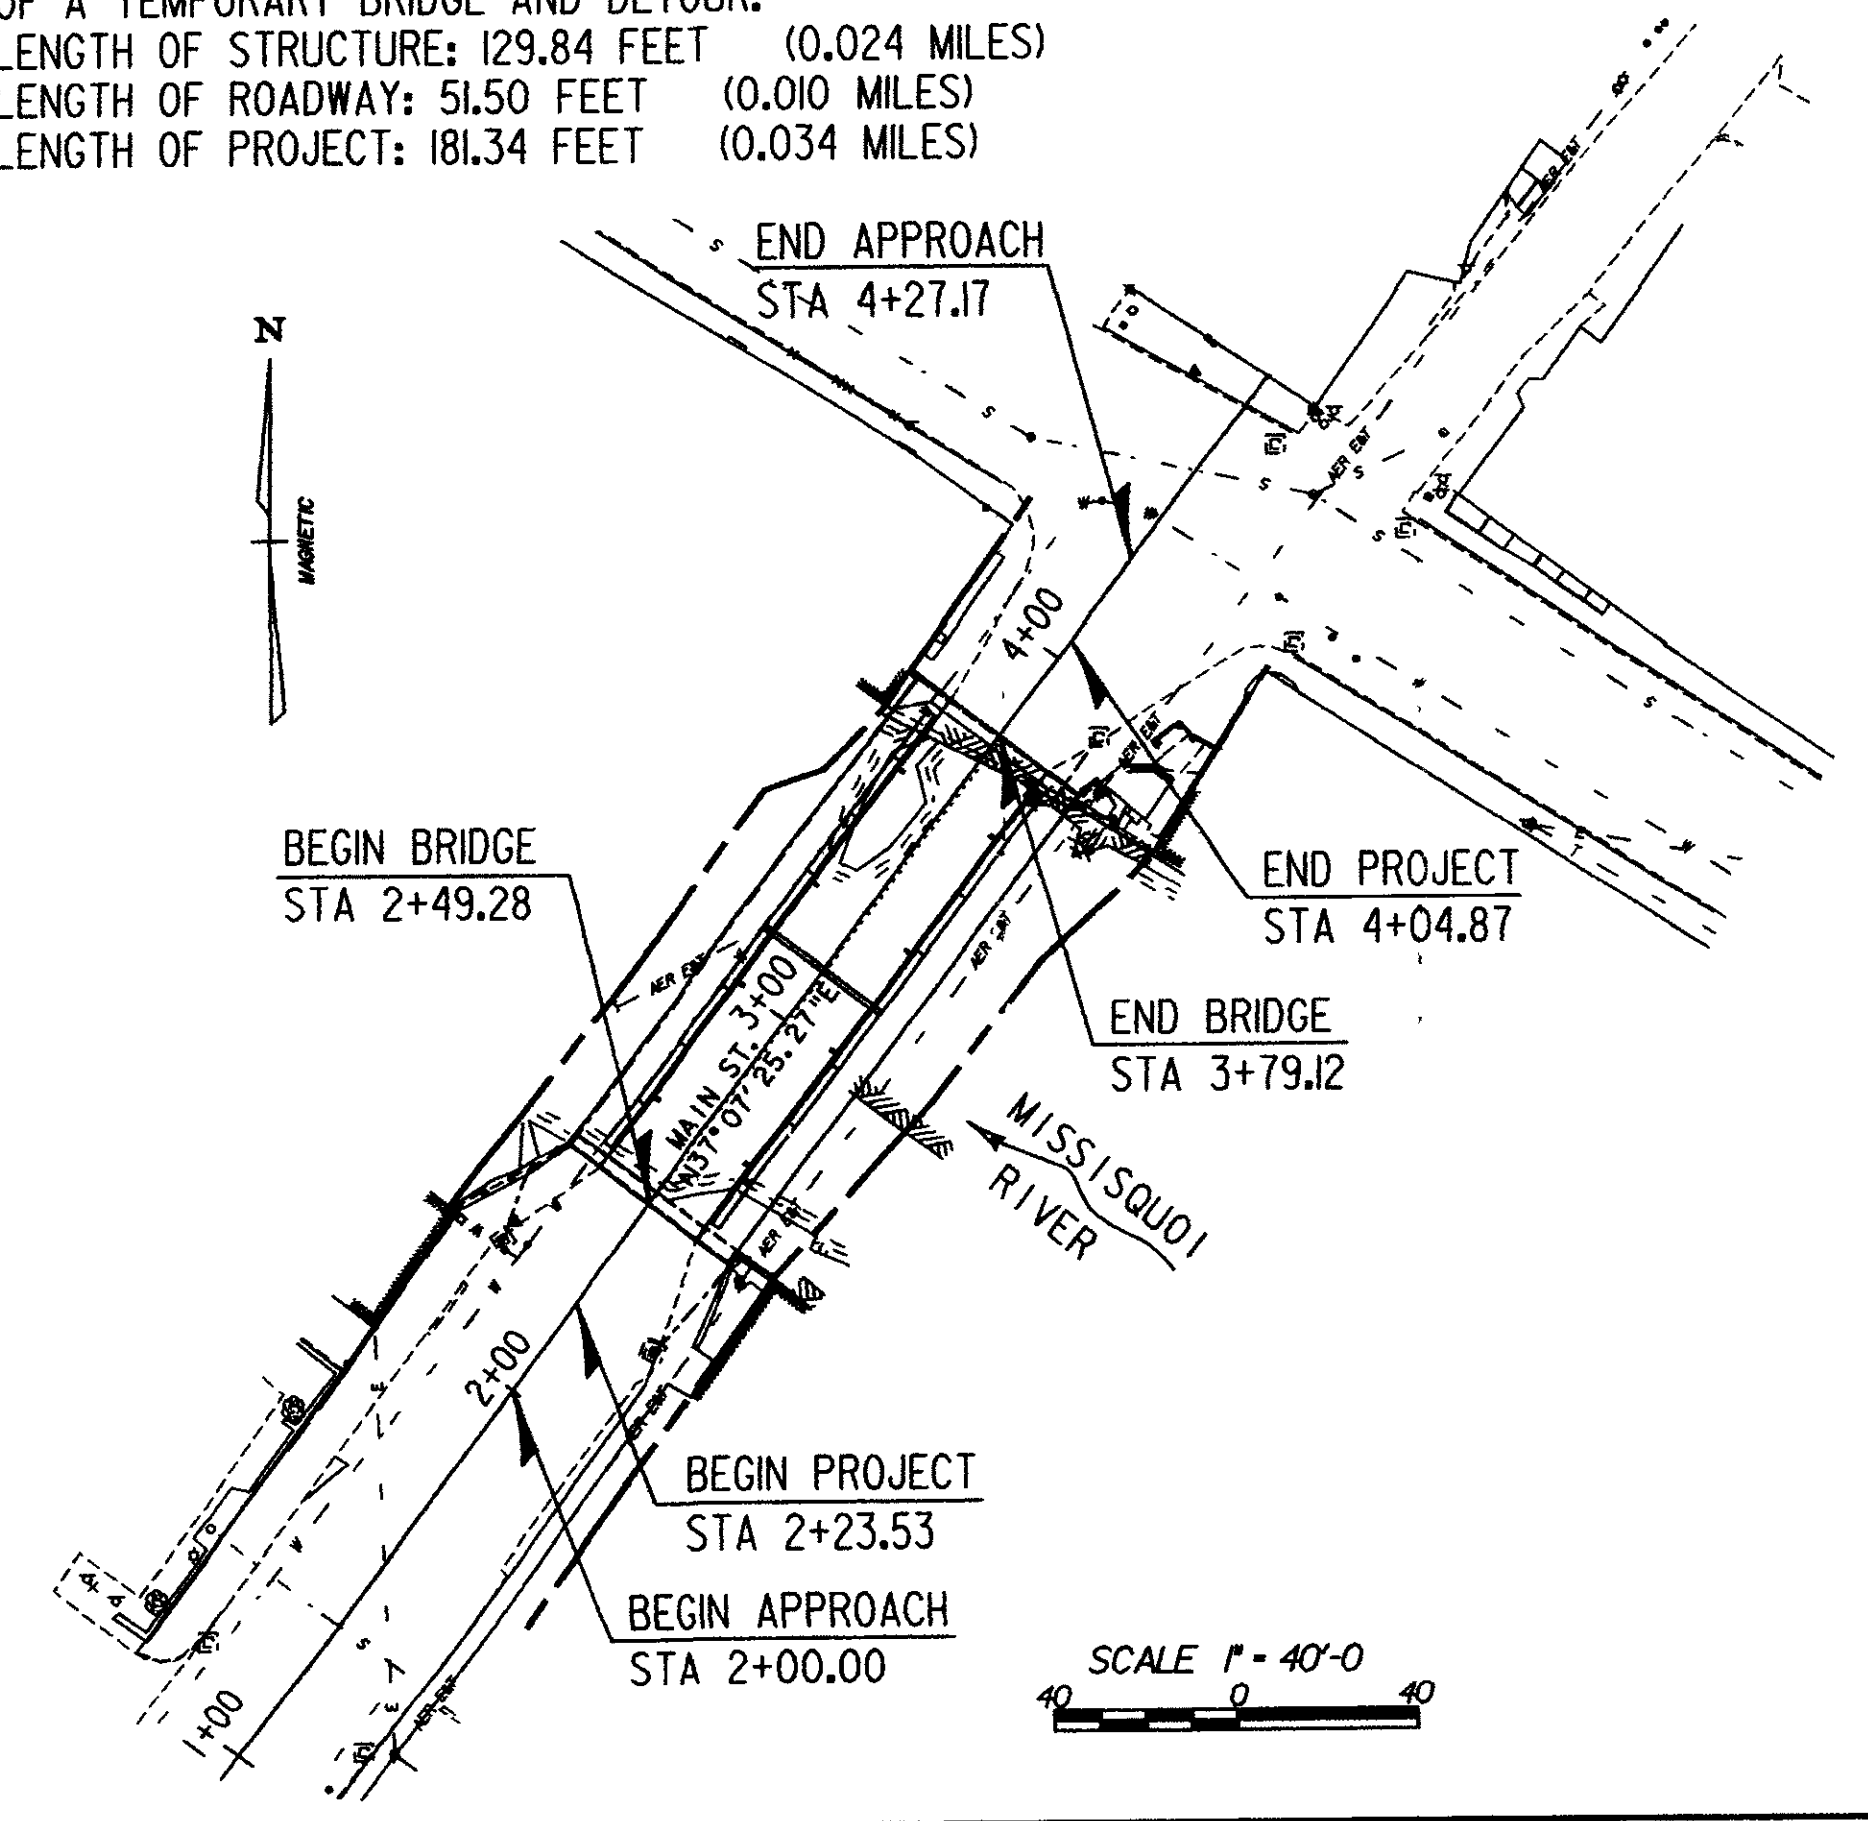

THESE PLANS ARE SUBJECT TO SUCH ENGINEERING CHANGES AS MAY BE REQUIRED BY THE FEDERAL HIGHWAY ADMINISTRATION OR THE DIRECTOR OF PROJECT DEVELOPMENT.
 CONSTRUCTION IS TO BE CARRIED ON IN ACCORDANCE WITH THESE PLANS AND THE STANDARD SPECIFICATIONS FOR CONSTRUCTION DATED 2006, AS APPROVED BY THE FEDERAL HIGHWAY ADMINISTRATION ON JUNE 15, 2006 FOR USE ON THIS PROJECT, INCLUDING ALL SUBSEQUENT REVISIONS AND SUCH REVISED SPECIFICATIONS AND SPECIAL PROVISIONS AS ARE INCORPORATED IN THESE PLANS.

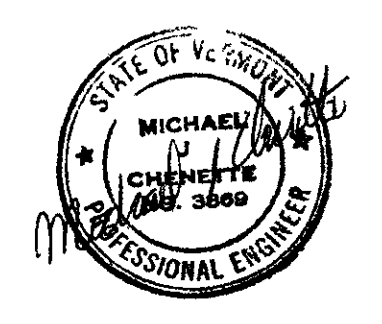

DIRECTOR OF PROGRAM DEVELOPMENT	
APPROVED <i>Warren Tripp</i>	DATE 12/16/11
PROJECT MANAGER: WARREN TRIPP	
PROJECT NAME: RICHFORD	
PROJECT NUMBER: BHF 0302 (3) S	
SHEET 1 OF 41 SHEETS	

INDEX OF SHEETS

1. TITLE SHEET
2. PRELIMINARY INFORMATION SHEET
3. TYPICAL BRIDGE SECTIONS
4. TYPICAL ROADWAY SECTIONS
- 5.-6. QUANTITY SHEETS
7. TIE SHEET
8. SITE PLAN AND ELEVATION
9. EPSC NARRATIVE
10. EPSC EXISTING CONDITIONS SITE PLAN
11. EPSC CONSTRUCTION SITE PLAN
12. EPSC FINAL CONDITIONS SITE PLAN
- 13.-15. EPSC DETAIL SHEETS
16. TRAFFIC CONTROL PLAN
17. BRIDGE AND DETOUR PROFILE
18. SIDEWALK MODIFICATIONS
19. TEMPORARY TRAFFIC SIGNAL PLAN
20. DETOUR SIGN SHEET
21. PROJECT NOTES
22. FRAMING PLAN
- 23.-24. STEEL DETAIL SHEETS
25. TYPICAL DECK SECTION & DETAILS
26. DECK REINFORCING PLAN
27. SCUPPER AND MISC. DETAILS
28. EXPANSION JOINT PLAN
29. EXPANSION JOINT DETAILS
30. DOWNSPOUT DETAILS
31. ABUTMENT NO. 1 PLAN & ELEVATION
32. ABUTMENT NO. 2 PLAN & ELEVATION
33. ABUTMENT SECTIONS
34. BRIDGE RAIL DETAILS
35. RAILING REPLACEMENT DETAILS
36. PAVEMENT MARKINGS PLAN
37. REINFORCING SCHEDULE
38. ROADWAY CROSS SECTIONS
- 39.-41. DETOUR CROSS SECTIONS

VAOT STANDARDS

C-1	01/03/00
C-2A	10/14/05
D-8	01/03/00
D-9	06/01/94
D-15	06/01/94
E-100	01/02/04
E-100A	01/02/04
E-101	05/30/03
E-102	06/30/03
E-102A	05/01/04
E-106	03/01/04
E-107	06/30/03
E-107A	08/08/95
E-121	08/08/95
E-140	08/30/96
E-142	09/20/95
E-170	11/04/99
E-171A	08/09/95
E-171B	08/09/95
E-171C	08/09/95
E-172	08/09/95
E-175	11/17/93
E-191	02/01/99
E-192	10/12/00
E-193	08/18/95
G-1b	06/01/94
SB-R6-82	01/06/95

FINAL HYDRAULICS REPORT

HYDROLOGIC DATA

DRAINAGE AREA= 393.4 square miles
 CHARACTER OF TERRAIN: _____
 CHARACTER & TYPE OF STREAM: _____
 NATURE OF STREAMBED: _____
 Q2.33= 8,300 cfs Q50= 18,000 cfs
 Q10= 13,300 cfs Q100= 20,000 cfs
 Q25= 15,600 cfs Q500= 25,500 cfs
 DATE OF FLOOD OF RECORD: _____
 WATER SURFACE ELEV.: _____ ESTIMATED DISCHARGE: _____
 NATURAL STREAM VELOCITY @ Q25 = _____
 ICE CONDITIONS: _____ DEBRIS: _____
 DOES THE STREAM REACH MAXIMUM HIGHWATER ELEVATION RAPIDLY? _____
 IS ORDINARY RISE RAPID? _____
 IS STAGE AFFECTED BY UPSTREAM OR DOWNSTREAM CONDITIONS? _____
 IF YES, DESCRIBE: _____
 WATERSHED STORAGE _____ HEADWATERS _____ UNIFORM THROUGHOUT WATERSHED _____
 IMMEDIATELY ABOVE SITE _____

EXISTING STRUCTURE


STRUCTURE TYPE: STEEL PONY TRUSS BRIDGE
 YEAR BUILT: 1934
 CLEAR SPAN (NORMAL TO STREAM): 119 feet
 VERTICAL CLEARANCE ABOVE STREAMBED: _____
 WATERWAY OF FULL OPENING: _____
 DISPOSITION OF STRUCTURE: Rehabilitation
 TYPE OF MATERIAL UNDER SUBSTRUCTURE: Ledge
 WATER SURFACE ELEV. @ Q2.33= 435.5 ft VELOCITY= _____
 Q10= 442.6 ft " _____
 Q25= 444.0 ft " _____
 Q50= 445.4 ft " _____
 Q100= 446.6 ft " _____
 LONG TERM STREAM BED CHANGES: _____
 IS THE ROADWAY OVERTOPPED BELOW THE Q100? _____ FREQUENCY: _____
 RELIEF ELEVATION: _____ DISCHARGE OVER ROAD @ Q100: _____
 UPSTREAM STRUCTURE: TOWN: _____ DISTANCE: _____
 HIGHWAY NO.: _____ STRUCTURE NO.: _____
 STRUCTURE TYPE: _____
 CLEAR SPAN: _____ CLEAR HEIGHT: _____
 YEAR BUILT: _____ FULL WATERWAY: _____
 DOWNSTREAM STRUCTURE: TOWN: _____ DISTANCE: _____
 HIGHWAY NO.: _____ STRUCTURE NO.: _____
 STRUCTURE TYPE: _____
 CLEAR SPAN: _____ CLEAR HEIGHT: _____
 YEAR BUILT: _____ FULL WATERWAY: _____

PROPOSED STRUCTURE

STRUCTURE TYPE: N/A
 CLEAR SPAN (NORMAL TO STREAM): _____
 VERTICAL CLEARANCE ABOVE STREAMBED: _____
 WATERWAY OF FULL OPENING: _____
 WATER SURFACE ELEV. @ Q2.33= _____ VELOCITY= _____
 Q10= _____ " _____
 Q25= _____ " _____
 Q50= _____ " _____
 Q100= _____ " _____
 IS THE ROADWAY OVERTOPPED BELOW THE Q100? _____ FREQUENCY: _____
 RELIEF ELEVATION: _____ DISCHARGE OVER ROAD @ Q100: _____
 AVERAGE LOW ELEVATION OF SUPERSTRUCTURE: _____
 VERTICAL CLEARANCE: _____
 SCOUR: _____
 REQUIRED CHANNEL PROTECTION: _____

PERMIT INFORMATION

AVERAGE DAILY FLOW: 800 cfs
 ORDINARY LOW WATER: 350 cfs DEPTH: EL. 427'
 ORDINARY HIGH WATER: 3,600 cfs DEPTH: EL. 431'

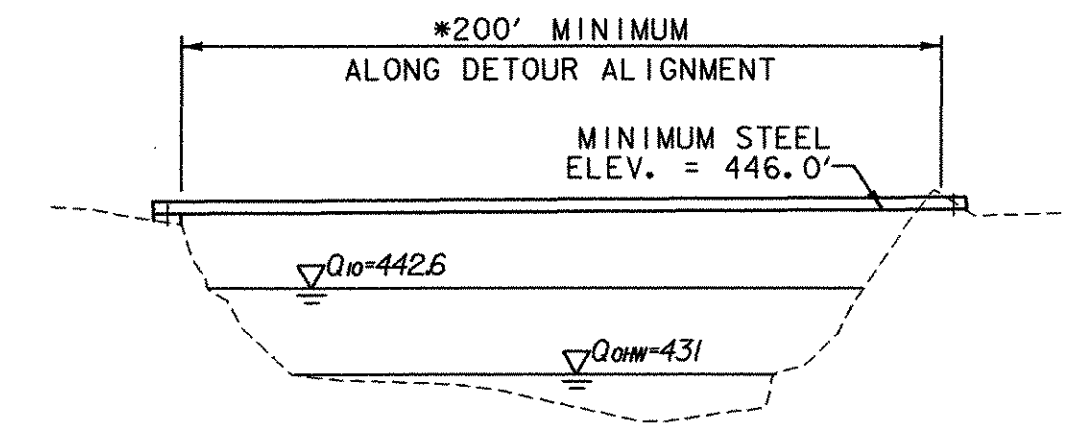

* - CONTRACTOR SHALL HAVE THE OPTION OF CONSTRUCTING A SINGLE SPAN OR TWO SPAN TEMPORARY BRIDGE. MAXIMUM PIER WIDTH SHALL BE 3 FEET.

TEMPORARY BRIDGE REQUIREMENTS

NTS

DESIGN CRITERIA:

1. DESIGN LIVE LOAD AASHTO HS-20
2. DESIGN SPAN 125'
3. ALLOWABLE LOAD FOR SPREAD FOOTINGS ON SOIL _____ N/A ON LEDGE _____ N/A
4. ALLOWABLE LOAD FOR PILING _____ TYPE _____ ESTIMATED LENGTH _____
5. STRUCTURAL STEEL AASHTO GRADE SEE PROJECT GENERAL NOTES
6. REINFORCING STEEL GRADE 60
 CONCRETE, HIGH PERFORMANCE CLASS A f'_c : 4000 PSI f'_c = 1600 psi
 CONCRETE, HIGH PERFORMANCE CLASS B f'_c : 3500 PSI f'_c = 1400 psi

TRAFFIC MAINTENANCE:

1. IS TRAFFIC TO BE MAINTAINED? YES IF YES, ON EXISTING STRUCTURE NO OR ON TEMPORARY BRIDGE YES
2. TEMPORARY BRIDGE REQUIREMENTS: ONE OR TWO WAY TWO WAY TRAFFIC CONTROL SIGNALS REQUIRED YES
 MINIMUM CLEAR SPAN (NORMAL TO STREAM) 200 feet MINIMUM CLEAR HEIGHT SEE TEMPORARY BRIDGE SKETCH
 MINIMUM WATERWAY AREA _____
 ARE SIDEWALKS REQUIRED? YES IF SO, ON WHAT SIDE? UPSTREAM
 STRUCTURE TYPE _____

LOAD FACTOR LOAD RATING (TONS)

LOADING LEVELS (LOAD FACTOR)	TRUCK						
	H	HS	3S2	6 AXLE	3A. STR.	4A. STR.	5A. SEMI
INVENTORY A=2.17; B=1.00	35	39					
POSTED A=1.55; B=1.40	48	55	60		51	53	56
OPERATING A=1.30; B=1.67		66	72	79	61	63	

TRAFFIC DATA

YEAR	AADT	DHV	% D	% T	ADTT
2008	4900	550	52	2.1	220
2028	6000	680	52	3.2	410

TRUSS TOP CHORD OF BAY #2 & #7 ARE THE CONTROLLING MEMBER


$$\text{STRENGTH RF} = \frac{\phi M_N - 1.3 M_{DL}}{A \times M_{LL+I}}$$



Stantec


PROJECT NAME: RICHFORD
 PROJECT NUMBER: BHF 0302 (3) S

FILE NAME: ... Structures\Design\rich-pi.d\DOT DATE: 12/19/2007
 PROJECT LEADER: MJC DRAWN BY: JTS
 DESIGNED BY: SEB CHECKED BY: MJC
PRELIMINARY INFORMATION SHEET SHEET 2 OF 41

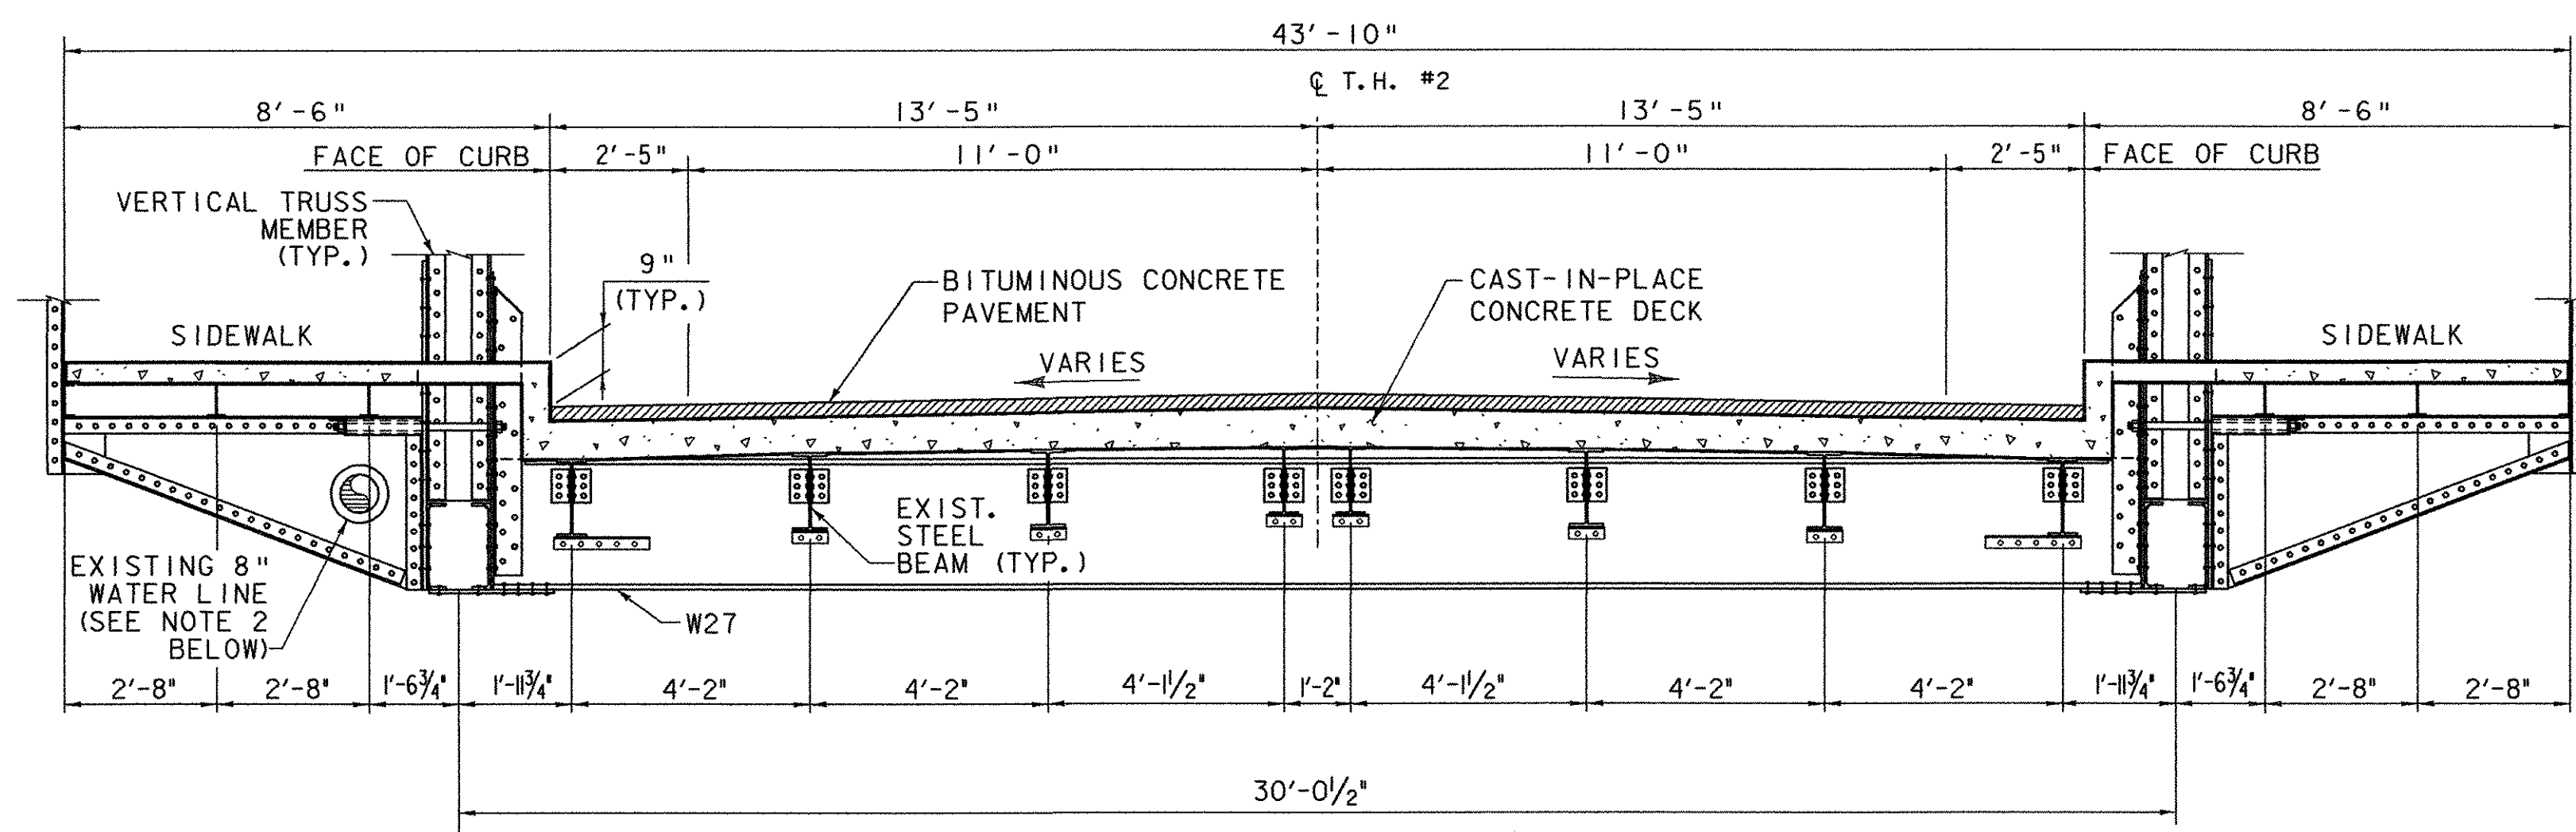


EXISTING BRIDGE TYPICAL SECTION

SCALE 3/8" = 1'-0"
 0 1 2 3 4

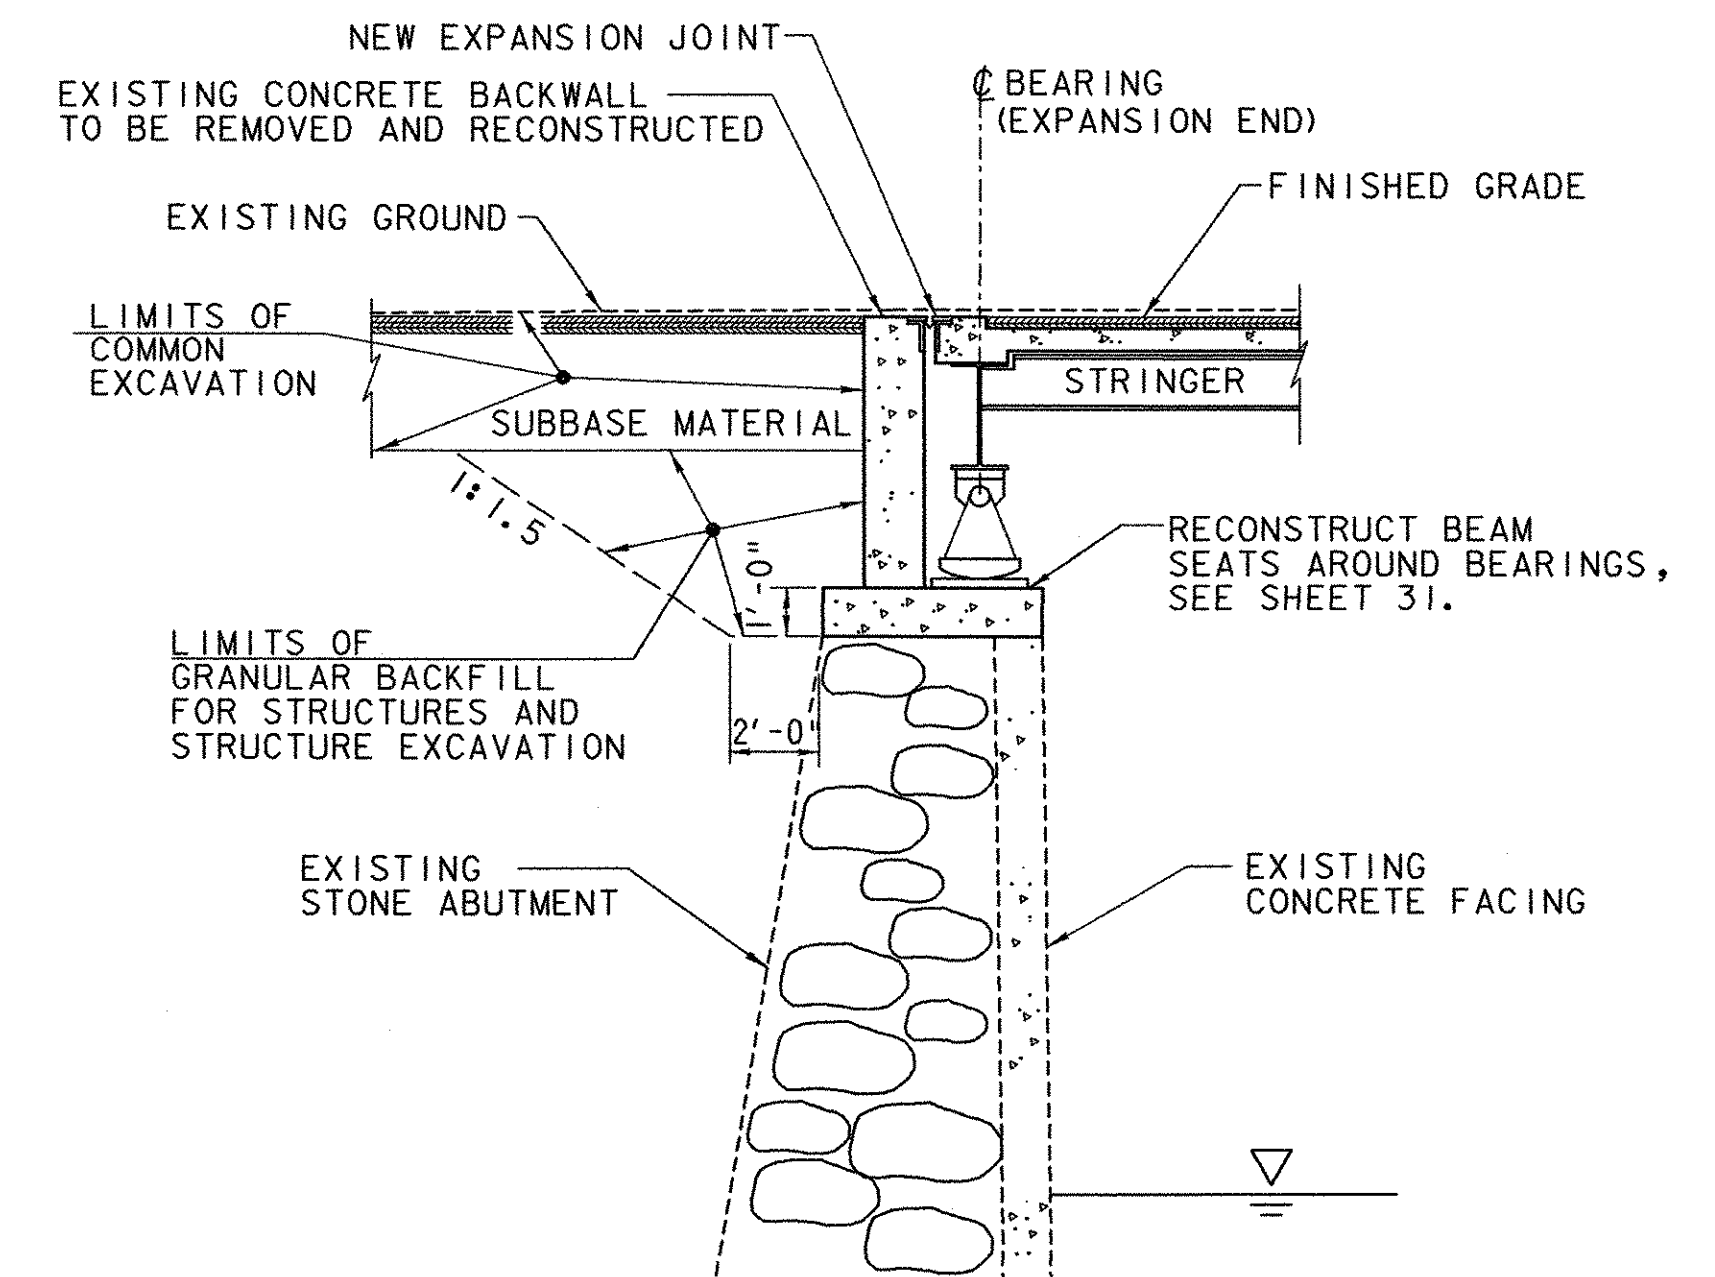


**ABUTMENT NO. 1
 EARTHWORK TYPICAL SECTION**

SCALE 1/4" = 1'-0"
 0 2 4 6

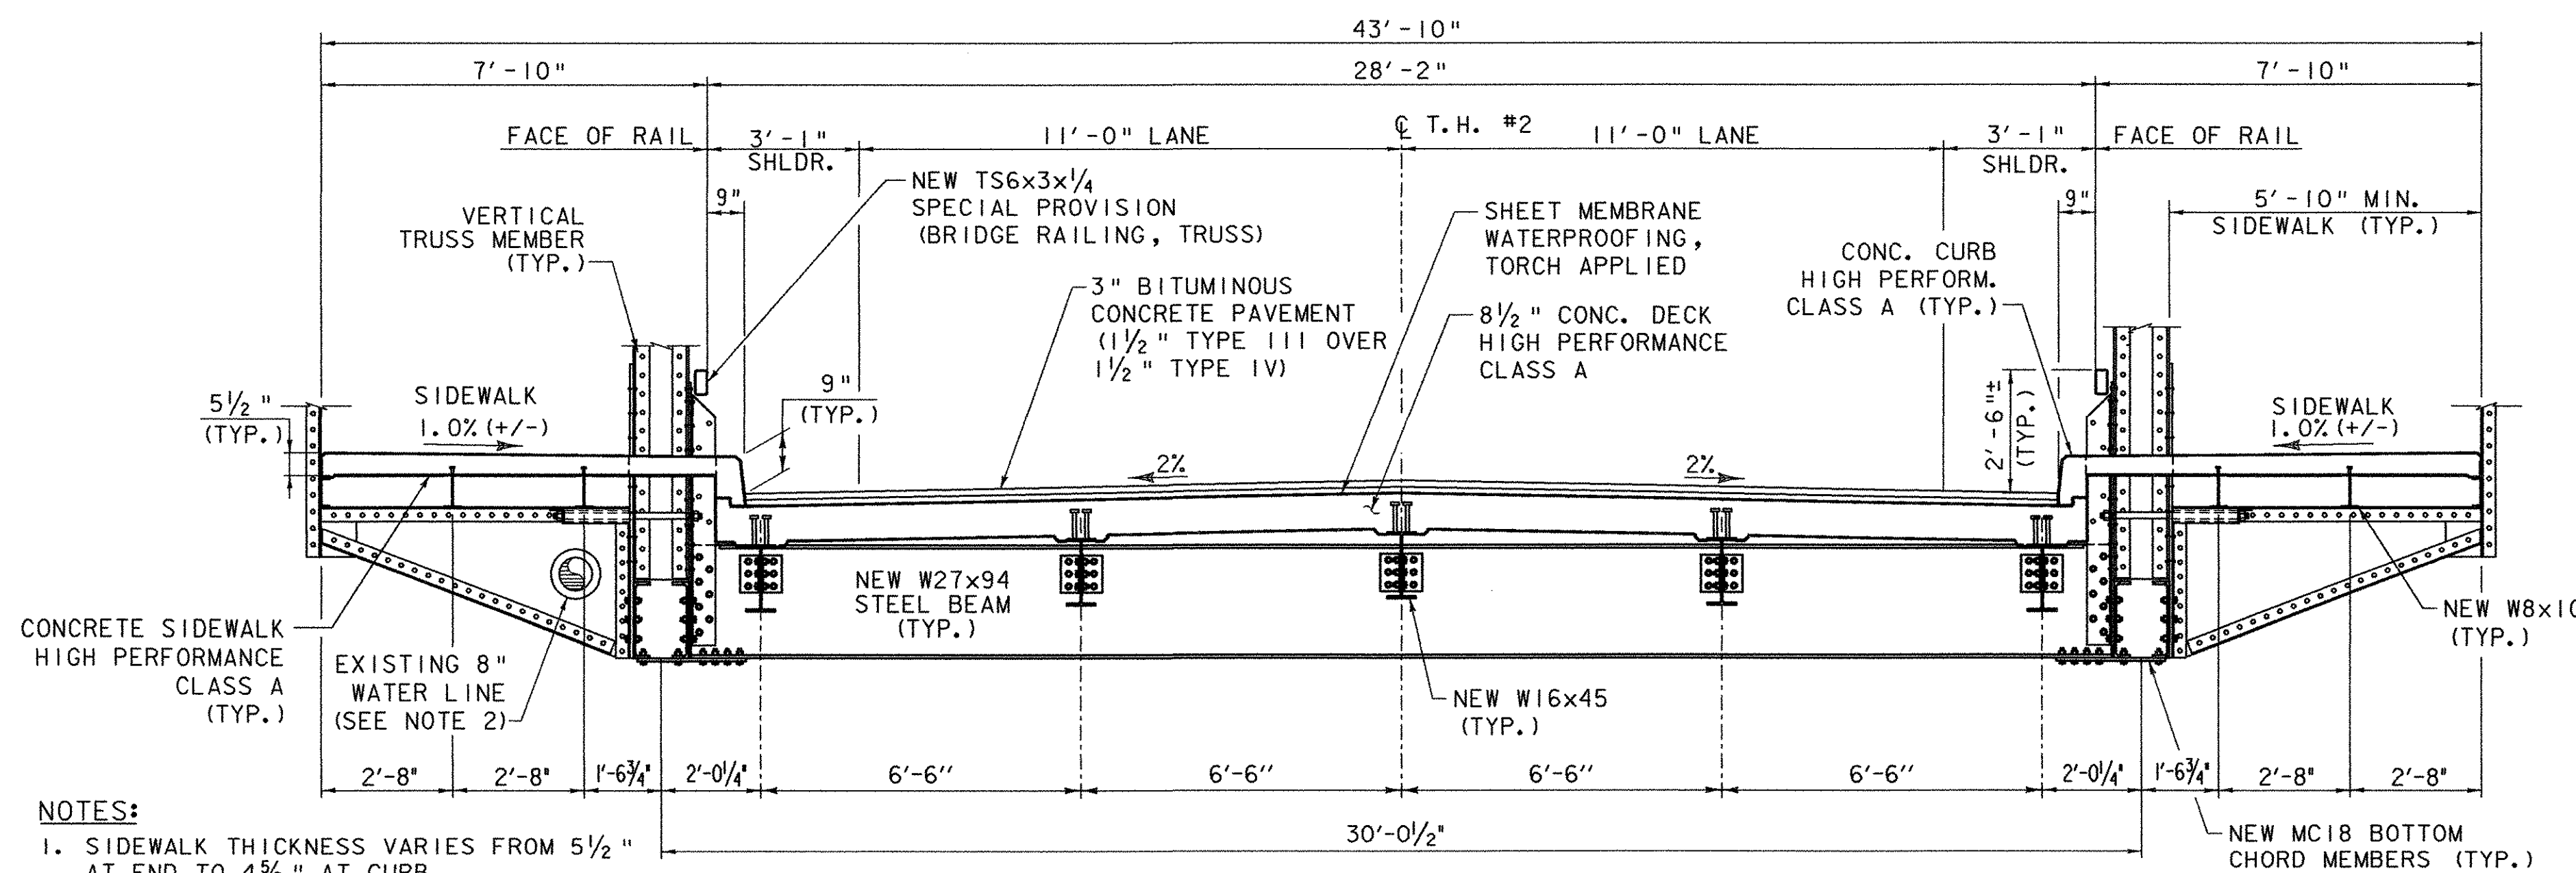

REHABILITATED BRIDGE TYPICAL SECTION

SCALE 3/8" = 1'-0"
 0 1 2 3 4

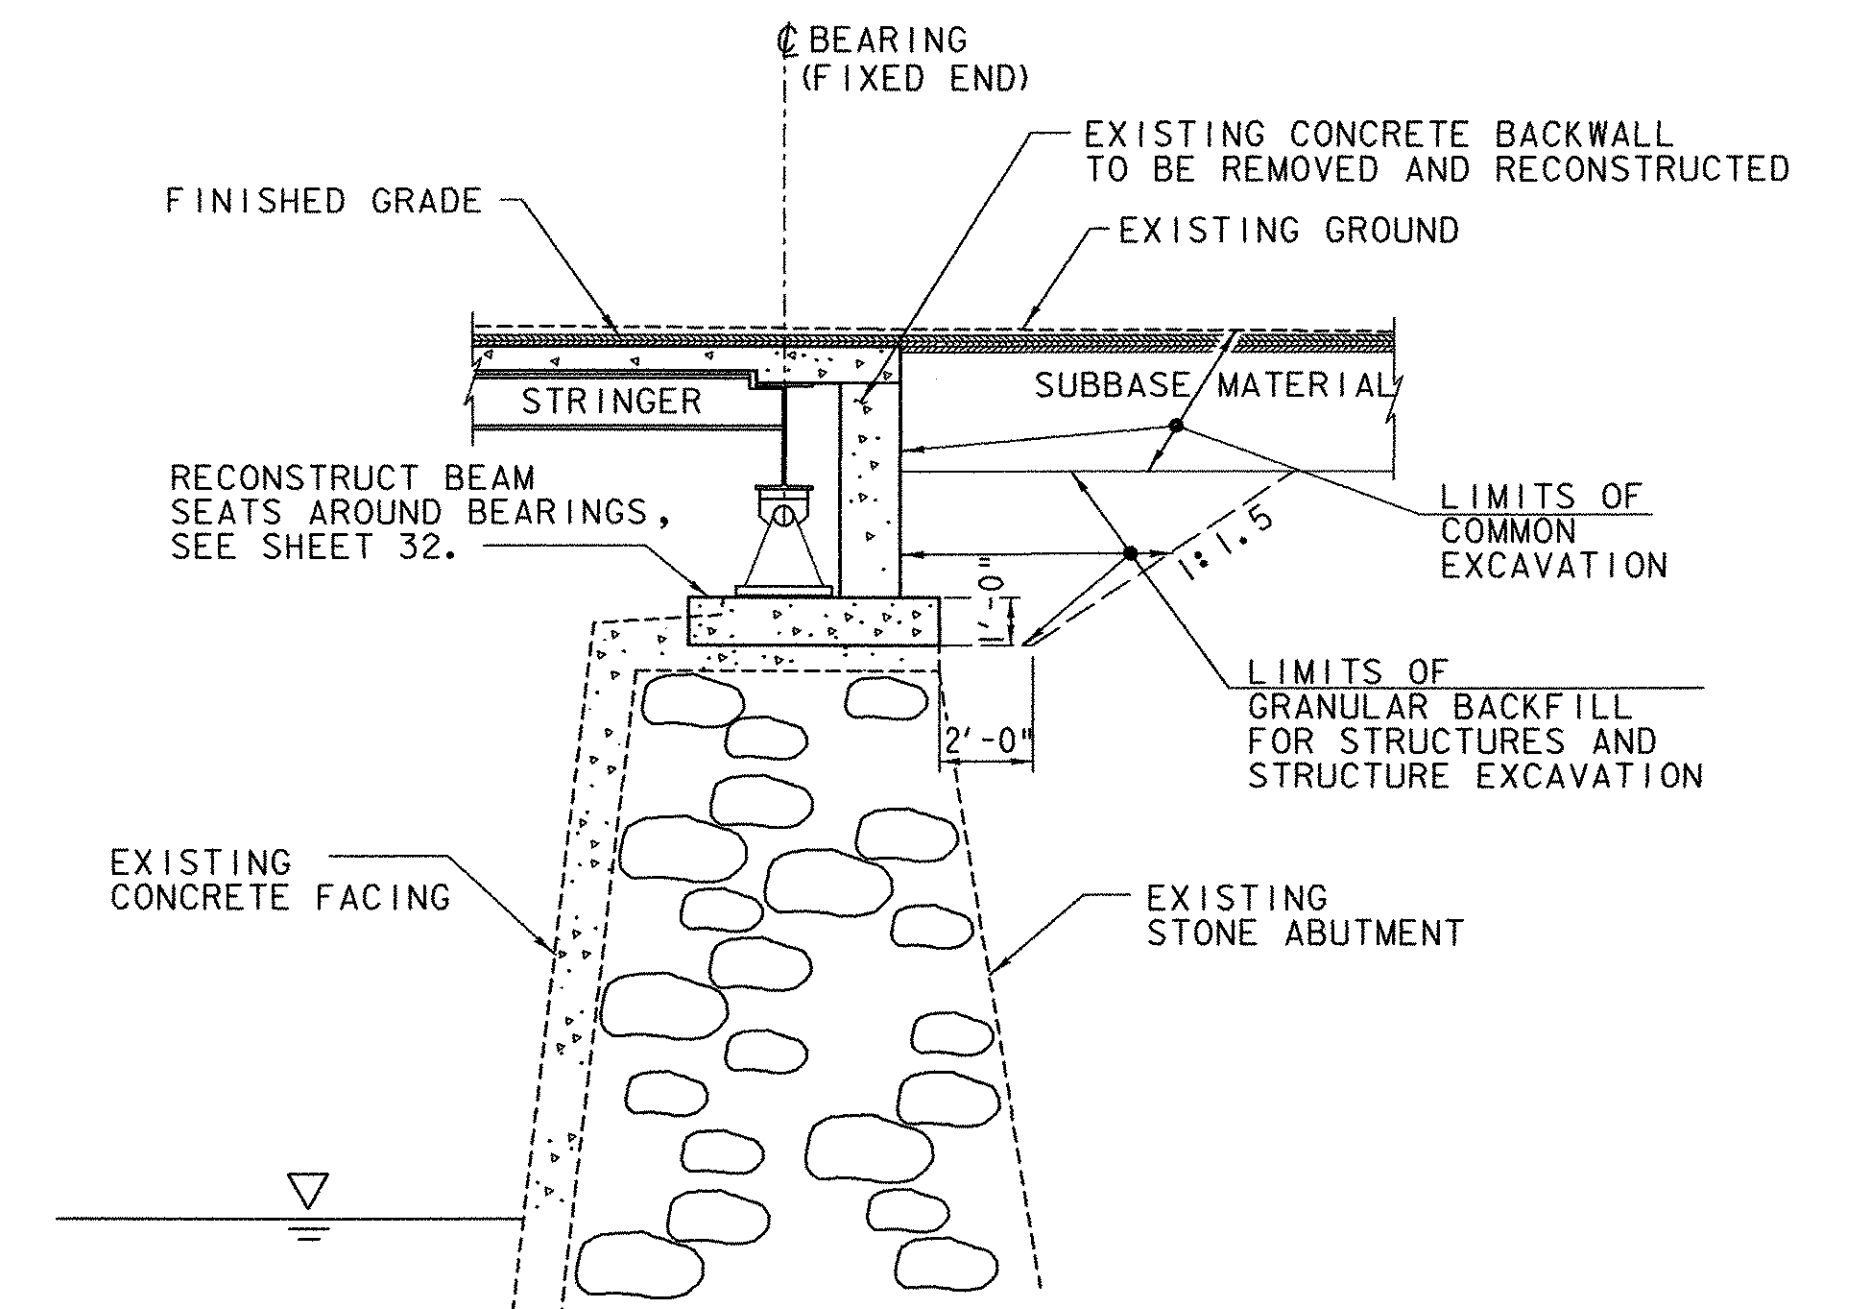

**ABUTMENT NO. 2
 EARTHWORK TYPICAL SECTION**


SCALE 1/4" = 1'-0"
 0 2 4 6

- NOTES:**
1. SIDEWALK THICKNESS VARIES FROM 5 1/2" AT END TO 4 3/8" AT CURB.
 2. EXISTING 8" WATER LINE TO BE PROTECTED AND MAINTAINED IN SERVICE DURING CONSTRUCTION. IF THE CONTRACTOR CHOOSES TO REMOVE THE TRUSS FROM THE SITE FOR REHABILITATION AND/OR PAINTING, THE CONTRACTOR SHALL PROVIDE TEMPORARY WATER SERVICE MEETING THE REQUIREMENTS OF SECTION 629. PAYMENT FOR PROTECTING AND MAINTAINING WATERLINE SERVICE SHALL BE INCIDENTAL TO ALL CONTRACT ITEMS.

NOTE: ANY MEMBERS THAT ARE NOT OTHERWISE NOTED AS NEW, SHALL BE RETAINED.




PROJECT NAME:	RICHFORD	PLOT DATE:	12/19/2007
PROJECT NUMBER:	BHF 0302 (3) S	DRAWN BY:	AET
FILE NAME:	...Design\Rich-brsect.dgn	CHECKED BY:	MJC
PROJECT LEADER:	MJC	TYPICAL BRIDGE SECTIONS	SHEET 3 OF 41
DESIGNED BY:	SEB		

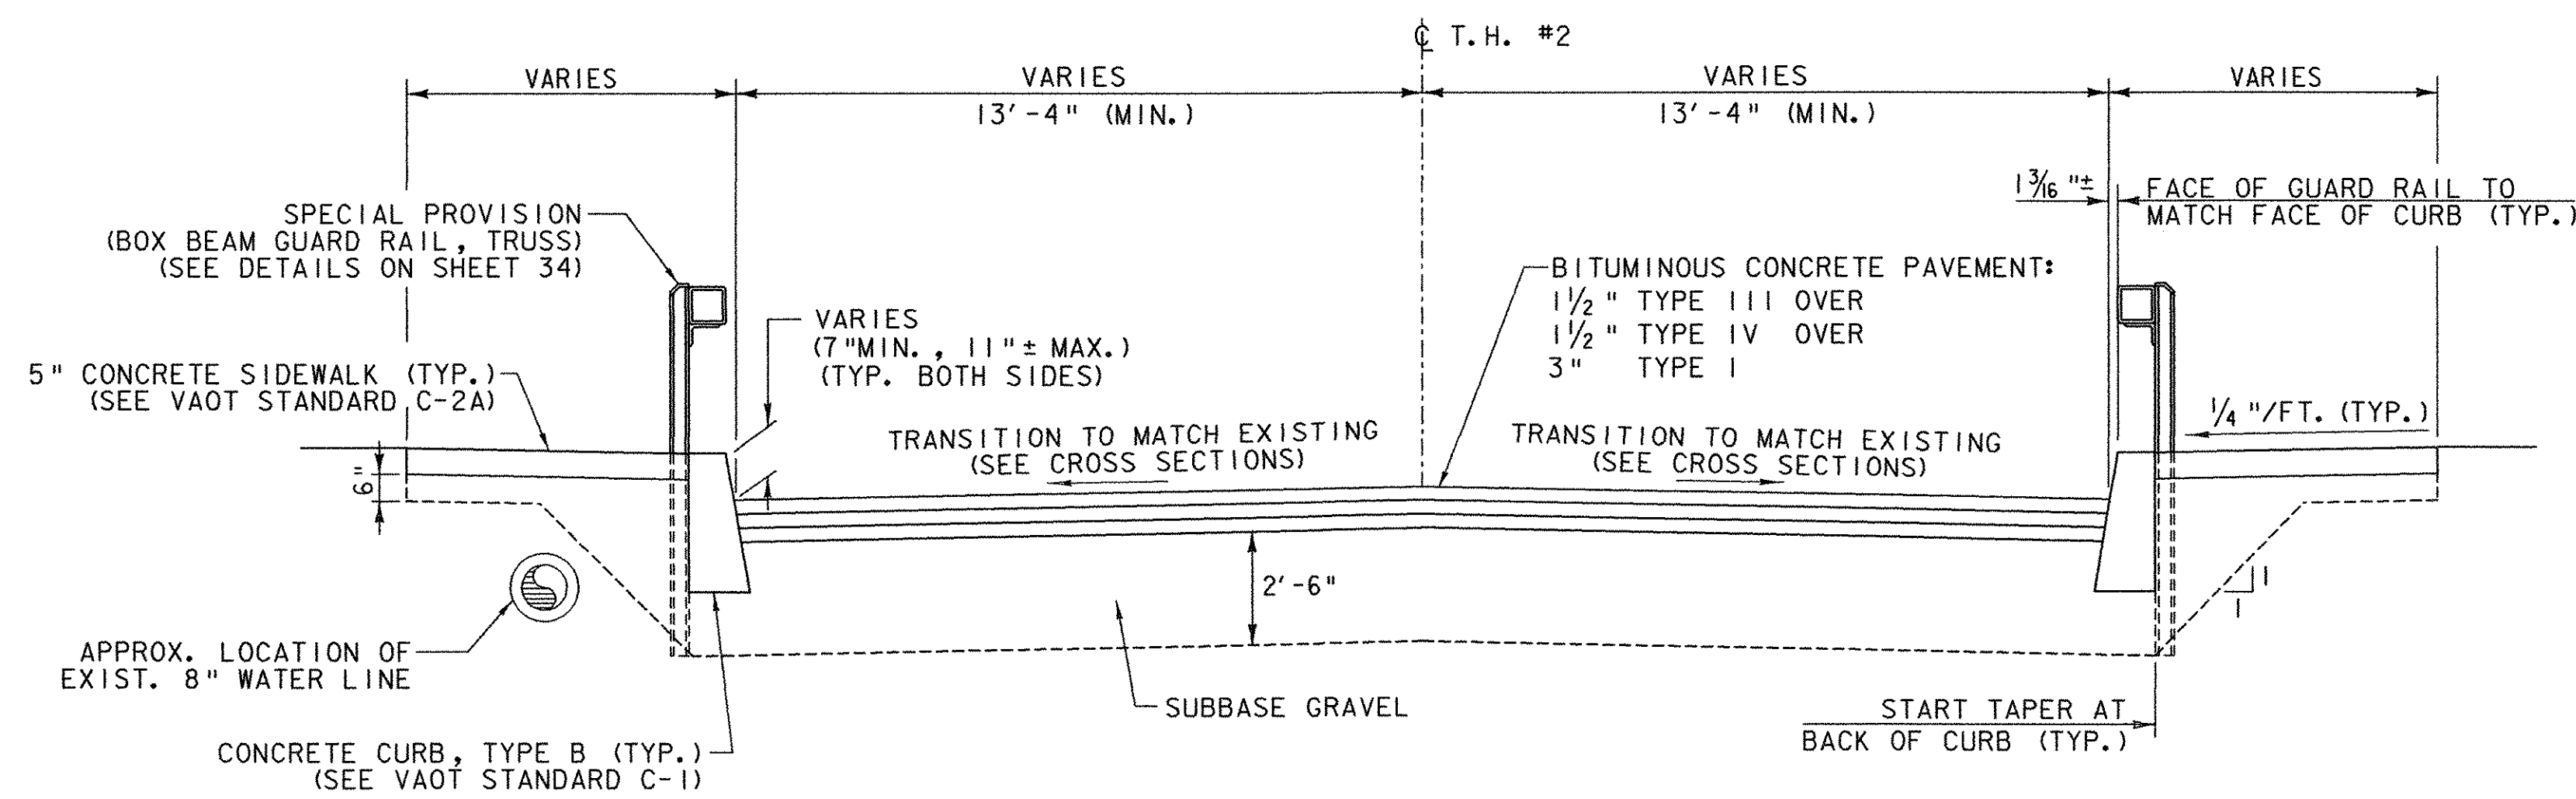

ROADWAY TYPICAL SECTION


NOT TO SCALE

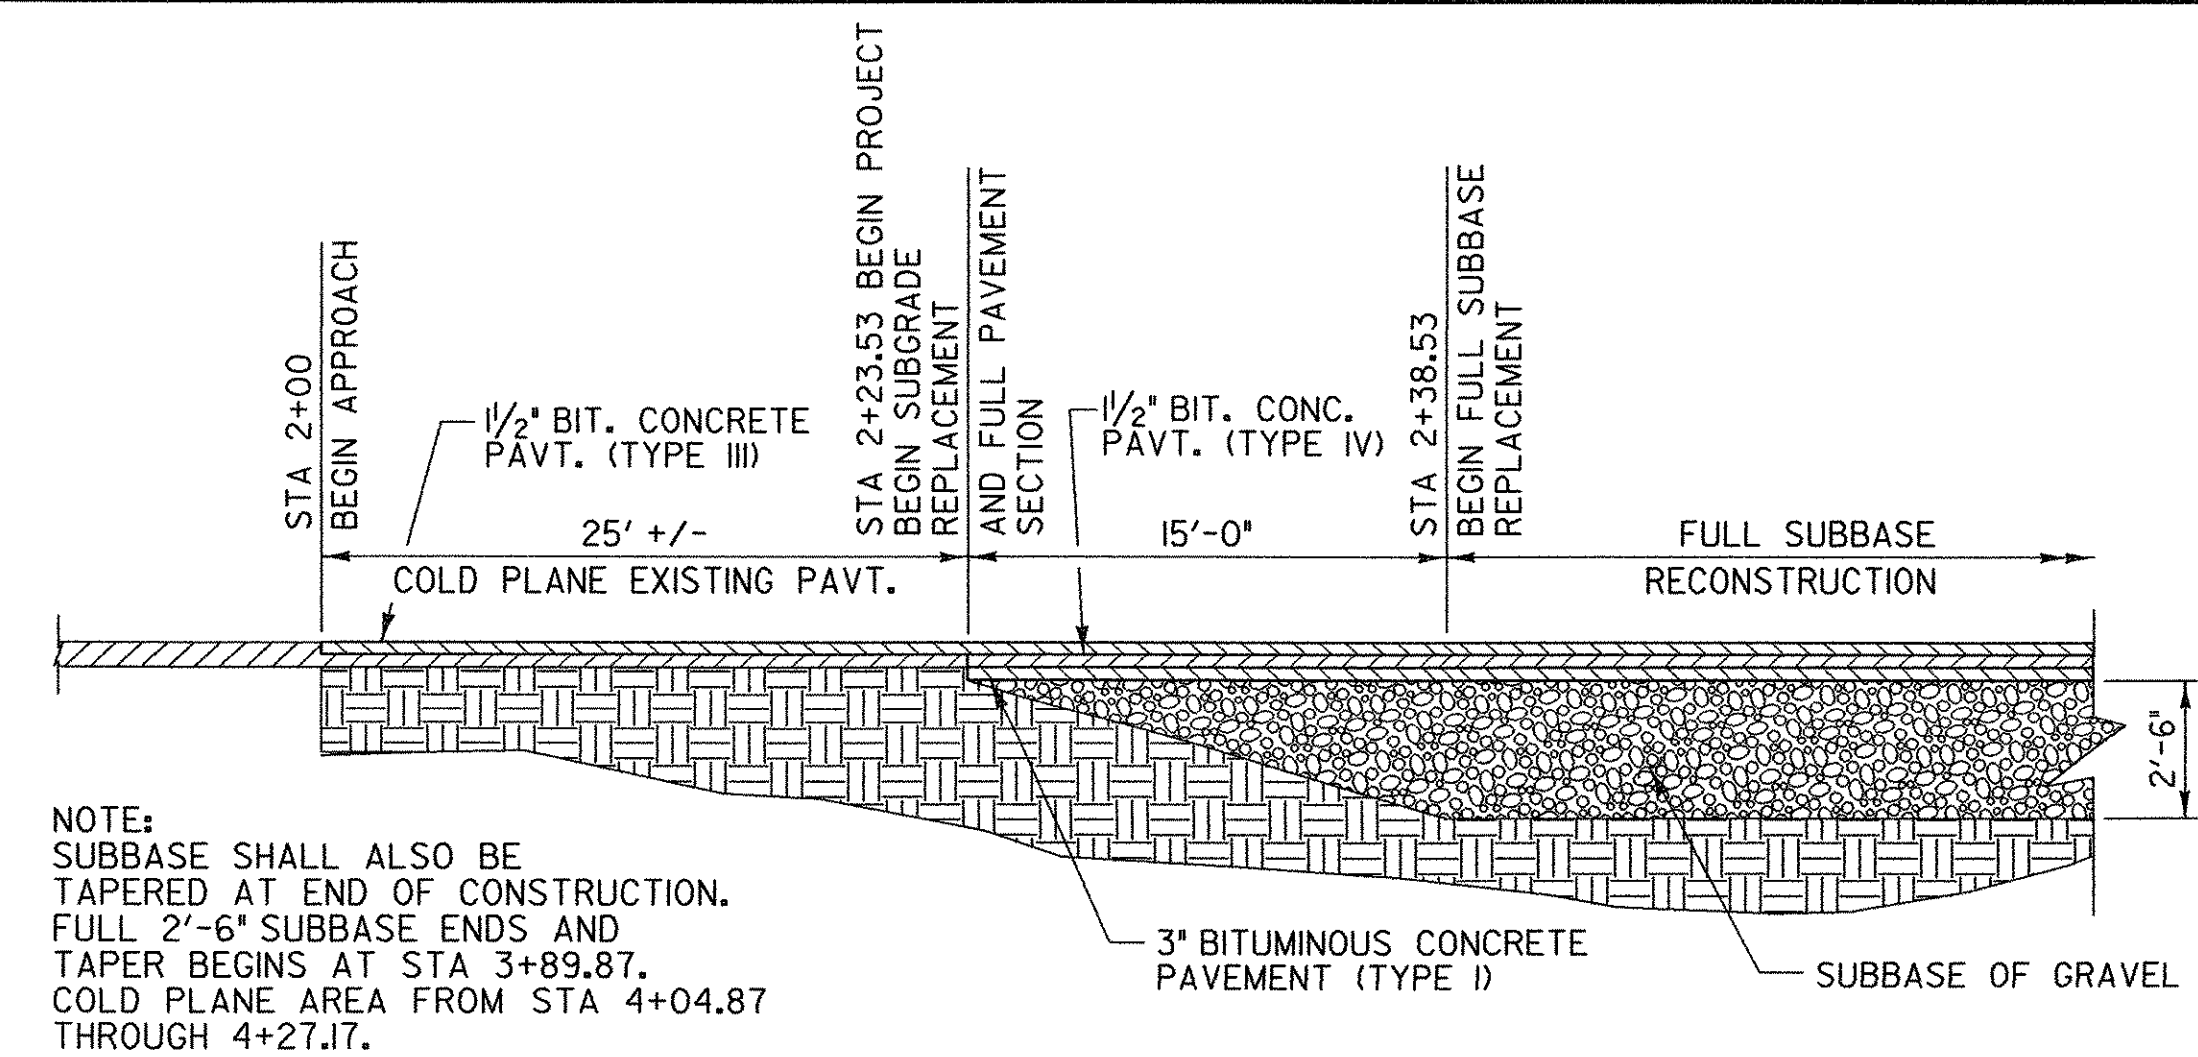

NOTE:
SUBBASE SHALL ALSO BE TAPERED AT END OF CONSTRUCTION. FULL 2'-6" SUBBASE ENDS AND TAPER BEGINS AT STA 3+89.87. COLD PLANE AREA FROM STA 4+04.87 THROUGH 4+27.17.


TYPICAL APPROACH SECTION

NOT TO SCALE

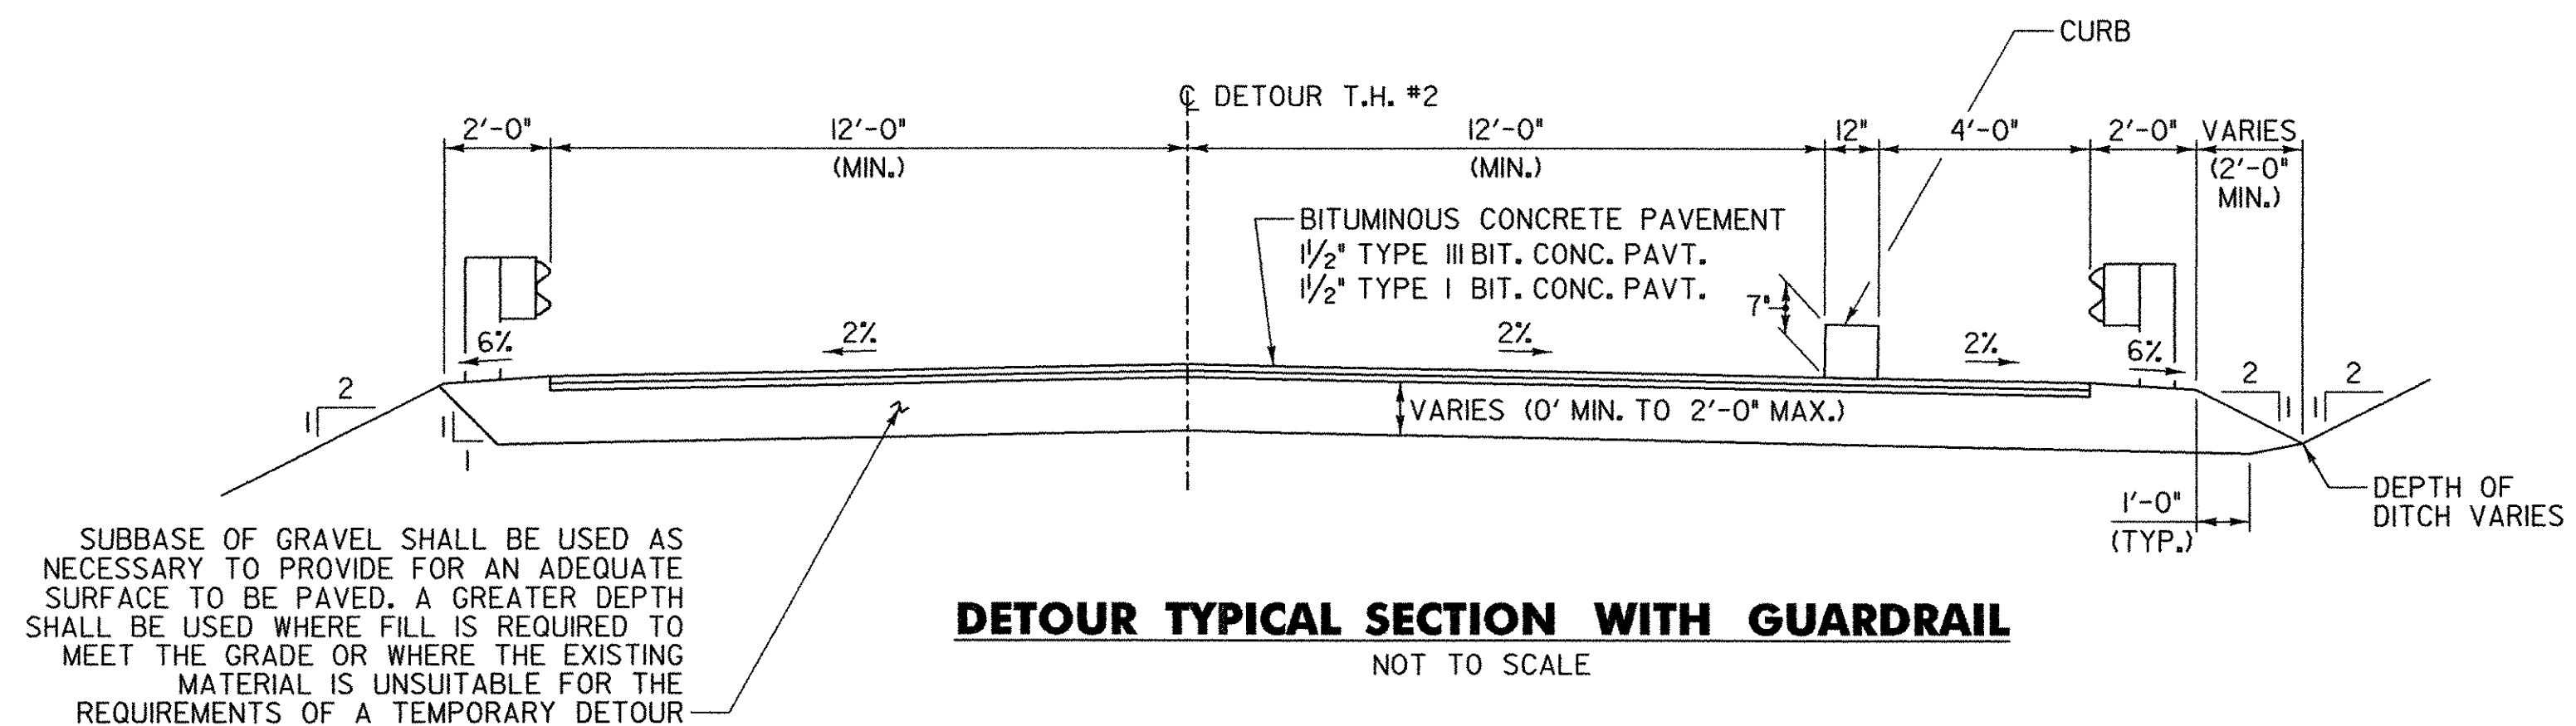

DETOUR TYPICAL SECTION WITH GUARDRAIL

NOT TO SCALE

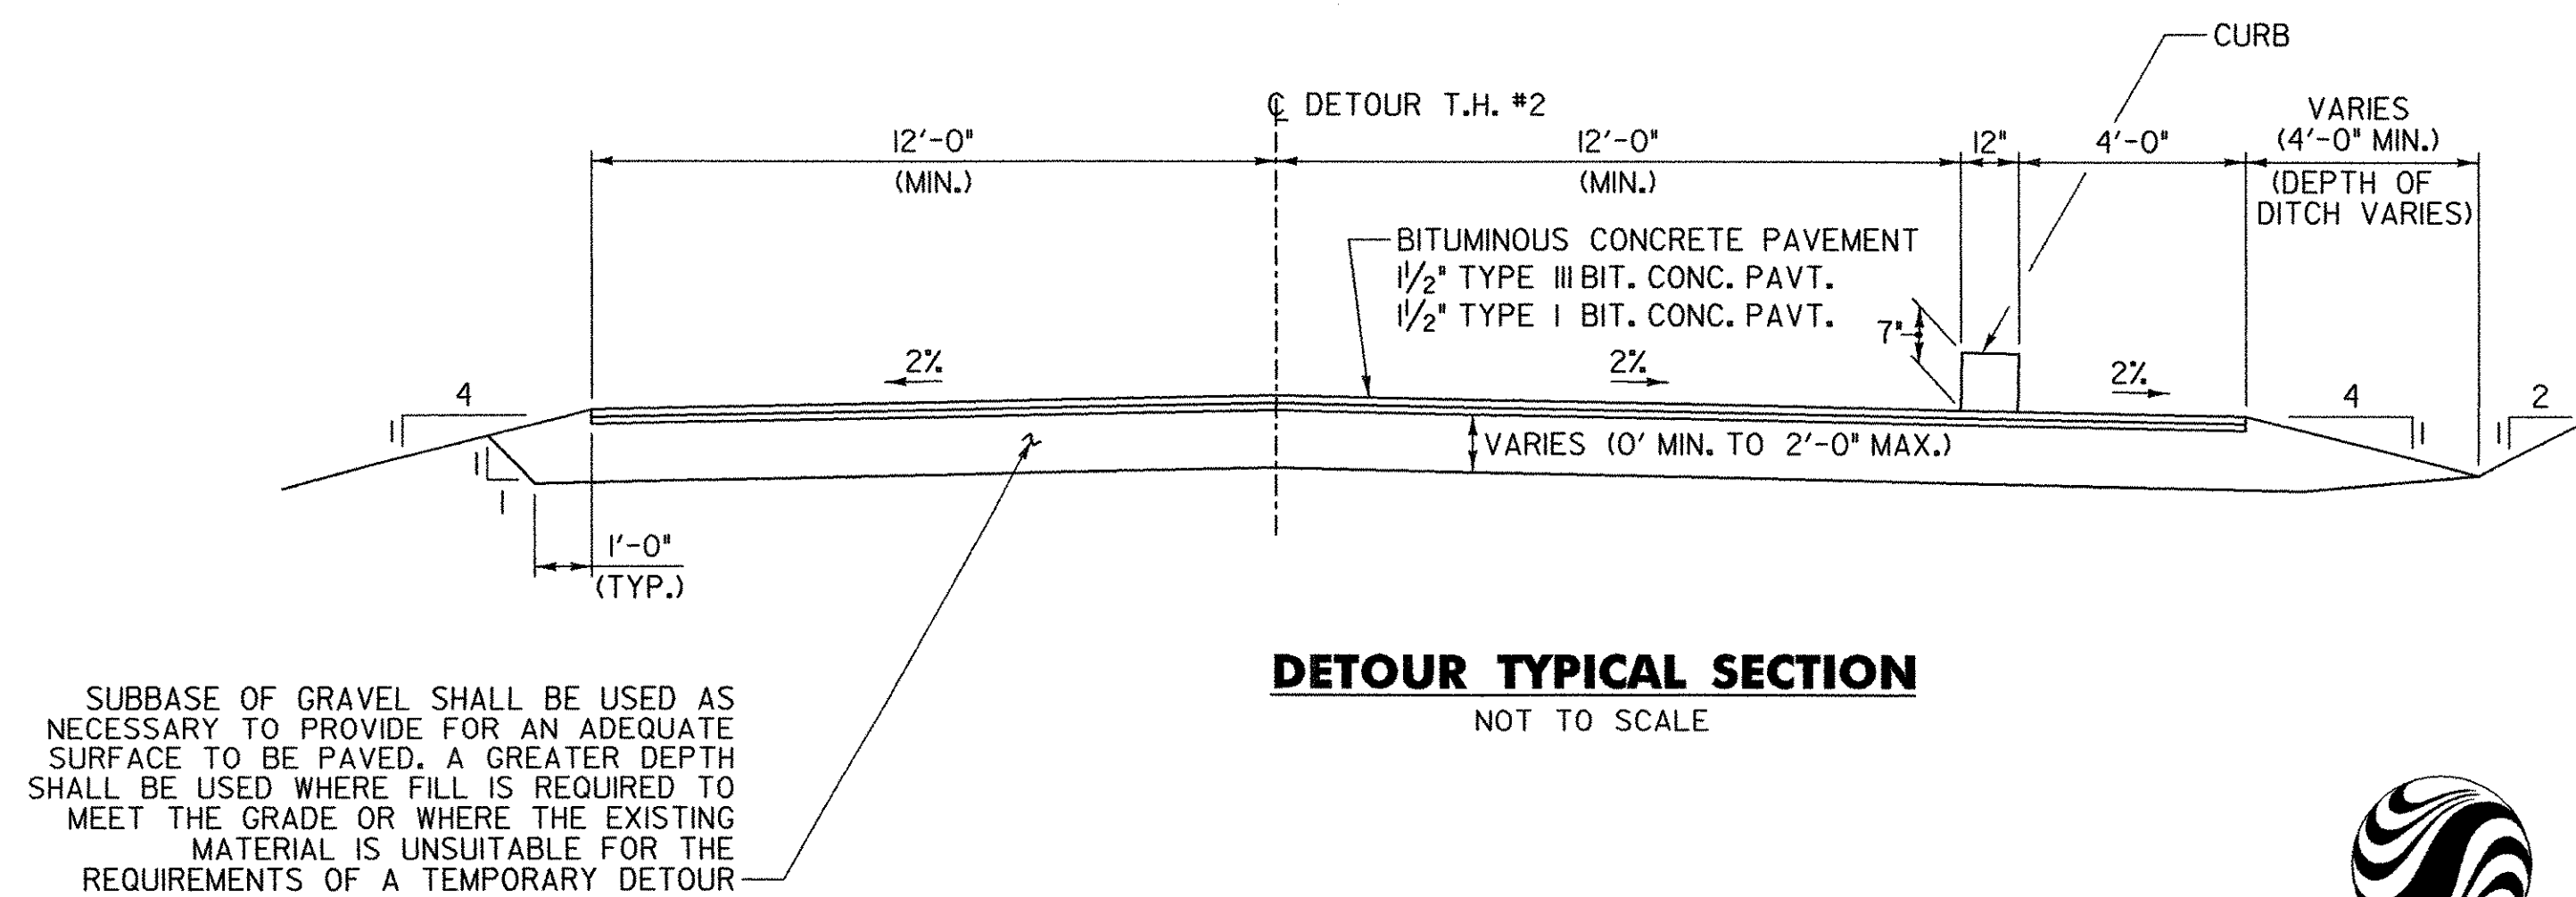

DETOUR TYPICAL SECTION

NOT TO SCALE



PROJECT NAME: RICHFORD
PROJECT NUMBER: BHF 0302 (3) S

FILE NAME: ...Design\Rich-rdwysect.dgn PLOT DATE: 12/19/2007
PROJECT LEADER: MJC DRAWN BY: AET
DESIGNED BY: SEB CHECKED BY: MJC
TYPICAL ROADWAY SECTIONS SHEET 4 OF 41

QUANTITY SHEET #1

SUMMARY OF ESTIMATED QUANTITIES										TOTALS				DESCRIPTIONS		DETAILED SUMMARY OF QUANTITIES	
TRAVEL	FILLICE	ROADWAY	BRIDGE	ABUTMENT	ABUTMENT	DECK	BRIDGE	ROUND	GRAND	FINAL	UNIT	ITEMS	ITEM	QUANTITIES	UNIT	ITEMS	
ITEM	ITEM	ITEM	CONTROL	NO. 1	NO. 2		QUANTITY	TOTAL	TOTAL	TOTAL							
	182							182			CY	COMMON EXCAVATION				203.15	
	22							22			CY	SOLID ROCK EXCAVATION				203.16	
	90							90			CY	TRENCH EXCAVATION OF EARTH				204.20	
	1			30	30		50	50			CY	TRENCH EXCAVATION OF EARTH, EXPLORATORY (N.A.#1)				204.22	
				30	30		60	60			CY	STRUCTURE EXCAVATION				204.25	
											CY	GRANULAR BACKFILL FOR STRUCTURES				205.30	
	255							255			SY	COLD PLANKING, BITUMINOUS PAVEMENT				210.30	
	150						1	150			CY	SUBBASE OF GRAVE				301.15	
	1						54	54			TON	EMULSIFIED ASPHALT				404.65	
	182							228			TON	MEDIUM DUTY BITUMINOUS CONCRETE PAVEMENT (PG 58-34)				406.27	
				6			138	144			CY	CONCRETE, HIGH PERFORMANCE CLASS A (FPO)				501.53	
	1			11	12			23			CY	CONCRETE, HIGH PERFORMANCE CLASS B				501.34	
				2				1			LS	SHORING SUPERSTRUCTURE				502.10	
				2				2			EA	SHORING SUPERSTRUCTURE BEARINGS (STA. 3+13.70)				502.11	
							87510	87510			LB	STRUCTURAL STEEL, ROLLED BEAM				506.80	
							1400	1400			LB	STRUCTURAL STEEL				506.90	
				1070	1716			2785			LB	REINFORCING STEEL				507.15	
				222	178			401			LF	DRILLING AND GROUTING DOWELS				507.16	
				1150			24395	25545			LB	EPOXY COATED REINFORCING STEEL				507.17	
							1	1			LS	SHEAR CONNECTORS (284 - 1 1/2" X 1 3/4")				508.15	
							2	2			LS	SHEAR CONNECTORS (282 - 7/8" X 1 1/2")				508.15	
							1	1			LS	STRUCTURAL PAINTING, SHOP APPLIED (44 TONS)				513.25	
							1	1			LS	STRUCTURAL PAINTING, FIELD APPLIED (30 TONS)				513.30	
							1	1			LS	CONTAINMENT & ENVIRONMENTAL PROTECTION, SHOP				513.35	
							1	1			LS	CONTAINMENT & ENVIRONMENTAL PROTECTION, FIELD				513.35	
							1	1			LS	SURFACE PREPARATION, SHOP (44 TONS)				513.40	
							1	1			LS	SURFACE PREPARATION, FIELD (30 TONS)				513.41	
				5	5		15	25			GAL	WATER REPELLENT, SILANE				514.10	
							27	27			LF	BRIDGE EXPANSION JOINT, VERMONT				515.11	
							380	380			SY	SHEET MEMBRANE WATERPROOFING, TORCH APPLIED				519.20	
	31							31			LF	REMOVAL OF EXISTING RAILING				528.10	
	1							1			LS	TWO-WAY TEMPORARY BRIDGE (8000 SF, EST.)				528.11	
							389	389			SY	REMOVAL OF BRIDGE PAVEMENT				529.10	
							1	1			EACH	PARTIAL REMOVAL OF STRUCTURE				529.20	
				4	2		6	6			CY	REMOVAL OF CONCRETE OR MASONRY				529.25	
				5	15		20	20			SY	REPAIR OF CONCRETE SUBSTRUCTURE SURFACE, CLASS I				530.13	
				2	8		10	10			SY	REPAIR OF CONCRETE SUBSTRUCTURE SURFACE, CLASS II				530.14	
	110							110			LF	1ST CRCP (SL)				601.2815	
				3				3			SY	STORE MASONRY FACING				602.25	
	1							1			EACH	PRECAST REINFORCED CONCRETE DROP INLET WITH CAST IRON GRATE				604.15	
	242							242			LF	CAST-IN-PLACE CONCRETE CURB, TYPE B				615.28	
	215							215			LF	REMOVAL OF EXISTING CURB				615.41	
	154							154			SY	PORTLAND CEMENT CONCRETE SIDEWALK, 6 INCH				618.10	

PROJECT NAME: RICHFORD
 PROJECT NUMBER: BHF 0302 (3) S
 FILE NAME: rich-quant1.dwg PLOT DATE: 1/8/2008
 PROJECT LEADER: MJC DRAWN BY: AET
 DESIGNED BY: SEB CHECKED BY: MJC
 QUANTITY SHEET #1 SHEET 5 OF 41

STATE OF VERMONT AGENCY OF TRANSPORTATION														QUANTITY SHEET #2								
SUMMARY OF ESTIMATED QUANTITIES														TOTALS			DESCRIPTIONS		DETAILED SUMMARY OF QUANTITIES			
TRAINING	FULL C.E. TRAIN	ADVISOR	EROSION CONTROL	ADJUSTMENT No. 1	ADJUSTMENT No. 2	DECK	BRIDGE QUANTITY	ROUND	GRAND TOTAL	FINAL	UNIT	ITEMS	ITEM NUMBER	QUANTITIES	UNIT	ITEMS						
		10							10		SF	DETECTABLE TRAVEL SURFACE	618.30									
		60							60		LF	TEMPORARY TRAFFIC BARRIER	621.00									
	1								1		LS	FIELD OFFICE, ENGINEERS	631.10									
	1								1		LS	TESTING EQUIPMENT, CONCRETE	631.16									
	1								1		LS	TESTING EQUIPMENT, BITUMINOUS	631.17									
	1								1		LU	FIELD OFFICE TELEPHONE (N.A.B.)	631.25									
500									500		HR	EMPLOYEE TRAINESHIP	634.10									
		1							1		LS	MOBILIZATION/DEMOLITION	635.11									
		1							1		LS	TRAFFIC CONTROL	641.10									
		350				200	200	200	610		LF	DURABLE 4 INCH WHITE LINE	646.400									
		690				200	200	200	900		LF	DURABLE 4 INCH YELLOW LINE	646.410									
		36							36		LF	DURABLE 6 INCH WHITE LINE	646.420									
		95							95		LF	DURABLE CROSSHAJK MARKING	646.500									
		102							102		LF	TEMPORARY 8 INCH WHITE LINE	646.640									
		54							54		LF	TEMPORARY 24 INCH STOP BAR	646.680									
		4							4		EACH	TEMPORARY LETTER OR SYMBOL	646.690									
		149							149		LF	PAINTED CURB	646.81									
		215							215		SF	REMOVAL OF EXISTING PAVEMENT MARKINGS	648.85									
		60							60		SY	GEOTEXTILE FOR SFT FENCE	649.61									
		220							220		SY	GEOTEXTILE FOR FILTER CURTAIN	649.61									
		10							20		LB	SEED	651.15									
		1							2		TON	HAY/ALDCH	651.35									
		1							1		LS	EPSC PLAN	652.10									
		80							80		HR	MONITORING EPSC PLAN	652.20									
		1							1		LU	MAINTENANCE OF EPSC PLAN (N.A.B.)	652.30									
		430							430		SY	TEMPORARY EROSION MATTING	653.20									
		2							2		CV	TEMPORARY STONE CHECK DAM, TYPE I	653.35									
		40							40		CV	VEHICLE TRACKING PAD	653.35									
		1							1		EACH	INLET PROTECTION DEVICE, TYPE I	653.40									
		1							1		EACH	FILTER BAG	653.45									
		180							180		LF	BARRIER FENCE	653.50									
		540							540		LF	PROJECT DEMARCATION FENCE	653.55									
		1							1		EACH	TRANSPLANTING SHRUBS (2')	655.50									
		2							2		EACH	REMOVING SIGNS	675.50									
		2							2		EACH	ERECTING SALVAGED SIGNS	675.60									
		1							1		EACH	SETTING SALVAGED POSTS	675.61									
		1							1		EACH	TEMPORARY TRAFFIC SIGNAL SYSTEM	678.40									
		3							3		EACH	TEMPORARY DETECTOR	678.42									
		1							1		EACH	SPECIAL PROVISION (GRASS OUTLET SEDIMENT TRAP)	900.620									
		50							50		EACH	SPECIAL PROVISION (GRAVE, BARR)	900.630									
		80							80		LF	SPECIAL PROVISION (BOX BEAM GUARD RAIL, TRUSS)	900.640									
		222							222		LF	SPECIAL PROVISION (BRIDGE RAILING, TRUSS)	900.641									
		31							31		LF	SPECIAL PROVISION (METAL HAND RAILING)	900.642									






PROJECT NAME: RICHFORD
PROJECT NUMBER: BHF 0302 (3) S
FILE NAME: rich-quant.xls PLOT DATE: 10/2008
PROJECT LEADER: MJC DRAWN BY: AET
DESIGNED BY: SEB CHECKED BY: MJC
QUANTITY SHEET #2 SHEET 8 OF 41

GPS CONTROL POINTS

BM #8
 C2 = P14 RESET
 ELEV. = 465.82



DESCRIBED BY VERMONT AGENCY OF TRANSPORTATION 1995 (CHR) GENERAL LOCATION RICHFORD VERMONT. ABOUT 23.5 MI (37.8 KM) NORTHEAST OF ST. ALBANS, ABOUT 25.5 MI (41.0 KM) WEST OF NEWPORT AND ABOUT 1.5 MI (2.4 KM) SOUTH OF THE US/CANADA BORDER. TO REACH FROM THE INTERSECTION OF VERMONT ROUTES 105 AND 139 (MAIN STREET), GO NORTHEAST ON VT ROUTE 139 FOR 0.1 MI (0.2 KM) TO THE MARK ON THE RIGHT, SET IN THE EAST CORNER OF THE 1.7 M (5.6 FT) SQUARE GRANITE BASE OF THE RICHFORD VETERANS MEMORIAL. THE MARK IS 12.5 M (41.0 FT) SOUTHEAST OF AND ABOUT 1M (3.3 FT) HIGHER THAN THE CENTERLINE OF ROUTE 139, 8.5 M (27.9 FT) NORTHEAST OF THE NORTH CORNER OF THE FRANKLIN-LAMOILLE BANK, 3.7 M (12.1 FT) SOUTHWEST OF A FLAGPOLE, AND 8.2 M (26.9 FT) NORTHEAST OF A FIBERGLASS WITNESS POST.

TRAVERSE TIES

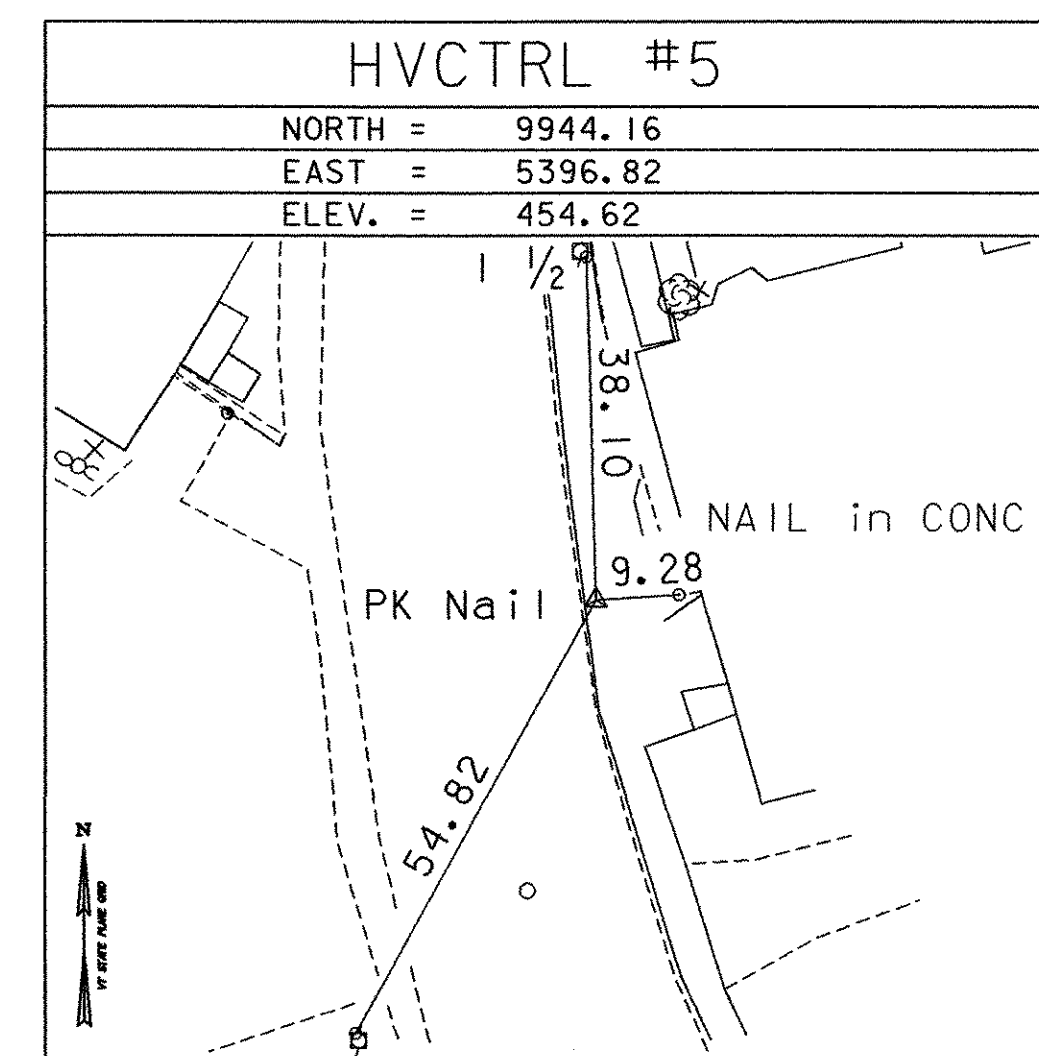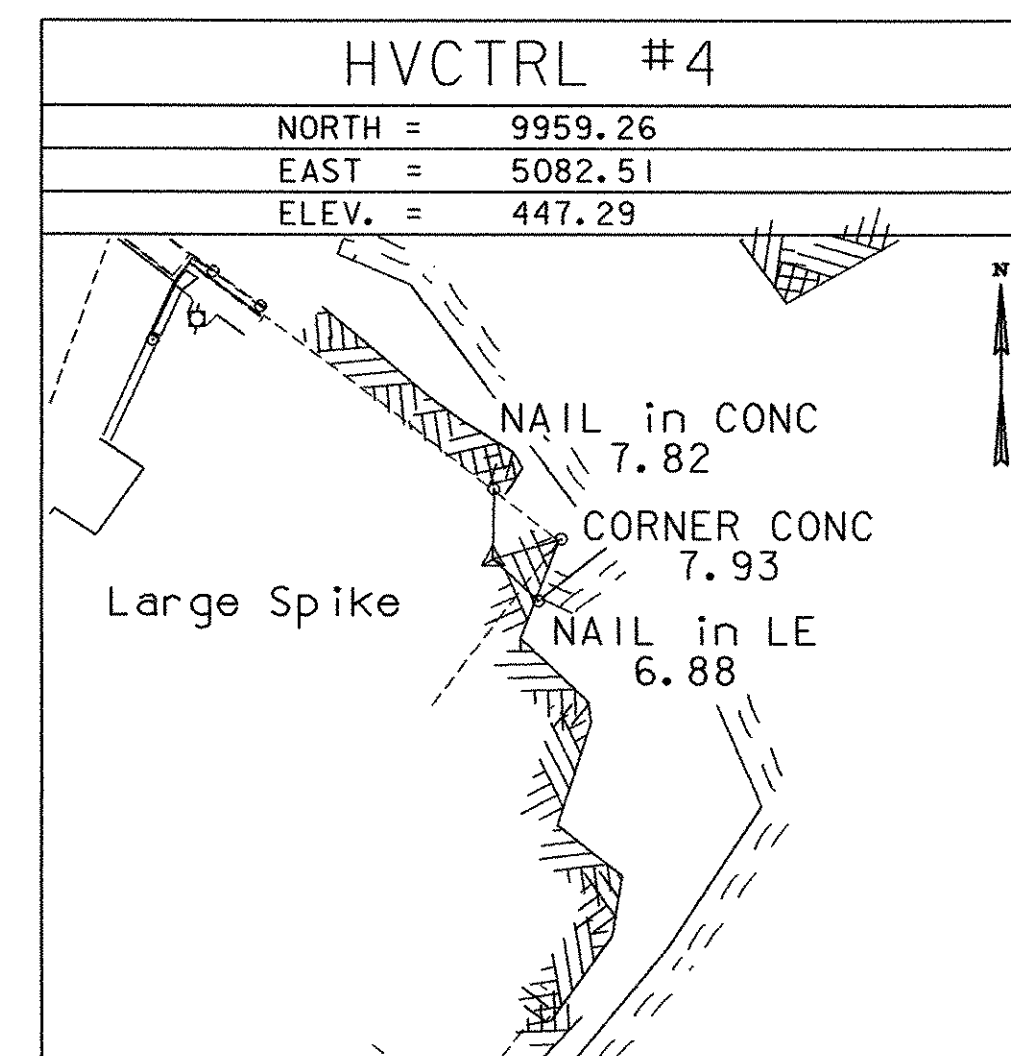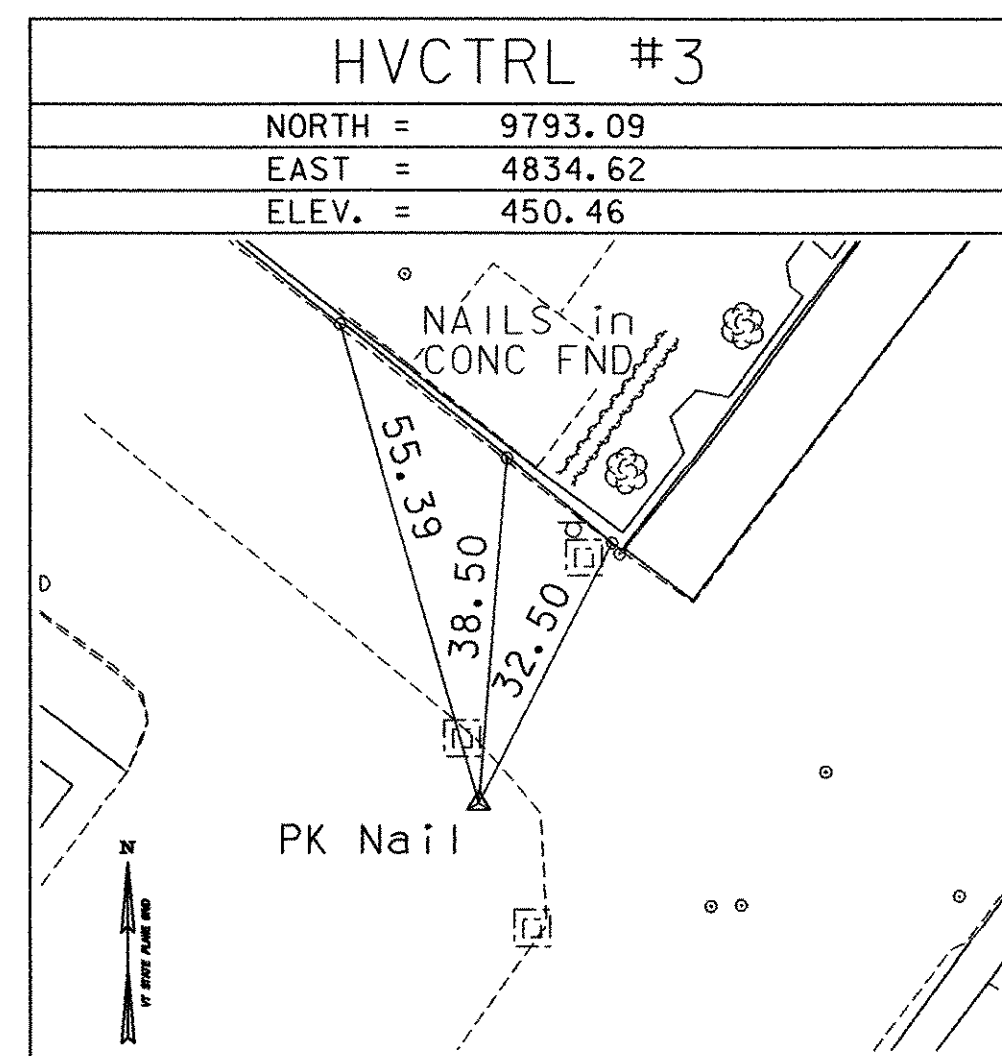
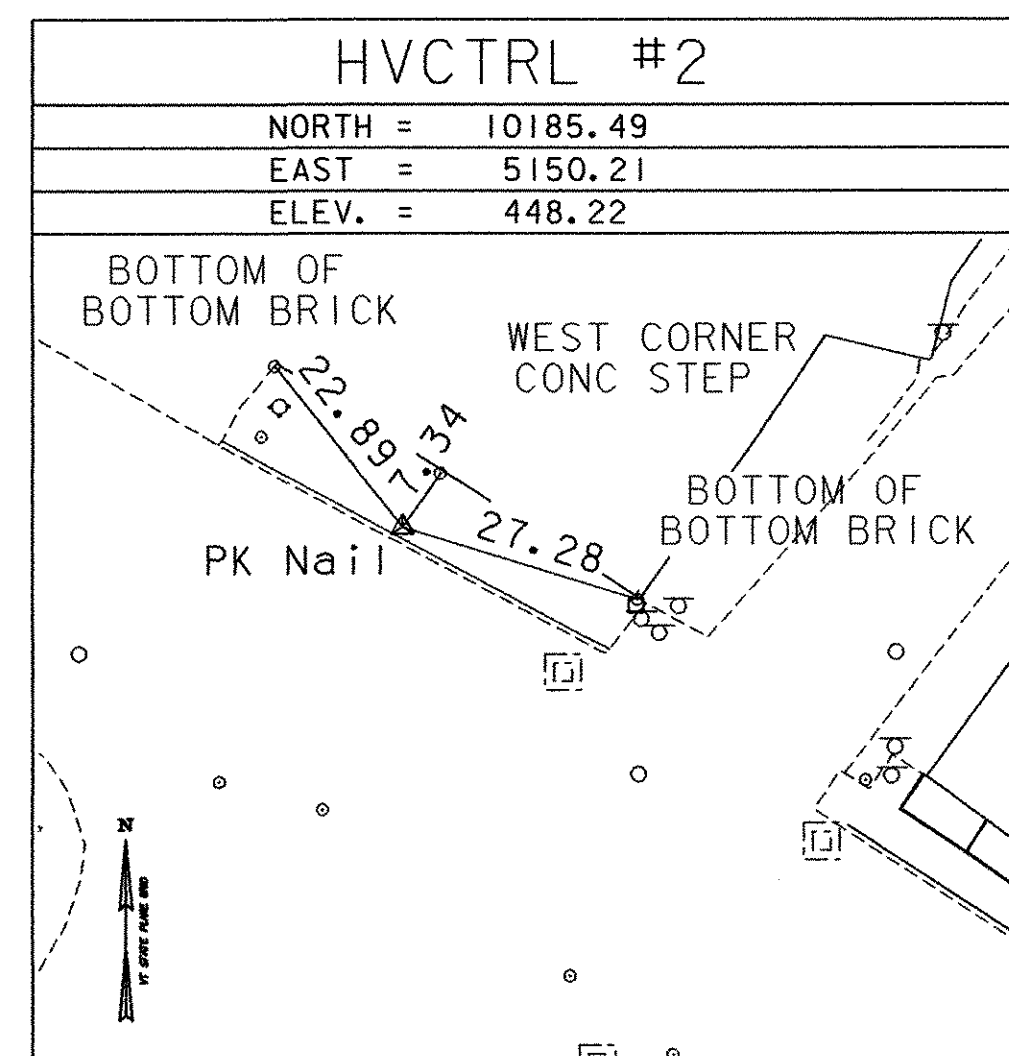
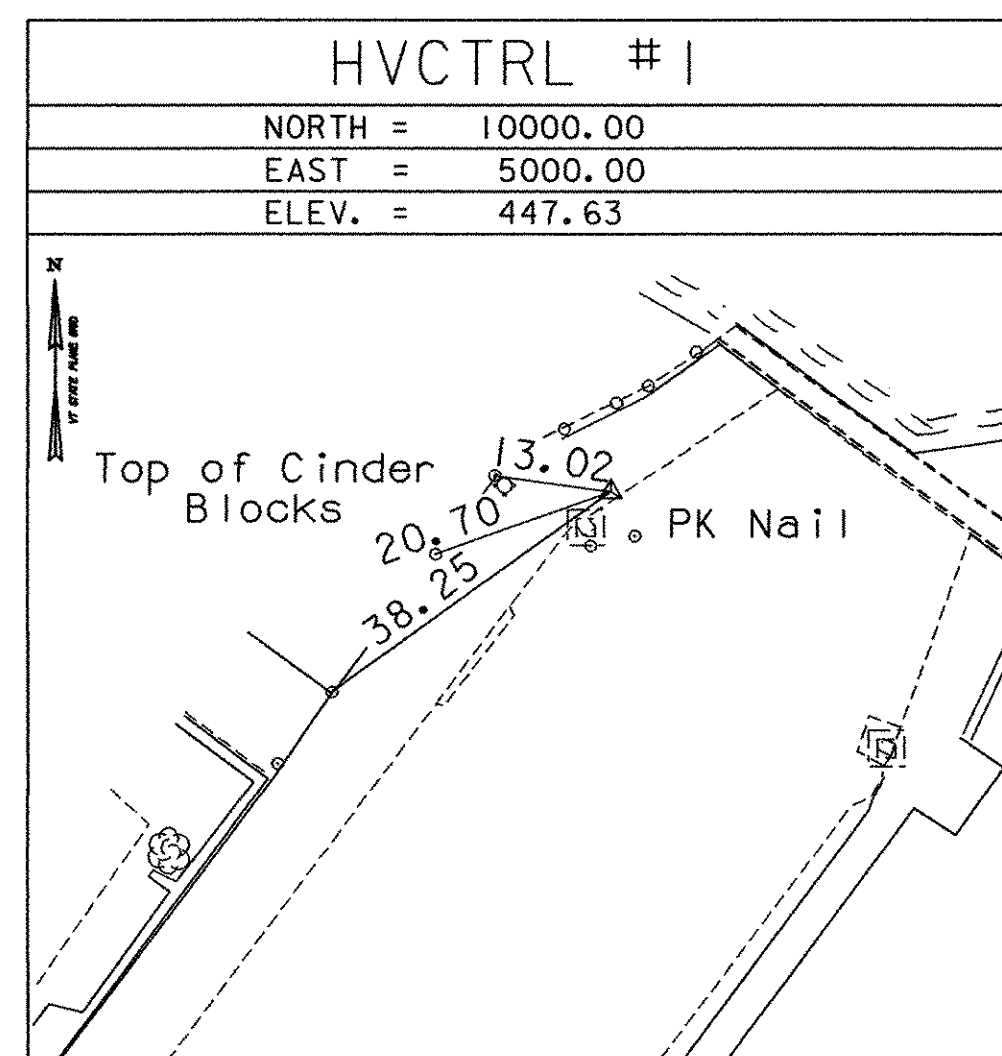


* Main Traverse Completed 6/11/07 by R. Bullock P.C. & T. Parker

TRAVERSE TIES

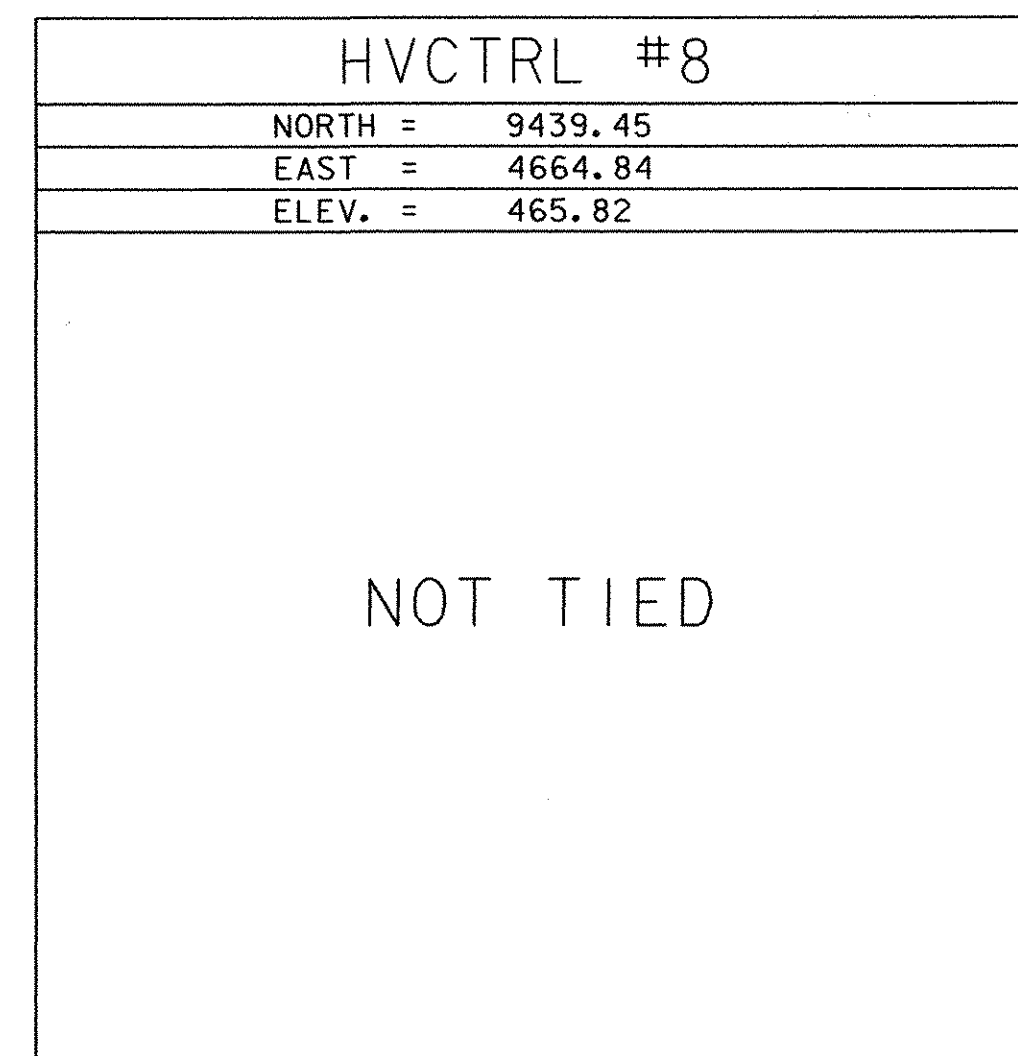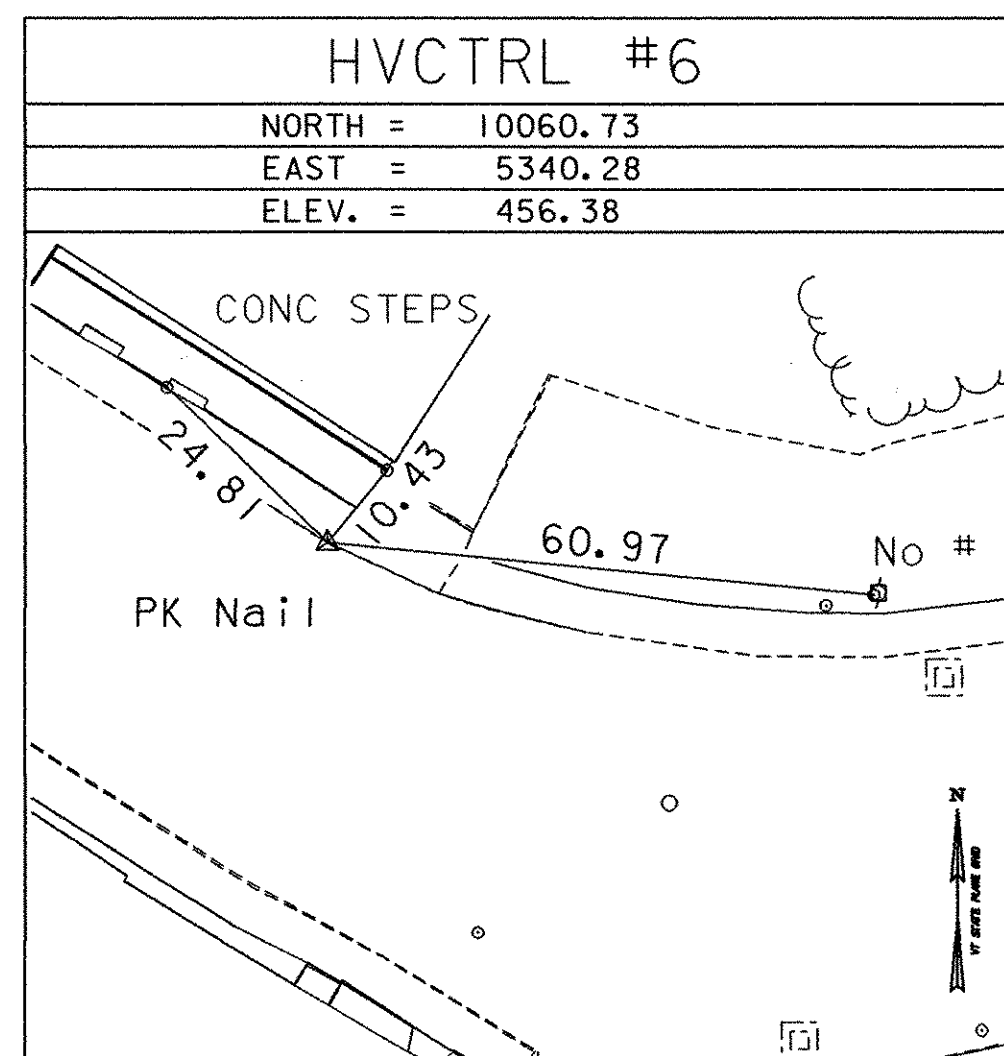


ALIGNMENT TIES

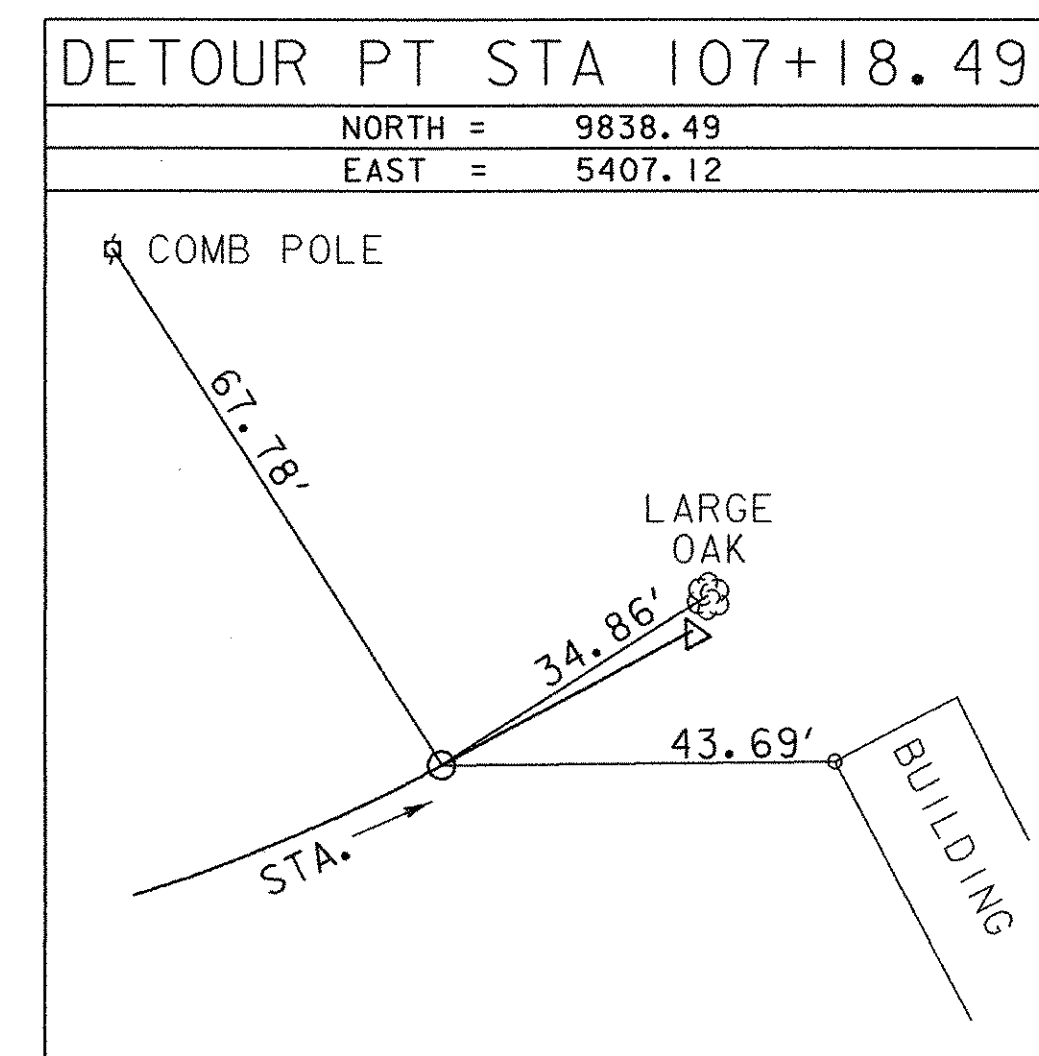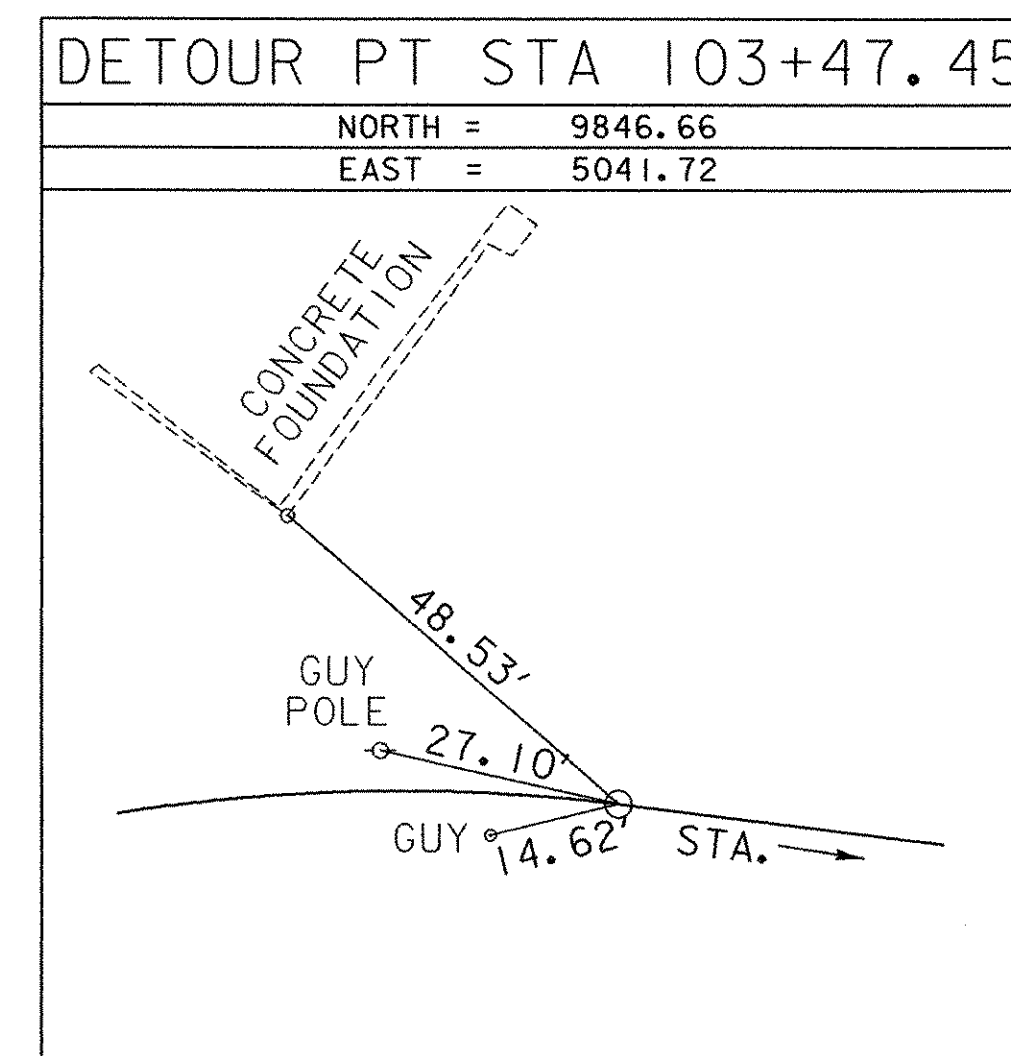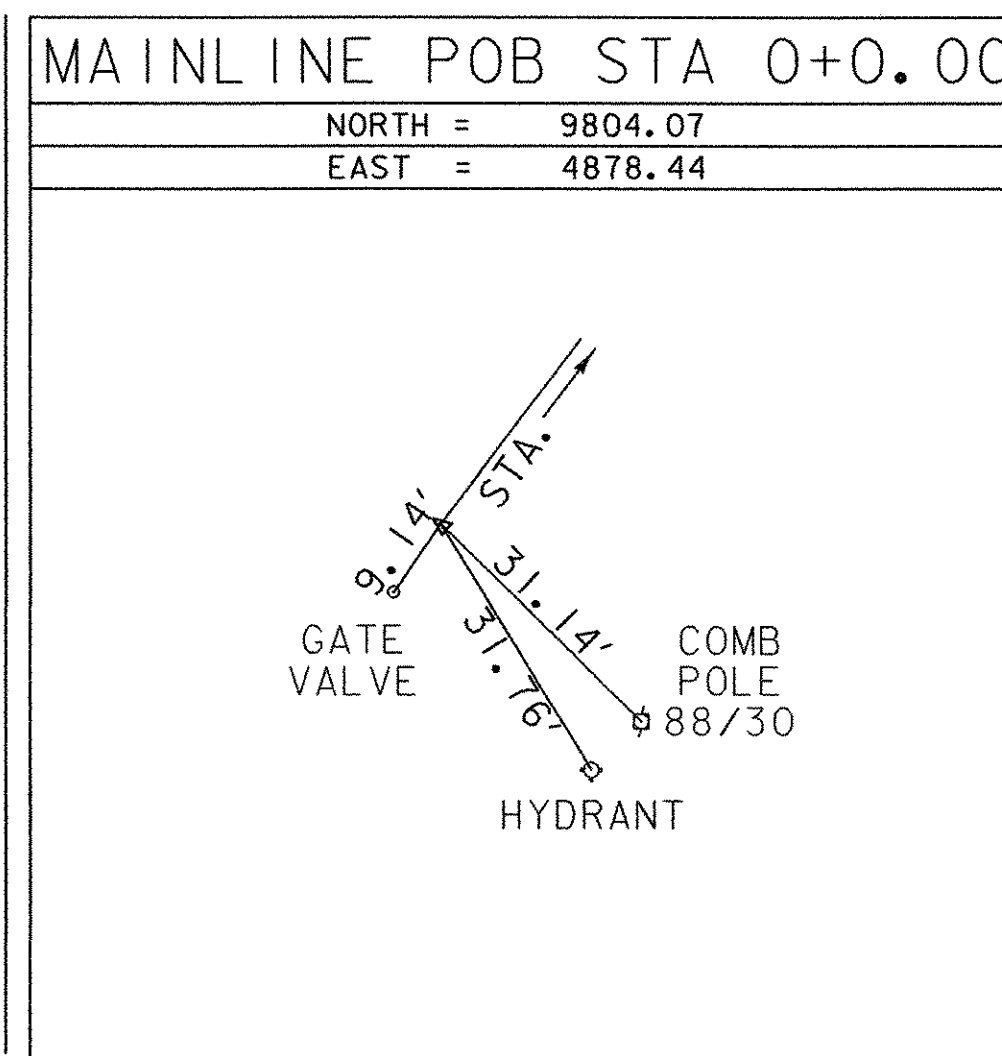

DATUM	
VERTICAL	NAVD 88
HORIZONTAL	ASSUMED
ADJUSTMENT	COMPASS

PROJECT NAME:	Richford
PROJECT NUMBER:	BHF 0302(3)S
FILE NAME:	99J242\survey\99J242+1.dgn
PROJECT LEADER:	MJC
DESIGNED BY:	VTRANS/STANTEC
TIE SHEET	
PLOT DATE:	12/18/2007
DRAWN BY:	R. Bullock
CHECKED BY:	VTRANS/STANTEC
SHEET	7 OF 41

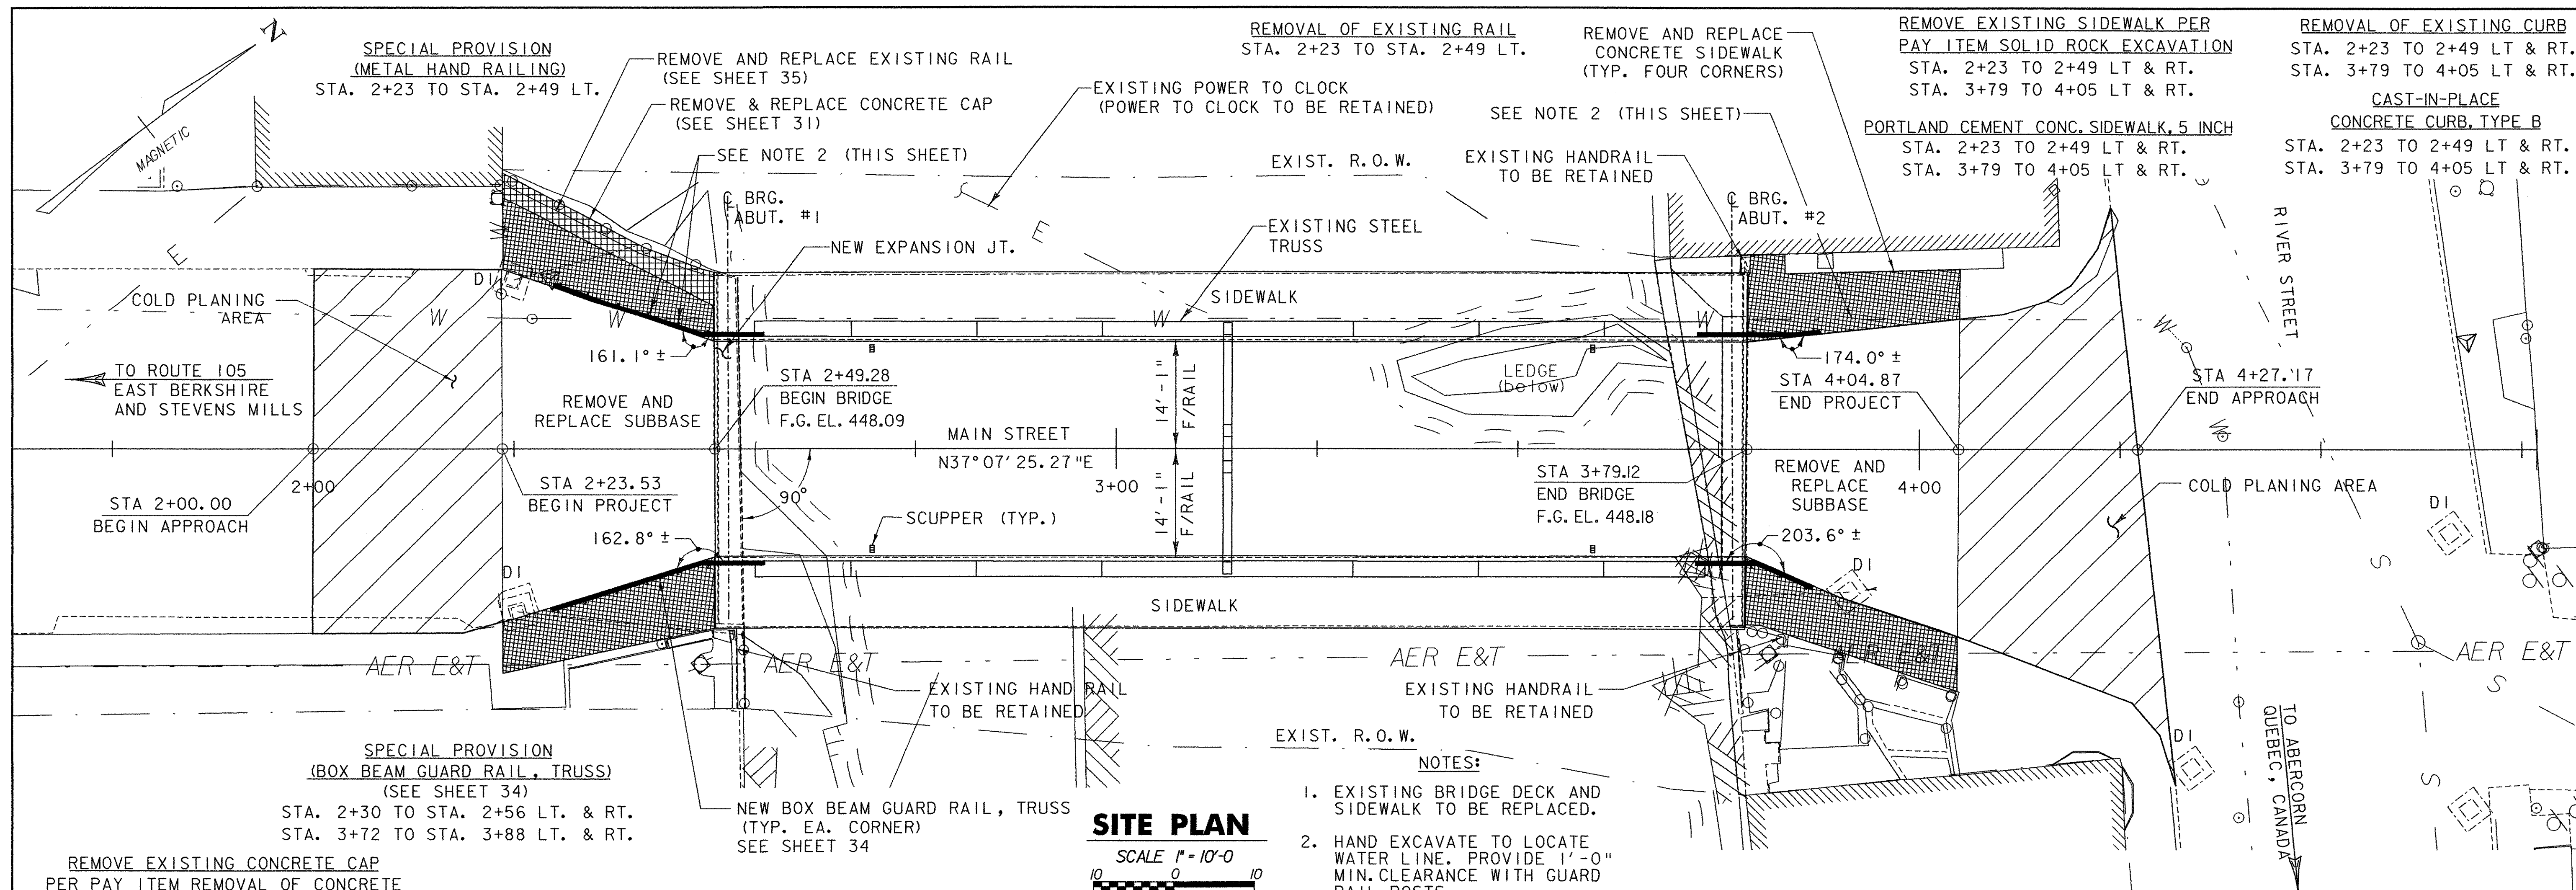

**SPECIAL PROVISION
(METAL HAND RAILING)**
STA. 2+23 TO STA. 2+49 LT.

REMOVE AND REPLACE EXISTING RAIL
(SEE SHEET 35)
REMOVE & REPLACE CONCRETE CAP
(SEE SHEET 31)

REMOVAL OF EXISTING RAIL
STA. 2+23 TO STA. 2+49 LT.

REMOVE AND REPLACE
CONCRETE SIDEWALK
(TYP. FOUR CORNERS)

**REMOVE EXISTING SIDEWALK PER
PAY ITEM SOLID ROCK EXCAVATION**
STA. 2+23 TO 2+49 LT & RT.
STA. 3+79 TO 4+05 LT & RT.

REMOVAL OF EXISTING CURB
STA. 2+23 TO 2+49 LT & RT.
STA. 3+79 TO 4+05 LT & RT.

**CAST-IN-PLACE
CONCRETE CURB, TYPE B**
STA. 2+23 TO 2+49 LT & RT.
STA. 3+79 TO 4+05 LT & RT.

PORTLAND CEMENT CONC. SIDEWALK, 5 INCH
STA. 2+23 TO 2+49 LT & RT.
STA. 3+79 TO 4+05 LT & RT.

**SPECIAL PROVISION
(BOX BEAM GUARD RAIL, TRUSS)**
(SEE SHEET 34)
STA. 2+30 TO STA. 2+56 LT. & RT.
STA. 3+72 TO STA. 3+88 LT. & RT.


**REMOVE EXISTING CONCRETE CAP
PER PAY ITEM REMOVAL OF CONCRETE
OR MASONRY**
STA. 2+23 TO STA. 2+49 LT.

**TEMPORARY TRAFFIC BARRIER
(CONCRETE MEDIAN BARRIER)**
STA. 2+45 LT. & RT. ±
STA. 3+85 LT. & RT. ±

SITE PLAN

SCALE 1" = 10'-0"
10 0 10

- NOTES:**
- EXISTING BRIDGE DECK AND SIDEWALK TO BE REPLACED.
 - HAND EXCAVATE TO LOCATE WATER LINE. PROVIDE 1'-0" MIN. CLEARANCE WITH GUARD RAIL POSTS.
 - REFER TO SHEETS 16 AND 18 FOR ADDITIONAL ROADWAY CONSTRUCTION ITEMS.

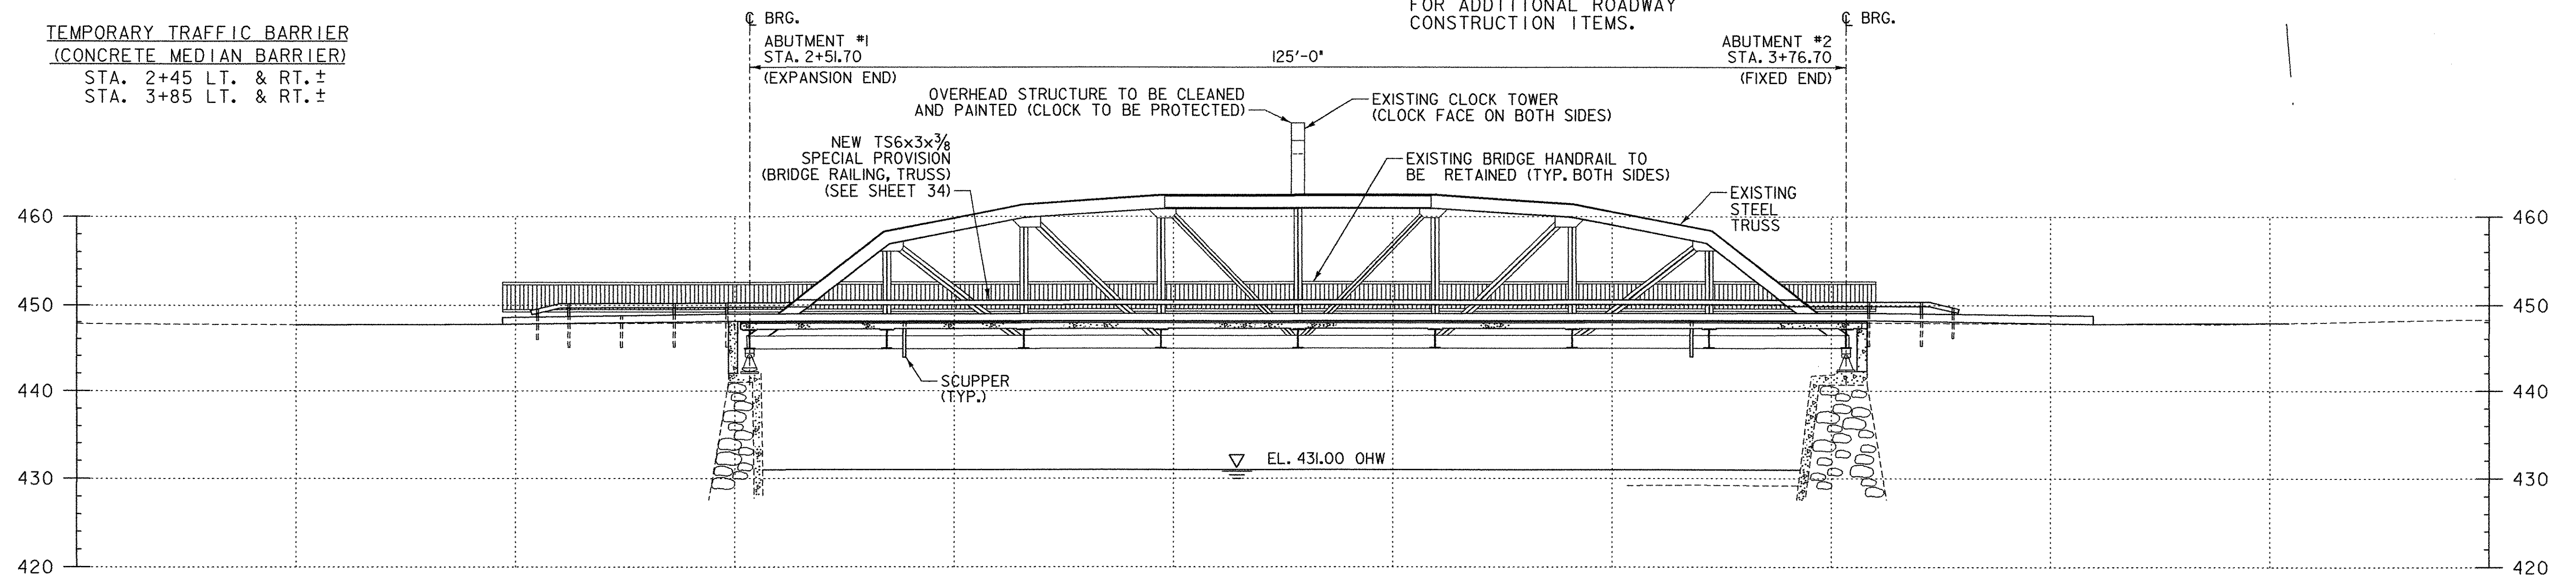

ELEVATION

SCALE 1" = 10'-0"
10 0 10



PROJECT NAME:	RICHFORD	FILE NAME:	...Design\Rich-plan.dgn	PLOT DATE:	12/18/2007
PROJECT NUMBER:	BHF 0302 (3) S	PROJECT LEADER:	MJC	DRAWN BY:	AET
		DESIGNED BY:	SEB	CHECKED BY:	MJC
		SITE PLAN AND ELEVATION			SHEET 8 OF 41

EROSION CONTROL NARRATIVE

1.1 PROJECT DESCRIPTION

THIS PROJECT IS LOCATED IN THE VILLAGE OF RICHFORD, ON MAIN STREET (T.H. #2) OVER THE MISSISQUOI RIVER, APPROXIMATELY 0.25 MILES NORTH OF THE INTERSECTION OF VT ROUTE 105 AND MAIN STREET (T.H. #2).

THIS PROJECT INVOLVES THE REMOVAL AND REPLACEMENT OF; THE BRIDGE DECK, THE TRUSS' BOTTOM CHORD AND THE TRUSS' FLOOR BEAMS AND STRINGERS. THE REPAIR AND PAINTING OF THE TRUSS' EXISTING STEEL, MINOR REPAIR OF THE EXISTING ABUTMENTS AND MINOR APPROACH RECONSTRUCTION. A DETOUR WITH A TEMPORARY BRIDGE WILL BE CONSTRUCTED TO THE SOUTHEAST OF THE EXISTING BRIDGE. THE ROADWAY ALIGNMENT WILL REMAIN THE SAME EXCEPT FOR A SLIGHT INCREASE (2.5') IN THE VERTICAL ALIGNMENT DUE TO THE INCREASE OF THE CROSS SLOPE ON THE BRIDGE TO 2% OR NORMAL CROWN.

NOTE: AREA OF DISTURBANCE SHALL INCLUDE LIMITS OF EARTH DISTURBANCE WITHIN THE PROJECT AREA INCLUDING ANY WASTE, STAGING, AND BORROW AREAS WITHIN OR DIRECTLY ADJACENT TO THE PROJECT LIMITS.

TOTAL AREA OF DISTURBANCE IS APPROXIMATELY 0.5 ACRES.

IT IS ANTICIPATED THAT THIS PROJECT WILL LAST ONE CONSTRUCTION SEASON.

1.2 SITE INVENTORY AND ANALYSIS

1.2.1 OFF SITE DRAINAGE CHARACTERISTICS (UP AND DOWN -GRADIENT)

THE AREA SURROUNDING THE PROJECT IS LOCATED IN AN URBAN AREA WITH MINIMAL GRASSY AREAS, AND SEVERAL ADJOINING GRAVEL OR PAVED PARKING LOTS. CONCRETE SIDEWALKS AND CURBS ARE LOCATED ON BOTH SIDES OF MAIN, RIVER AND PROVIDENCE STREETS WHICH ARE PAVED. THE APPROACHES ARE RELATIVELY FLAT WITH AN INCREASE IN GRADE AS YOU TRAVEL FURTHER NORTH OR SOUTH OF THE PROJECT, BEFORE FLATTENING OUT AGAIN. DIS ARE LOCATED ALONG THE CURB LINES OF ALL THE STREETS ON EACH SIDE OF THE RIVER. STORMWATER IS COLLECTED IN THESE DIS AND DISCHARGED INTO THE MISSISQUOI RIVER ON EITHER SIDE OF THE RIVER.

1.2.2 DRAINAGE, WATERWAYS BODIES OF WATER PROXIMITY TO NATURAL OR MAN-MADE WATER FEATURES

THE MISSISQUOIRIVER GOES DIRECTLY THROUGH THE PROJECT SITE AND IS THE ONLY WATER SOURCE ON THE PROJECT SITE. THE MISSISQUOIRIVER IS FLANKED BY BRICK OR STONE BUILDINGS CONSTRUCTED ON STONE RETAINING WALLS WHICH ALSO FORM THE BRIDGE'S ABUTMENTS. THESE RETAINING WALLS AND ABUTMENTS FORM THE RIVER'S BANKS. WHERE THERE ARE NO BUILDINGS OR RETAINING WALLS THE RIVER'S BANKS CONSIST OF STEEP LEDGE OR STEEP SLOPES COVERED WITH FLAT STONES FOR STABILIZATION. TREES ARE LOCATED AT THE TOP OF THE RIVER BANKS WHERE THERE ARE NO BUILDINGS.

1.2.3 TOPOGRAPHY, EXISTING ROADS, BUILDINGS, UTILITIES

THE TOPOGRAPHY OF THE AREA IS A SMALL RIVER VALLEY WITH GRADUAL SLOPES DESCENDING TOWARDS THE RIVER, WITH STEEP SLOPES AT THE RIVERS EDGE. PAVED VILLAGE STREETS (MAIN, RIVER AND PROVIDENCE) WITH CONCRETE CURBS AND SIDEWALKS ARE LOCATED ABOVE THE RIVER IN THE VALLEY AREA. BRICK AND WOODEN BUILDINGS ARE LOCATED ALONG THE STREETS WITH SEVERAL GRAVEL OR PAVED PARKING LOTS NEXT TO THE BUILDINGS AND THE RIVER. THERE ARE SEWER AND WATERLINES BURIED UNDER THE STREETS (THE WATERLINE CROSSES THE RIVER UNDER THE BRIDGE). THERE ARE OVERHEAD UTILITIES ALONG ALL THE ROADS AND THEY CROSS THE RIVER TO THE EAST OF THE BRIDGE.

1.2.4 VEGETATION

THE VEGETATION IN THE PROJECT AREA CONSISTS OF GRASS LAWNS AND HARDWOOD TREES AND UNDERGROWTH ON THE TOPS OF THE RIVER BANKS, WHERE NO BUILDINGS ARE LOCATED. THE IMPACT TO THE VEGETATION WILL BE LIMITED TO THAT WHICH IS DIRECTLY AFFECTED BY THE CONSTRUCTION OF THE DETOUR AND THE REPLACEMENT OF THE SIDEWALKS. DISTURBED VEGETATION WILL BE REESTABLISHED WITH STANDARD SEED AND MULCH PRACTICES.

1.2.5 SOILS

ALL SOIL DATA CAME FROM THE U.S. DEPARTMENT OF AGRICULTURE SOIL CONSERVATION SERVICE FOR THE COUNTY OF FRANKLIN, VERMONT. SOILS ON THE PROJECT SITE VARY BY LOCATION.

1.2.5 SOILS (CONTINUED)

THE HIGHLY ERODIBLE SOILS ARE ONDWA VARINAT SILT LOAM, SLOPES ARE NOT LISTED, "K FACTOR" = 0.37, EAST SIDE OF THE RIVER, RUMNEY VARIANT SILT LOAM, SLOPES ARE NOT LISTED, "K FACTOR" = 0.37, SOUTHEAST SIDE OF THE RIVER AND MUNSON SILT LOAM, 3% TO 8% SLOPES, "K FACTOR" = 0.49, NORTH SIDE OF THE RIVER. THE LOW ERODIBLE SOILS ARE DEERFIELD LOAMY FINE SAND, 0% TO 8%, "K FACTOR" = 0.17, EAST SIDE OF THE RIVER, WINDSOR LOAMY FINE SAND, 8% TO 15% SLOPES, "K FACTOR" = 0.17, EAST SIDE OF THE RIVER AND EXISTING GRAVEL AND SAND PLACED DURING THE CONSTRUCTION OF THE EXISTING ROADWAY, EXISTING GRAVEL PARKING LOT AND BRIDGE, SLOPES UNKNOWN, "K FACTOR" = 0.23 AND LESS.

NOTE: K-VALUES GENERALLY INDICATE THE FOLLOWING: 0.0 TO 0.23 = LOW EROSION POTENTIAL, 0.24 TO 0.36 = MODERATE EROSION POTENTIAL, 0.37 AND HIGHER = HIGHER EROSION POTENTIAL.

1.2.6 SENSITIVE RESOURCE AREAS

CRITICAL HABITATS - NO, HISTORICAL - THE EXISTING TRUSS BRIDGE IS A HISTORIC STRUCTURE, ARCHEOLOGICAL - THERE IS A KNOWN ARCHEOLOGICALLY SENSITIVE SITE OFF EASTERN AVENUE, SOUTH OF THE MUNICIPAL PARKING LOT (OUTSIDE OF PROJECT LIMITS), PRIME AGRICULTURAL LAND - NO, THREATENED AND ENDANGERED SPECIES - NO, WATER RESOURCE - MISSISQUOIRIVER - TEMPORARY PIER (APPROXIMATELY 300 SF IMPACT), WETLANDS - NO.

1.3 RISK EVALUATION

THIS PROJECT DOES NOT FALL UNDER THE JURISDICTION OF CONSTRUCTION GENERAL PERMIT 3-9020 BASED ON THE PROJECT IMPACT AREA. SHOULD CHANGES PRIOR TO OR DURING CONSTRUCTION RESULT IN ONE OR MORE ACRES OF EARTH DISTURBANCE OR SHOULD THE PROJECT BECOME PART OF A LARGER PLAN OF DEVELOPMENT THEN THE SELECTED CONTRACTOR WILL BE RESPONSIBLE FOR ADDITIONAL PERMITTING WITH VANR VIA FILING OF THE APPROPRIATE NOTICE OF INTENT UNDER THE CONSTRUCTION GENERAL PERMIT PROCESS.

1.4 EROSION PREVENTION AND SEDIMENT CONTROL

THE EROSION CONTROL PLANS ARE MEANT AS A GUIDELINE FOR PREVENTING EROSION AND CONTROLLING SEDIMENT TRANSPORT. THE WORK OUTLINED IN THIS NARRATIVE CONSISTS OF APPLYING MEASURES THROUGHOUT THE LIFE OF THE PROJECT MINIMIZING SEDIMENT TRANSPORT TO THE RECEIVING WATERS. THE MEASURES INCLUDE STABILIZATION AND STRUCTURAL PRACTICES, STORM WATER CONTROLS AND OTHER POLLUTION PREVENTION CONTROLS.

PREVENTING INITIAL SOIL EROSION IS MUCH MORE EFFECTIVE THAN TREATING ERODED SEDIMENT. MAINTAINING VEGETATED BUFFERS ALONG STREAM BANKS, WETLANDS, OR OTHER SENSITIVE AREAS IS A CRUCIAL EROSION AND SEDIMENT CONTROL MEASURE THAT SHOULD BE ESTABLISHED WHERE EVER POSSIBLE.

ALL MEASURES SHOULD BE REGULARLY MAINTAINED AND SHALL BE CHECKED FOR SEDIMENT BUILD-UP. SEDIMENT SHALL BE DISPOSED AT AN APPROVED SITE WHERE IT WILL NOT BE SUBJECT TO EROSION.

(REFER TO THE LOW RISK SITE HANDBOOK AND APPROPRIATE DETAIL SHEETS FOR EACH PRACTICE REQUIRED ON THE PROJECT TO INCLUDE BUT NOT LIMITED TO THE FOLLOWING):

1.4.1 MARK SITE BOUNDARIES

PROJECT DEMARCATION FENCING, DENOTED -PDF- ON THE PLANS, IS USED TO DELINEATE THE LIMITS THE CONTRACTOR CAN ACCESS WITH CONSTRUCTION EQUIPMENT. THIS MEASURE LIMITS THE AREA THAT CAN BE DISTURBED AND EXPOSED TO EROSION.

1.4.2 LIMIT DISTURBANCE AREA

EMPLOY TEMPORARY STABILIZATION PRACTICES IN INCREMENTAL STAGES (PHASING) AS CONSTRUCTION PROCEEDS. ADDITIONAL MEASURES MAY BE NEEDED DUE TO THE PHASING OF THE PROJECT AND AS DIRECTED BY THE ENGINEER.

1.4.3 STABILIZED CONSTRUCTION ENTRANCE

STABILIZED CONSTRUCTION ENTRANCE SHALL BE UTILIZED AS NECESSARY.

1.4.4 INSTALL SILT FENCE

SILT FENCE SHALL BE INSTALLED PRIOR TO ANY UP SLOPE WORK AS SHOWN ON THE PLANS OR AS NECESSARY.

1.4.5 DIVERT UPLAND RUNOFF

INSTALL A NEW PERMANENT DI, PRIOR TO THE DETOUR EXITING MAIN STREET, TO COLLECT ALL UPLAND STORMWATER RUNOFF. USE GRAVEL BAGS TO DIRECT AND/OR DIVERT OFF-SITE RUNOFF FROM ENTERING THE DISTURBED AREAS.

1.4.6 SLOW DOWN CHANNELIZED RUNOFF

CHECK DAMS SHALL BE UTILIZED AS NECESSARY.

1.4.7 CONSTRUCT PERMANENT CONTROLS

SEED AND MULCH
NEW DRAINAGE INLET AND PIPING

1.4.8 STABILIZE EXPOSED SOILS

SEED AND MULCH
EROSION MATTING

TRACKING OF ALL EXPOSED SLOPES, COMBINED WITH TEMPORARY MULCHING, WILL BE UTILIZED ON A REGULAR BASIS. SLOPES SHALL BE STABILIZED WITHIN 48 HOURS OF FORECASTED RAIN. SEEDING, MULCHING AND BIODEGRADABLE EROSION CONTROL MATTING OR AN EQUIVALENT SHALL BE USED TO STABILIZE ALL SLOPES STEEPER THAN 1:3. THESE SLOPES SHALL BE STABILIZED WITHIN 48 HOURS OF REACHING INTERMITTENT PHASES OF CONSTRUCTION.

1.4.9 WINTER STABILIZATION

VARIOUS MEASURES SPECIFIC TO WINTER (SEE LOW RISK HANDBOOK)

1.4.10 STABILIZE SOIL AT FINAL GRADE

SEED AND MULCH
EROSION MATTING

SEEDING, MULCHING AND BIODEGRADABLE EROSION CONTROL MATTING OR AN EQUIVALENT SHALL BE USED TO STABILIZE ALL SLOPES STEEPER THAN 1:3. THESE SLOPES SHALL BE STABILIZED WITHIN 48 HOURS OF REACHING FINAL GRADE.

1.4.11 DE-WATERING ACTIVITIES

A FILTER BAG WILL BE USED IN THE EVENT THAT IT IS NECESSARY TO DEWATER BEHIND THE ABUTMENTS. A SEDIMENT BASIN SHALL BE USED FOR THE TEMPORARY PIER WORK AS NECESSARY.

1.4.12 INSPECT YOUR SITE


INSPECT SITE BASED ON PERMIT AUTHORIZATION OR SPECIAL PROVISION REQUIREMENTS.

EPSC NARRATIVE

PROJECT NAME: RICHFORD
PROJECT NUMBER: BHF 0302 (3) S

FILE NAME: ...Design\rich-eronar.dgn PLOT DATE: 12/18/2007
PROJECT LEADER: MJC DRAWN BY: JTS
DESIGNED BY: SEB CHECKED BY: MJC
EPSC NARRATIVE SHEET 9 OF 41



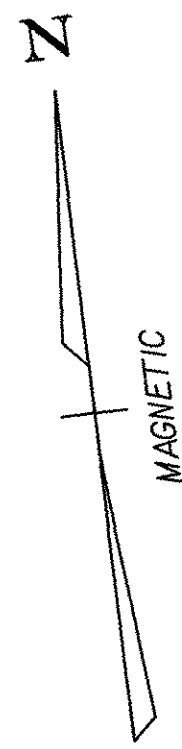

SOIL CLASSIFICATION
(NORTH SIDE OF RIVER)

MUNSON SILT LOAM
3% - 8% SLOPES
K FACTOR 0.49
CLASSIFIED HIGHLY ERODIBLE

SOIL CLASSIFICATION
(EAST SIDE OF RIVER)

DEERFIELD LOAMY FINE SAND
0% - 8% SLOPES
K FACTOR 0.17
CLASSIFIED LOW ERODIBLE

SOIL CLASSIFICATION
(EAST SIDE OF RIVER)

WINDSOR LOAMY FINE SAND
8% - 15% SLOPES
K FACTOR 0.17
CLASSIFIED LOW ERODIBLE

SOIL CLASSIFICATION
(SOUTHWEST SIDE OF RIVER)

ONDAWA VARIANT SILT LOAM
SLOPES NOT LISTED
K FACTOR 0.37
CLASSIFIED HIGHLY ERODIBLE

SOIL CLASSIFICATION
(SOUTHEAST SIDE OF RIVER)

RUMNEY VARIANT SILT LOAM
SLOPES NOT LISTED
K FACTOR 0.37
CLASSIFIED HIGHLY ERODIBLE


HISTORIC RESOURCE
STEEL TRUSS BRIDGE
TO BE REHABILITATED

NEW CROSSWALK
MARKING
TO REMAIN
AFTER PROJECT

~KNOWN ARCHEOLOGICALLY SENSITIVE
SITE TO BE AVOIDED~


--- LIMITS OF ARCHEOLOGICALLY
SENSITIVE SITE

VERTICAL DATUM - NAVD88

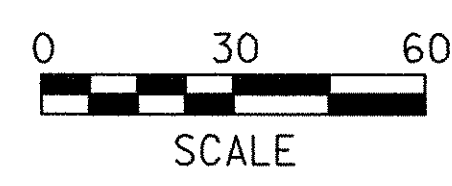

EPSC EXISTING CONDITIONS SITE PLAN

PROJECT NAME: RICHFORD
PROJECT NUMBER: BHF 0302 (3) S
FILE NAME: ...NPlotFiles\Rich-exist.ptf PLOT DATE: 12/18/2007
PROJECT LEADER: MJC DRAWN BY: JTS
DESIGNED BY: SEB CHECKED BY: MJC
EPSC EXISTING CONDITIONS SITE PLAN SHEET 10 OF 41

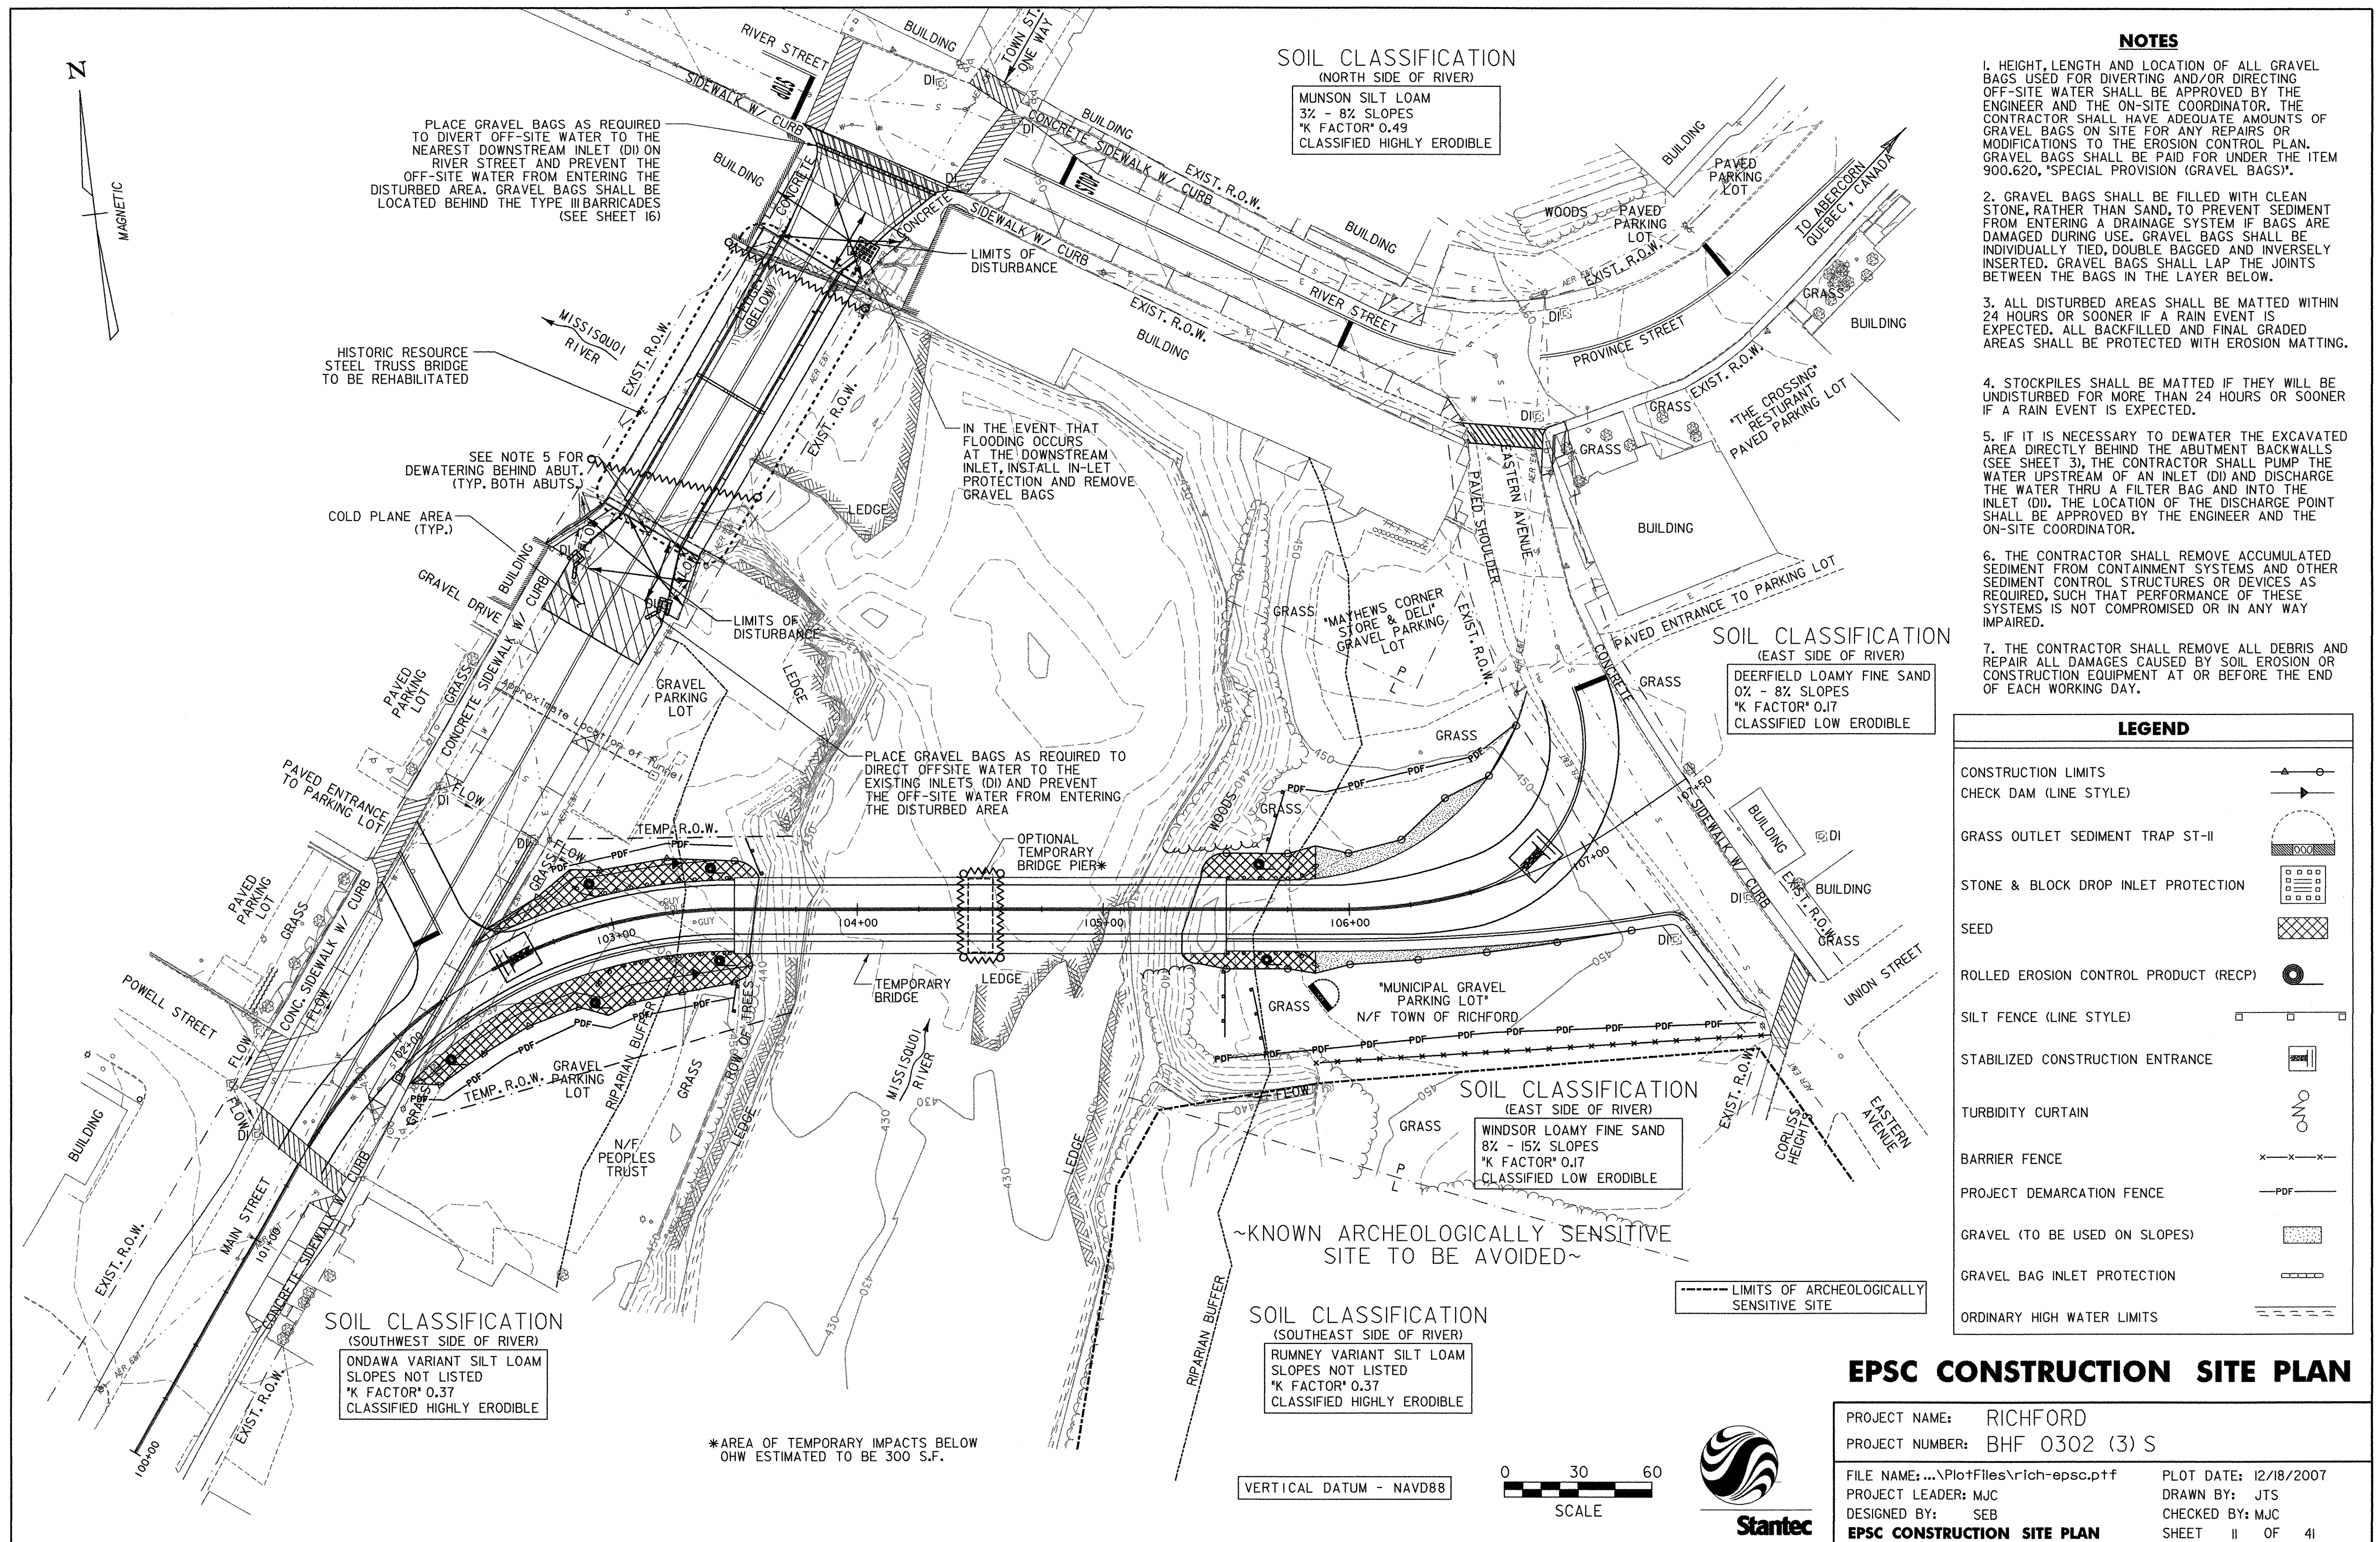

NOTES


1. HEIGHT, LENGTH AND LOCATION OF ALL GRAVEL BAGS USED FOR DIVERTING AND/OR DIRECTING OFF-SITE WATER SHALL BE APPROVED BY THE ENGINEER AND THE ON-SITE COORDINATOR. THE CONTRACTOR SHALL HAVE ADEQUATE AMOUNTS OF GRAVEL BAGS ON SITE FOR ANY REPAIRS OR MODIFICATIONS TO THE EROSION CONTROL PLAN. GRAVEL BAGS SHALL BE PAID FOR UNDER THE ITEM 900.620, 'SPECIAL PROVISION (GRAVEL BAGS)'.
2. GRAVEL BAGS SHALL BE FILLED WITH CLEAN STONE, RATHER THAN SAND, TO PREVENT SEDIMENT FROM ENTERING A DRAINAGE SYSTEM IF BAGS ARE DAMAGED DURING USE. GRAVEL BAGS SHALL BE INDIVIDUALLY TIED, DOUBLE BAGGED AND INVERSELY INSERTED. GRAVEL BAGS SHALL LAP THE JOINTS BETWEEN THE BAGS IN THE LAYER BELOW.
3. ALL DISTURBED AREAS SHALL BE MATTED WITHIN 24 HOURS OR SOONER IF A RAIN EVENT IS EXPECTED. ALL BACKFILLED AND FINAL GRADED AREAS SHALL BE PROTECTED WITH EROSION MATTING.
4. STOCKPILES SHALL BE MATTED IF THEY WILL BE UNDISTURBED FOR MORE THAN 24 HOURS OR SOONER IF A RAIN EVENT IS EXPECTED.
5. IF IT IS NECESSARY TO DEWATER THE EXCAVATED AREA DIRECTLY BEHIND THE ABUTMENT BACKWALLS (SEE SHEET 3), THE CONTRACTOR SHALL PUMP THE WATER UPSTREAM OF AN INLET (DI) AND DISCHARGE THE WATER THRU A FILTER BAG AND INTO THE INLET (DI). THE LOCATION OF THE DISCHARGE POINT SHALL BE APPROVED BY THE ENGINEER AND THE ON-SITE COORDINATOR.
6. THE CONTRACTOR SHALL REMOVE ACCUMULATED SEDIMENT FROM CONTAINMENT SYSTEMS AND OTHER SEDIMENT CONTROL STRUCTURES OR DEVICES AS REQUIRED, SUCH THAT PERFORMANCE OF THESE SYSTEMS IS NOT COMPROMISED OR IN ANY WAY IMPAIRED.
7. THE CONTRACTOR SHALL REMOVE ALL DEBRIS AND REPAIR ALL DAMAGES CAUSED BY SOIL EROSION OR CONSTRUCTION EQUIPMENT AT OR BEFORE THE END OF EACH WORKING DAY.

LEGEND

CONSTRUCTION LIMITS	
CHECK DAM (LINE STYLE)	
GRASS OUTLET SEDIMENT TRAP ST-II	
STONE & BLOCK DROP INLET PROTECTION	
SEED	
ROLLED EROSION CONTROL PRODUCT (RECP)	
SILT FENCE (LINE STYLE)	
STABILIZED CONSTRUCTION ENTRANCE	
TURBIDITY CURTAIN	
BARRIER FENCE	
PROJECT DEMARCATION FENCE	
GRAVEL (TO BE USED ON SLOPES)	
GRAVEL BAG INLET PROTECTION	
ORDINARY HIGH WATER LIMITS	

EPSC CONSTRUCTION SITE PLAN

PROJECT NAME: RICHFORD
 PROJECT NUMBER: BHF 0302 (3) S
 FILE NAME: ... \PilotFiles\Rich-epsc.pxf PLOT DATE: 12/18/2007
 PROJECT LEADER: MJC DRAWN BY: JTS
 DESIGNED BY: SEB CHECKED BY: MJC
EPSC CONSTRUCTION SITE PLAN SHEET 11 OF 41

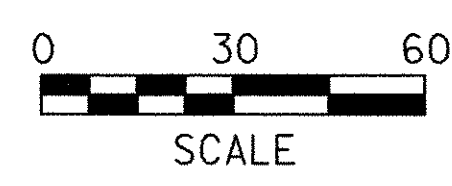

VERTICAL DATUM - NAVD88

*AREA OF TEMPORARY IMPACTS BELOW OHW ESTIMATED TO BE 300 S.F.

SOIL CLASSIFICATION
(NORTH SIDE OF RIVER)
MUNSON SILT LOAM
3% - 8% SLOPES
K FACTOR 0.49
CLASSIFIED HIGHLY ERODIBLE

SOIL CLASSIFICATION
(EAST SIDE OF RIVER)
DEERFIELD LOAMY FINE SAND
0% - 8% SLOPES
K FACTOR 0.17
CLASSIFIED LOW ERODIBLE

SOIL CLASSIFICATION
(EAST SIDE OF RIVER)
WINDSOR LOAMY FINE SAND
8% - 15% SLOPES
K FACTOR 0.17
CLASSIFIED LOW ERODIBLE

SOIL CLASSIFICATION
(SOUTHWEST SIDE OF RIVER)
ONDAWA VARIANT SILT LOAM
SLOPES NOT LISTED
K FACTOR 0.37
CLASSIFIED HIGHLY ERODIBLE

SOIL CLASSIFICATION
(SOUTHEAST SIDE OF RIVER)
RUMNEY VARIANT SILT LOAM
SLOPES NOT LISTED
K FACTOR 0.37
CLASSIFIED HIGHLY ERODIBLE

PLACE GRAVEL BAGS AS REQUIRED TO DIVERT OFF-SITE WATER TO THE NEAREST DOWNSTREAM INLET (DI) ON RIVER STREET AND PREVENT THE OFF-SITE WATER FROM ENTERING THE DISTURBED AREA. GRAVEL BAGS SHALL BE LOCATED BEHIND THE TYPE III BARRICADES (SEE SHEET 16)

IN THE EVENT THAT FLOODING OCCURS AT THE DOWNSTREAM INLET, INSTALL IN-LET PROTECTION AND REMOVE GRAVEL BAGS

PLACE GRAVEL BAGS AS REQUIRED TO DIRECT OFF-SITE WATER TO THE EXISTING INLETS (DI) AND PREVENT THE OFF-SITE WATER FROM ENTERING THE DISTURBED AREA

HISTORIC RESOURCE STEEL TRUSS BRIDGE TO BE REHABILITATED

SEE NOTE 5 FOR DEWATERING BEHIND ABUT. (TYP. BOTH ABUTS.)

~KNOWN ARCHEOLOGICALLY SENSITIVE SITE TO BE AVOIDED~



SOIL CLASSIFICATION
(NORTH SIDE OF RIVER)

MUNSON SILT LOAM
3% - 8% SLOPES
K FACTOR 0.49
CLASSIFIED HIGHLY ERODIBLE

SOIL CLASSIFICATION
(EAST SIDE OF RIVER)

DEERFIELD LOAMY FINE SAND
0% - 8% SLOPES
K FACTOR 0.17
CLASSIFIED LOW ERODIBLE

SOIL CLASSIFICATION
(EAST SIDE OF RIVER)

WINDSOR LOAMY FINE SAND
8% - 15% SLOPES
K FACTOR 0.17
CLASSIFIED LOW ERODIBLE

SOIL CLASSIFICATION
(SOUTHWEST SIDE OF RIVER)

ONDAWA VARIANT SILT LOAM
SLOPES NOT LISTED
K FACTOR 0.37
CLASSIFIED HIGHLY ERODIBLE

SOIL CLASSIFICATION
(SOUTHEAST SIDE OF RIVER)

RUMNEY VARIANT SILT LOAM
SLOPES NOT LISTED
K FACTOR 0.37
CLASSIFIED HIGHLY ERODIBLE



EPSC FINAL CONDITIONS SITE PLAN

PROJECT NAME: RICHFORD
PROJECT NUMBER: BHF 0302 (3) S

FILE NAME: ...\\PlotFiles\Rich-final.plt
PROJECT LEADER: MJC
DESIGNED BY: SEB
PLOT DATE: 12/18/2007
DRAWN BY: JTS
CHECKED BY: MJC
EPSC FINAL CONDITIONS SITE PLAN
SHEET 12 OF 41


DISTURBED AREAS REQUIRING RE-VEGETATION

VERTICAL DATUM - NAVD88

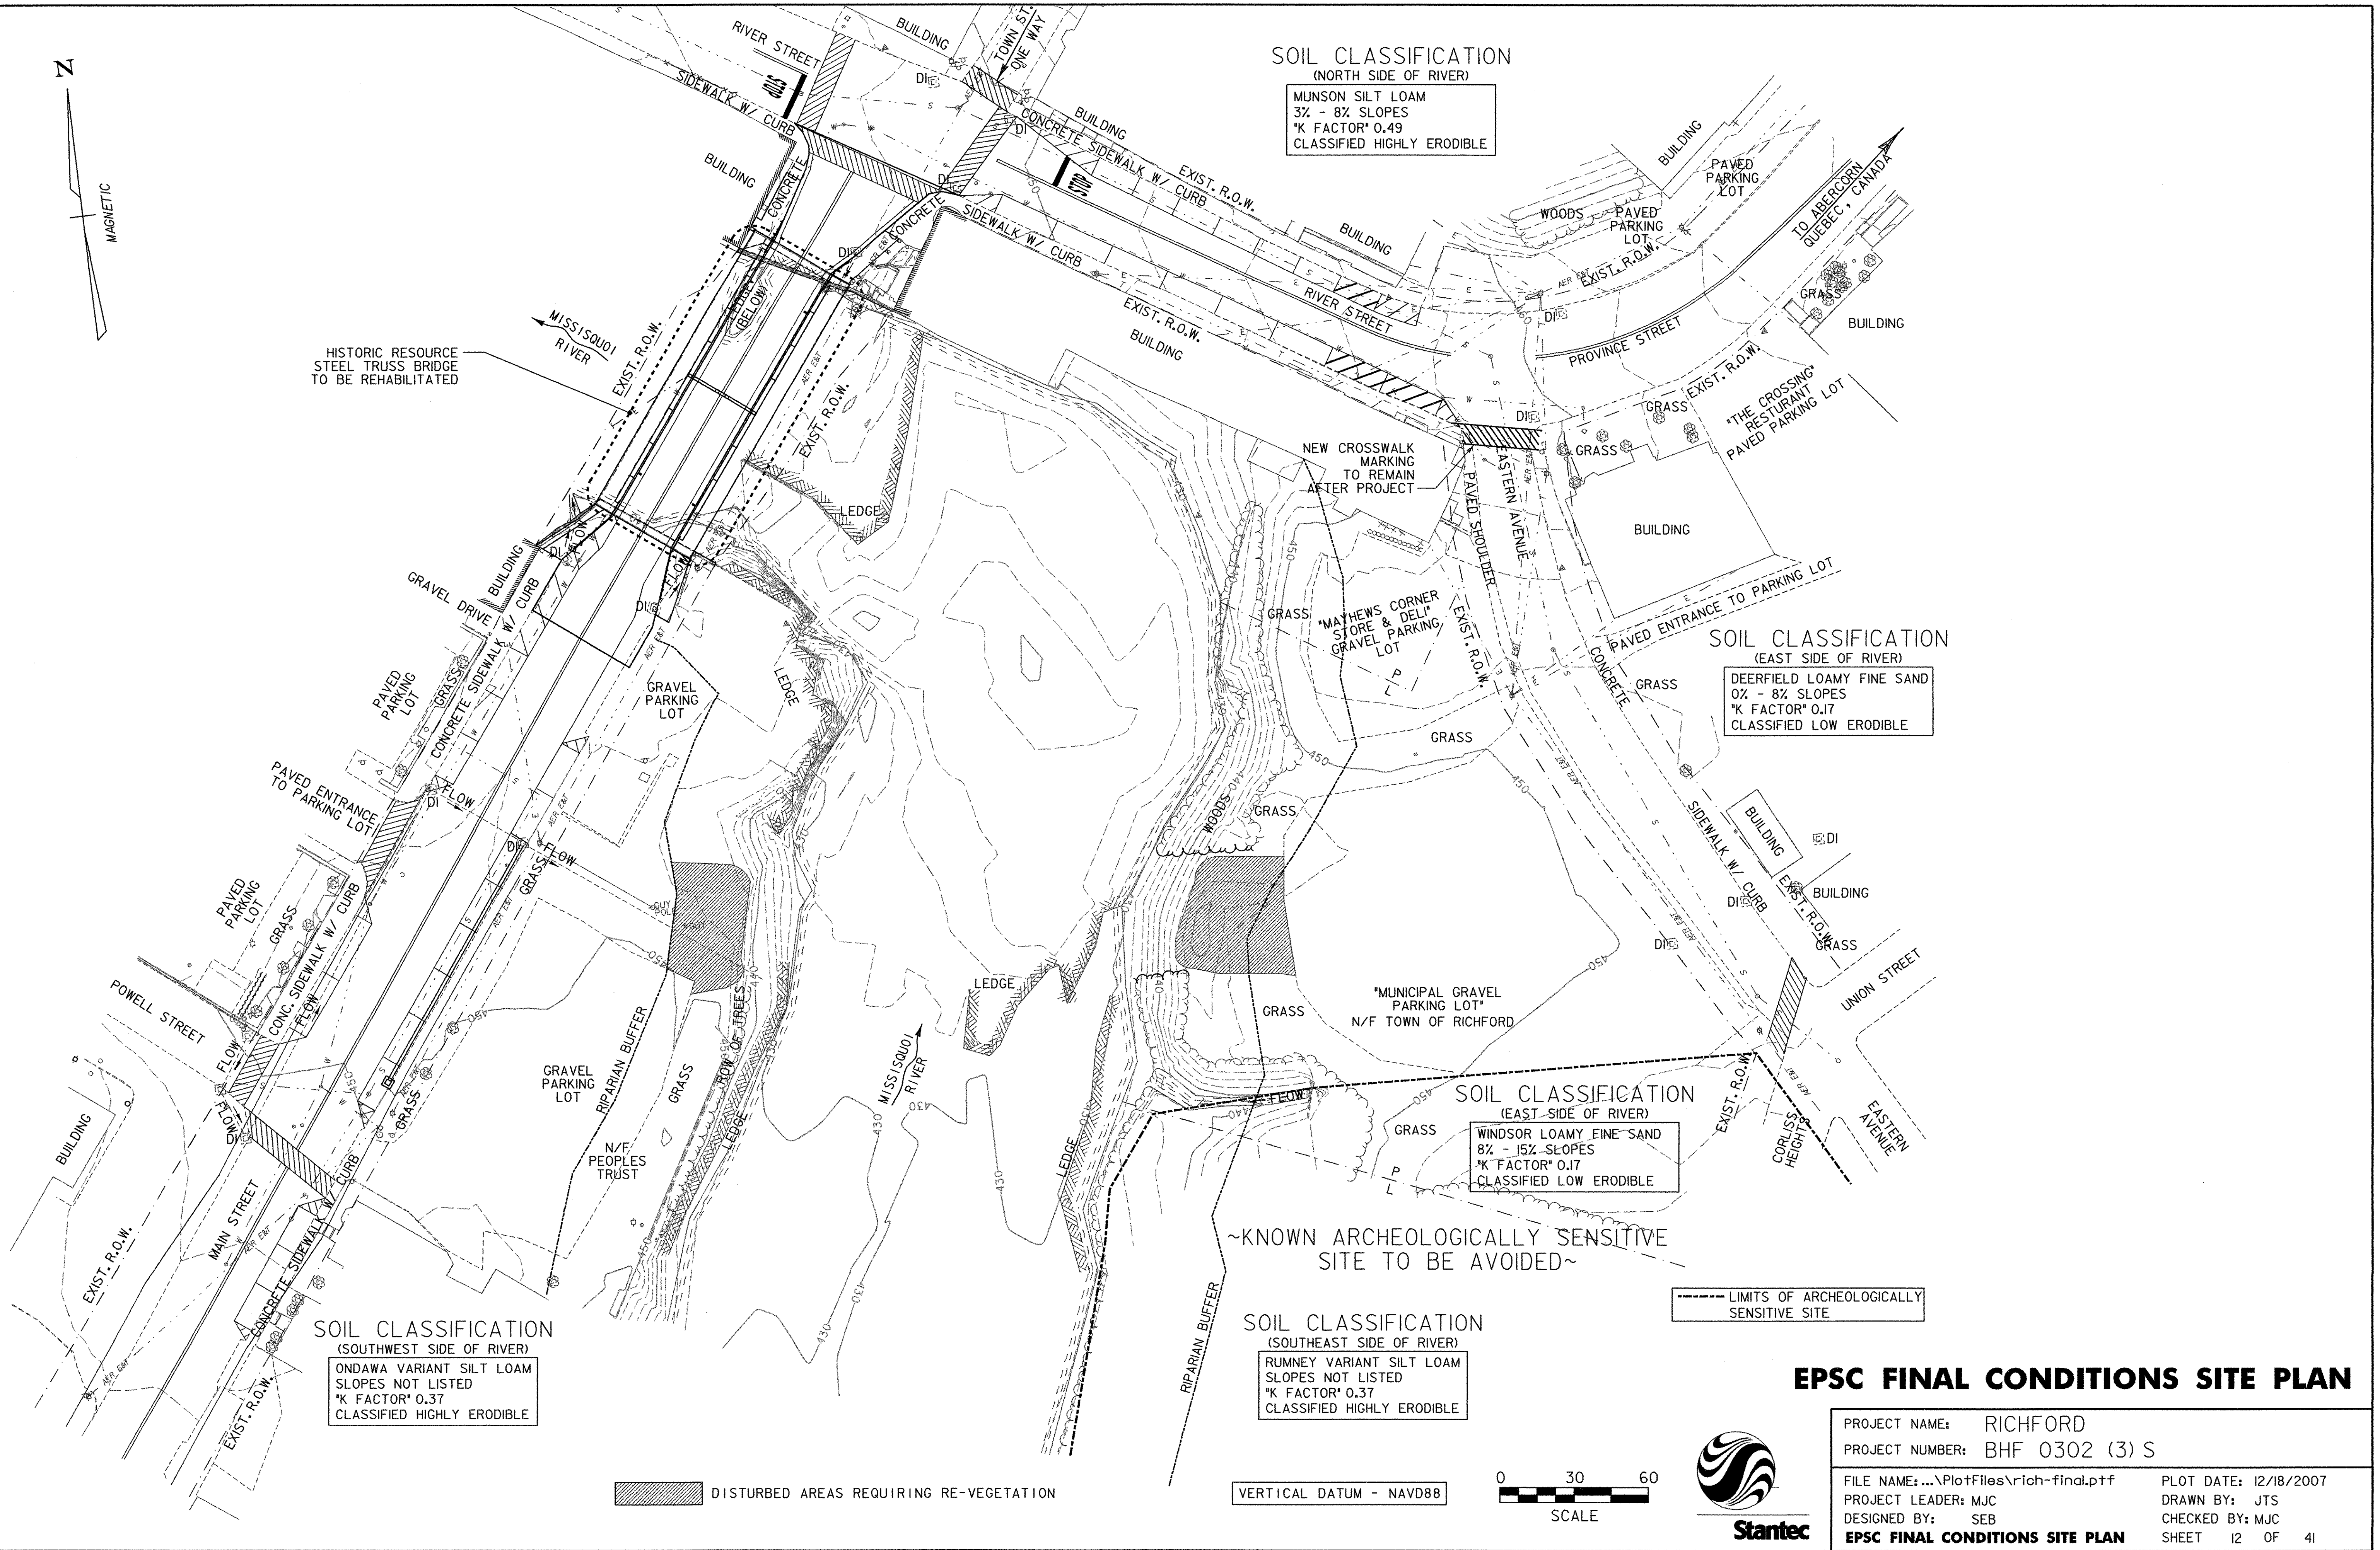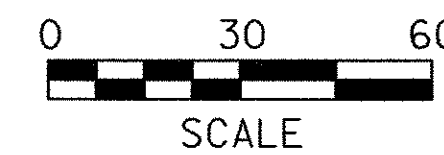

~KNOWN ARCHEOLOGICALLY SENSITIVE SITE TO BE AVOIDED~

--- LIMITS OF ARCHEOLOGICALLY SENSITIVE SITE

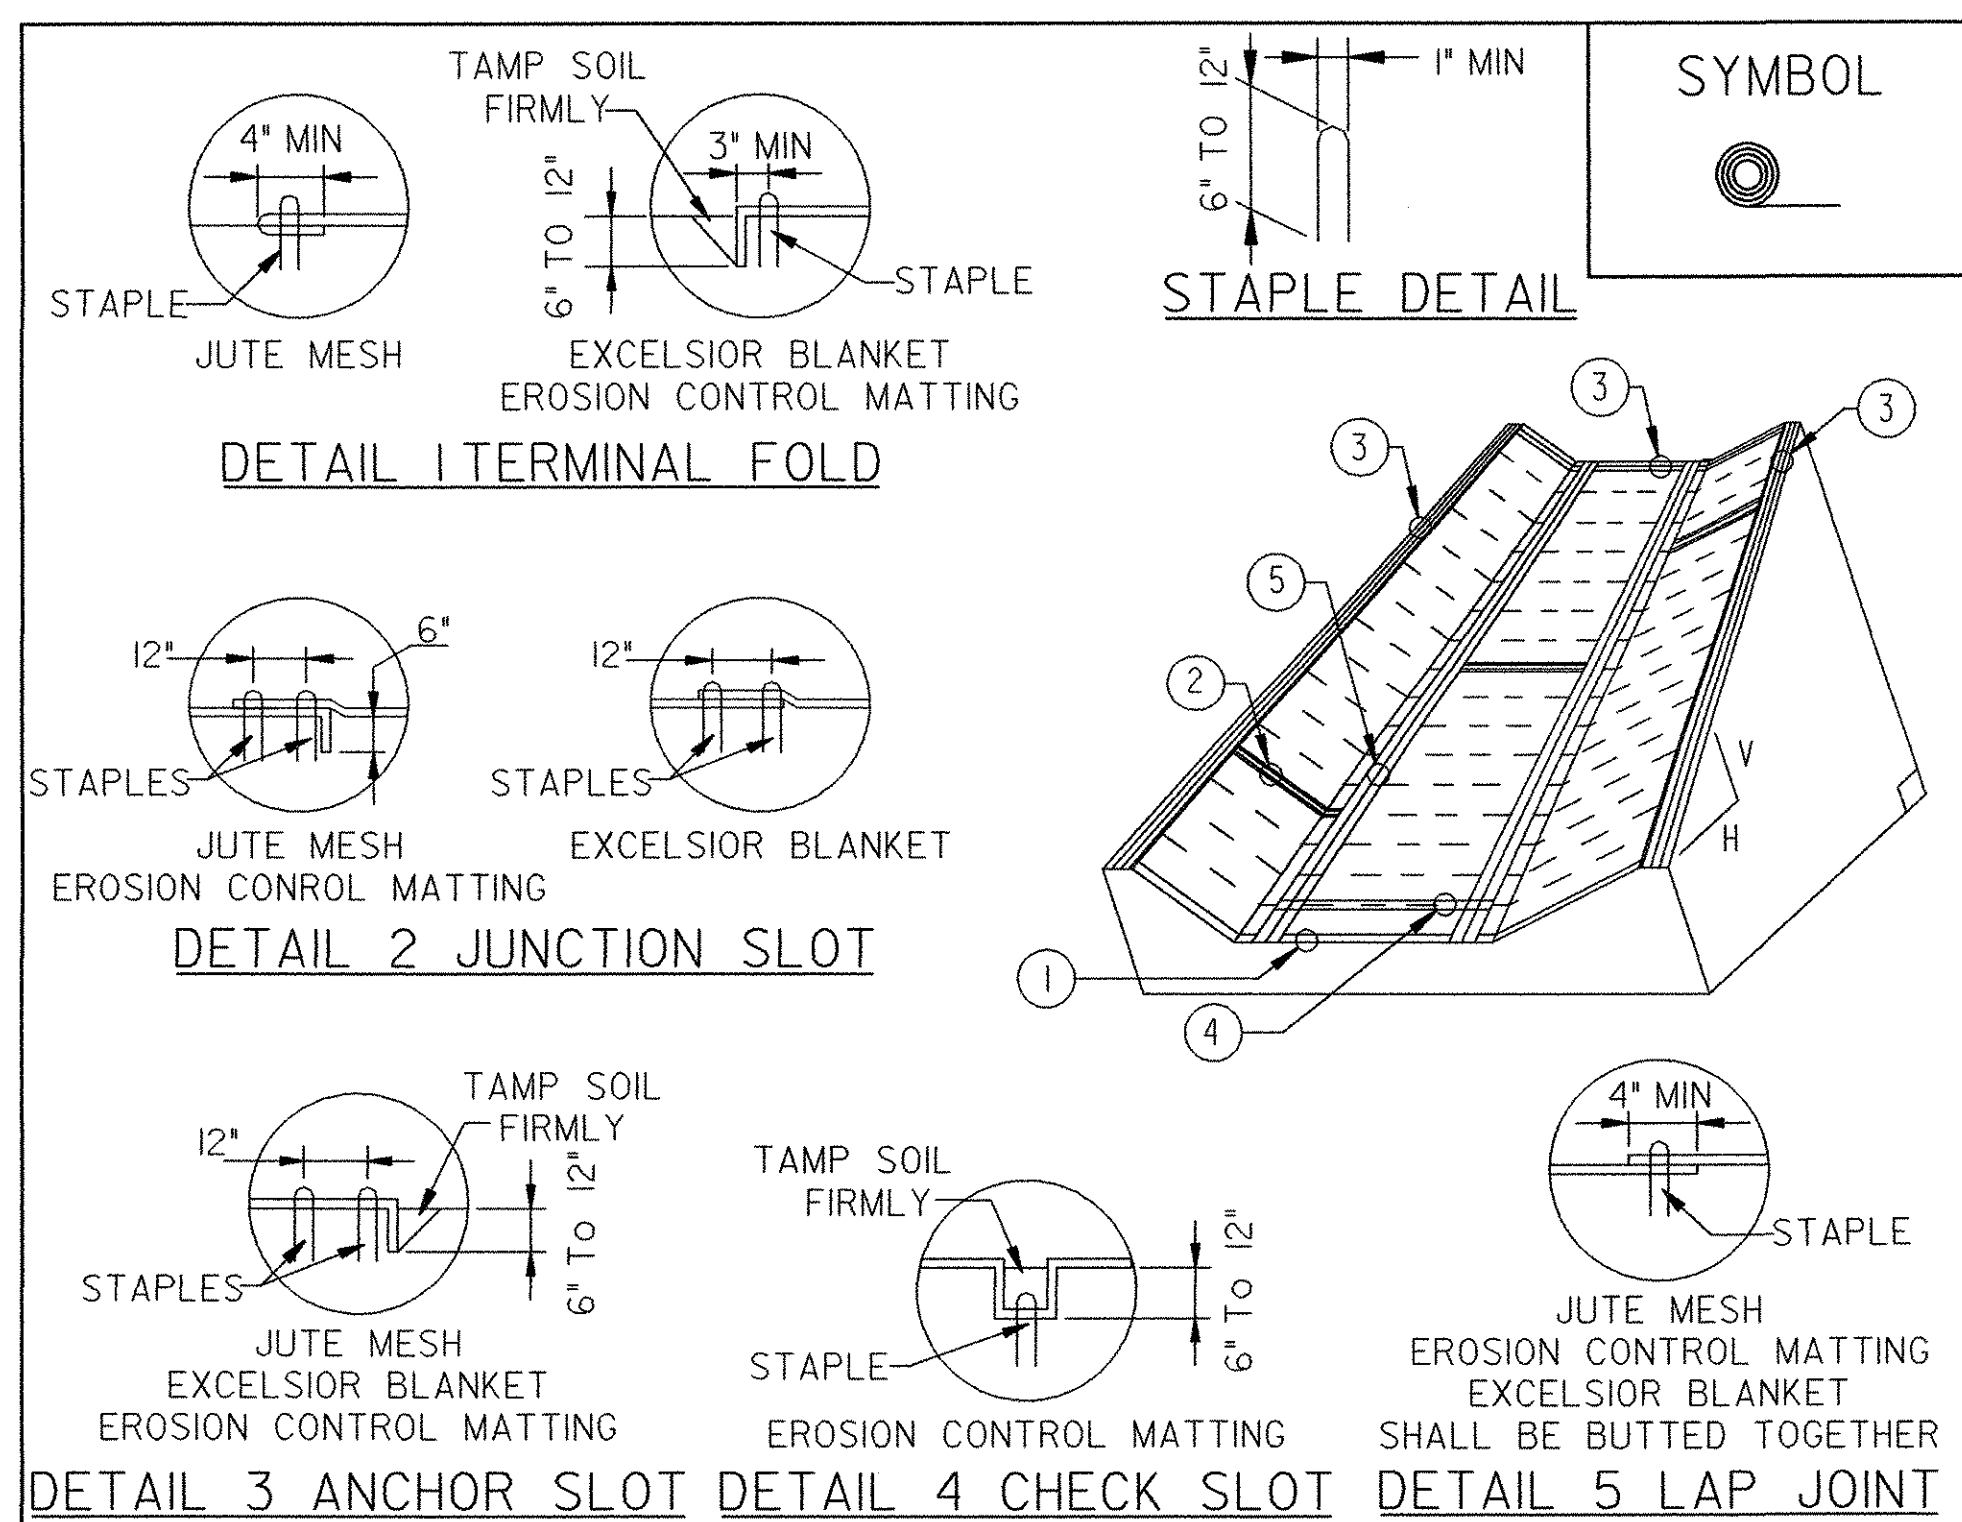

CONSTRUCTION SPECIFICATIONS

1. EROSION MATTING, CHECK SLOTS, SHALL BE SPACED IN DITCH CHANNEL SO THAT ONE OCCURS WITHIN EACH 50' ON SLOPES OF MORE THAN 4% AND LESS THAN 6%. ON SLOPES OF 6% OR MORE, THEY SHALL BE SPACED SO THAT ONE OCCURS WITHIN EACH 25'.
2. APPLY FERTILIZER, LIME SEED PRIOR TO PLACING MATTING.
3. STAPLES ARE TO BE PLACED ALTERNATELY, IN COLUMNS APPROXIMATELY 2' APART AND IN ROWS APPROXIMATELY 3' APART. APPROXIMATELY 175 STAPLES ARE REQUIRED PER 4'X225' ROLL OF MATERIAL AND 125 STAPLES ARE REQUIRED PER 4'X150' ROLL OF MATERIAL.
4. DISTURBED AREAS SHALL BE SMOOTHLY GRADED. EROSION CONTROL MATERIAL SHALL BE PLACED LOOSELY OVER GROUND SURFACE. DO NOT STRETCH.
5. ALL TERMINAL ENDS AND TRANSVERSE LAPS SHALL BE STAPLED AT APPROXIMATELY 12" INTERVALS.


ADAPTED FROM DETAILS PROVIDED BY: ILLINOIS USDA-NRCS
ORIGINALLY DEVELOPED BY USDA-NRCS
VERMONT DEPARTMENT OF ENVIRONMENTAL CONSERVATION

ROLLED EROSION CONTROL PRODUCT (RECP) DITCH

NOTES:
REFER TO "THE VERMONT STANDARDS & SPECIFICATIONS FOR EROSION PREVENTION & SEDIMENT CONTROL -2006- " FROM THE VT AGENCY OF NATURAL RESOURCES FOR ADDITIONAL GUIDANCE.

THIS ITEM SHALL BE PAID FOR UNDER ITEM
653.20 TEMPORARY EROSION MATTING

REVISIONS		
MARCH 8, 2007	JMF	
APRIL 16, 2007	WHF	

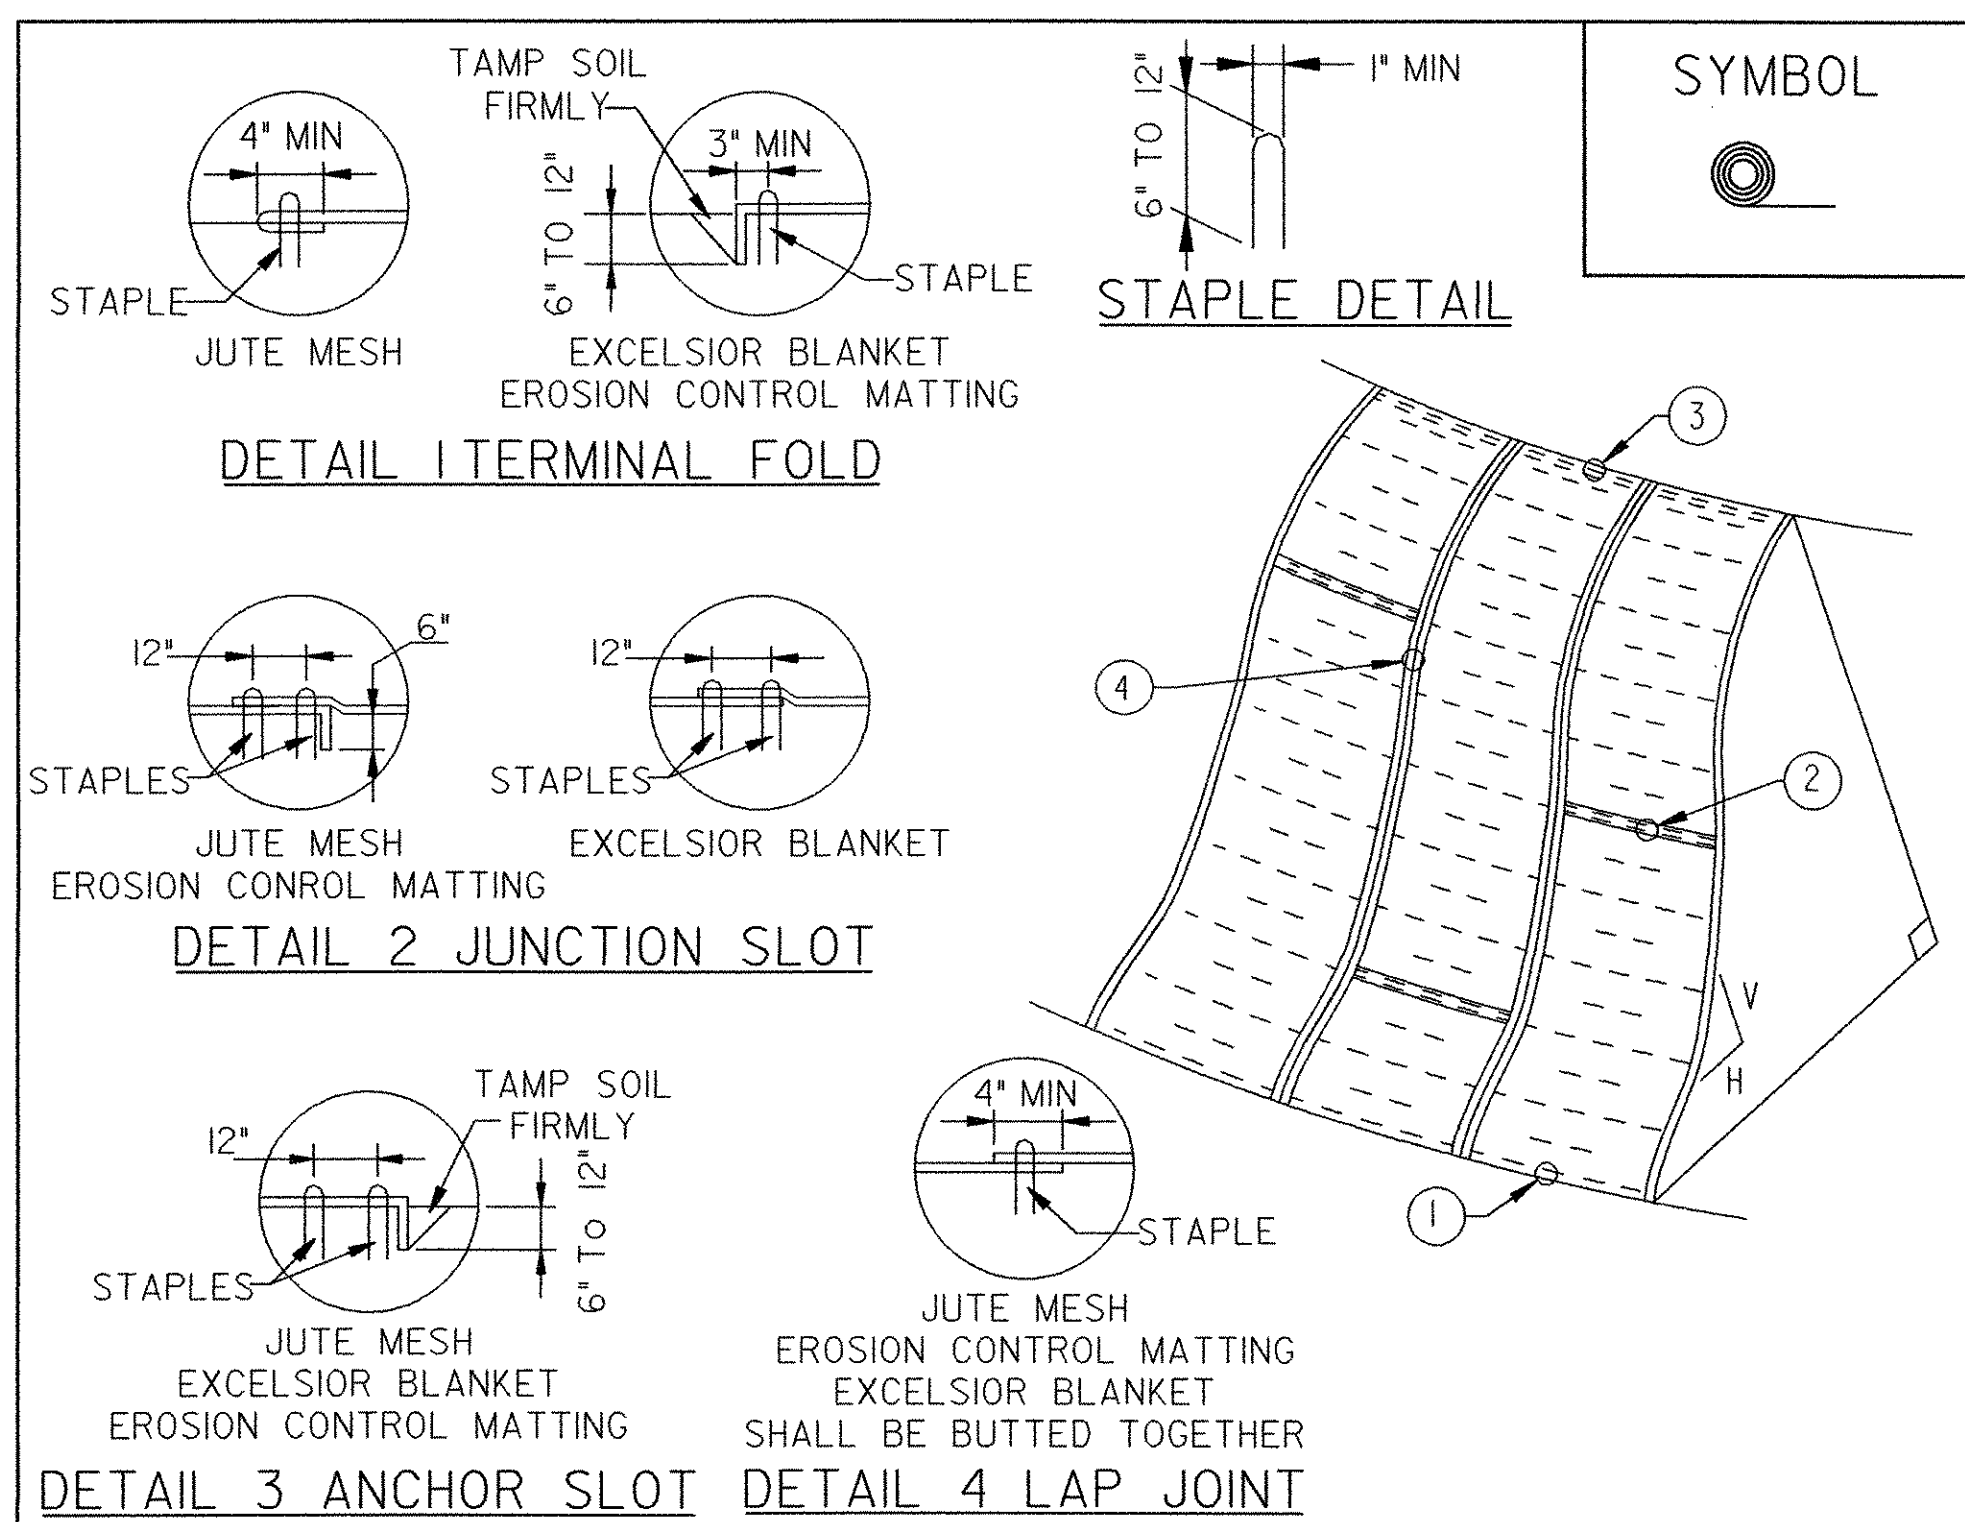

CONSTRUCTION SPECIFICATIONS

1. APPLY TO SLOPES GREATER THAN 3H:1V OR WHERE NECESSARY TO AID IN ESTABLISHING VEGETATION.
2. APPLY FERTILIZER, LIME AND SEED PRIOR TO PLACING MATTING.
3. STAPLES ARE TO BE PLACED ALTERNATELY, IN COLUMNS APPROXIMATELY 2' APART AND IN ROWS APPROXIMATELY 3' APART. APPROXIMATELY 175 STAPLES ARE REQUIRED PER 4'X225' ROLL OF MATERIAL AND 125 STAPLES ARE REQUIRED PER 4'X150' ROLL OF MATERIAL.
4. DISTURBED AREAS SHALL BE SMOOTHLY GRADED. EROSION CONTROL MATERIAL SHALL BE PLACED LOOSELY OVER GROUND SURFACE. DO NOT STRETCH.
5. ALL TERMINAL ENDS AND TRANSVERSE LAPS SHALL BE STAPLED AT APPROXIMATELY 12" INTERVALS.


ADAPTED FROM DETAILS PROVIDED BY: ILLINOIS USDA-NRCS
ORIGINALLY DEVELOPED BY USDA-NRCS
VERMONT DEPARTMENT OF ENVIRONMENTAL CONSERVATION

ROLLED EROSION CONTROL PRODUCT (RECP) SIDE SLOPE

NOTES:
REFER TO "THE VERMONT STANDARDS & SPECIFICATIONS FOR EROSION PREVENTION & SEDIMENT CONTROL -2006- " FROM THE VT AGENCY OF NATURAL RESOURCES FOR ADDITIONAL GUIDANCE.

THIS ITEM SHALL BE PAID FOR UNDER ITEM
653.20 TEMPORARY EROSION MATTING

NEW		
APRIL 16, 2007	WHF	

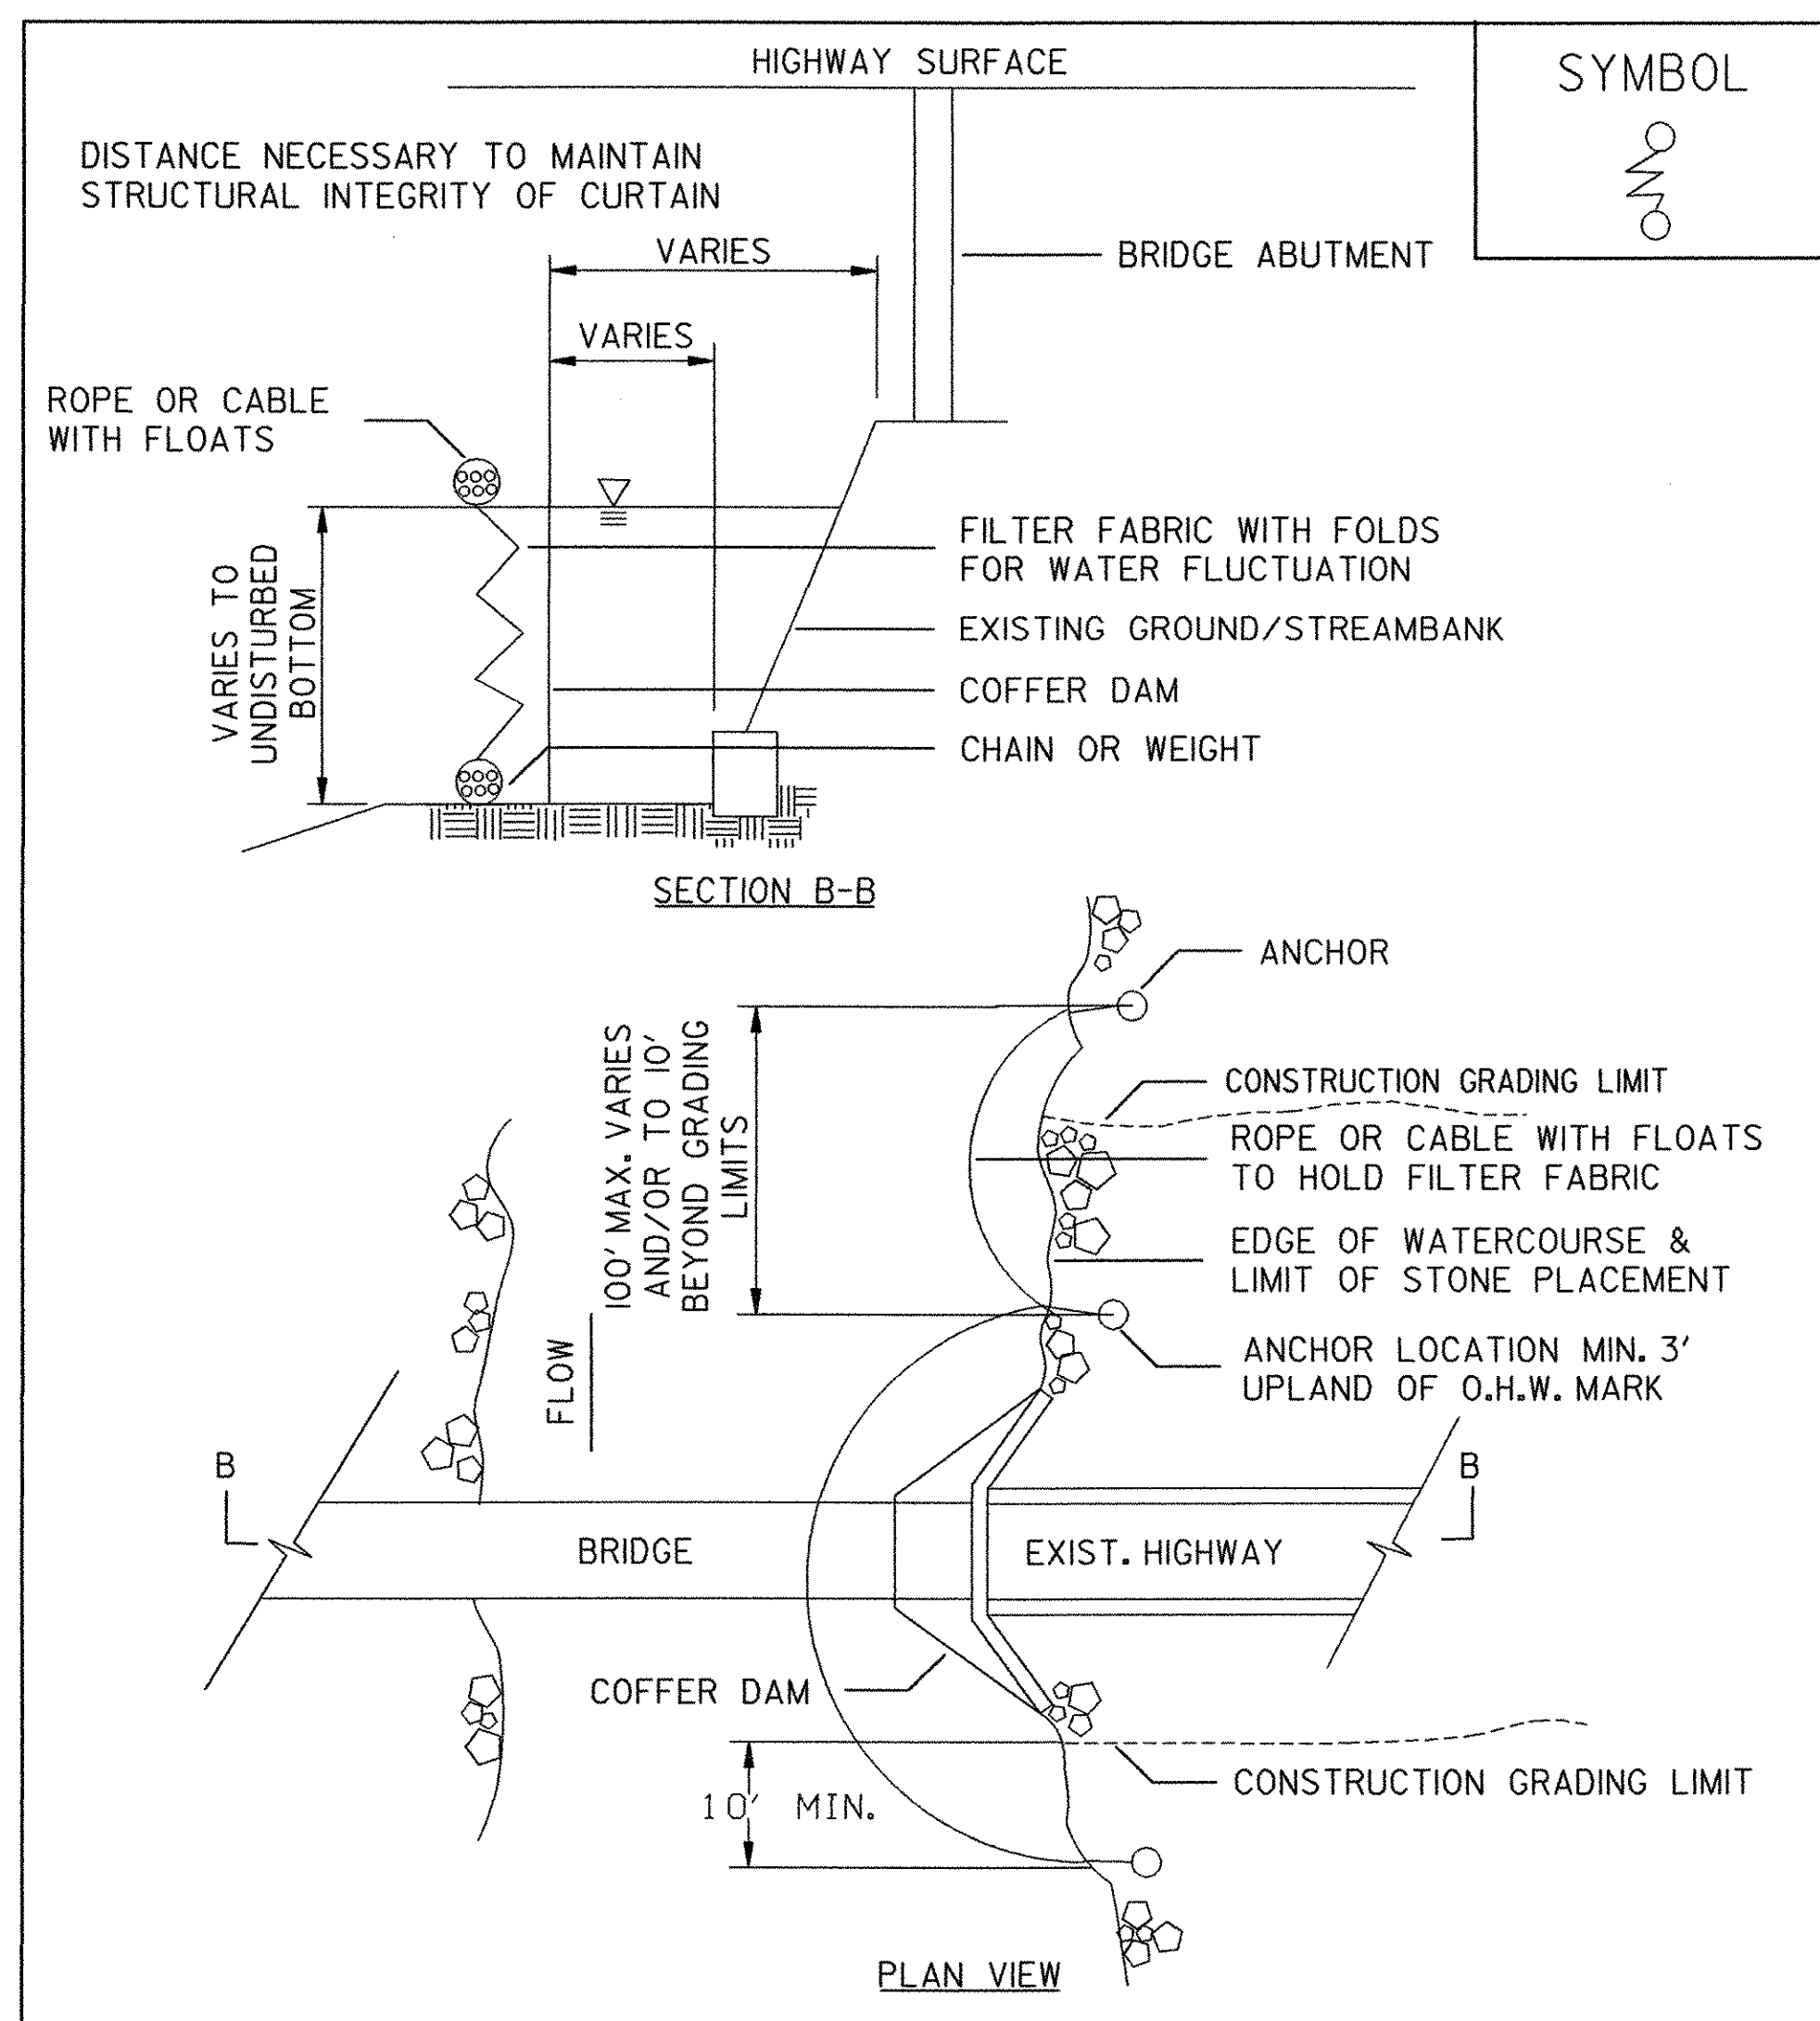

ADAPTED FROM DETAILS PROVIDED BY: NEW YORK STATE DEC
ORIGINALLY DEVELOPED BY USDA-NRCS
VERMONT AGENCY OF TRANSPORTATION


TURBIDITY CURTAIN

NOTES:
THIS ITEM SHALL BE PAID FOR UNDER ITEM
649.61 GEOTEXTILE FOR FILTER CURTAIN



EPSC DETAIL SHEETS

PROJECT NAME:	RICHFORD	PLOT DATE:	12/18/2007
PROJECT NUMBER:	BHF 0302 (3) S	DRAWN BY:	JTS
FILE NAME:	...Design\rich-erodet.dgn	CHECKED BY:	MJC
PROJECT LEADER:	MJC	DESIGNED BY:	SEB
DESIGNED BY:	SEB	EPSC DETAILS SHEET 1	SHEET 13 OF 41

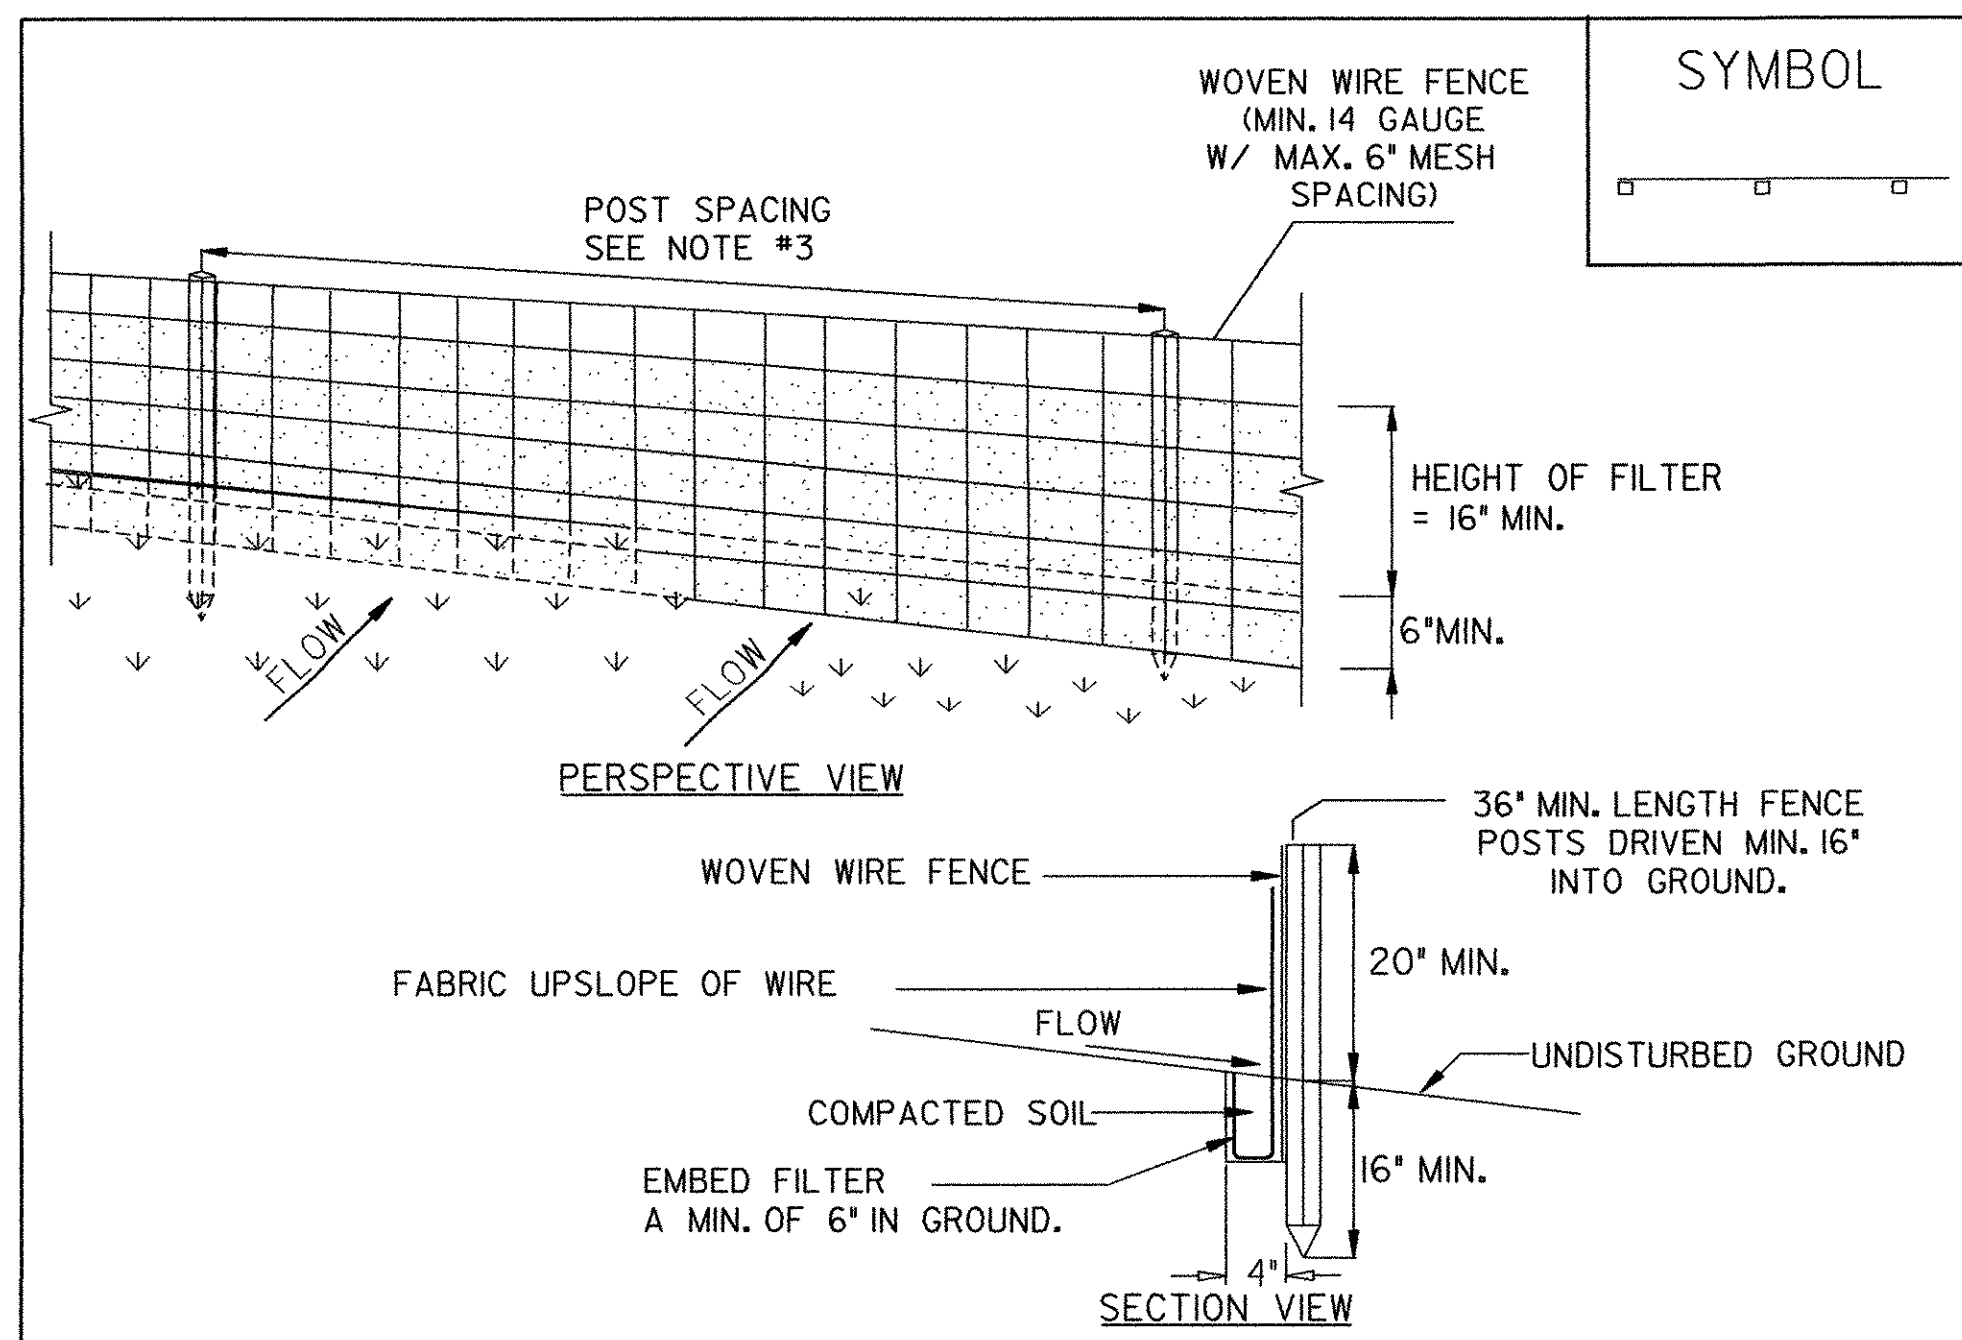

CONSTRUCTION SPECIFICATIONS


1. WOVEN WIRE FENCE REINFORCEMENT IS ONLY REQUIRED WITHIN 100 FT UPSLOPE OF RECEIVING WATERS.
2. WHERE REQUIRED FENCE SHALL BE WOVEN WIRE, MIN. 14 GAUGE WITH A 6\"/>

ADAPTED FROM DETAILS PROVIDED BY: NEW YORK STATE DEC
 ORIGINALLY DEVELOPED BY USDA-NRCS
 VERMONT DEPARTMENT OF ENVIRONMENTAL CONSERVATION

SILT FENCE

NOTES:
 REFER TO "THE VERMONT STANDARDS & SPECIFICATIONS FOR EROSION PREVENTION & SEDIMENT CONTROL -2006-" FROM THE VT AGENCY OF NATURAL RESOURCES FOR ADDITIONAL GUIDANCE.

THIS ITEM SHALL BE PAID FOR UNDER ITEM
 649.51 GEOTEXTILE FOR SILT FENCE

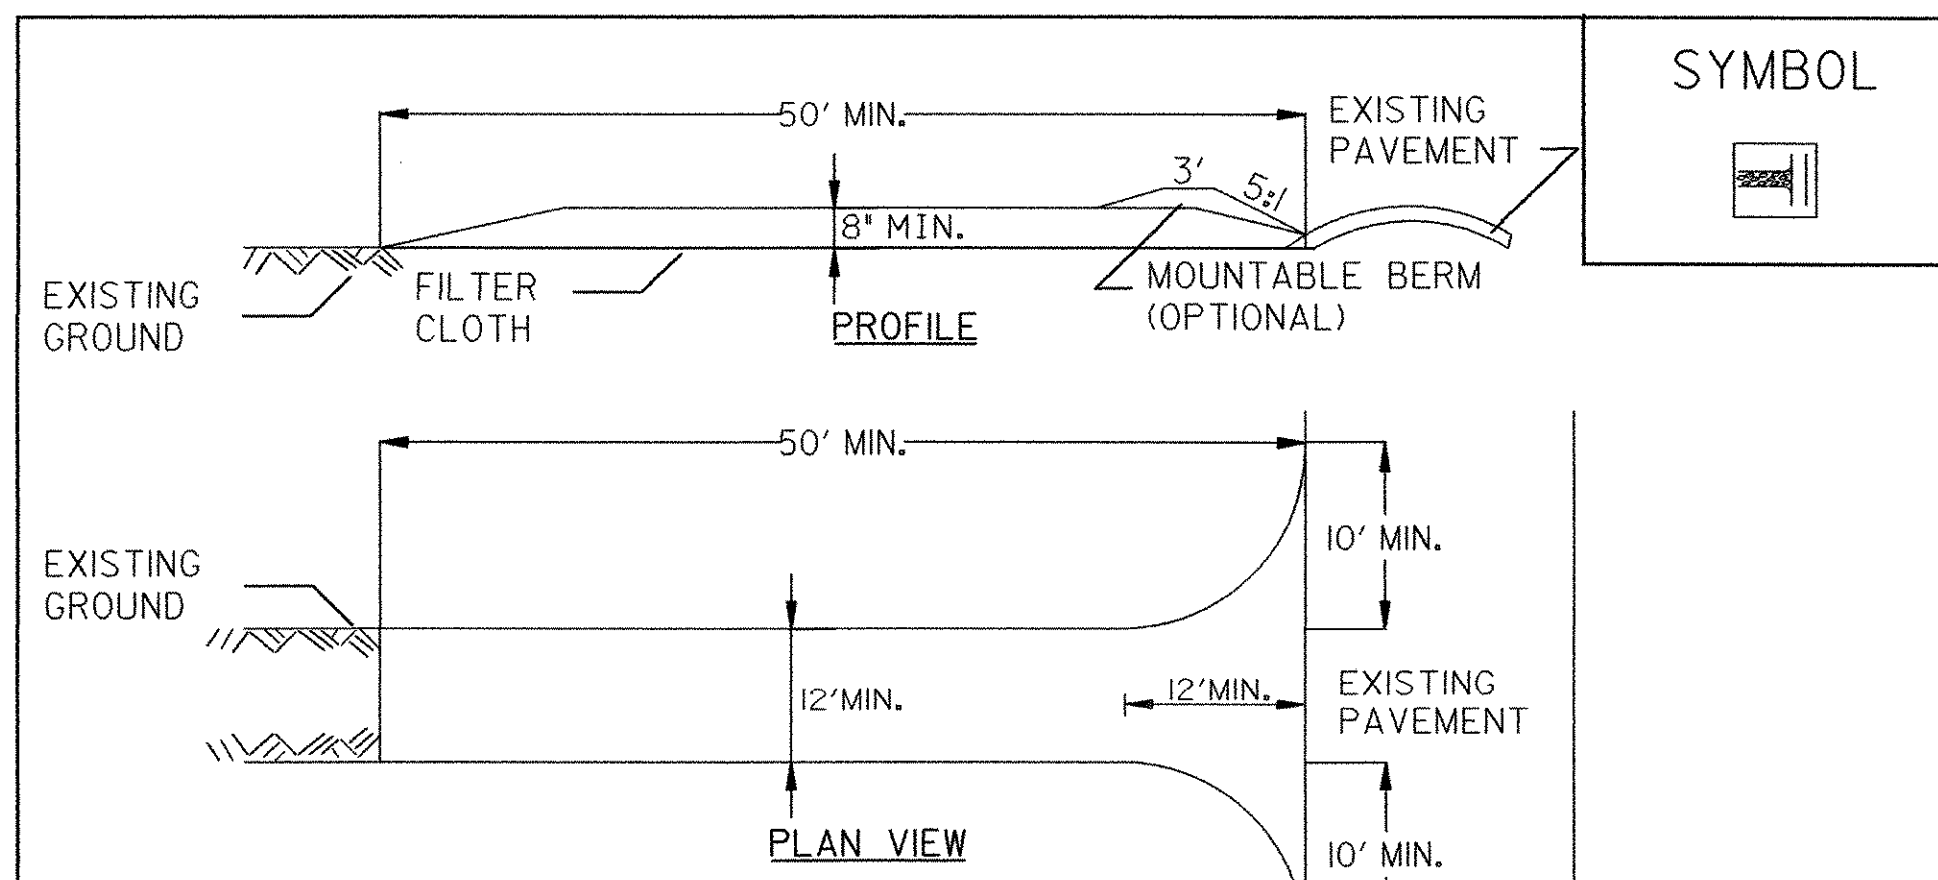

CONSTRUCTION SPECIFICATIONS

1. STONE SIZE - USE 1-4\"/>


ADAPTED FROM DETAILS PROVIDED BY: NEW YORK STATE DEC
 ORIGINALLY DEVELOPED BY USDA-NRCS
 VERMONT DEPARTMENT OF ENVIRONMENTAL CONSERVATION

STABILIZED CONSTRUCTION ENTRANCE

NOTES:
 REFER TO "THE VERMONT STANDARDS & SPECIFICATIONS FOR EROSION PREVENTION & SEDIMENT CONTROL -2006-" FROM THE VT AGENCY OF NATURAL RESOURCES FOR ADDITIONAL GUIDANCE.

THIS ITEM SHALL BE PAID FOR UNDER ITEM
 653.35 VEHICLE TRACKING PAD

REVISIONS	
FEBRUARY 9, 2007	WHF
MARCH 8, 2007	JMF

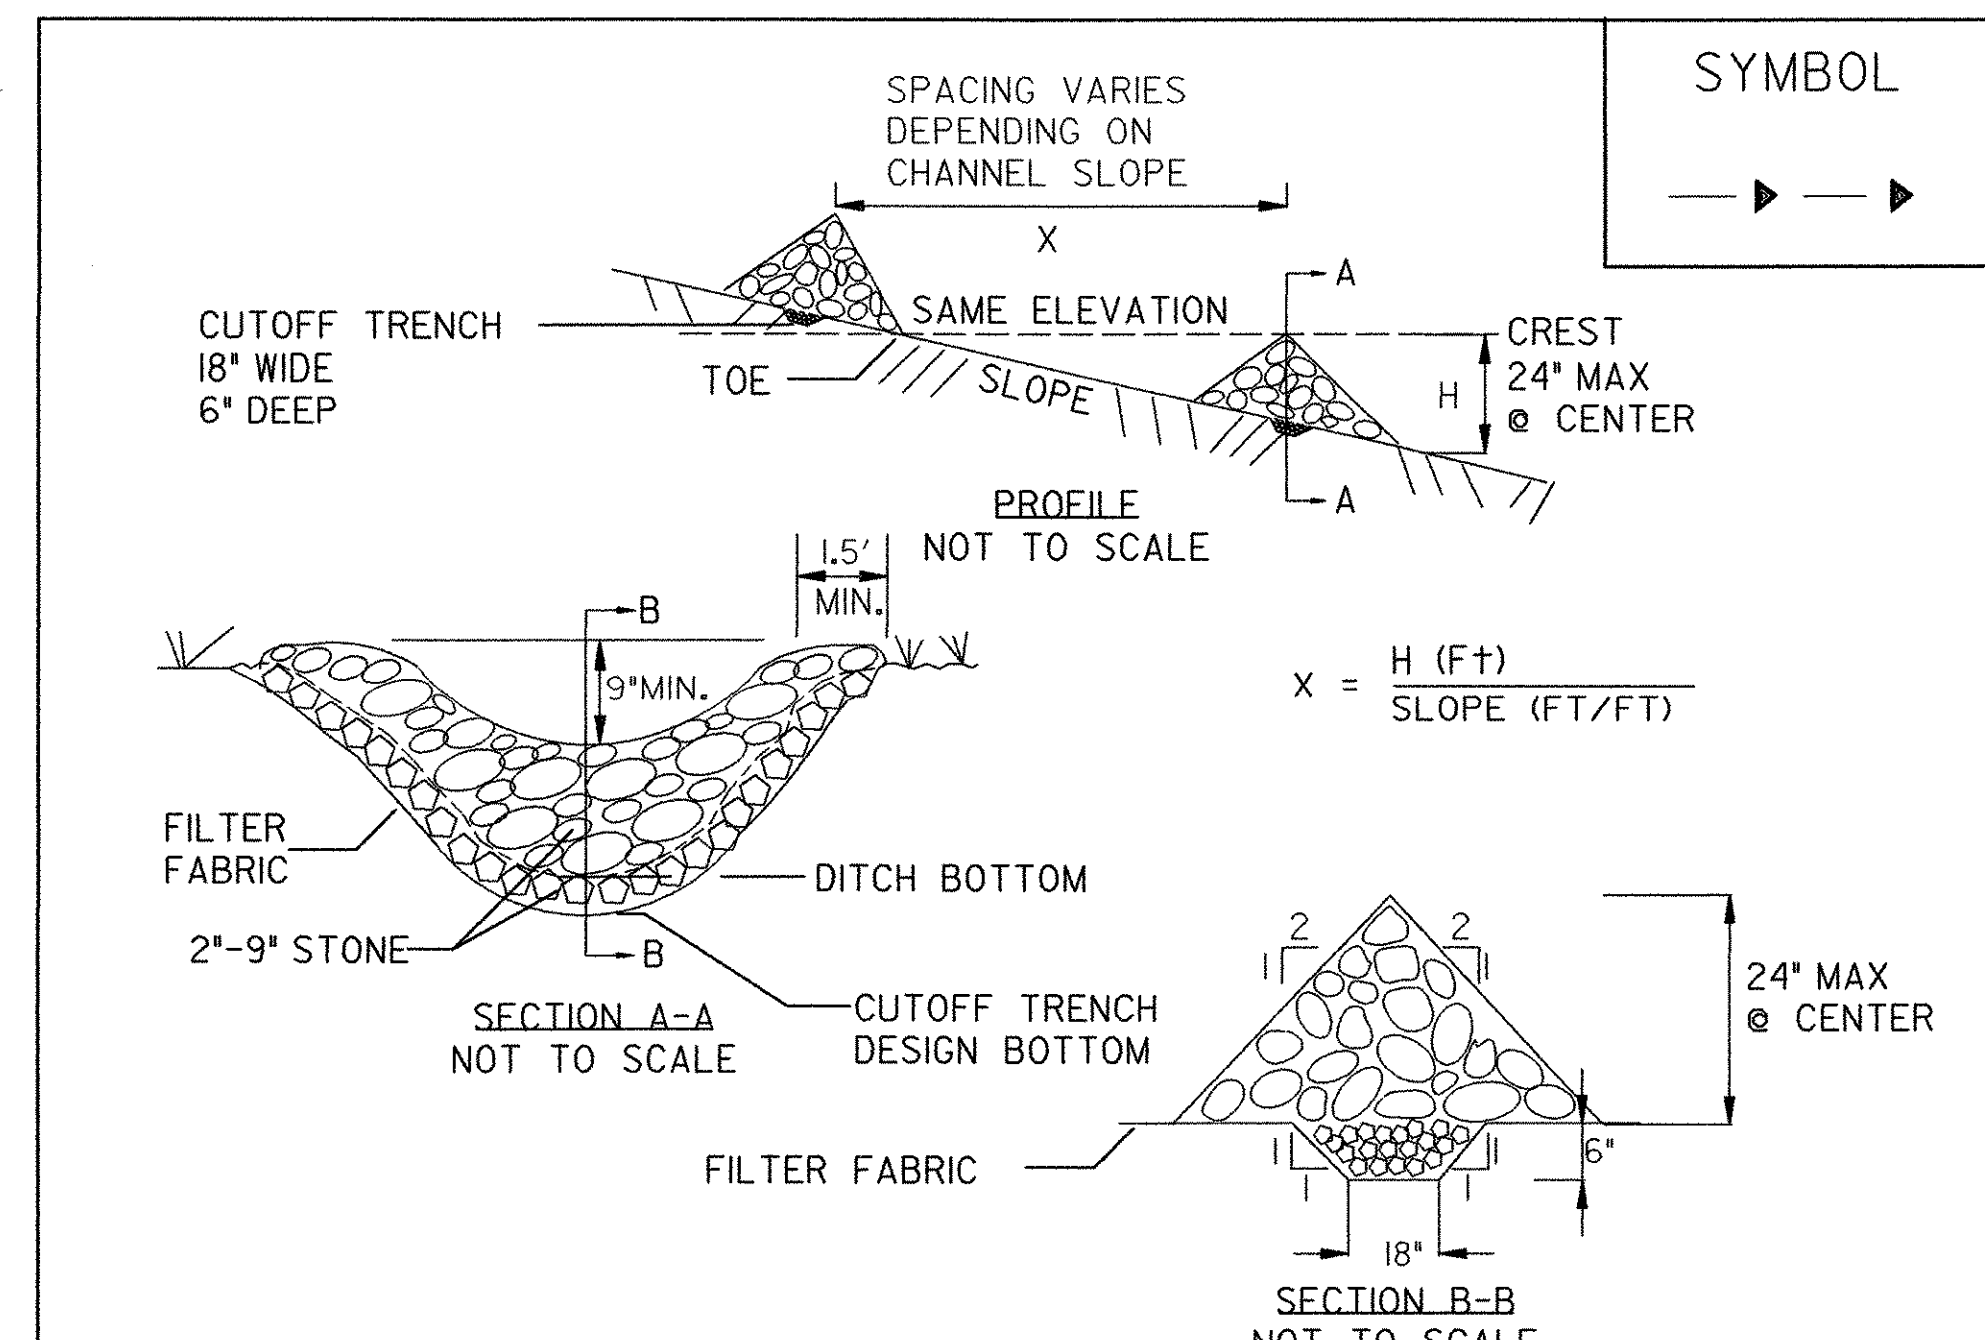

CONSTRUCTION SPECIFICATIONS

1. STONE WILL BE PLACED ON A FILTER FABRIC FOUNDATION.
2. SET SPACING OF CHECK DAMS SO THAT THE ELEVATION OF THE CREST OF THE DOWNSTREAM DAM IS AT THE SAME ELEVATION AS THE TOE OF THE UPSTREAM DAM.
3. EXTEND THE STONE A MINIMUM OF 1.5 FEET BEYOND THE DITCH BANKS TO PREVENT CUTTING AROUND THE DAM.
4. PROTECT THE CHANNEL DOWNSTREAM OF THE LOWEST CHECK DAM FROM SCOUR AND EROSION WITH STONE OR LINER AS APPROPRIATE.
5. ENSURE THAT CHANNEL APPURTENANCES SUCH AS CULVERT ENTRANCES BELOW CHECK DAMS ARE NOT SUBJECT TO DAMAGE OR BLOCKAGE FROM DISPLACED STONE.

ADAPTED FROM DETAILS PROVIDED BY: NEW YORK STATE DEC ORIGINALLY DEVELOPED BY USDA-NRCS VERMONT DEPARTMENT OF ENVIRONMENTAL CONSERVATION

CHECK DAM

NOTES:
 REFER TO "THE VERMONT STANDARDS & SPECIFICATIONS FOR EROSION PREVENTION & SEDIMENT CONTROL -2006-" FROM THE VT AGENCY OF NATURAL RESOURCES FOR ADDITIONAL GUIDANCE.


THIS ITEM SHALL BE PAID FOR UNDER ITEM
 653.25 TEMPORARY STONE CHECK DAM, TYPE I

REVISIONS	
MARCH 8, 2007	JMF




EPSC DETAIL SHEETS

PROJECT NAME: RICHFORD	PLOT DATE: 12/18/2007
PROJECT NUMBER: BHF 0302 (3) S	DRAWN BY: JTS
FILE NAME: ...Design\rich-erodet.dgn	CHECKED BY: MJC
PROJECT LEADER: MJC	SHEET 14 OF 41
DESIGNED BY: SEB	
EPSC DETAILS SHEET 2	

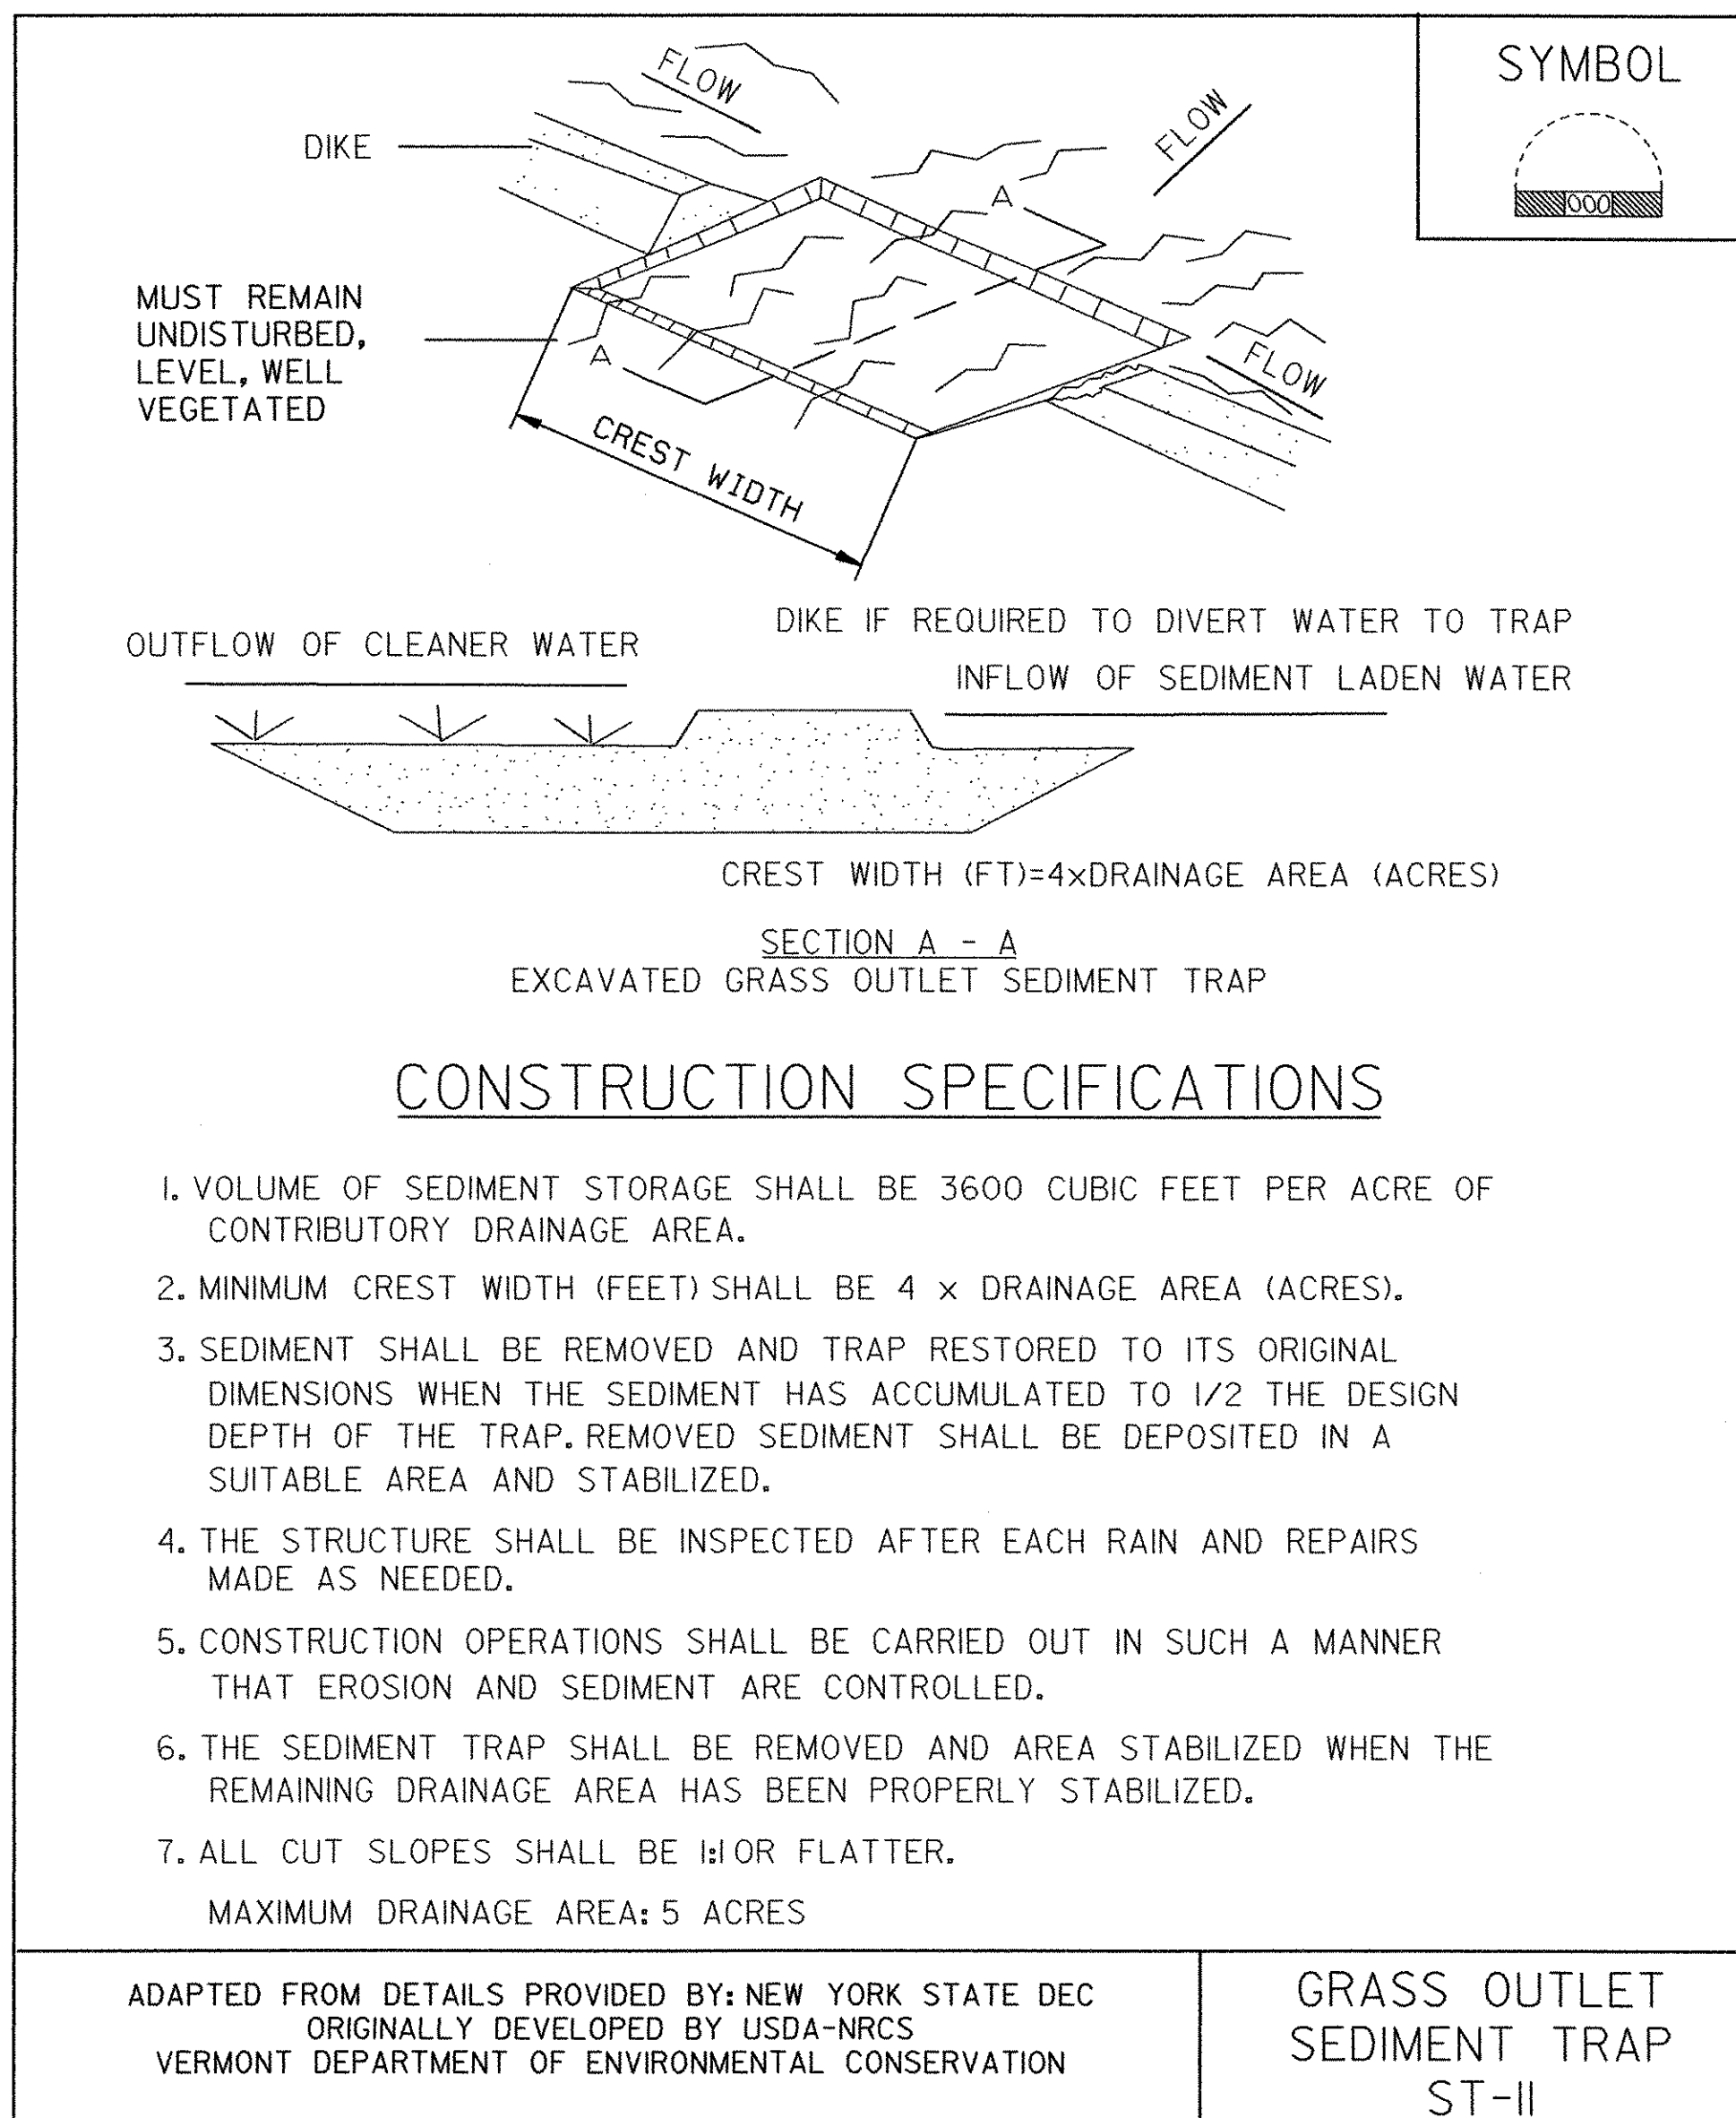

NOTES:
REFER TO *THE VERMONT STANDARDS & SPECIFICATIONS FOR EROSION PREVENTION & SEDIMENT CONTROL -2006- * FROM THE VT AGENCY OF NATURAL RESOURCES FOR ADDITIONAL GUIDANCE.

THIS ITEM SHALL BE PAID FOR UNDER ITEM 900.620 SPECIAL PROVISION (GRASS OUTLET SEDIMENT TRAP)

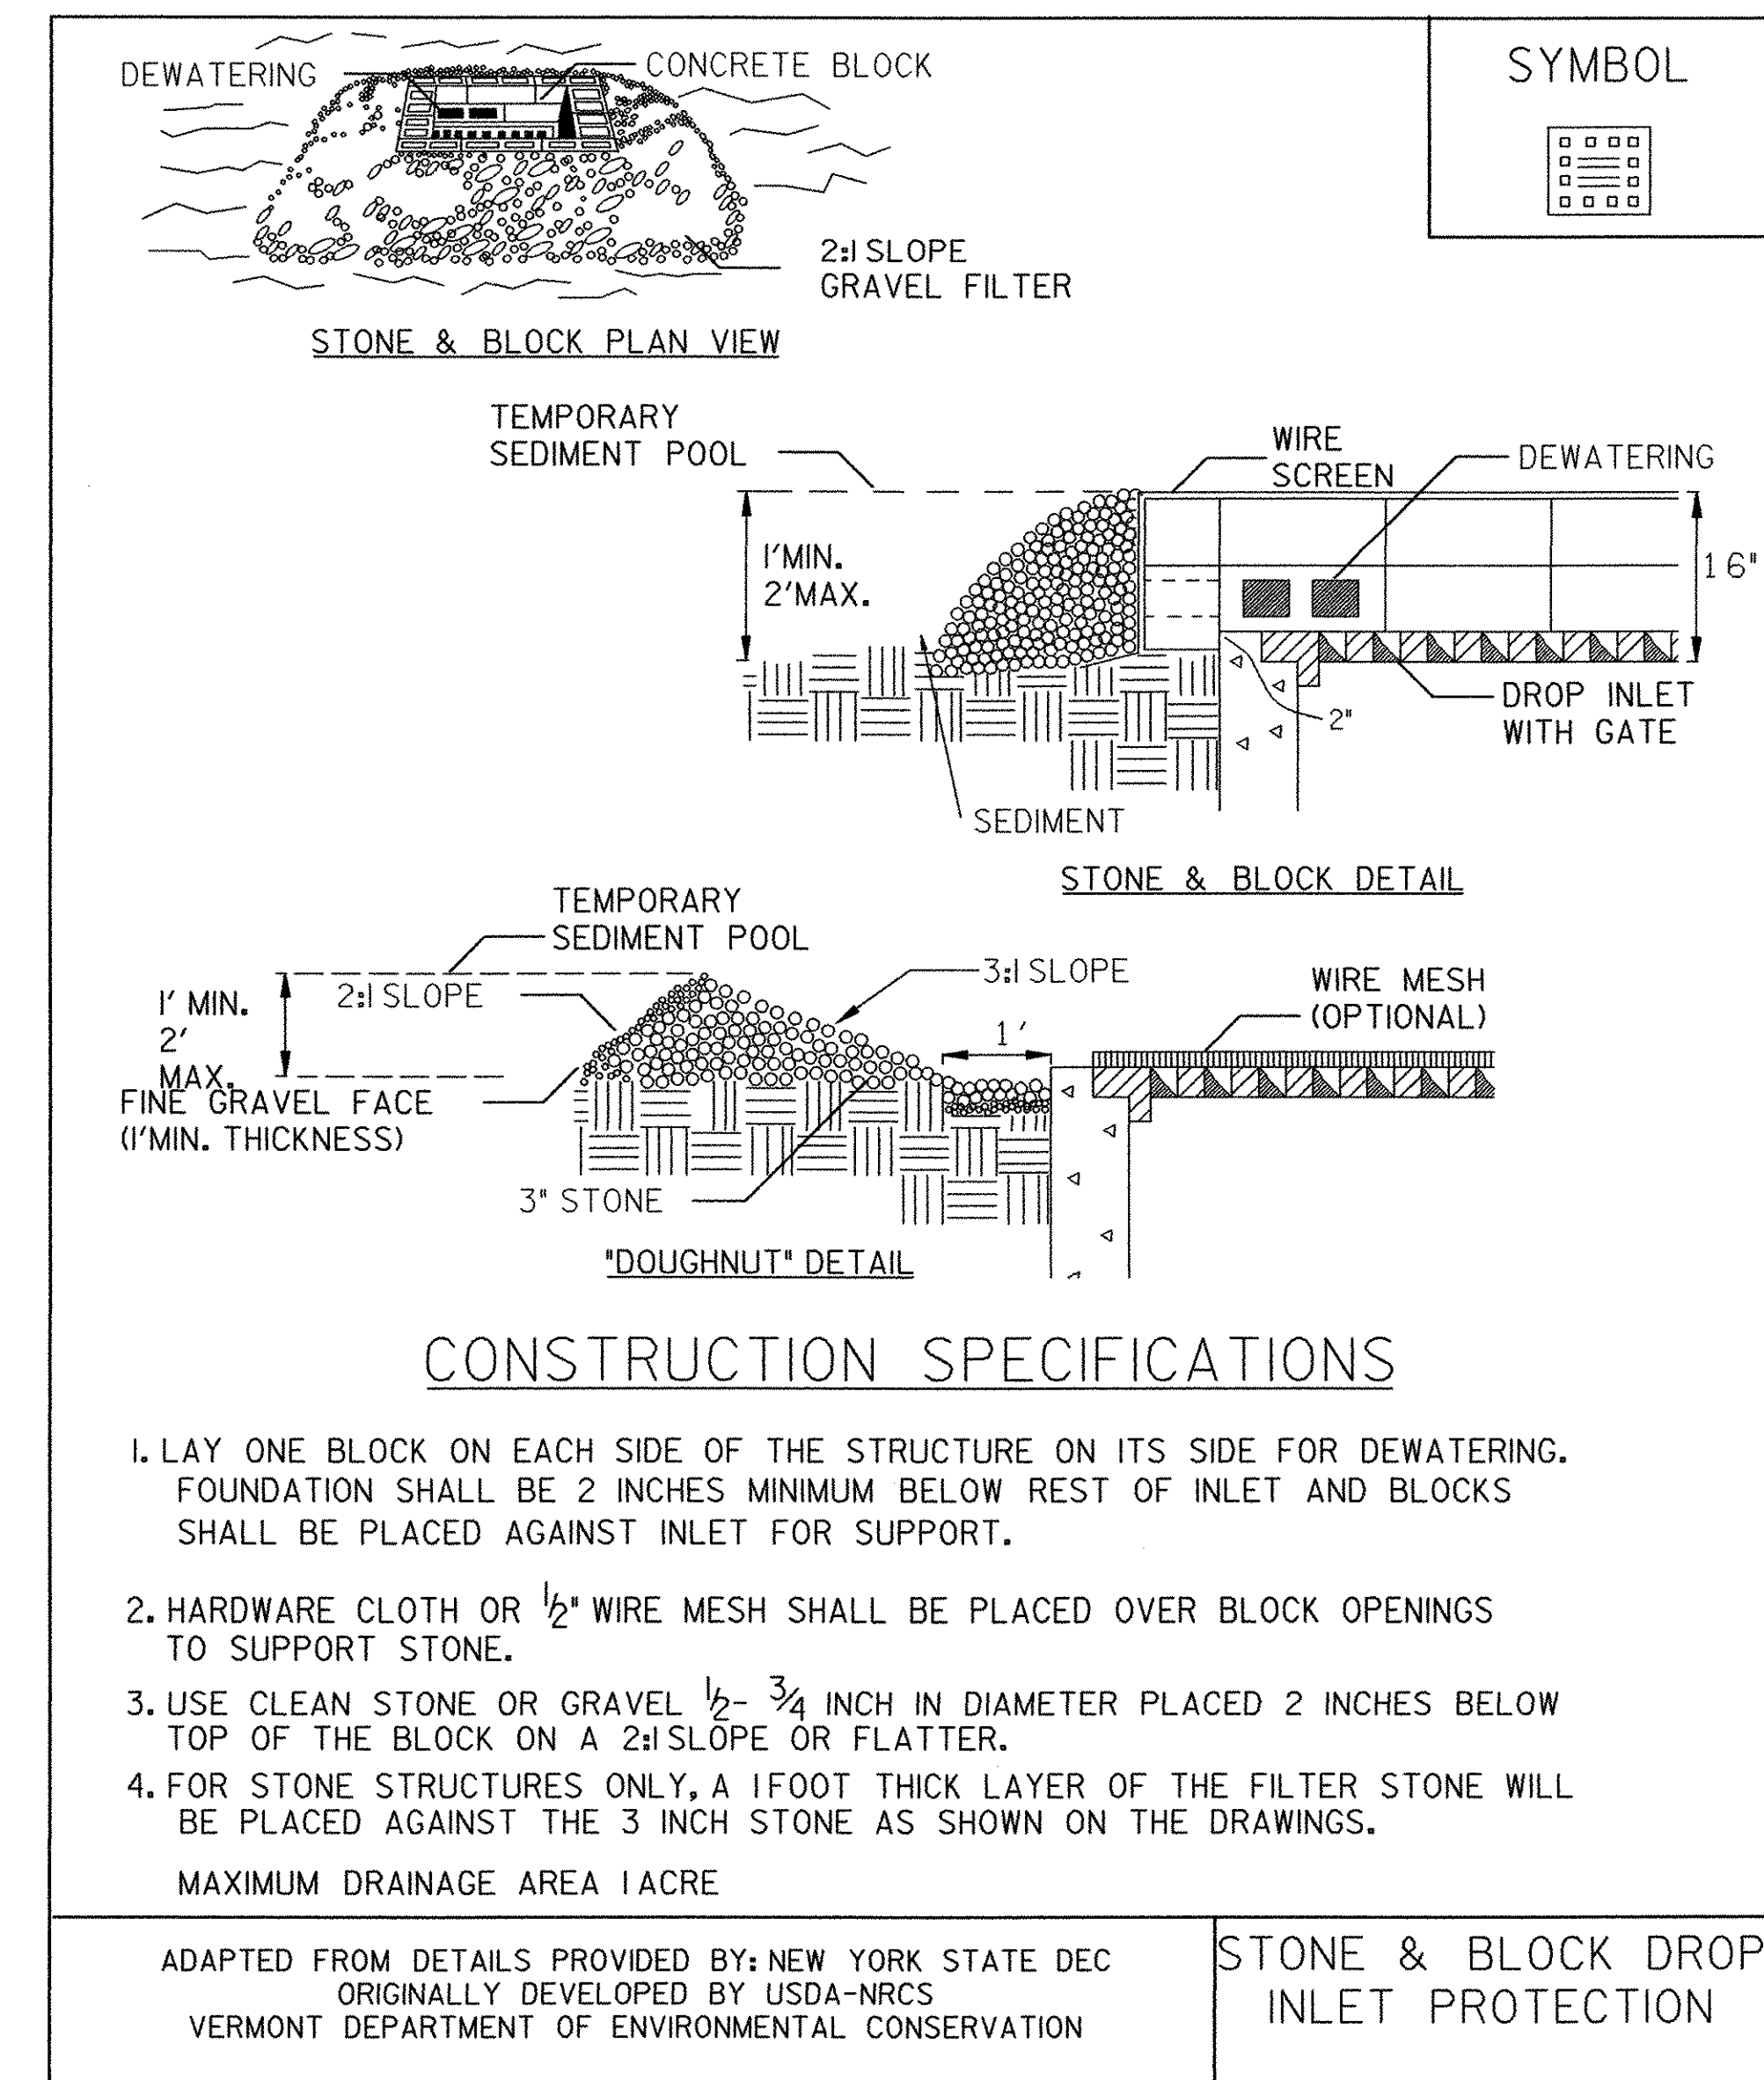

NOTES:
REFER TO *THE VERMONT STANDARDS & SPECIFICATIONS FOR EROSION PREVENTION & SEDIMENT CONTROL -2006- * FROM THE VT AGENCY OF NATURAL RESOURCES FOR ADDITIONAL GUIDANCE.

THIS ITEM SHALL BE PAID FOR UNDER ITEM 653.40 INLET PROTECTION DEVICE, TYPE I

EPSC DETAIL SHEETS



PROJECT NAME: RICHFORD	PLOT DATE: 12/18/2007
PROJECT NUMBER: BHF 0302 (3) S	DRAWN BY: JTS
FILE NAME: ...Design\Rich-erodet.dgn	CHECKED BY: MJC
PROJECT LEADER: MJC	SHEET 15 OF 41
DESIGNED BY: SEB	
EPSC DETAILS SHEET 3	

*PORTLAND CEMENT CONCRETE SIDEWALK, 5 INCH
STA. 101+86 RT. TO STA. 102+82 LT.

*CAST-IN-PLACE CONCRETE CURB, TYPE B
STA. 101+86 RT. TO STA. 102+82 LT.

* CONSTRUCTION ITEMS TO BE DONE AFTER DETOUR IS REMOVED,
TO RESTORE MAIN STREET TO ITS PRE-DETOUR CONDITION

SOLID ROCK EXCAVATION
STA. 101+86 RT. TO STA. 102+82 LT.

PRECAST REINFORCED CONCRETE DROP INLET
WITH CAST IRON GRATE
STA. 101+89 RT.

18" CPEP (SL)
STA. 101+89 RT. TO 102+80 LT.

TEMPORARY 24 INCH STOP BAR
STA. 102+32 LT.
STA. 107+40 LT.
RIVER STREET
PROVINCE STREET

TEMPORARY LETTER OR SYMBOL
STA. 102+32 LT.

TEMPORARY 8 INCH WHITE LINE
RIVER STREET (3 PARKING SPACES)

REMOVAL OF EXISTING PAVEMENT MARKINGS
STA. 101+43 LT. & RT. TO STA. 102+50, LT.
(DOUBLE YELLOW LINE)
STA. 101+67 RT. TO STA. 102+50, LT.
(WHITE PARKING SPACES LINES)
INTERSECTION OF RIVER STREET,
PROVINCE STREET AND EASTERN AVENUE
(DOUBLE YELLOW LINE)

NEW 18" x 10' CPEP (SL)
INV. AT INLET = 445.20 IN NEW DI
INV. AT OUTLET = 443.45 IN EXIST. DI

INSTALL TEMPORARY POST
WITH EMERGENCY SIGNAL
PREEMPTION BUTTON.
BUTTON TO BE CONTAINED
IN A LOCKABLE WATERPROOF
BOX SECURED TO THE POST
(SEE NOTE 3 ON SHEET 19)

EXISTING POWER
DROP STANCHION
FOR AMBULANCE
& FIRE STATION




DETOUR CURVE #1 DATA

Δ	= 60° 30' 32.73"
D	= 28° 38' 52.40"
R	= 200.00'
T	= 116.66'
L	= 211.22'
E	= 31.54'
BANK	= N/C

DETOUR CURVE #2 DATA


Δ	= 34° 44' 40.54"
D	= 28° 38' 52.40"
R	= 200.00'
T	= 62.57'
L	= 121.28'
E	= 9.56'
BANK	= N/C

- NOTES:
- SEE TEMPORARY TRAFFIC SIGNAL PLAN FOR SIGNAL INFORMATION.
 - THE CONTRACTOR MAY MAKE MINOR ADJUSTMENTS TO THE TEMPORARY DETOUR PROFILE, SUBJECT TO THE APPROVAL OF THE ENGINEER, PROVIDED THAT ALL WORK REMAINS WITHIN THE LIMITS SHOWN AND THE MINIMUM BEAM ELEVATIONS AND SPAN LENGTH ARE MAINTAINED.
 - ALL TRAFFIC SIGNS SHALL CONFORM TO THE MANUAL OF UNIFORM TRAFFIC CONTROL DEVICES (MUTCD) 2003 EDITION.
 - CONTRACTOR SHALL CONTACT:
CAROLYN SMITH
TRUCKING SUPERVISOR
BLUE SEAL FEEDS
RICHFORD, VT
(802) 848-7718
A MINIMUM OF TWO WEEKS PRIOR TO TRAFFIC BEING RE-DIRECTED TO THE TEMPORARY BRIDGE DETOUR.
 - COSTS FOR ALL APPROACH WORK FOR THE TEMPORARY BRIDGE INCLUDING PAVEMENT, SUBBASE, RAILING, PAVEMENT MARKINGS (ALL TEMPORARY DOUBLE YELLOW AND TEMPORARY WHITE SHOULDER LINES), CURBS AND SIDEWALKS WILL BE CONSIDERED TO BE INCLUDED IN THE CONTRACT LUMP SUM PRICE FOR TWO-WAY TEMPORARY BRIDGE (6000 SF - EST.), ITEM 528.II.
 - COSTS FOR ALL TEMPORARY TRAFFIC CONTROL DEVICES INCLUDING TRAFFIC BARRICADES, SIGNS AND SIGN POSTS WILL BE CONSIDERED TO BE INCLUDED IN THE CONTRACT LUMP SUM PRICE FOR TRAFFIC CONTROL, ITEM 641.J0.
 - CONTRACTOR SHALL VERIFY LOCATION AND CONDITION OF EXISTING 18" CMP. NOTIFY ENGINEER IF ANY EXISTING PROBLEMS OR IF MODIFICATIONS ARE PROPOSED DUE TO CONFLICTS WITH THE TEMPORARY BRIDGE ABUTMENT.
 - UNLESS NOTED OTHERWISE, WORK ITEMS SHOWN ON THIS SHEET ARE NECESSITATED BY THE DETOUR ROUTE, AND MUST BE COMPLETED PRIOR TO OPENING THE DETOUR TO TRAFFIC. THE WORK WILL BE PAID UNDER THE ITEMS AS INDICATED, NOT AS A PART OF THE TEMPORARY BRIDGE ITEM, AND ARE TO BE PERMANENT IN NATURE.

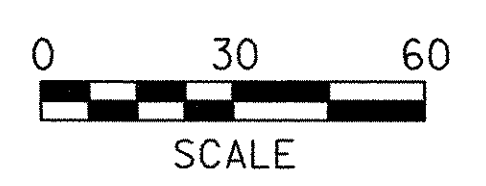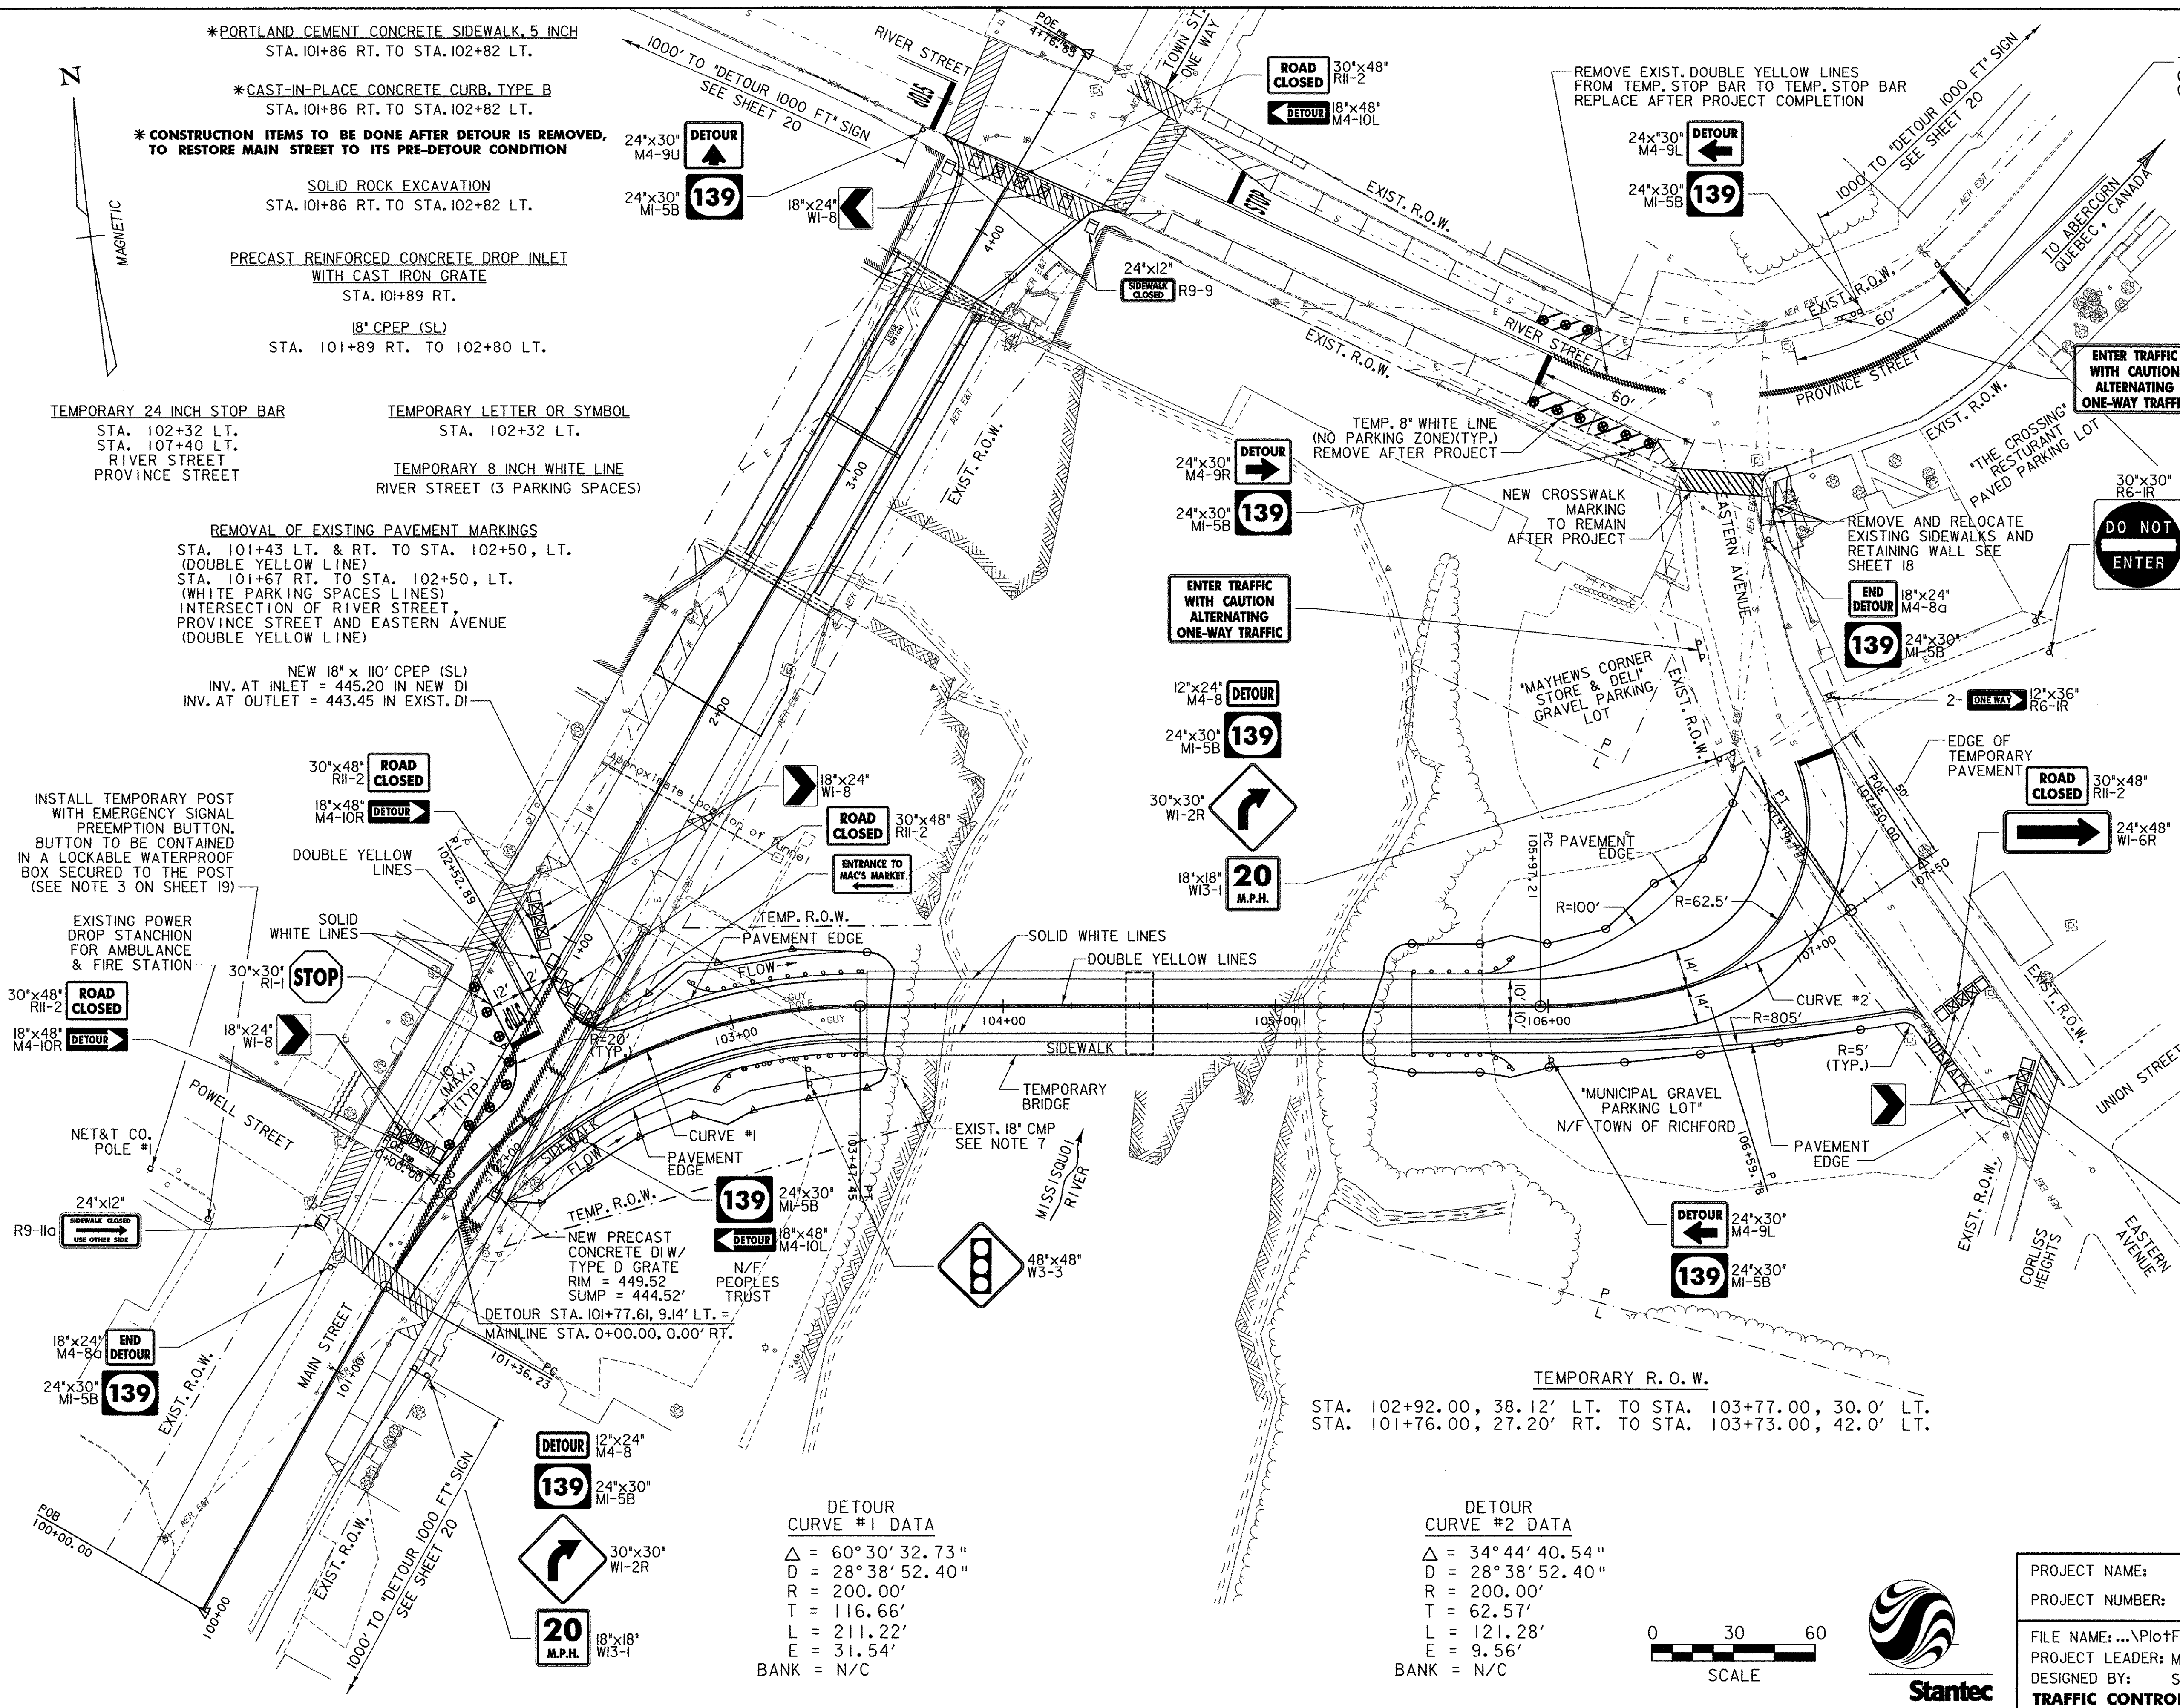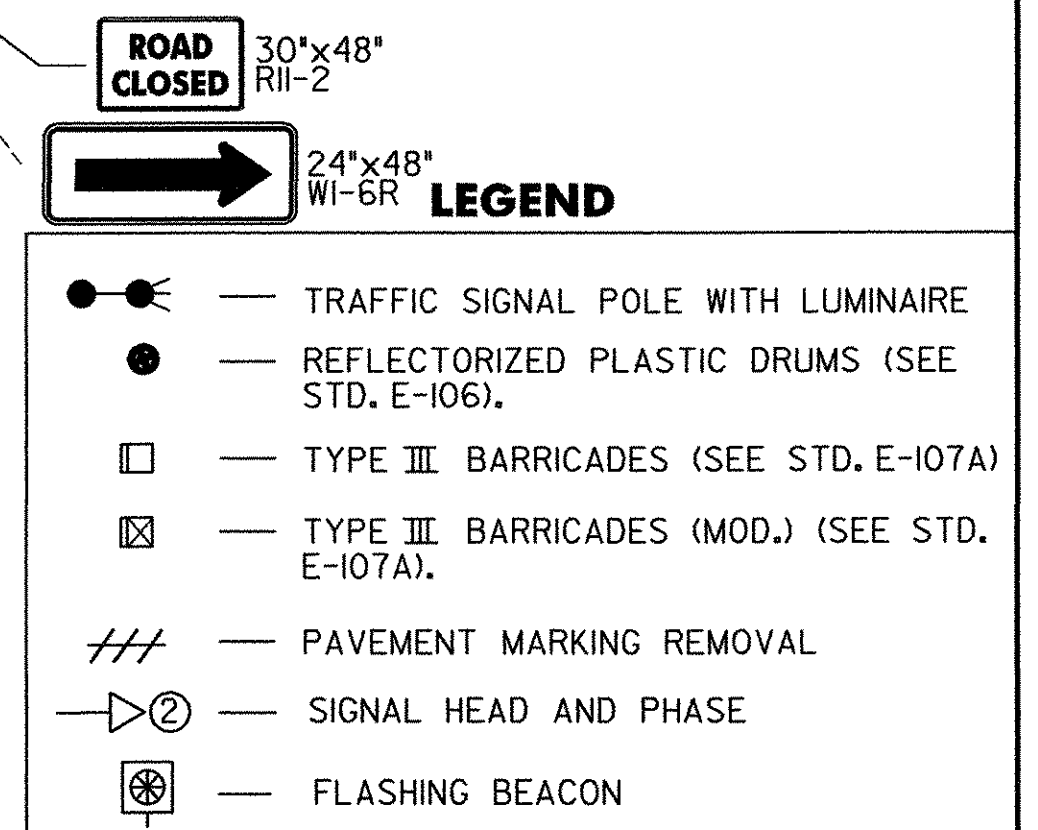


PROJECT NAME: RICHFORD
PROJECT NUMBER: BHF 0302 (3) S

FILE NAME: ...N:\PlotFiles\Rich-detour.pff PLOT DATE: 12/18/2007
PROJECT LEADER: MJC DRAWN BY: JTS
DESIGNED BY: SEB CHECKED BY: MJC
TRAFFIC CONTROL PLAN SHEET 16 OF 41

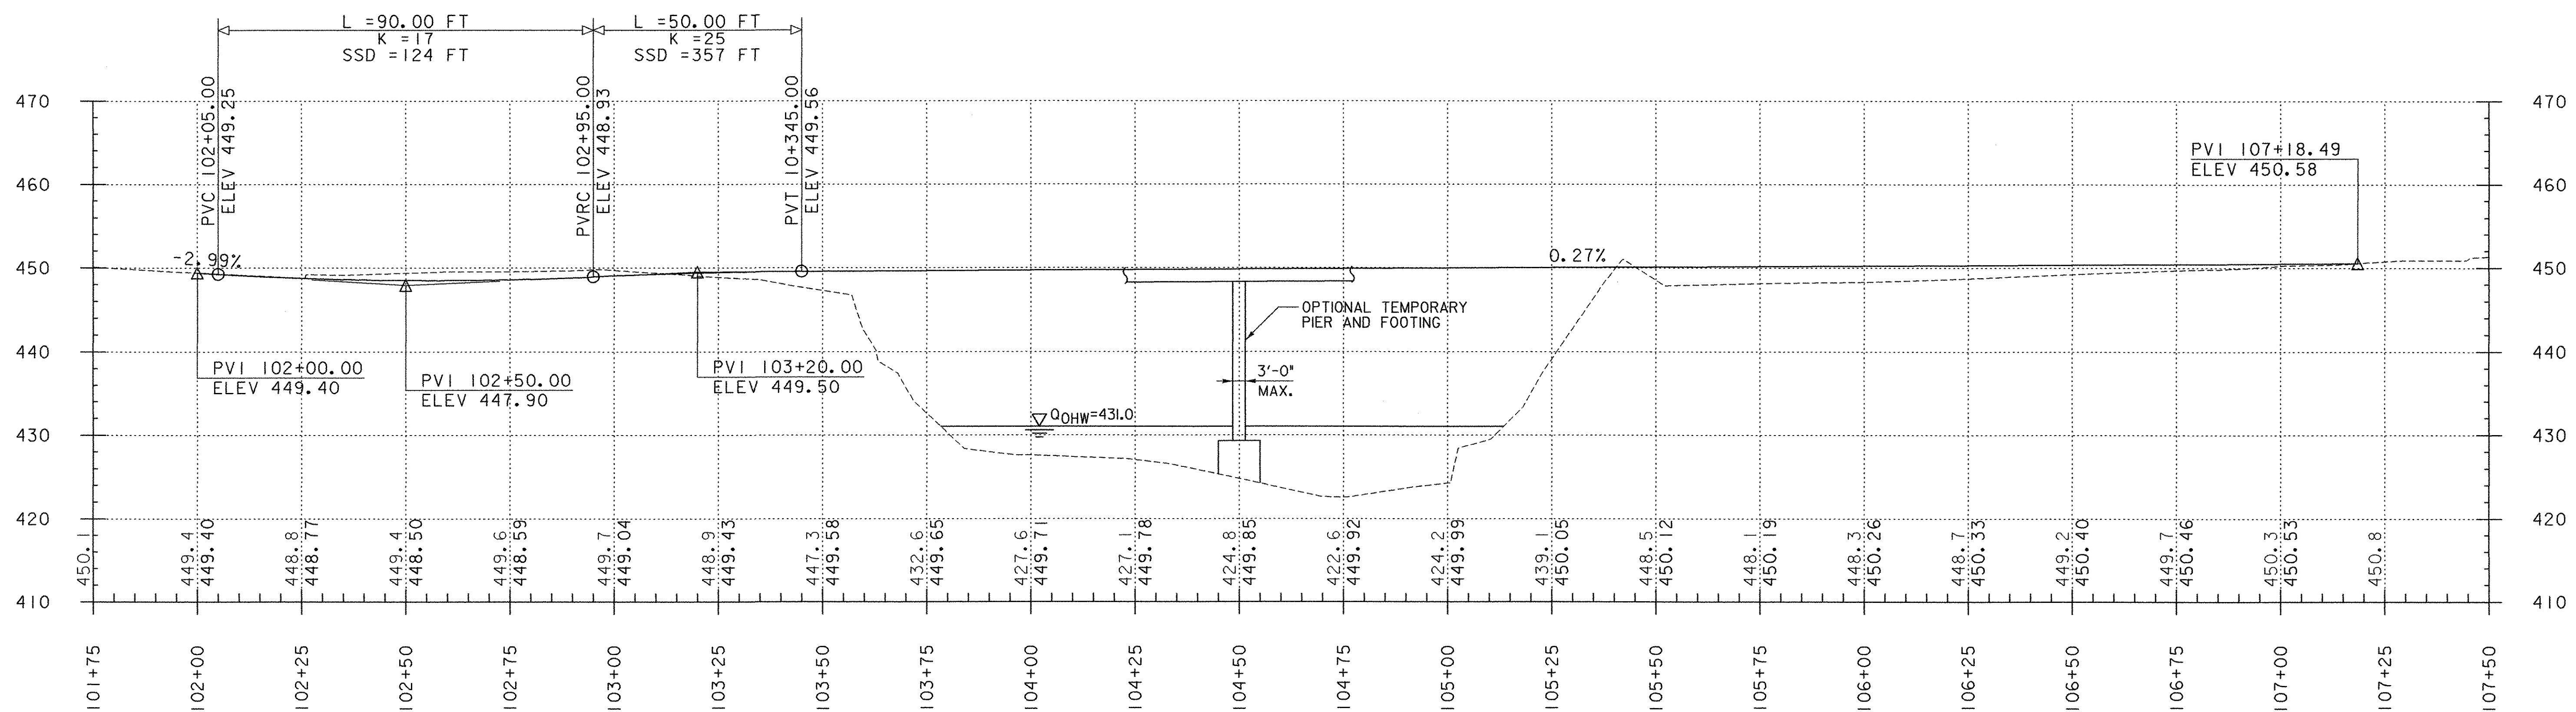


NOTE: ELEVATIONS SHOWN TO THE NEAREST TENTH ARE EXISTING GROUND ALONG CENTERLINE.
ELEVATIONS SHOWN TO THE NEAREST HUNDREDTH ARE FINISH GRADE ALONG CENTERLINE.

DETOUR PROFILE

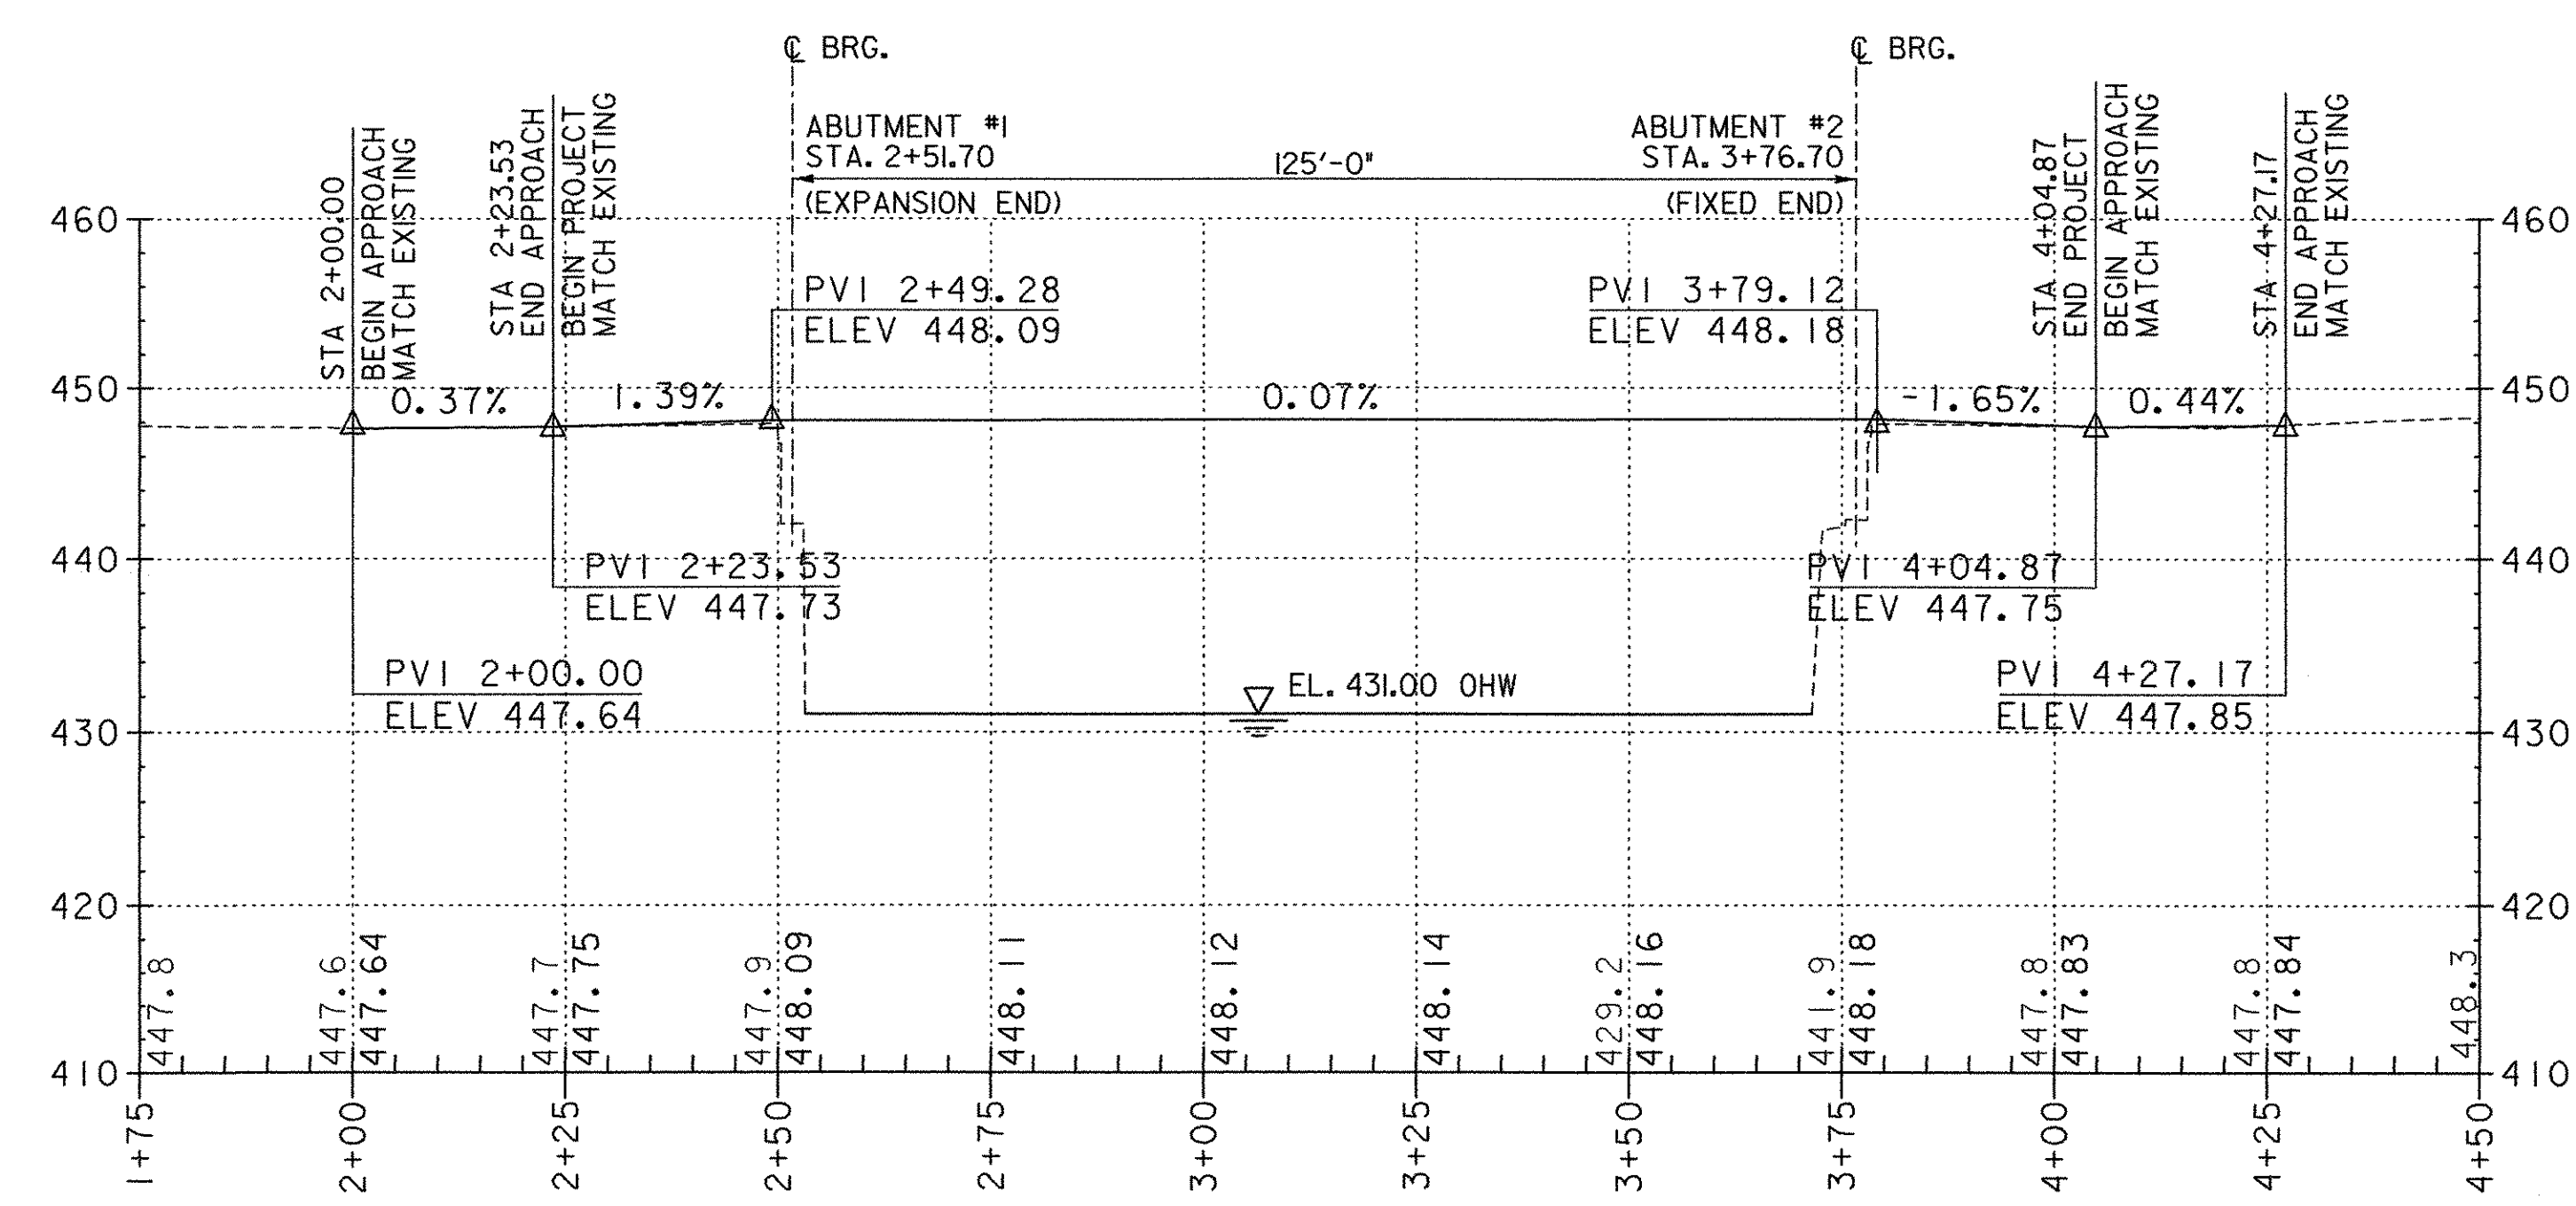


NOTE: ELEVATIONS SHOWN TO THE NEAREST TENTH ARE EXISTING GROUND ALONG CENTERLINE.
ELEVATIONS SHOWN TO THE NEAREST HUNDREDTH ARE FINISH GRADE ALONG CENTERLINE.

BRIDGE PROFILE

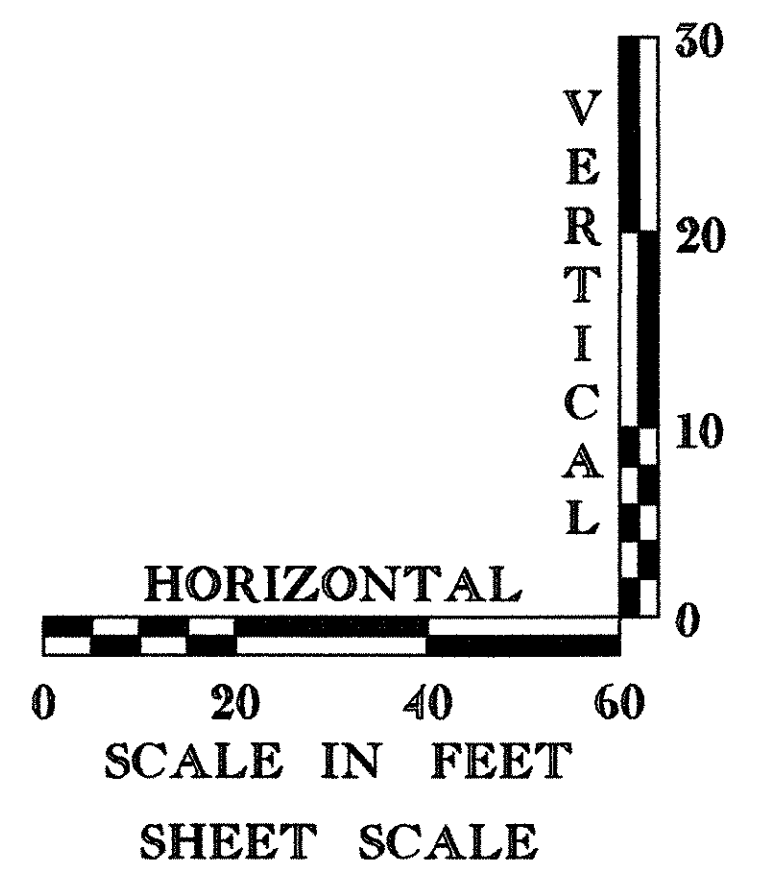

PROJECT NAME: RICHFORD
 PROJECT NUMBER: BHO 0302 (3) S
 FILE NAME: ...Design\Rich-prof.dgn PLOT DATE: 12/18/2007
 PROJECT LEADER: MJC DRAWN BY: SEB
 DESIGNED BY: SEB CHECKED BY: MJC
BRIDGE AND DETOUR PROFILE SHEET 17 OF 41

DURABLE CROSSWALK MARKING 35 LF (SEE DETAIL ON SHEET 36)	REMOVING SIGNS 2 EA	ERECTING SALVAGED SIGNS 2 EA	SETTING SALVAGED POSTS 1EA
TRANSPLANTING SHRUBS (2") 1EA	SOLID ROCK EXCAVATION 3 CY	DETECTABLE WARNING SURFACE 10 SF	SUBBASE OF GRAVEL 11 CY
PORTLAND CEMENT CONCRETE SIDEWALK, 5 INCH 18 SY	CONCRETE, HIGH PERFORMANCE CLASS B 1 CY	COMMON EXCAVATION 12 CY	CAST-IN-PLACE CONCRETE CURB, TYPE B 28 LF

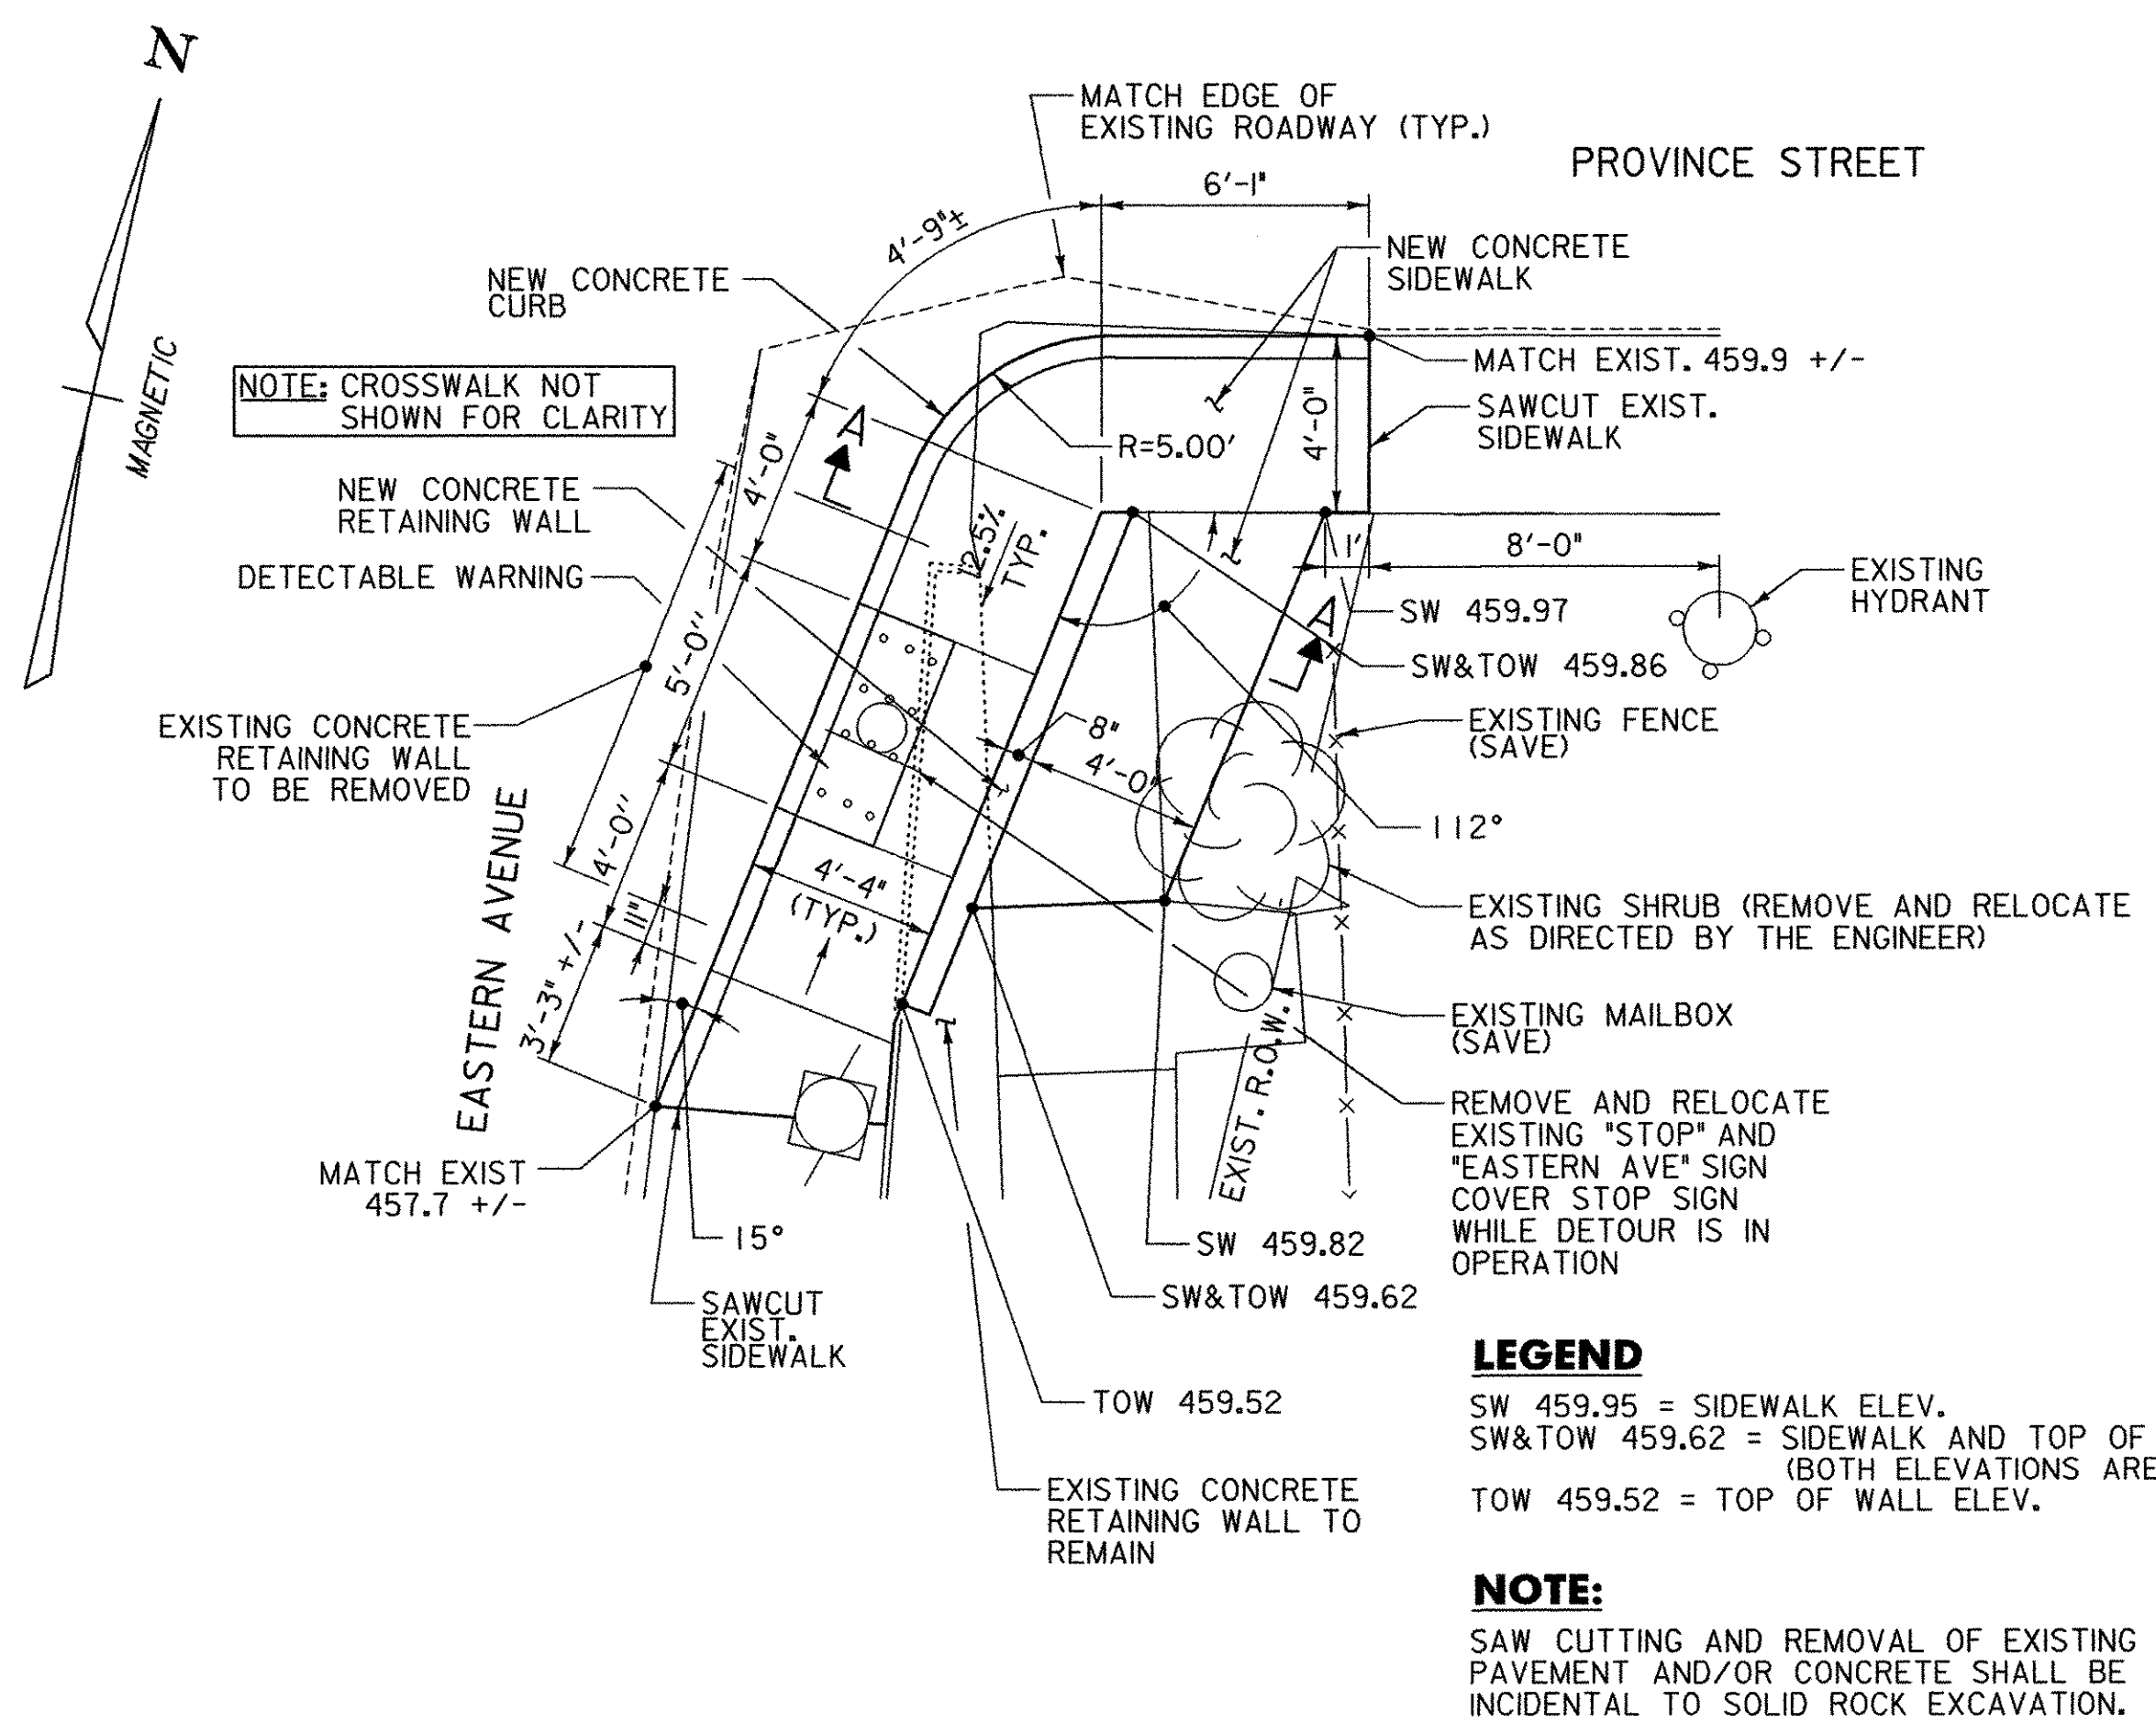


RELOCATED SIDEWALK PLAN AT THE INTERSECTION OF EASTERN AVENUE AND PROVINCE STREET

SCALE 1/4" = 1'-0"
1 0 2 4 6


LEGEND
SW 459.95 = SIDEWALK ELEV.
SW&TOW 459.62 = SIDEWALK AND TOP OF WALL ELEV. (BOTH ELEVATIONS ARE THE SAME)
TOW 459.52 = TOP OF WALL ELEV.

NOTE:
SAW CUTTING AND REMOVAL OF EXISTING PAVEMENT AND/OR CONCRETE SHALL BE INCIDENTAL TO SOLID ROCK EXCAVATION.

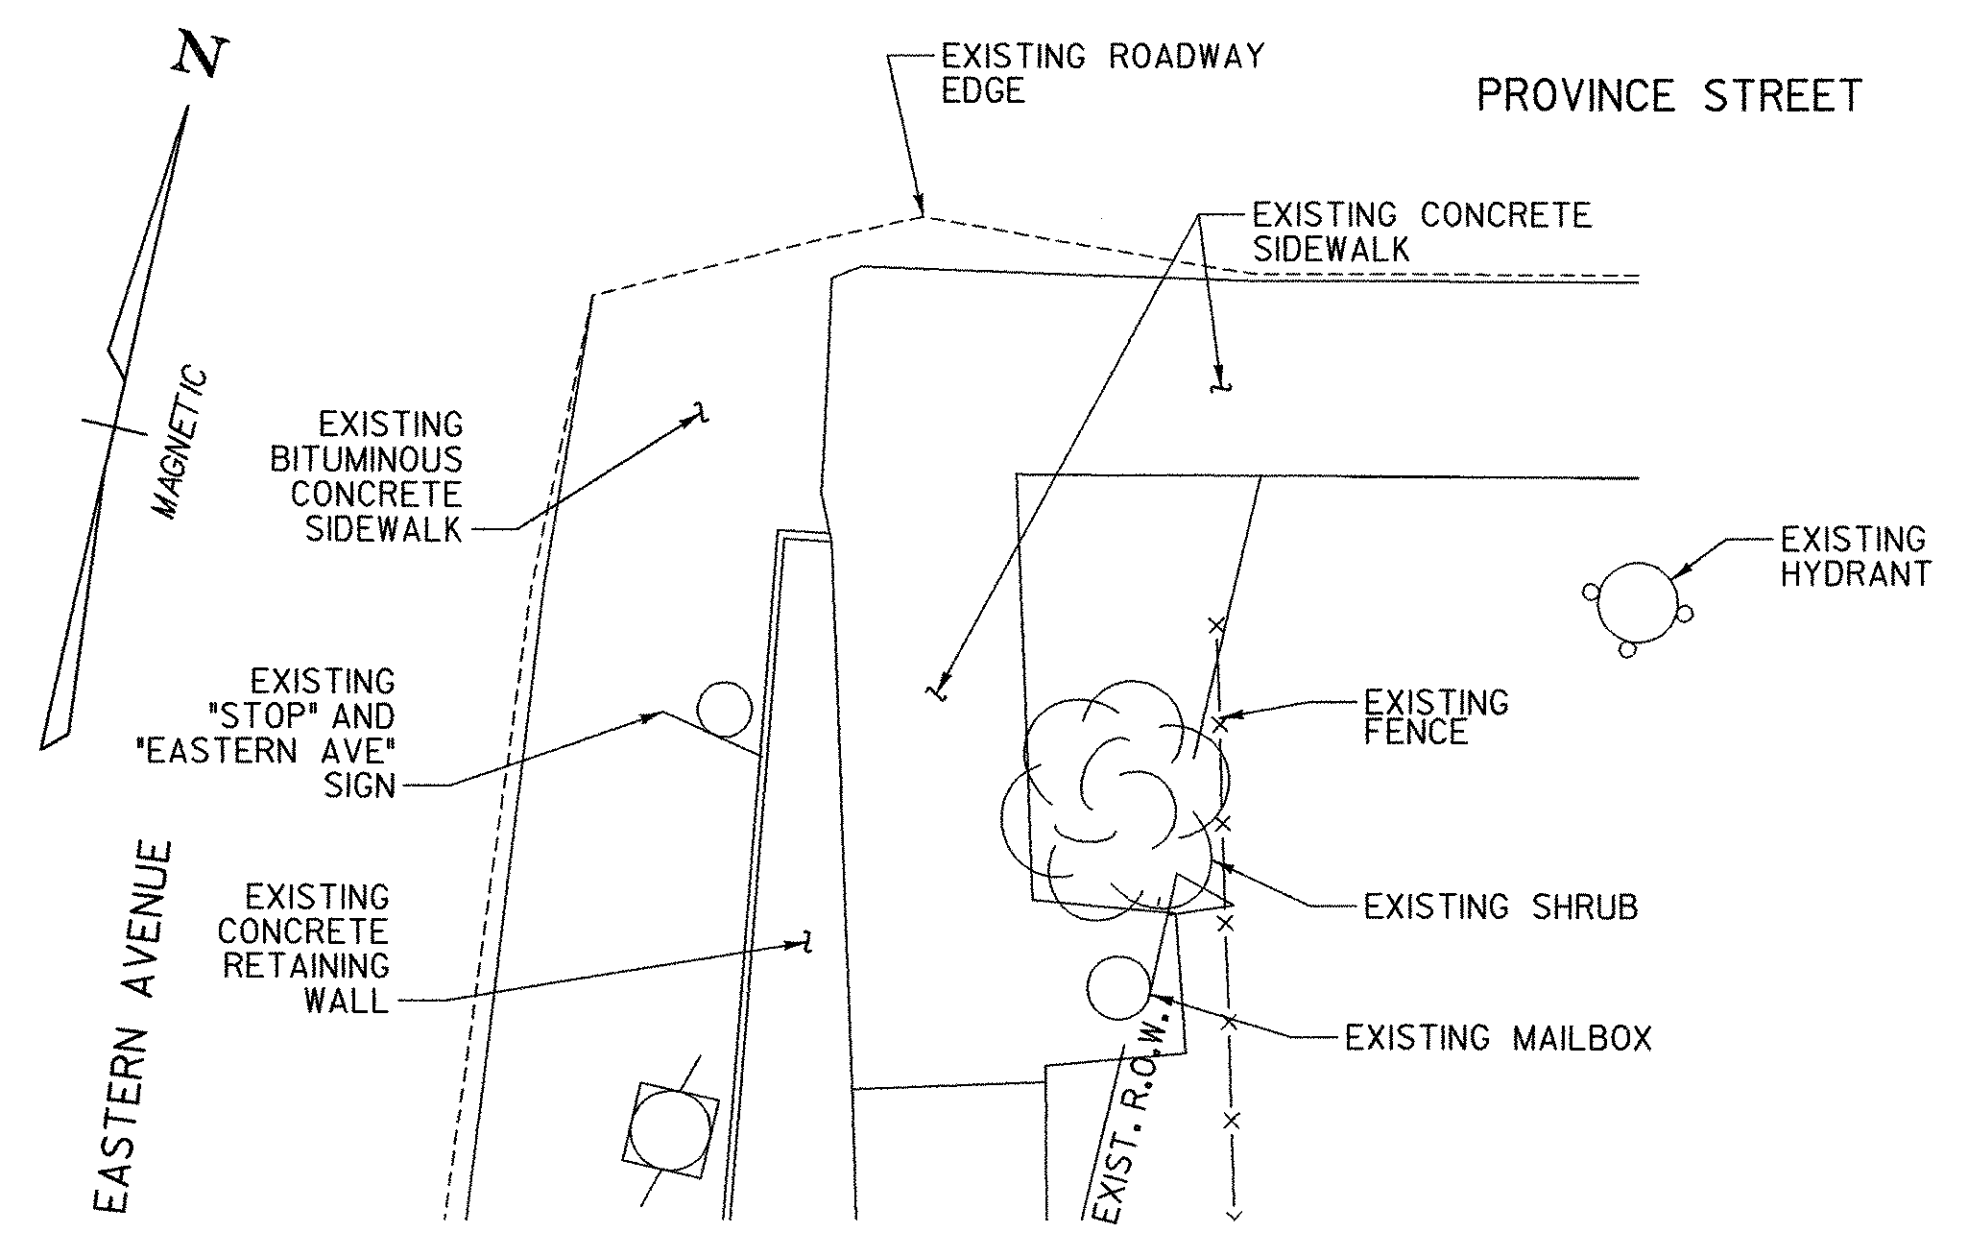

EXISTING SIDEWALK PLAN AT THE INTERSECTION OF EASTERN AVENUE AND PROVINCE STREET

SCALE 1/4" = 1'-0"
1 0 2 4 6

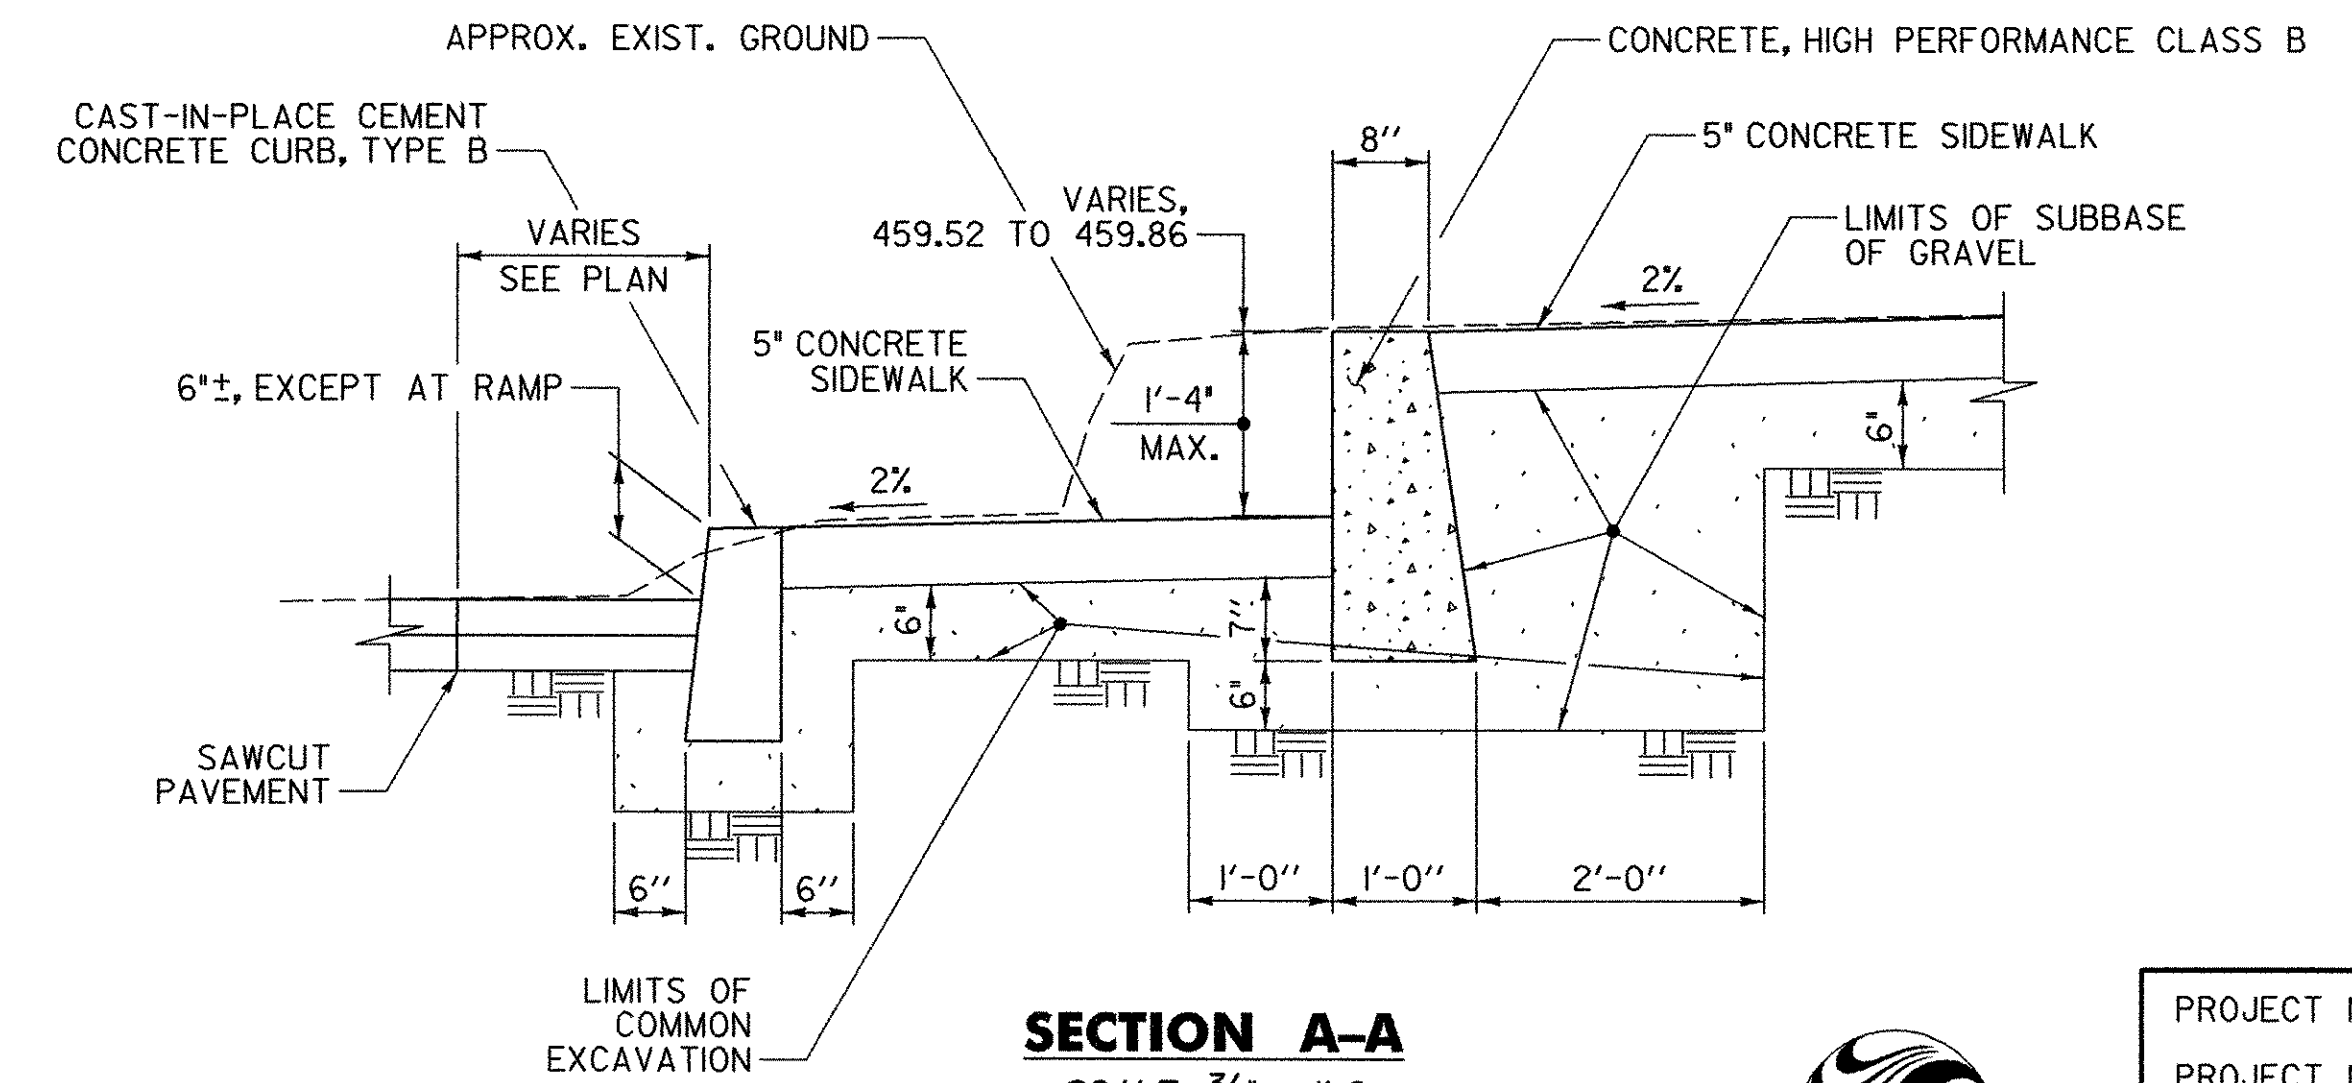


SECTION A-A
SCALE 3/4" = 1'-0"
1 0 2



PROJECT NAME: RICHFORD	PLOT DATE: 12/18/2007
PROJECT NUMBER: BHF 0302 (3) S	DRAWN BY: SEB
FILE NAME: ...Design\Rich-sdwk mod.dgn	CHECKED BY: MJC
PROJECT LEADER: MJC	SHEET 18 OF 41
DESIGNED BY: SEB	SIDEWALK MODIFICATIONS

GENERAL TEMPORARY TRAFFIC SIGNAL NOTES

- DESIGN OF THE SIGNAL SUPPORT(S) AND ANY REQUIRED GUYING IS THE RESPONSIBILITY OF THE CONTRACTOR.
- SIGNAL TIMING/TIMING ADJUSTMENTS REQUESTED BY THE ENGINEER SHALL BE ACCOMPLISHED WITHIN A 48 HOUR PERIOD AND PAYMENT SHALL BE INCIDENTAL TO THE TRAFFIC SIGNAL ITEM. THE ALL-RED CLEARANCE INTERVAL IS BASED ON AN ASSUMED SPEED OF 10-20 MPH, THE ENGINEER SHALL MAKE SEVERAL TRIAL RUNS TO DETERMINE THE PROPER ALL-RED CLEARANCE INTERVAL.
- THE SIGNAL SYSTEM SHALL INCLUDE "HARD WIRED" PREEMPTION. A MANUALLY OPERATED BUTTON LOCATED AS INDICATED ON THE PLANS (SEE SHEET 16) SHALL ACTIVATE THE SYSTEM. THE CONTRACTOR SHALL COORDINATE WITH RESIDENT ENGINEER, TOWN FIRE, AMBULANCE, POLICE AND ANY OTHER APPROPRIATE DEPARTMENTS TO DETERMINE THE PROPER TIMING REQUIRED FOR EMERGENCY VEHICLES TO CLEAR THE PROJECT AREA ONCE PREEMPTION IS ACTIVATED. SEVERAL TRIAL RUNS SHALL BE MADE. PAYMENT SHALL BE INCIDENTAL TO ITEM 678.40, TEMPORARY TRAFFIC SIGNAL SYSTEM.
- SIGNAL FACES SHALL CONSIST OF 12" LENSES. (RED, YELLOW, AND GREEN)
- THE BOTTOM OF THE HOUSING OF A SIGNAL FACE SUSPENDED OVER A ROADWAY SHALL NOT BE LESS THAN 16.5 FEET NOR MORE THAN 19 FEET ABOVE THE PAVEMENT GRADE AT THE CENTER OF THE ROADWAY. THE BOTTOM OF A SIGNAL FACE NOT MOUNTED OVER A ROADWAY, SHALL NOT BE LESS THAN 8 FEET NOR MORE THAN 15 FEET ABOVE THE GROUND. CAUTION SHOULD BE USED TO INSURE COMPLIANCE WITH THE HEIGHT REQUIREMENTS IN THE EVENT THE NEW APPROACH GRADES DIFFER SIGNIFICANTLY FROM THE OLD ROAD GRADE.
- SIGNAL FACES FOR ANY ONE APPROACH SHALL NOT BE LESS THAN 8 FEET APART MEASURED HORIZONTALLY BETWEEN CENTER FACES.
- SIGNAL HEADS MAY BE HUNG ON A SPAN WIRE OR ON A CANTILEVER MAST ARM. AT LEAST ONE SIGNAL HEAD SHALL BE UNMISTAKABLY IN LINE WITH THE CENTER OF APPROACHING TRAFFIC AT ALL TIMES. THE SECOND SIGNAL HEAD MAY BE POST MOUNTED, LOCATED AT A DISTANCE NO GREATER THAN 14.5 FEET FROM THE CENTER OF THE APPROACH LANE WHEN THE STOP BAR IS 40 FEET FROM THE SIGNAL HEAD. CONSULT THE M.U.T.C.D. 2003 EDITION FOR ADDITIONAL INFORMATION CONCERNING SIGNAL PLACEMENT.
- SIGNAL HEAD PLACEMENT IS CRITICAL. HEADS SHALL BE ADJUSTED TO REFLECT LANE LOCATION CHANGES.
- THE SIGNAL SYSTEM SHALL CONSIST OF POLES, SIGNS AND POSTS, WARNING SIGN, LUMINARIES, SIGNAL EQUIPMENT, CONTROLLER AND CABINET AND WIRING TO DETECTORS IN ACCORDANCE WITH THE STANDARD SPECIFICATIONS. IT ALSO INCLUDES PERMITS AND COSTS ASSOCIATED WITH PROVIDING ELECTRICAL POWER.
- THE CONTRACTOR SHALL PROVIDE AN ACTUATED CONTROLLER. THE APPROACHES NOTED SHALL HAVE A TEMPORARY DETECTOR. THE TYPE OF DETECTION SHALL BE AT THE OPTION OF THE CONTRACTOR. LOOPS ARE SHOWN FOR PLACEMENT PURPOSES ONLY. THE CONTROLLER, DETECTOR AND ALL OTHER SIGNAL EQUIPMENT SHALL MEET OR EXCEED ALL NEMA STANDARDS.
- WHEN USED, TEMPORARY DETECTOR SHALL BE 6' X 40' FOR PRESENCE DETECTION AT THE STOP BAR WITH THE NEAR PORTION LOCATED 5 FEET BEYOND THE STOP BAR.
- INTERVAL TIMING SHOWN IN SECONDS.
- INSTALL WIRING BETWEEN SIGNAL POLES BY WHATEVER MEANS POSSIBLE OR CONVENIENT TO PROVIDE FOR A SAFE INSTALLATION. ATTACHMENT TO UTILITY POLES TO BE COORDINATED BY THE CONTRACTOR WITH UTILITY COMPANY.
- PLACE TEMPORARY POLES BEHIND GUARDRAIL WHERE POSSIBLE.
- POLES SUPPORTING SPAN WIRES AND/OR MAST ARMS SHALL BE ADEQUATELY BRACED OR GUYED AND SHALL NOT BE PLACED SO AS TO CREATE A HAZARD TO THE TRAVELLING PUBLIC.
- ALL TEMPORARY SIGNAL EQUIPMENT, SIGNS, TYPE III BARRICADES, ETC., SHALL BELONG TO THE CONTRACTOR AT THE END OF THE PROJECT AND THE CONTRACTOR SHALL BE RESPONSIBLE FOR THEIR REMOVAL, INCLUDING ANY TEMPORARY PAVEMENT MARKINGS, UTILITY POLES, WIRES, ETC.
- A 250 WATT MER/150 WATT HPS LUMINAIRE AND MAST ARM SHALL BE PROVIDED ON A POLE ON EACH APPROACH AT A MOUNTING HEIGHT OF 30 FEET ABOVE ROADWAY CENTERLINE. THE INTENT IS TO LIGHT UP THE AREA AROUND THE SIGNAL HEADS AND STOP BAR FOR INCREASED VISIBILITY. THE ENGINEER SHALL DETERMINE THE ADEQUACY OF THE LIGHTING AND DIRECT CHANGES IF THE LIGHTING IS INSUFFICIENT.
- SIGNAL HEAD SHALL BE LOCATED A MINIMUM OF 40' AND A MAXIMUM OF 120' FROM THE NEAREST STOP BAR.
- PAYMENT FOR THE TEMPORARY DETECTORS SHALL BE FOR EACH UNIT INSTALLED.
- POSTS AS SHOWN ON THIS SHEET AND NOTED BELOW ARE INCIDENTAL TO THE TRAFFIC CONTROL SIGNAL ITEMS ("STOP HERE ON RED", "SIGNAL AHEAD", "NO PASSING ZONE", "NO TURN ON RED", AND "TO GET GREEN LIGHT", ETC.) THE TEMPORARY STOP BARS WILL BE PAID FOR UNDER THE TEMPORARY 24" STOP BAR ITEM.
- SEE STD. E-140 FOR "STOP HERE ON RED" AND "NO TURN ON RED" SIGN DETAIL. E-101 FOR "SIGNAL AHEAD" SYMBOL SIGN AND CHEVRON SYMBOL SIGN. SEE STANDARD E-102A FOR "ROAD CLOSED" SIGN. SEE STANDARD E-121 FOR SIGN PLACEMENT. SEE STANDARD E-171A AND E-172 FOR ADDITIONAL INFORMATION ON SIGNALS AND DETECTORS.
- ALL ELECTRICAL WORK SHALL MEET THE REQUIREMENTS OF THE NATIONAL ELECTRICAL CODE AND STATE INSPECTOR.
- ALL STOP SIGNS AND ANY TRAFFIC SIGNS MADE IRRELEVANT DUE TO THE TEMPORARY SIGNAL SHALL BE COVERED WITH A NON TRANSLUCENT WEATHER RESISTANT MATERIAL. THESE SIGNS SHOULD ONLY BE COVERED DURING THE OPERATION OF THE TEMPORARY SIGNAL OR AT THE DISCRETION OF THE ENGINEER. THE COSTS OF COVERING AND UNCOVERING THESE SIGNS SHALL BE INCLUDED IN THE PAYMENT FOR CONTRACT ITEM 678.40.
- CONSTRUCTION APPROACH SIGNS SHALL BE PROVIDED ON EACH APPROACH PER STANDARD E-100. ADDITIONAL CONSTRUCTION APPROACH SIGNS SHALL BE INSTALLED AS REQUIRED BY THE ENGINEER PER STANDARD E-100A, E-101, E-102 AND E-102A. PAYMENT FOR THESE SIGNS, THE REFLECTORIZED PLASTIC DRUMS, ETC., SHALL BE PAID AS A PART OF CONTRACT ITEM 641.10.

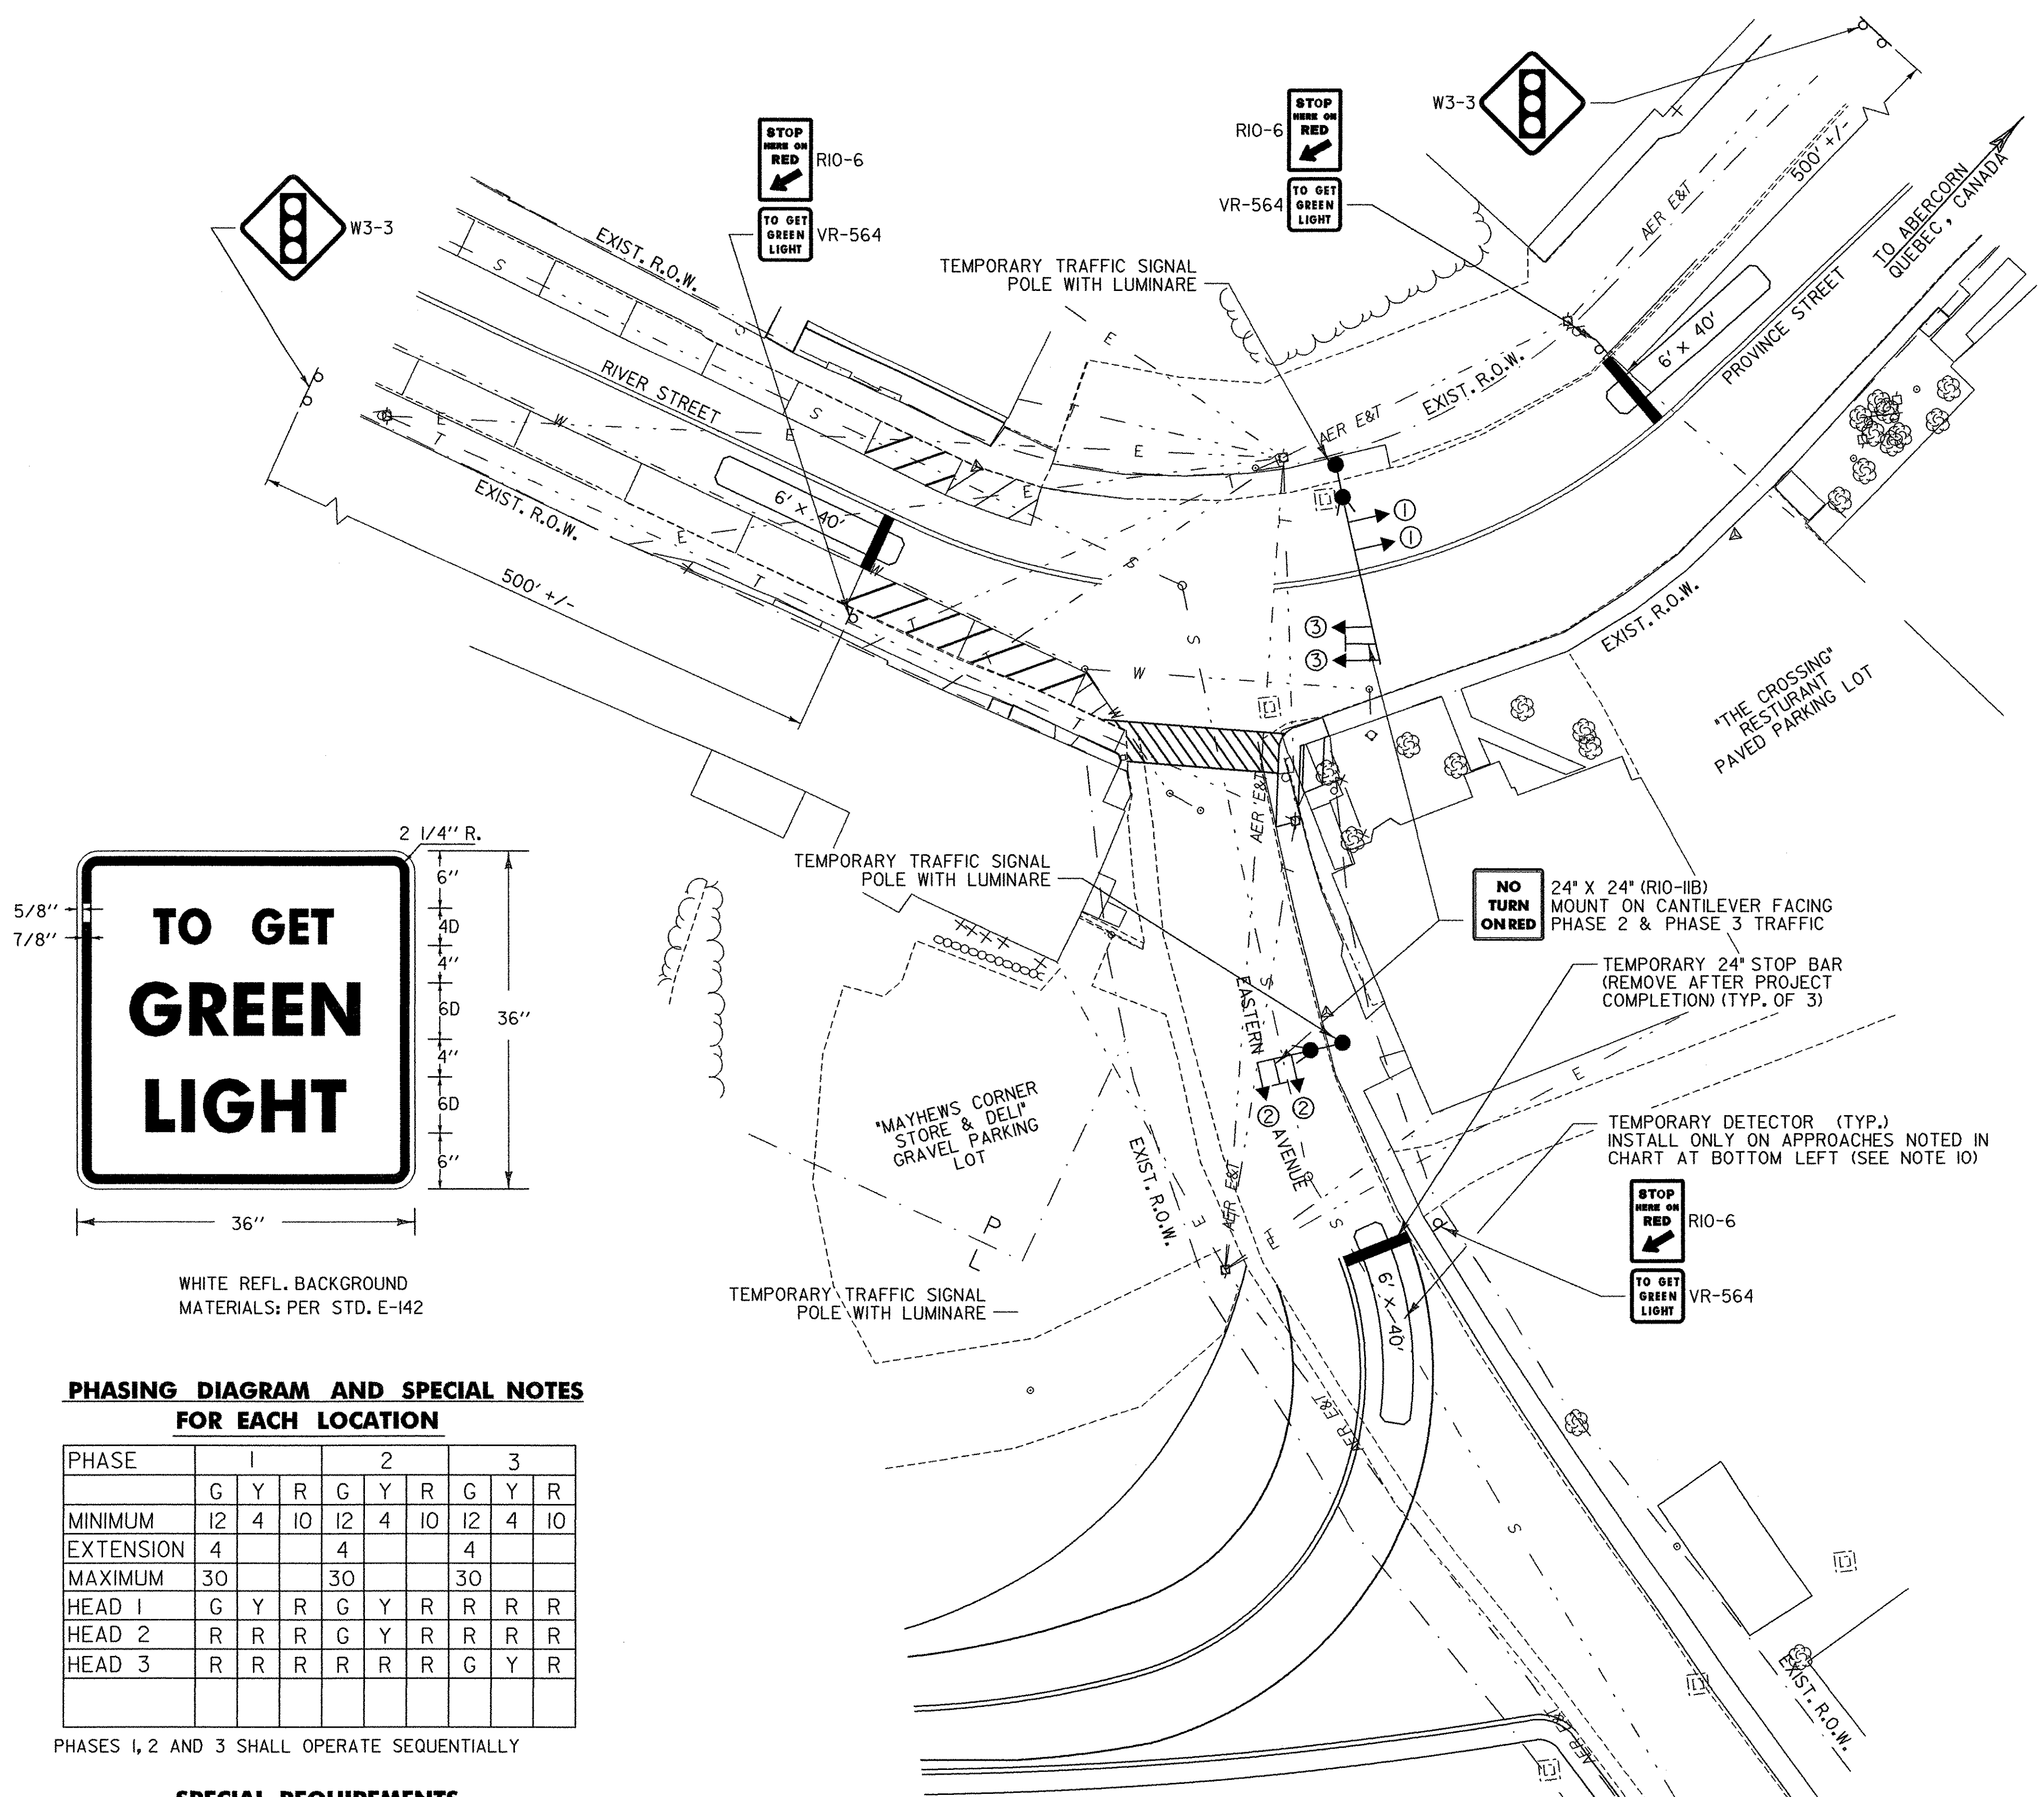

LEGEND

- — TRAFFIC SIGNAL POLE WITH LUMINAIRE
- ⊙ — SIGNAL HEAD AND PHASE
- ⊛ — FLASHING BEACON



STANDARDS REQUIRED:	E-100, E-100A, E-101, E-102, E-102A, E-106, E-107, E-107A, E-121, E-140, E-142, E-170, E-171A, E-171B, E-171C, E-172, E-175
PROJECT NAME:	RICHFORD
PROJECT NUMBER:	BHF 0302 (3) S
FILE NAME:	...Design\rich-signal.dgn
PLOT DATE:	12/18/2007
PROJECT LEADER:	MJC
DRAWN BY:	JTS
DESIGNED BY:	SEB
CHECKED BY:	MJC
TEMPORARY TRAFFIC SIGNAL PLAN	SHEET 19 OF 41

PROJECT NOTES

GENERAL

1. ALL MATERIALS AND CONSTRUCTION SHALL CONFORM TO STATE OF VERMONT, AGENCY OF TRANSPORTATION, 2006 STANDARD SPECIFICATIONS FOR CONSTRUCTION, AND ITS LATEST REVISIONS, AND THE AASHTO STANDARD SPECIFICATIONS FOR HIGHWAY BRIDGES, DATED 2002, AND ITS LATEST REVISIONS.
2. ALL WORK ON THIS PROJECT SHALL BE PERFORMED WITHIN THE EXISTING RIGHT-OF-WAY LIMITS, EXCEPT FOR WORK ASSOCIATED WITH THE TEMPORARY BRIDGE. NO ADDITIONAL PERMANENT R.O.W. RIGHTS ARE ANTICIPATED FOR THIS PROJECT.
3. NO EQUIPMENT SHALL BE PLACED IN THE WATERCOURSE. MATERIALS SHALL NOT BE PLACED IN THE WATERCOURSE, EXCEPT FOR CONSTRUCTION OF THE TEMPORARY BRIDGE PIER. AREA OF MATERIAL IMPACT FOR THE TEMPORARY PIER SHALL BE LIMITED TO 300 SF AND SHALL BE COMPLETELY REMOVED AT THE END OF CONSTRUCTION.
4. ALL DIMENSIONS SHOWN IN THE PLANS ARE HORIZONTAL OR VERTICAL AT 68 DEGREES FAHRENHEIT.
5. PLANS FOR THE EXISTING BRIDGE ARE NOT AVAILABLE. DIMENSIONS SHOWN ON EXISTING DETAILS ARE TAKEN FROM FIELD MEASUREMENTS MADE BY THE DESIGN ENGINEER AND ARE NOT GUARANTEED. THE CONTRACTOR SHALL DETERMINE AND VERIFY ALL DIMENSIONS AND EXISTING DETAILS NECESSARY FOR THE COMPLETION OF ALL WORK BY FIELD MEASUREMENT AND SURVEY. THE CONTRACTOR SHALL BE RESPONSIBLE FOR THE ADEQUACY AND ACCURACY THEREOF, AND SHALL NOT ORDER ANY MATERIAL OR COMMENCE ANY FABRICATION UNTIL THEY HAVE MADE THE REQUIRED MEASUREMENTS ON THE EXISTING STRUCTURE.
6. THE ITEMS 502.II, "SHORING SUPERSTRUCTURE BEARINGS (STA. 2+51.70) AND 502.II, "SHORING SUPERSTRUCTURE BEARINGS (STA. 3+76.70) SHALL BE PAYMENT FOR SUPPORTING THE SUPERSTRUCTURE WHILE THE SUBSTRUCTURES AND BEARINGS ARE BEING REPAIRED. THE BEARINGS AT ABUTMENTS NO. 1 AND NO. 2 SHALL BE JACKED SIMULTANEOUSLY ABOVE THE EXISTING TOP OF THE BEAM SEAT. ITEM 502.I0, "SHORING SUPERSTRUCTURE" SHALL BE PAYMENT FOR SUPPORTING THE SUPERSTRUCTURE IN PLACE DURING REPAIRS OR REMOVAL OFF-SITE FOR REPAIRS, AT THE DISCRETION OF THE CONTRACTOR.
7. THE FOLLOWING SHALL BE PAID FOR UNDER ITEM 529.20, "PARTIAL REMOVAL OF STRUCTURE"; REMOVAL AND DISPOSAL OF THE EXISTING CONCRETE BRIDGE DECK, BRIDGE CURBS, BRIDGE SIDEWALKS, BACKWALLS, AND ALL STEEL MEMBERS THAT ARE TO BE REPLACED AS DETAILED IN THE CONTRACT PLANS OR AS DIRECTED BY THE ENGINEER. REMOVAL OF BRIDGE PAVEMENT SHALL BE PAID FOR UNDER ITEM 529.I0, "REMOVAL OF BRIDGE PAVEMENT". THE EXISTING STRUCTURAL STEEL ON THIS PROJECT WAS PAINTED WITH A MATERIAL WHICH MAY CONTAIN LEAD. THE REMOVED STRUCTURAL STEEL IS THE PROPERTY OF THE CONTRACTOR. THE CONTRACTOR SHALL INDEMNIFY AND HOLD THE STATE, ITS OFFICERS AND EMPLOYEES HARMLESS CONCERNING THE CONTRACTOR'S USE OR DISPOSITION OF THE STRUCTURAL STEEL. TEN DAYS PRIOR TO COMMENCING WORK WHICH INVOLVES THE HANDLING OR DISTURBANCE OF PAINTED COMPONENTS, THE CONTRACTOR SHALL PROVIDE DOCUMENTS TO THE ENGINEER, AS REFERENCED IN SECTION 513 OF THE SPECIFICATIONS.

CONCRETE AND REINFORCING STEEL

8. CONCRETE FOR THE DECK, EXPANSION JOINT BLOCKOUT AND CURBS SHALL BE HIGH PERFORMANCE CLASS A AND WILL BE PAID FOR UNDER ITEM 501.33, "CONCRETE, HIGH PERFORMANCE CLASS A (FPQ)". ALL OTHER CONCRETE SHALL BE HIGH PERFORMANCE CLASS B AND WILL BE PAID FOR UNDER ITEM 501.34, "CONCRETE, HIGH PERFORMANCE CLASS B" UNLESS OTHERWISE NOTED.
9. WATER REPELLENT, SILANE SHALL BE APPLIED TO ALL EXPOSED CONCRETE SURFACES.
10. ALL EXPOSED EDGES OF CONCRETE SHALL BE CHAMFERED 1".

11. CONCRETE CONSTRUCTION JOINTS SHALL BE CONSTRUCTED AS SHOWN ON SHEET 25 OF THE PLANS OR AS DIRECTED BY THE ENGINEER.
12. ALL SUPERSTRUCTURE REINFORCING STEEL SHALL BE EPOXY COATED AND PAID FOR UNDER ITEM 507.I7, "EPOXY COATED REINFORCING STEEL" UNLESS NOTED OTHERWISE. WHEN EPOXY COATED REINFORCING STEEL IS TO BE CUT, THE UNCOATED ENDS SHALL BE REPAIRED WITH MATERIALS AND PROCEDURES APPROVED BY THE COATING MANUFACTURER. FLAME CUTTING OF EPOXY COATED REINFORCING STEEL WILL NOT BE PERMITTED.
13. ALL SUBSTRUCTURE REINFORCING STEEL SHALL BE PAID FOR UNDER ITEM 507.I5, "REINFORCING STEEL".
14. ALL REINFORCING STEEL SHALL BE DETAILED AND FABRICATED USING PROCEDURES AND TOLERANCES IN ACCORDANCE WITH AND APPLICABLE PUBLICATIONS OF THE "CONCRETE REINFORCING STEEL INSTITUTE."
15. MINIMUM COVER FOR REINFORCING STEEL IN THE SUBSTRUCTURES SHALL BE TWO INCHES ALONG WALL FACES AGAINST EARTH, AND THREE INCHES ELSEWHERE UNLESS DETAILED OTHERWISE.
16. REINFORCING PLACEMENT TOLERANCES SHALL BE:
SPACING +/- 1"
CLEARANCE +/- 1/4"
17. SURFACES OF BRIDGE SEATS UNDER BEARING DEVICES SHALL BE LEVEL. THE BRIDGE SEAT SURFACE SHALL BE GIVEN A STEEL TROWEL FINISH.

STRUCTURAL STEEL

18. ALL STRUCTURAL COMPONENTS OF THE BRIDGE SHALL BE INSPECTED BY THE CONTRACTOR AND THE ENGINEER FOR ADDITIONAL AREAS IN NEED OF REPAIR NOT SHOWN ON THE CONTRACT DOCUMENTS. SOME OF THE AREAS INDICATED ON THESE PLANS AS REQUIRING PATCHES MAY HAVE BEEN PATCHED SUBSEQUENT TO DEVELOPMENT OF THESE PLANS, AND ADDITIONAL AREAS OF PATCHING ARE ANTICIPATED. ANY ADDITIONAL REPAIRS SHALL BE MADE AT THE DISCRETION OF THE ENGINEER AND SHALL BE APPROVED BY THE ENGINEER. THE PLATES USED FOR PATCHING SHALL BE 3/8" THICK AND CUT TO THE REQUIRED SIZE BASED ON FIELD MEASUREMENTS. ADDITIONAL REPAIRS SHALL BE PAID FOR UNDER CONTRACT ITEM 506.60.
19. ALL NEW STEEL BEAMS, CHANNELS, CONNECTION ANGLES, PLATES, WASHER PLATES AND BOLTS SHALL BE PAID FOR UNDER ITEM 506.50, "STRUCTURAL STEEL, ROLLED BEAM". ALL 3/8" PATCHING PLATES, SCUPPERS AND DOWNSPOUTS SHALL BE PAID FOR UNDER ITEM 506.60, "STRUCTURAL STEEL".
20. ALL STRUCTURAL STEEL PAID UNDER THE ITEM 506.50, "STRUCTURAL STEEL, ROLLED BEAM" SHALL CONFORM TO AASHTO M 270M/M 270 GRADE 50 UNLESS NOTED OTHERWISE ON THE PLANS. ALL STRUCTURAL STEEL PAID UNDER THE ITEM 506.60, "STRUCTURAL STEEL" SHALL CONFORM TO AASHTO M 270M/M 270 GRADE 36 OR HIGHER UNLESS NOTED OTHERWISE ON THE PLANS. EXCEPT ALL STRUCTURAL TUBING SHALL CONFORM TO SUBSECTIONS 714.II OR 732.03, AS NOTED ON THE PLANS.
21. ANY EXISTING RIVETS THAT ARE MISSING OR REMOVED FOR REPAIRS AS DETAILED ON THE PLANS OR AS ORDERED BY THE ENGINEER SHALL BE REPLACED WITH 7/8" DIAMETER HIGH STRENGTH BOLTS MEETING THE REQUIREMENTS OF NOTE 22 AND 23. WHERE RIVET HEADS ARE IN DIRECT CONTACT WITH MEMBERS TO BE RETAINED, TORCHES AND/OR THE USE OF FLAME CUTTING WILL NOT BE PERMITTED FOR ANY PORTION OF THE RIVET REMOVAL. THE CONTRACTOR SHALL VERIFY THAT THE EXISTING HOLE DIAMETER IS 15/16" AND BRING ANY DISCREPANCIES TO THE ATTENTION OF THE ENGINEER. THE BOLTS SHALL BE TIGHTENED IN ACCORDANCE WITH SUBSECTION 506.I9 OF THE STANDARD SPECIFICATIONS.

22. ALL NEW CONNECTIONS SHALL BE MADE WITH 7/8" DIAMETER HIGH STRENGTH BOLTS, MEETING AASHTO M-164 TYPE I. ALL BOLTS SHALL BE FULL DIAMETER BODY ROUND HEAD BOLTS MEETING ANSI/ASME B 18.5 REQUIREMENTS. EXCEPT BOLTS FOR THE NEW BRIDGE RAILING AND SIDEWALK STRINGERS SHALL BE 3/4" DIAMETER MEETING THE REQUIREMENTS ABOVE. CONNECTIONS NOT DESIGNATED SHALL BE DETAILED BY THE FABRICATOR AND SUBMITTED TO THE ENGINEER FOR APPROVAL.
23. ALL BOLTS SHALL BE GALVANIZED IN ACCORDANCE WITH AASHTO M-298. BOLTS SHALL NOT BE PAID FOR DIRECTLY BUT SHALL BE INCIDENTAL TO ITEM 506.50, "STRUCTURAL STEEL, ROLLED BEAMS". THE FASTENERS SHALL RECEIVE INTERMEDIATE AND FINAL COATS OF THE PAINT SYSTEM AFTER INSTALLATION.
24. THE SURFACE PREPARATION OF THE EXISTING STEEL SHALL INCLUDE 100% REMOVAL OF THE EXISTING PAINT SYSTEM.
25. THE COLOR OF THE FINAL COAT OF PAINT SHALL BE GREEN CONFORMING TO SUBSECTION 708.03.
26. THE EXISTING HANDRAIL TO BE RETAINED SHALL HAVE THE EXISTING PAINT REMOVED AND BE PAINTED USING THE SAME PAINT SYSTEM AS THE BRIDGE STEEL. THE REMOVAL OF EXISTING PAINT AND PAINTING OF THE RETAINED HANDRAIL SHALL BE INCIDENTAL TO ITEMS 513.41, "SURFACE PREPARATION, FIELD (30 TONS)", 513.36, "CONTAINMENT & ENVIRONMENTAL PROTECTION, FIELD", AND 513.30, "STRUCTURAL PAINTING, FIELD APPLIED (30 TONS)".
27. ALL NEW STEEL ELEMENTS PROVIDED UNDER THE ITEMS 506.50, "STRUCTURAL STEEL, ROLLED BEAMS", 900.640, "SPECIAL PROVISIONS (BOX BEAM GUARD RAIL, TRUSS)" AND 900.640, "SPECIAL PROVISION (BRIDGE RAILING, TRUSS)" SHALL BE GIVEN A SHOP APPLIED PRIMER, INTERMEDIATE AND TOP COATING OF PAINT PER SECTION 513. THE PRIMER SYSTEM USED IN THE SHOP SHALL BE THE SAME SYSTEM AS THAT EMPLOYED FOR THE FIELD APPLIED PAINT SYSTEM.
28. AFTER THE FINAL COAT OF FIELD APPLIED PAINT HAS BEEN APPLIED AND THOROUGHLY CURED, BUT PRIOR TO THE REMOVAL OF THE ENVIRONMENTAL PROTECTION, THE FOLLOWING STRUCTURAL STEEL SHALL BE GREASED PER SECTION 513; ENTIRE BRIDGE FLOOR SYSTEM, EXCEPT THE UNDERSIDE OF THE DECK. ALL TRUSS COMPONENTS BELOW THE TOP OF THE CURB, AND THE BEARINGS. PAYMENT FOR THE GREASE SHALL BE INCIDENTAL TO THE ITEM 513.30 "STRUCTURAL PAINTING, FIELD APPLIED (30 TONS)". THE COLOR OF THE GREASE SHALL BE GREEN.

EROSION CONTROL




29. APPROPRIATE EROSION CONTROL MEASURES SHALL BE UTILIZED THROUGHOUT THE DURATION OF THE CONSTRUCTION AS INDICATED ON THE PLANS AND AS DIRECTED BY THE ENGINEER.




Stantec

PROJECT NAME: RICHFORD
PROJECT NUMBER: BHF 0302 (3) S


FILE NAME: ...Design\Rich-notes.dgn PLOT DATE: 12/18/2007
PROJECT LEADER: MJC DRAWN BY: AET
DESIGNED BY: SEB CHECKED BY: MJC
PROJECT NOTES SHEET 21 OF 41

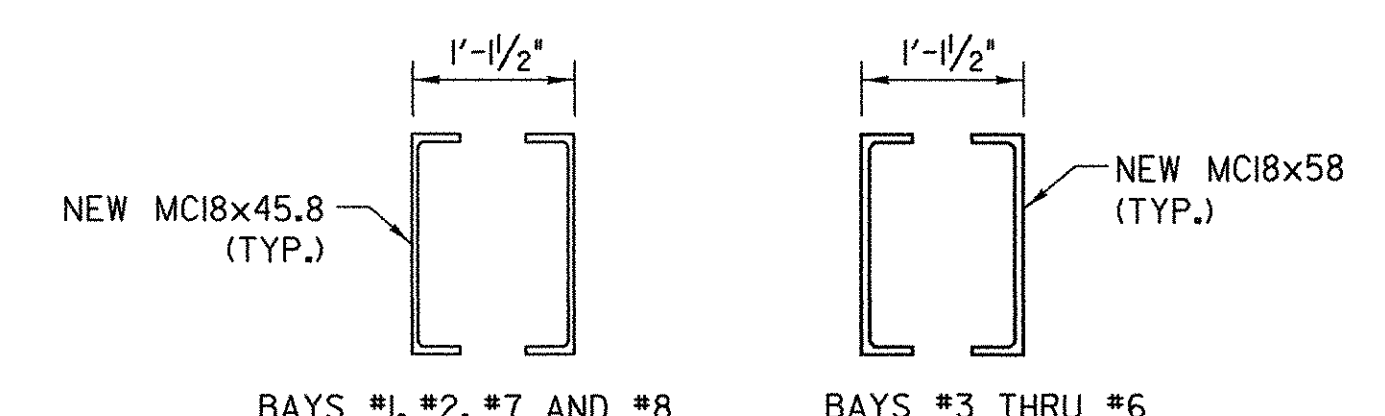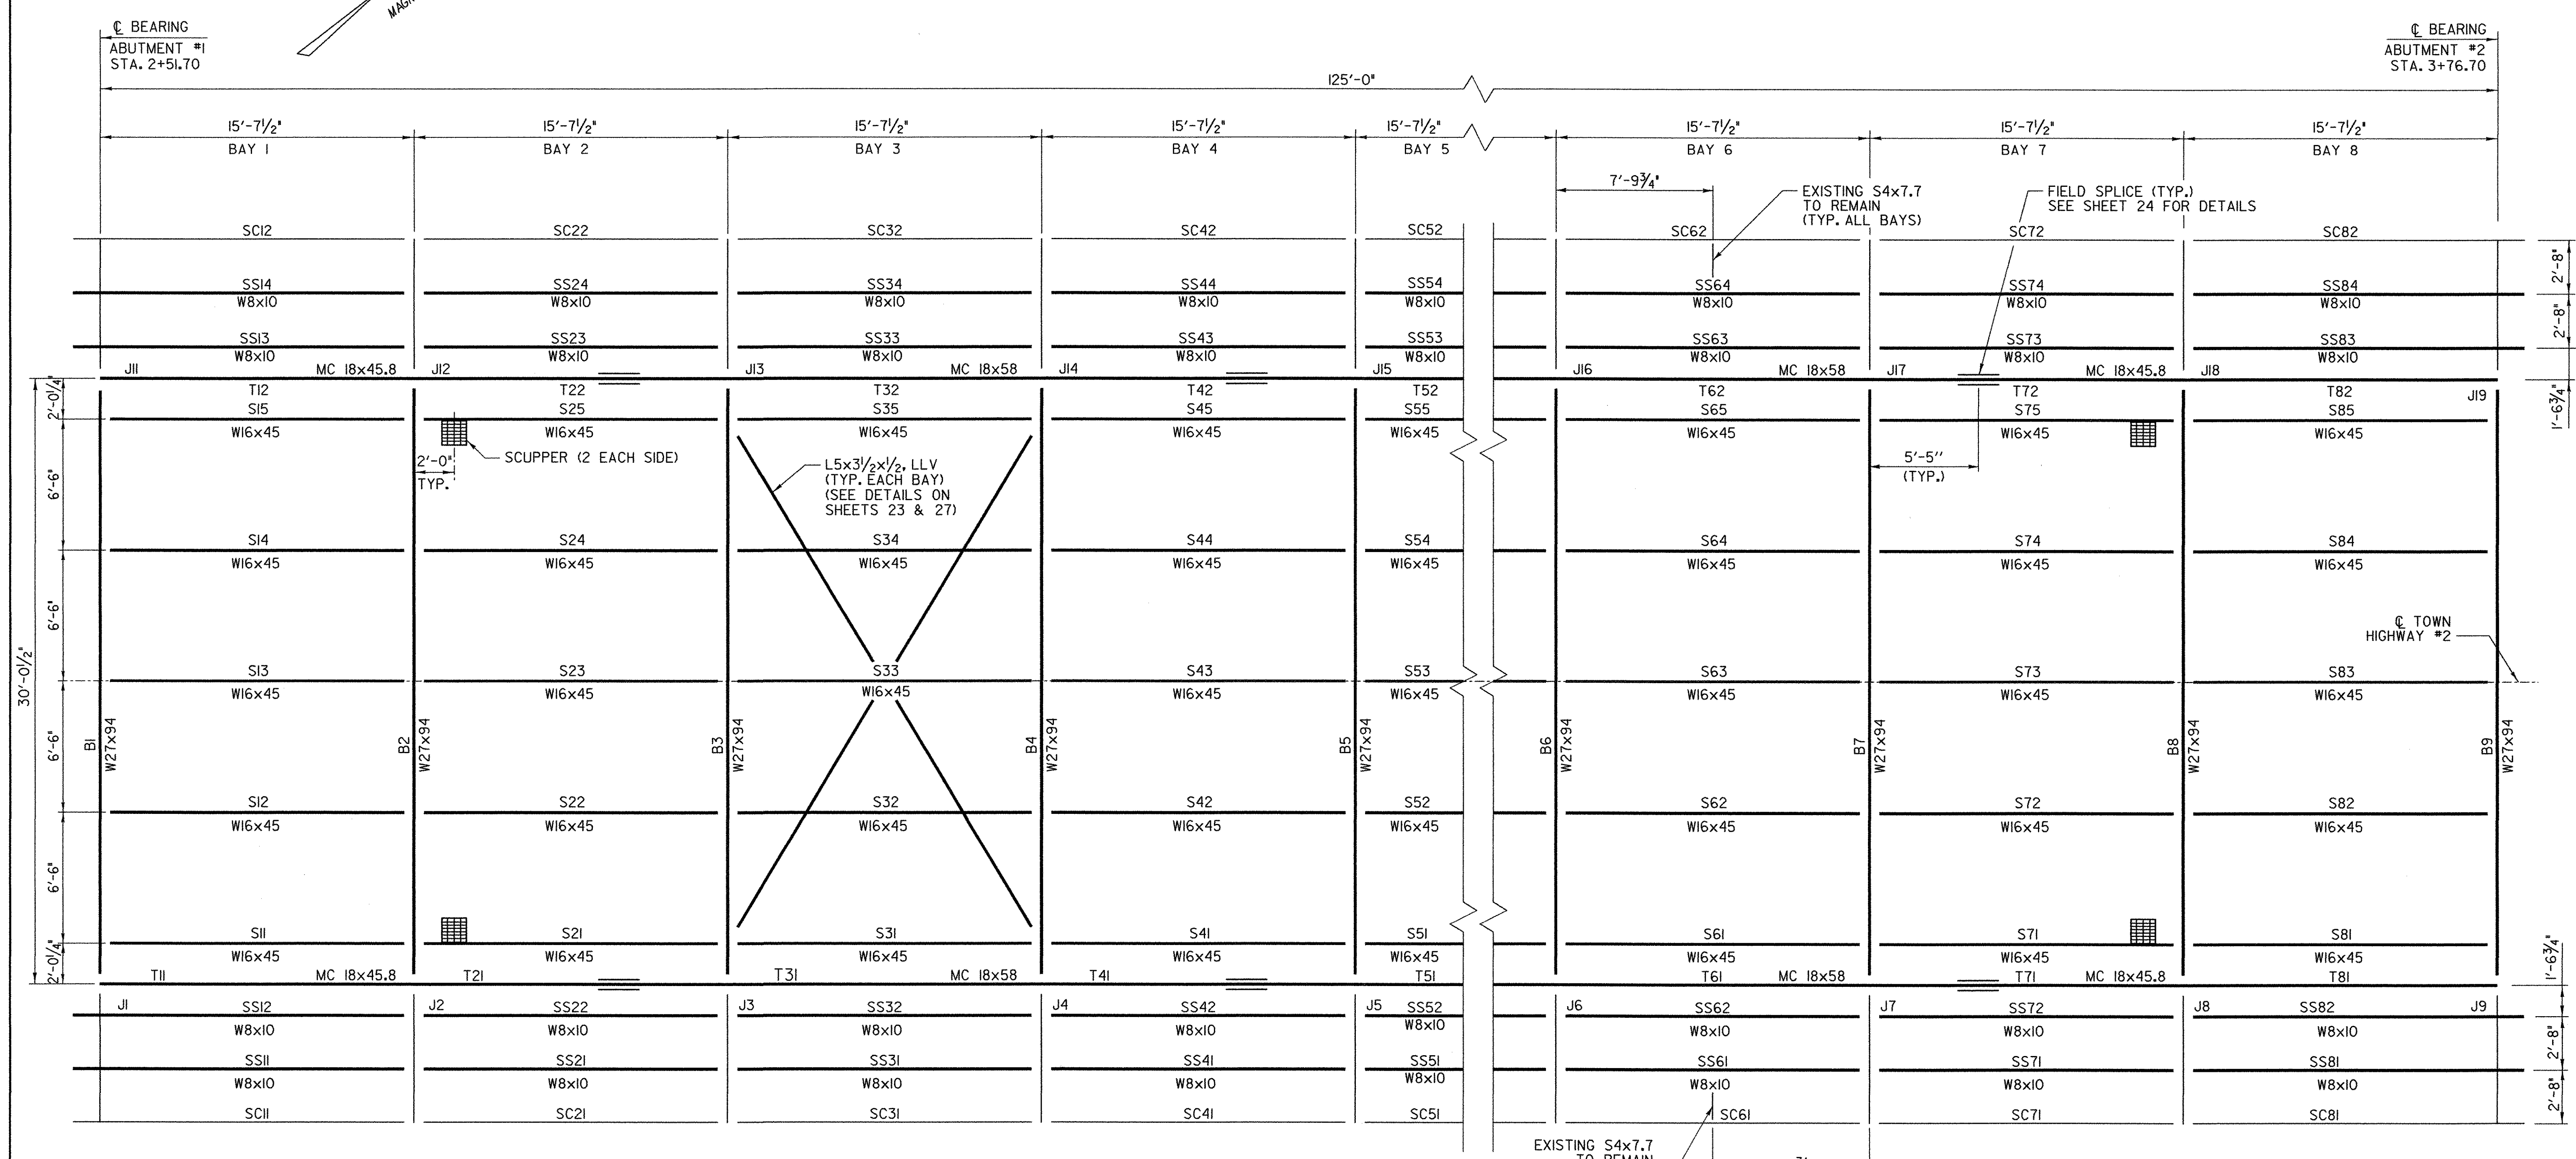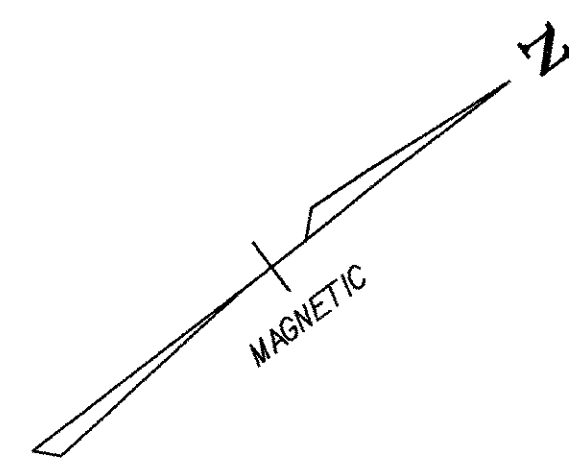

BOTTOM CHORD SECTIONS

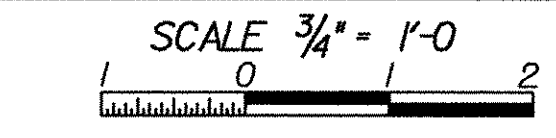




FRAMING PLAN

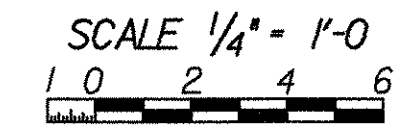



- LEGEND**
- J = JOINT
 - S = FLOOR STRINGER (NEW W16x45)
 - B = BEAM (NEW W27x94)
 - T = TRUSS BOTTOM CHORD (SEE SECTIONS AT LEFT)
 - SS = SIDEWALK STRINGER (NEW W8x10)
 - SC = EXISTING SIDEWALK CHANNEL (C7)
 - = NEW FRAMING MEMBER
 - = EXISTING FRAMING MEMBER TO BE RETAINED




PROJECT NAME: RICHFORD	PLOT DATE: 12/18/2007
PROJECT NUMBER: BHF 0302 (3) S	DRAWN BY: JJS
FILE NAME: ...Design\Rich-frame.dgn	CHECKED BY: MJC
PROJECT LEADER: MJC	SHEET 22 OF 41
DESIGNED BY: SEB	

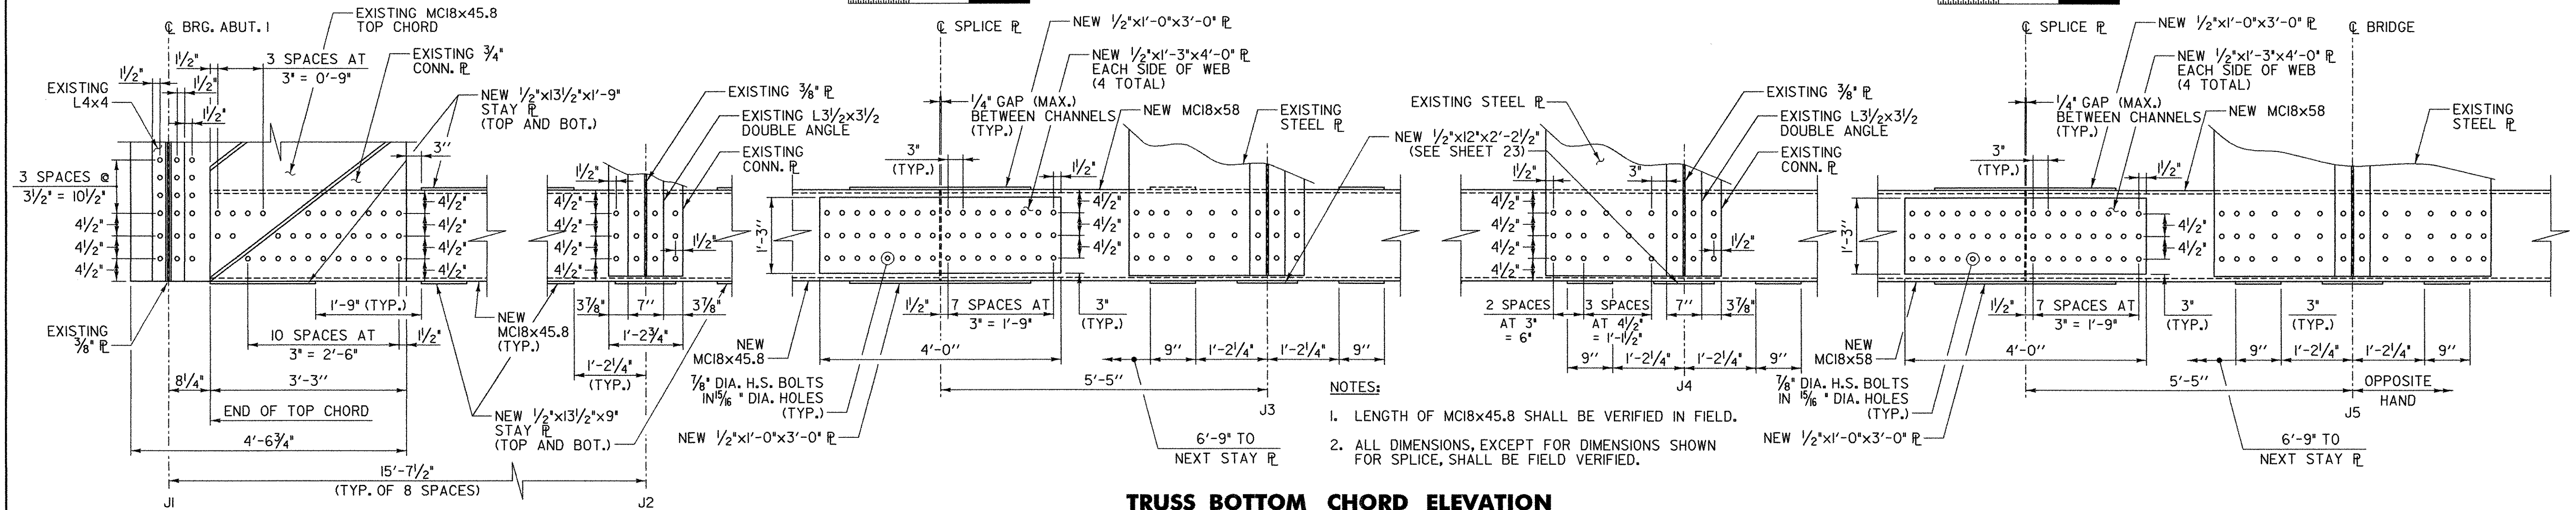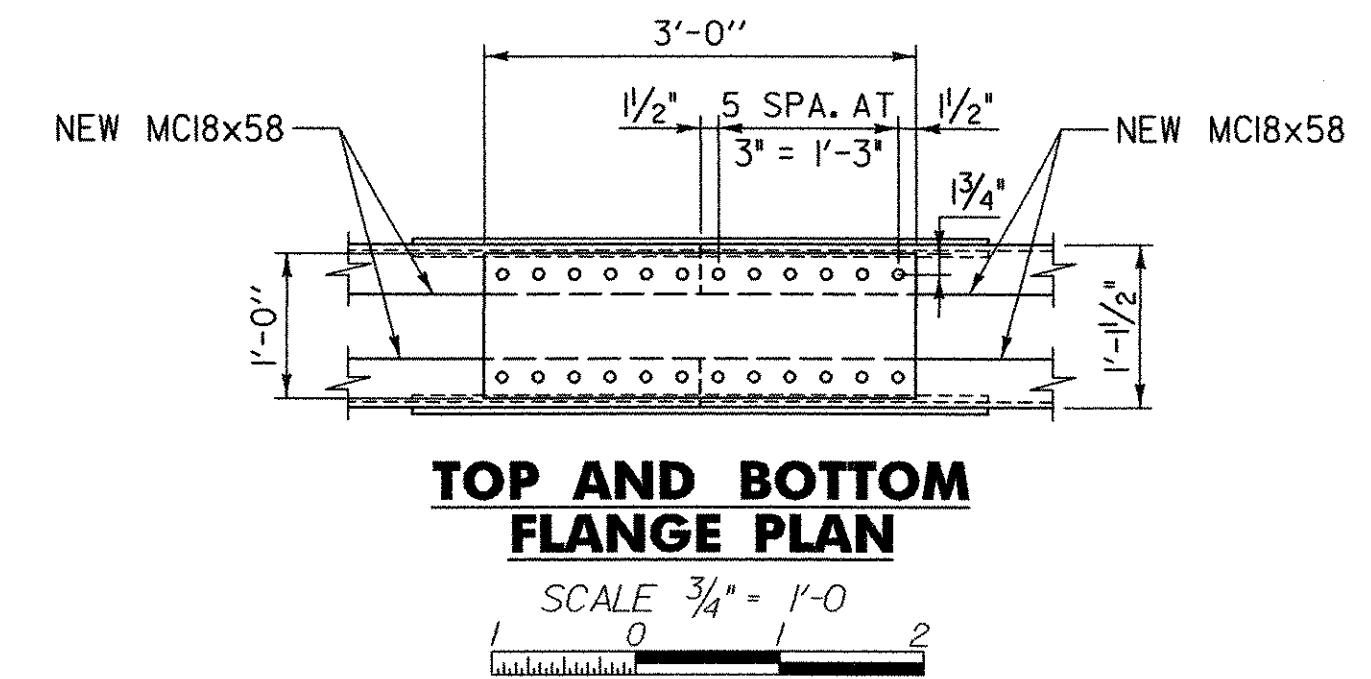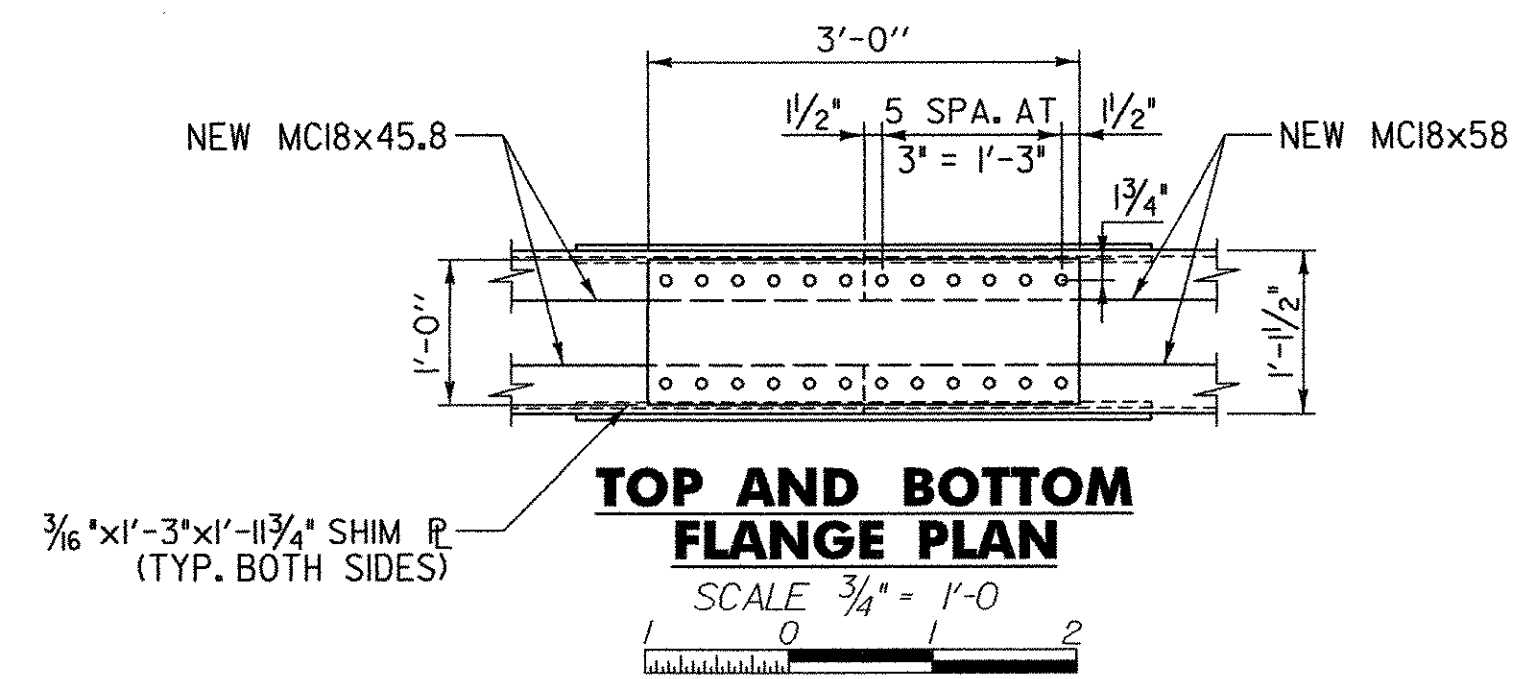


TRUSS BOTTOM CHORD ELEVATION

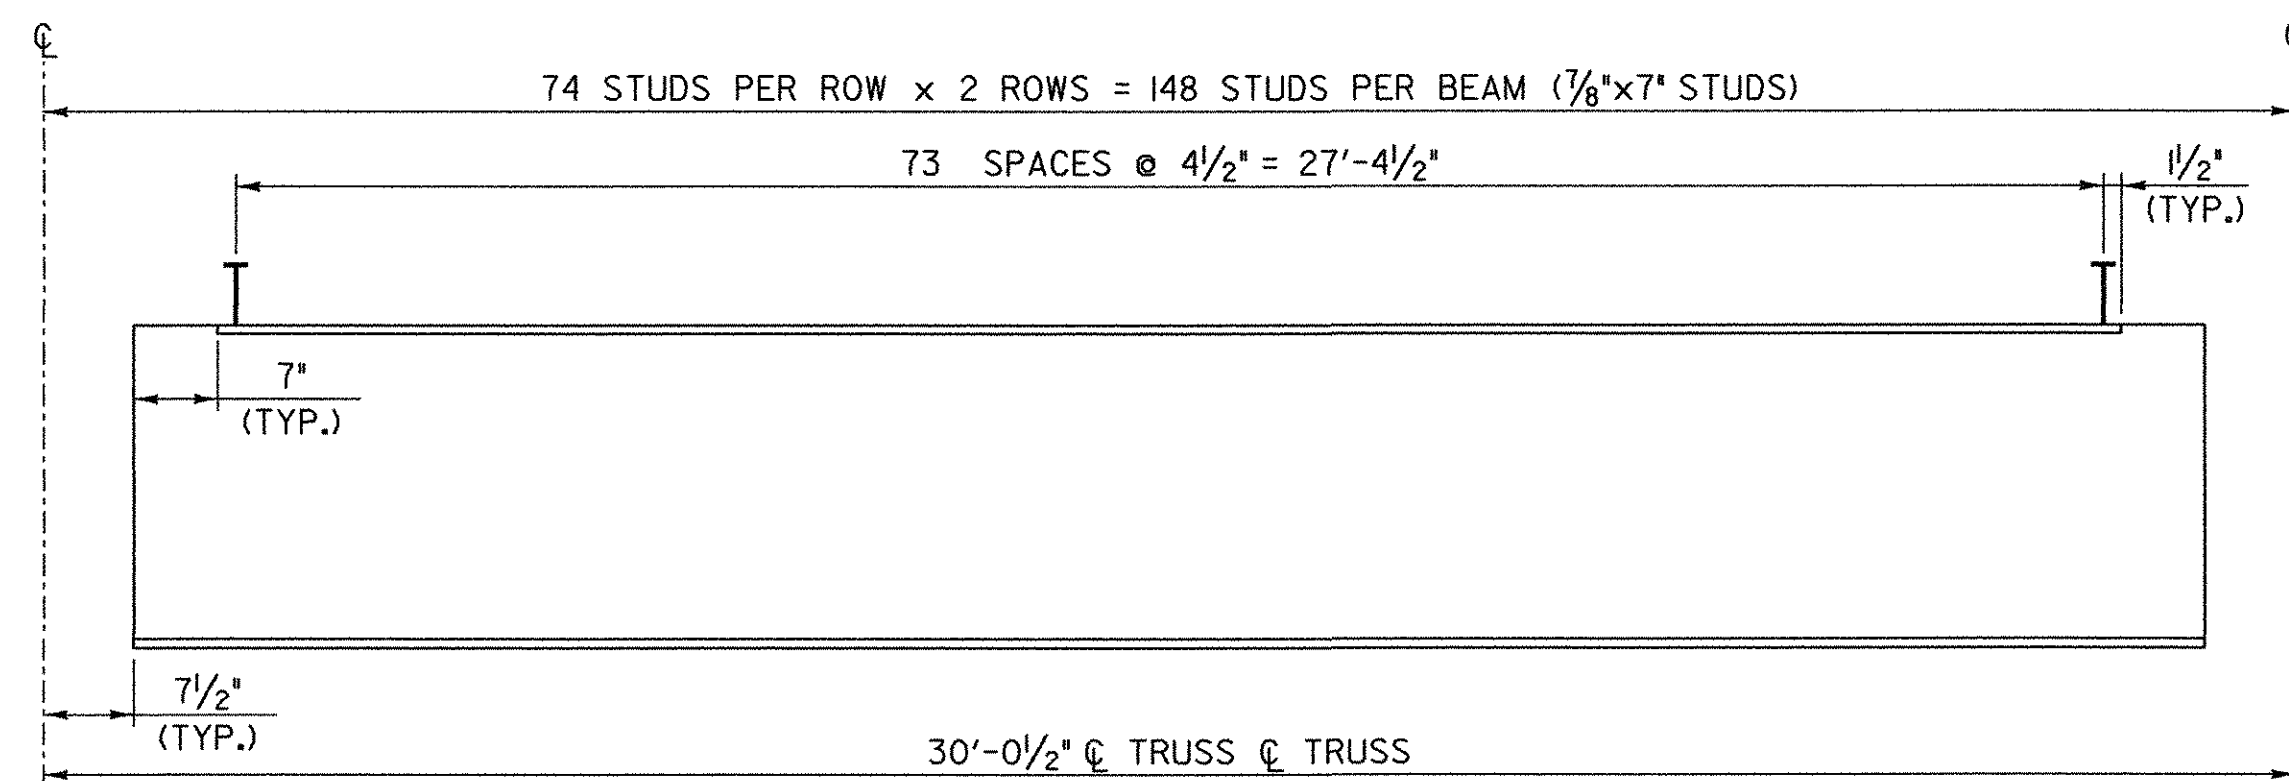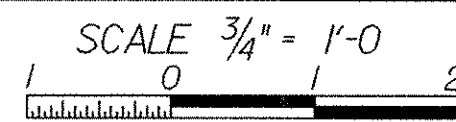



W27 ELEVATION
NOT TO SCALE

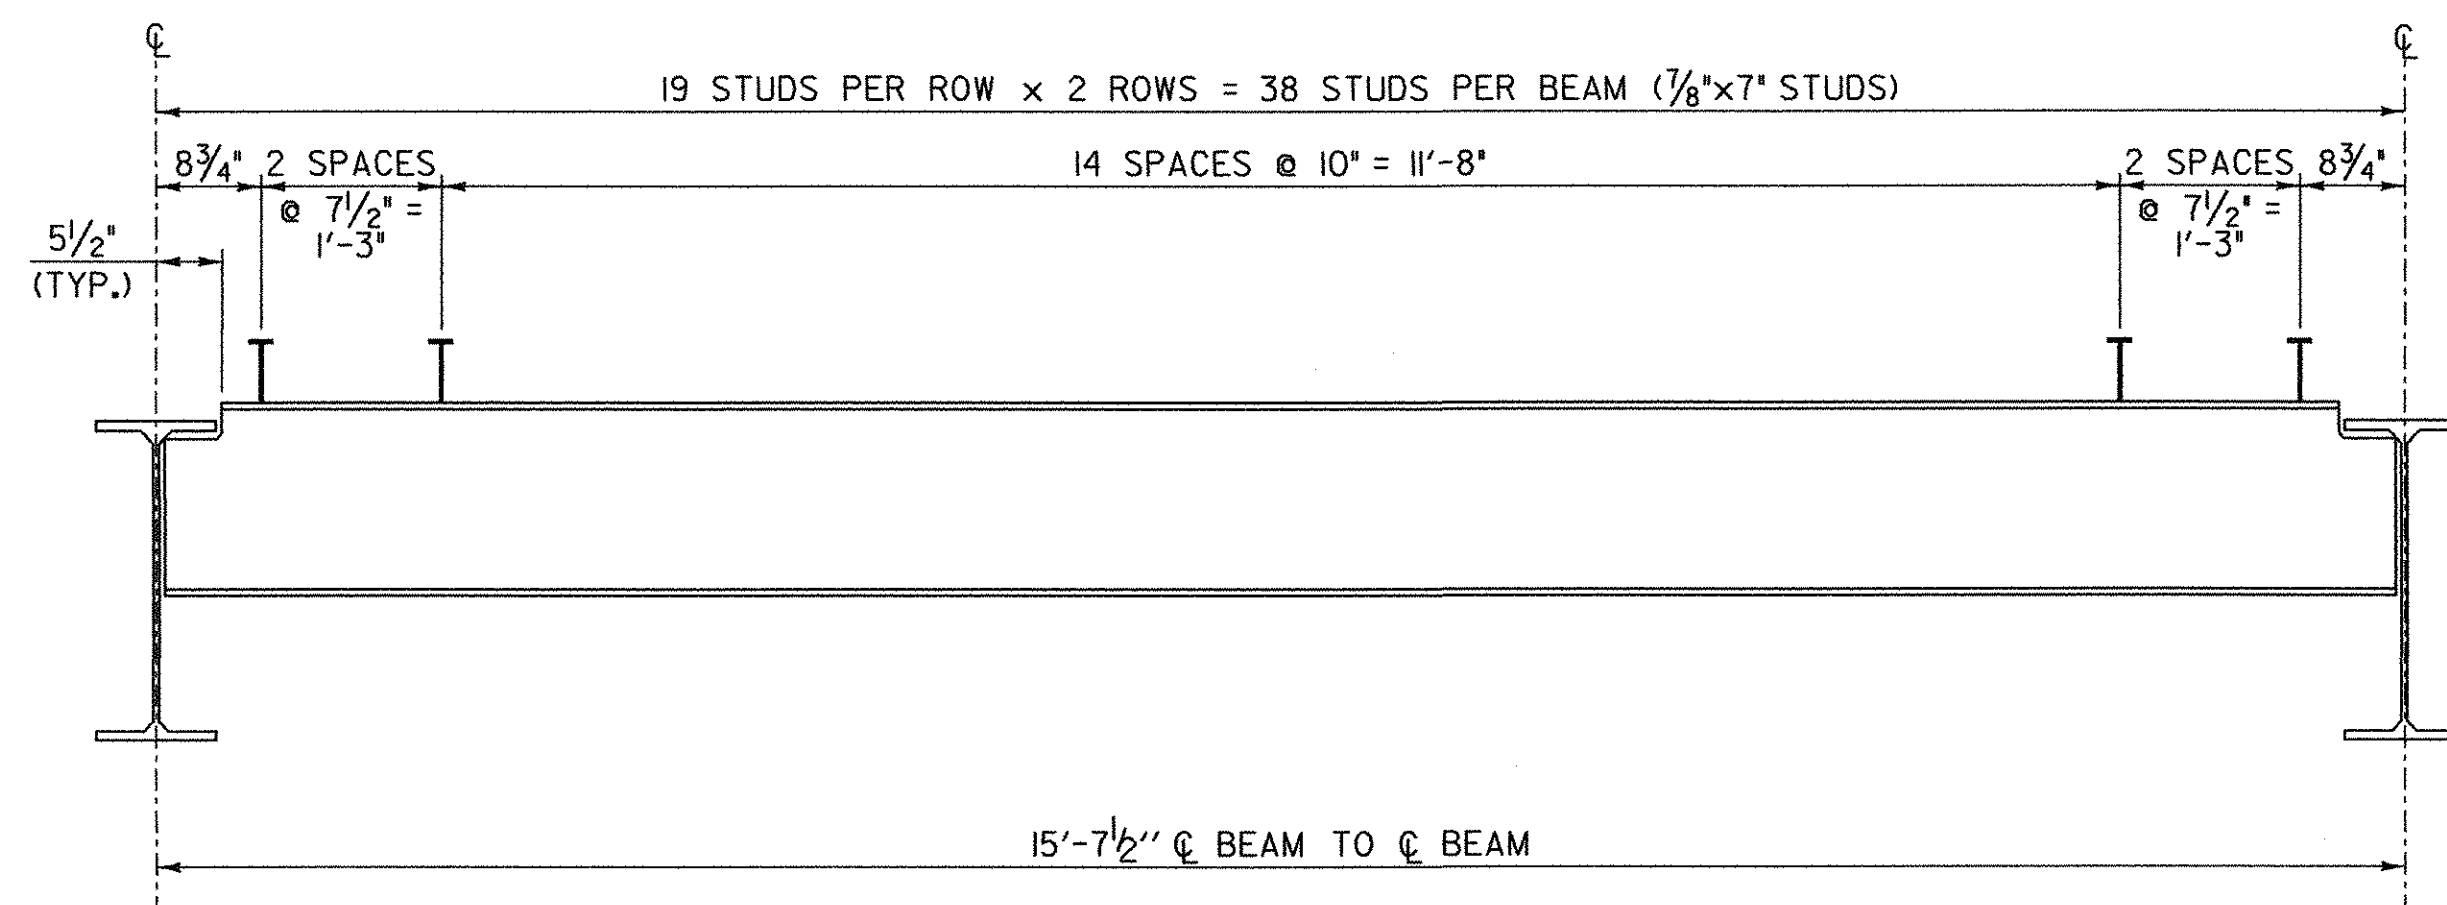


W16 ELEVATION
NOT TO SCALE

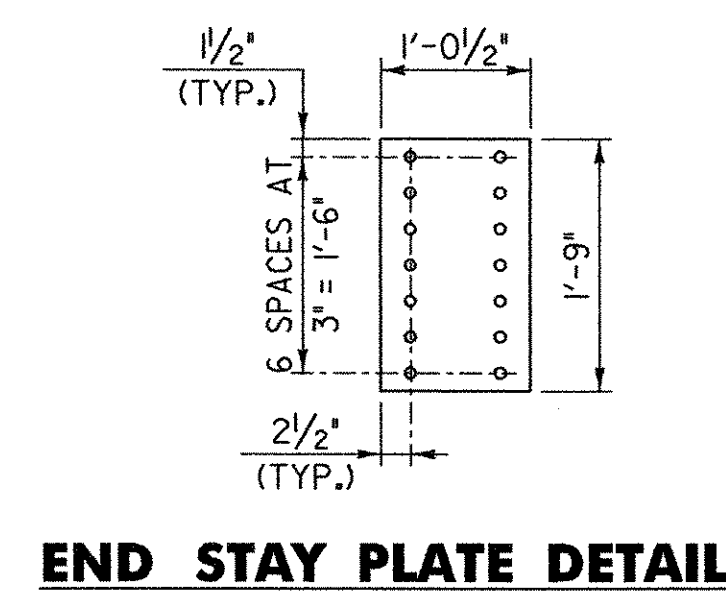


END STAY PLATE DETAIL

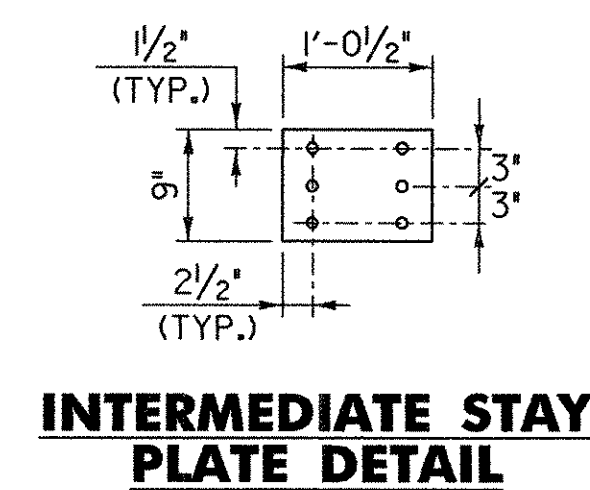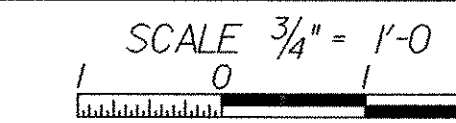


INTERMEDIATE STAY PLATE DETAIL

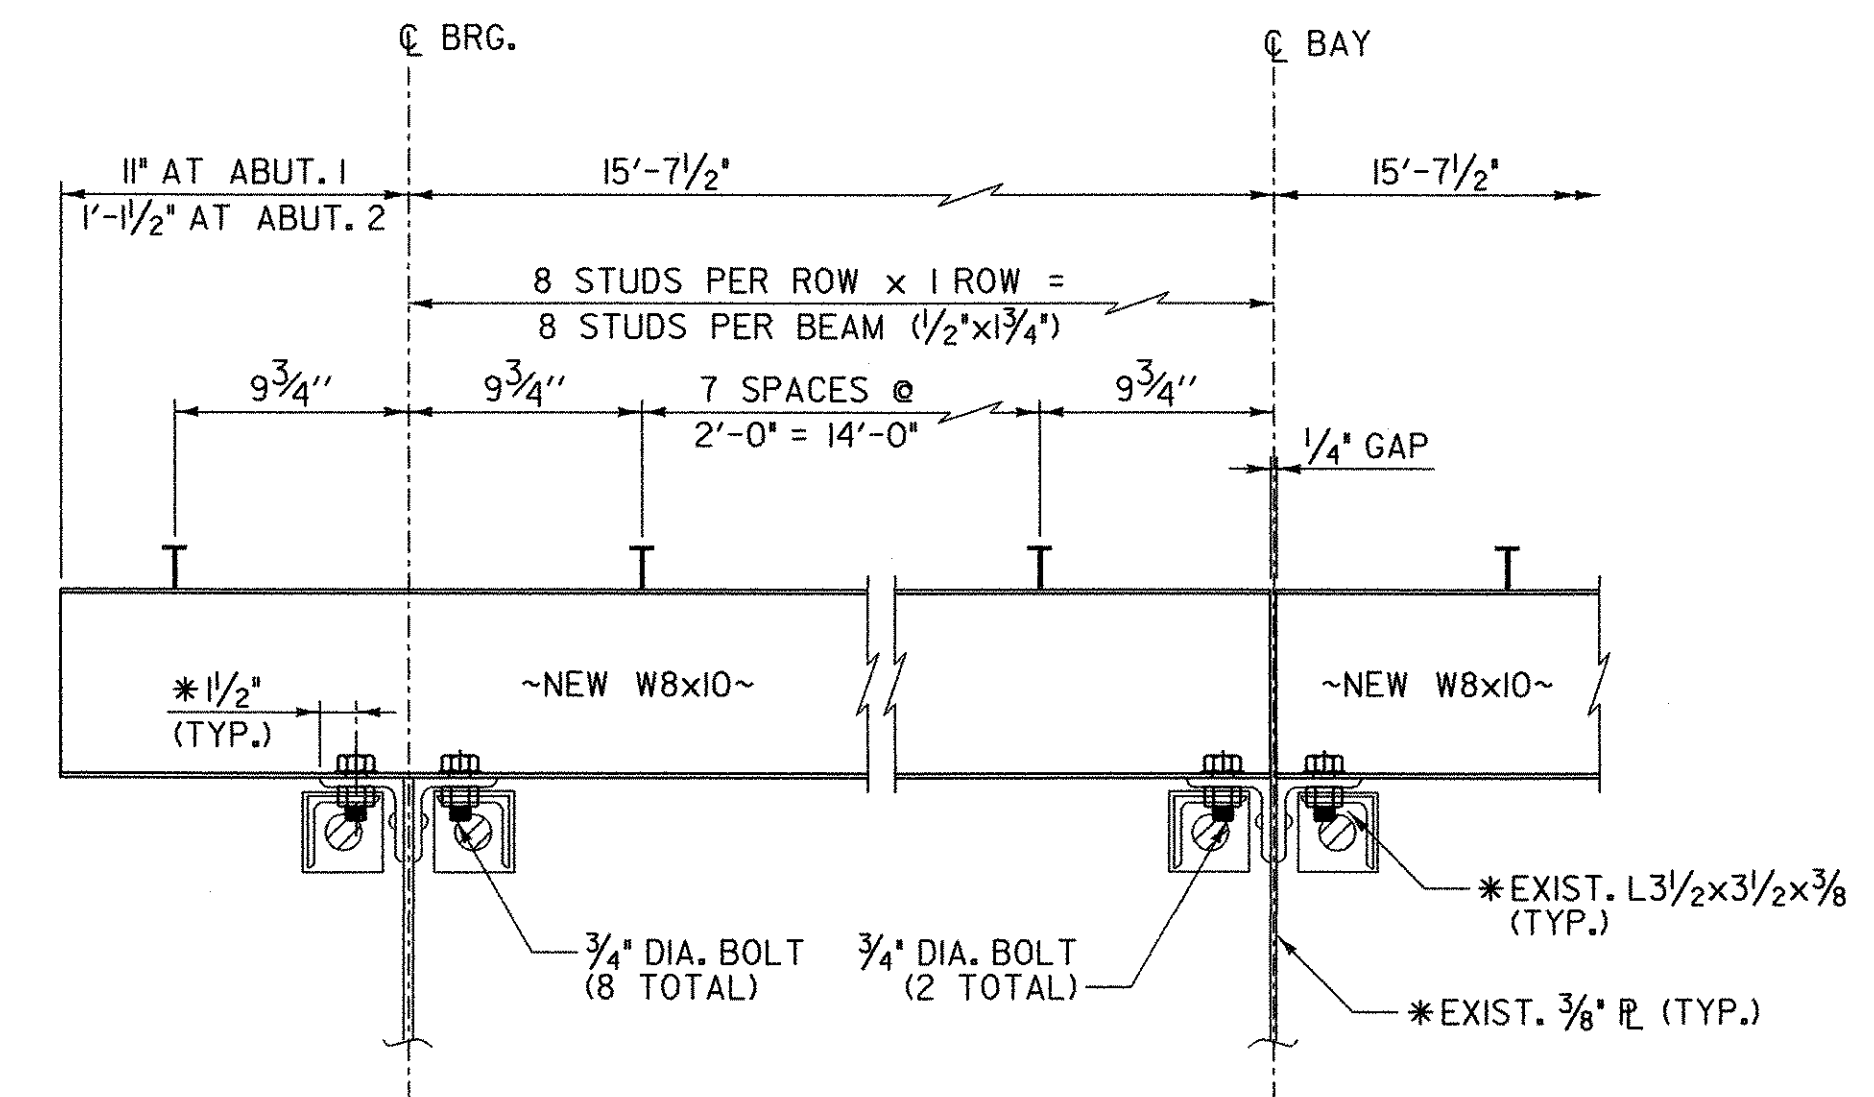

SIDEWALK STRINGER CONNECTION DETAIL

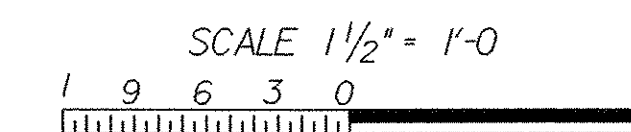

PROJECT NAME: RICHFORD
 PROJECT NUMBER: BHF 0302 (3) S
 FILE NAME: ...Design\Rich-steel\dets2.dgn PLOT DATE: 12/18/2007
 PROJECT LEADER: MJC DRAWN BY: JJS
 DESIGNED BY: SEB CHECKED BY: MJC
STEEL DETAILS SHEET 2 SHEET 24 OF 41

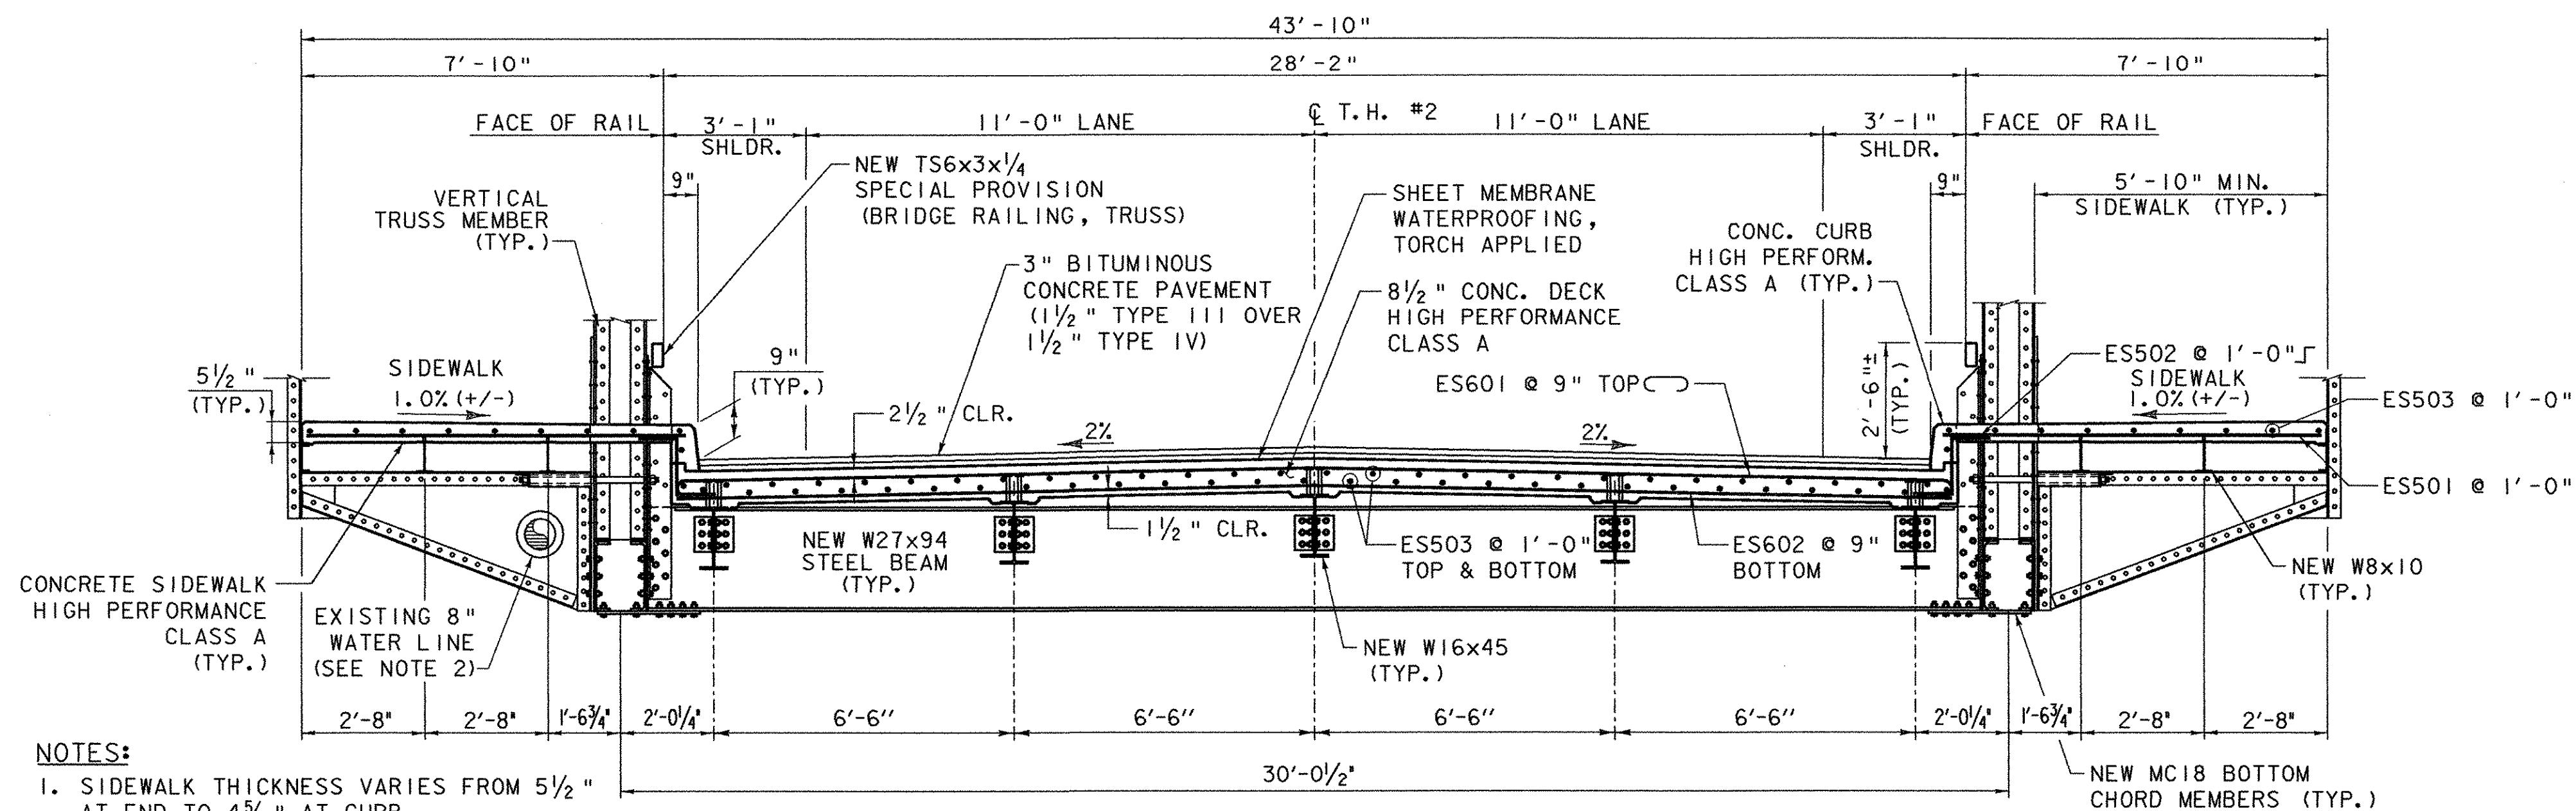



NOTES:

1. SIDEWALK THICKNESS VARIES FROM 5 1/2" AT END TO 4 3/8" AT CURB.
2. EXISTING 8" WATER LINE TO BE PROTECTED AND MAINTAINED IN SERVICE DURING CONSTRUCTION. IF THE CONTRACTOR CHOOSES TO REMOVE THE TRUSS FROM THE SITE FOR REHABILITATION AND/OR PAINTING, THE CONTRACTOR SHALL PROVIDE TEMPORARY WATER SERVICE MEETING THE REQUIREMENTS OF SECTION 629. PAYMENT FOR PROTECTING AND MAINTAINING WATERLINE SERVICE SHALL BE INCIDENTAL TO ALL CONTRACT ITEMS.


NOTE: ANY MEMBERS THAT ARE NOT OTHERWISE NOTED AS NEW, SHALL BE RETAINED.

TYPICAL DECK SECTION

SCALE 3/8" = 1'-0"

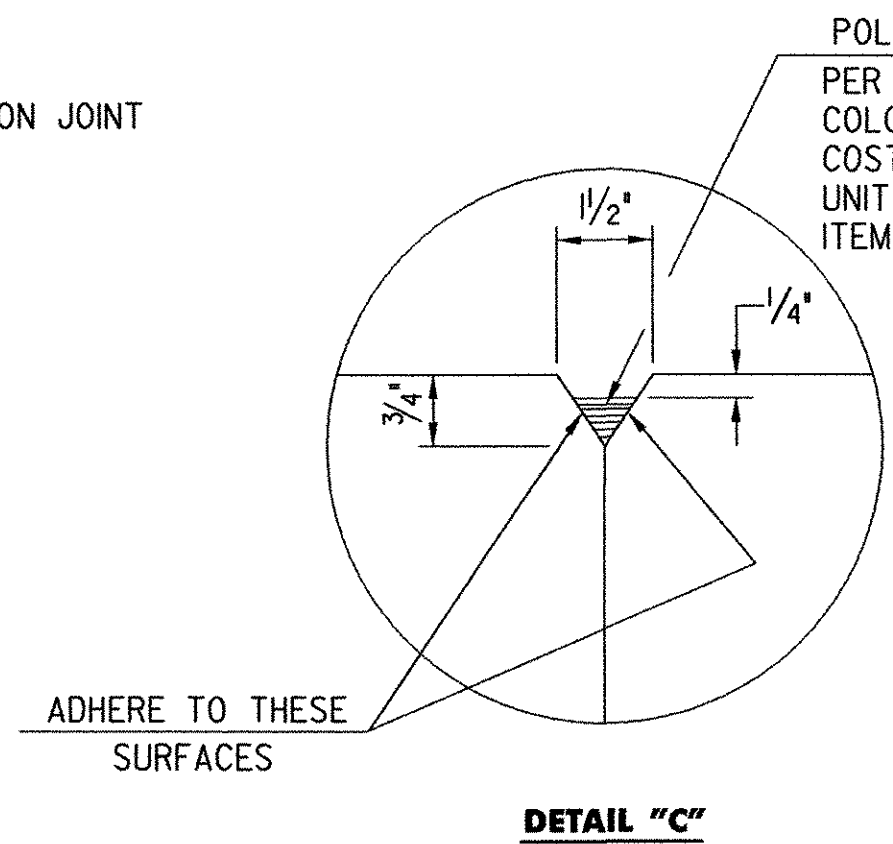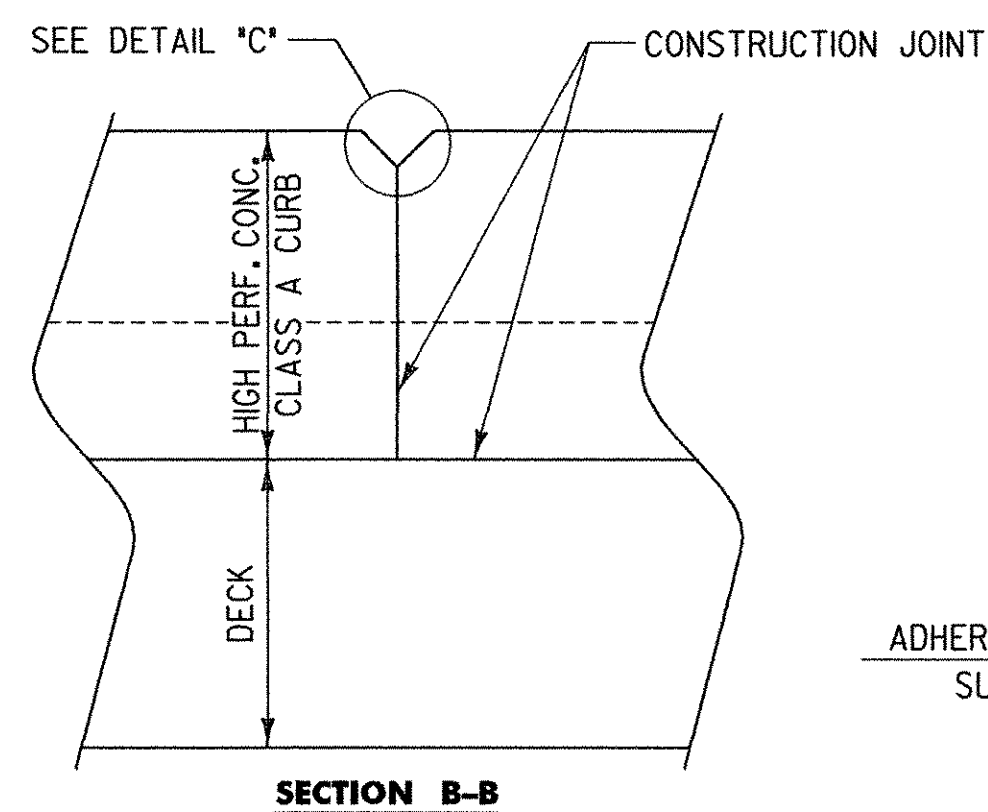

POLYURETHANE JOINT SEALER PER SUBSECTION 524.06c COLOR TO MATCH CONCRETE. COST TO BE INCLUDED IN THE UNIT PRICE BID FOR CONTRACT ITEM 501.33.


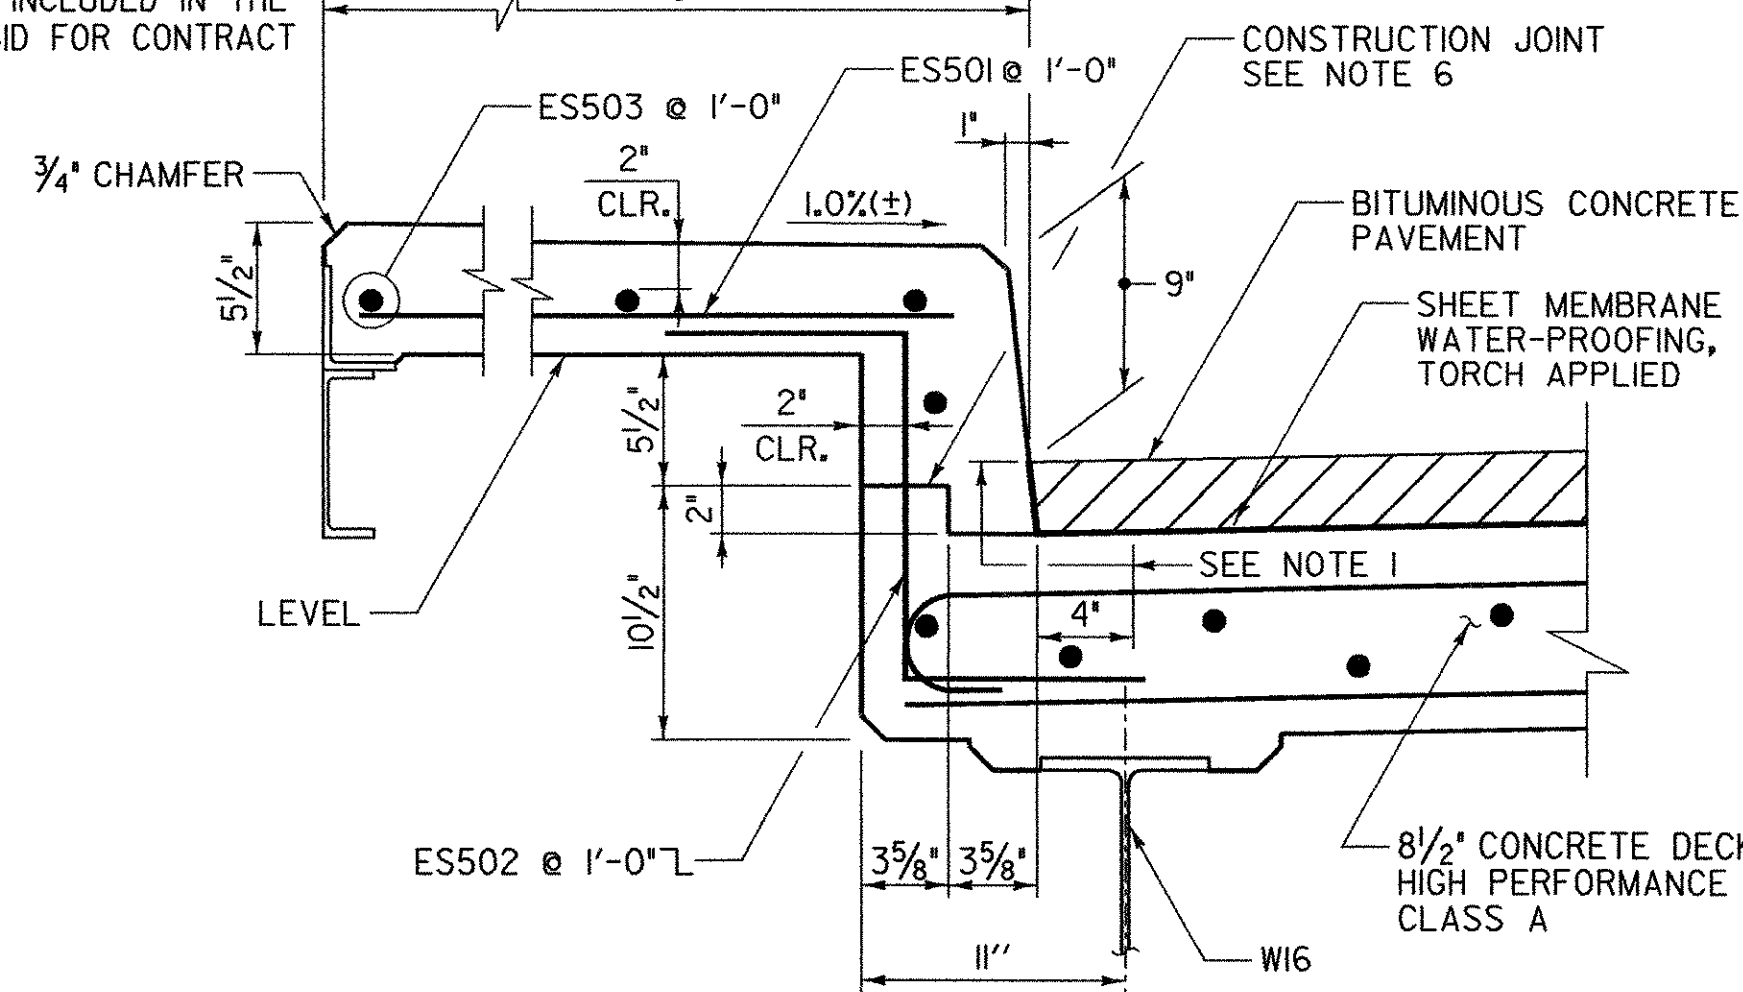


NOTES:

1. INDICATES AREA ALONG DECK AND UP FACE OF CURB FOR PLACEMENT OF TWO COATS OF POLYURETHANE MEMBRANE.
2. POLYURETHANE MEMBRANE AND BLAST CLEANING SHALL BE INCLUDED IN THE UNIT PRICE BID FOR SHEET MEMBRANE WATERPROOFING, TORCH APPLIED.
3. SHEET MEMBRANE AND WATERPROOFING SHALL EXTEND TO FACE OF CURB AS SHOWN ABOVE.
4. IN ADDITION TO THE REQUIREMENTS OF SUBSECTION 519.04, BLAST CLEAN 3" UP THE CURB FACE PRIOR TO PLACING THE MEMBRANE.
5. ALL CONCRETE IN CURB AND SIDEWALK SHALL BE HIGH PERFORMANCE, CLASS A CONCRETE.
6. CONTRACTOR MAY ELIMINATE KEYED CONSTRUCTION JOINT SHOWN. IF ELIMINATED, JOINT SURFACE SHALL BE ROUGHENED TO 1/4" AMPLITUDE.


CONCRETE CURB AND SIDEWALK DETAIL

SCALE 1 1/2" = 1'-0"

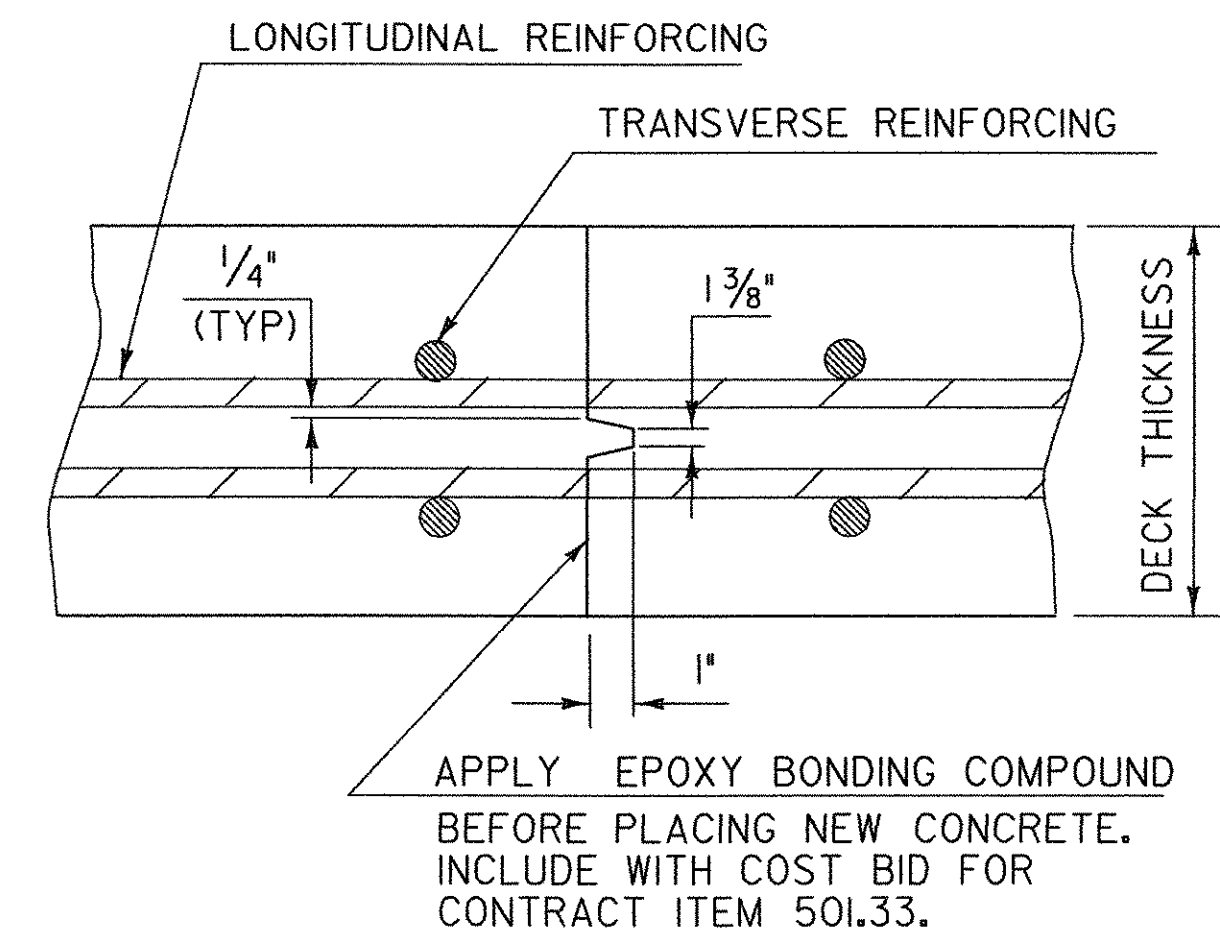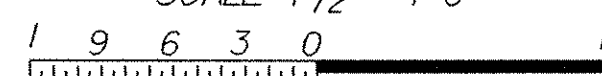

TRANSVERSE BRIDGE SLAB CONSTRUCTION JOINT DETAIL


NOT TO SCALE

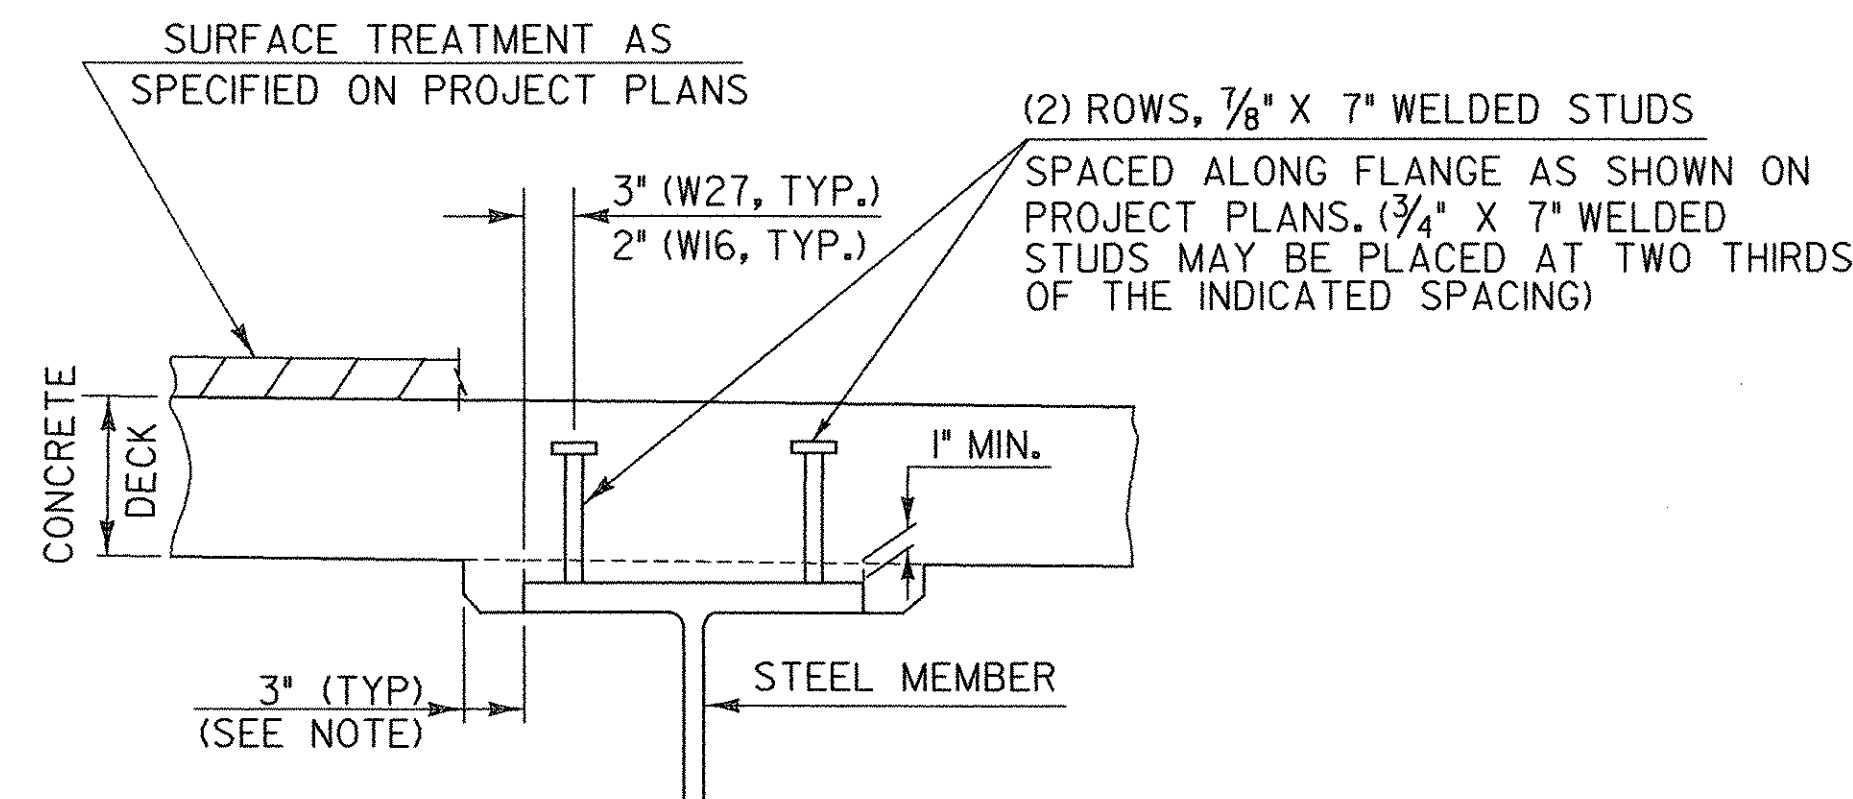

NOTE: THE 3" HORIZONTAL SECTION MAY BE ELIMINATED FOR FORMING SYSTEMS DESIGNED FOR THE CONSTRUCTION OF VERTICAL HAUNCHES. SYSTEMS SHALL BE SUBMITTED FOR APPROVAL TO THE STRUCTURES ENGINEER. ALL VOIDS SHALL BE FILLED WITH MORTAR, TYPE IV OR AN EQUIVALENT PRODUCT FROM THE APPROVED PRODUCTS LIST.

HAUNCH AND SHEAR CONNECTOR DETAILS

NOT TO SCALE

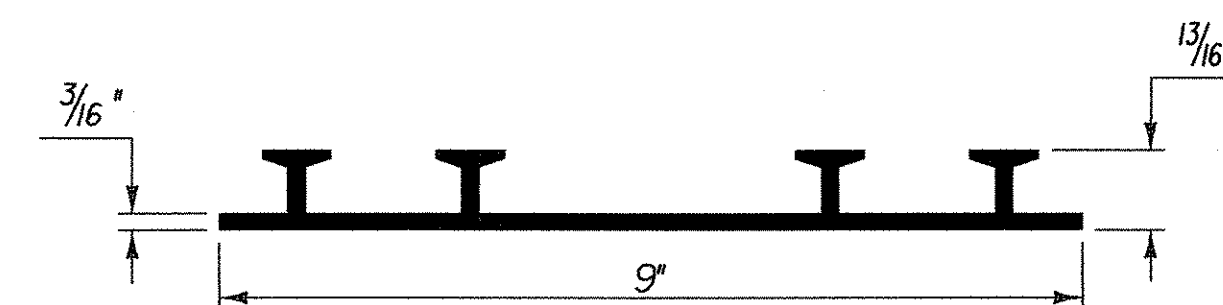

P. V. C. WATERSTOP FOR CONSTRUCTION JOINTS

THE COSTS FOR P. V. C. WATERSTOP SHALL BE INCLUDED IN THE UNIT PRICE BID FOR CONTRACT ITEM 501.34. OTHER CONFIGURATIONS MAY BE USED UPON APPROVAL OF THE ENGINEER.





PROJECT NAME: RICHFORD
PROJECT NUMBER: BHF 0302 (3) S

FILE NAME: ...Design\Rich-decksect.dgn PLOT DATE: 12/18/2007
PROJECT LEADER: MJC DRAWN BY: AET
DESIGNED BY: SEB CHECKED BY: MJC
TYPICAL DECK SECTION AND DETAILS SHEET 25 OF 41


TYPICAL SECTION THROUGH CONCRETE CURB / SIDEWALK CONSTRUCTION JOINT

NOT TO SCALE

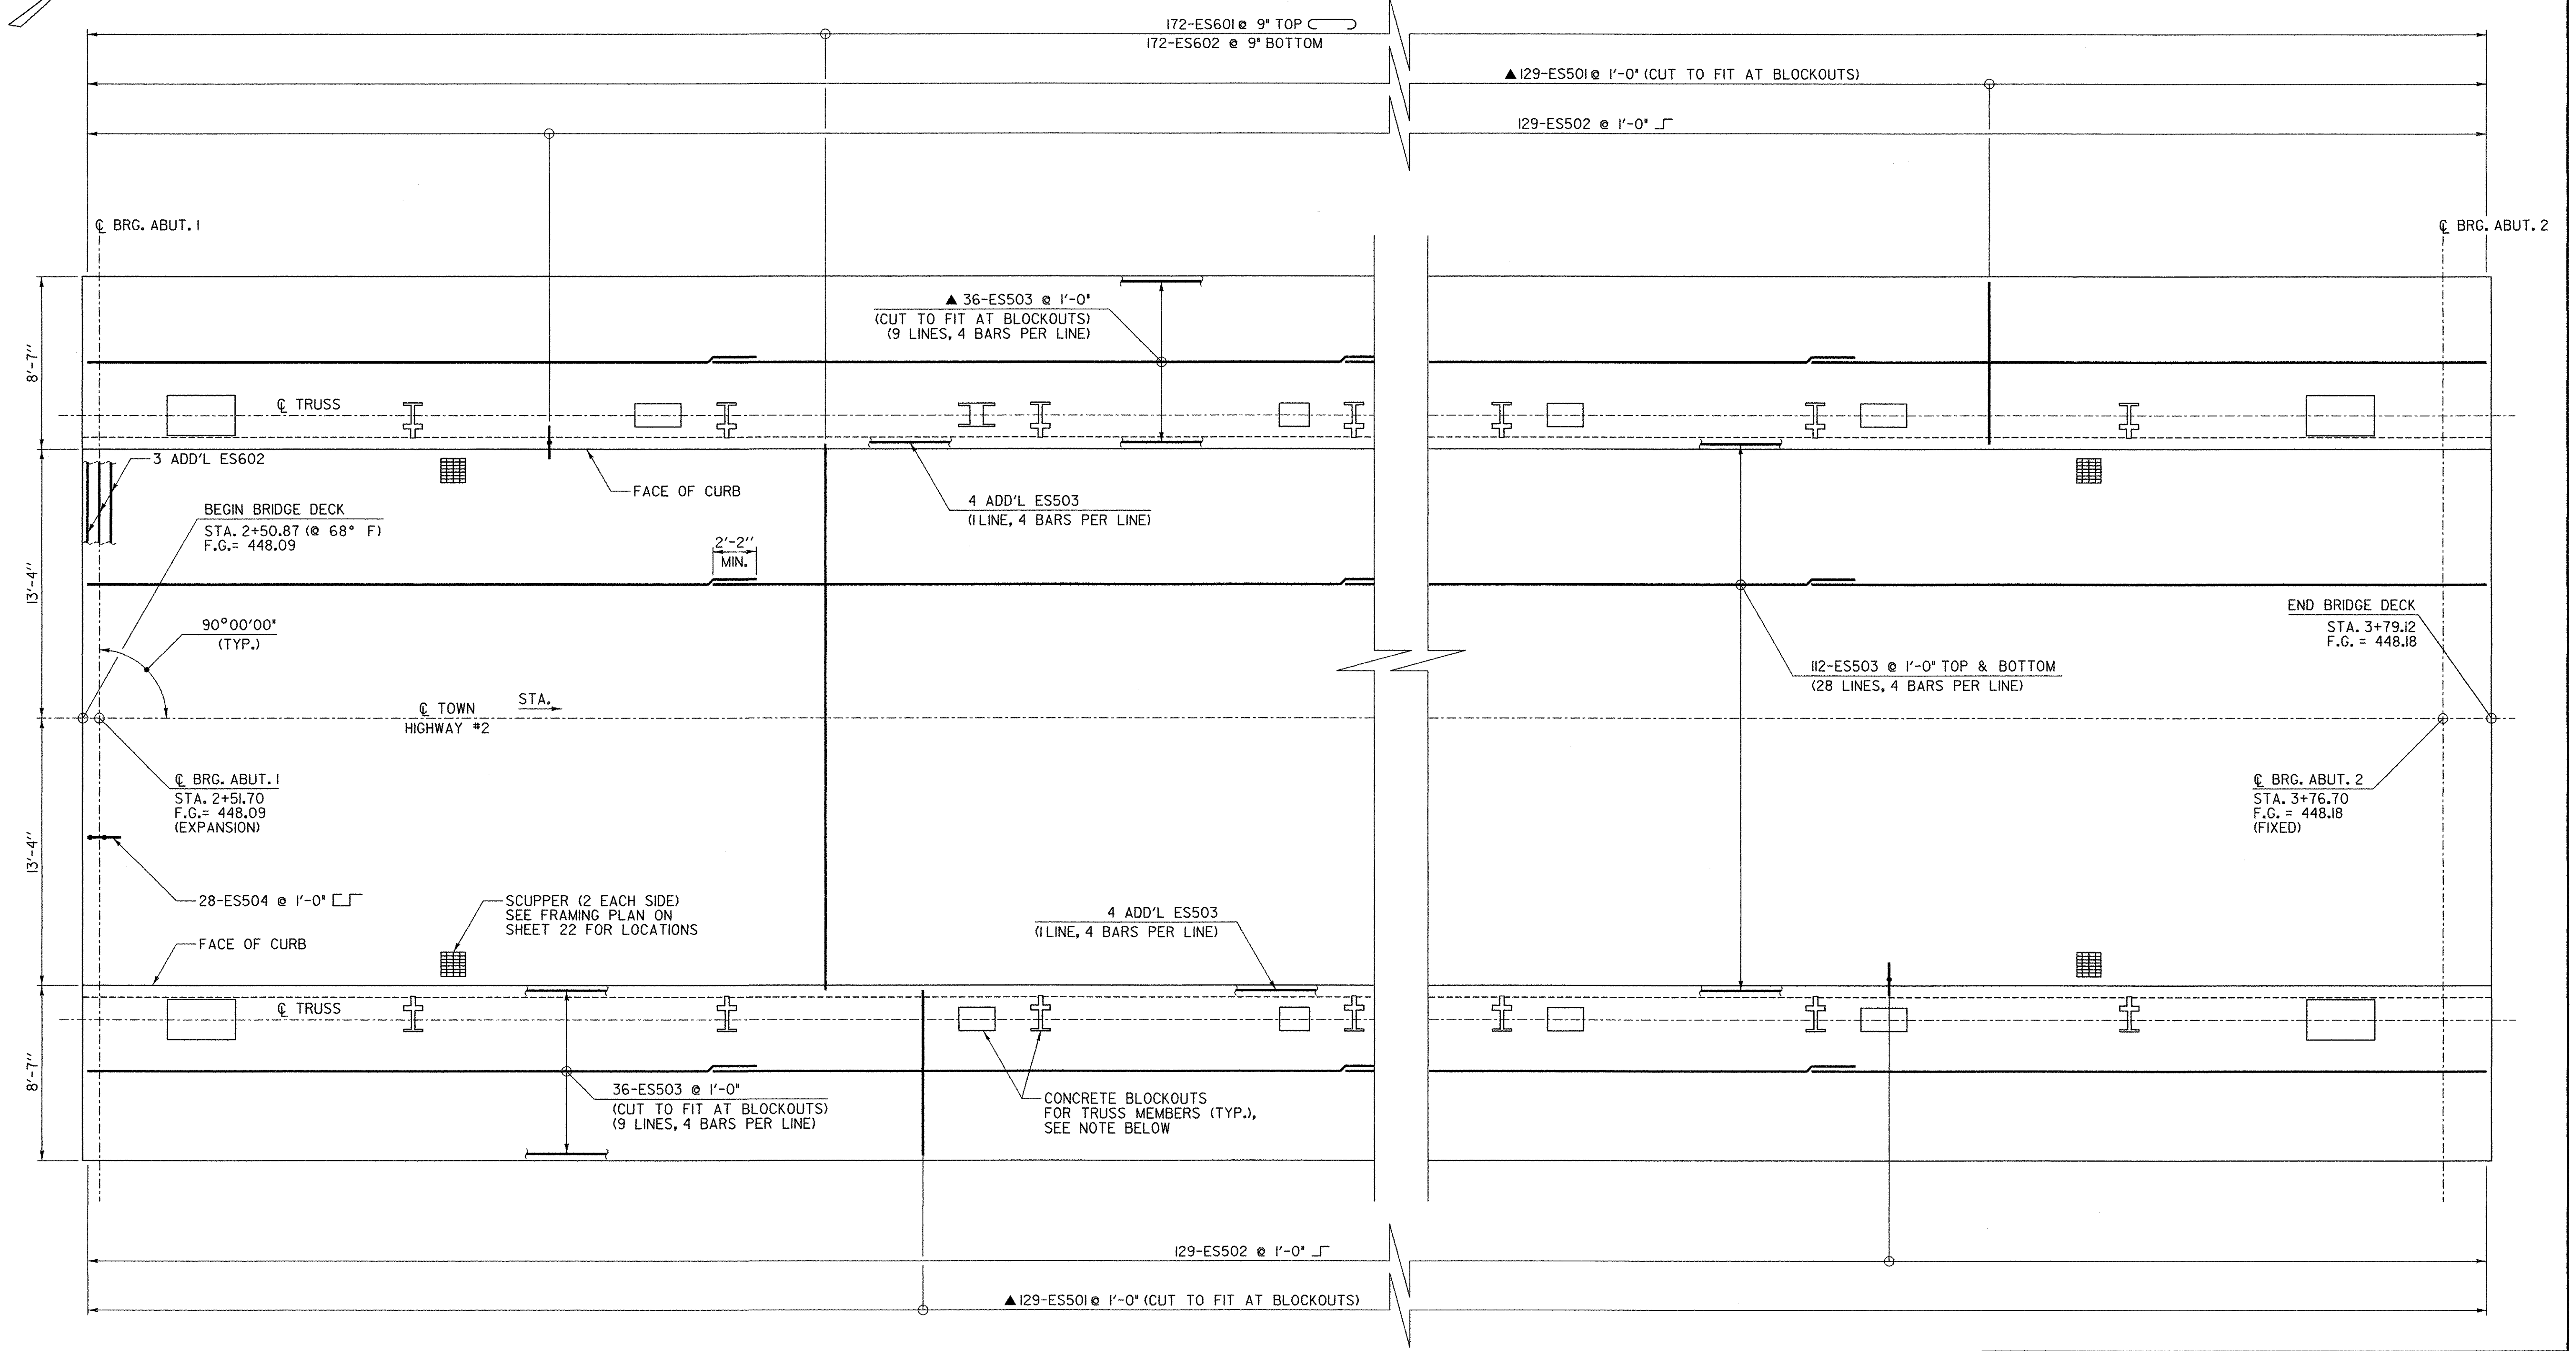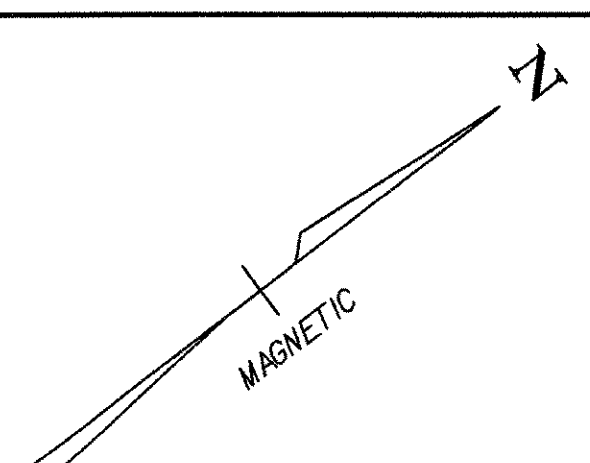


NOTE:
 CLEARANCE TO STEEL FRAMING AT
 BLOCKOUTS SHALL BE A MAXIMUM
 OF 2" AND A MINIMUM OF 1/2".

DECK PLAN

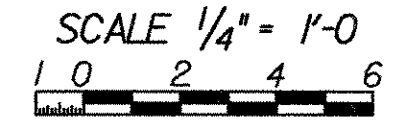


PROJECT NAME:	RICHFORD	PLOT DATE:	12/18/2007
PROJECT NUMBER:	BHF 0302 (3) S	DRAWN BY:	JTS
FILE NAME:	...Design\Rich-deck.pln.dgn	CHECKED BY:	MJC
PROJECT LEADER:	MJC	SHEET	26 OF 41
DESIGNED BY:	SEB	DECK REINFORCING PLAN	

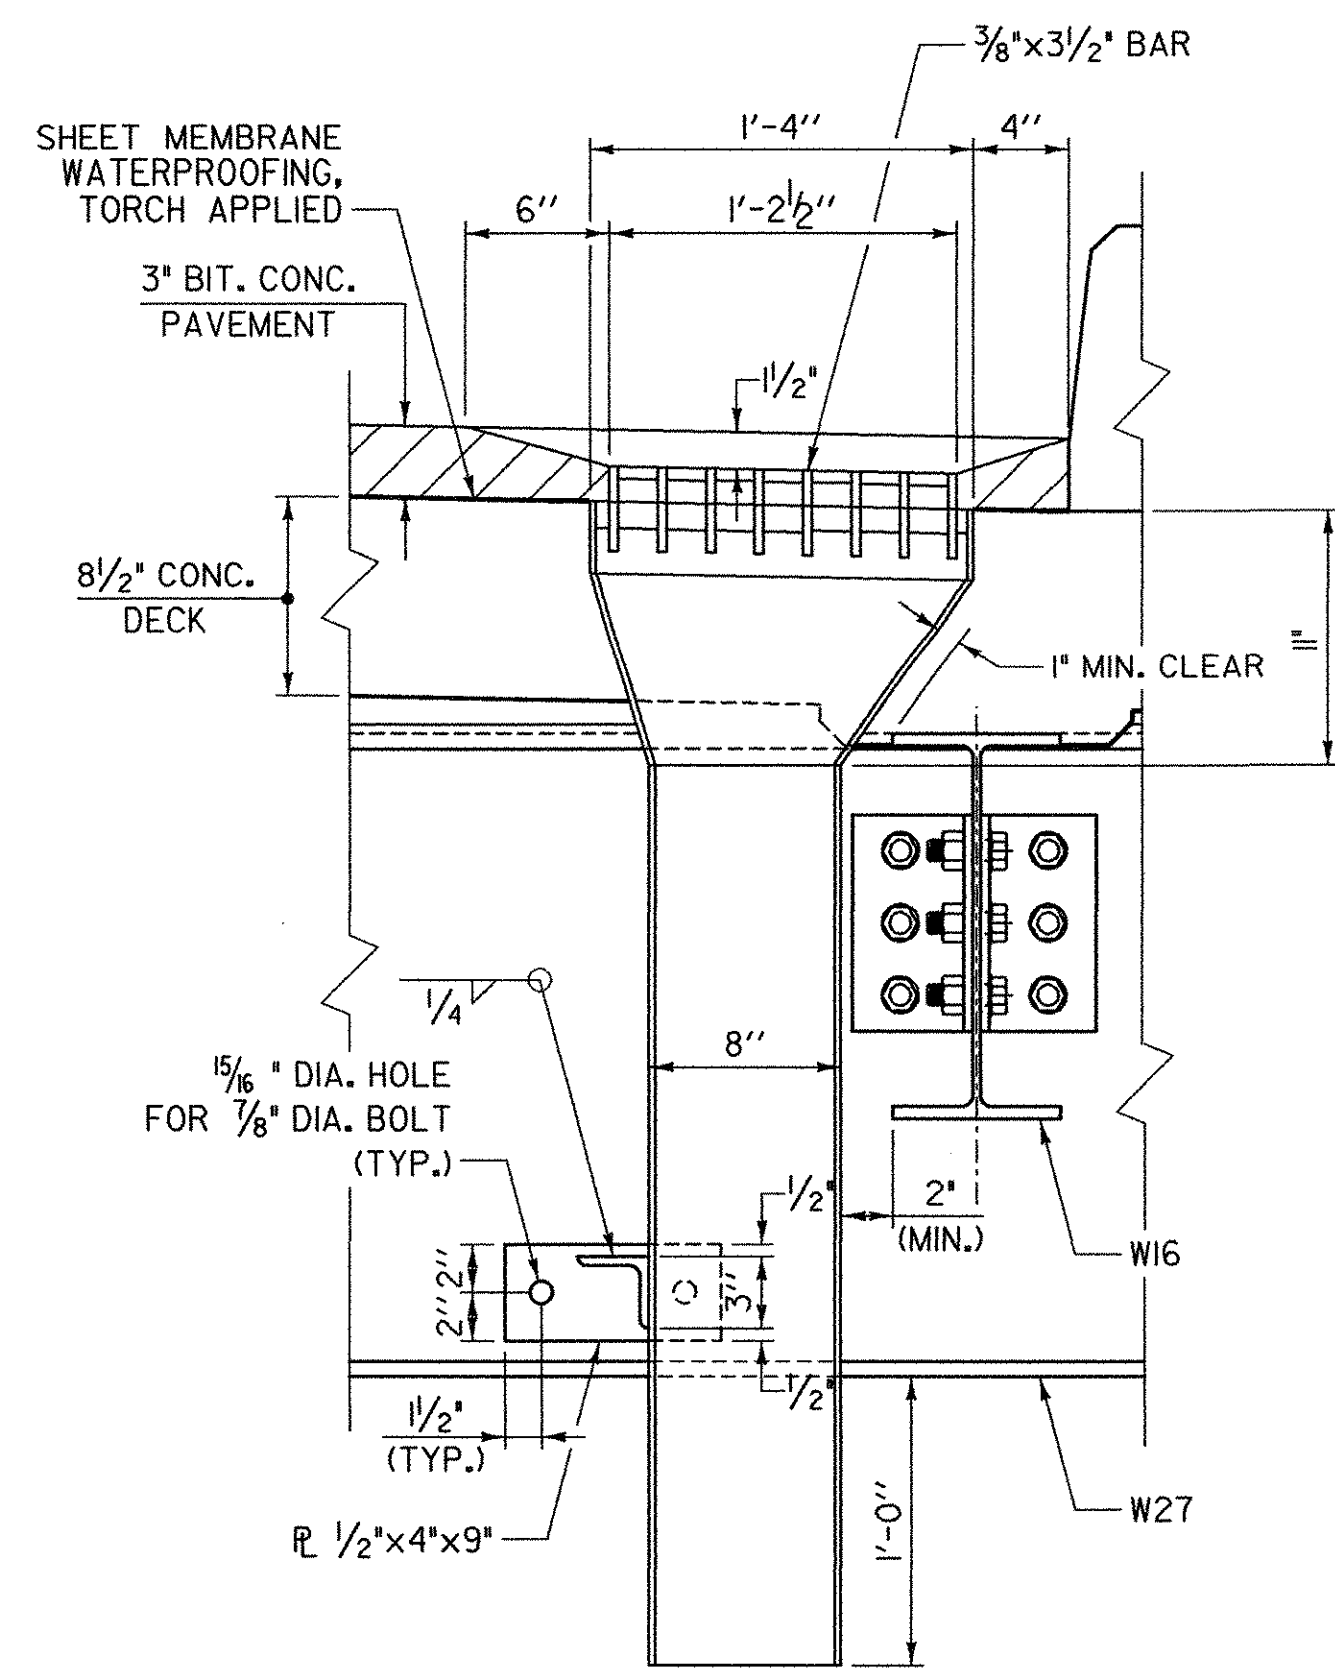


SECTION A-A

SCALE 1 1/2" = 1'-0"
 1 9 6 3 0 1

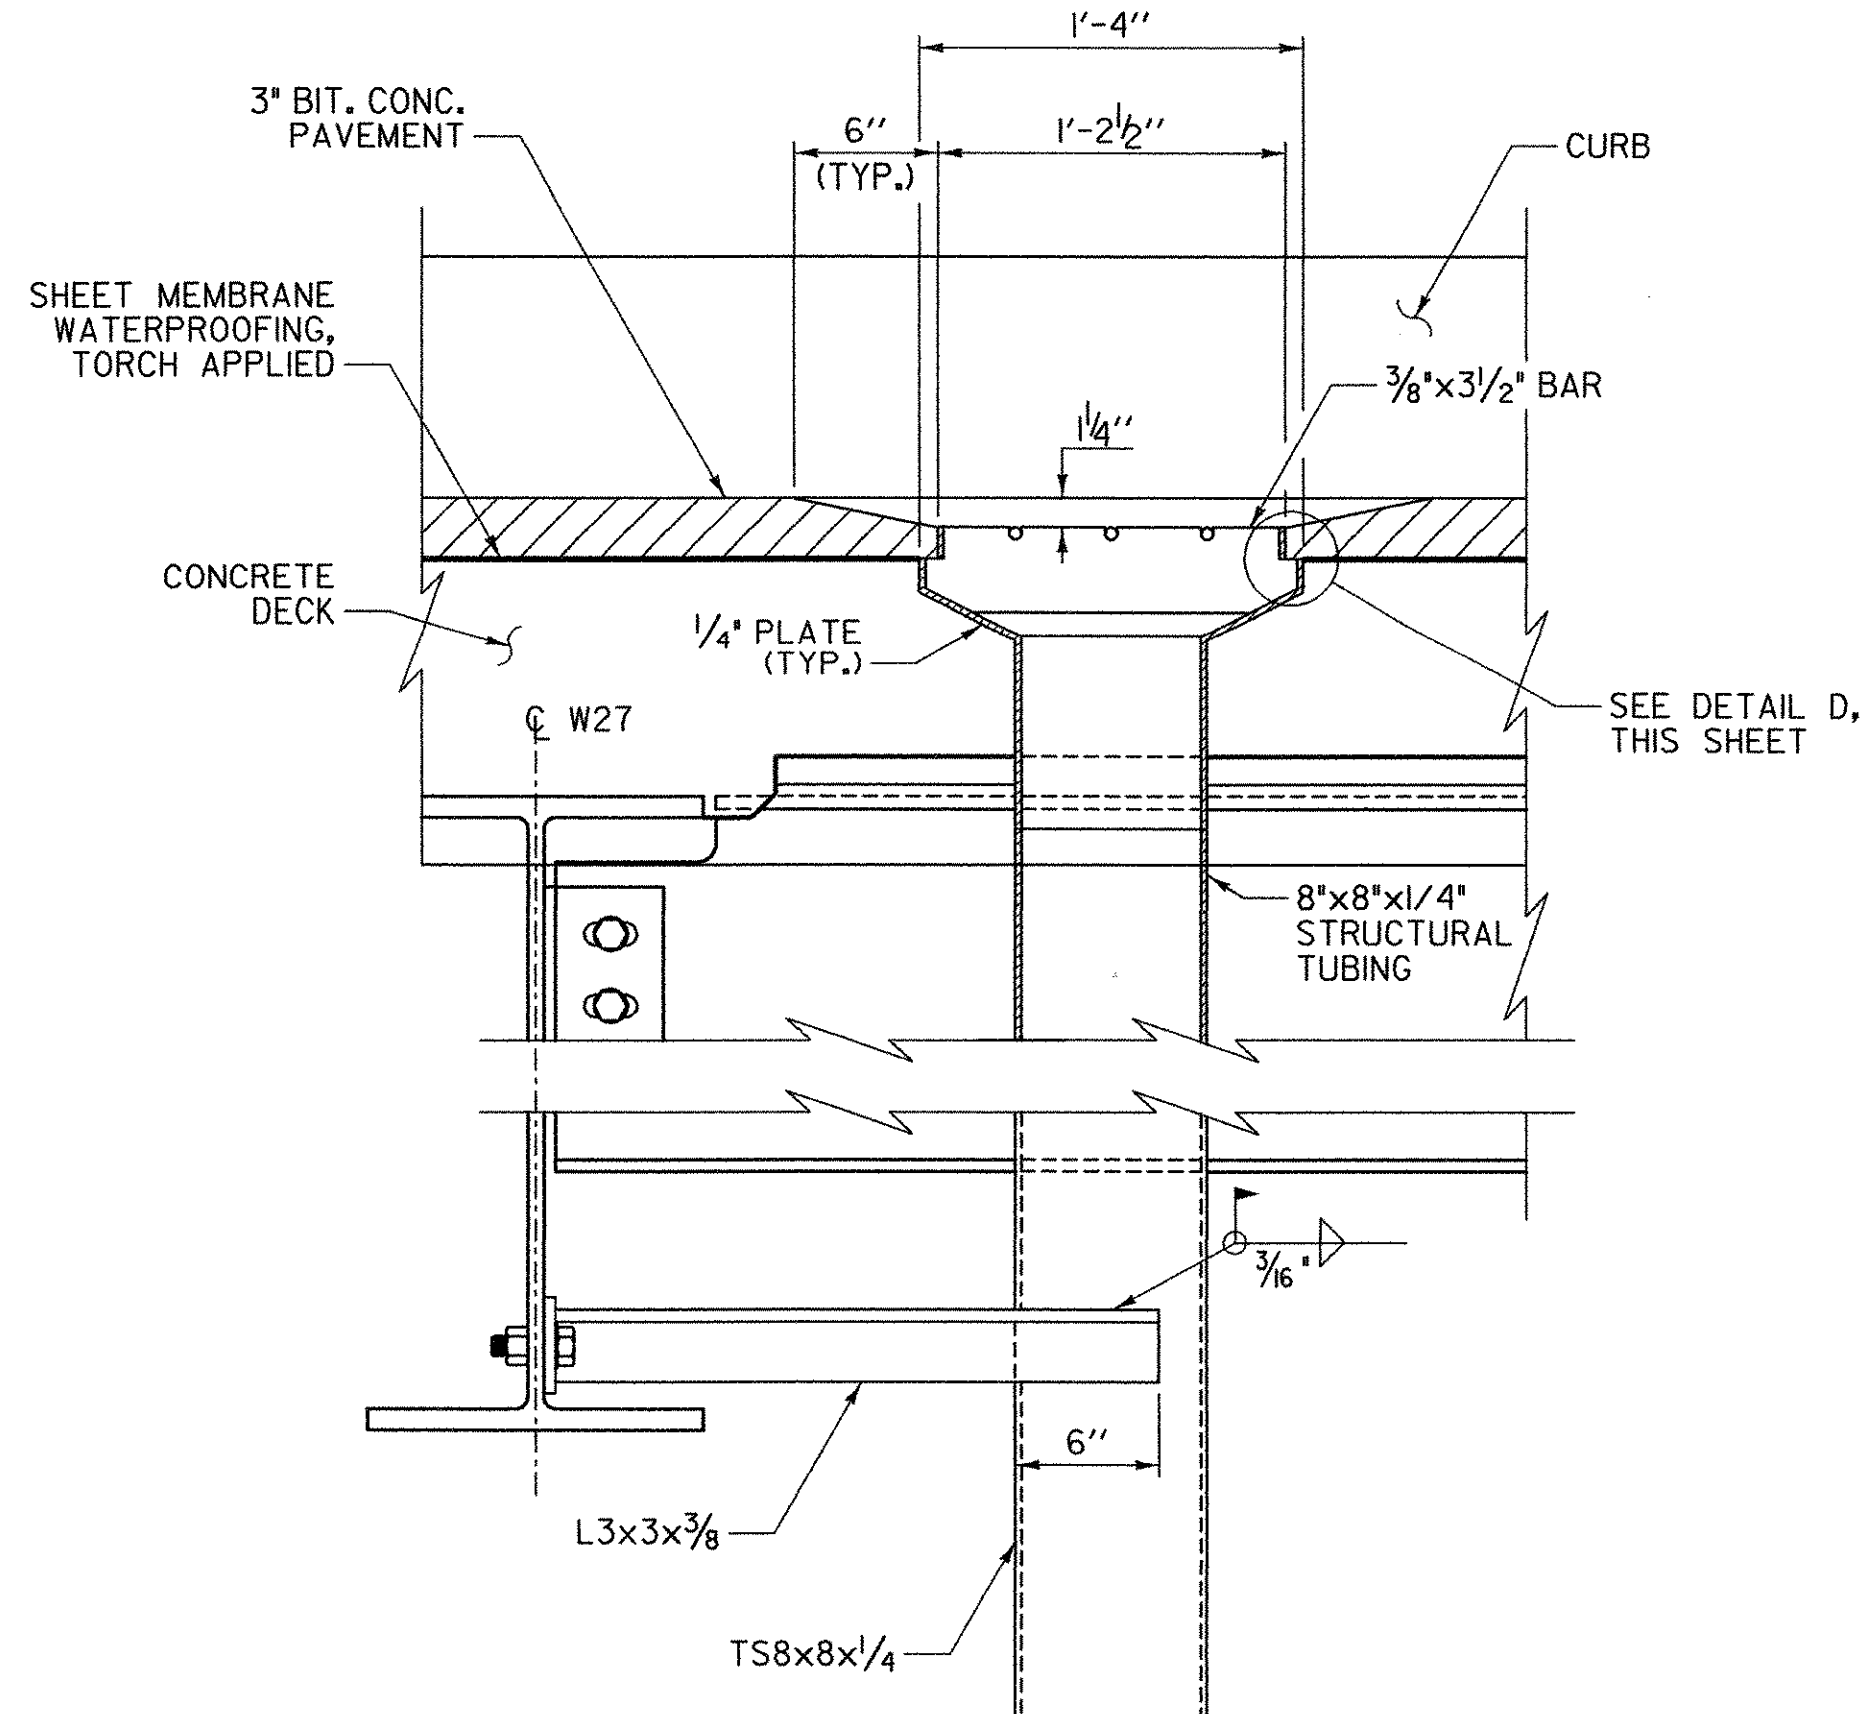


SECTION B-B

SCALE 1 1/2" = 1'-0"
 1 9 6 3 0 1

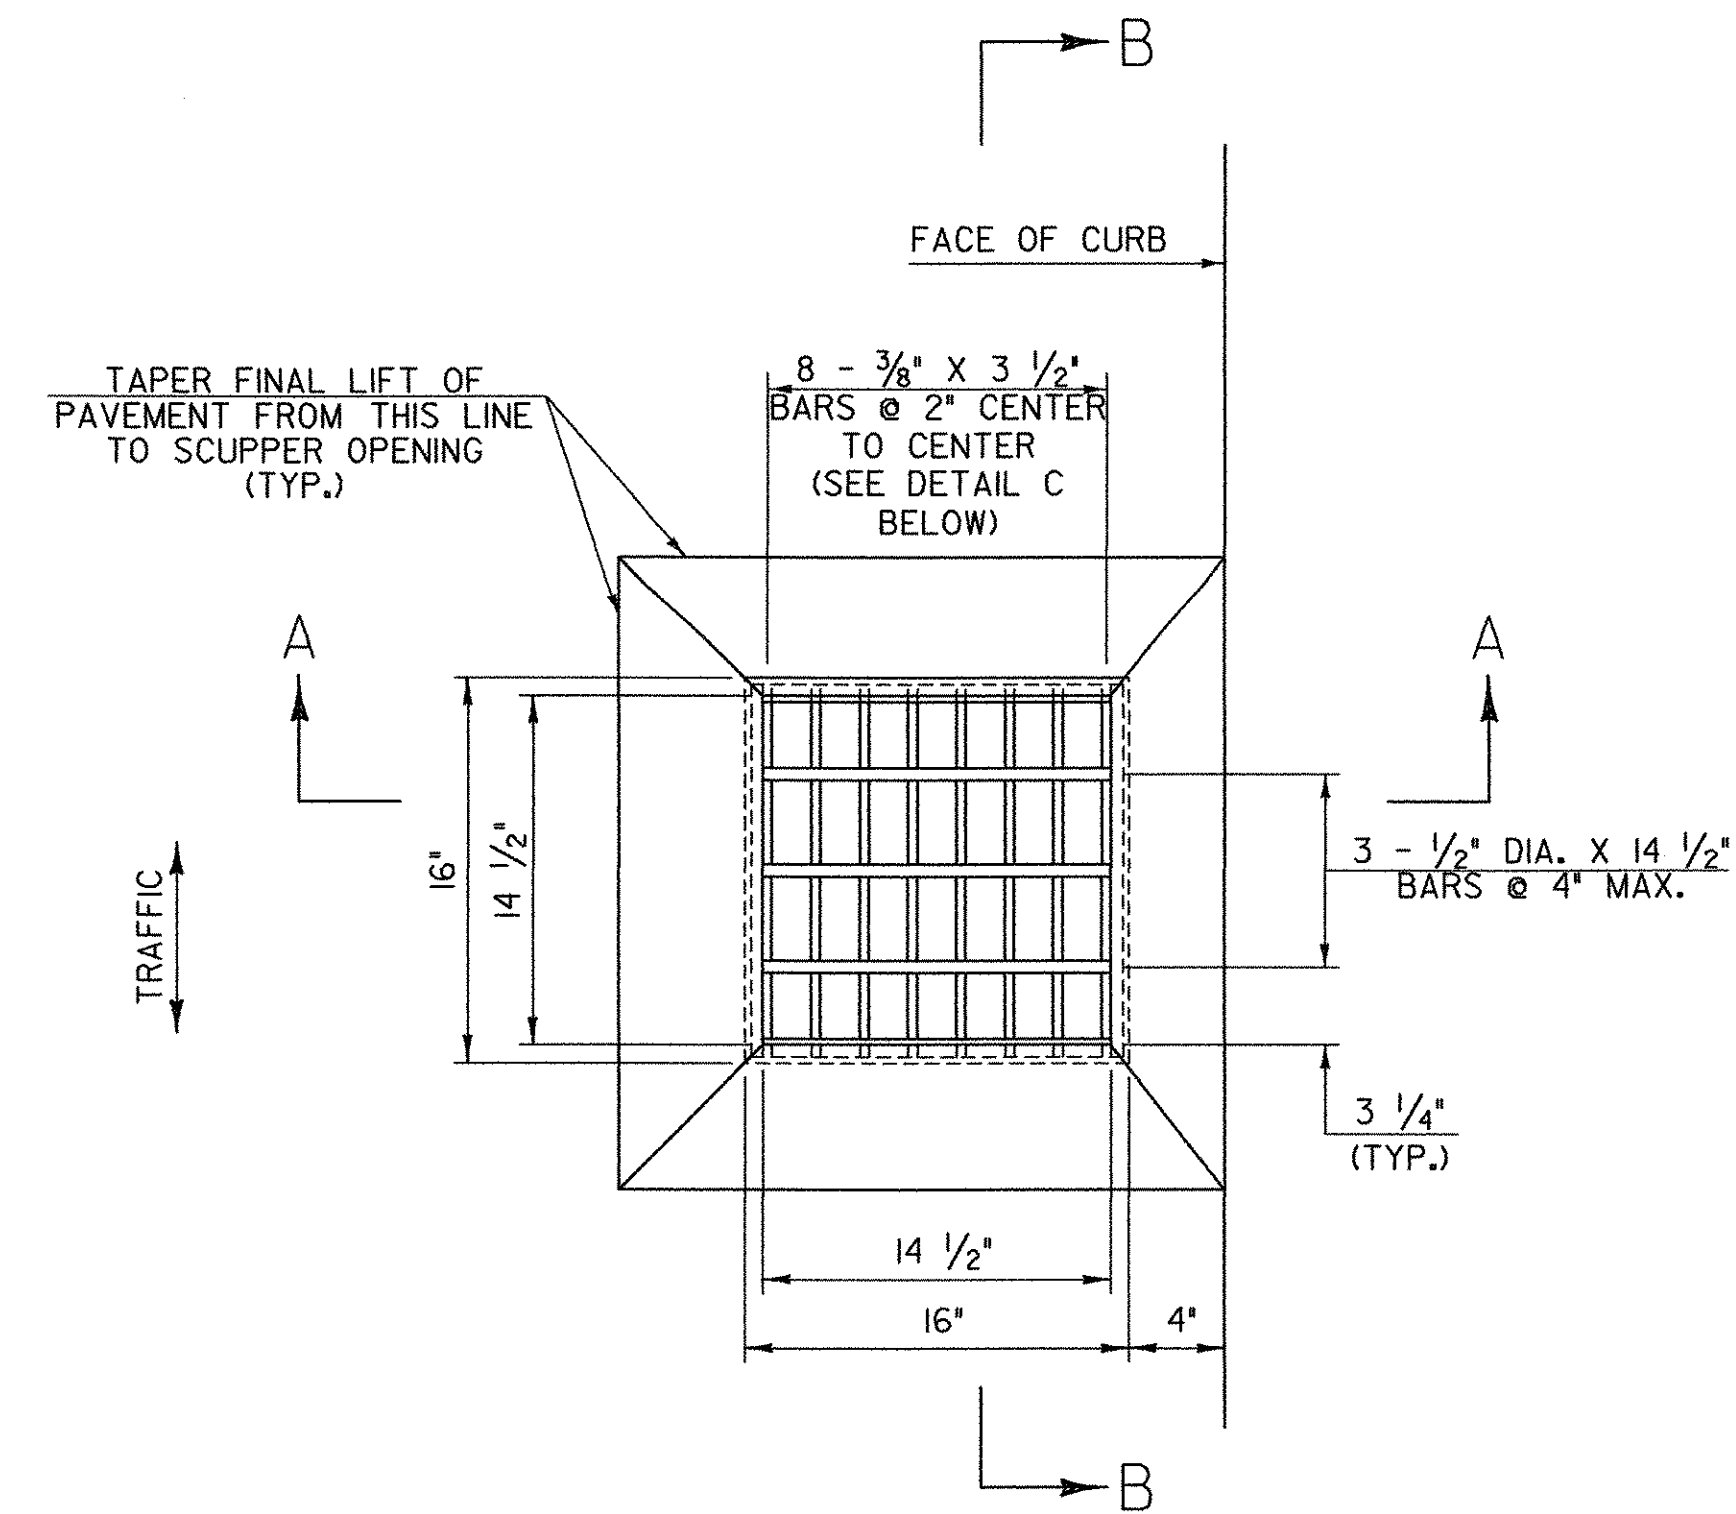


SCUPPER PLAN

SCALE 1 1/2" = 1'-0"
 1 9 6 3 0 1

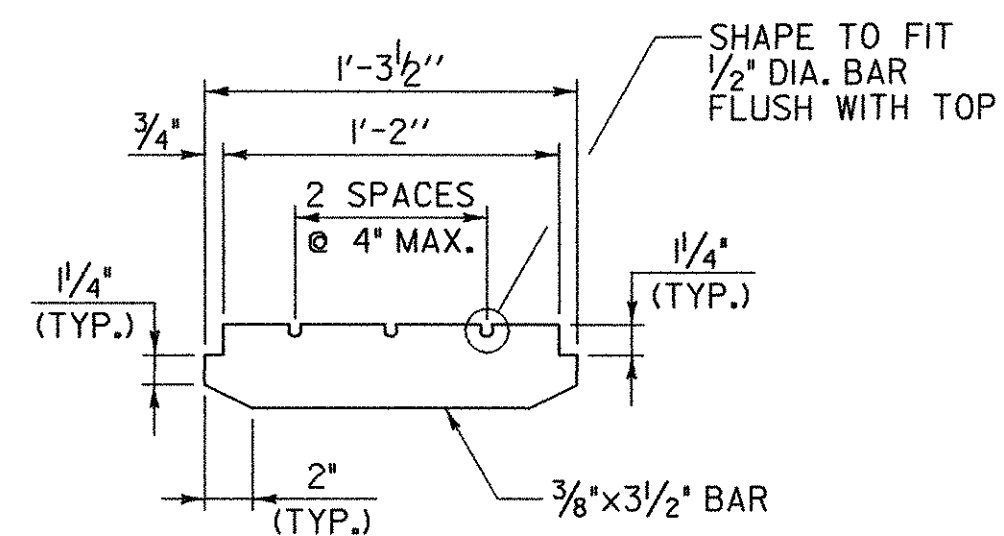


DETAIL C

SCALE 1 1/2" = 1'-0"
 1 9 6 3 0 1

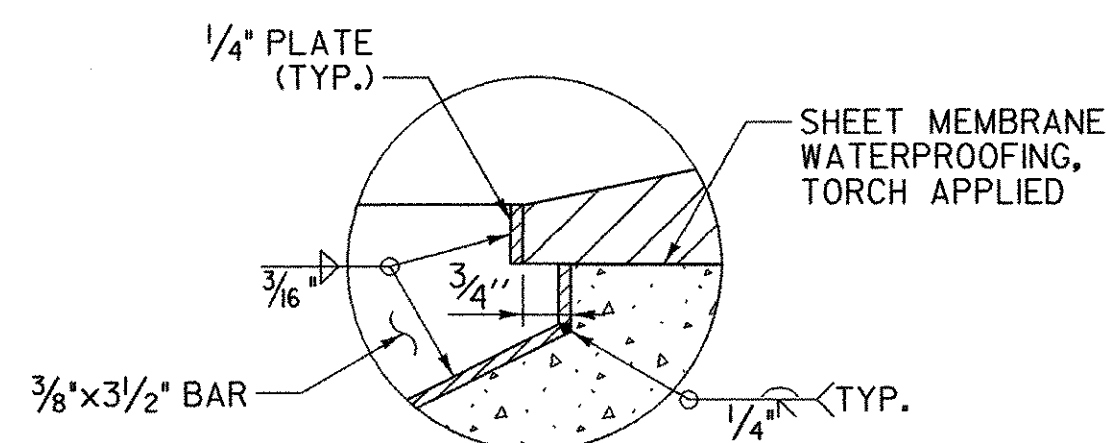


DETAIL D

NOT TO SCALE

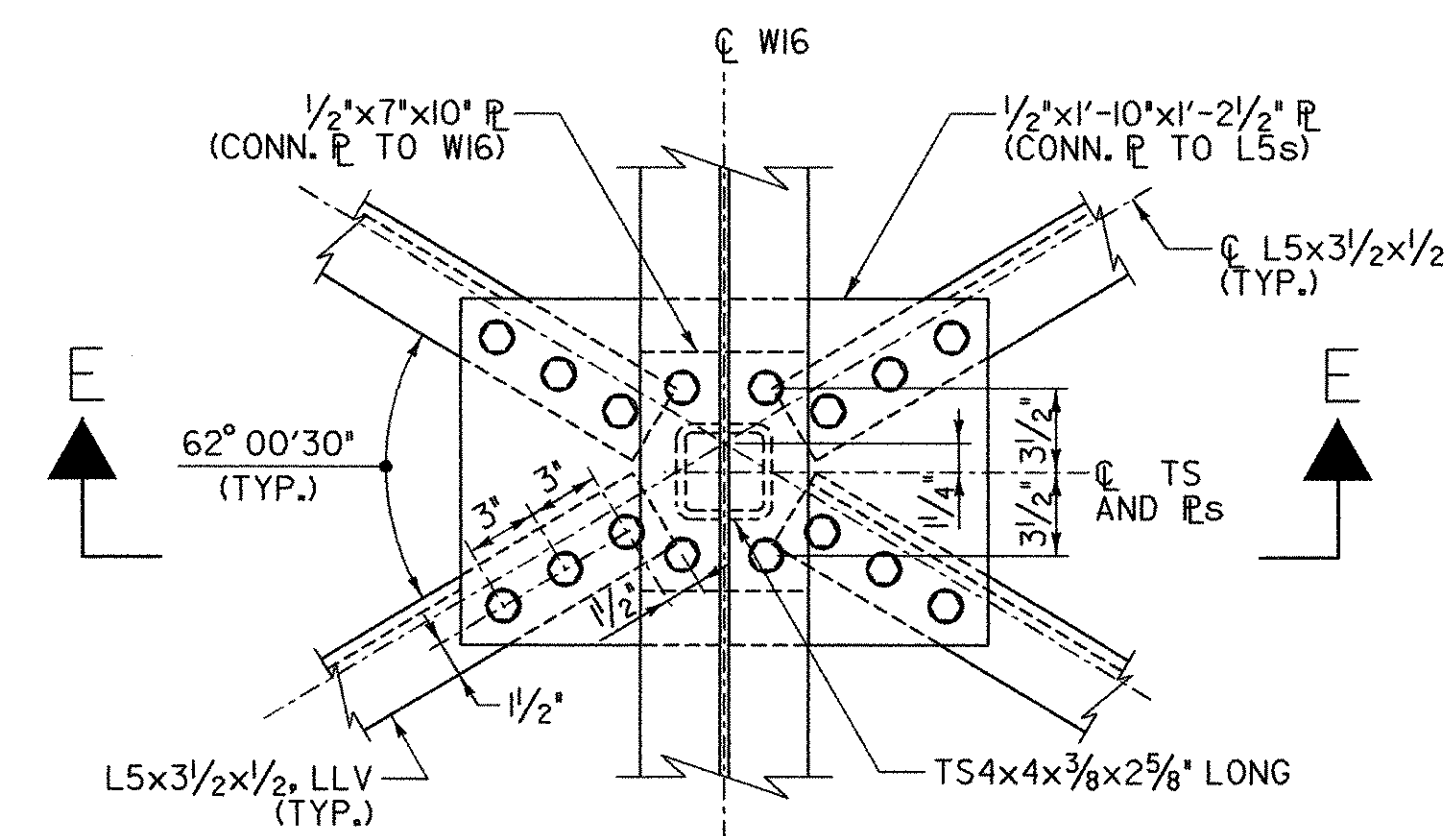

DIAGONAL CONNECTION DETAIL AT CENTER STRINGER

SCALE 1 1/2" = 1'-0"
 1 9 6 3 0 1

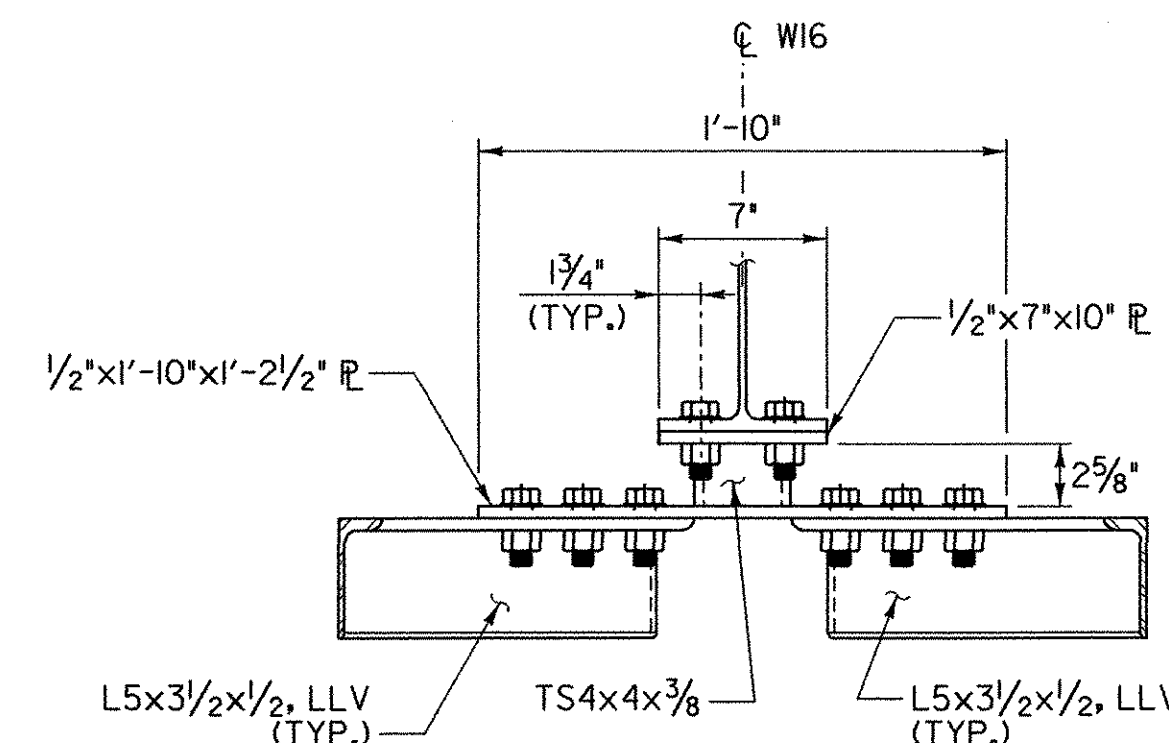

SECTION E-E


SCUPPER NOTES

- HOLLOW STRUCTURAL STEEL TUBING SHALL CONFORM TO SUBSECTION 714.11.
- ALL PLATES, BARS, AND ANGLES SHALL CONFORM TO SUBSECTION 714.03.
- ALL SCUPPERS, INCLUDING SUPPORT ANGLES, SHALL BE GALVANIZED AFTER FABRICATION IN ACCORDANCE WITH SUBSECTION 506.15, PART (d).
- THE TOP SURFACE OF THE SCUPPER SHALL BE SLOPED TO MATCH ROADWAY SLOPE AND GRADE.
- ANY PLACE WHERE THE GALVANIZING HAS BEEN REMOVED FROM THE SCUPPER EITHER BY CUTTING, BURNING, WELDING, PLACING, OR ANY OTHER MEANS, SHALL BE REPAIRED PER SECTION 513.
- SCUPPERS SHALL BE PAID FOR UNDER ITEM 506.60, "STRUCTURAL STEEL"





PROJECT NAME: RICHFORD
 PROJECT NUMBER: BHF 0302 (3) S
 FILE NAME: ...Design\Rich-scupper.dgn
 PROJECT LEADER: MJC
 DESIGNED BY: SEB
 SCUPPER AND MISC. DETAILS



PLOT DATE: 12/18/2007
 DRAWN BY: TEK
 CHECKED BY: MJC
 SHEET 27 OF 41

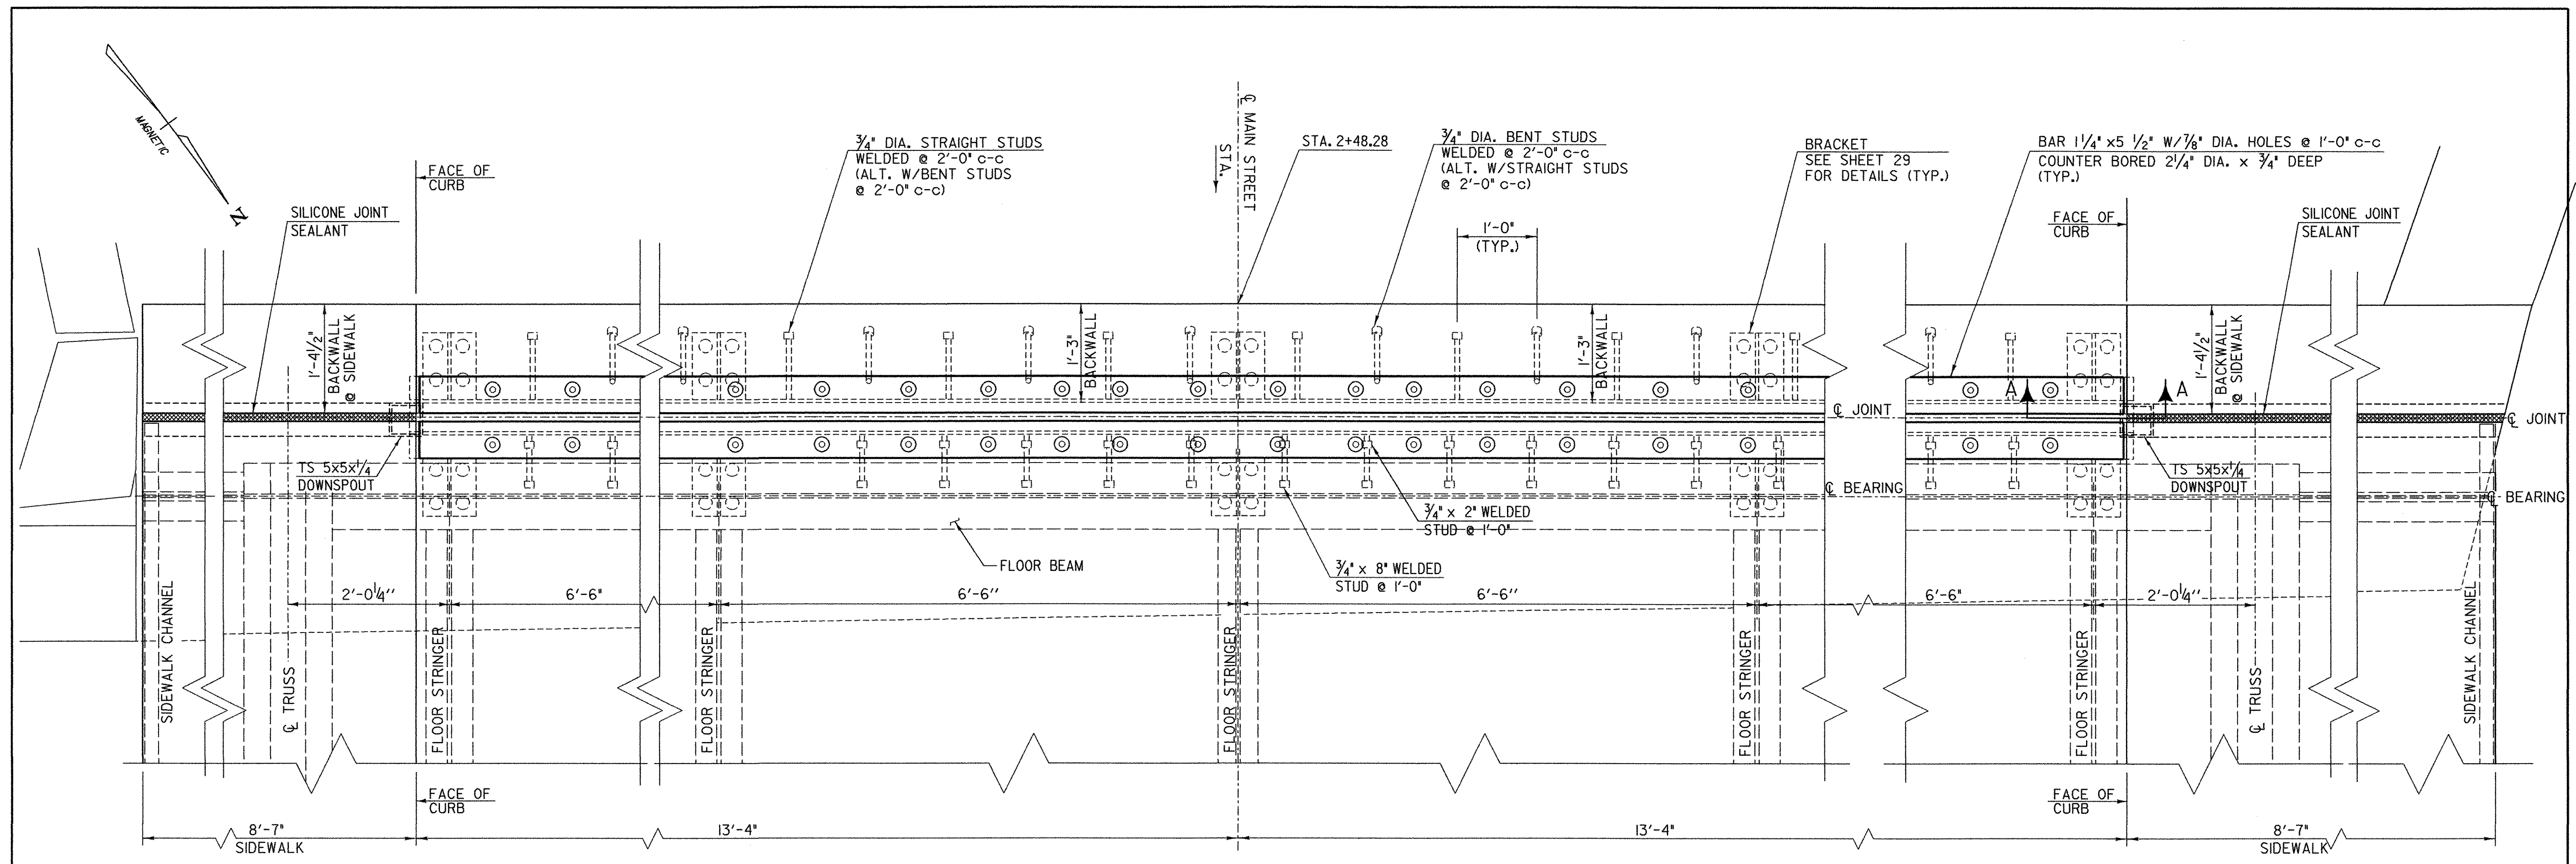


EXPANSION JOINT PLAN AT ABUTMENT NO. 1

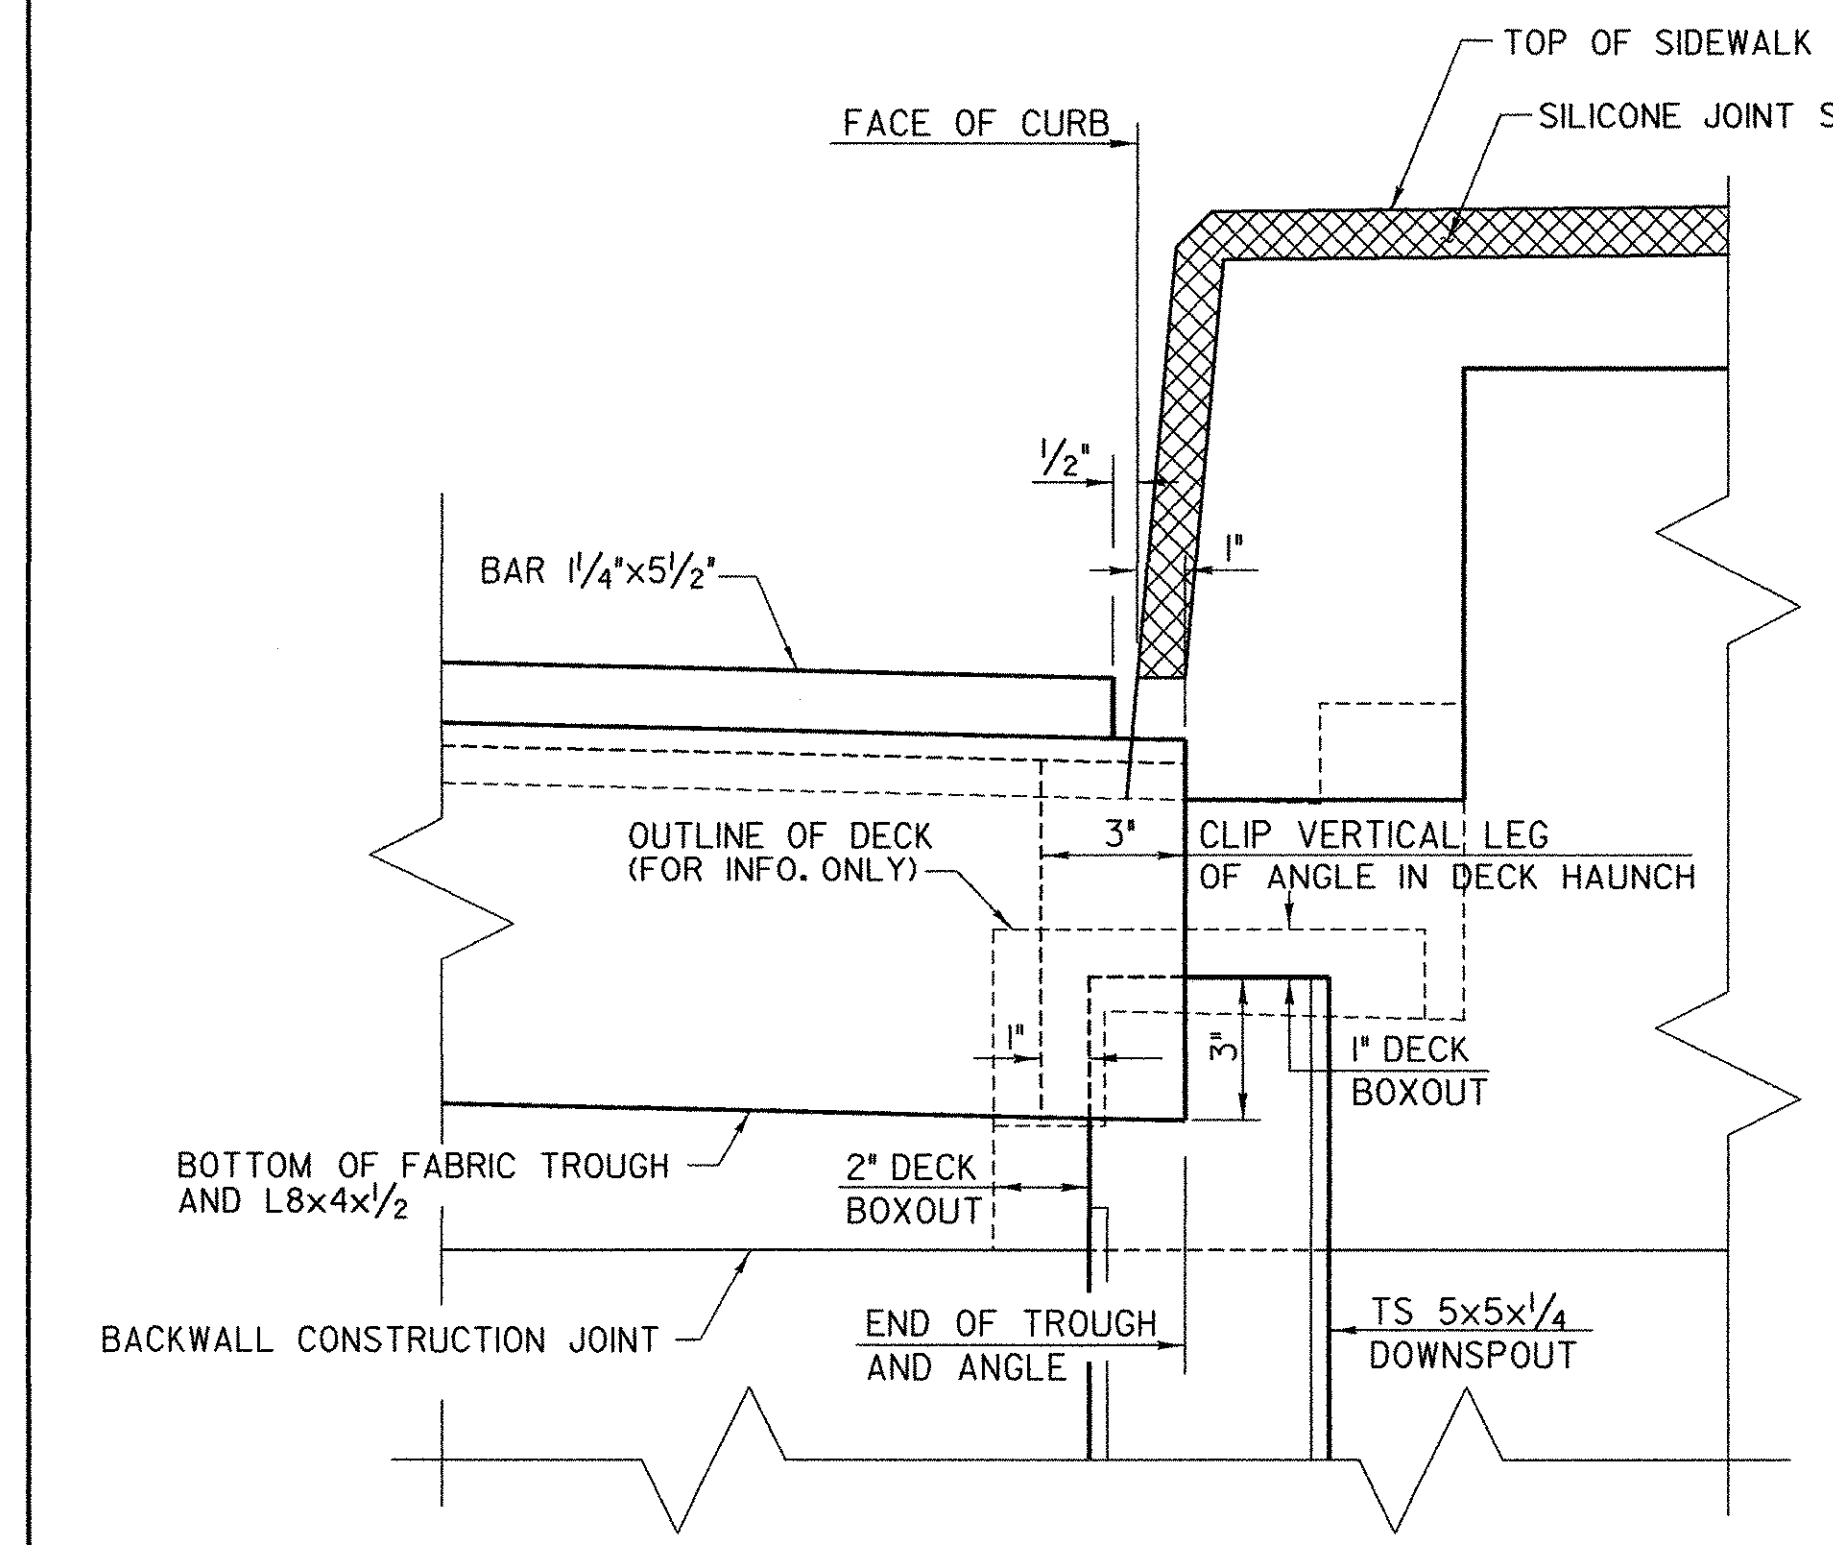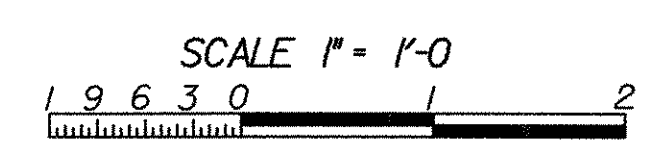

SECTION A-A

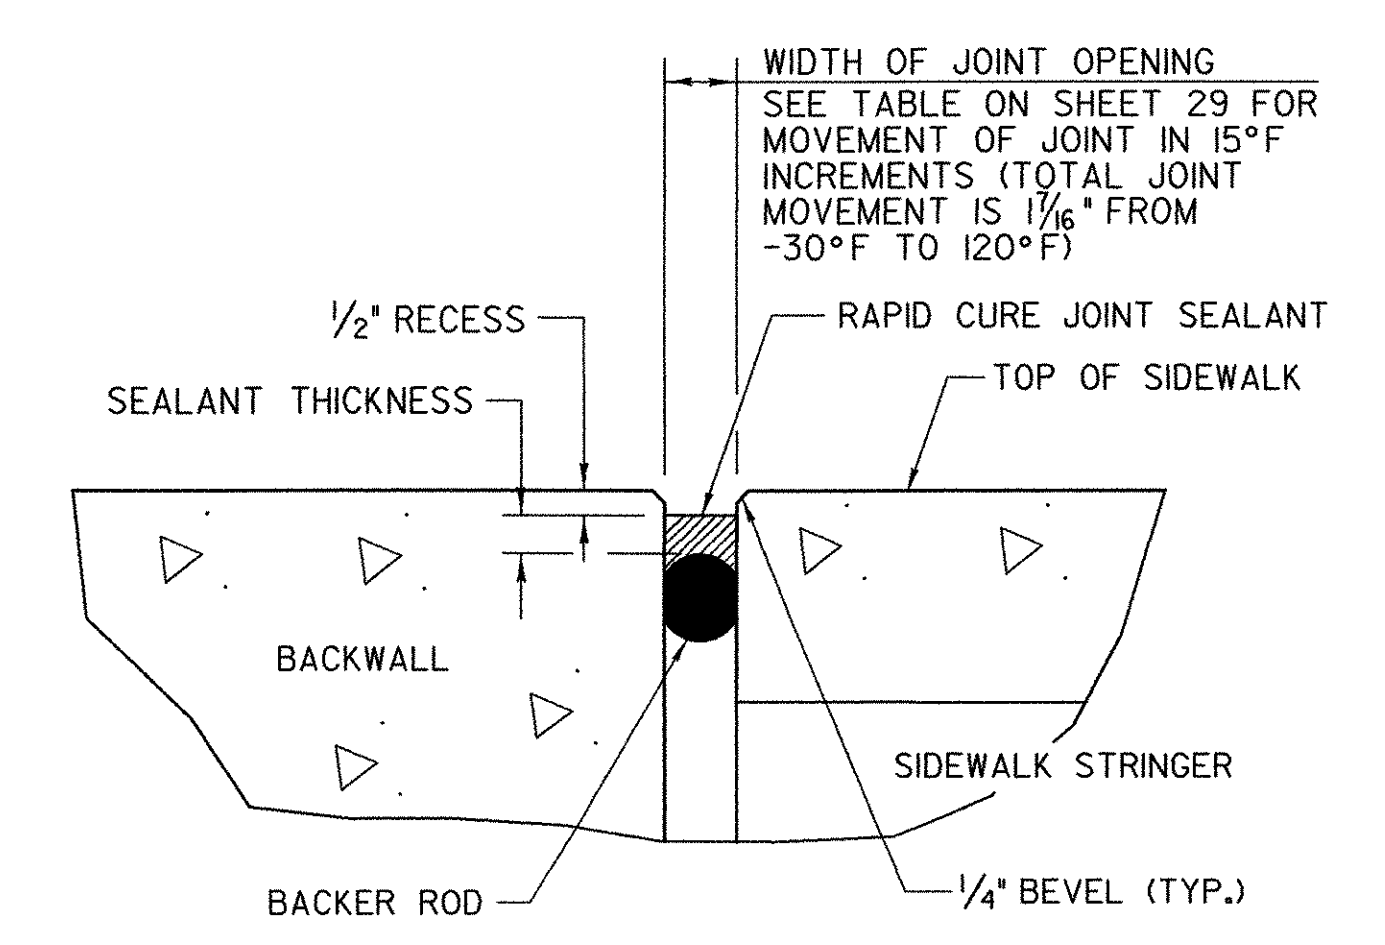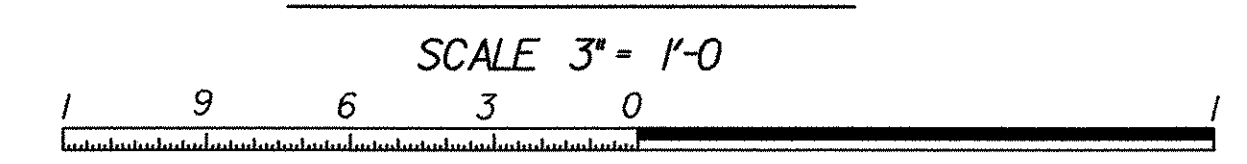

SIDEWALK EXPANSION JOINT

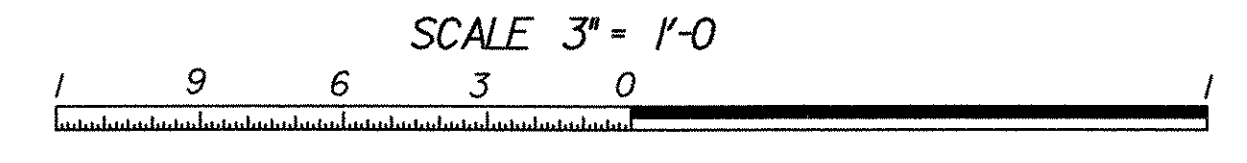


SIDEWALK JOINT NOTES:



1. THE JOINT WILL BE A "SILICONE SEALANT WITH BACKER ROD."
2. THE SILICONE SEALANT THICKNESS AND WIDTH OF JOINT OPENING SHALL BE AS RECOMMENDED BY SILICONE SEALANT SUPPLIER. THE JOINT SHALL BE INSTALLED AS RECOMMENDED BY SEALANT SUPPLIER.
3. THE LIMITS OF "SILICONE SEALANT WITH BACKER ROD" SHALL BE 5 1/2 INCHES DOWN THE FASCIA FROM THE TOP, ACROSS THE TOP OF THE SIDEWALK AND DOWN THE CURB SIDE OF THE SIDEWALK TO THE TOP OF THE CONCRETE DECK.
4. SIDEWALK EXPANSION JOINT SHALL BE PAID INCIDENTAL TO CONTRACT ITEM 618.10.





PROJECT NAME:	RICHFORD
PROJECT NUMBER:	BHF 0302 (3) S
FILE NAME:	...\\Design\Rich-expjtl.dgn
PROJECT LEADER:	MJC
DESIGNED BY:	SEB
EXPANSION JOINT PLAN	
PLOT DATE:	12/18/2007
DRAWN BY:	AET
CHECKED BY:	MJC
SHEET	28 OF 41

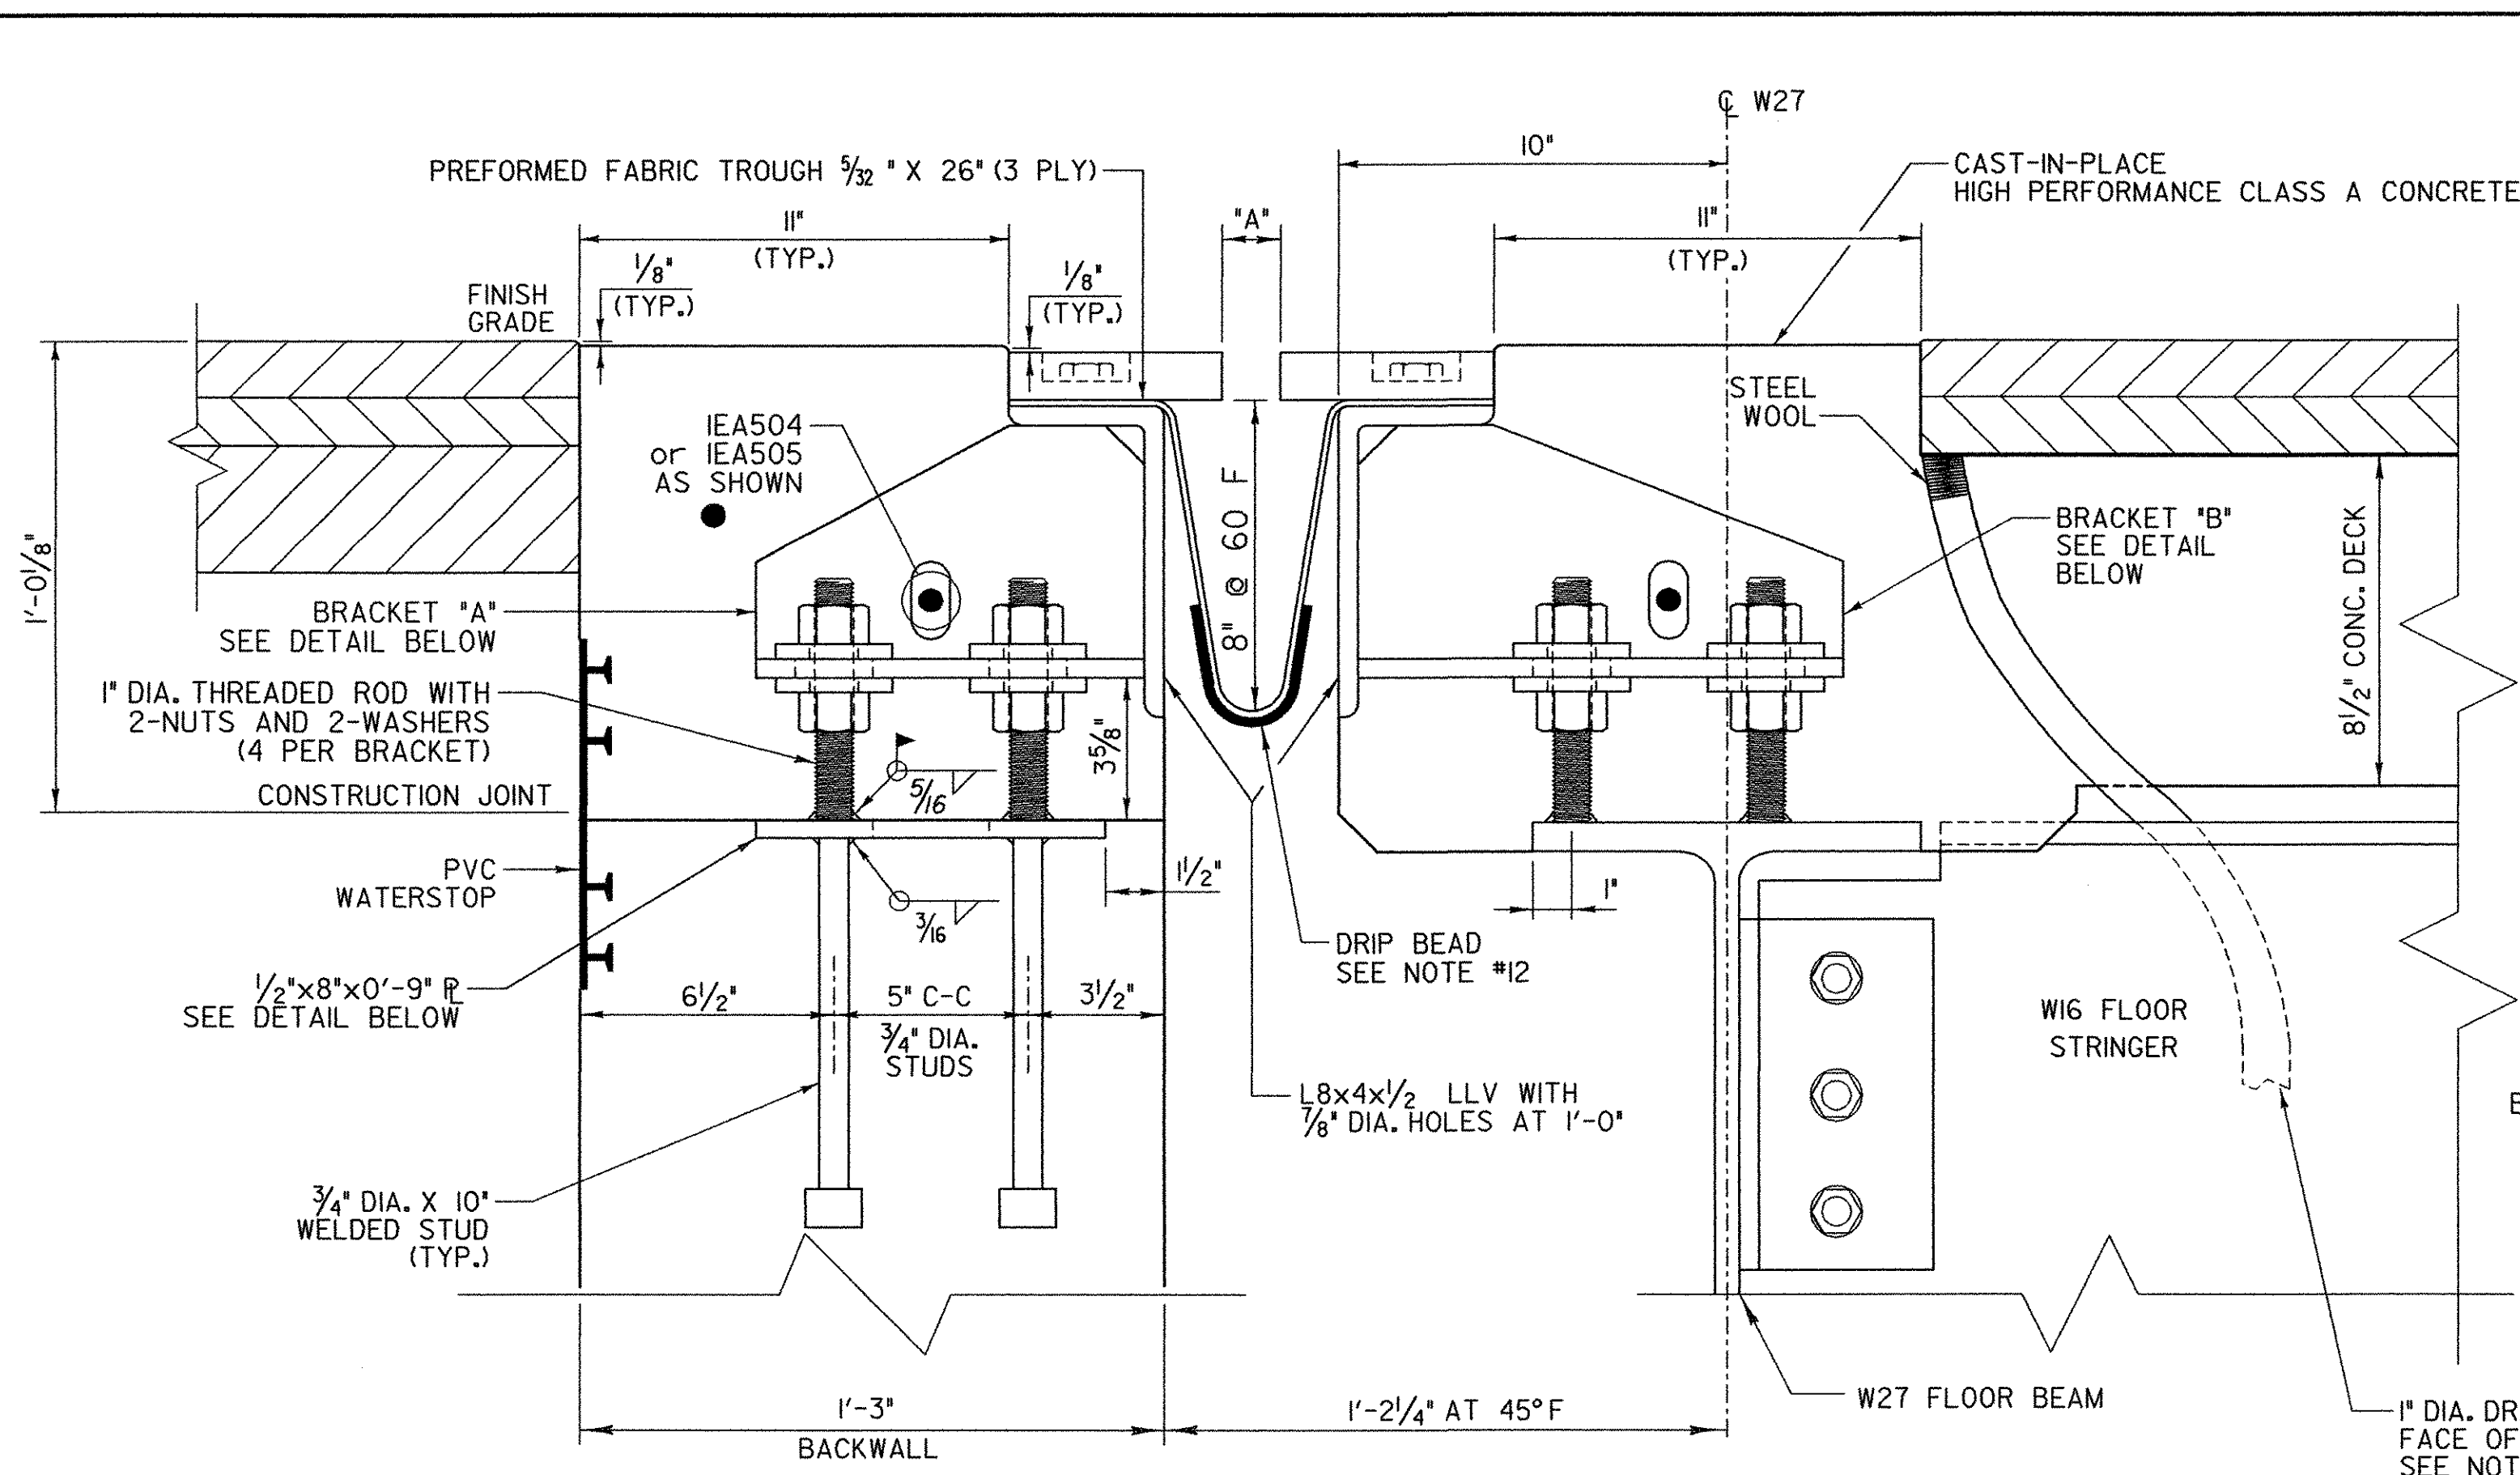



TYPICAL SECTION AT BRACKETS

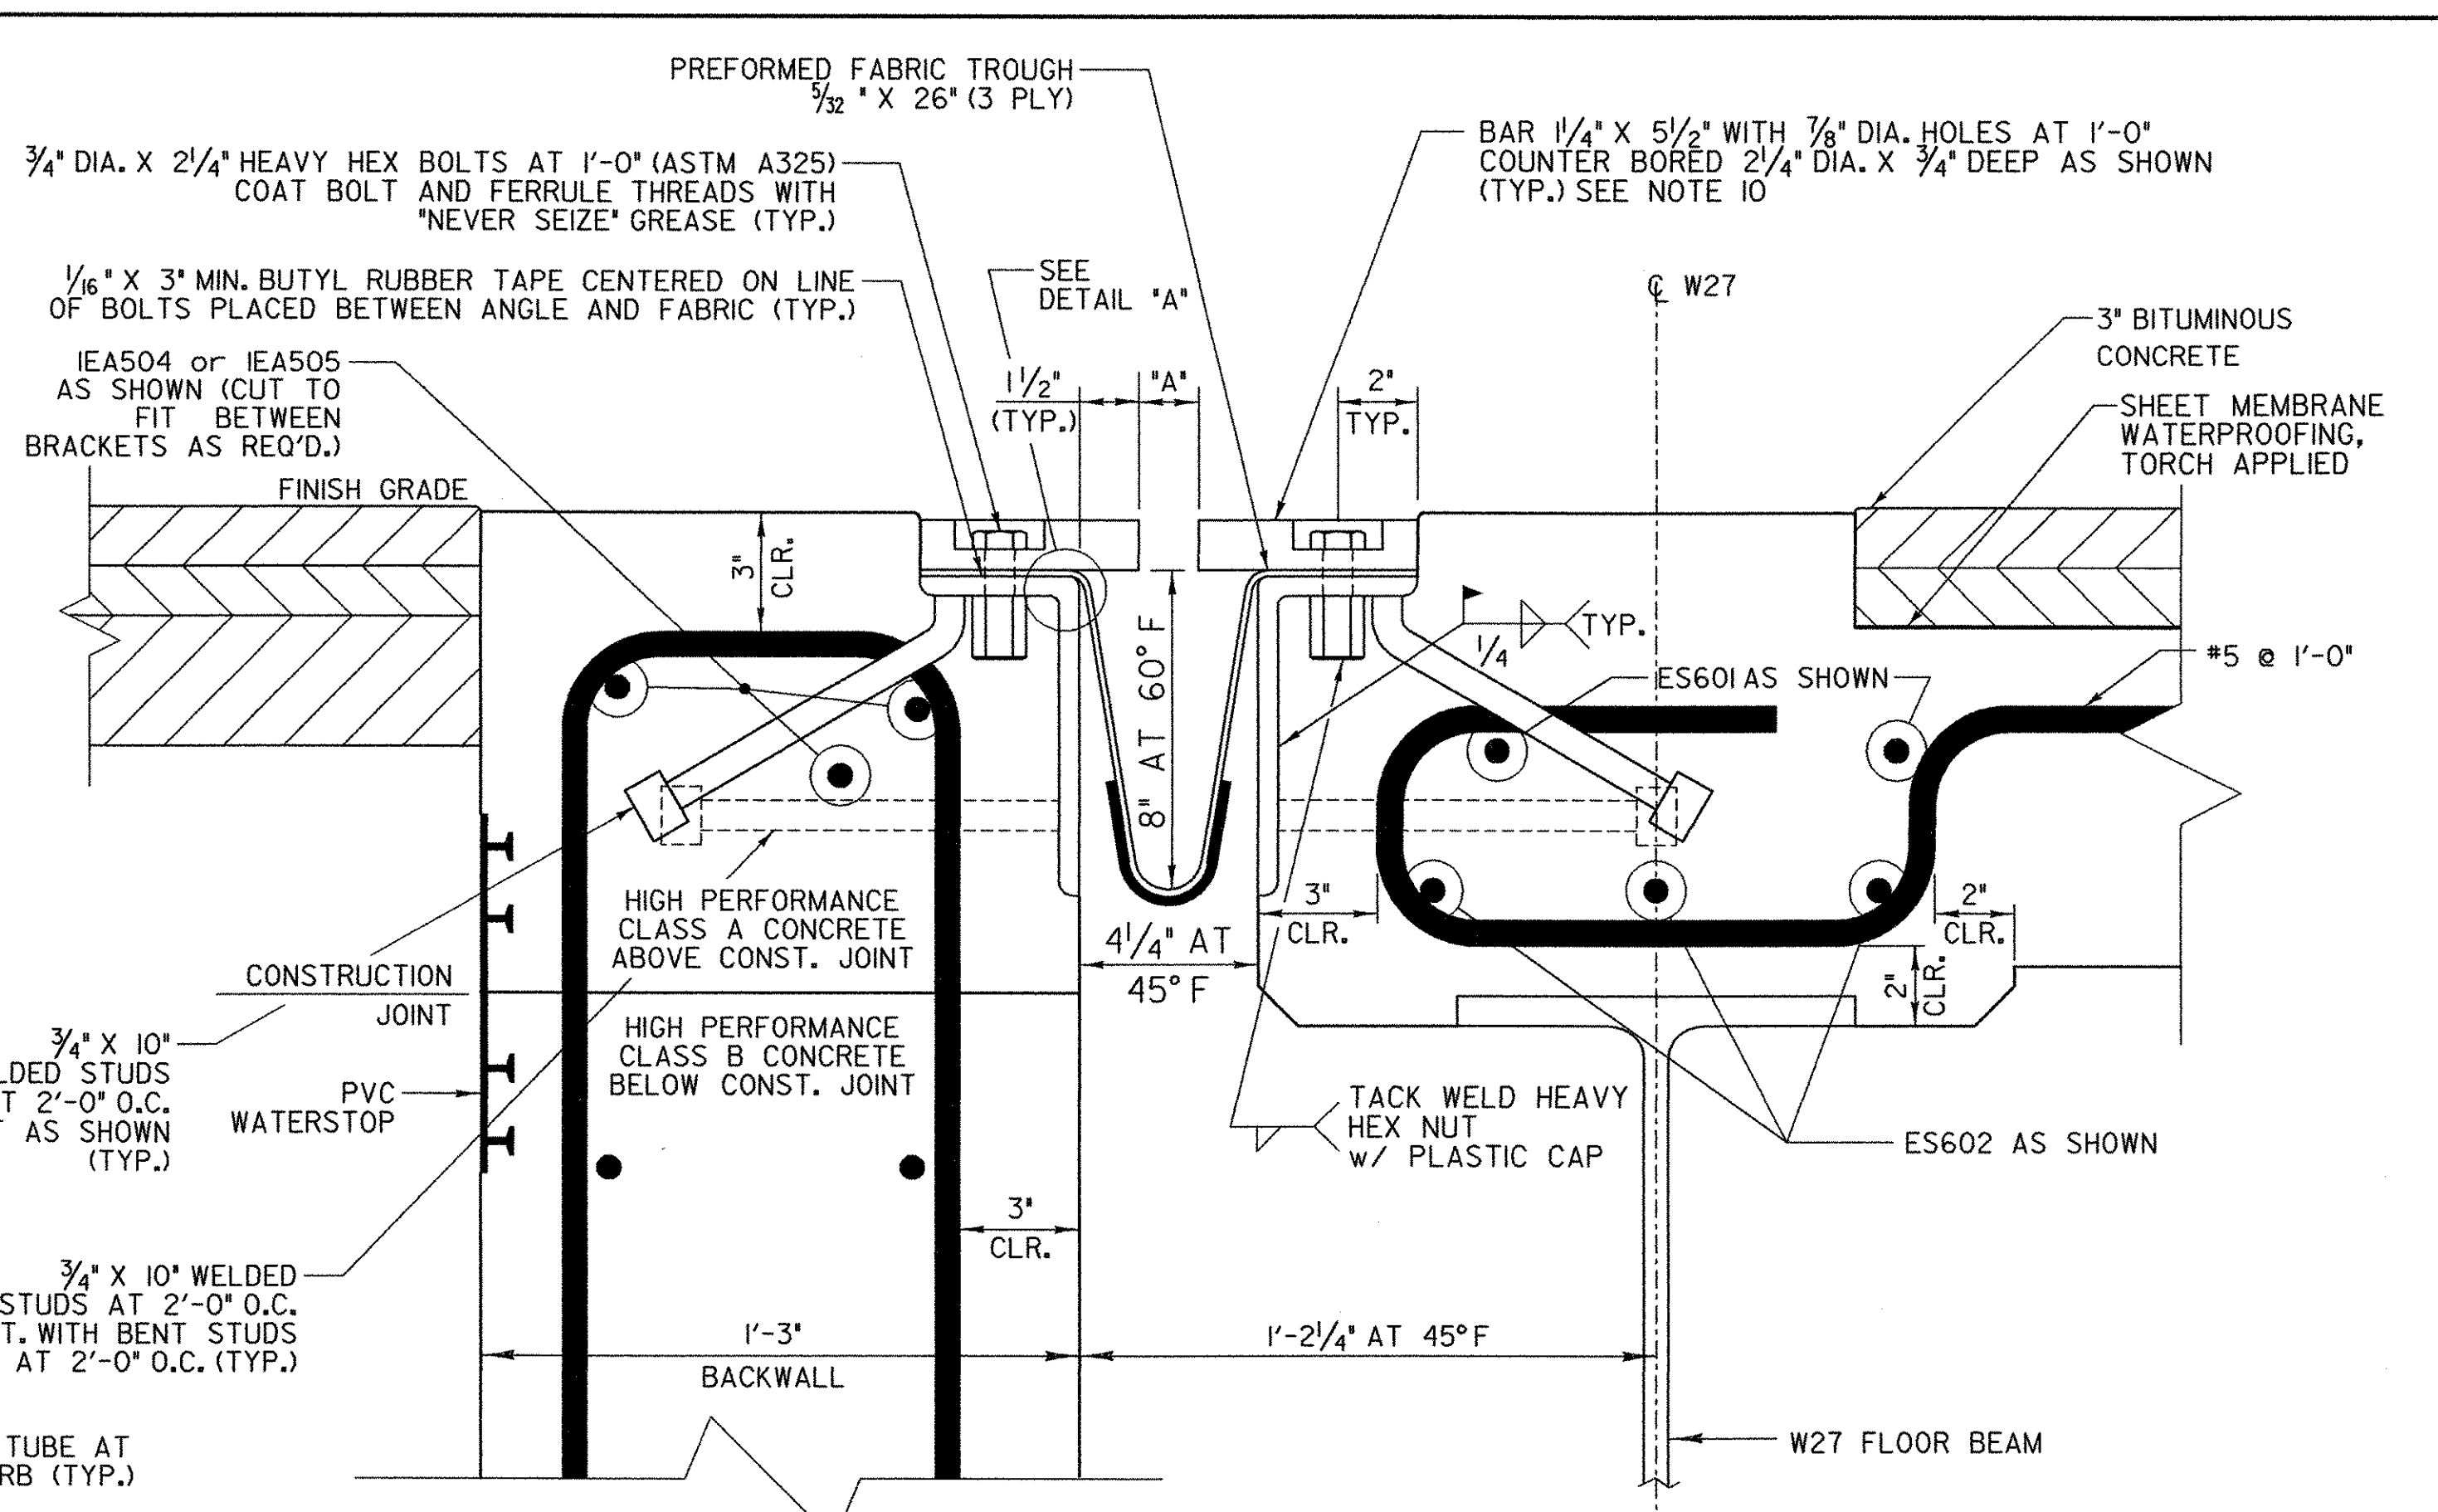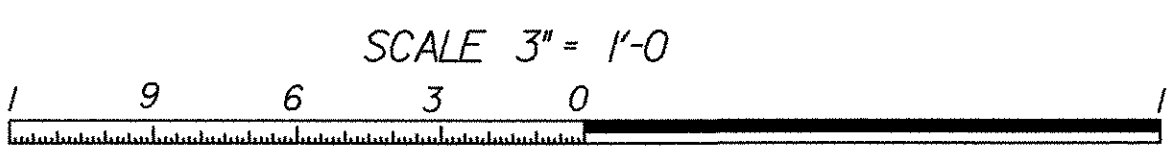



TYPICAL SECTION BETWEEN BRACKETS

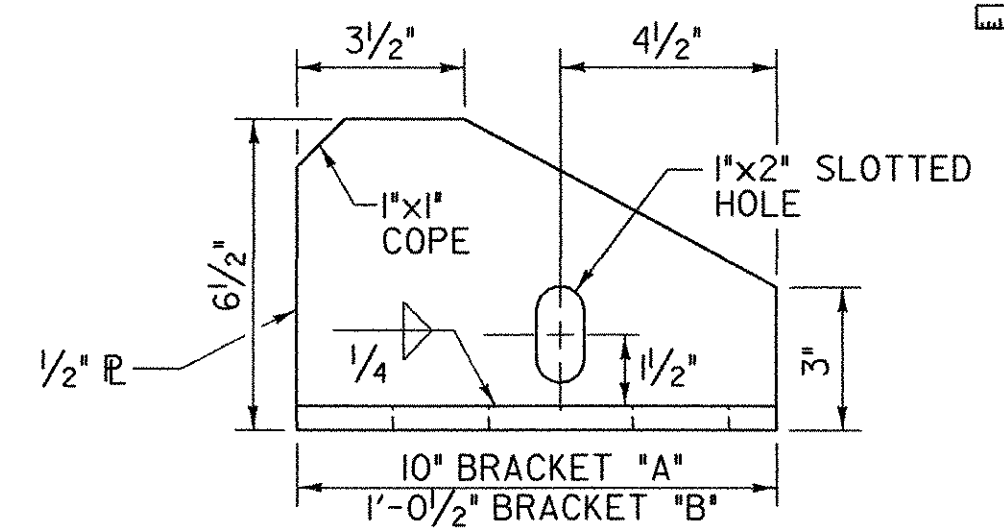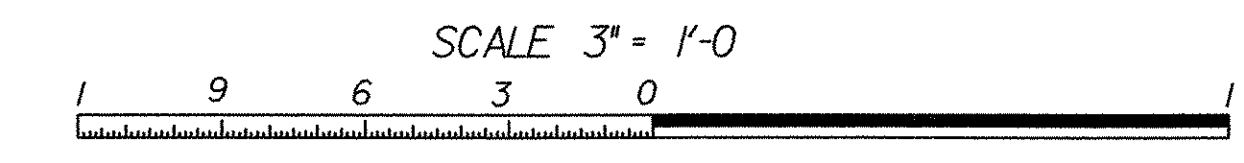

BRACKET "A" AND "B" ELEVATION

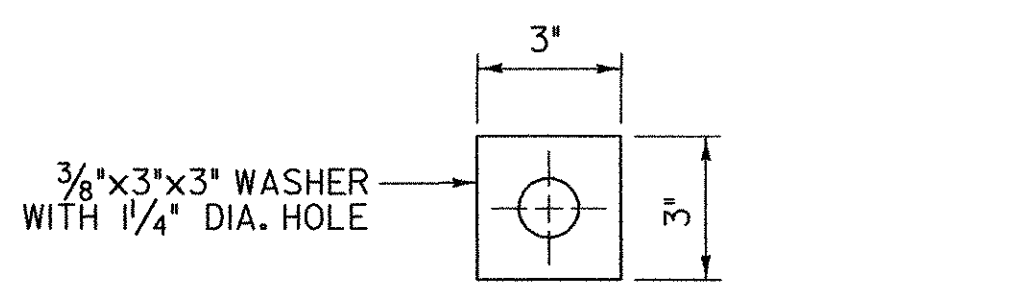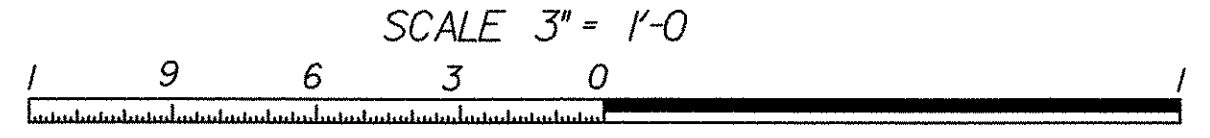

WASHER FOR BRACKET

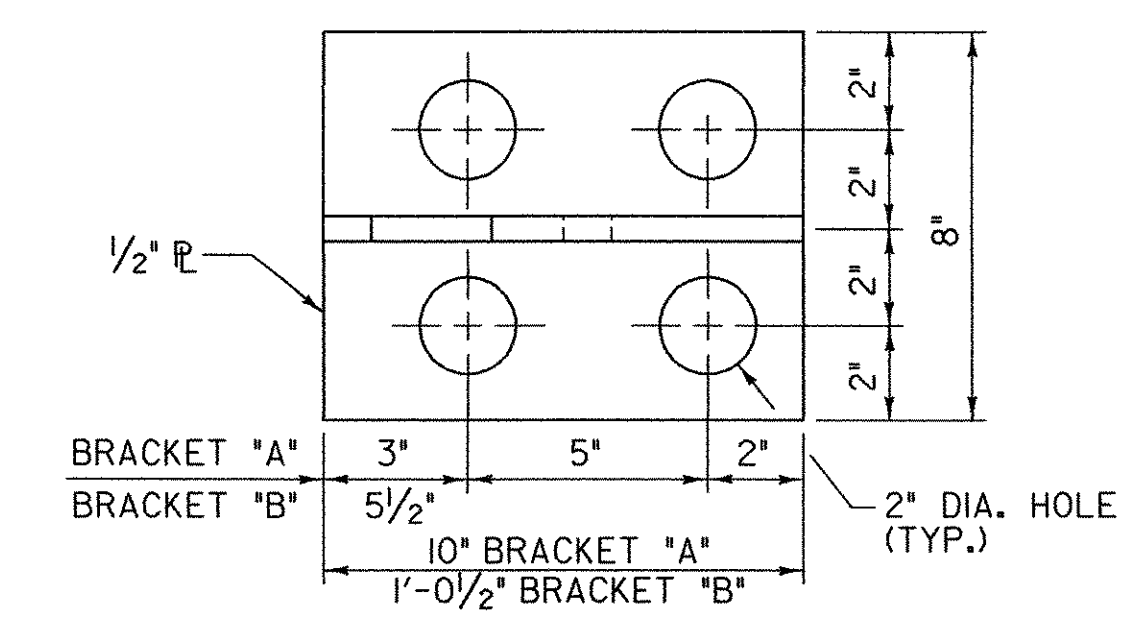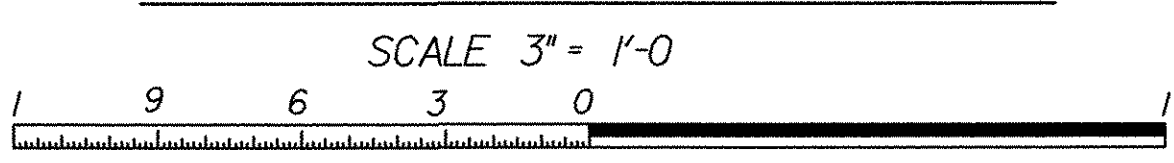

BRACKET "A" AND "B" PLAN



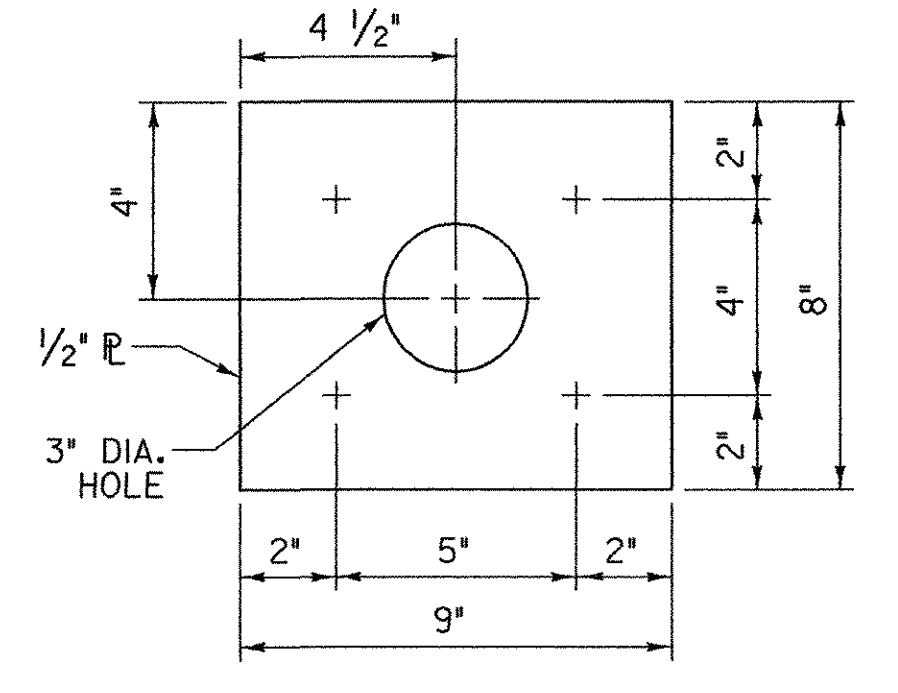



PLATE PLAN

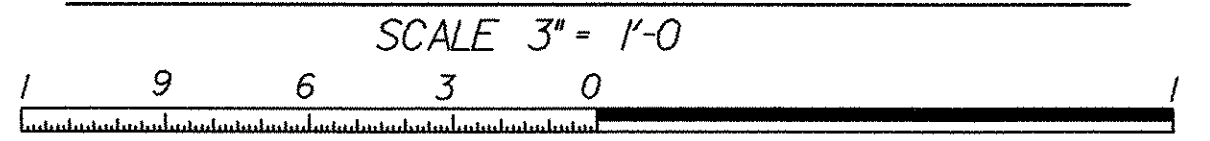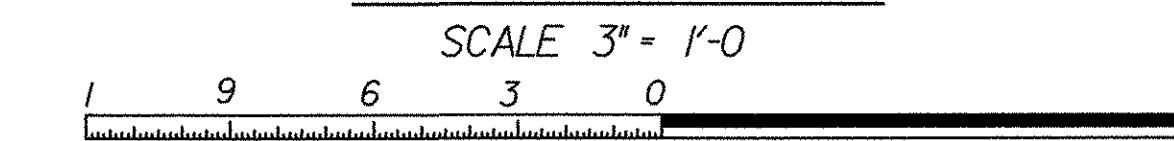

TEMP	"A" DIST.
0° F	1 1/16"
15° F	1 1/2"
30° F	1 3/8"
45° F	1 1/4"
60° F	1 1/16"
75° F	1 5/16"
90° F	1 3/8"
105° F	5/8"
120° F	1/2"

"A" IS THE SETTING DISTANCE WHEN DEAD LOADS ARE IN PLACE.


1. DETAILS ON THIS SHEET ARE FOR ITEM 516.11, "BRIDGE EXPANSION JOINT, VERMONT".
2. THE PREFORMED FABRIC MATERIAL SHALL BE CONTINUOUS AND INSTALLED ONLY AFTER THE BRIDGE DECK IS COMPLETED. THE PREFORMED FABRIC MATERIAL SHALL CONFORM TO SUBSECTION 707.07.
3. BUTYL RUBBER TAPE SHALL CONFORM TO SUBSECTION 707.12.
4. THE FINAL FINISH OF THE EXPANSION DEVICE SHALL BE COVERED DURING THE PLACING OF BRIDGE DECK CONCRETE.
5. ALL STEEL COMPONENTS SHALL BE AASHTO M 270M/M 270 GRADE 36 GALVANIZED OR METALIZED AS PER SUBSECTION 506.15, UNLESS OTHERWISE SPECIFIED. THREADED RODS SHALL CONFORM TO ASTM A307, GRADE C. THE NUTS FOR THE THREADED RODS SHALL BE ASTM A563.
6. THE ITEM 516.11, "BRIDGE EXPANSION JOINT, VERMONT" SHALL INCLUDE THE FABRICATION AND ERECTION OF THE COMPLETE JOINT ASSEMBLY INCLUDING ALL STEEL PLATES, BRACKETS, ANGLES, WELDED STUDS OR RODS, PREFORMED FABRIC DRAIN TROUGH MATERIAL AND PLASTIC DRAIN TUBES, BUTYL RUBBER TAPE AND ANY OTHER MISCELLANEOUS MATERIAL NECESSARY TO INSTALL JOINT.
7. THE 8"x4"x1/2" ANGLES SHALL BE FURNISHED AS ONE CONTINUOUS PIECE. THE 1 1/4" X 5 1/2" BARS EACH SIDE OF THE JOINT SHALL BE PROVIDED IN FOUR EQUAL LENGTHS.
8. COAT CONCRETE CONTACT SURFACES WITH EPOXY BONDING COMPOUND MEETING THE REQUIREMENTS OF SUBSECTION 719.02. PAYMENT SHALL BE INCLUDED IN THE UNIT PRICE BID FOR ITEM 516.11 "BRIDGE EXPANSION JOINT, VERMONT".
9. A 1" DIAMETER PLASTIC DRAIN TUBE (PER STD. SPEC. 740.01) SHALL BE INSTALLED AS SHOWN AT THE FACE OF CURB. THE UPPER END IS TO BE PLUGGED WITH STEEL WOOL AND THE LOWER END IS TO EXTEND BELOW THE BOTTOM OF THE W27 BEAM. THE DRAIN TUBES SHALL BE FASTENED TO THE BEAMS AND STRINGERS USING A METHOD APPROVED BY THE ENGINEER.
10. FILL COUNTER BORED HOLES WITH HOT POURED JOINT SEALER AFTER BOLT INSTALLATION. PAYMENT FOR THE WORK SHALL BE INCIDENTAL TO ITEM 516.11.
11. PAYMENT FOR WATERSTOP SHALL BE INCIDENTAL TO CONTRACT ITEM 501.34.
12. A DRIP BEAD OF 1/4" X 7" STRIP OF PREFORMED MATERIAL SHALL BE CEMENTED TO THE BOTTOM OF THE FABRIC TROUGH USING AN ADHESIVE APPROVED BY THE MANUFACTURER. THE DRIP BEAD SHALL BE APPLIED 1" FROM THE DOWNSPOUT END OF THE TROUGH.
13. FABRIC TROUGH SHALL BE THOROUGHLY CLEANED AND FLUSHED AFTER PAVING OPERATION.
14. THE EXPANSION JOINT SHALL BE SHOP ASSEMBLED AND SHIPPED AS ONE UNIT.

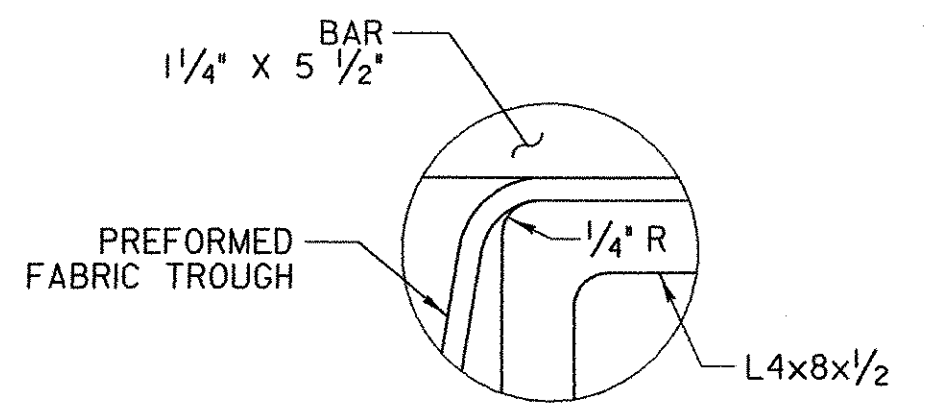

DETAIL "A"
NOT TO SCALE



PROJECT NAME:	RICHFORD
PROJECT NUMBER:	BHF 0302 (3) S
FILE NAME:	...Design\Rich-expj+2.dgn
PROJECT LEADER:	MJC
DESIGNED BY:	SEB
EXPANSION JOINT DETAILS	
PLOT DATE:	12/18/2007
DRAWN BY:	SEB
CHECKED BY:	MJC
SHEET	29 OF 41

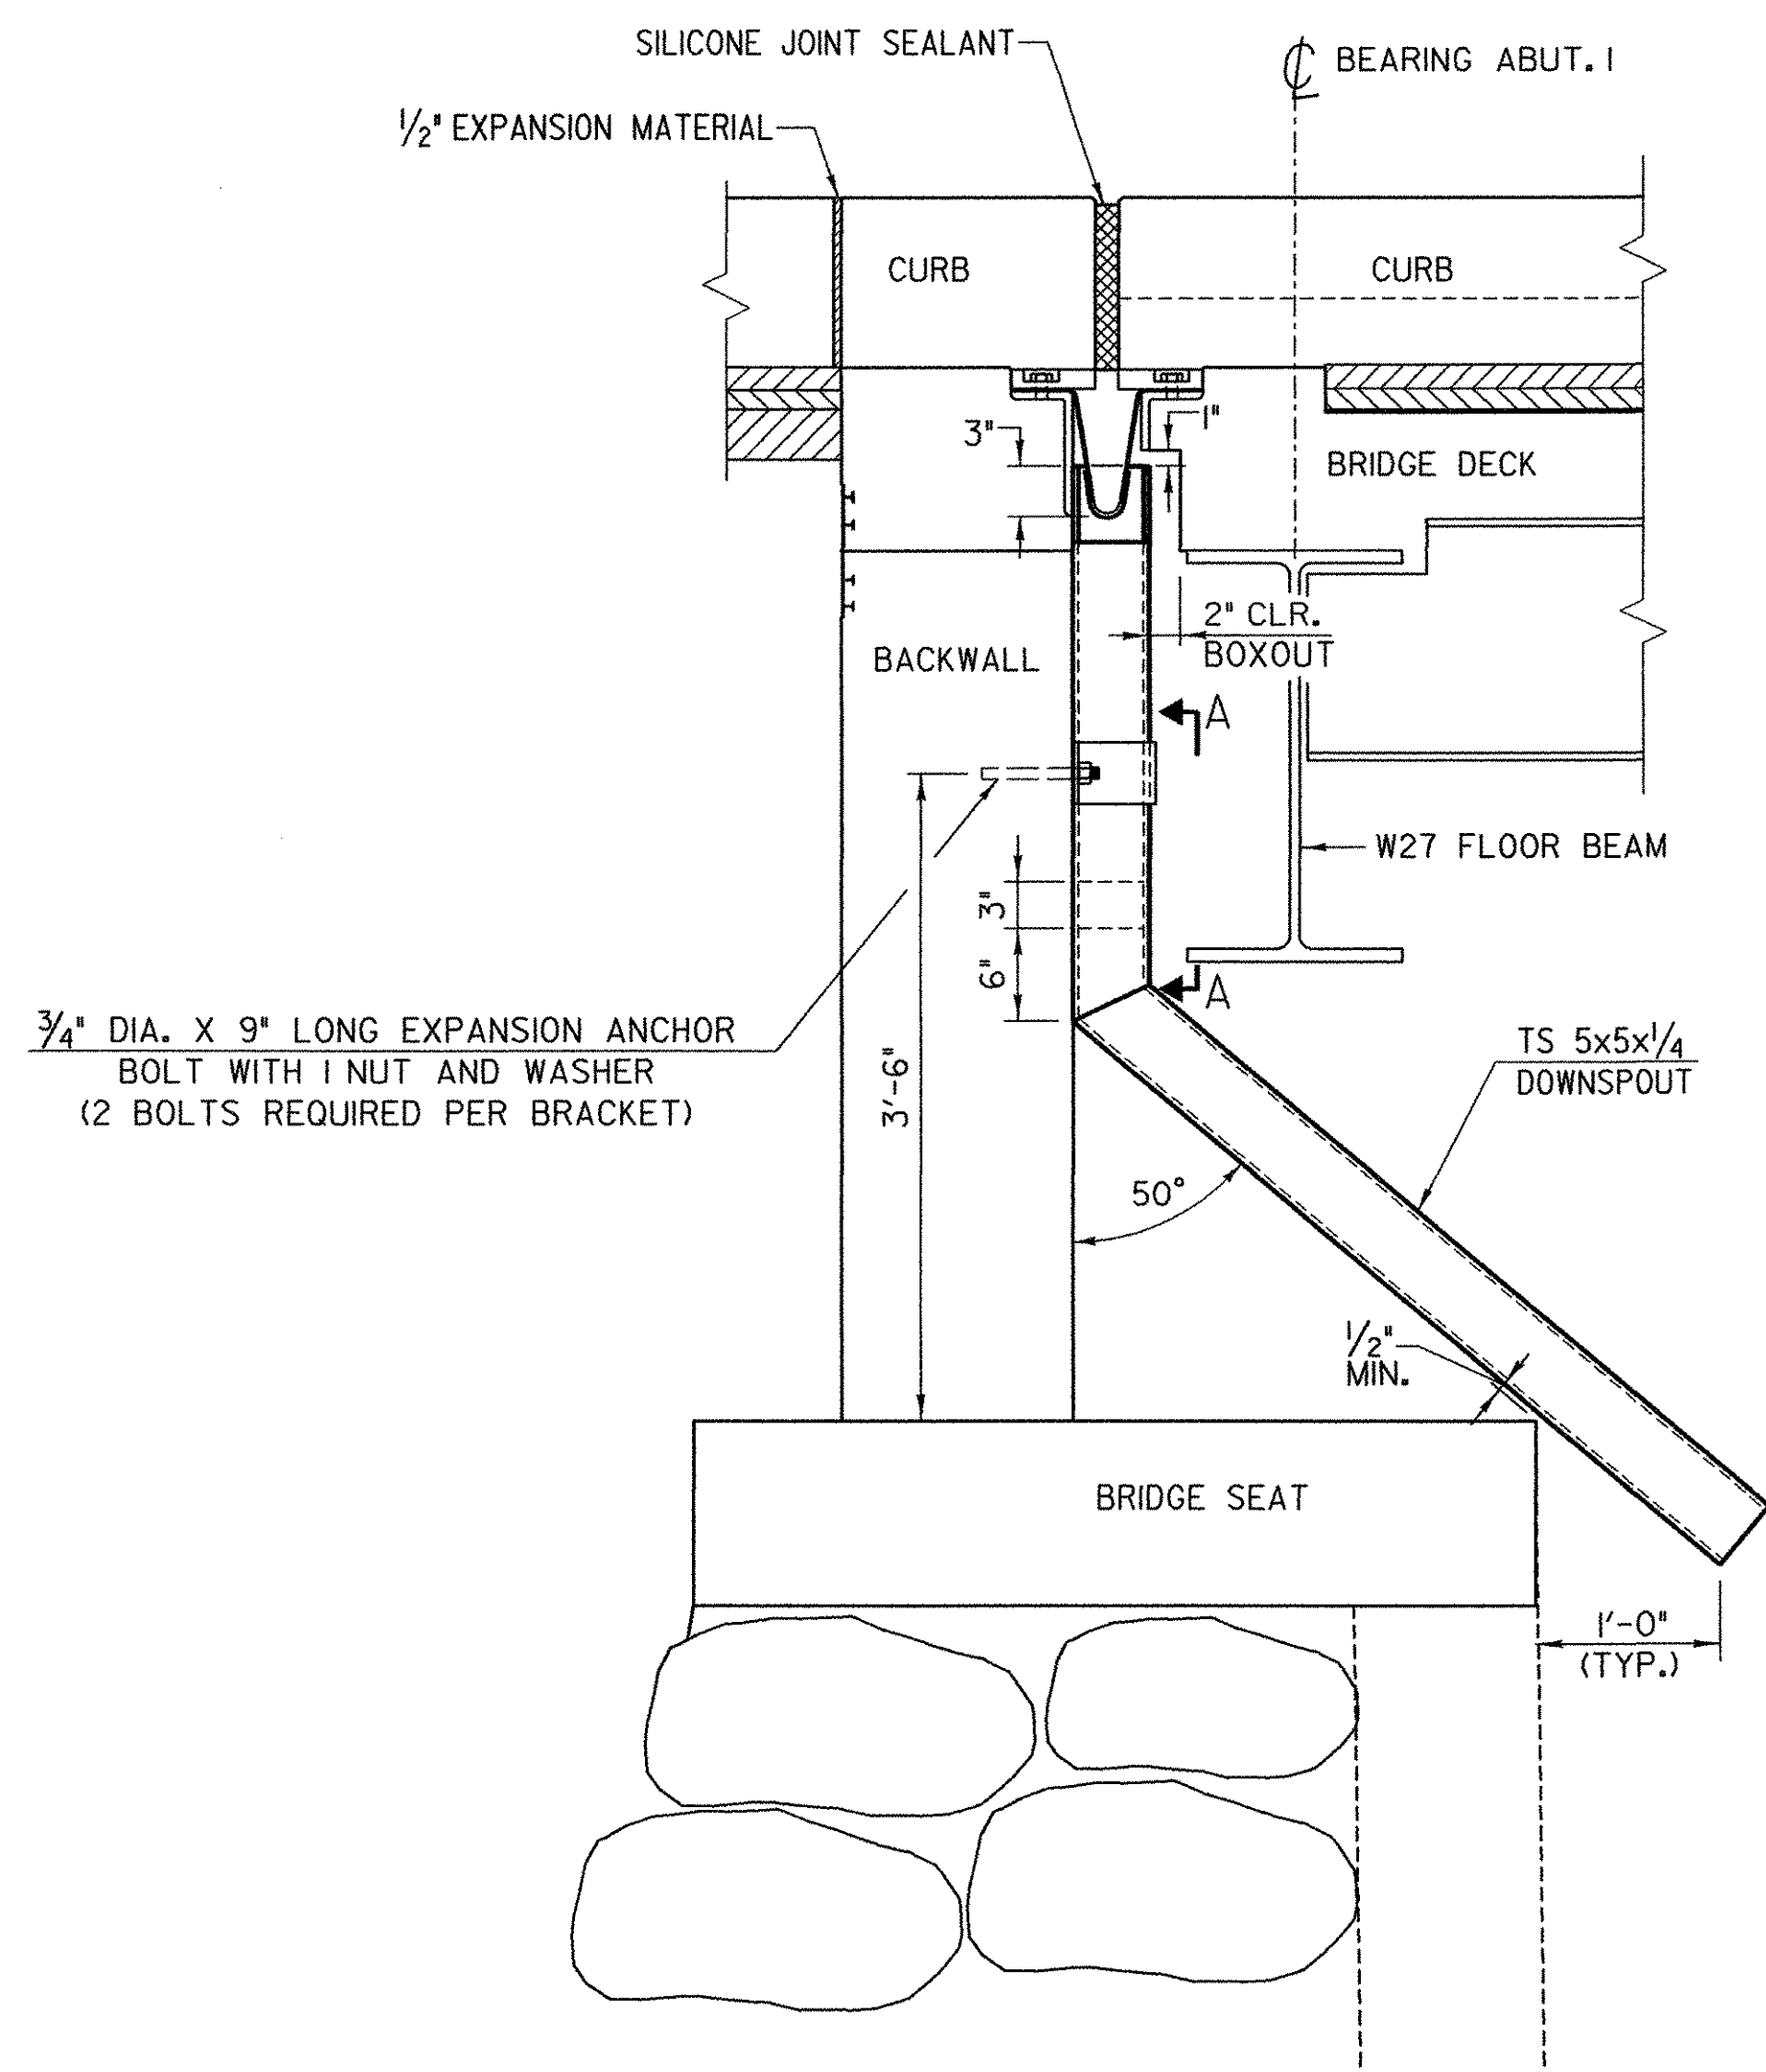


DOWNSPOUT ELEVATION

SCALE 1" = 1'-0"
 1 9 6 3 0 1 2


DOWNSPOUT NOTES

1. HOLLOW STRUCTURAL STEEL TUBING SHALL CONFORM TO SUBSECTION 714.II.
2. ALL PLATES, BARS, AND ANGLES SHALL CONFORM TO SUBSECTION 714.O3.
3. DOWNSPOUT SHALL BE GALVANIZED IN ACCORDANCE WITH SUBSECTION 506.I5, PART (a).
4. ALL BOLTS AND RELATED HARDWARE SHALL CONFORM TO SUBSECTION 714.O4 AND SHALL BE GALVANIZED IN ACCORDANCE WITH SUBSECTION 506.I5, PART (a).
5. ANY PLACE WHERE THE GALVANIZING HAS BEEN REMOVED FROM THE DOWNSPOUT EITHER BY CUTTING, BURNING, WELDING, PLACING, OR ANY OTHER MEANS, SHALL BE REPAIRED PER SECTION 513.
6. DOWNSPOUT AND ALL ANCHOR BOLTS WITH RELATED HARDWARE SHALL BE PAID FOR UNDER THE ITEM 506.60, "STRUCTURAL STEEL".

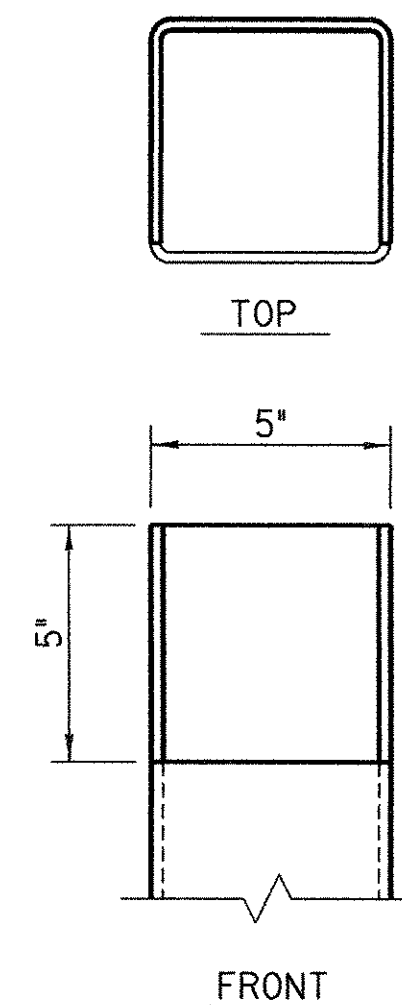


DOWNSPOUT CUTOUT FOR TROUGH

SCALE 3" = 1'-0"
 1 9 6 3 0 1

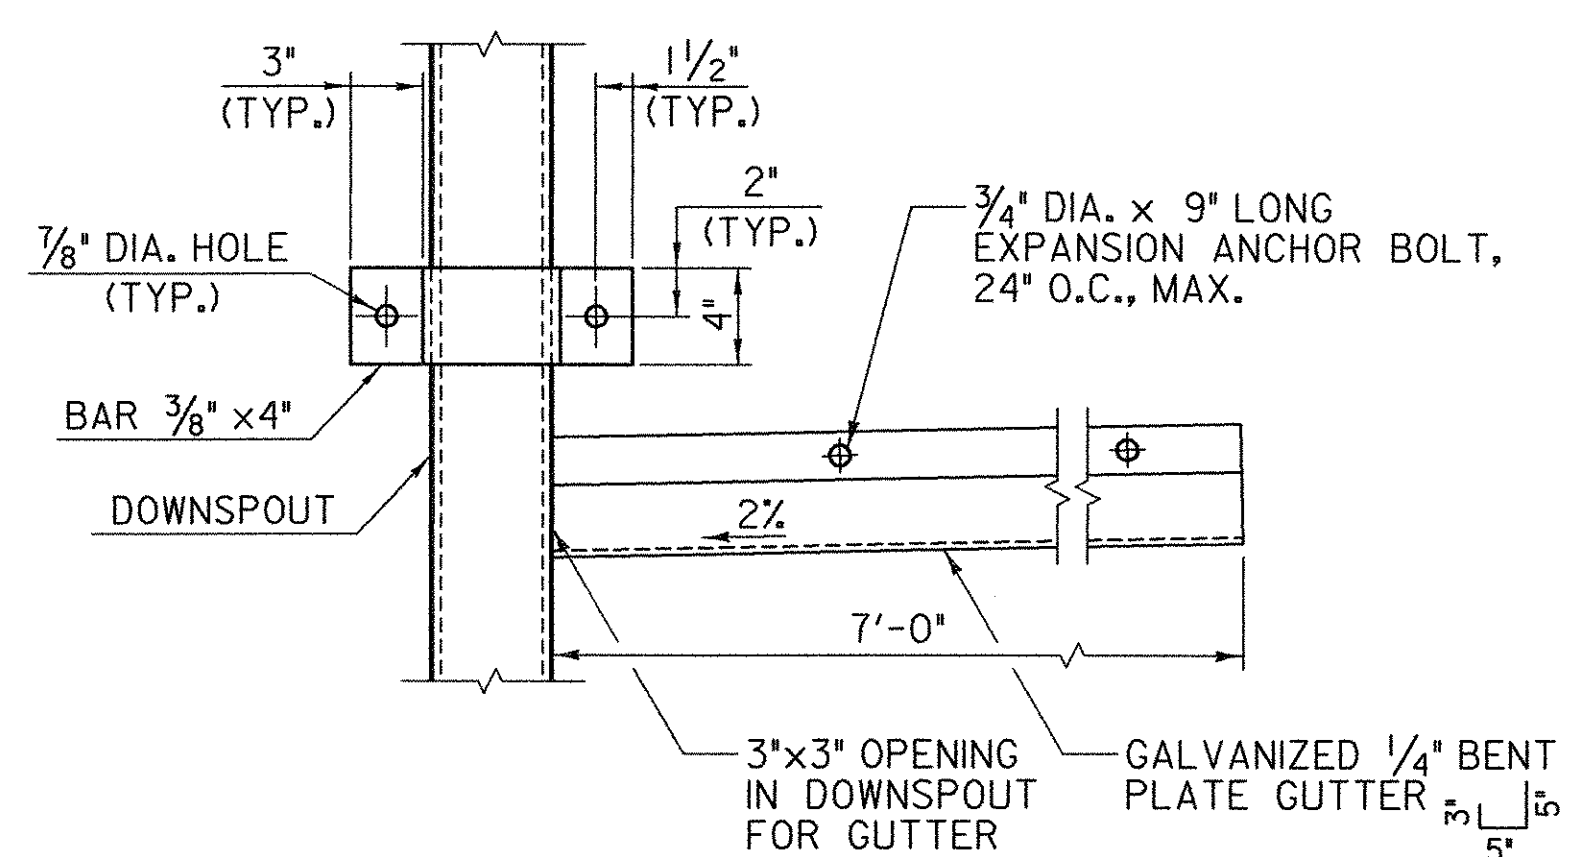


SECTION A-A

SCALE 1 1/2" = 1'-0"
 1 9 6 3 0 1

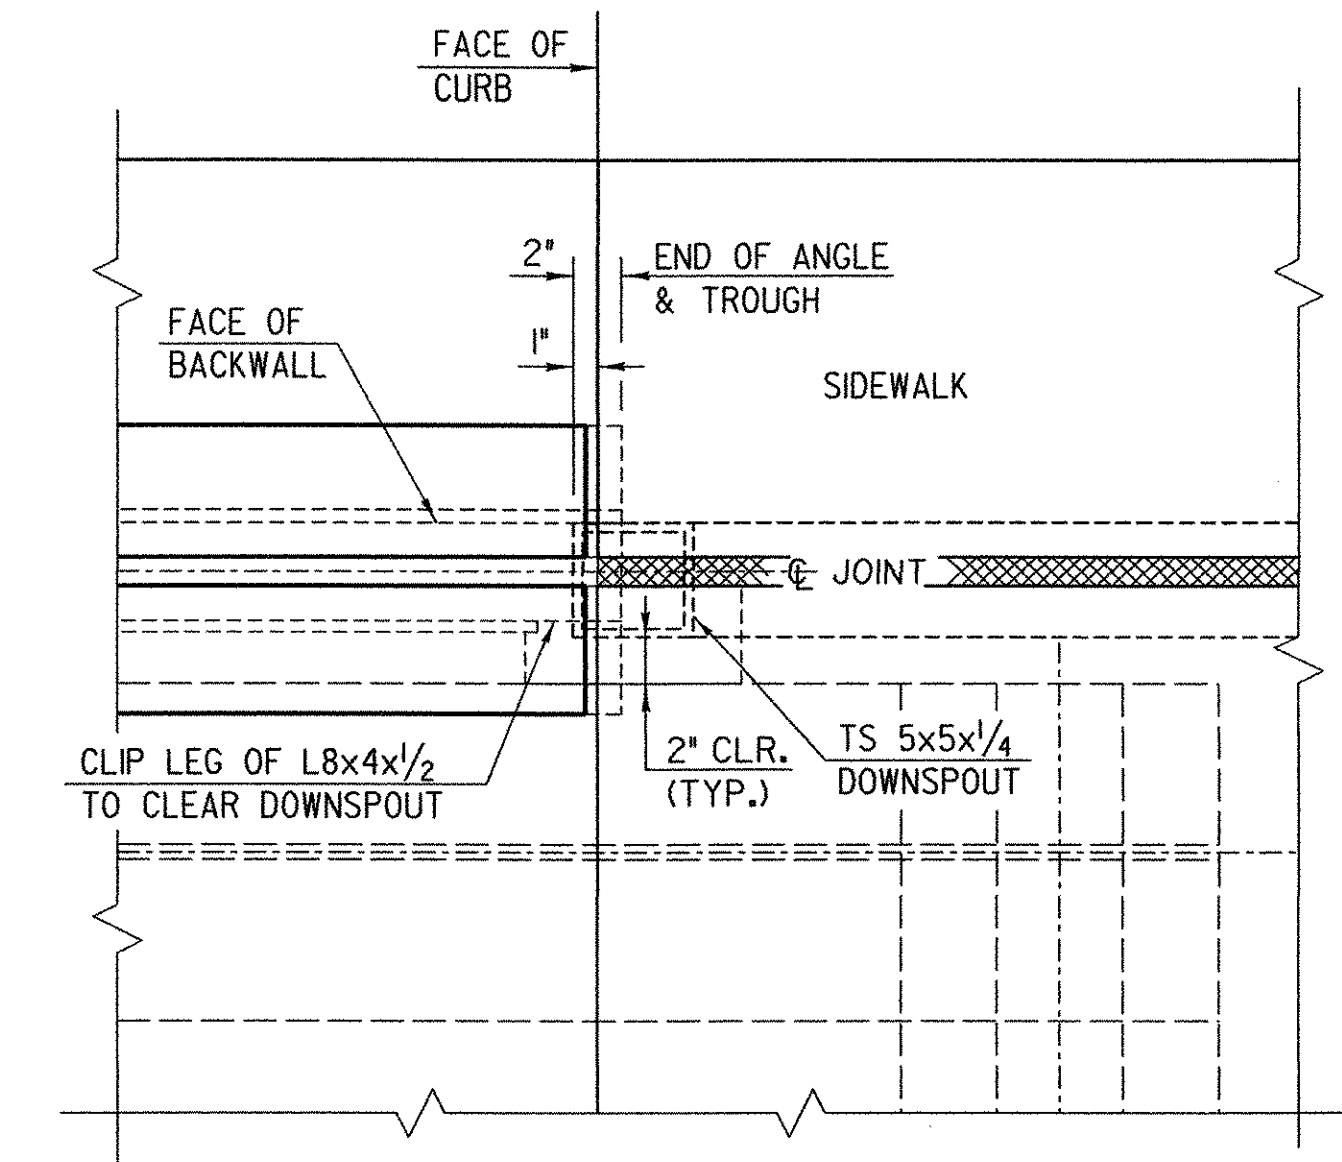

PLAN VIEW OF DOWNSPOUT

SCALE 1 1/2" = 1'-0"
 1 9 6 3 0 1

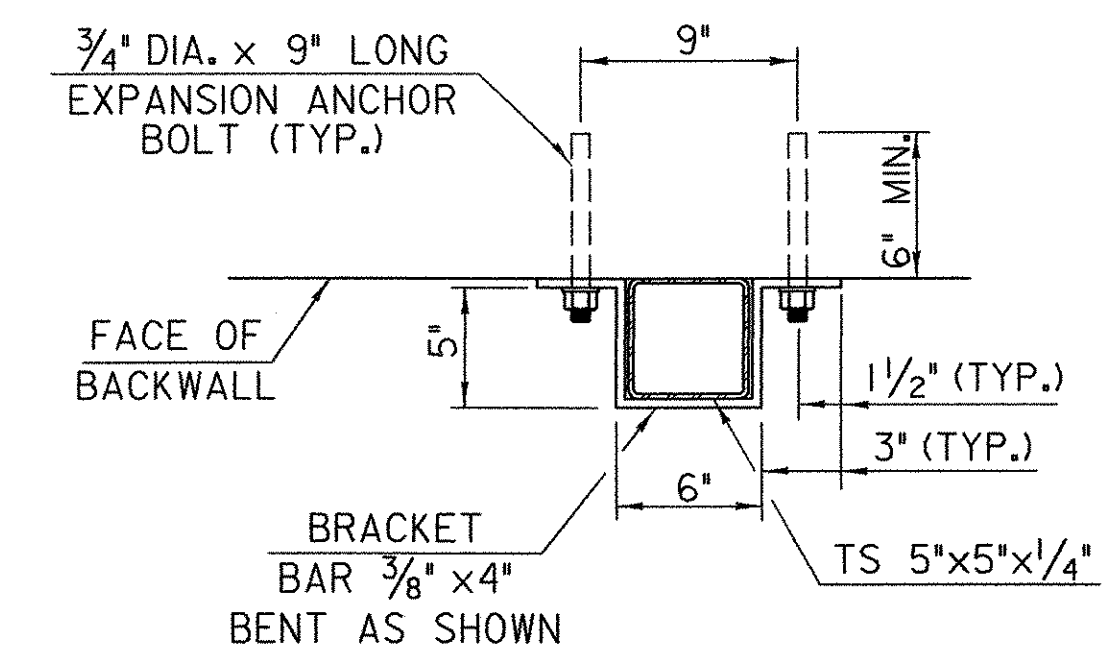


DETAILS FOR ATTACHING DOWNSPOUT TO ABUTMENT


SCALE 1 1/2" = 1'-0"
 1 9 6 3 0 1



PROJECT NAME: RICHFORD	PLOT DATE: 12/18/2007
PROJECT NUMBER: BHF 0302 (3) S	DRAWN BY: AET
FILE NAME: ...Design\rich-dspout.dgn	CHECKED BY: MJC
PROJECT LEADER: MJC	DESIGNED BY: SEB
DOWNSPOUT DETAILS	
SHEET 30 OF 41	

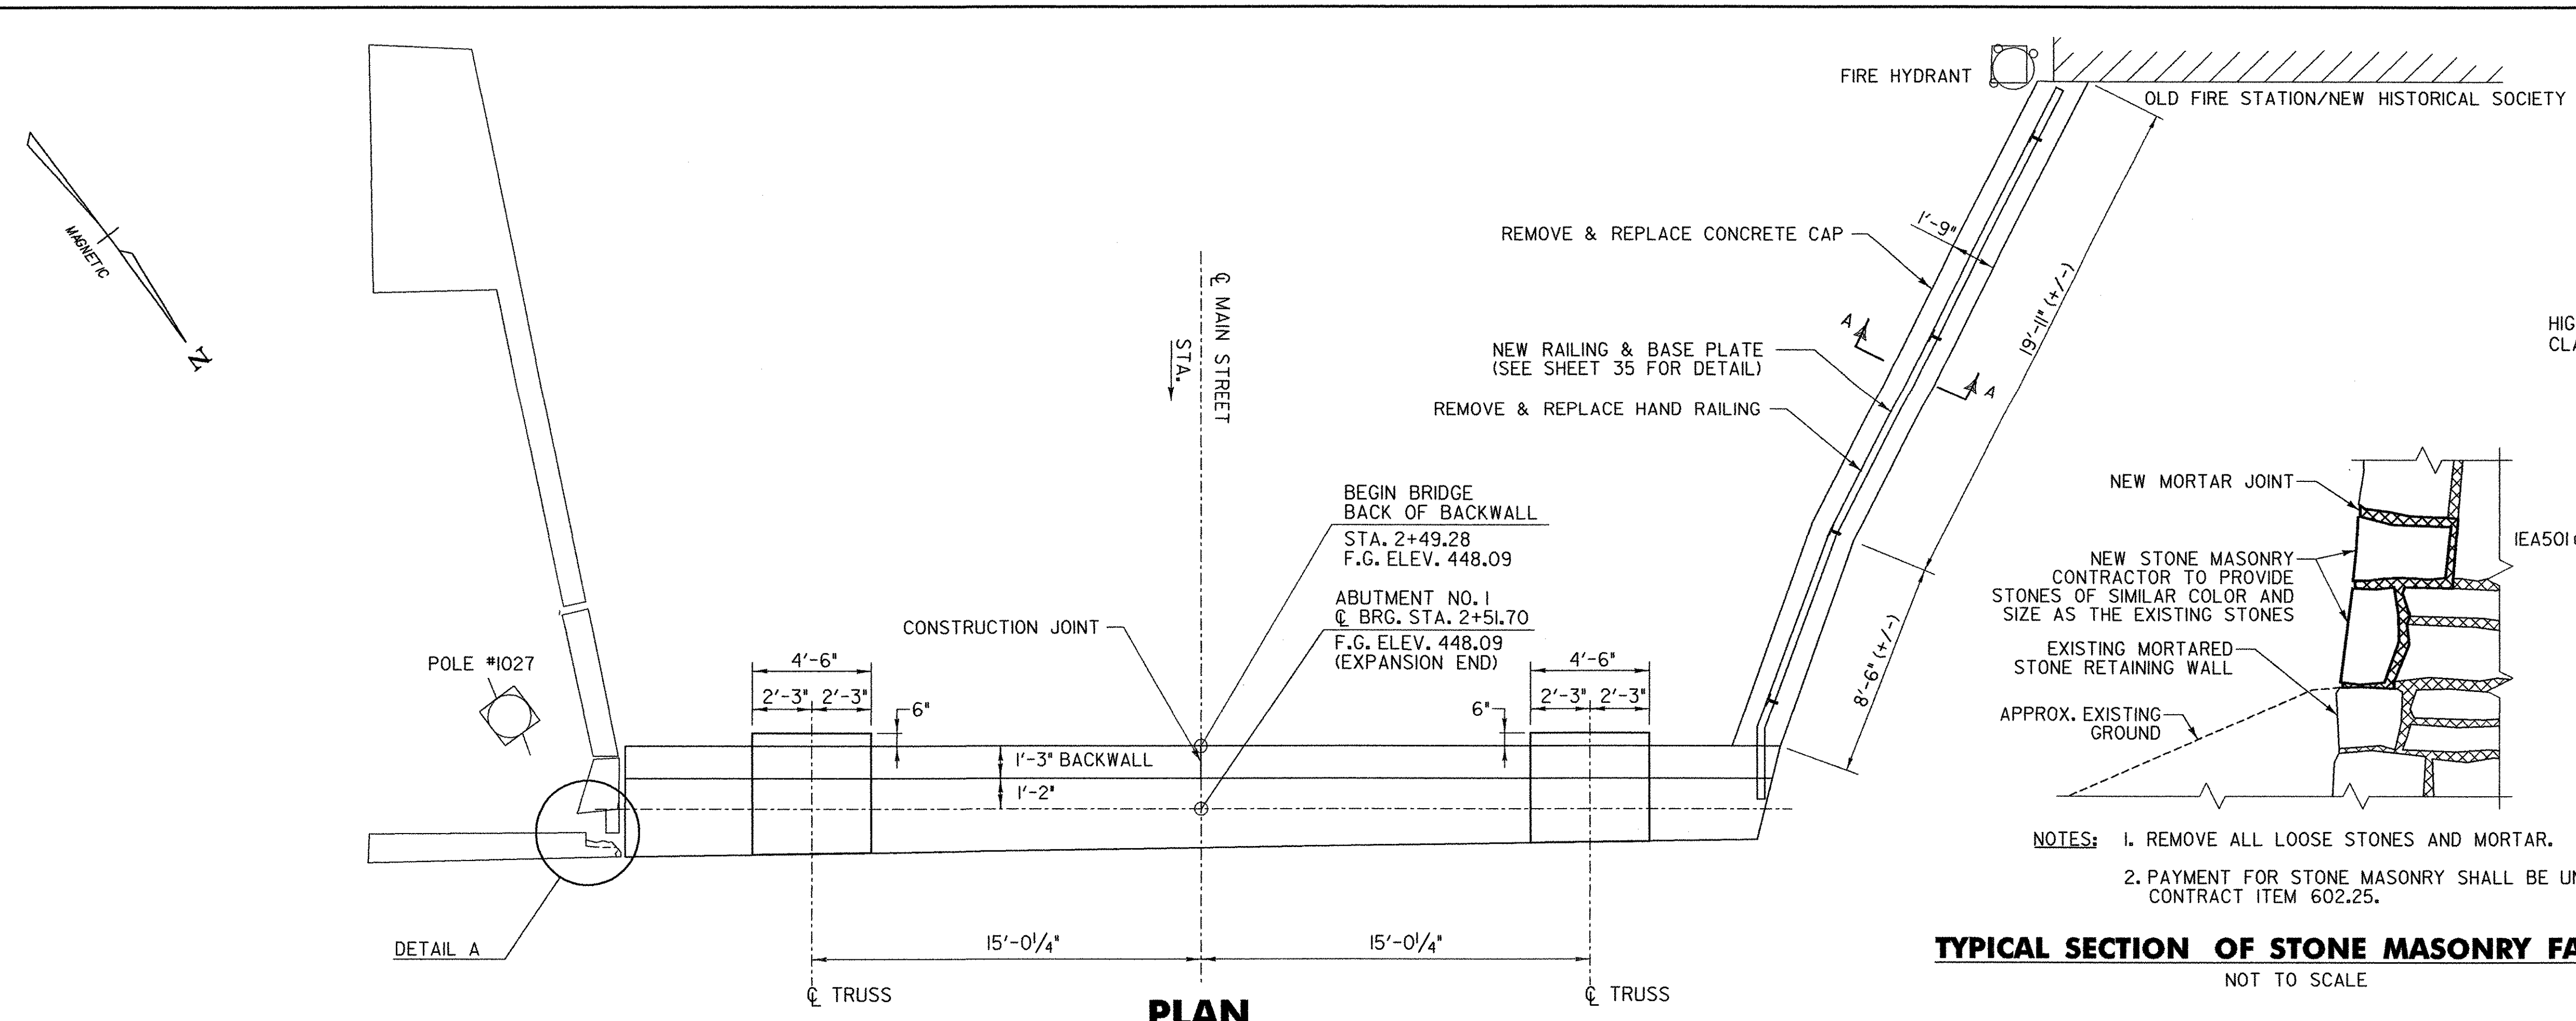

PLAN
SCALE 1/4" = 1'-0"
1 0 2 4 6

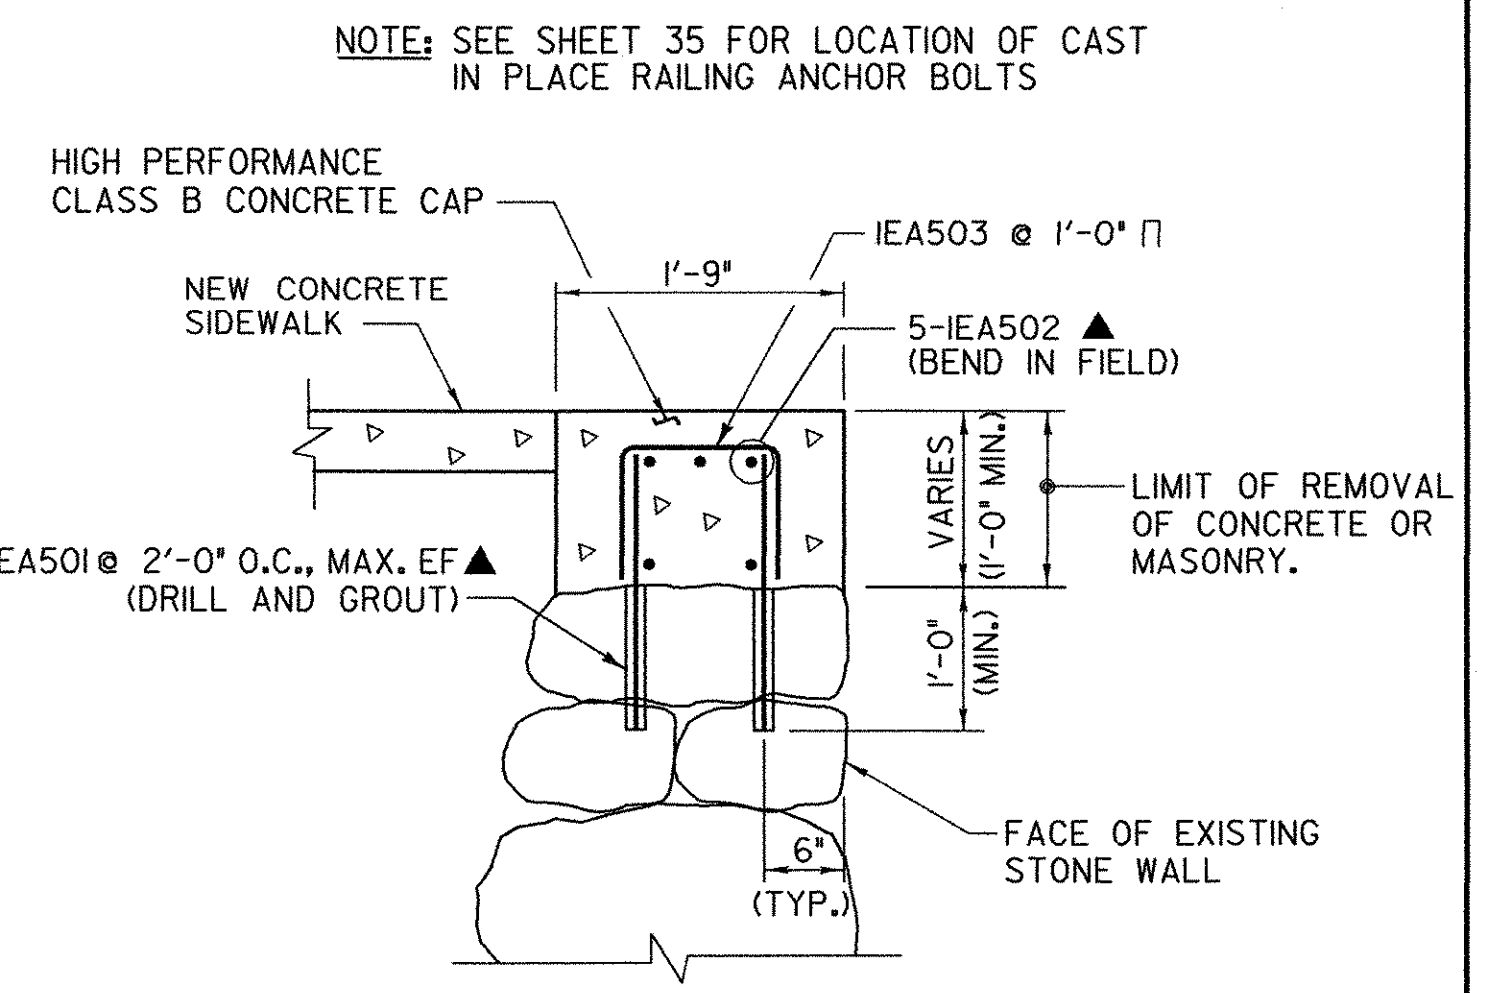


SECTION A-A
SCALE 3/4" = 1'-0"
1 0 2

TYPICAL SECTION OF STONE MASONRY FACING
NOT TO SCALE

NOTES: 1. REMOVE ALL LOOSE STONES AND MORTAR.
2. PAYMENT FOR STONE MASONRY SHALL BE UNDER CONTRACT ITEM 602.25.


LEGEND FOR CONCRETE REPAIR

■ - ITEM 602.25, "STONE MASONRY FACING"

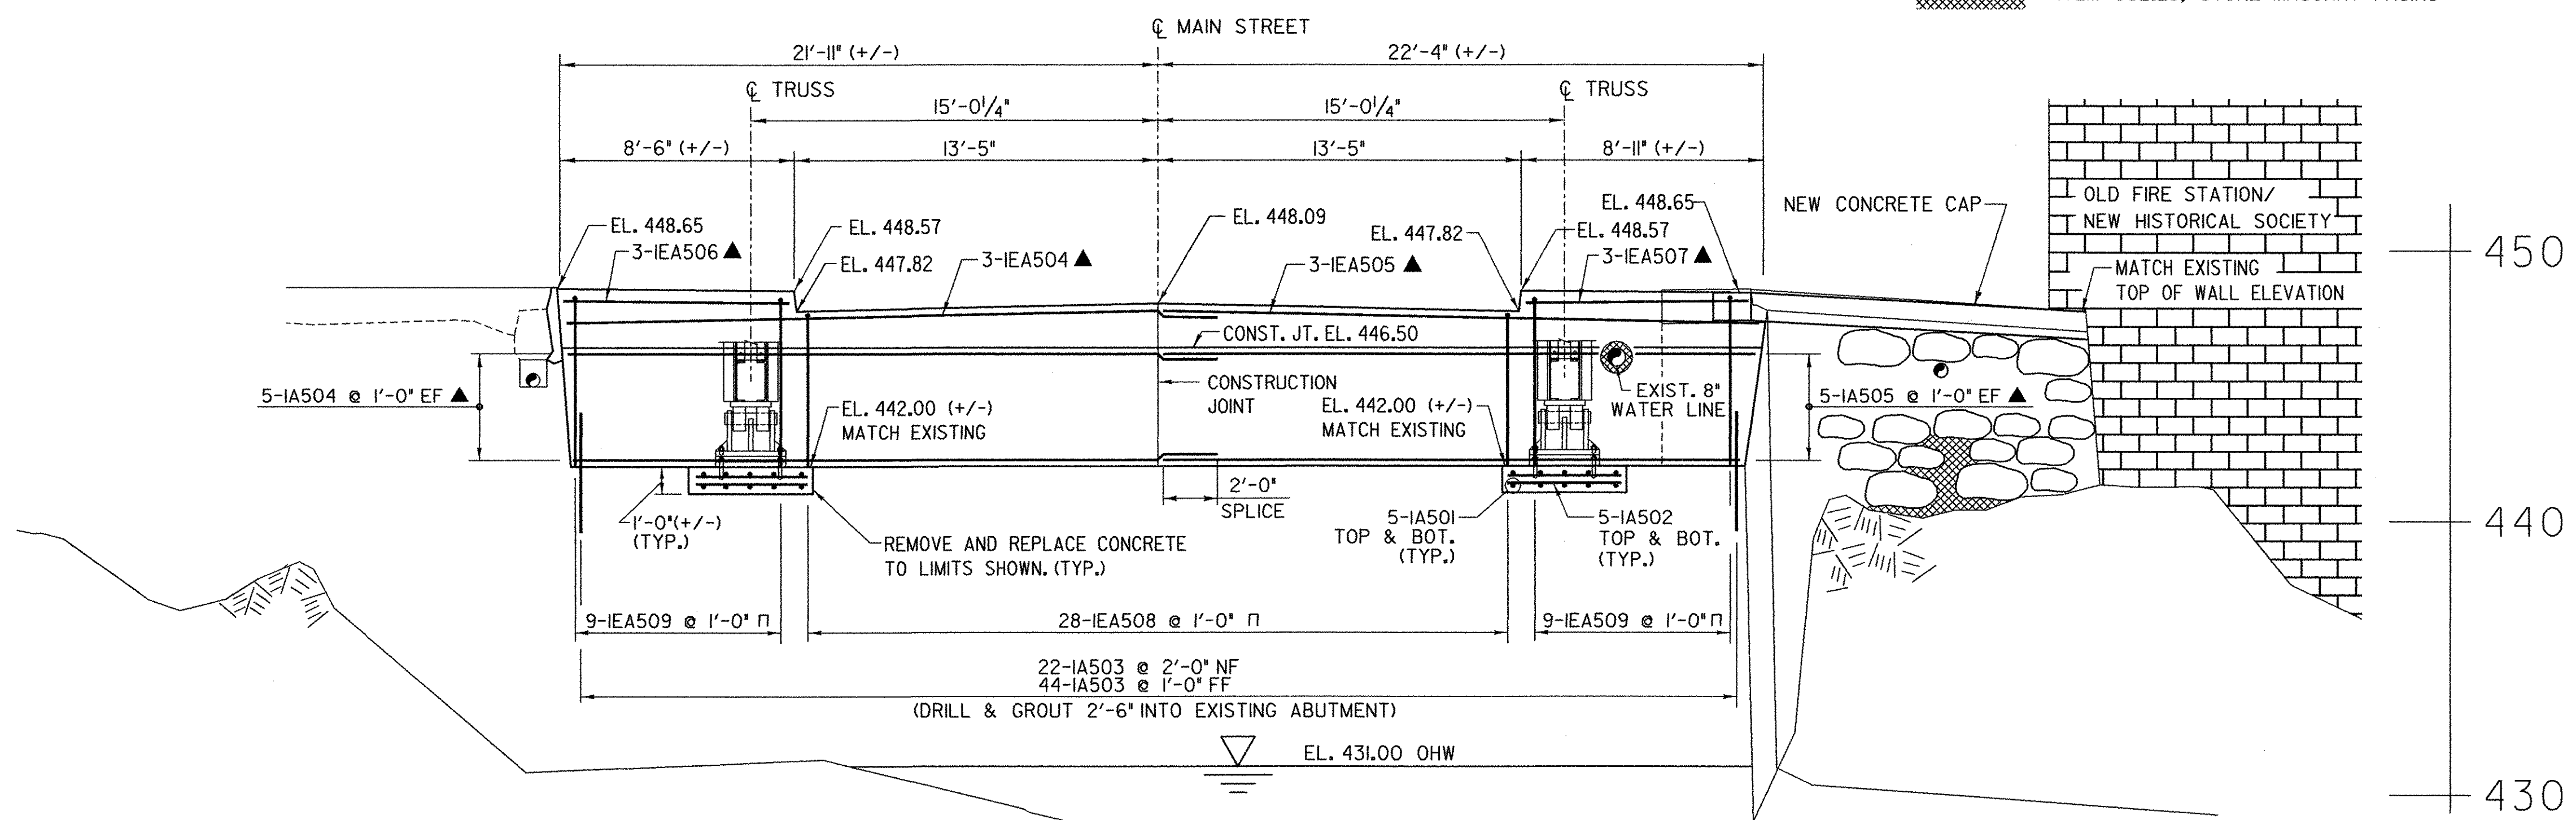

ELEVATION
SCALE 1/4" = 1'-0"
1 0 2 4 6

NOTE:
NF = NEAR FACE
FF = FAR FACE
EF = EACH FACE
▲ = CUT TO FIT IN FIELD

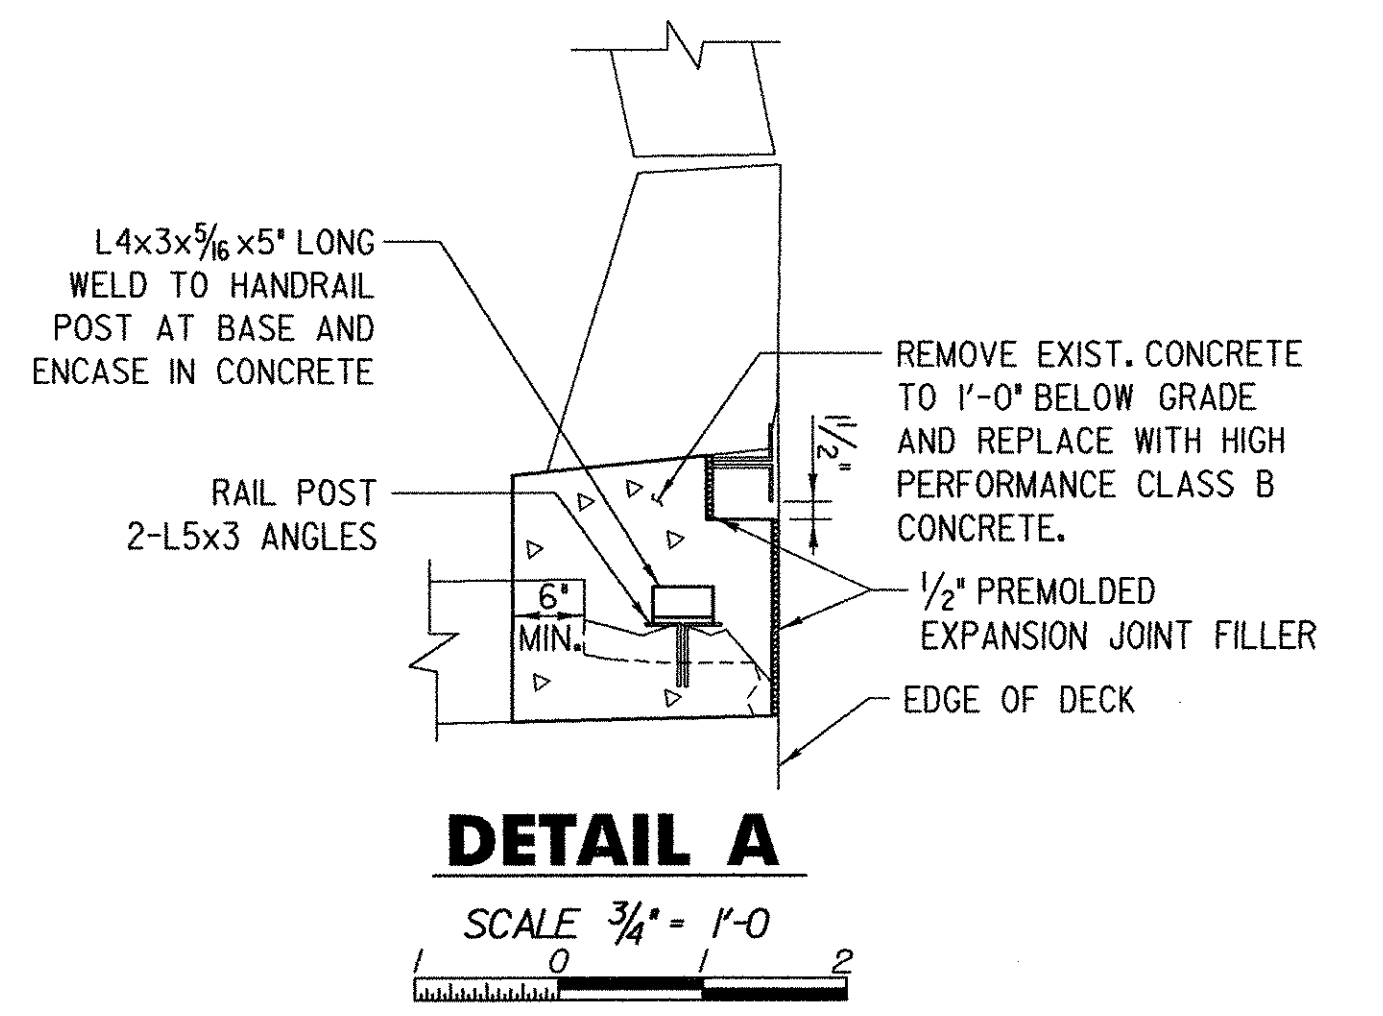


DETAIL A
SCALE 3/4" = 1'-0"
1 0 2

NOTES:
1. SEE SHEET 33 FOR ABUTMENT SECTIONS.
2. AREAS OF CONCRETE SURFACE REPAIR ON EXISTING ABUTMENTS TO BE DETERMINED IN THE FIELD BY THE ENGINEER AND PAID FOR UNDER ITEM 580.13 "REPAIR OF CONCRETE SUBSTRUCTURE SURFACE CLASS I OR 580.14 "REPAIR OF CONCRETE SUBSTRUCTURE SURFACE CLASS II.




PROJECT NAME:	RICHFORD	FILE NAME:	...Design\Rich-abut1.dgn	PLOT DATE:	12/18/2007
PROJECT NUMBER:	BHF 0302 (3) S	PROJECT LEADER:	MJC	DRAWN BY:	AET
		DESIGNED BY:	SEB	CHECKED BY:	MJC
ABUTMENT NO. 1 PLAN & ELEVATION			SHEET 31 OF 41		

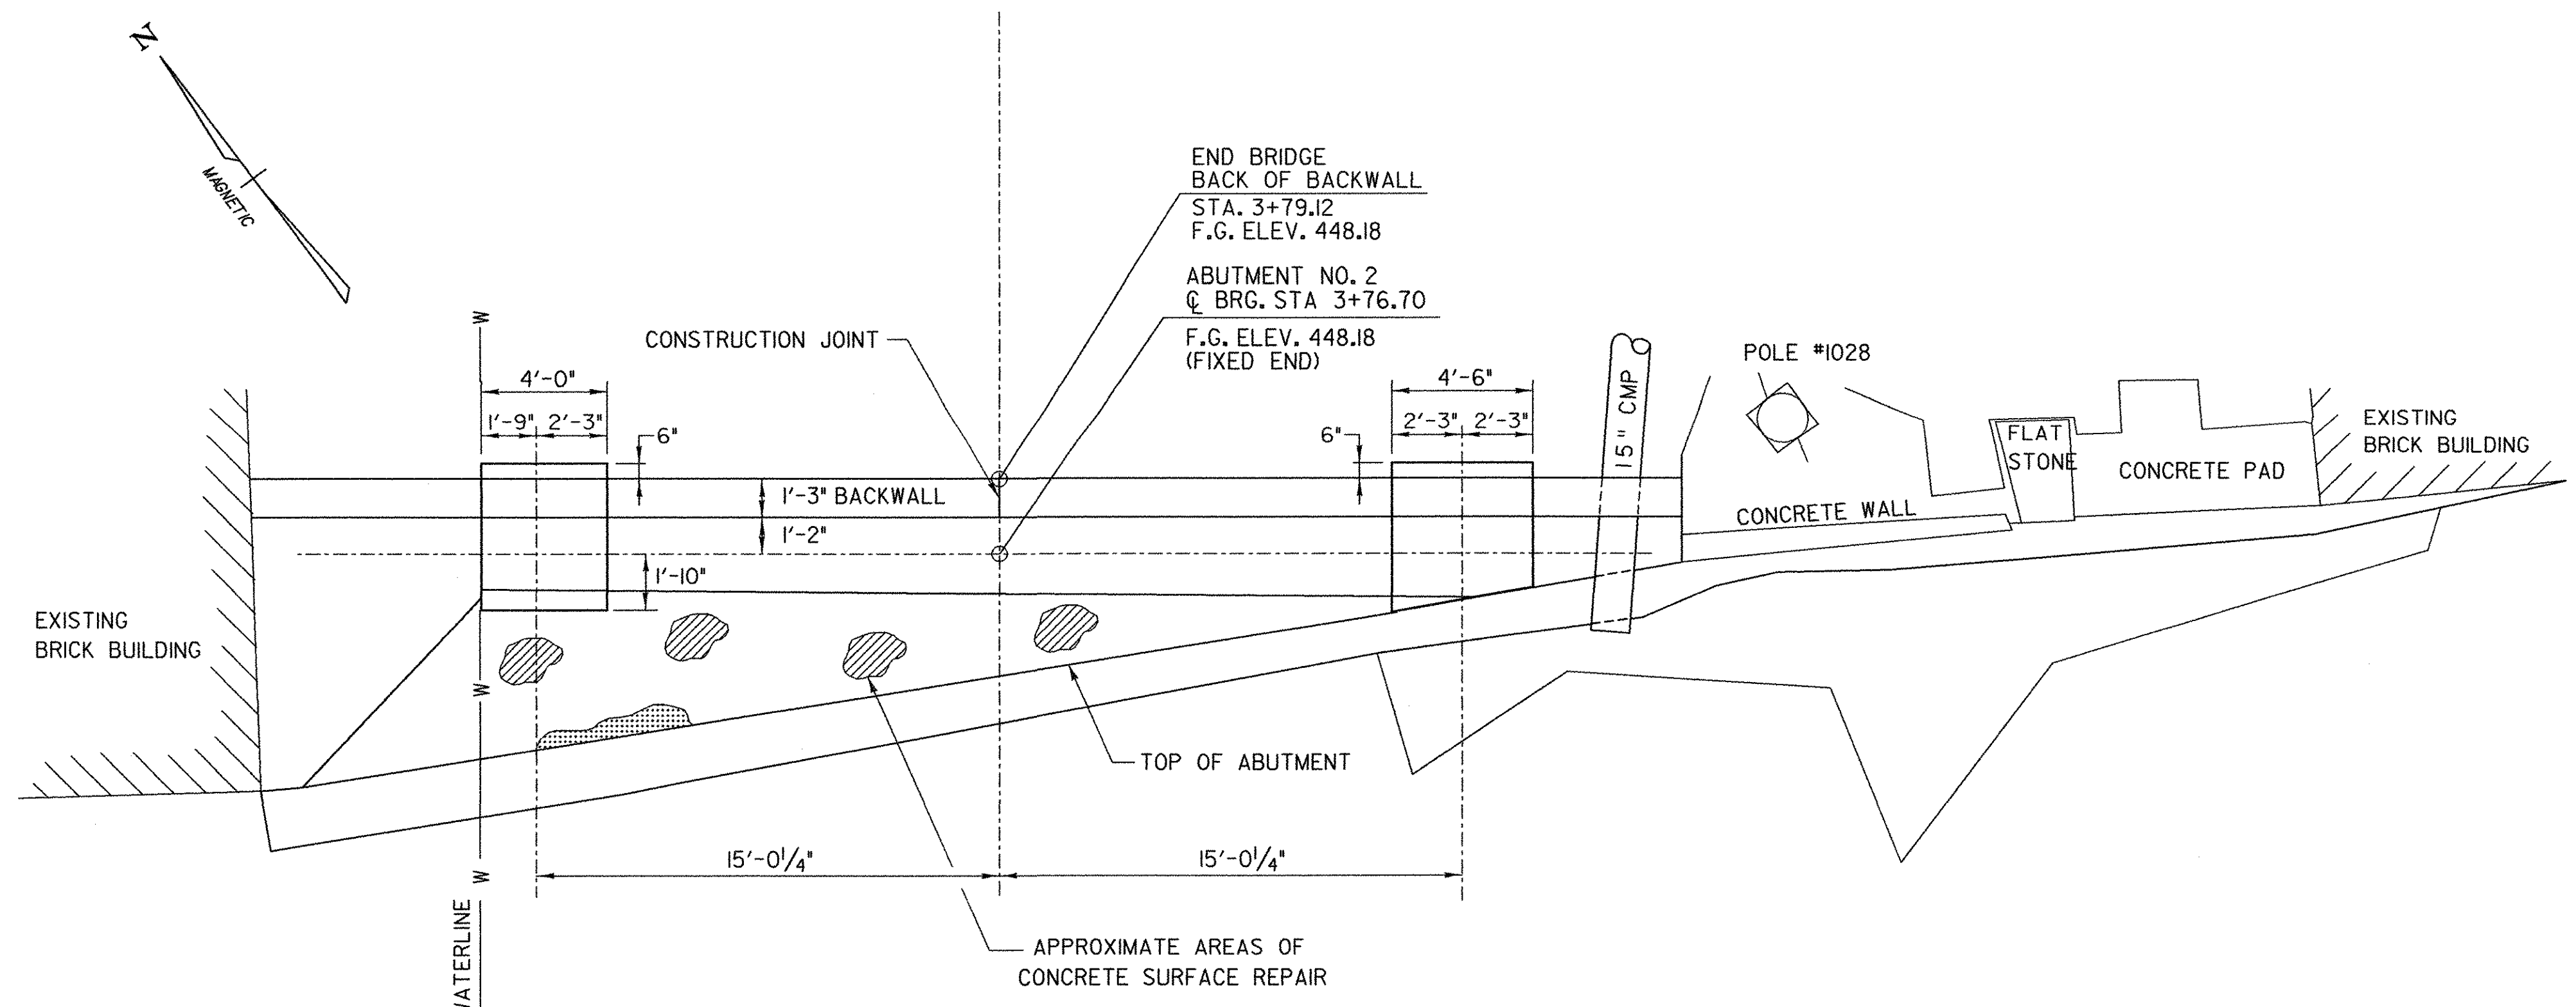

PLAN
SCALE 1/4" = 1'-0"
1 0 2 4 6

LEGEND FOR CONCRETE REPAIR

- ITEM 580.13, "REPAIR OF CONCRETE SUBSTRUCTURE SURFACE CLASS I"
- ITEM 580.14, "REPAIR OF CONCRETE SUBSTRUCTURE SURFACE CLASS II"

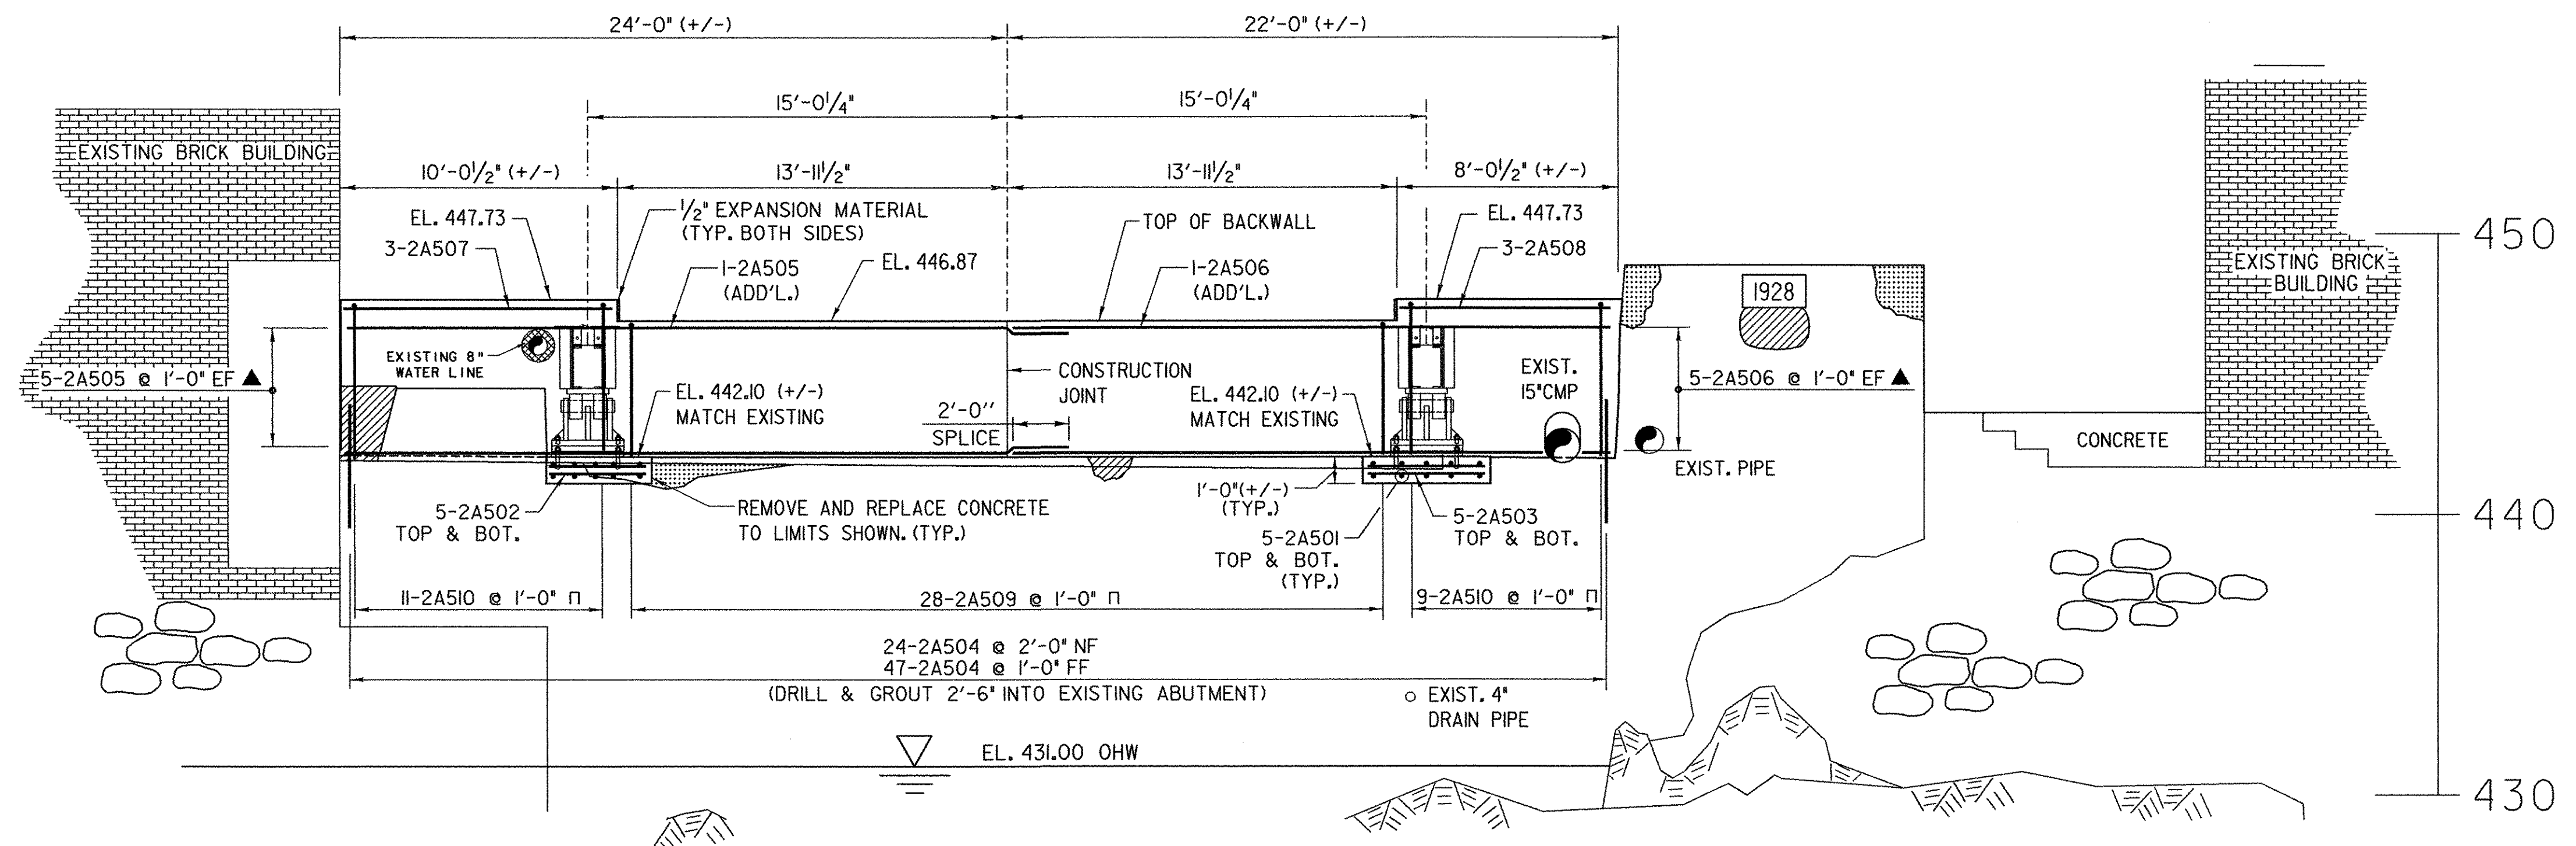

ELEVATION
SCALE 1/4" = 1'-0"
1 0 2 4 6

NOTES:


1. SEE SHEET 33 FOR ABUTMENT SECTIONS.
2. AREAS OF CONCRETE SURFACE REPAIR ON EXISTING ABUTMENTS TO BE DETERMINED IN THE FIELD BY THE ENGINEER.

NOTE:



- NF = NEAR FACE
- FF = FAR FACE
- EF = EACH FACE
- ▲ = CUT TO FIT IN FIELD





PROJECT NAME:	RICHFORD	FILE NAME:	...Design\rich-abut2.dgn	PLOT DATE:	12/18/2007
PROJECT NUMBER:	BHF 0302 (3) S	PROJECT LEADER:	MJC	DRAWN BY:	AET
		DESIGNED BY:	SEB	CHECKED BY:	MJC
ABUTMENT NO. 2 PLAN & ELEVATION				SHEET 32 OF 41	

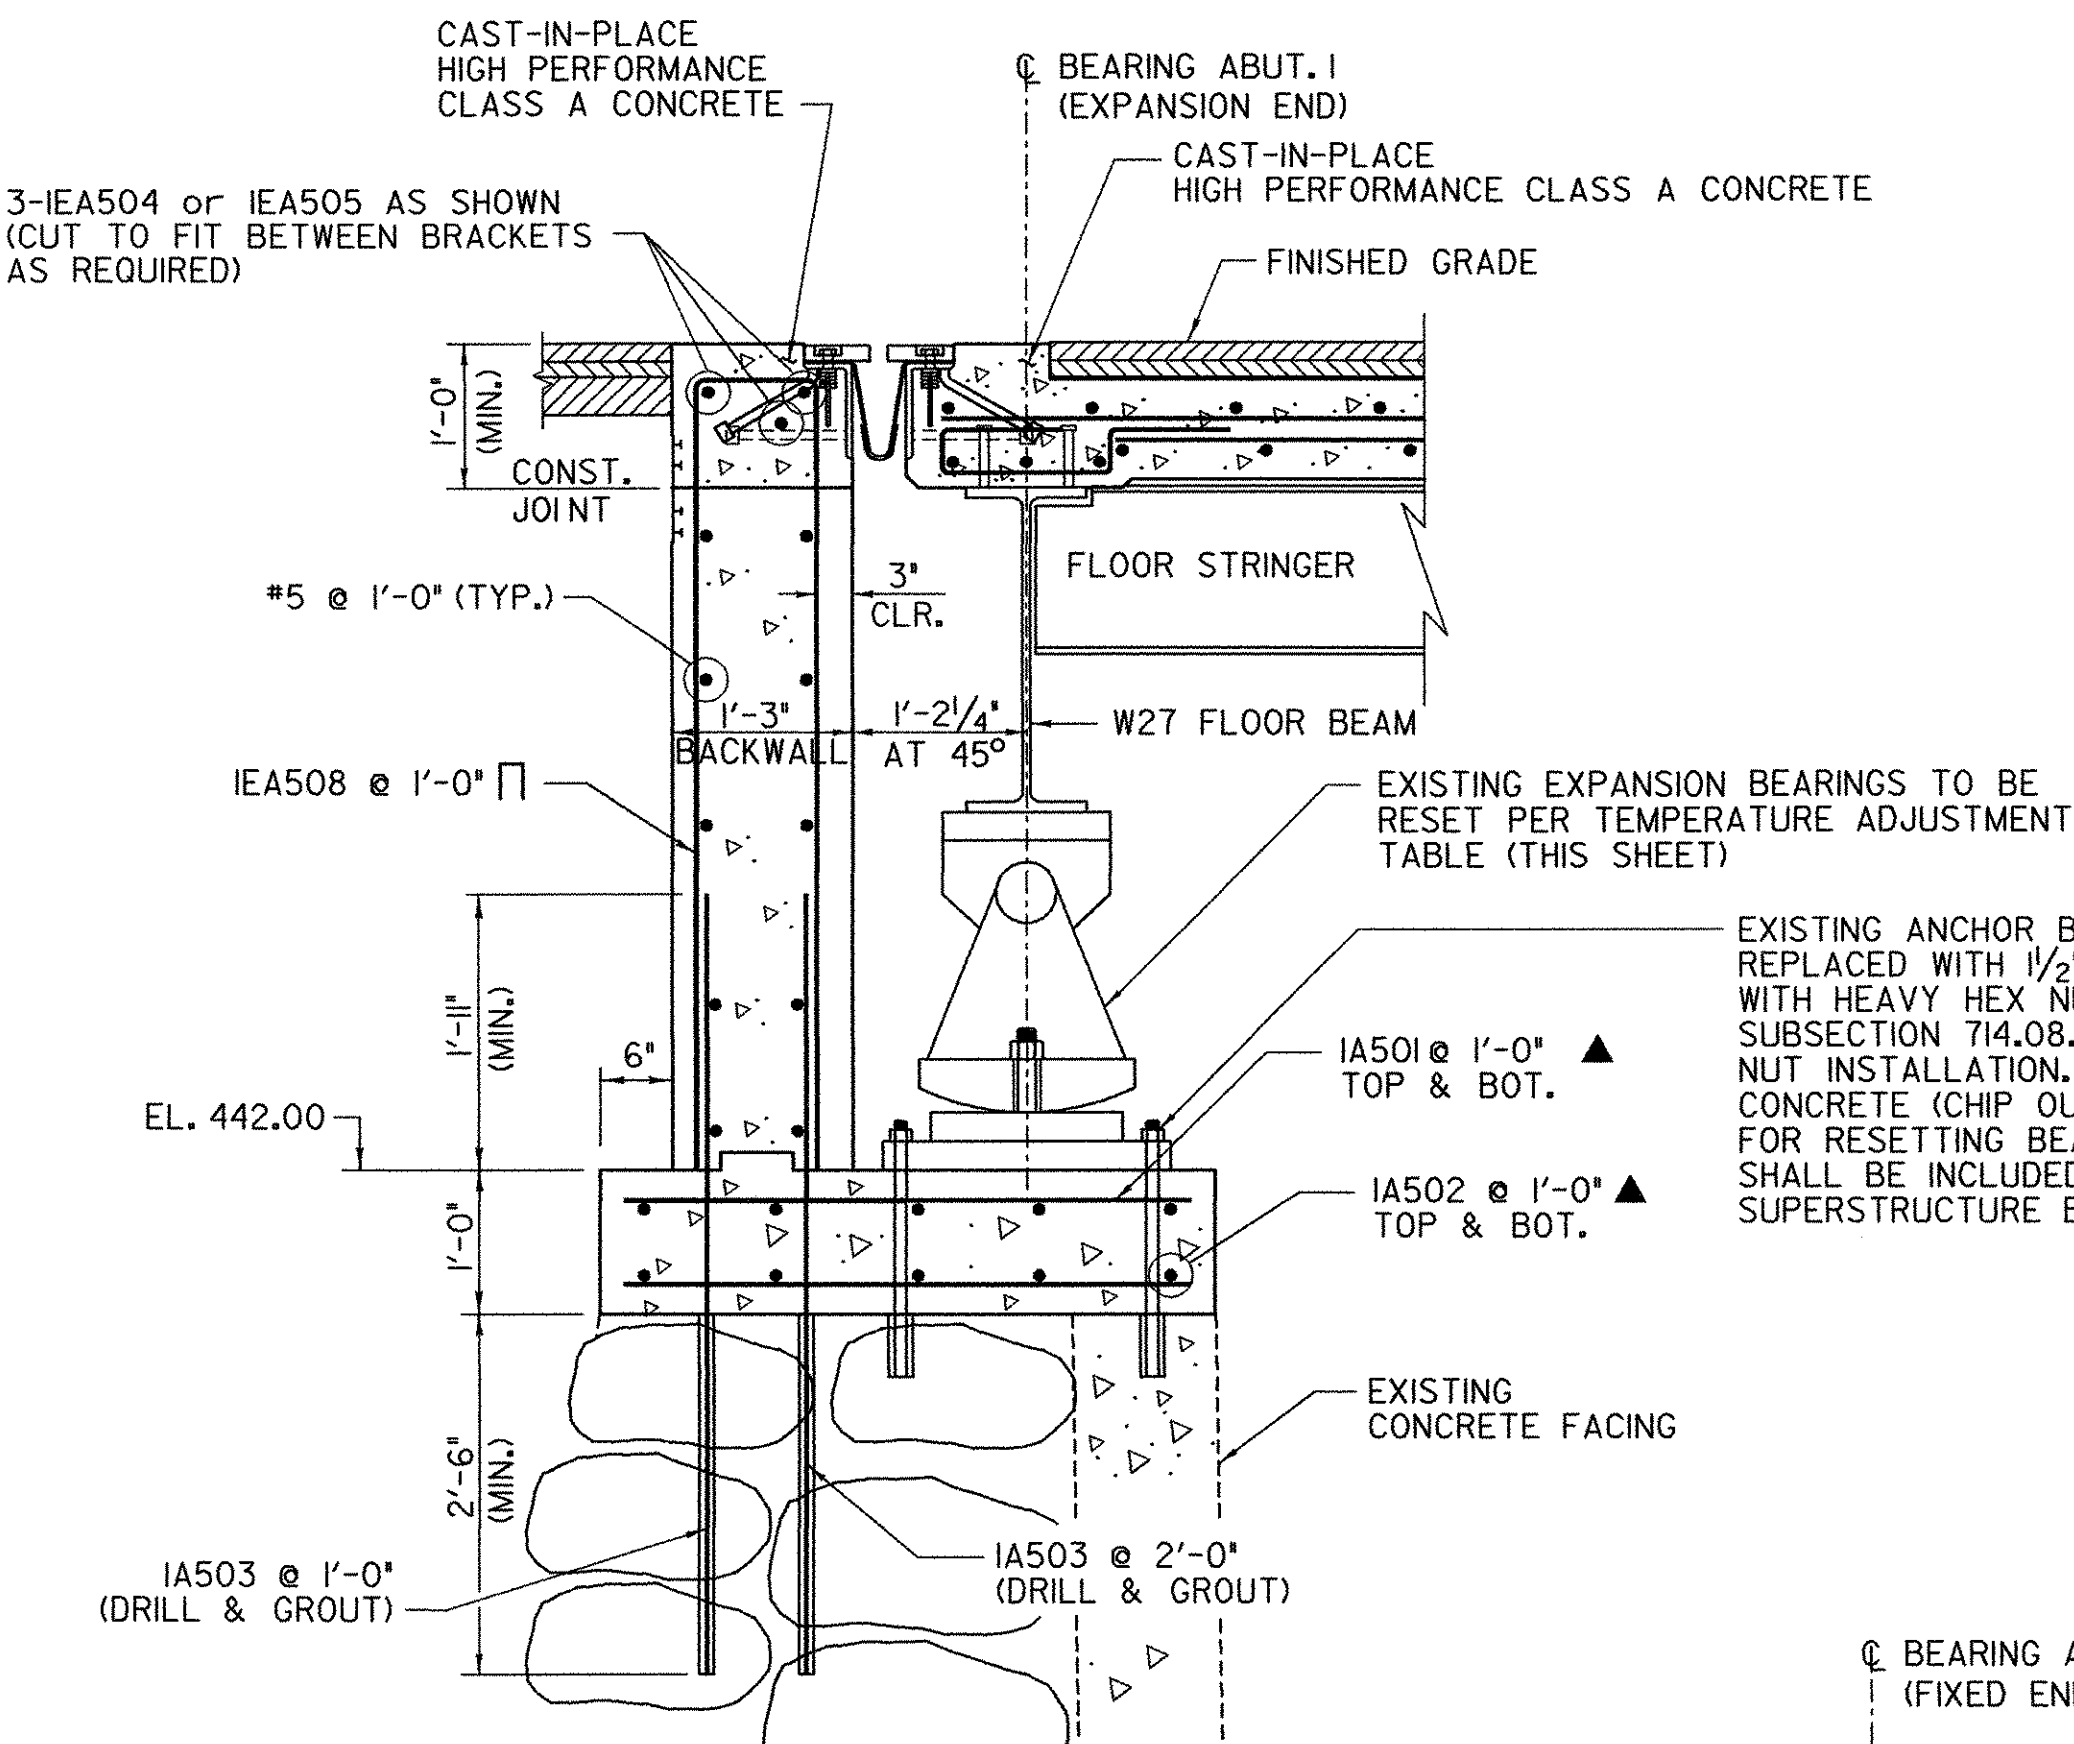


ABUTMENT NO.1 SECTION

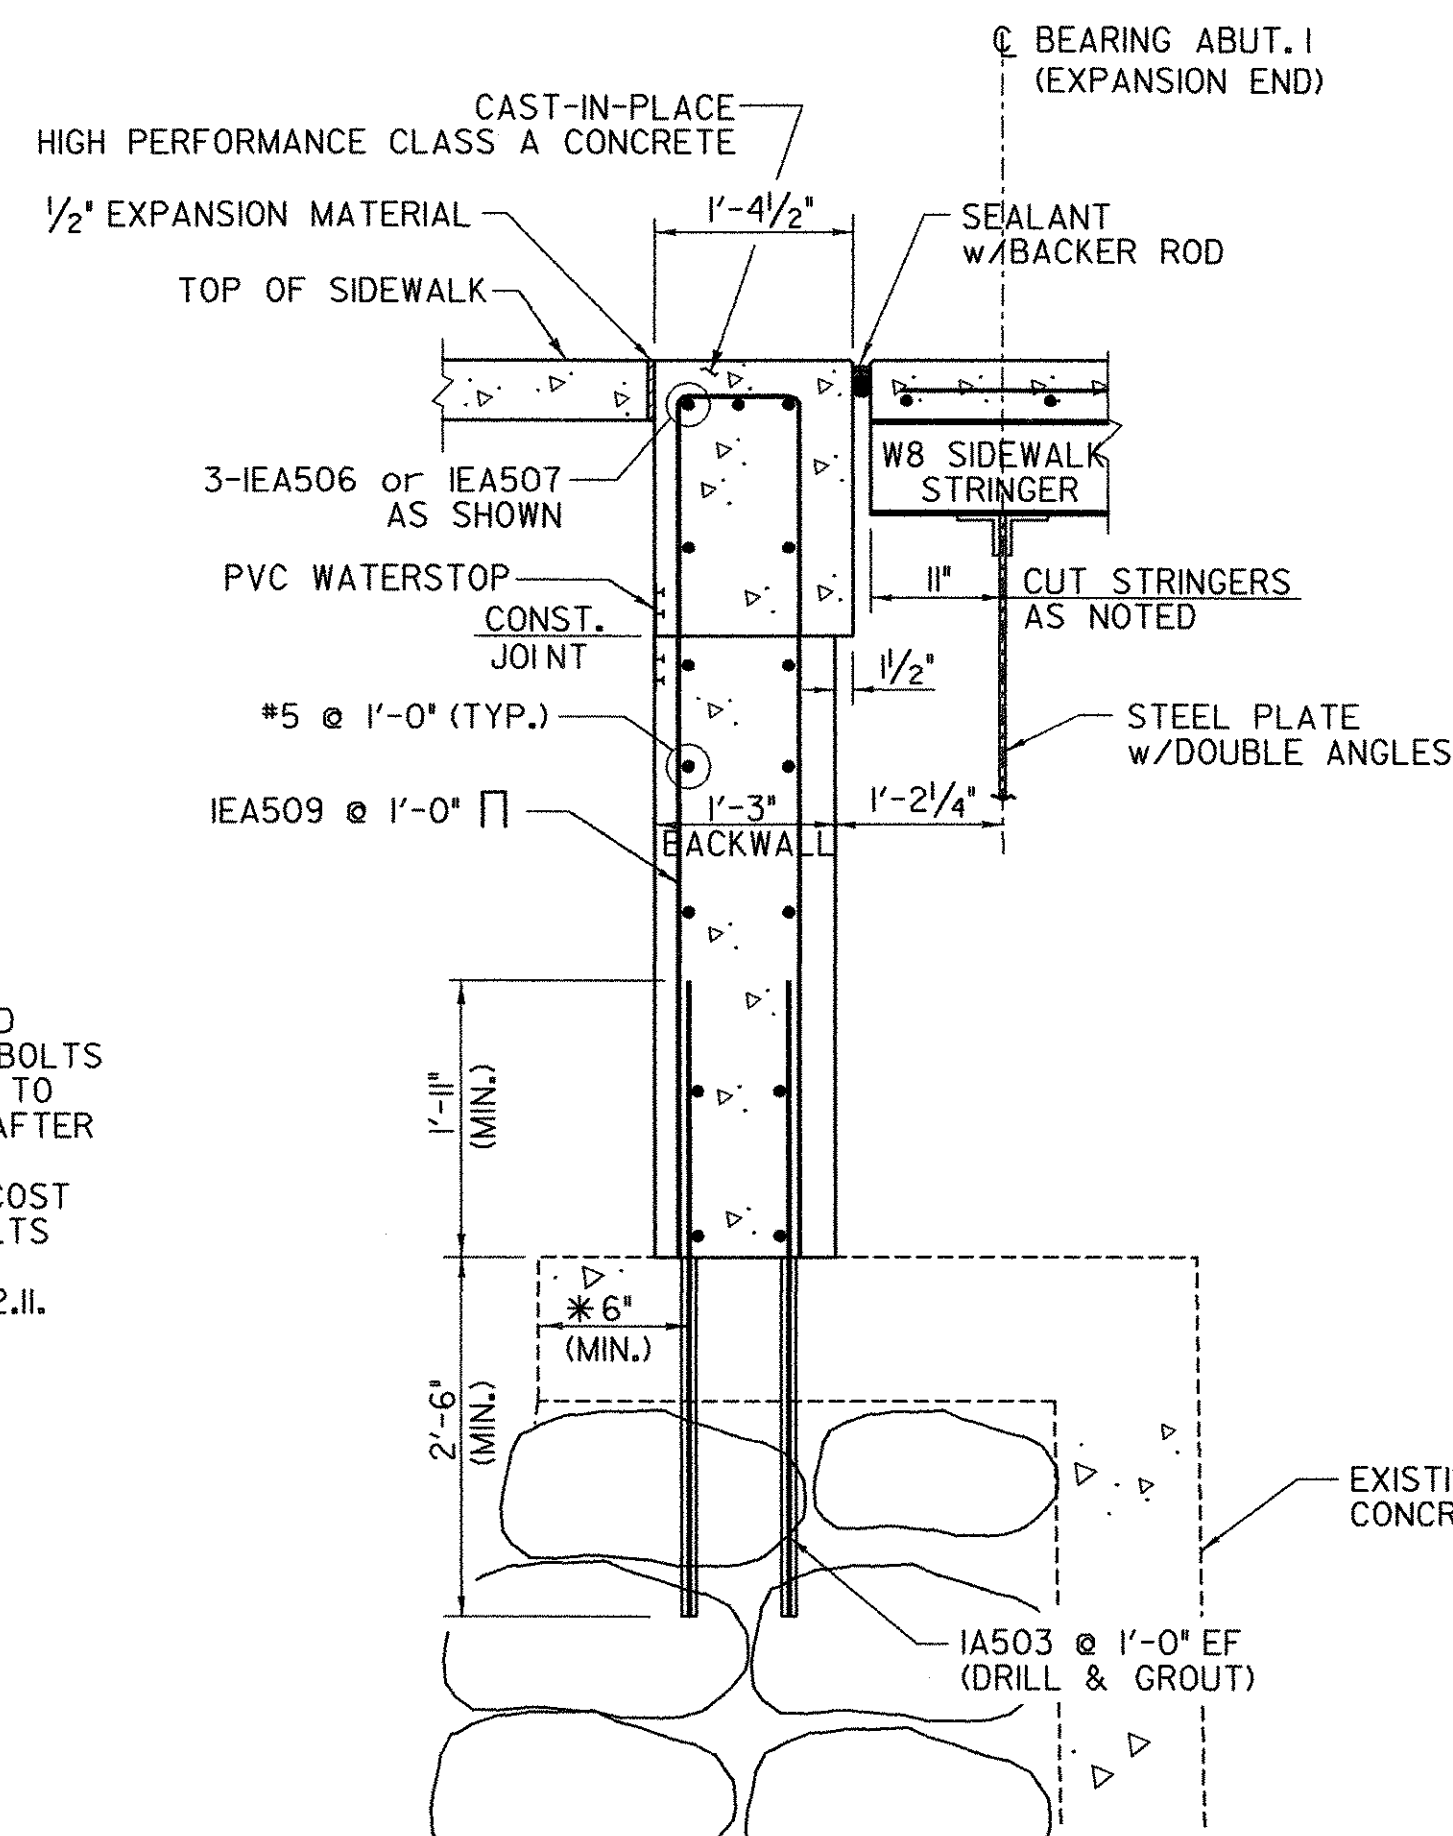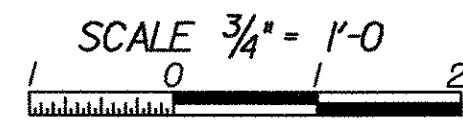

SECTION THRU SIDEWALK AT ABUTMENT NO. 1

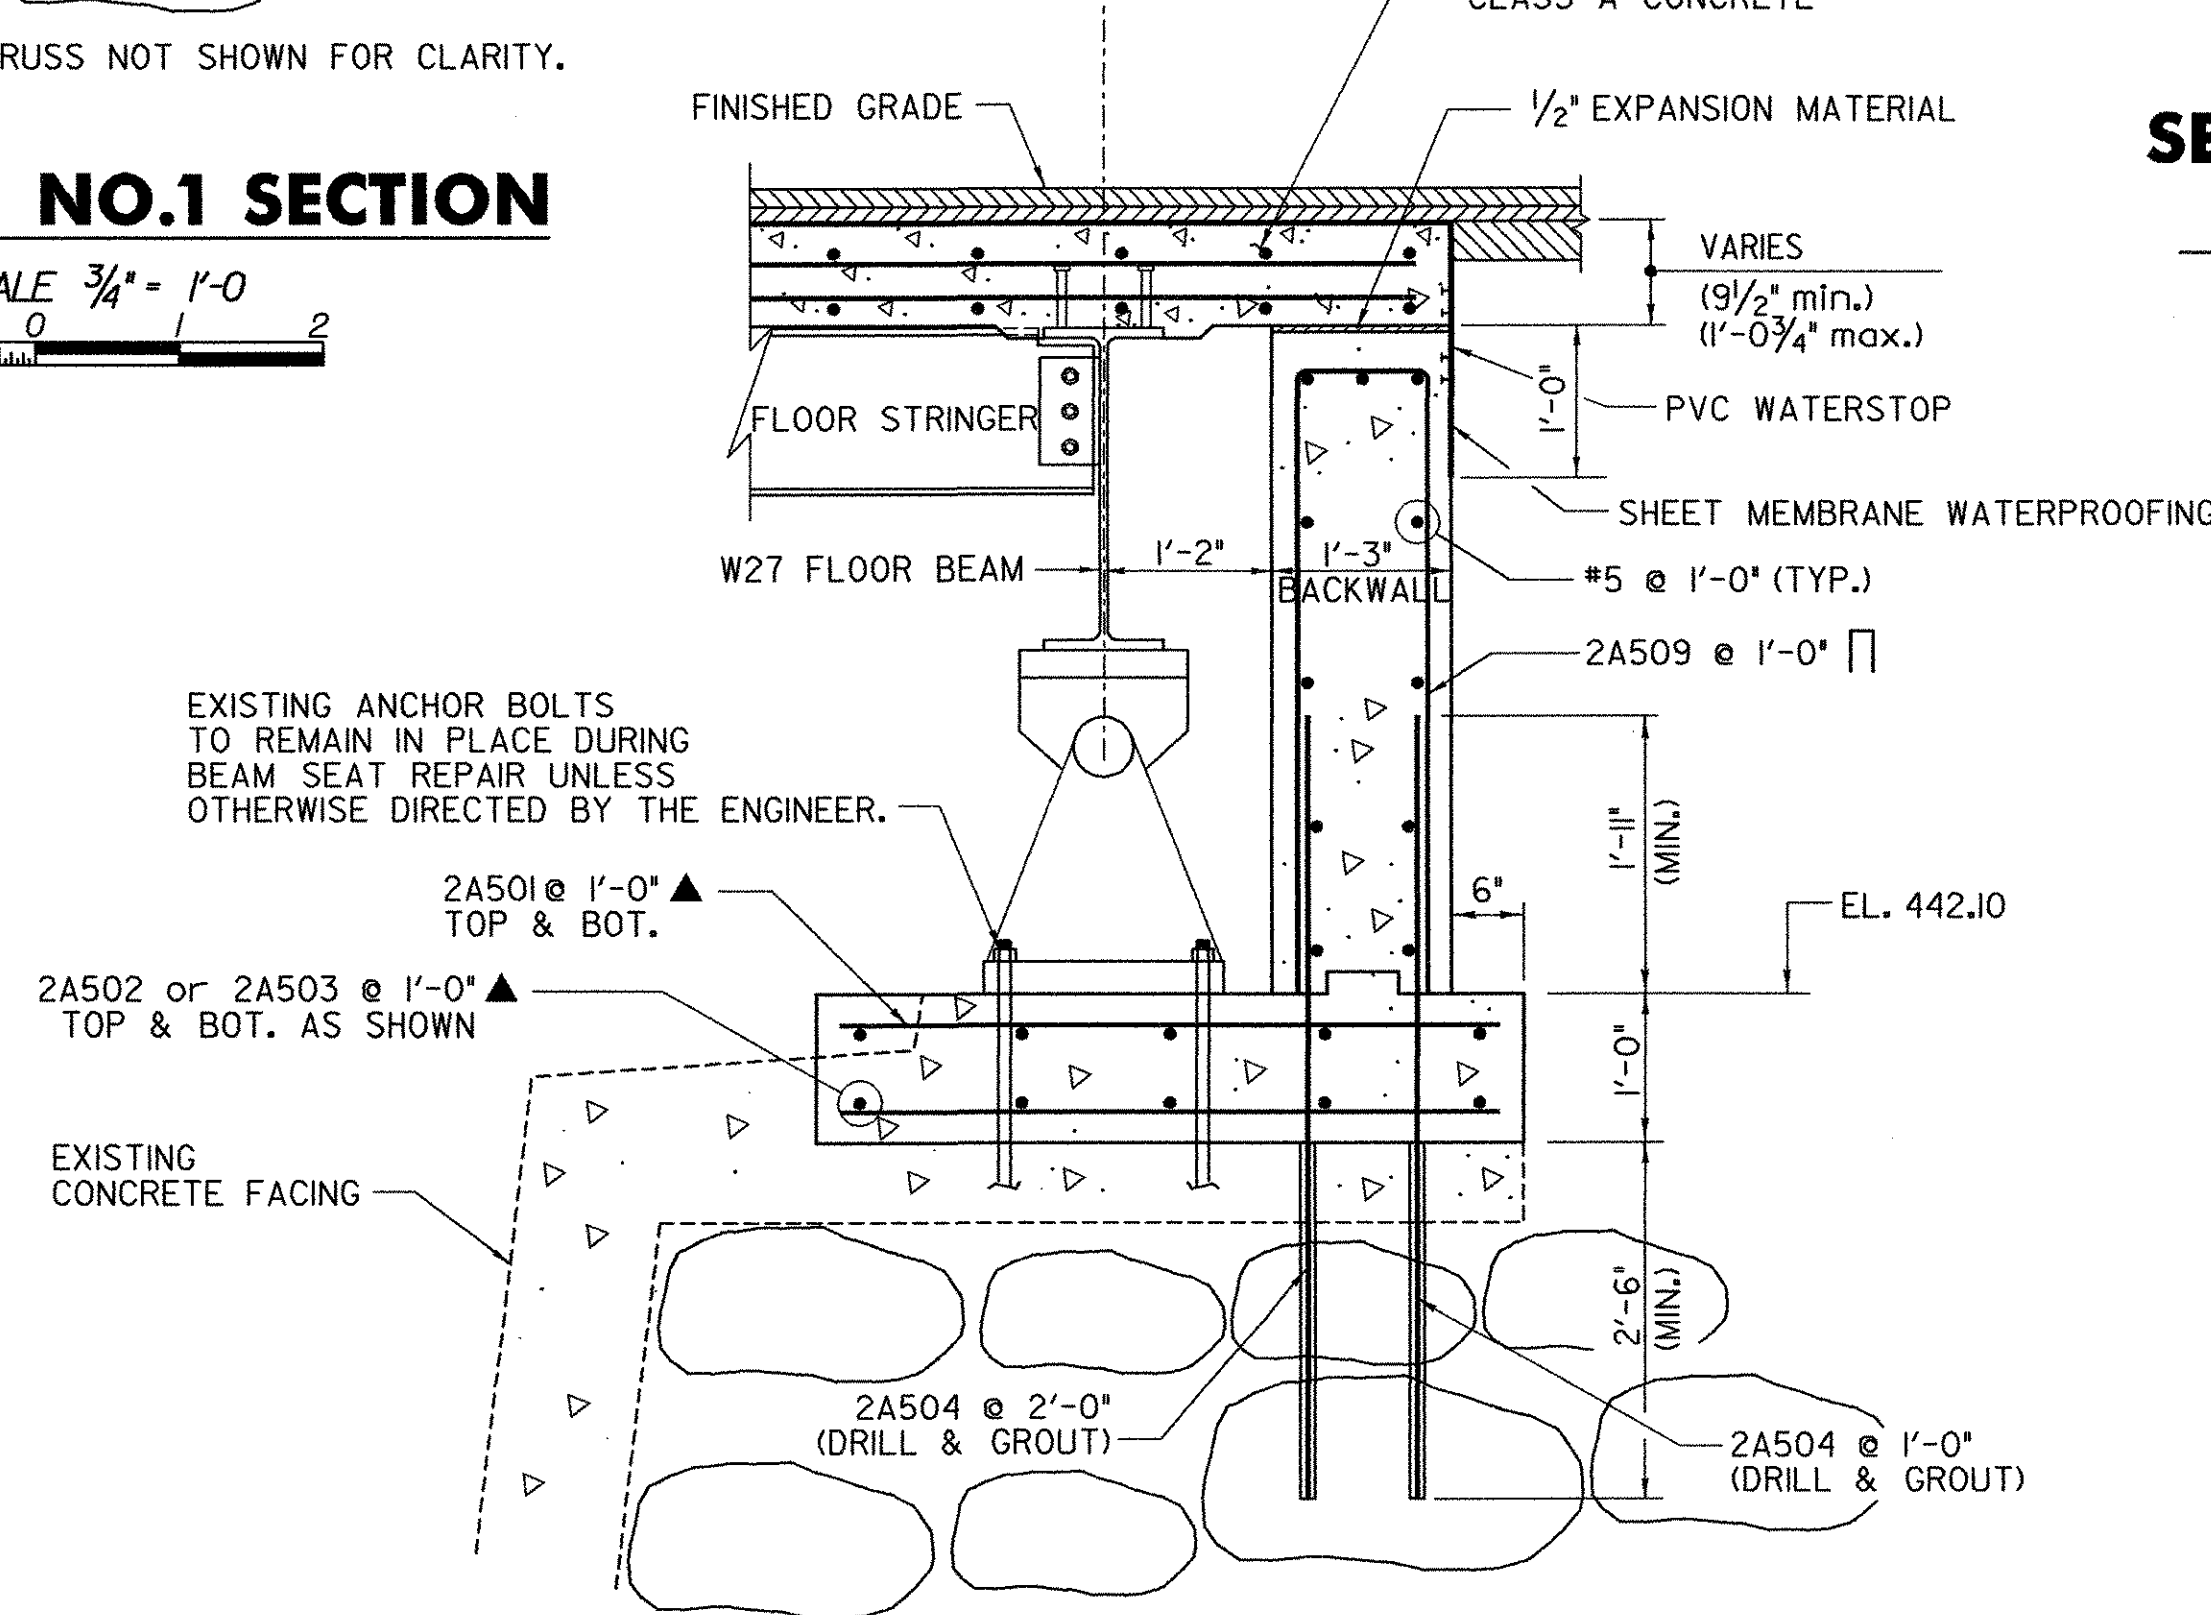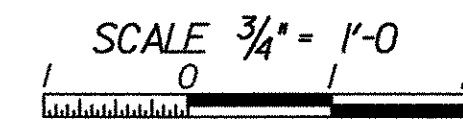


ABUTMENT NO.2 SECTION

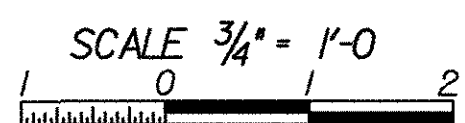

* - CONTRACTOR TO VERIFY THAT A MINIMUM EDGE DISTANCE OF 6" IS PROVIDED.

NOTE:

- NF - NEAR FACE
- FF - FAR FACE
- EF - EACH FACE
- ▲ - CUT TO FIT IN FIELD
- 3" CLR. UNLESS OTHERWISE SPECIFIED ON THE PLANS.

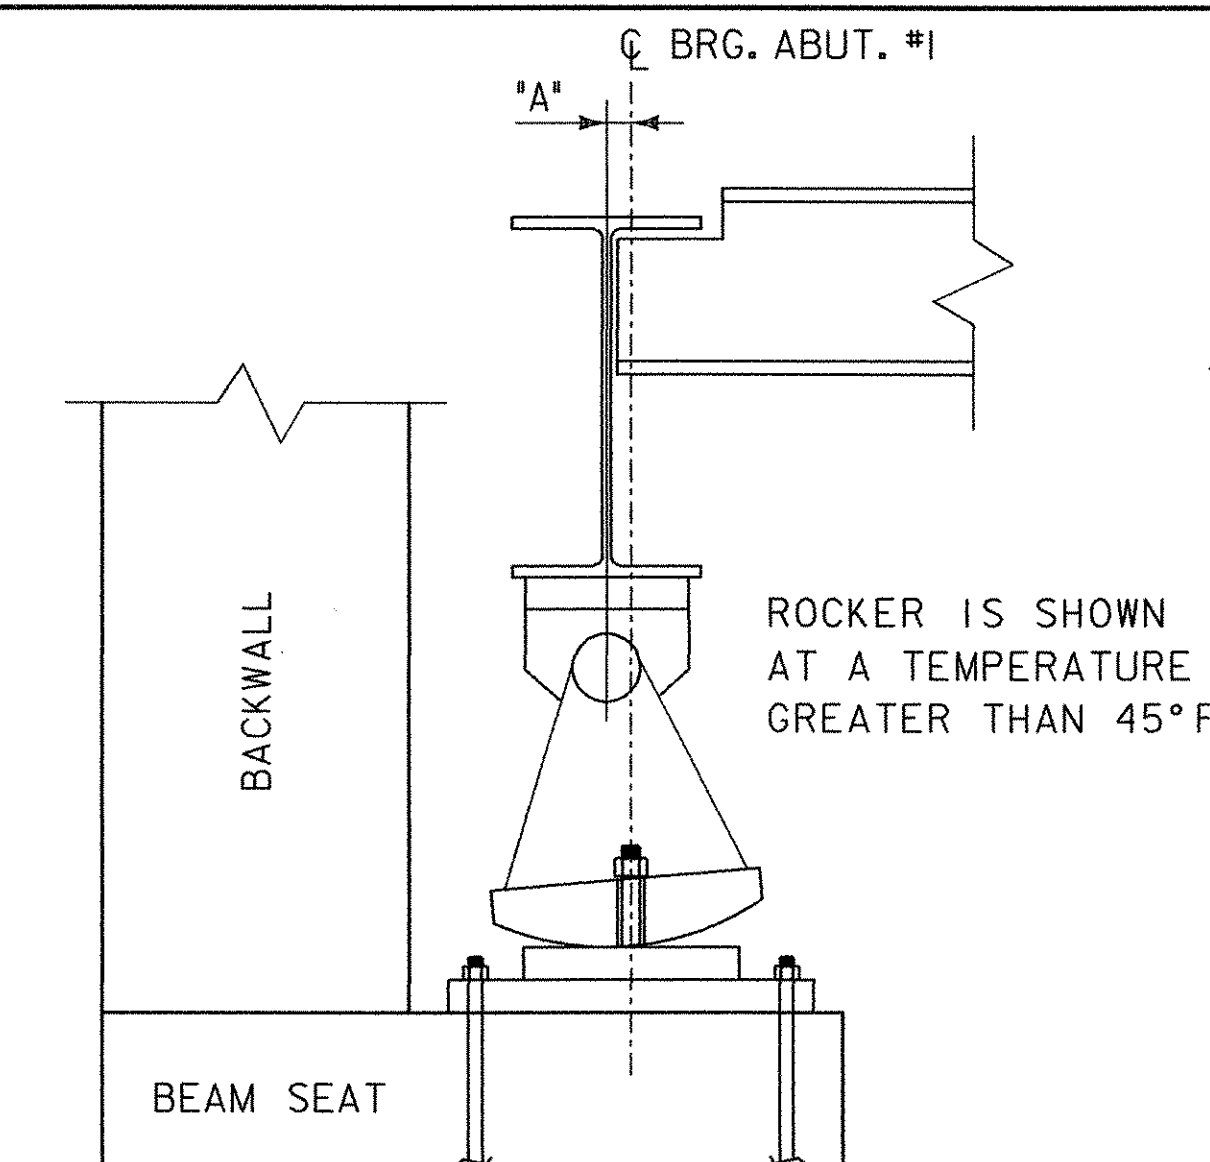


EXISTING ROCKER ABUT. #1


NOT TO SCALE

TEMPERATURE ADJUSTMENT TABLE FOR ROCKER


ABUTMENT NO. 1	
TEMP.	DIM. "A"
0°F	-7/16"
15°F	-5/16"
30°F	-1/8"
45°F	0"
60°F	1/8"
75°F	5/16"
90°F	7/16"
105°F	3/4"

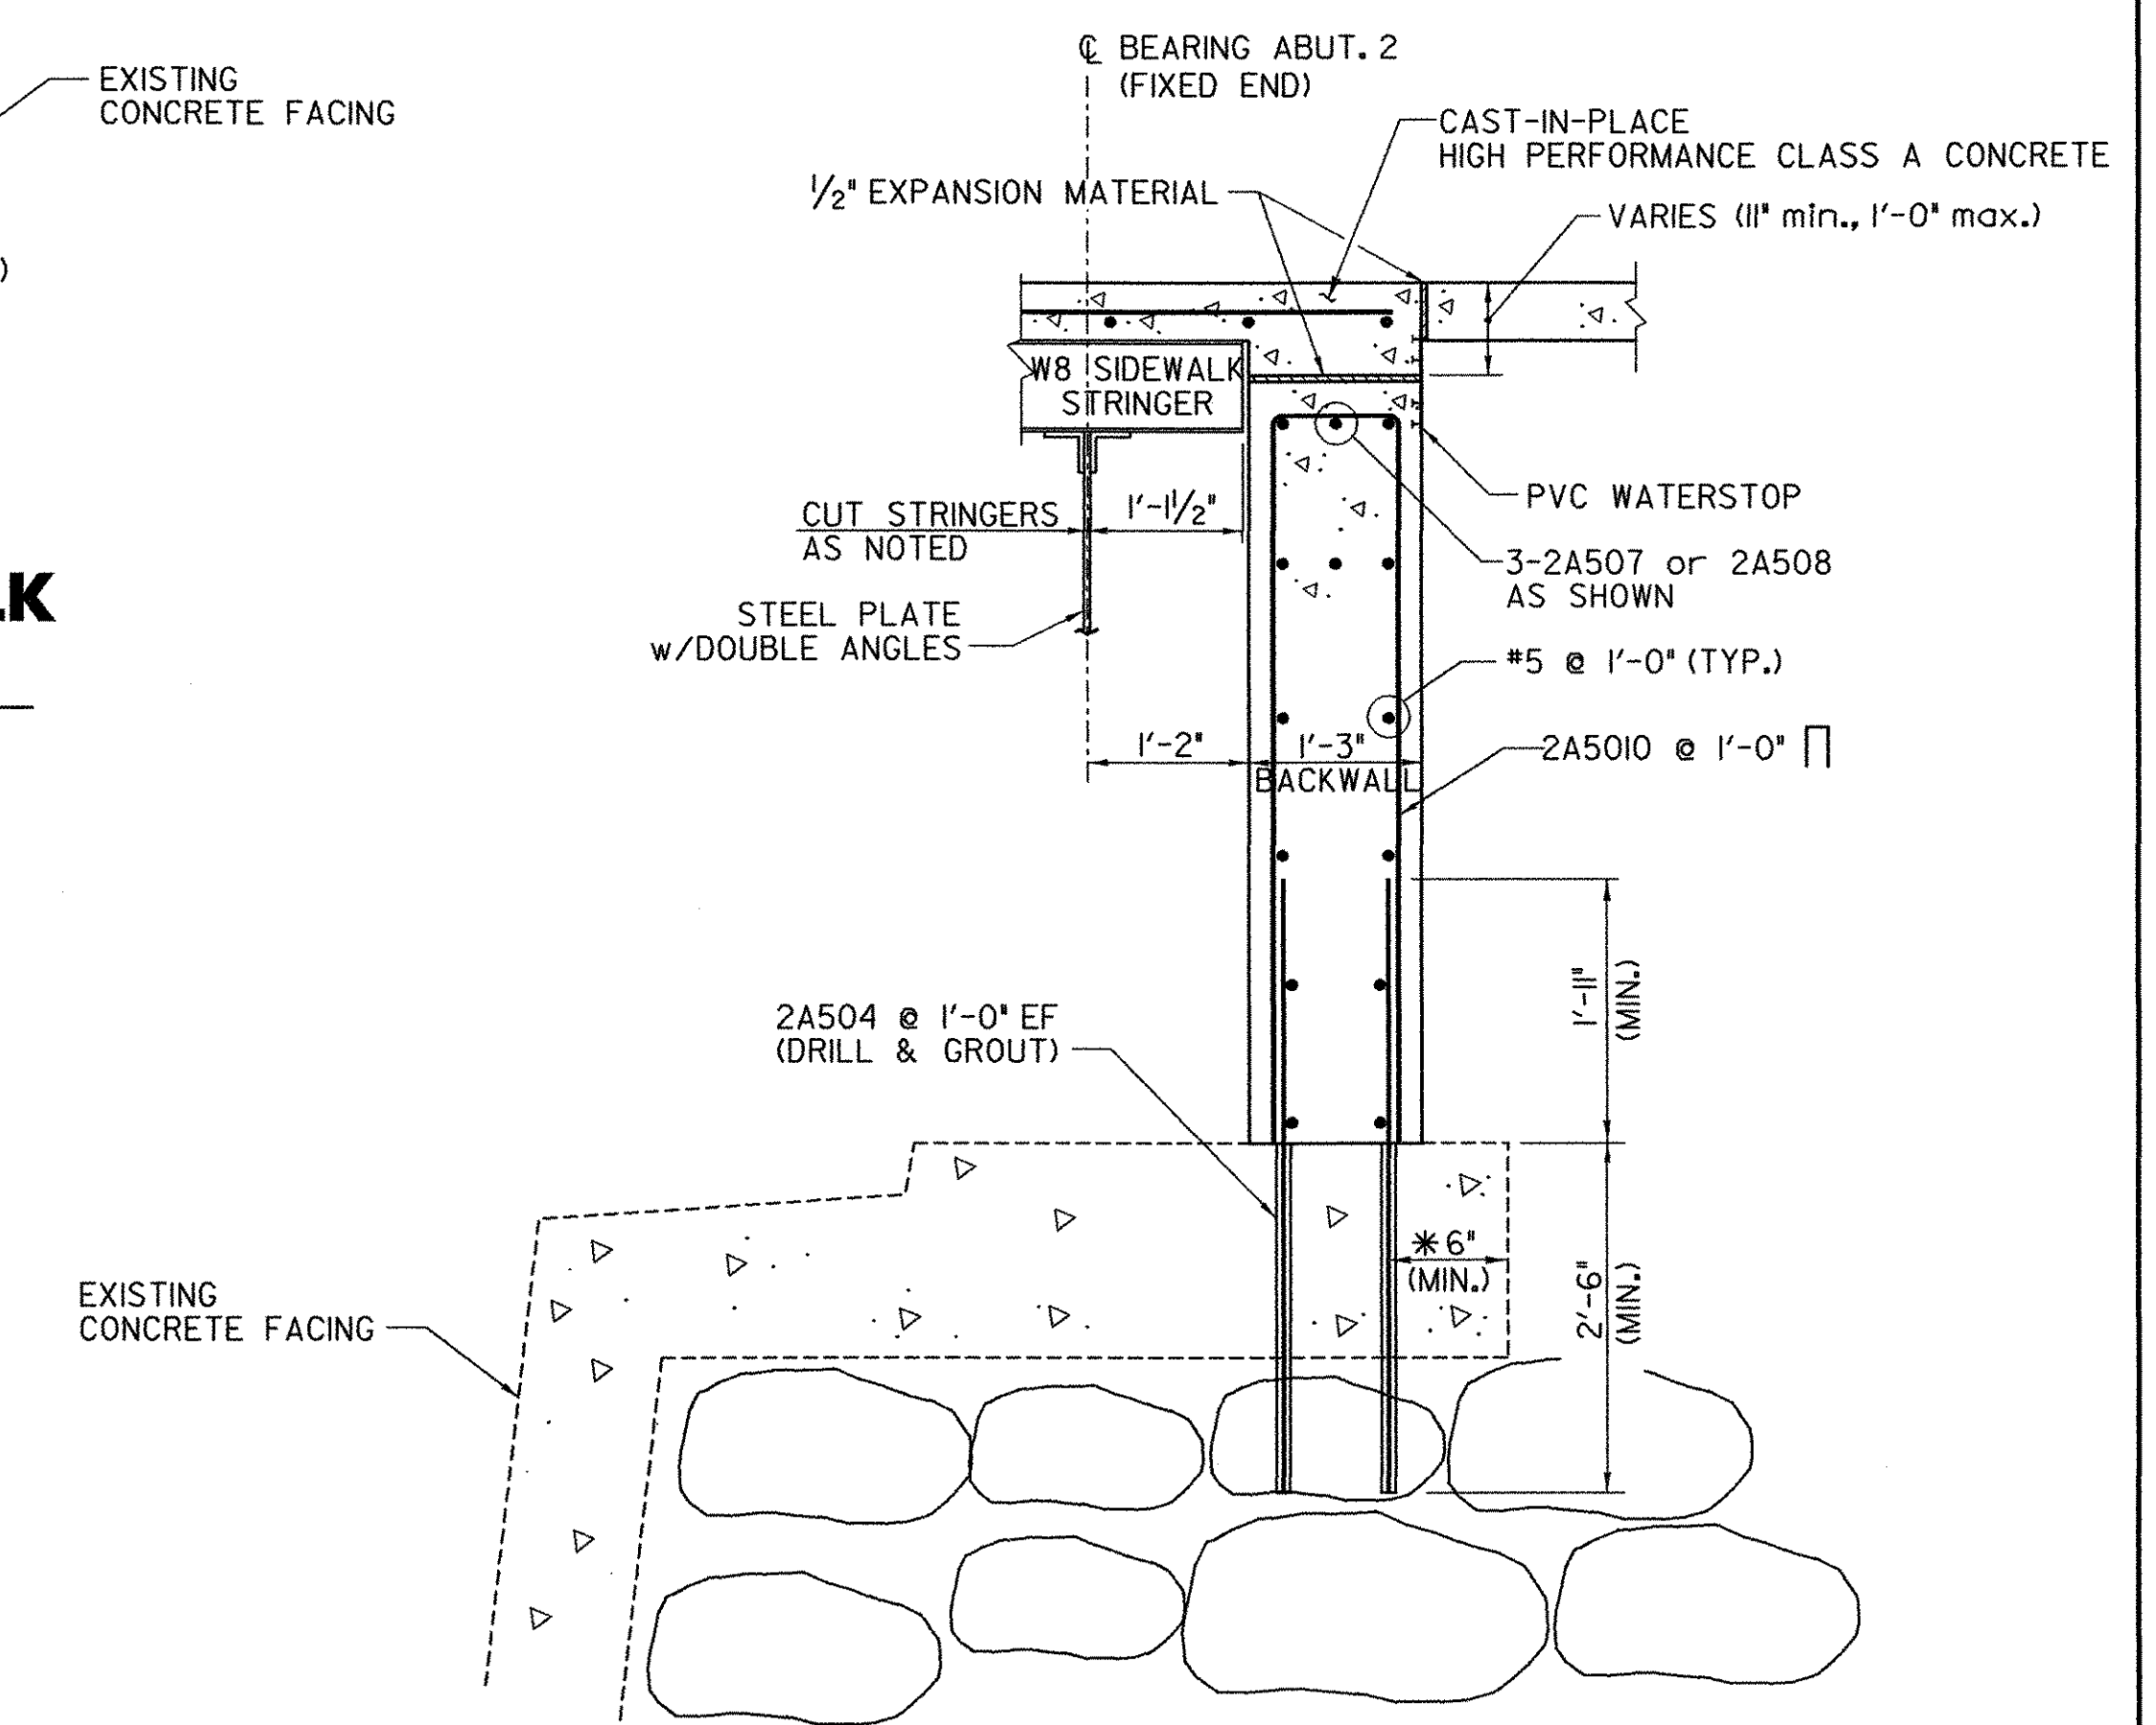

SECTION THRU SIDEWALK AT ABUTMENT NO. 2

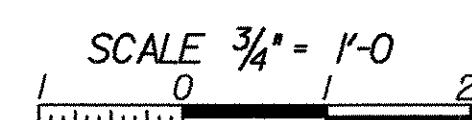


PROJECT NAME: RICHFORD
 PROJECT NUMBER: BHF 0302 (3) S
 FILE NAME: ...Design\rich-abutsects.dgn PLOT DATE: 12/18/2007
 PROJECT LEADER: MJC DRAWN BY: AET
 DESIGNED BY: SEB CHECKED BY: MJC
ABUTMENT SECTIONS SHEET 33 OF 41

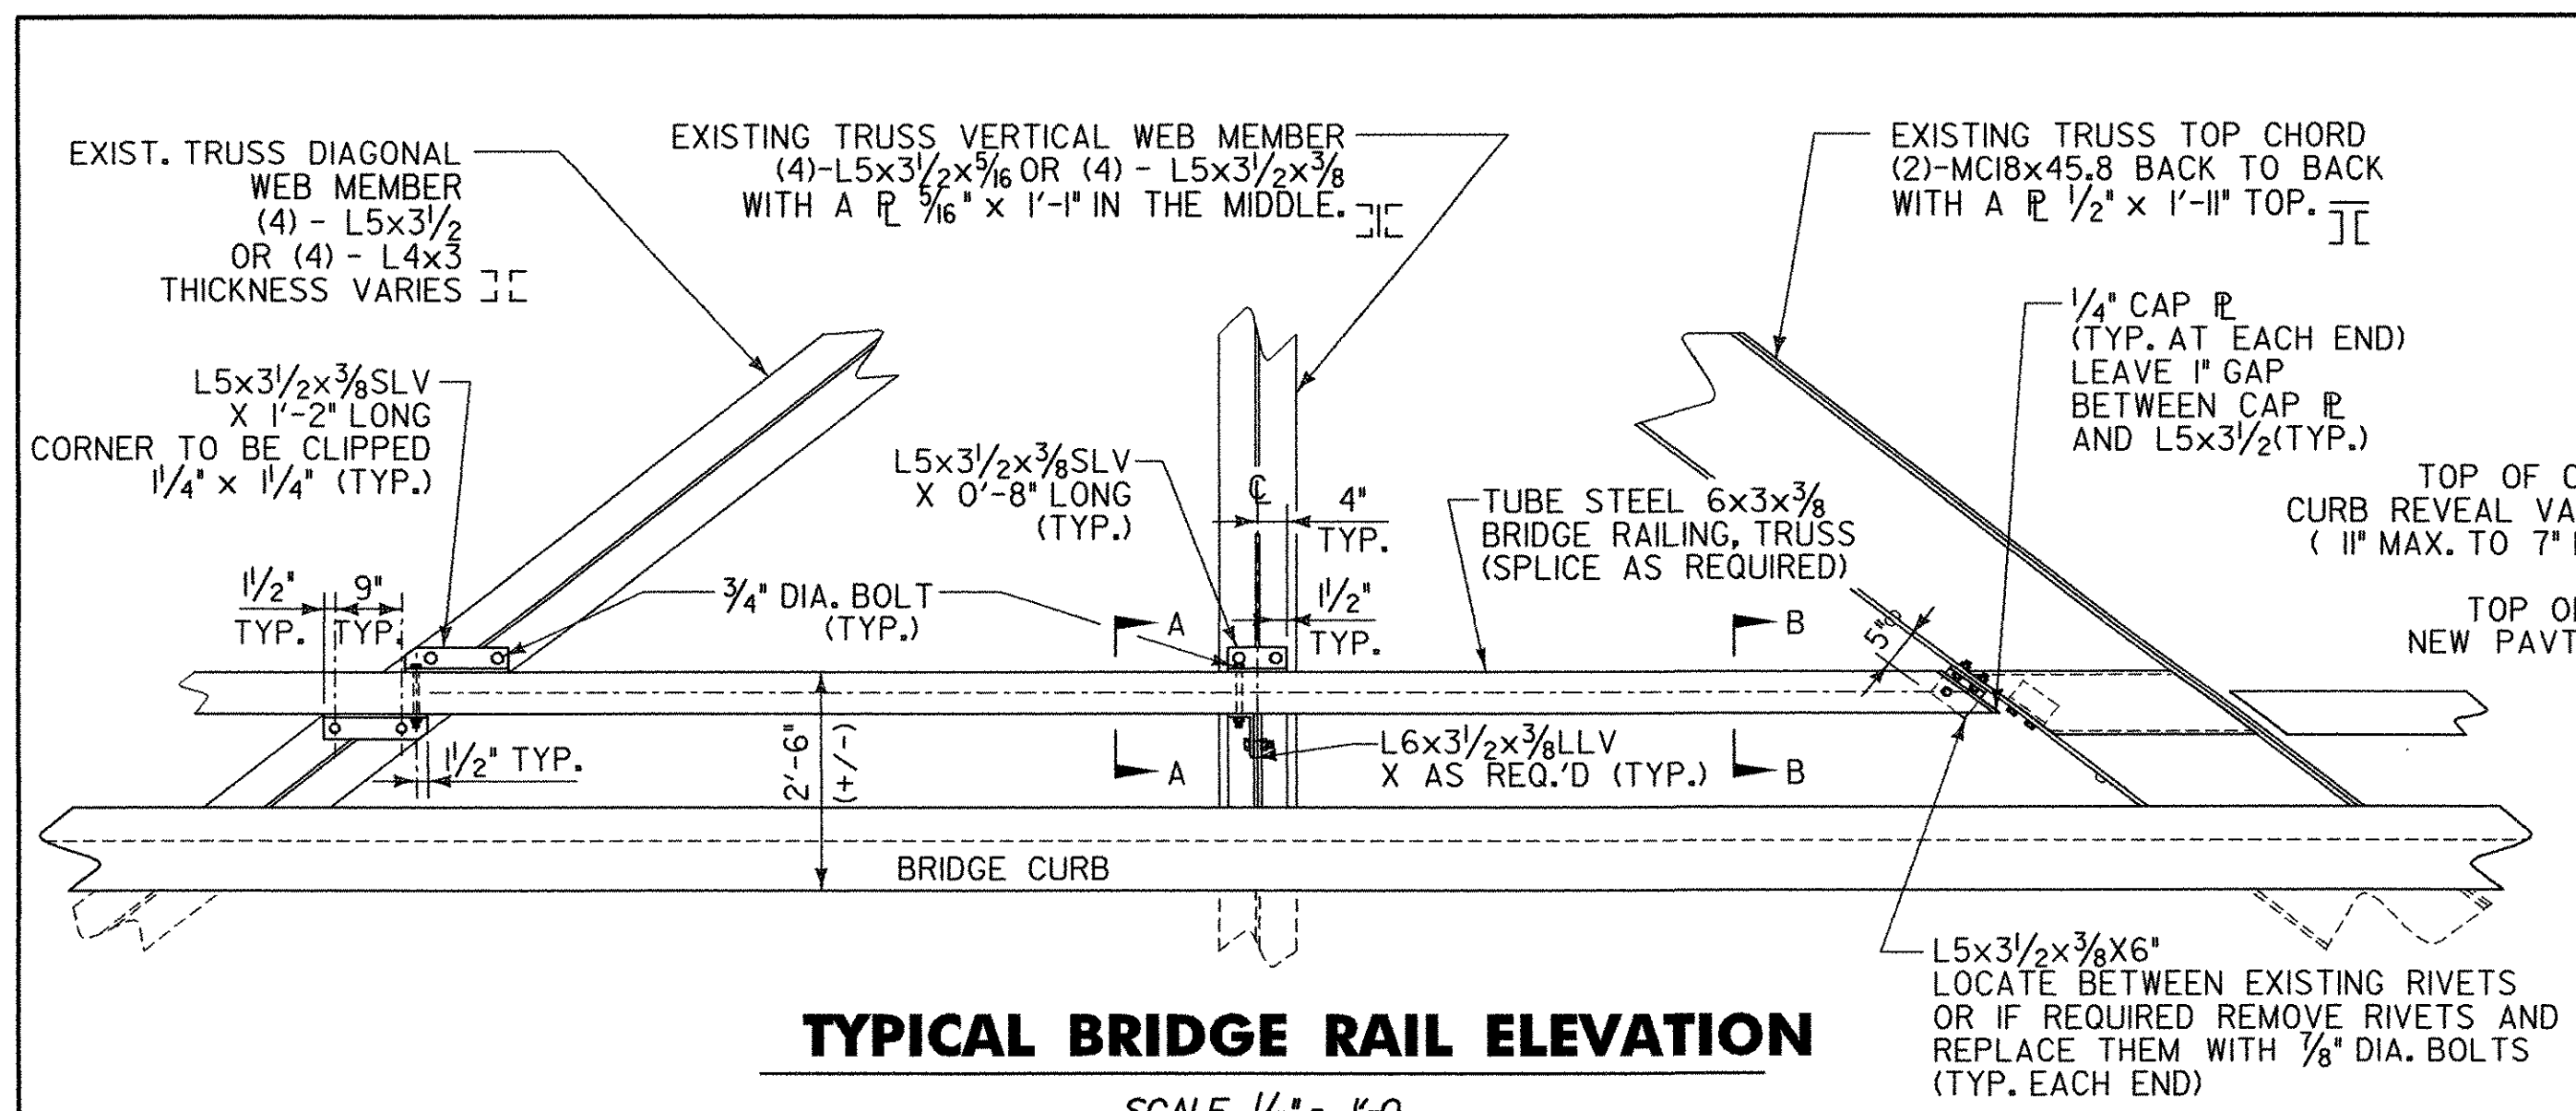


TYPICAL BRIDGE RAIL ELEVATION

SCALE 1/2" = 1'-0"

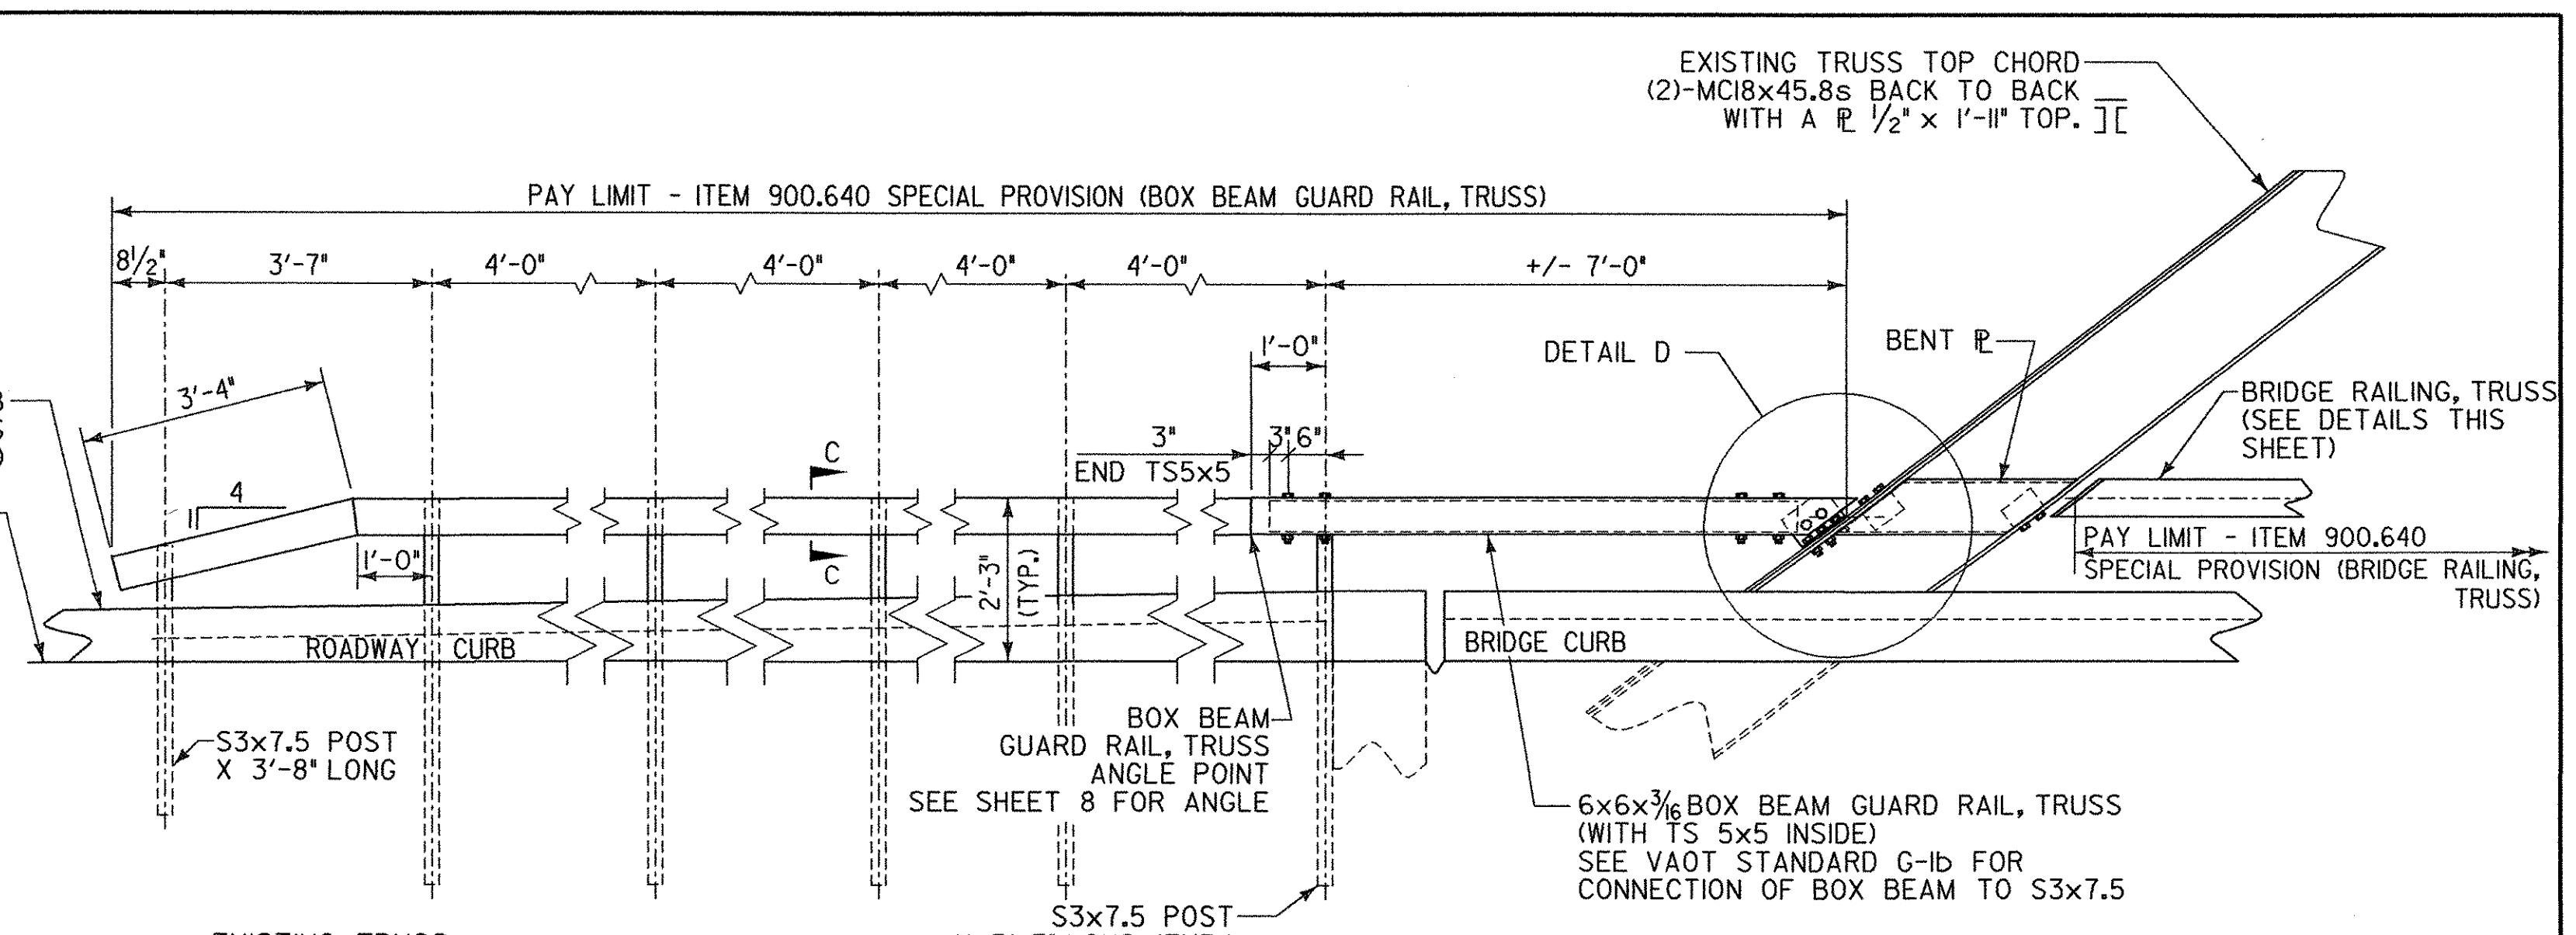


GUARD RAIL APPROACH ELEVATION AT SE & SW CORNER

SCALE 1/2" = 1'-0"

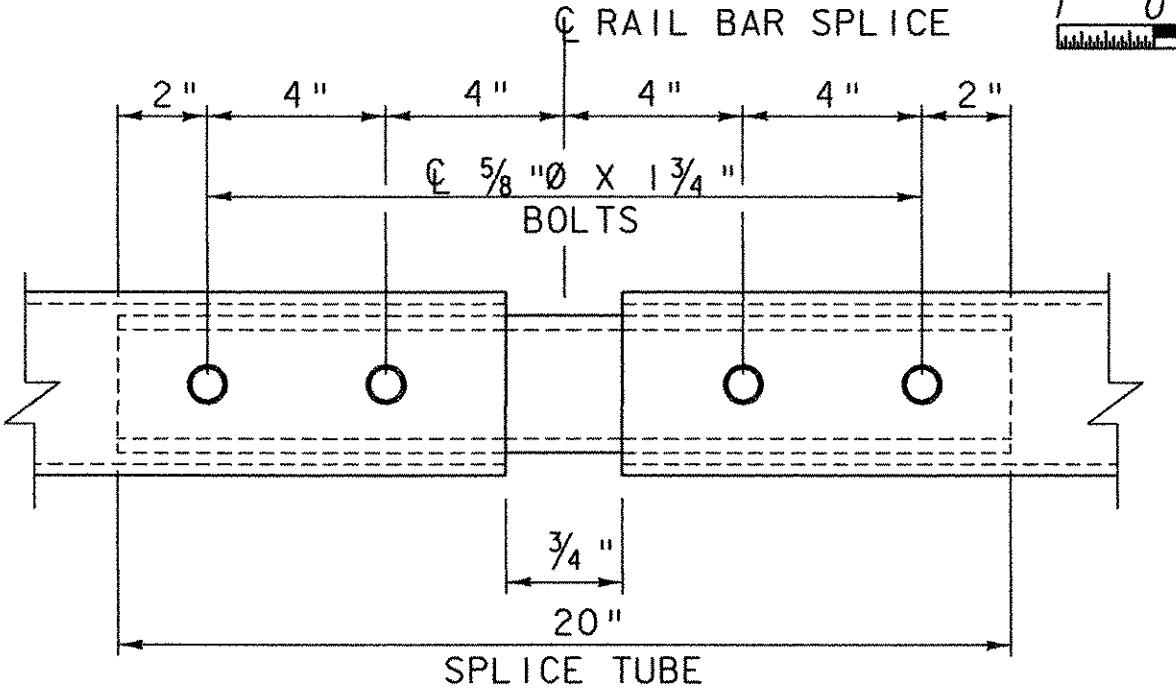


BRIDGE RAIL BAR SPLICE DETAIL

[BOTTOM VIEW] NOT TO SCALE

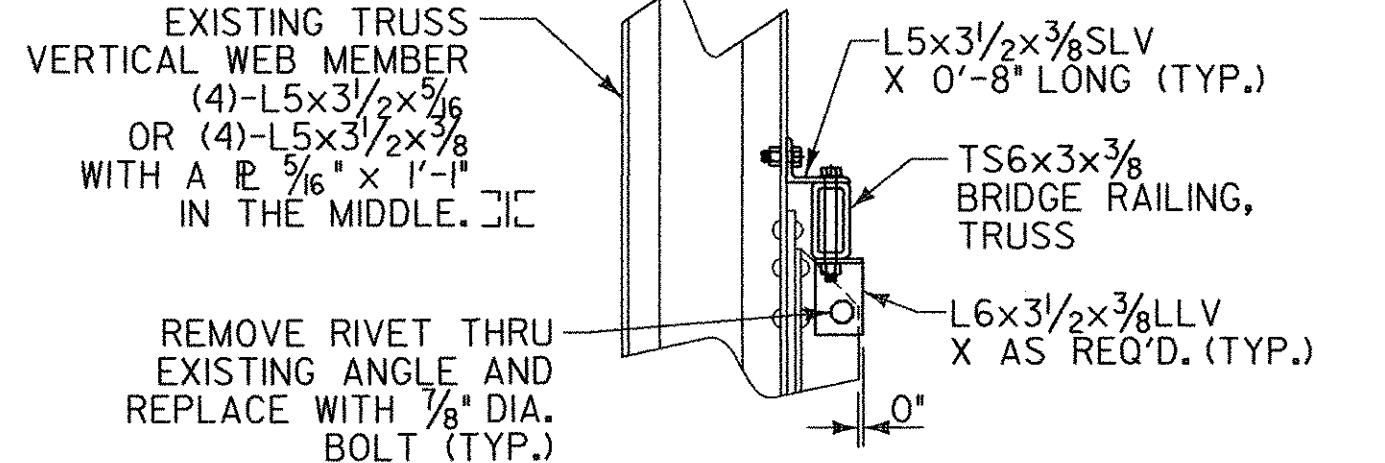


SECTION A-A

SCALE 3/4" = 1'-0"

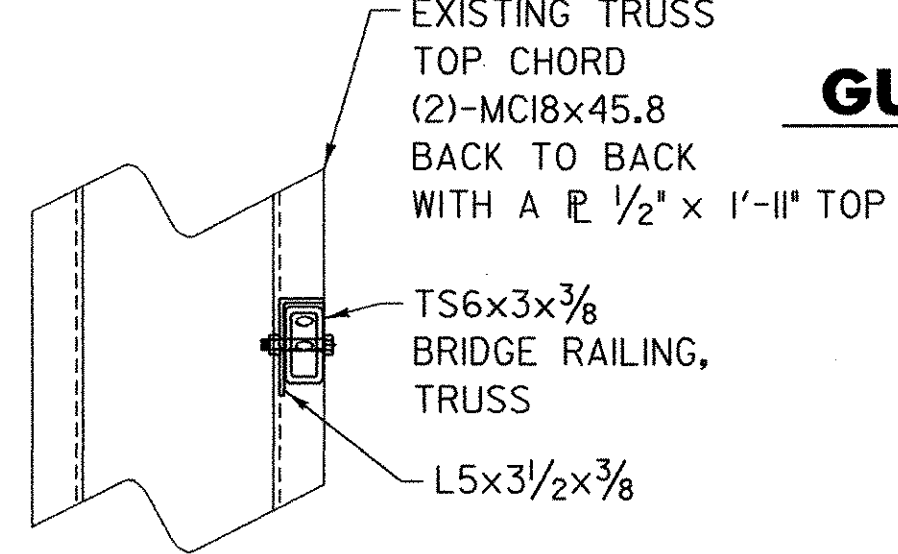


SECTION B-B

SCALE 3/4" = 1'-0"

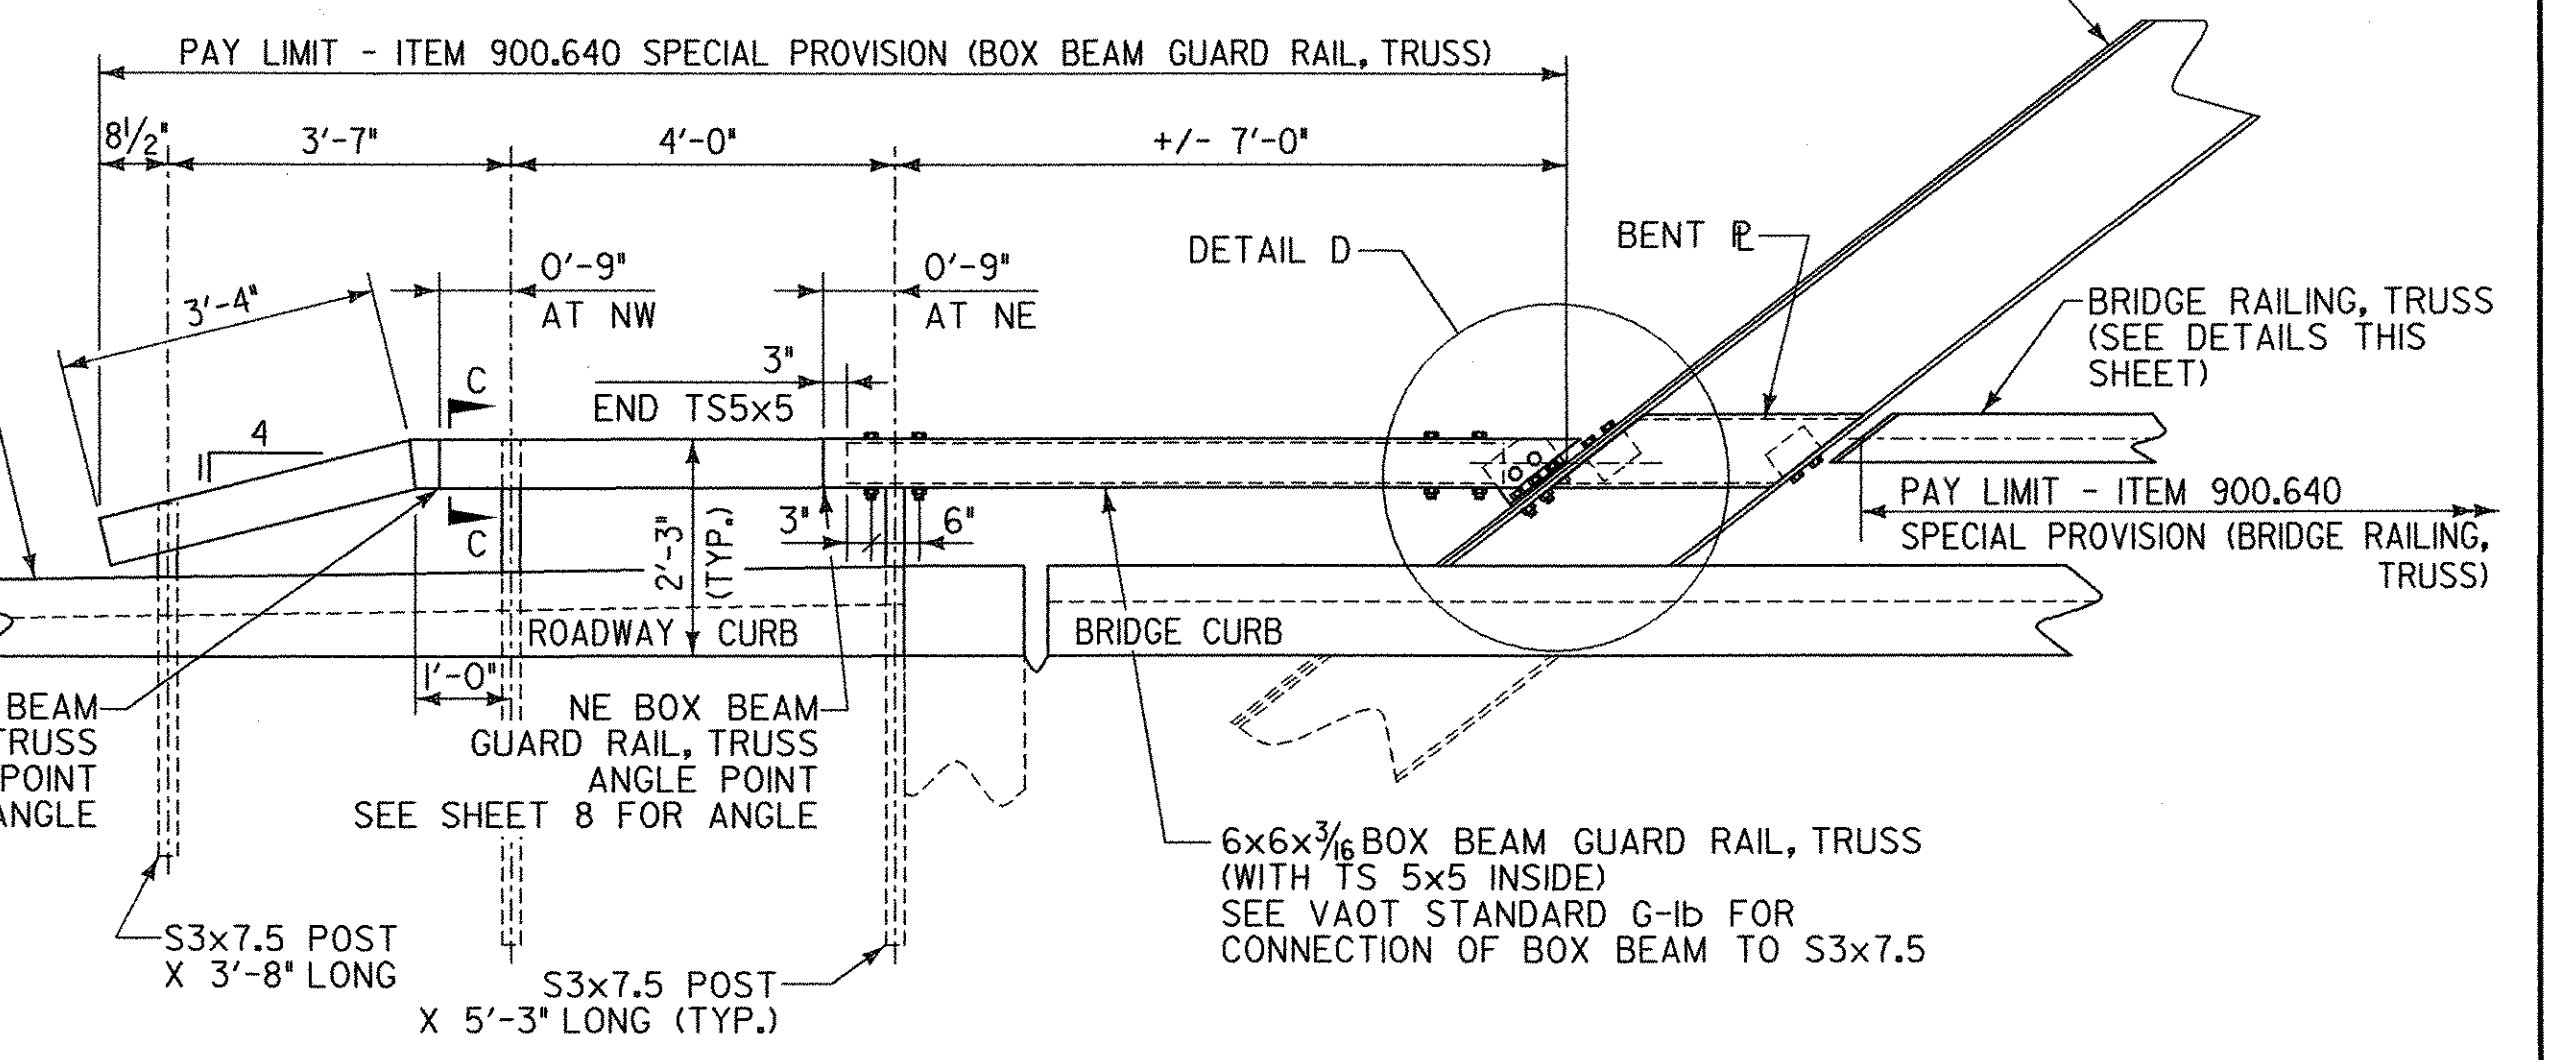


GUARD RAIL APPROACH ELEVATION AT NW & NE CORNERS

SCALE 1/2" = 1'-0"

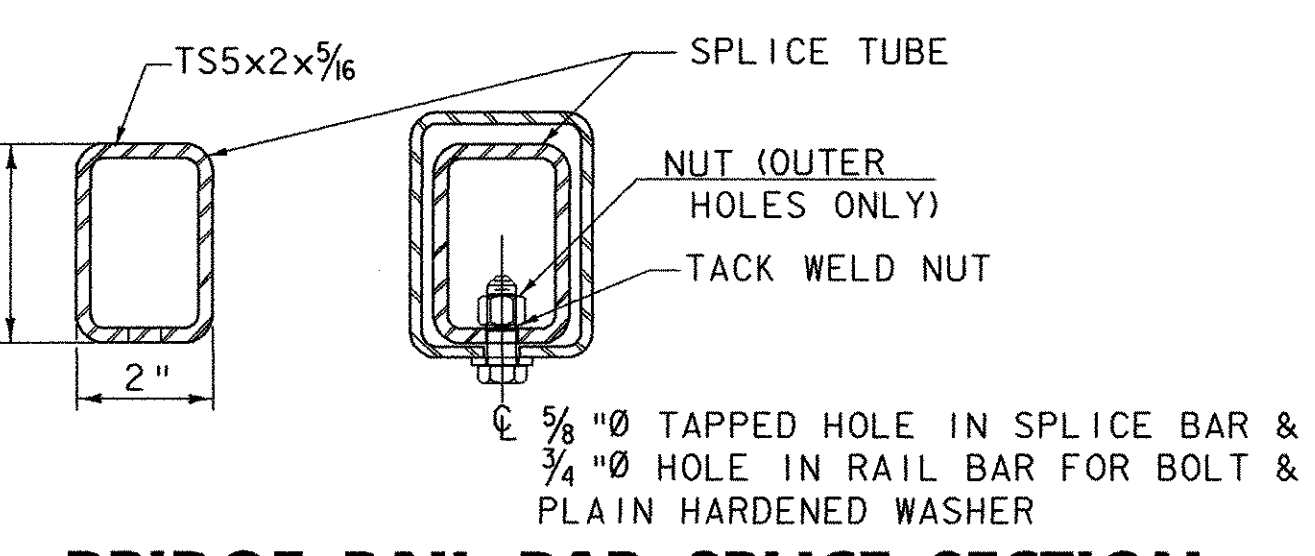


BRIDGE RAIL BAR SPLICE SECTION

NOT TO SCALE

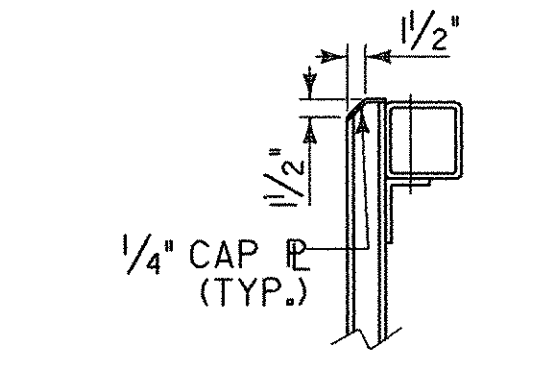

SECTION C-C

SCALE 3/4" = 1'-0"

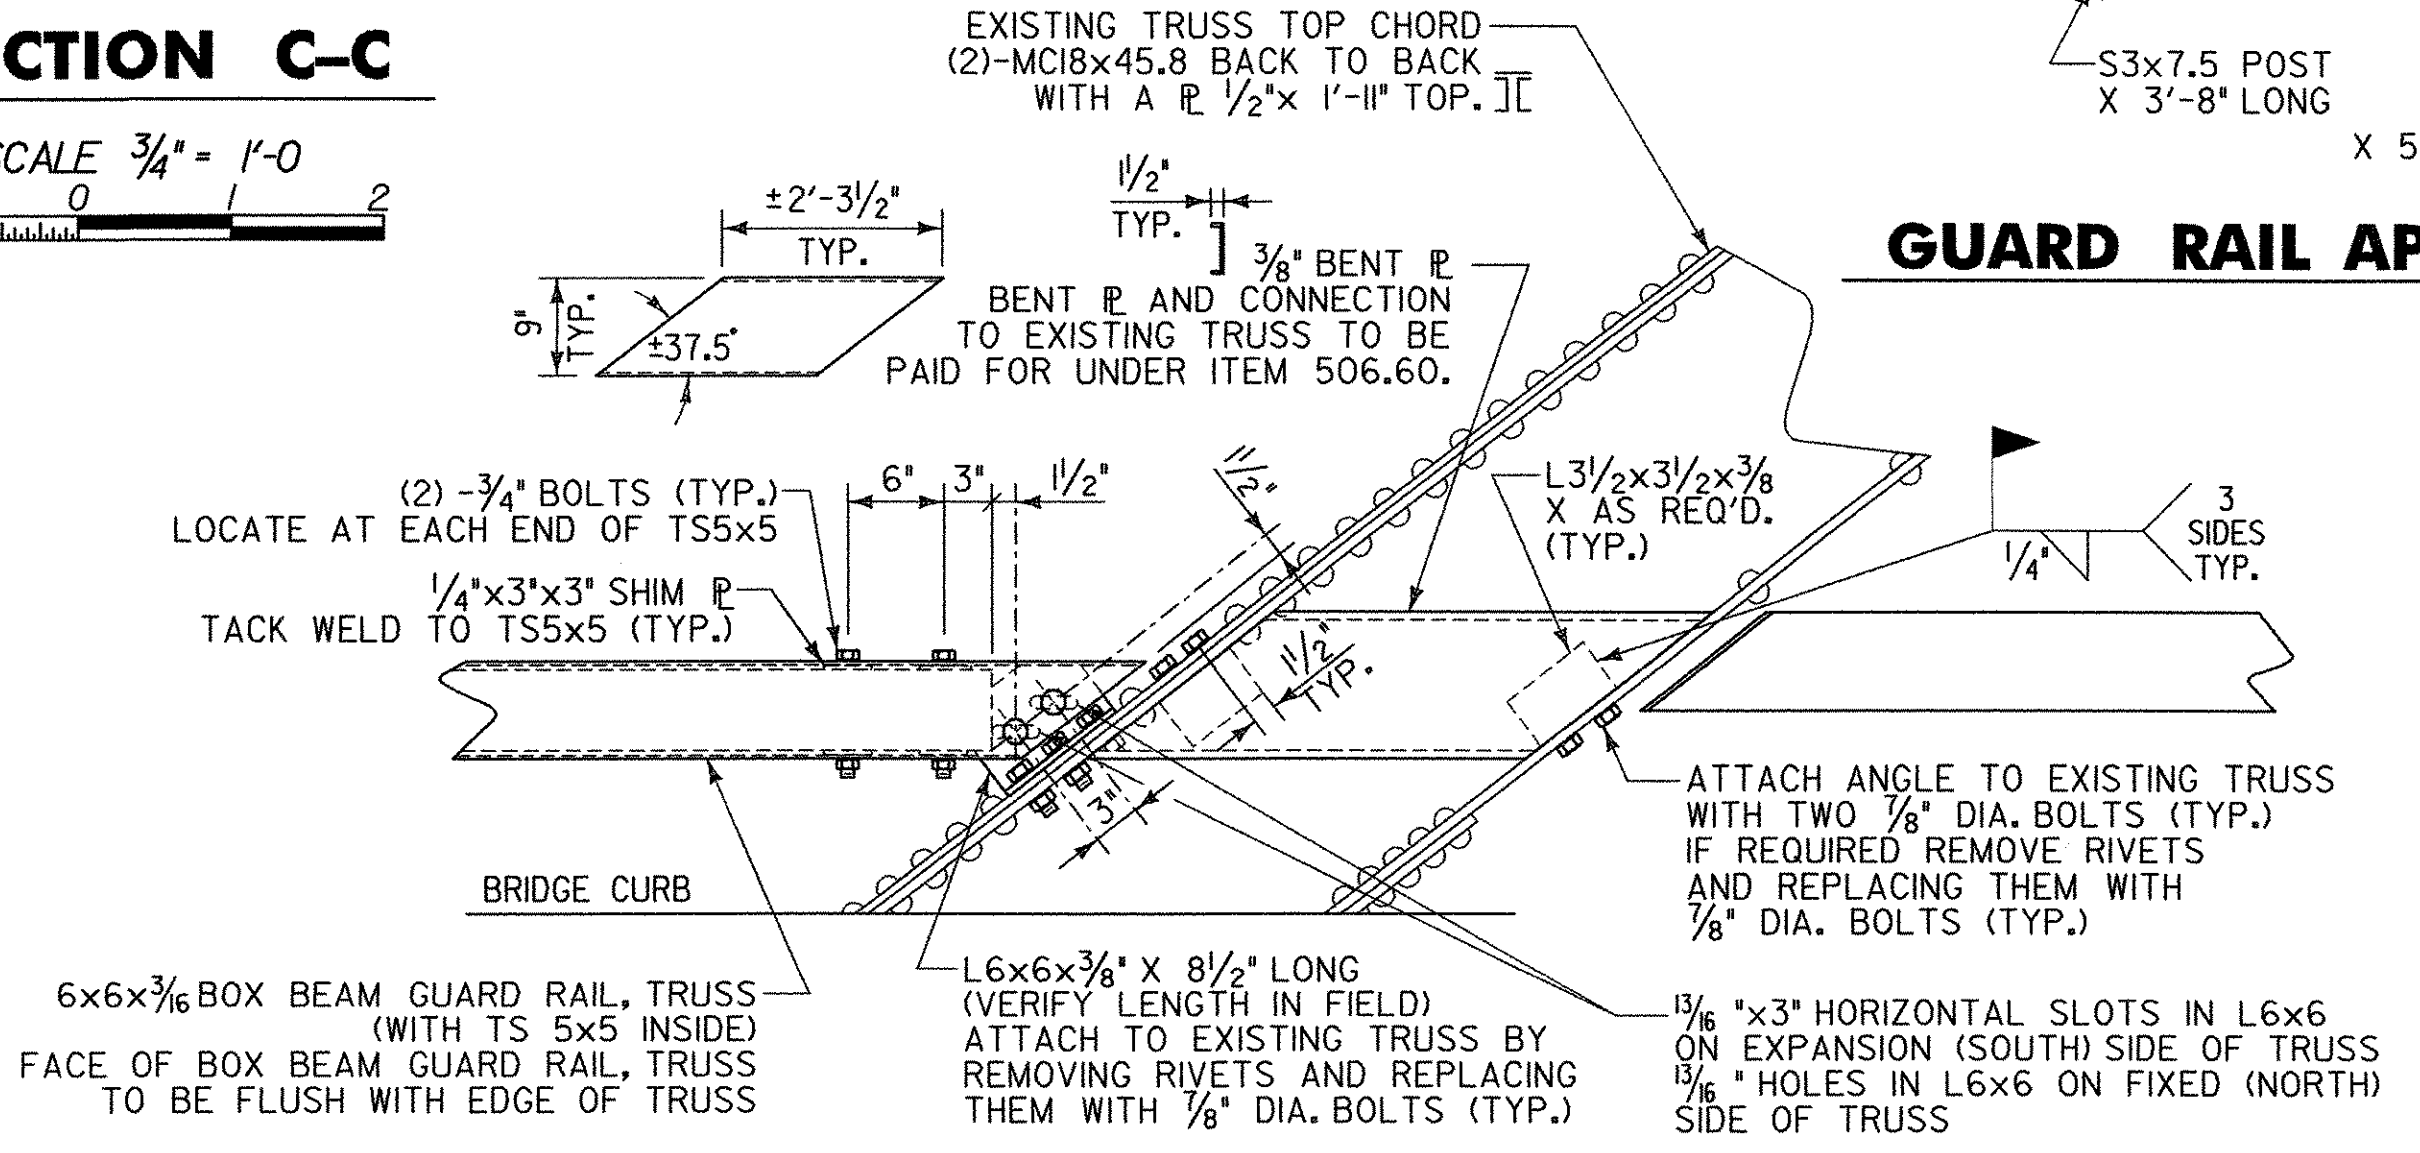

DETAIL D

SCALE 1" = 1'-0"


- BRIDGE RAIL AND APPROACH RAIL NOTES**
1. ALL WORK AND MATERIALS SHALL CONFORM TO SECTION 525.
 2. ALL BRIDGE RAIL CONNECTION HARDWARE SHALL BE INCIDENTAL TO ITEM 900.640 SPECIAL PROVISION (BRIDGE RAILING, TRUSS).
 3. TUBING SHALL MEET THE REQUIREMENTS OF SUBSECTION 732.03. ALL OTHER SHAPES AND PLATES SHALL BE AASHTO M 270M/M 270 GRADE 36. BOLTS SHALL CONFORM TO NOTE 22 OF THE PROJECT NOTES.
 4. ALL EXPOSED CUT OR SHEARED EDGES SHALL BE ROUNDED TO A 1/16" RADIUS AND BE FREE OF BURRS.
- SECTIONS OF BRIDGE RAIL SHALL BE ATTACHED TO
5. A MINIMUM OF TWO (2) TRUSS MEMBERS.
- ALL PARTS SHALL BE PAINTED ACCORDING
6. TO NOTES 26 AND 27 OF THE PROJECT NOTES.
- ANY BENDING OF BRIDGE RAIL SHALL BE BY SHOP
7. PROCEDURE ONLY.

NOTE:

SLV = SHORT LEG VERTICAL
LLV = LONG LEG VERTICAL




PROJECT NAME:	RICHFORD
PROJECT NUMBER:	BHF 0302 (3) S
FILE NAME: ...Design\Rich-brraildets.dgn	PLOT DATE: 12/18/2007
PROJECT LEADER: MJC	DRAWN BY: SEB
DESIGNED BY: SEB	CHECKED BY: MJC
BRIDGE RAIL DETAILS	SHEET 34 OF 41

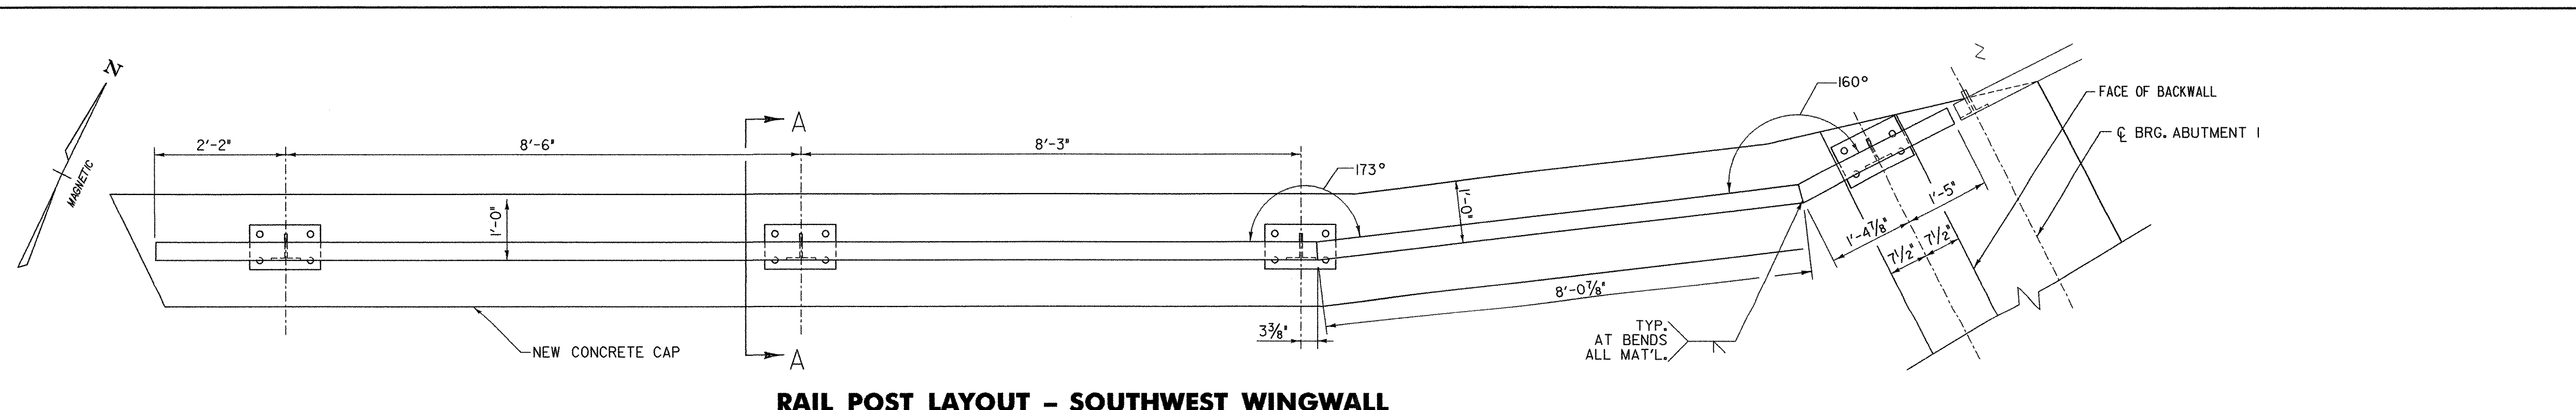


RAIL POST LAYOUT - SOUTHWEST WINGWALL

SCALE 3/4" = 1'-0"

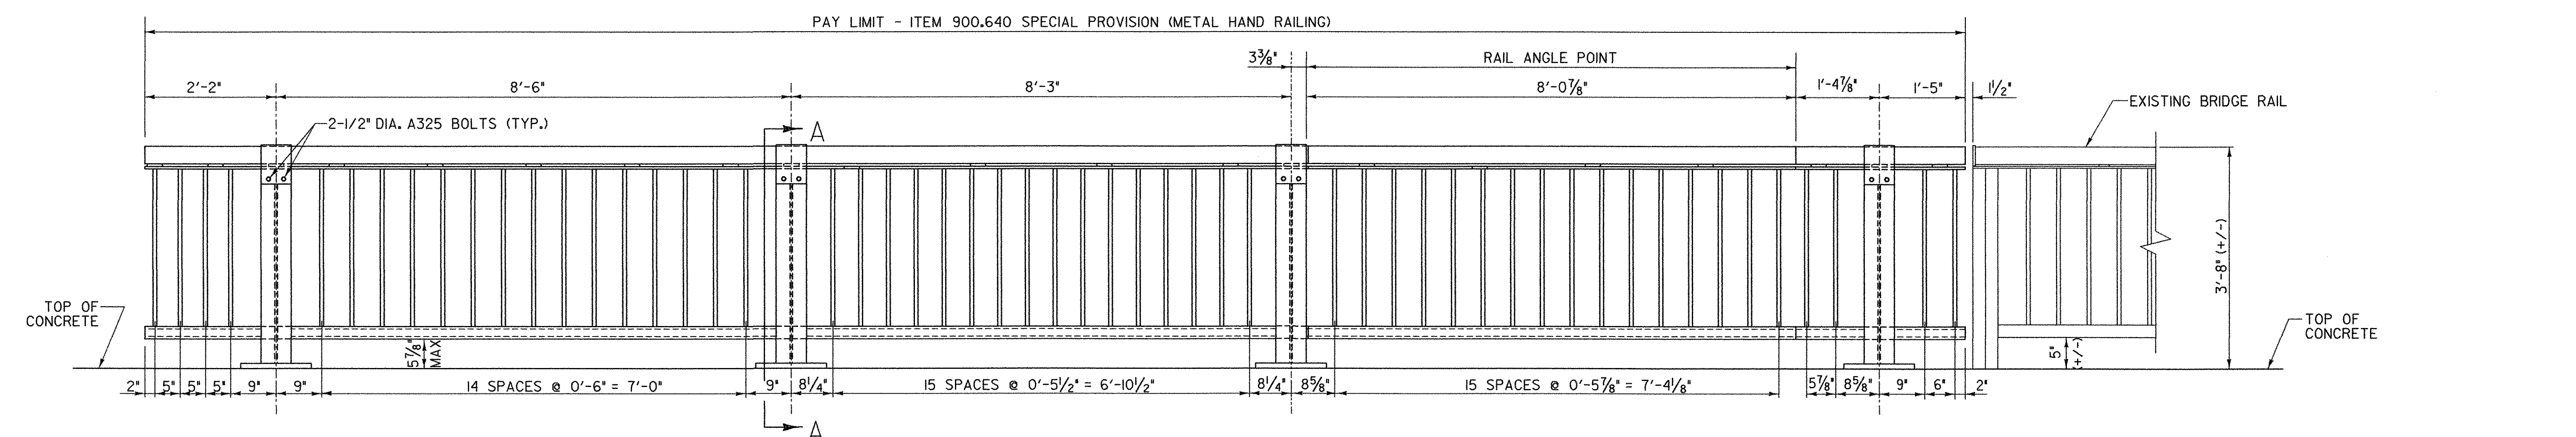


RAIL ELEVATION

SCALE 3/4" = 1'-0"

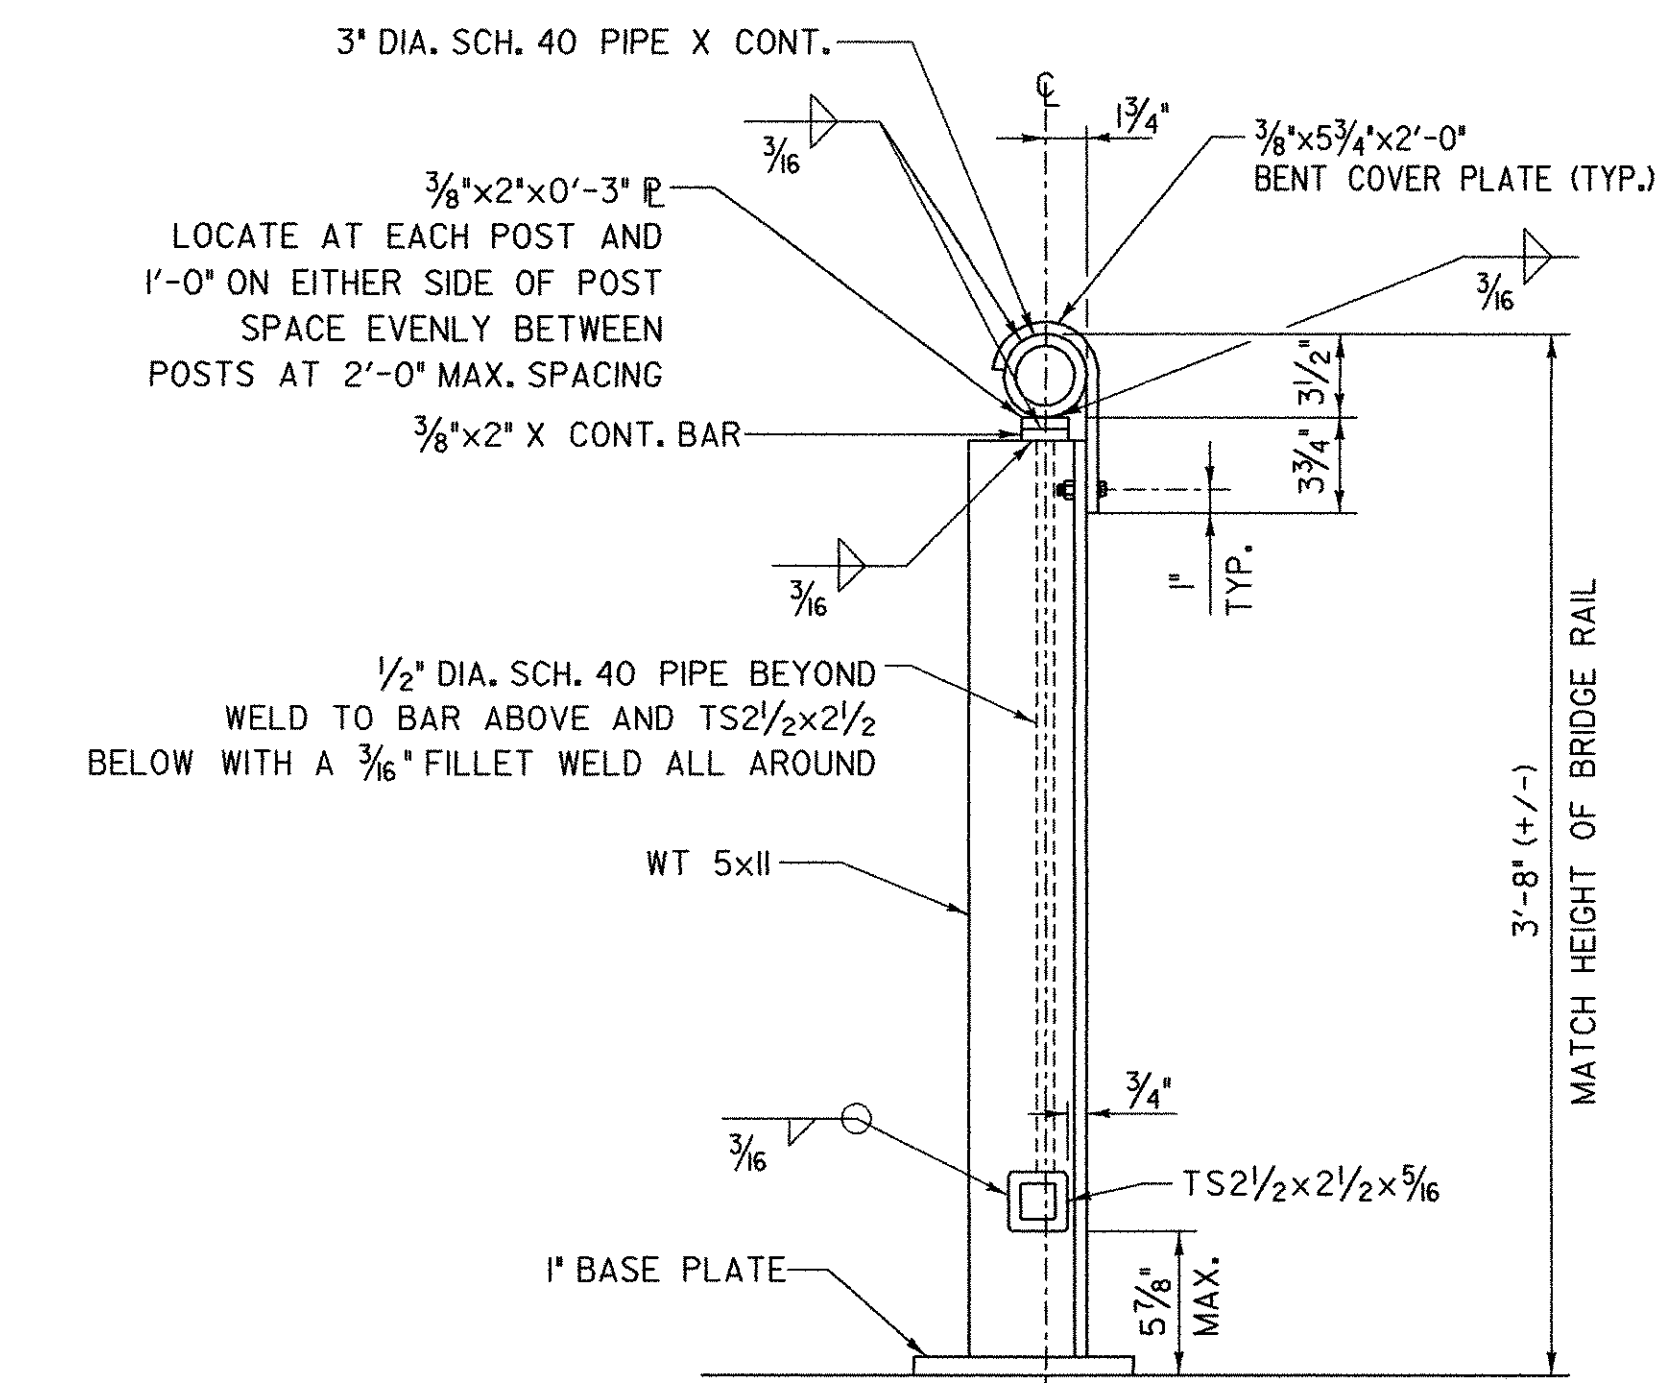


SECTION A-A

SCALE 1 1/2" = 1'-0"

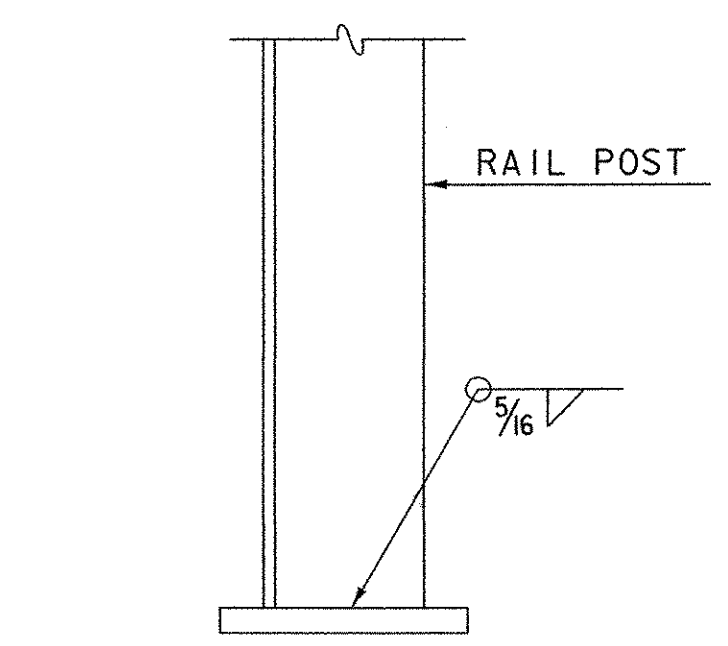


BASE WELD DETAIL

NOT TO SCALE

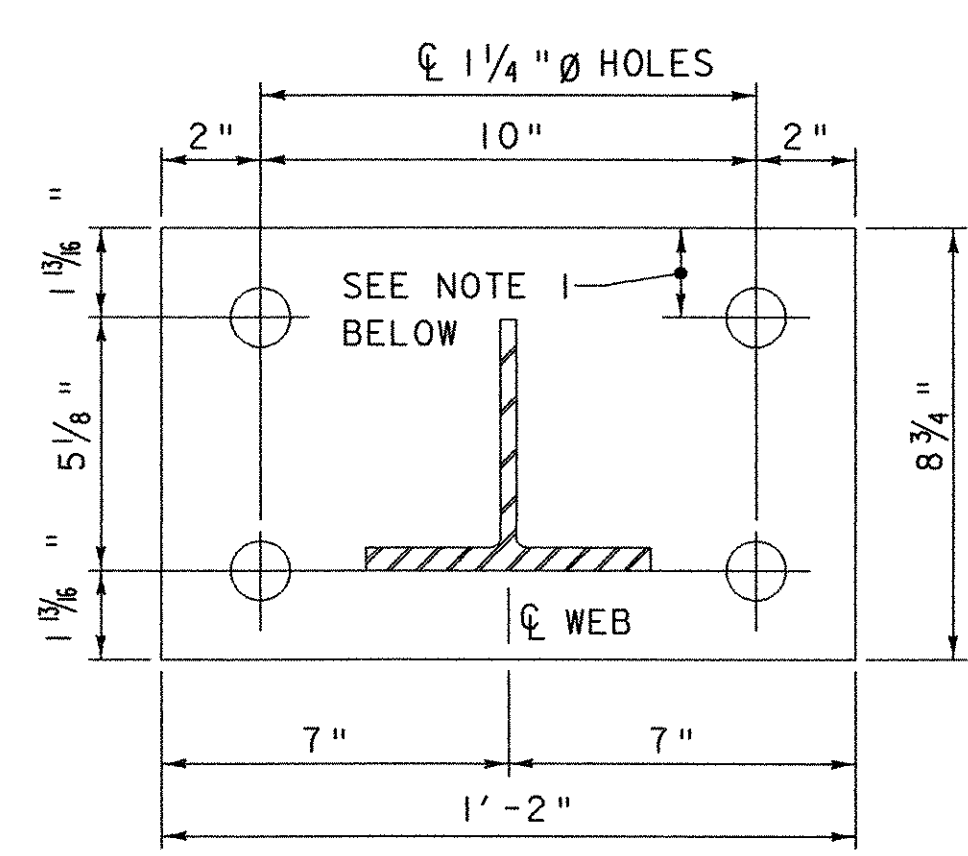


POST & BASE PLATE

NOT TO SCALE

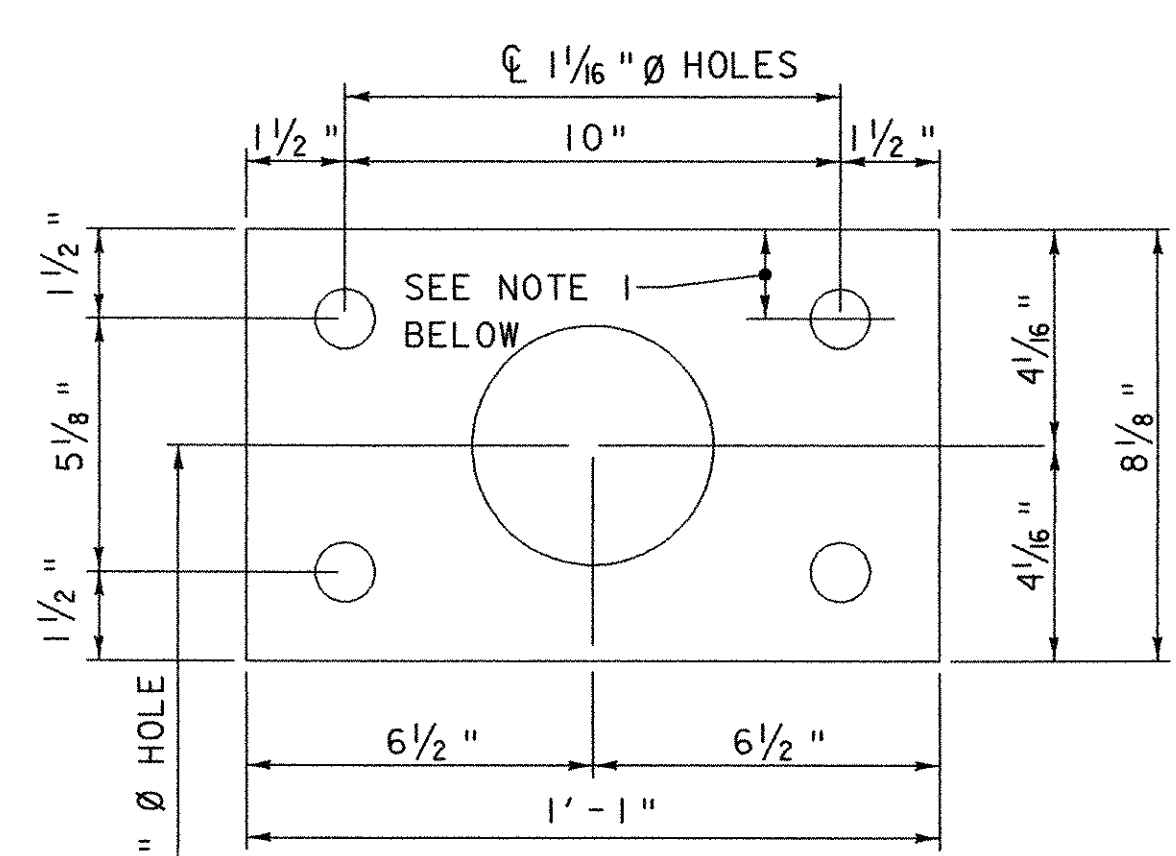

SPACER PLATE

NOT TO SCALE

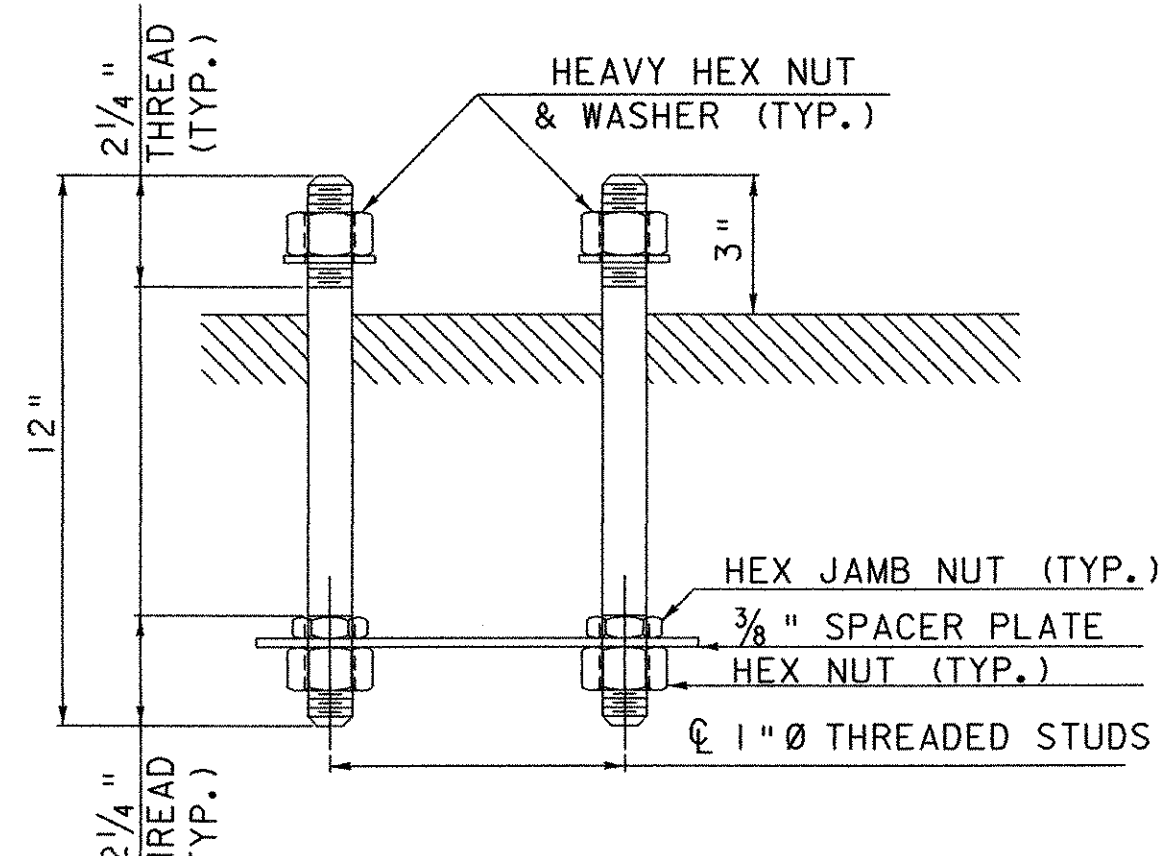

RAIL POST ANCHORAGE


NOT TO SCALE

HAND RAIL NOTES:

1. BASE ϕ CLOSEST TO BRIDGE SHALL HAVE UPPER RIGHT HOLE LOCATED 3/8" DOWN INSTEAD OF 1 1/8". 2" DIMENSION FROM THE SIDE SHALL REMAIN THE SAME.
2. HAND RAIL TO RECEIVE SAME PAINT SYSTEM AS BRIDGE.
3. ALL STEEL FOR RAILING ASSEMBLY SHALL CONFORM TO AASHTO M 270M/M 270 GRADE 36 UNLESS OTHERWISE NOTED. STEEL PIPE SHALL CONFORM TO ASTM A53 GRADE B, SCHEDULE 40. STRUCTURAL TUBING SHALL MEET THE REQUIREMENTS OF NOTE 20 ON THE PROJECT NOTES.
4. ANCHOR STUDS SHALL MEET THE REQUIREMENTS OF ASTM A449.



PROJECT NAME:	RICHFORD	FILE NAME:	...Design\Rich-handrail.dgn	PLOT DATE:	12/18/2007
PROJECT NUMBER:	BHF 0302 (3) S	PROJECT LEADER:	MJC	DRAWN BY:	JTS
		DESIGNED BY:	SEB	CHECKED BY:	MJC
RAILING REPLACEMENT DETAILS				SHEET 35 OF 41	

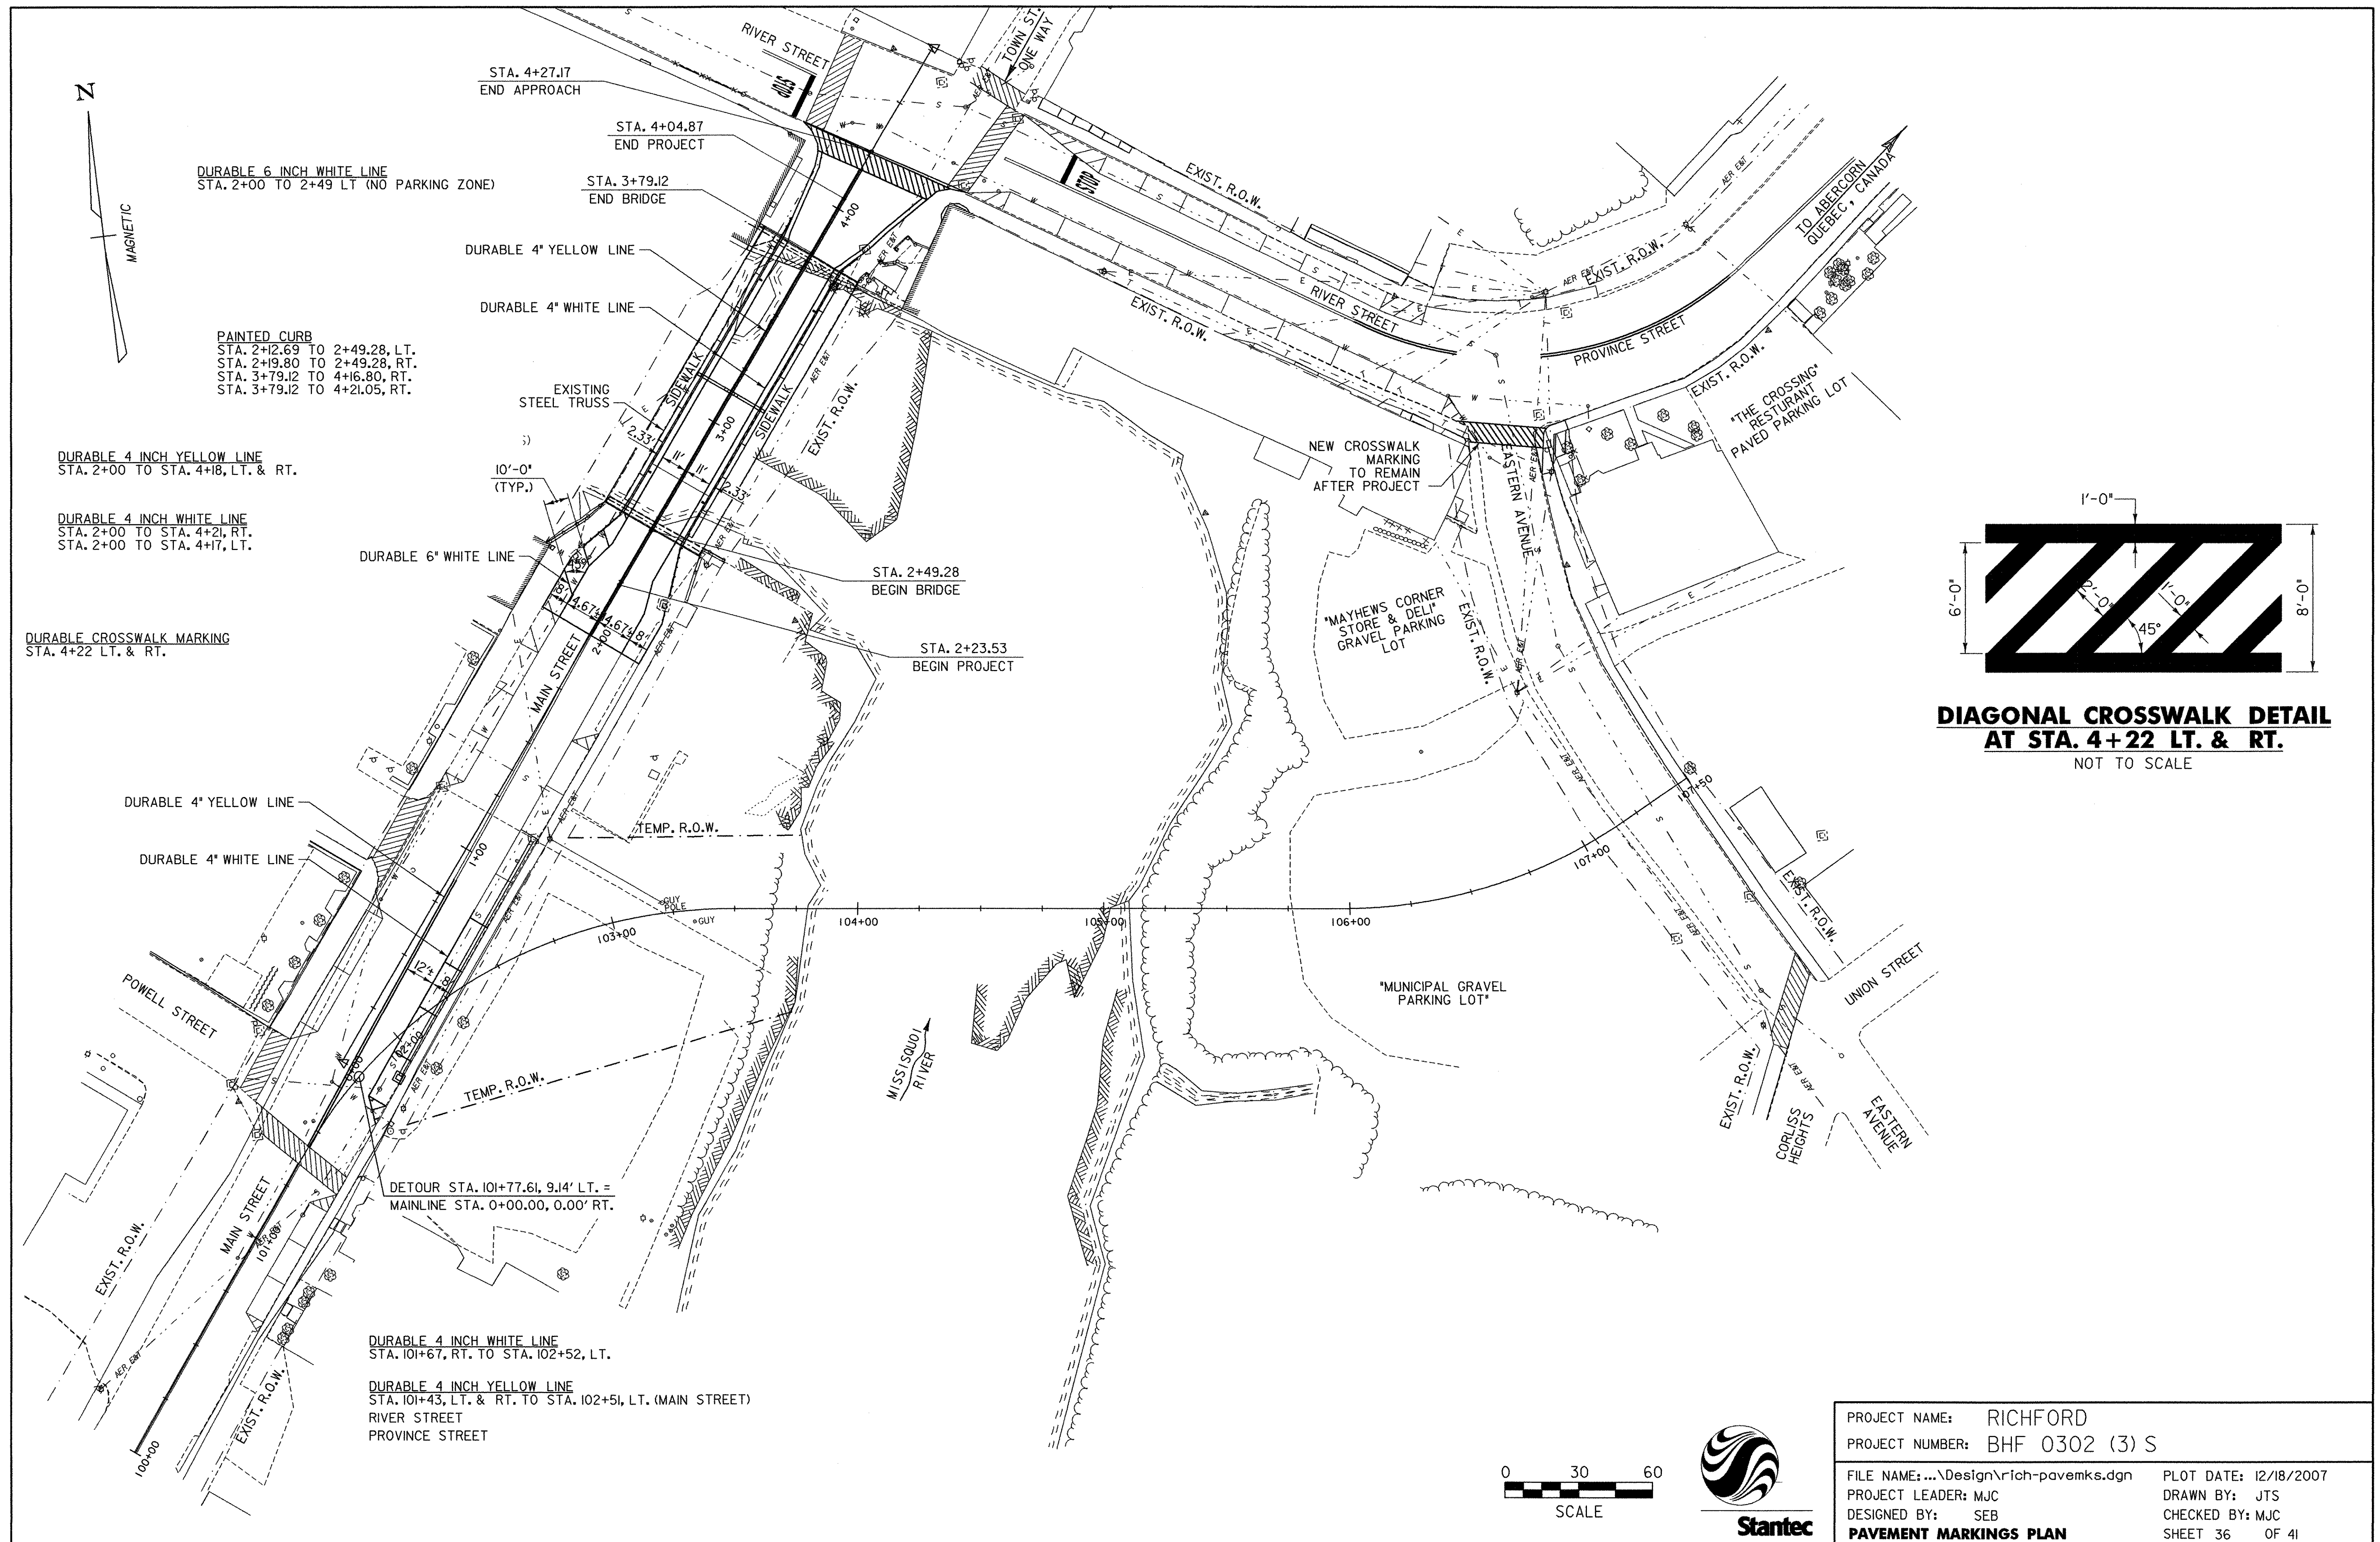

DURABLE 6 INCH WHITE LINE
STA. 2+00 TO 2+49 LT (NO PARKING ZONE)

PAINTED CURB
STA. 2+12.69 TO 2+49.28, LT.
STA. 2+19.80 TO 2+49.28, RT.
STA. 3+79.12 TO 4+16.80, RT.
STA. 3+79.12 TO 4+21.05, RT.

DURABLE 4 INCH YELLOW LINE
STA. 2+00 TO STA. 4+18, LT. & RT.

DURABLE 4 INCH WHITE LINE
STA. 2+00 TO STA. 4+21, RT.
STA. 2+00 TO STA. 4+17, LT.

DURABLE CROSSWALK MARKING
STA. 4+22 LT. & RT.

DURABLE 4 INCH YELLOW LINE

DURABLE 4 INCH WHITE LINE

DURABLE 4 INCH WHITE LINE
STA. 101+67, RT. TO STA. 102+52, LT.

DURABLE 4 INCH YELLOW LINE
STA. 101+43, LT. & RT. TO STA. 102+51, LT. (MAIN STREET)
RIVER STREET
PROVINCE STREET

STA. 4+27.17
END APPROACH

STA. 4+04.87
END PROJECT

STA. 3+79.12
END BRIDGE

DURABLE 4" YELLOW LINE

DURABLE 4" WHITE LINE

EXISTING STEEL TRUSS

10'-0" (TYP.)


STA. 2+49.28
BEGIN BRIDGE

STA. 2+23.53
BEGIN PROJECT


TEMP. R.O.W.

TEMP. R.O.W.

DETOUR STA. 101+77.61, 9.14' LT. =
MAINLINE STA. 0+00.00, 0.00' RT.

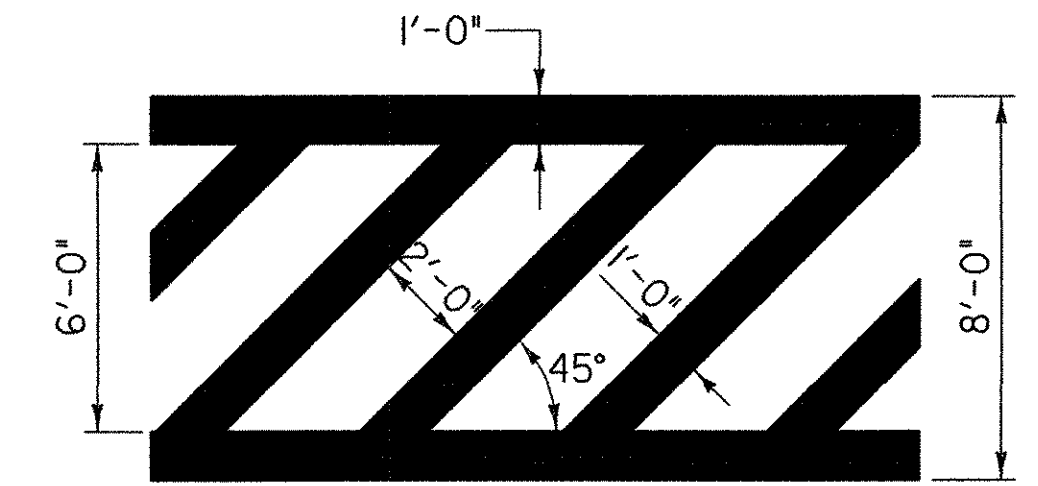

DIAGONAL CROSSWALK DETAIL
AT STA. 4+22 LT. & RT.
NOT TO SCALE

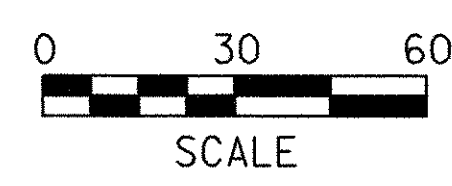

PROJECT NAME:	RICHFORD	PLOT DATE:	12/18/2007
PROJECT NUMBER:	BHF 0302 (3) S	DRAWN BY:	JTS
FILE NAME:	...Design\Rich-pavemks.dgn	CHECKED BY:	MJC
PROJECT LEADER:	MJC		
DESIGNED BY:	SEB		
PAVEMENT MARKINGS PLAN		SHEET	36 OF 41


STATE OF VERMONT
AGENCY OF TRANSPORTATION

REINFORCING STEEL SCHEDULE

ITEM	EACH	SIZE	LENGTH	MARK	TYPE	A	B	C	D	E	F	G	H	J	K	R	O	ITEM	EACH	SIZE	LENGTH	MARK	TYPE	A	B	C	D	E	F	G	H	J	K	R	O
DECK																																			
•	259	5	8'-3"	ES501	STR																														
•	258	5	3'-0"	ES502	8	0'-10"	1'-4"					0'-10"																							
•	192	5	33'-8"	ES503	STR																														
•	28	5	3'-9"	ES504	SS	0'-10"	0'-6"	1'-1"	0'-6"			0'-10"																							
•	172	6	28'-9"	ES601	1	0'-8"	27'-5"					0'-8"	0'-4 1/2"																						
•	172	6	27'-5"	ES602	STR																														
ABUTMENT NO. 1																																			
•	21	5	5'-0"	1A501	STR																														
•	20	5	4'-2"	1A502	STR																														
•	66	5	5'-6"	1A503	STR																														
•	10	5	24'-6"	1A504	STR																														
•	10	5	23'-0"	1A505	STR																														
•	58	5	2'-0"	1EA501	STR																														
•	5	5	28'-6"	1EA502	STR																														
•	29	5	2'-9"	1EA503	17	0'-9"	1'-3"	0'-9"																											
•	3	5	24'-6"	1EA504	STR																														
•	3	5	23'-0"	1EA505	STR																														
•	4	5	9'-1"	1EA506	STR																														
•	3	5	9'-7"	1EA507	STR																														
•	28	5	11'-4"	1EA508	17	5'-3"	0'-10"	5'-3"																											
•	18	5	13'-2"	1EA509	17	6'-2"	0'-10"	6'-2"																											
ABUTMENT NO. 2																																			
•	21	5	5'-0"	2A501	STR																														
•	10	5	3'-8"	2A502	STR																														
•	10	5	4'-2"	2A503	STR																														
•	71	5	5'-6"	2A504	STR																														
•	11	5	26'-0"	2A505	STR																														
•	11	5	22'-0"	2A506	STR																														
•	3	5	10'-0"	2A507	STR																														
•	3	5	8'-0"	2A508	STR																														
•	28	5	9'-2"	2A509	17	4'-2"	0'-10"	4'-2"																											
•	20	5	11'-6"	2A510	17	5'-4"	0'-10"	5'-4"																											



~ NOTES ~

- UNLESS OTHERWISE DESIGNATED, ALL BAR REINFORCEMENT FOR CONCRETE IN SIZES UP TO AND INCLUDING NO. 18 SHALL CONFORM TO THE REQUIREMENTS OF THE "SPECIFICATIONS FOR DEFORMED BILLET-STEEL BARS FOR CONCRETE REINFORCEMENT", AASHTO M 31 (ASTM A 615-S1). ALL BARS SHALL BE GRADE 60, UNLESS OTHERWISE DESIGNATED.
- FOR TYPICAL BENDING DETAILS, RECOMMENDED PIN DIAMETER "D" OF BENDS AND HOOKS, AND OTHER STANDARD PRACTICE, SEE CURRENT CONCRETE REINFORCING STEEL INSTITUTE "MANUAL OF STANDARD PRACTICE".
- BARS WHICH REQUIRE MORE ACCURATE BENDING THAN STANDARD PRACTICES SHOULD HAVE LIMITS INDICATED.
- ALL DIMENSIONS ARE OUT TO OUT OF BAR EXCEPT "A" AND "G" ON STANDARD 180 DEGREE AND 135 DEGREE HOOKS.
- "J" DIMENSION ON 180 DEGREE HOOKS TO BE SHOWN ONLY WHERE NECESSARY TO RESTRICT HOOK SIZE. OTHERWISE, STANDARD HOOKS ARE TO BE USED.
- "H" DIMENSION ON STIRRUPS TO BE SHOWN ONLY WHEN NECESSARY TO MAINTAIN CLEARANCES.
- WHERE SLOPE DIFFERS FROM 45 DEGREES, DIMENSIONS "H" AND "K" MUST BE SHOWN.
- DENOTES BARS TO BE CUT IN FIELD.
- DENOTES ONE EXTRA BAR ADDED FOR TESTING PURPOSES.
- ⊕ DENOTES TWO EXTRA BARS ADDED FOR TESTING PURPOSES.
- "E" IN PREFIX DENOTES EPOXY COATED REINFORCING STEEL.

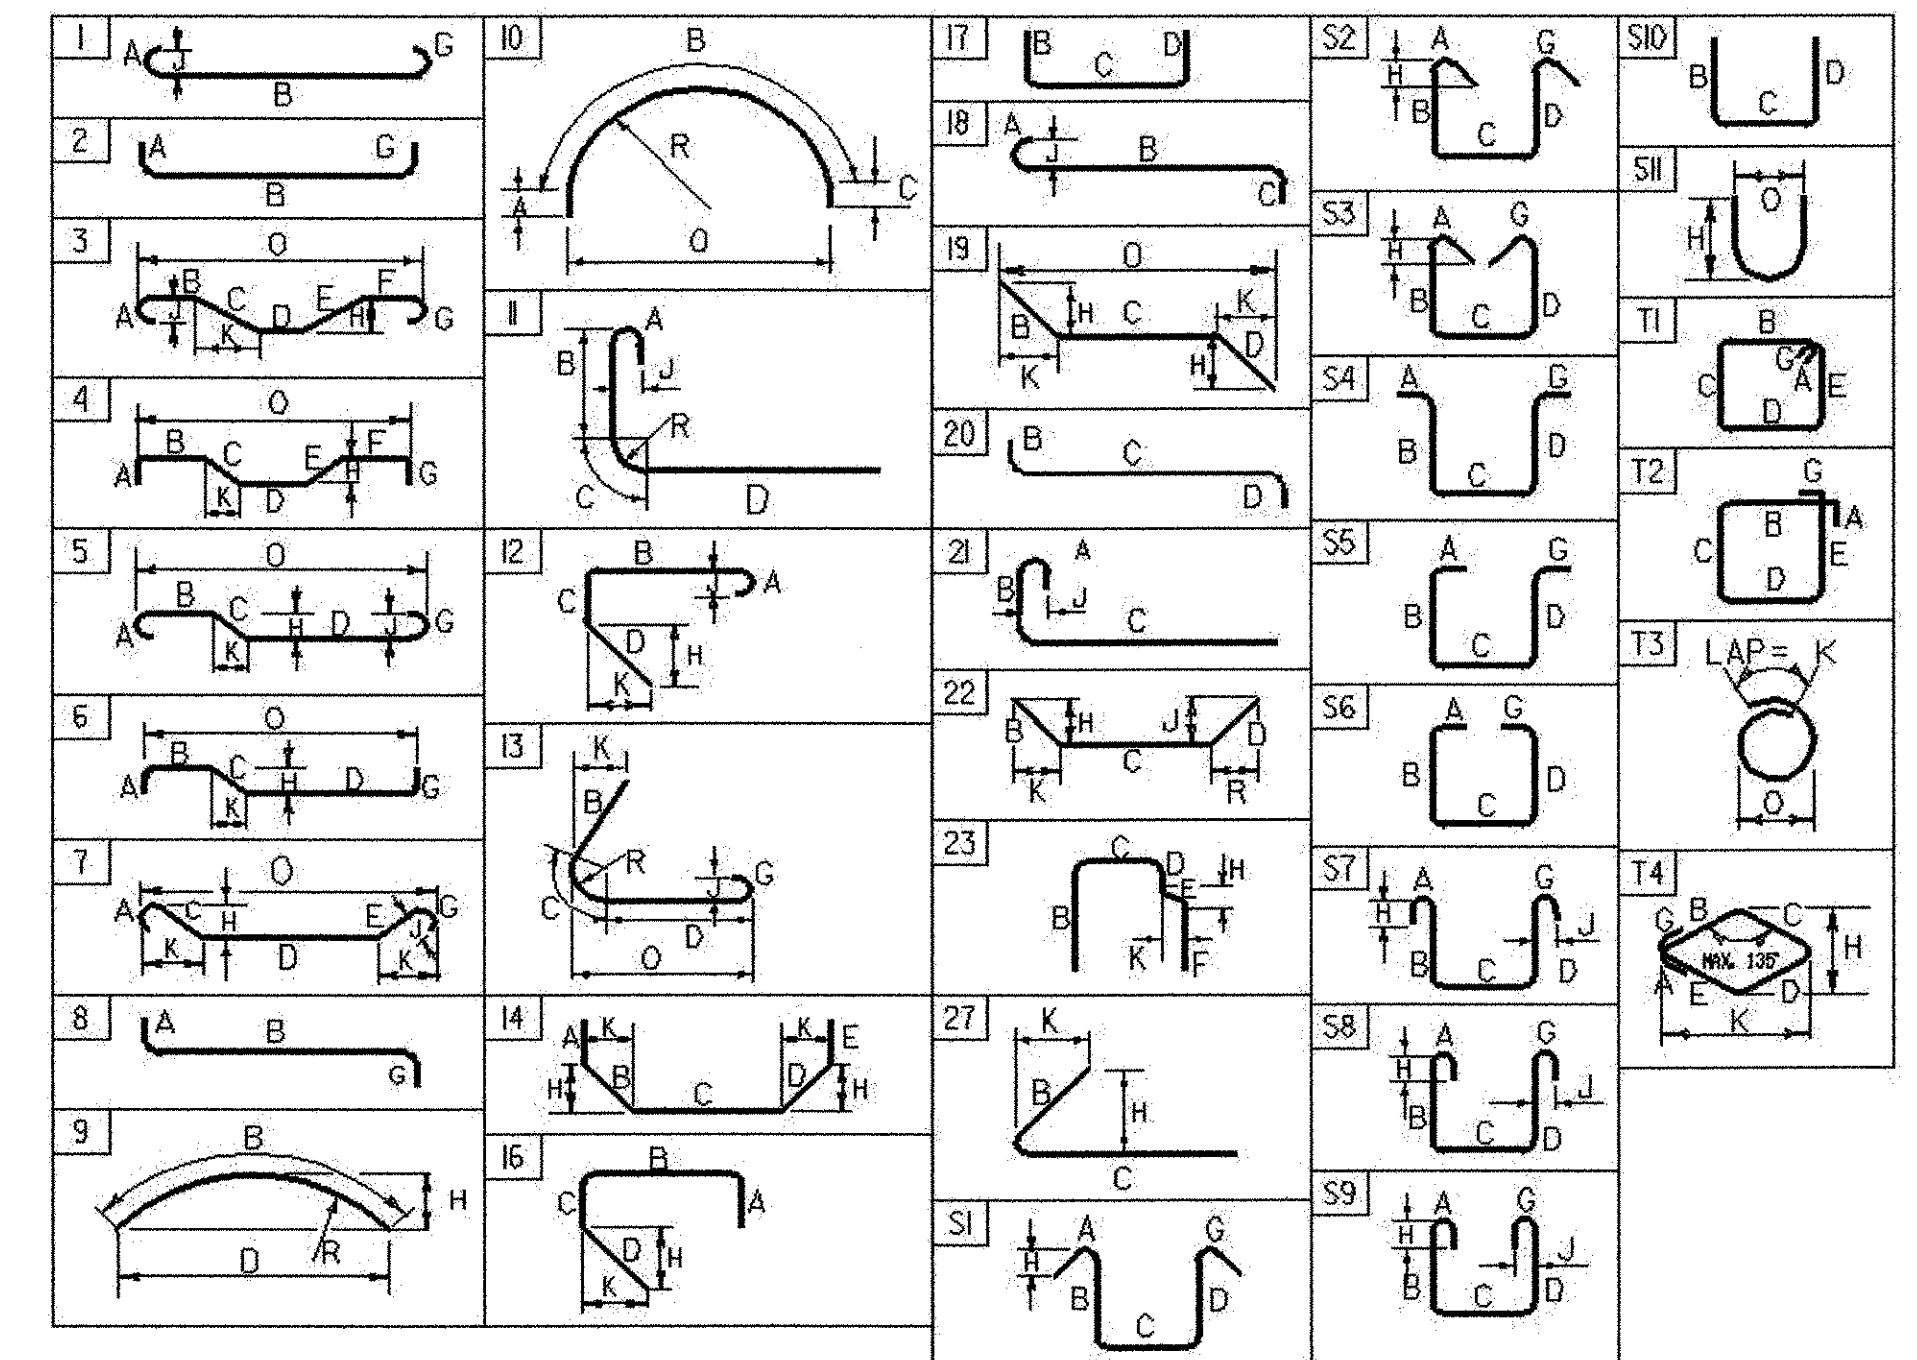

ASTM STANDARD REINFORCING BARS				
BAR SIZE DESIGNATION	WEIGHT POUNDS PER FOOT	NOMINAL DIMENSIONS ROUND SECTION		
		DIAMETER INCHES	AREA INCHES ²	PERIMETER INCHES
#3	0.376	0.375	0.11	1.178
#4	0.668	0.500	0.20	1.571
#5	1.043	0.625	0.31	1.963
#6	1.502	0.750	0.44	2.356
#7	2.044	0.875	0.60	2.749
#8	2.670	1.000	0.79	3.142
#9	3.400	1.128	1.00	3.544
#10	4.303	1.270	1.27	3.990
#11	5.313	1.410	1.56	4.430
#14	7.65	1.693	2.25	5.32
#18	13.60	2.257	4.00	7.09


PROJECT NAME: **RICHFORD**
PROJECT NUMBER: **BHF 0302 (3) S**
FILE NAME: **rich-reinf.xls** PLOT DATE: **9/26/2007**
PROJECT LEADER: **MJC** DRAWN BY: **AET**
DESIGNED BY: **SEB** CHECKED BY: **MJC**
REINFORCING SCHEDULE SHEET **37** OF **41**

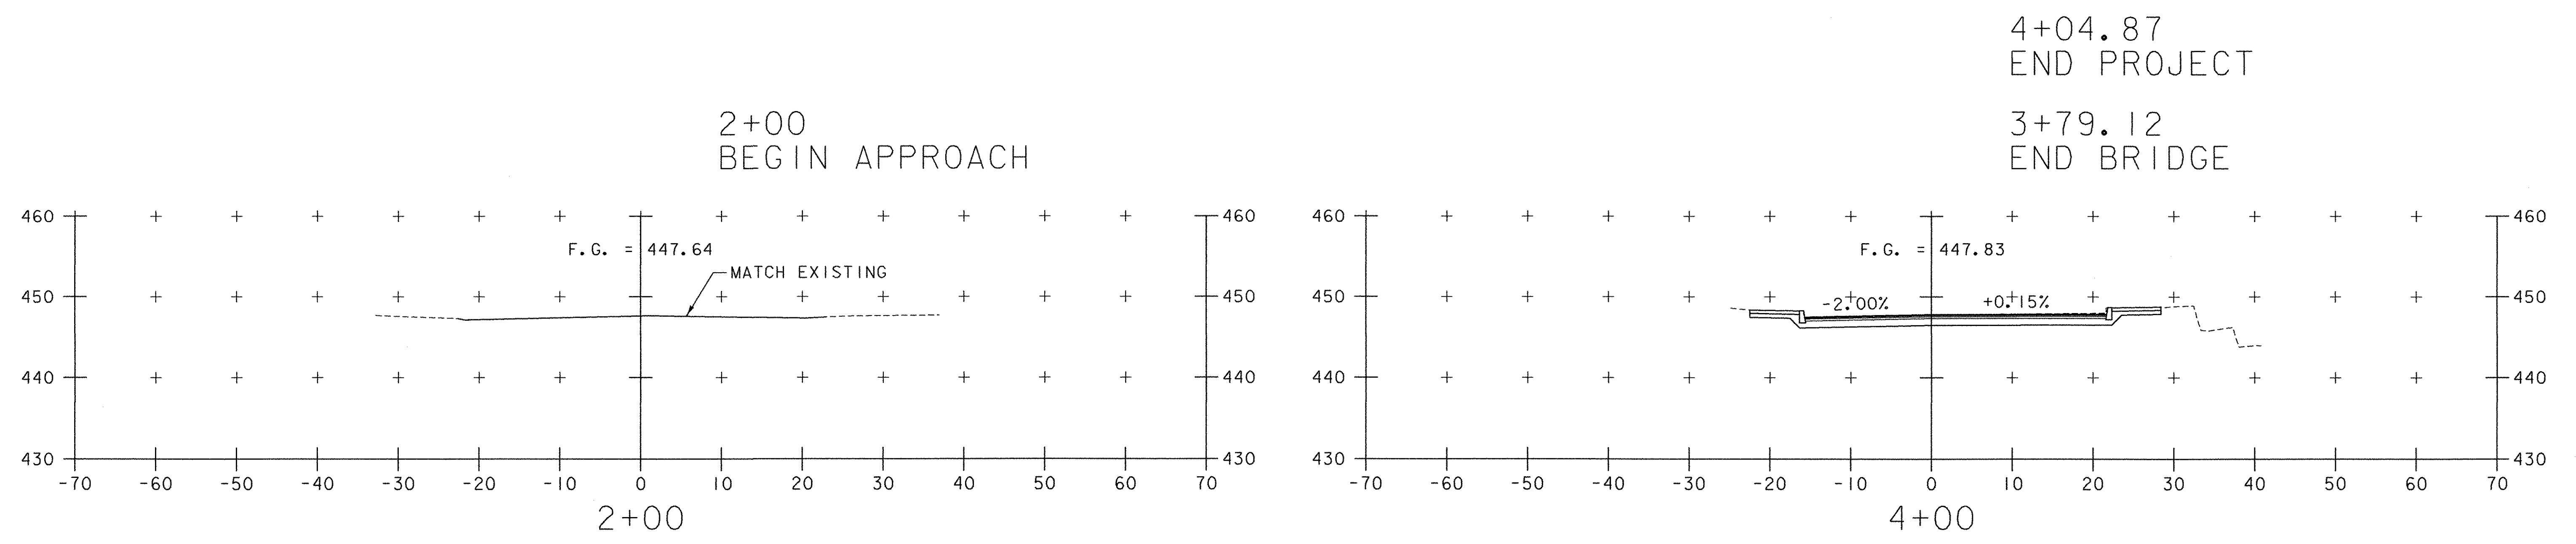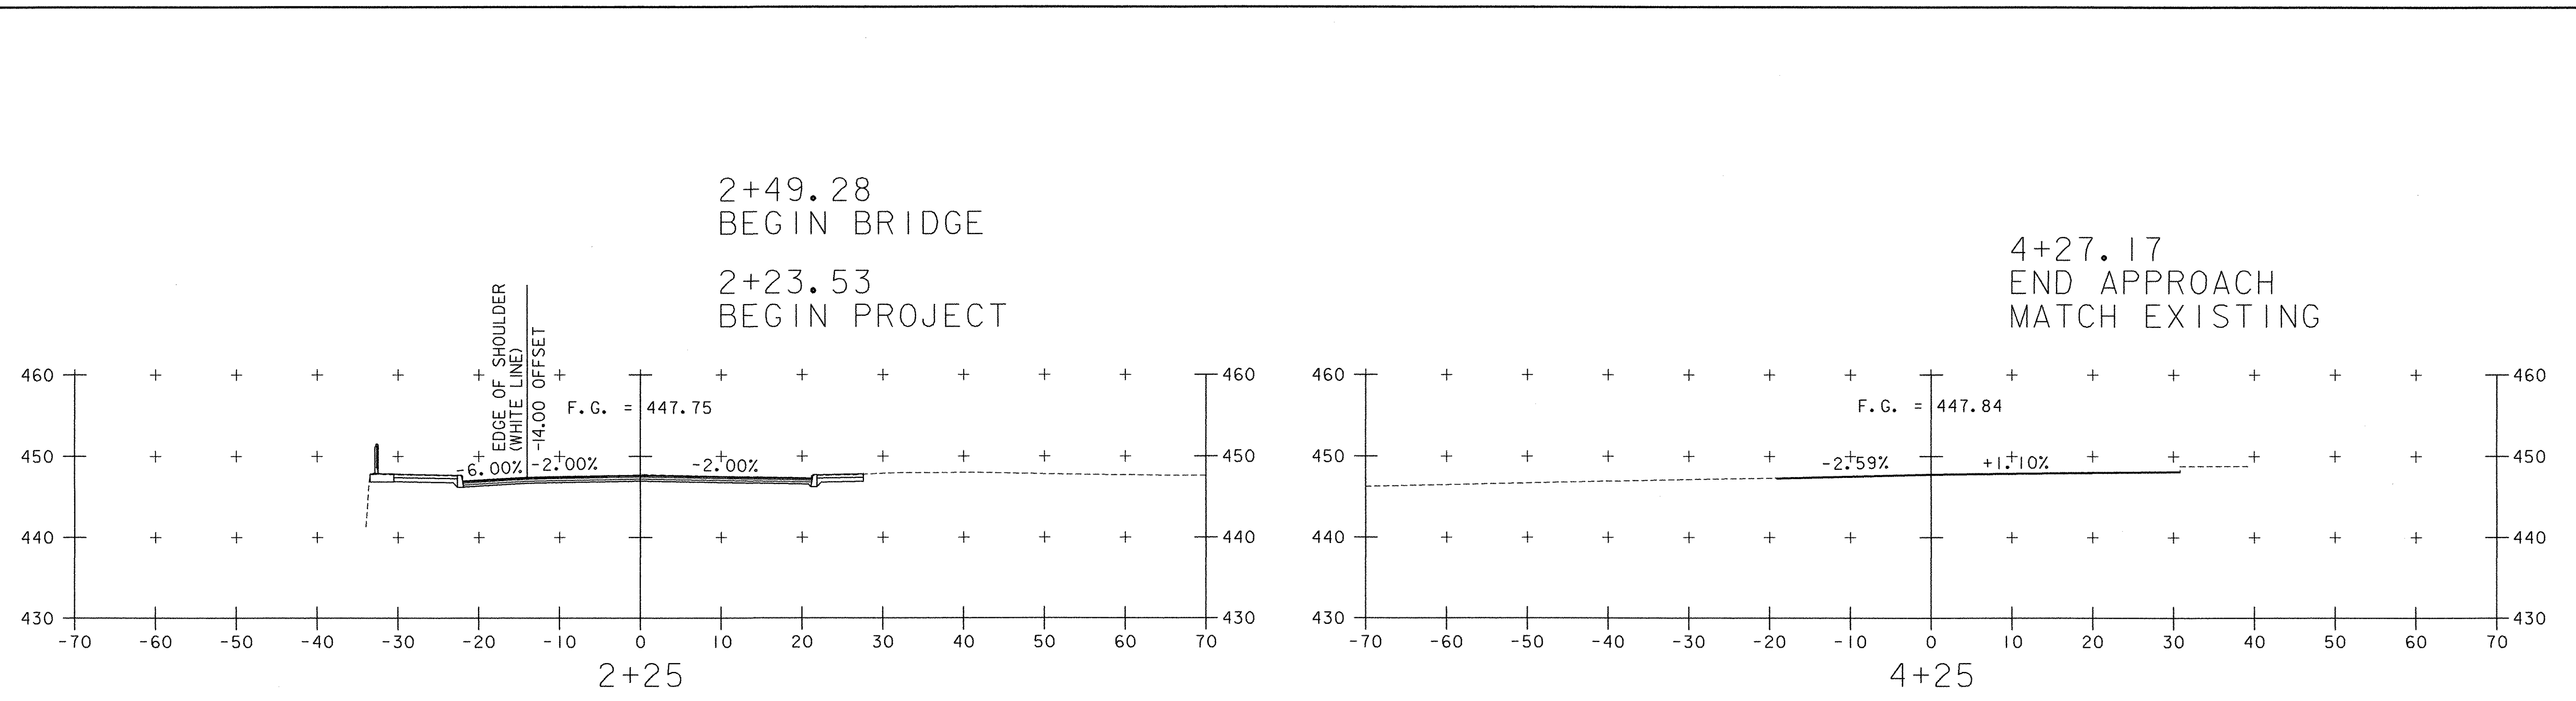


SCALE 1" = 10'-0"




PROJECT NAME:	RICHFORD
PROJECT NUMBER:	BHF 0302 (3) S
FILE NAME:	...Structures\Design\Rich-xsl.dwg
PROJECT LEADER:	MJC
DESIGNED BY:	SEB
DRAWN BY:	MJC
CHECKED BY:	MJC
ROADWAY CROSS SECTIONS	
	SHEET 38 OF 41

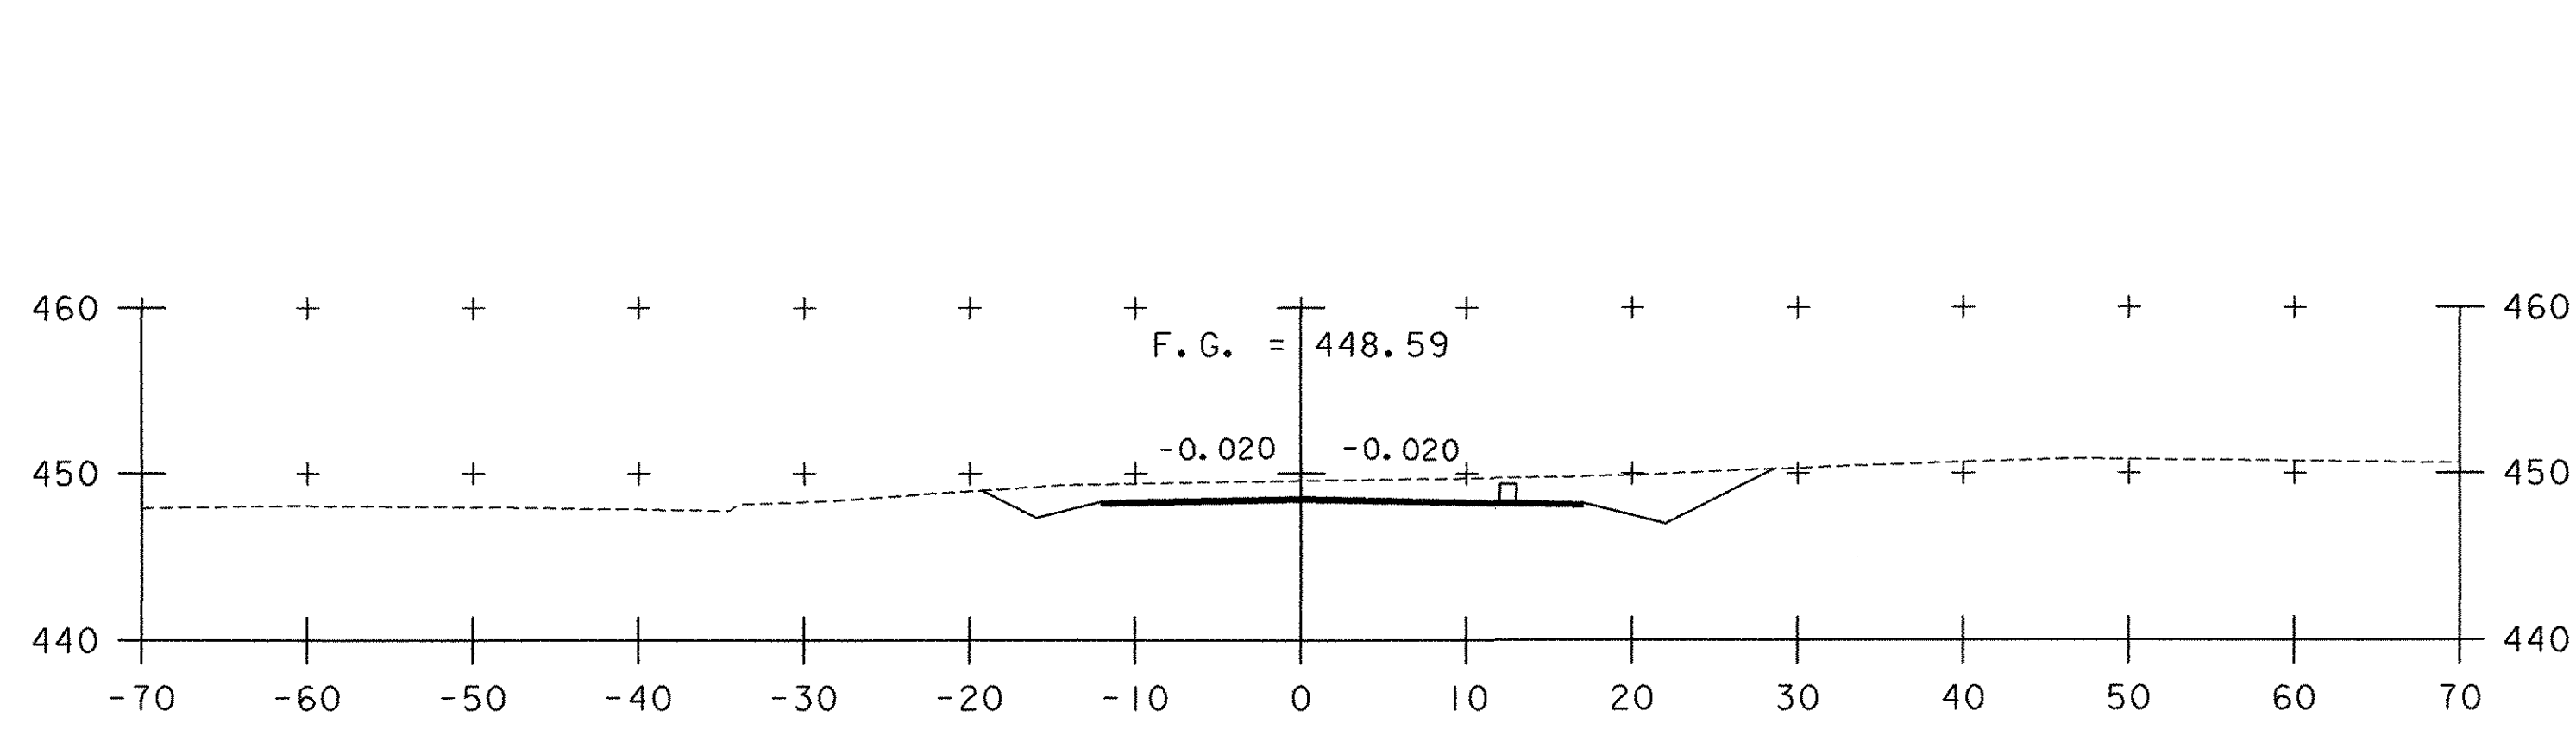


102+75

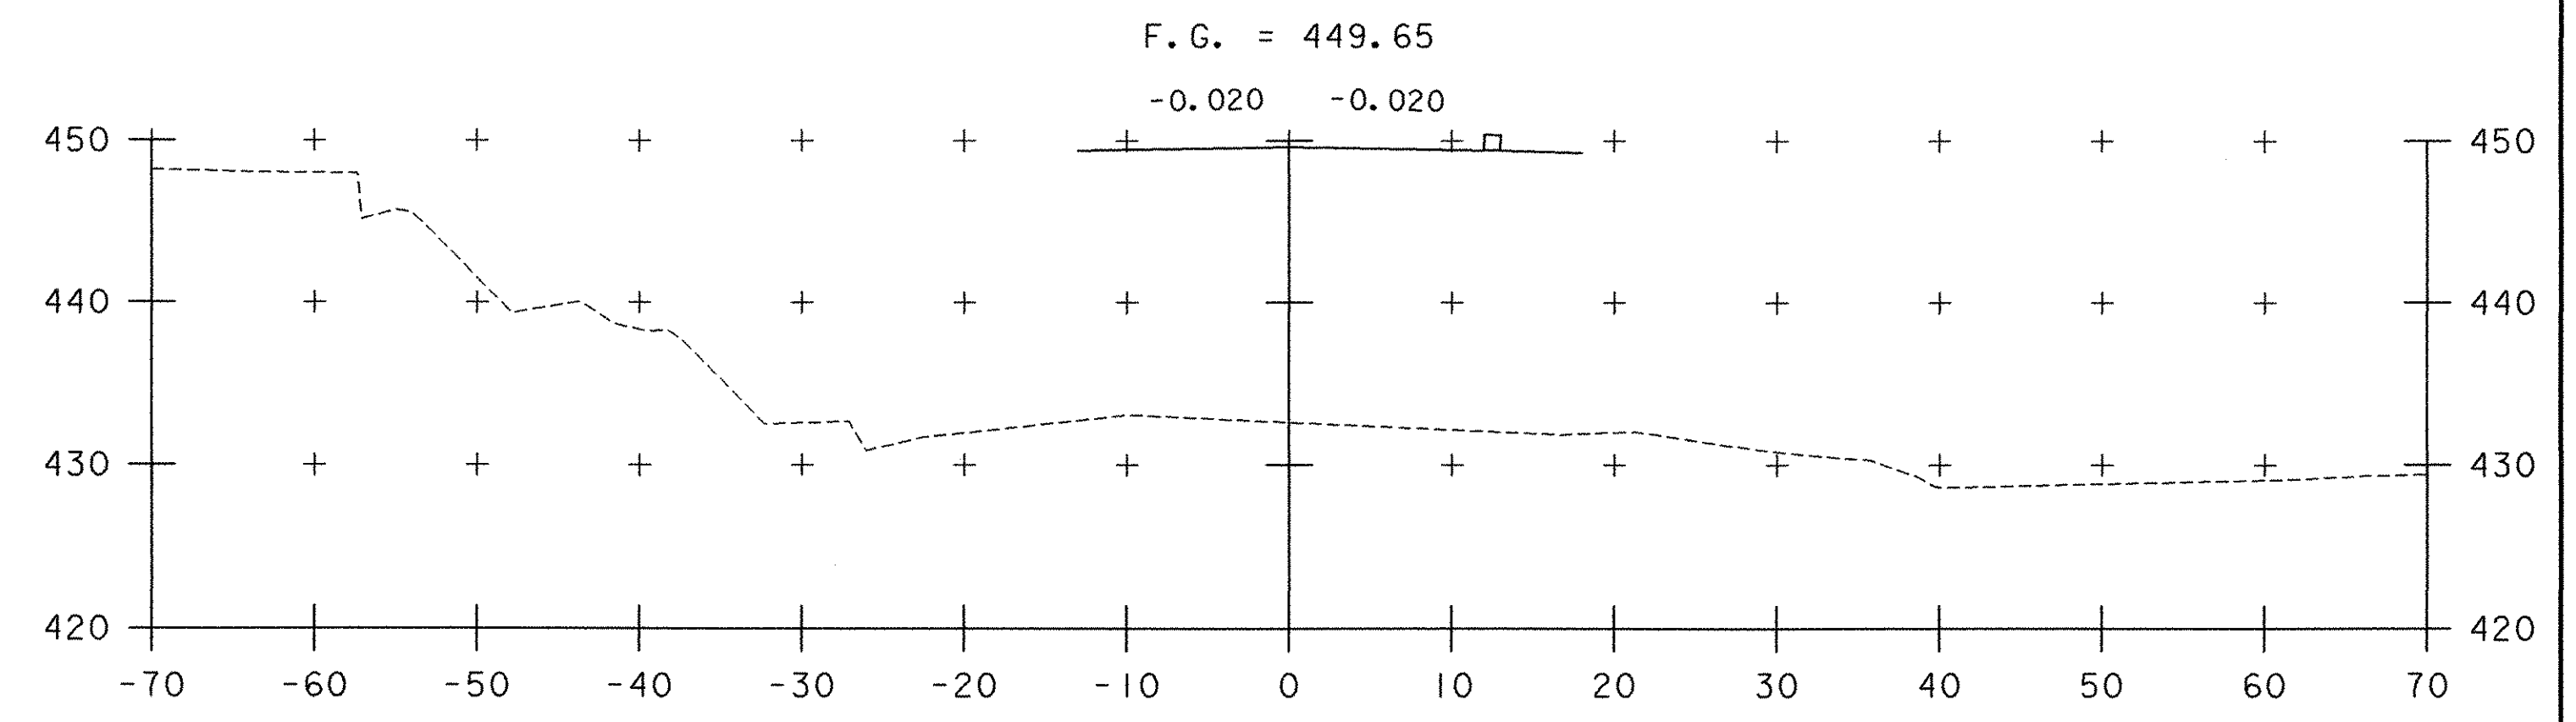


103+75

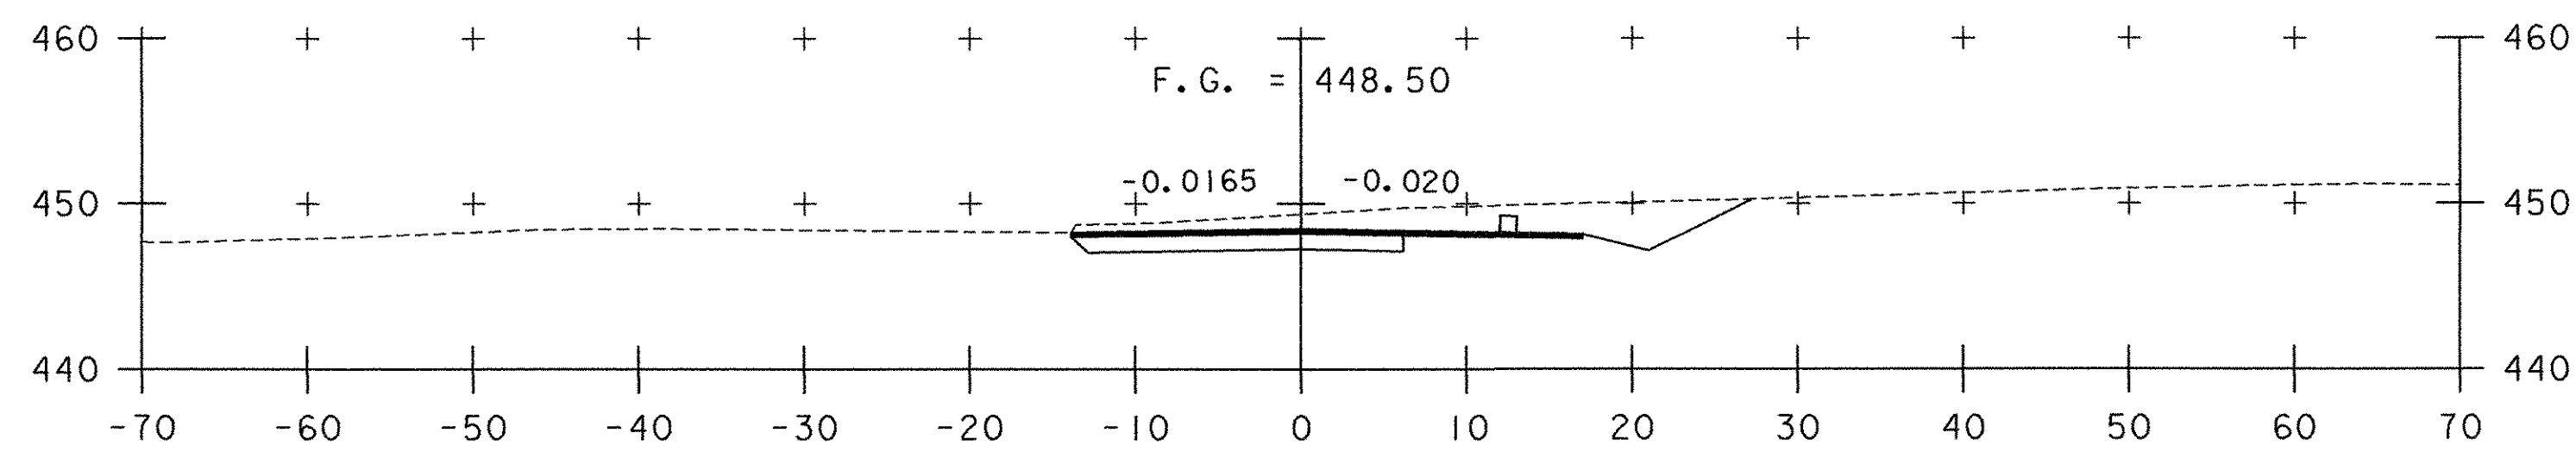


102+50

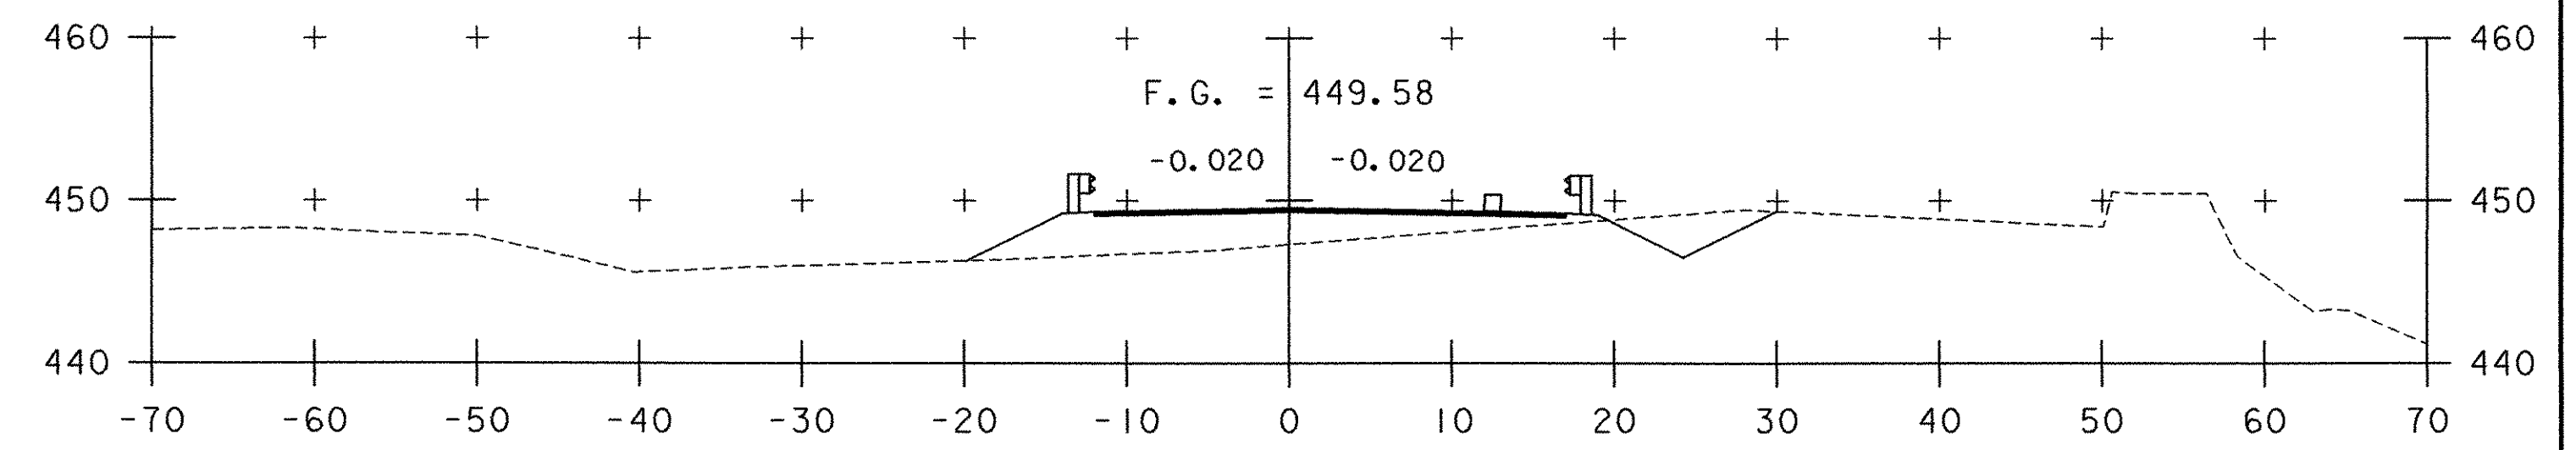


103+50

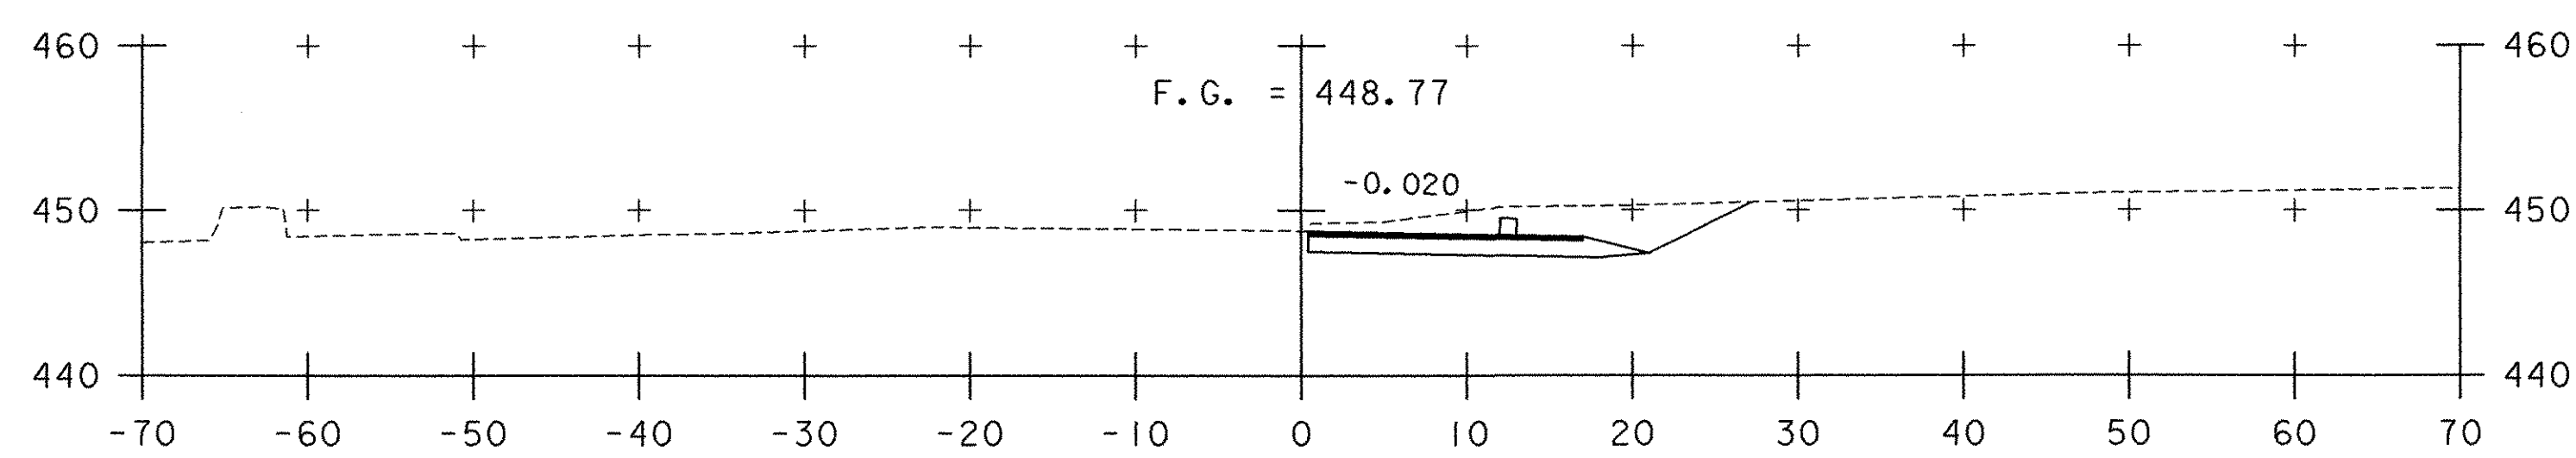


102+25

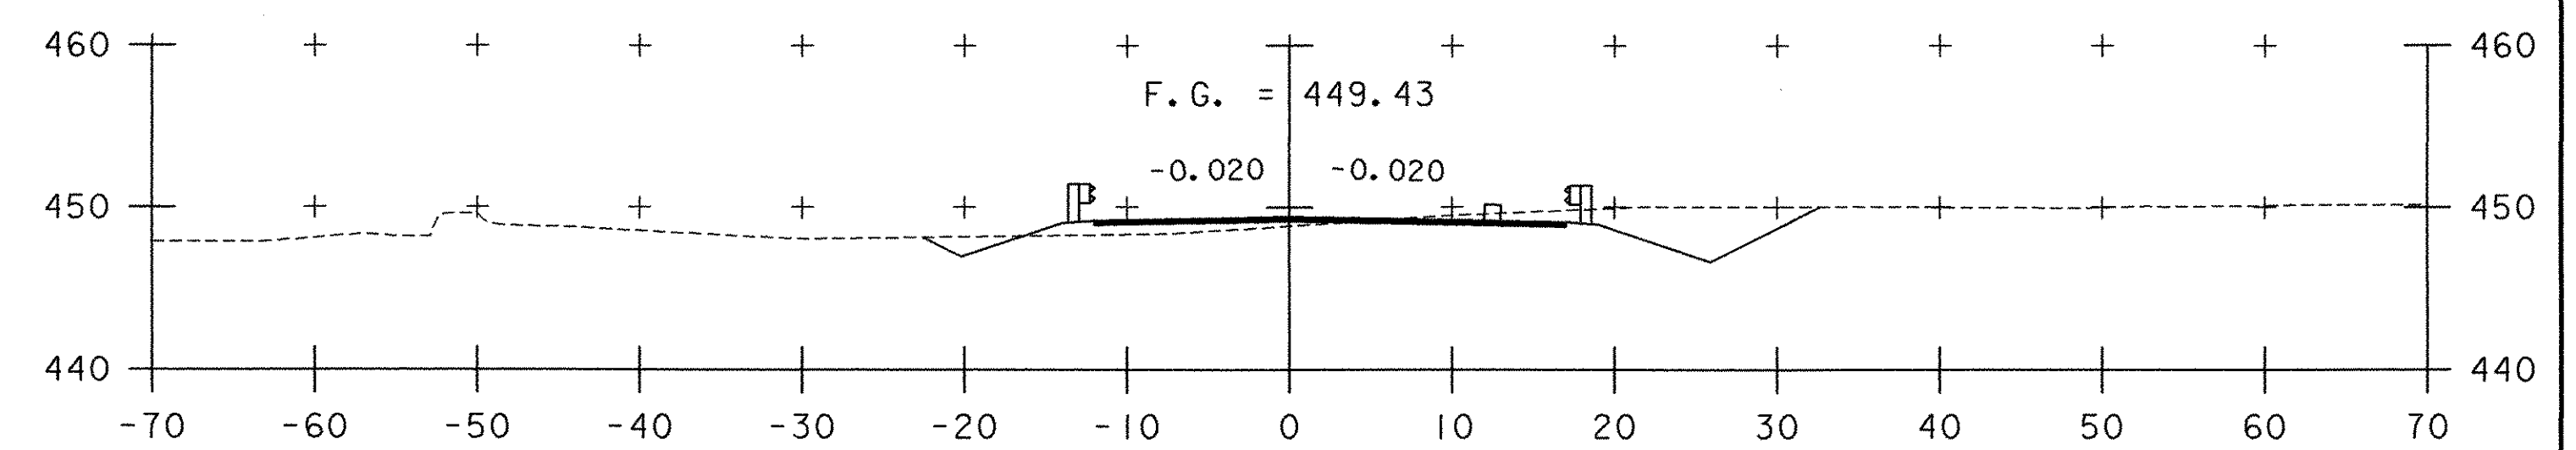

103+25

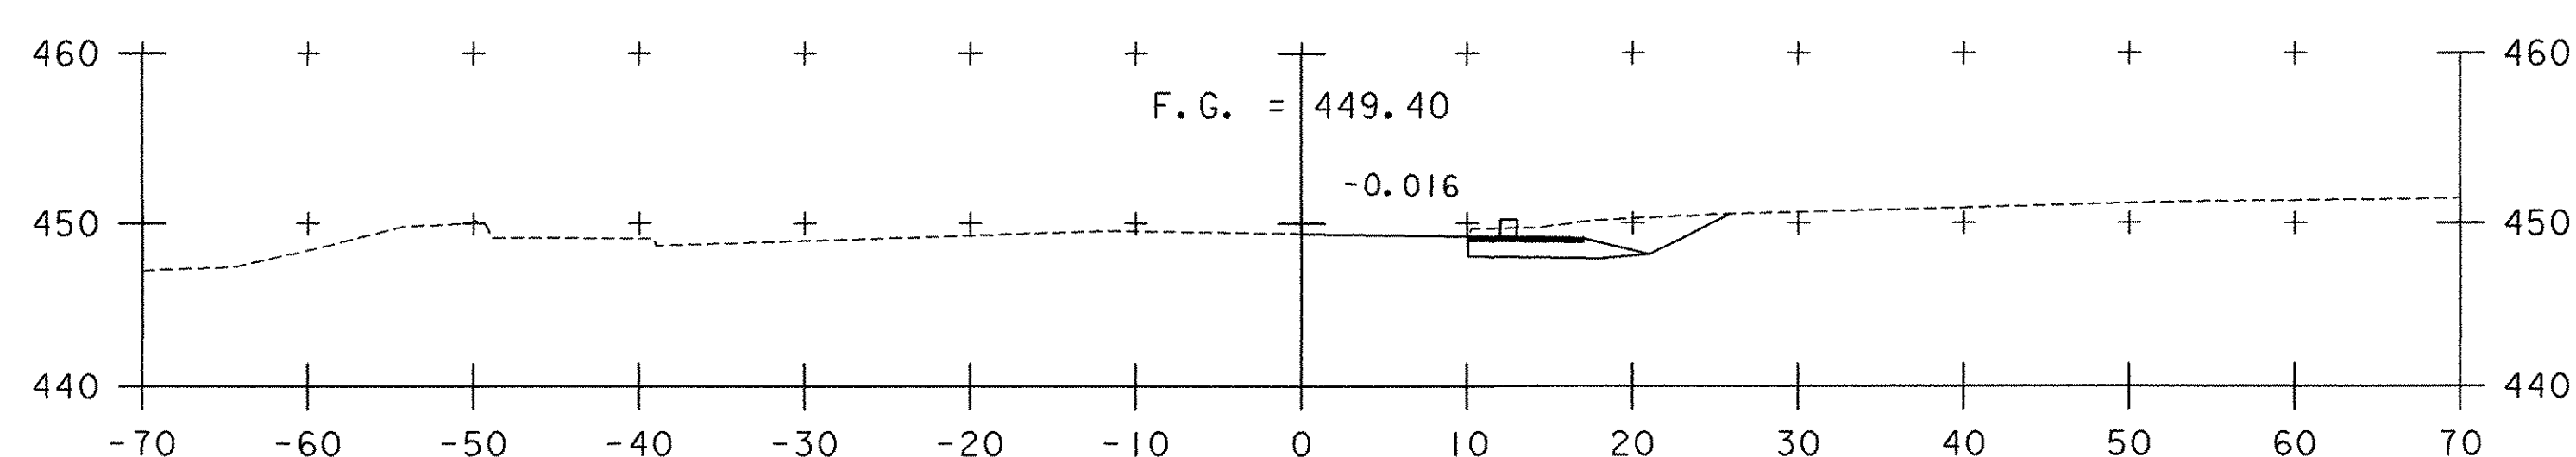

102+00

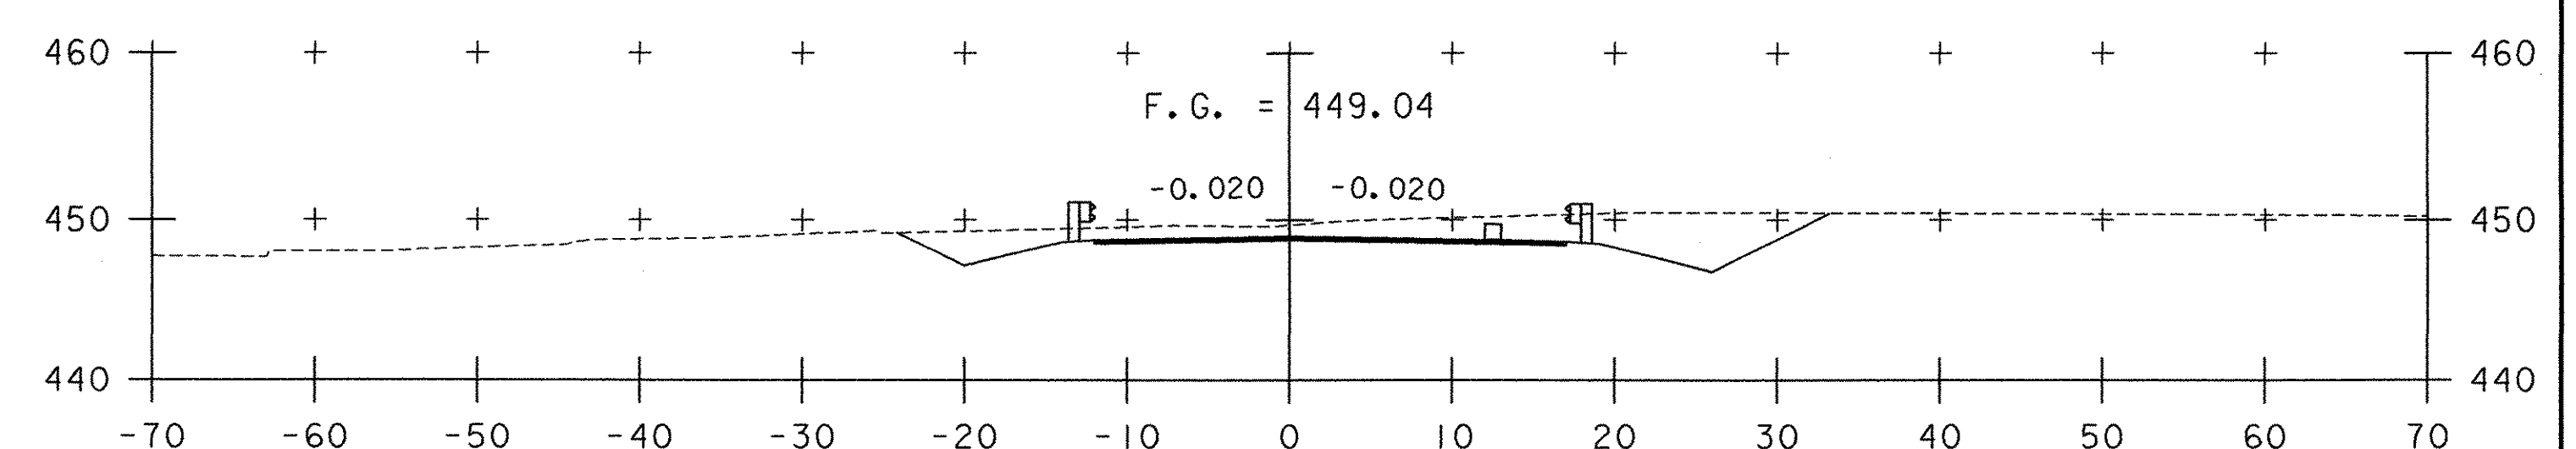


103+00

STA. 102+00 TO STA. 103+75




PROJECT NAME:	RICHFORD
PROJECT NUMBER:	BHF 0302 (3) S
FILE NAME:	...Structures\Design\Rich-xsl.dwg
PROJECT LEADER:	MJC
DESIGNED BY:	SEB
DETOUR CROSS SECTIONS - 1	
PRINT DATE:	12/18/2007
DRAWN BY:	
CHECKED BY:	MJC
SHEET	39 OF 41

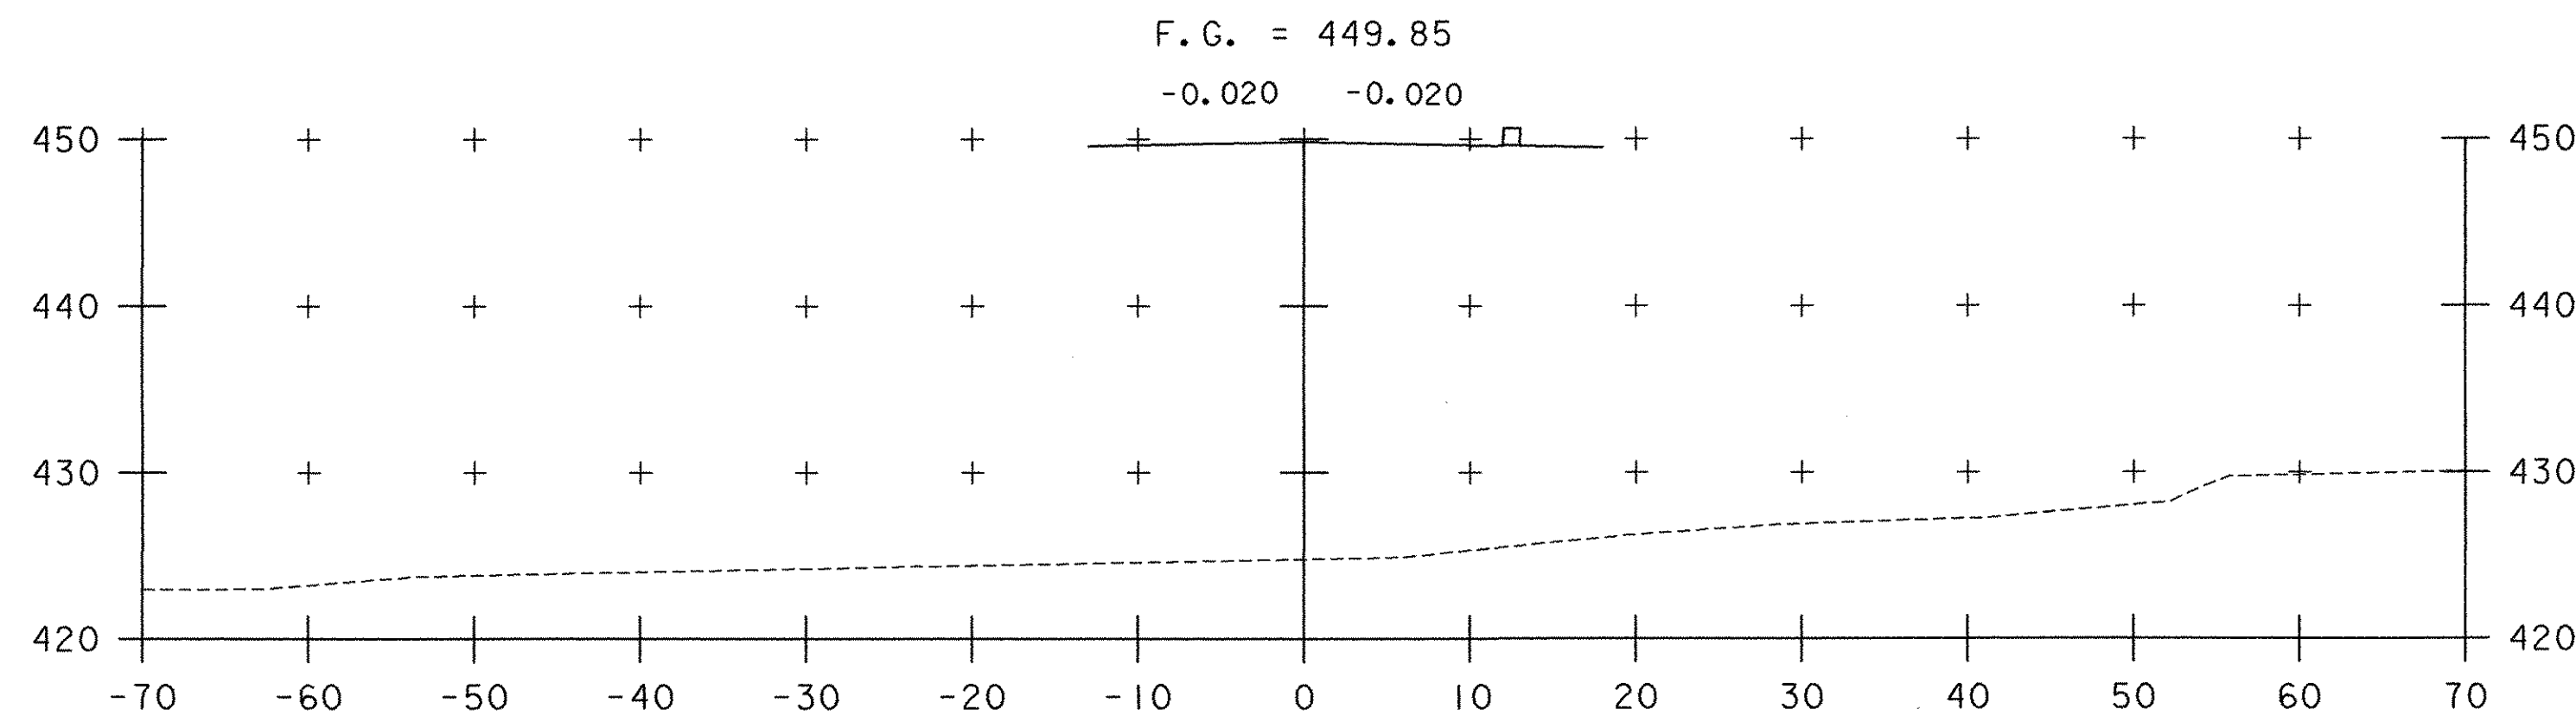


104+50

F. G. = 449.85
-0.020 -0.020

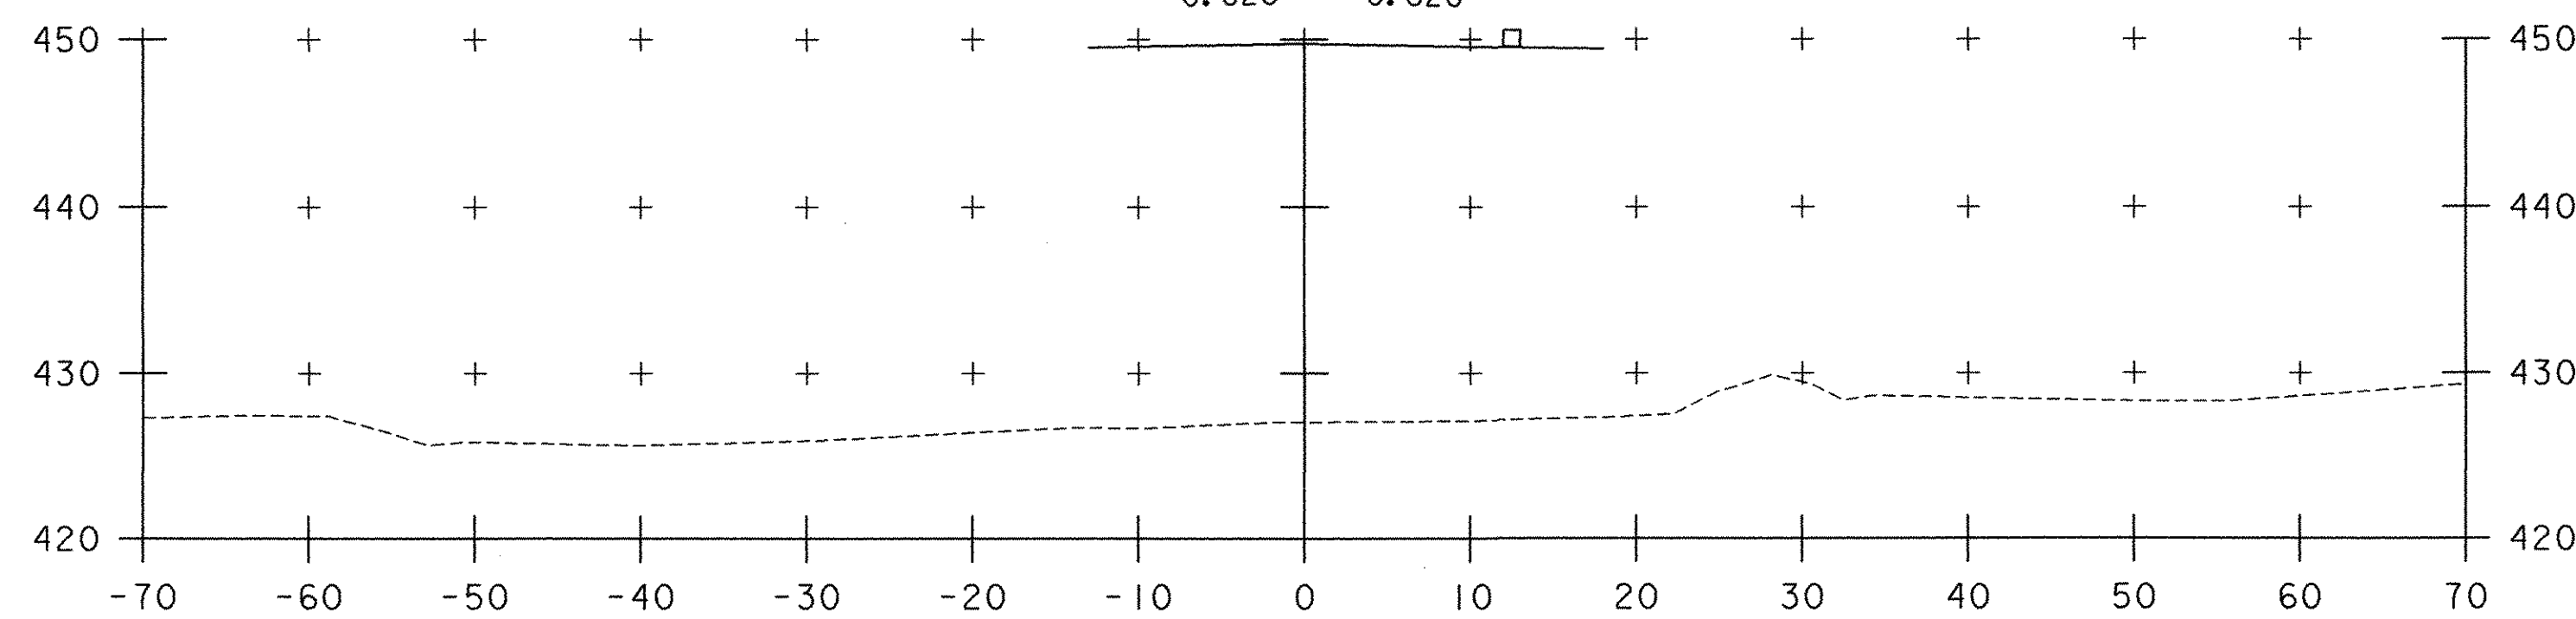


104+25

F. G. = 449.78
-0.020 -0.020

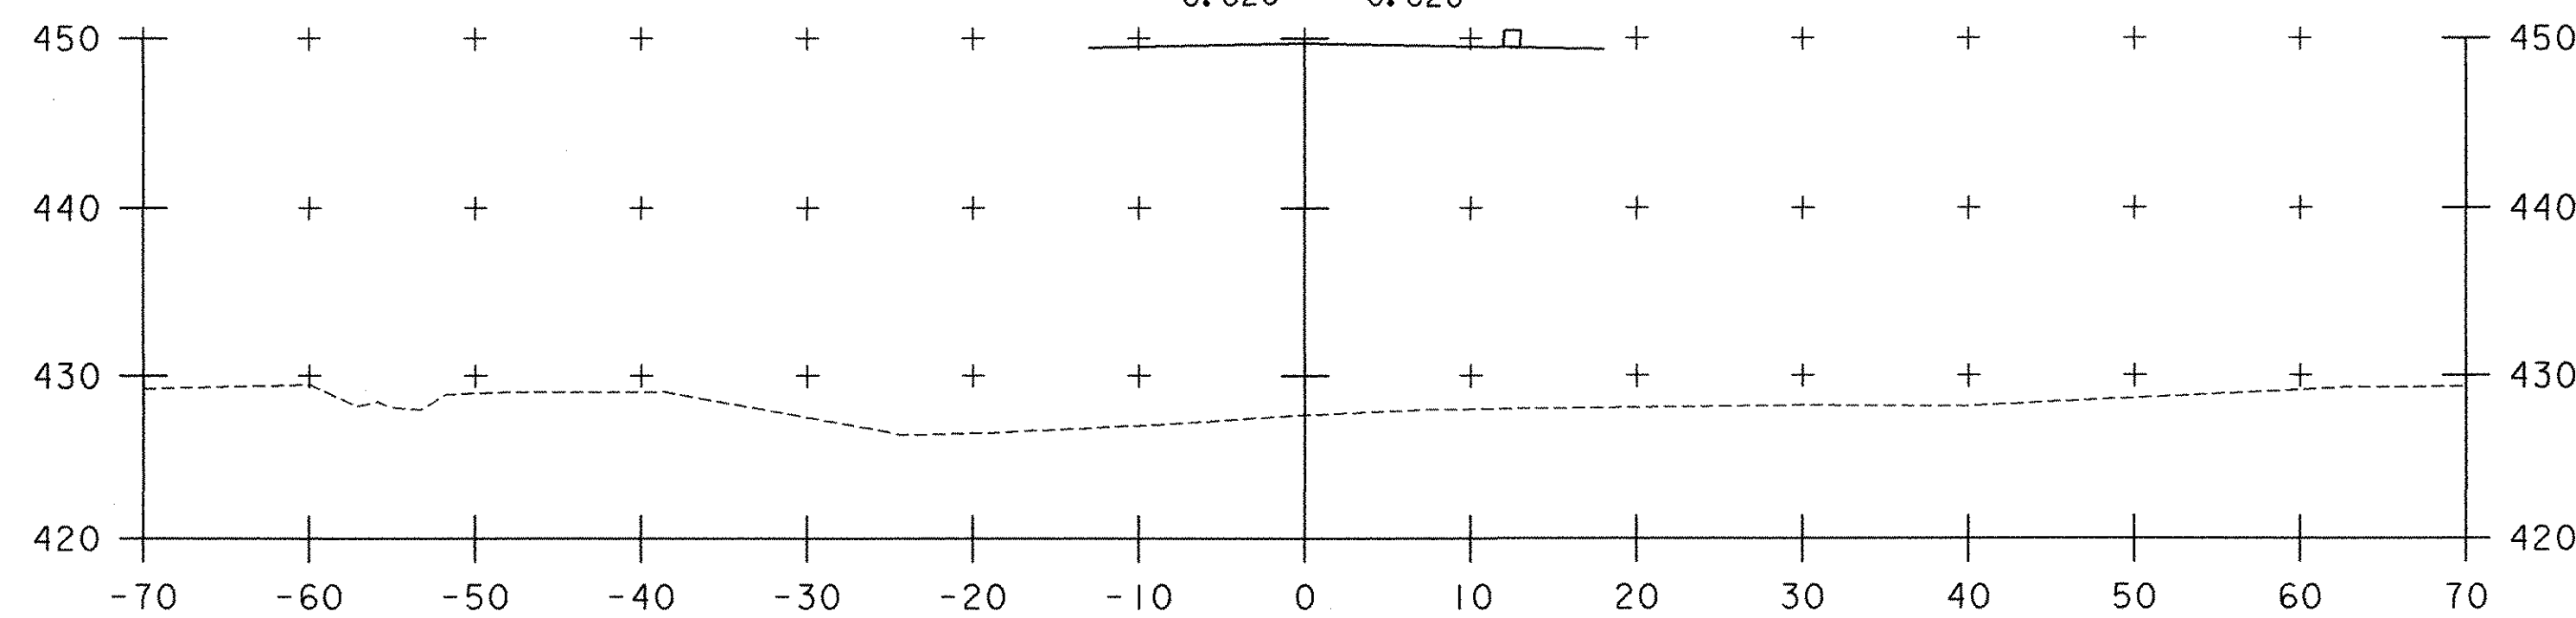


104+00

F. G. = 449.71
-0.020 -0.020

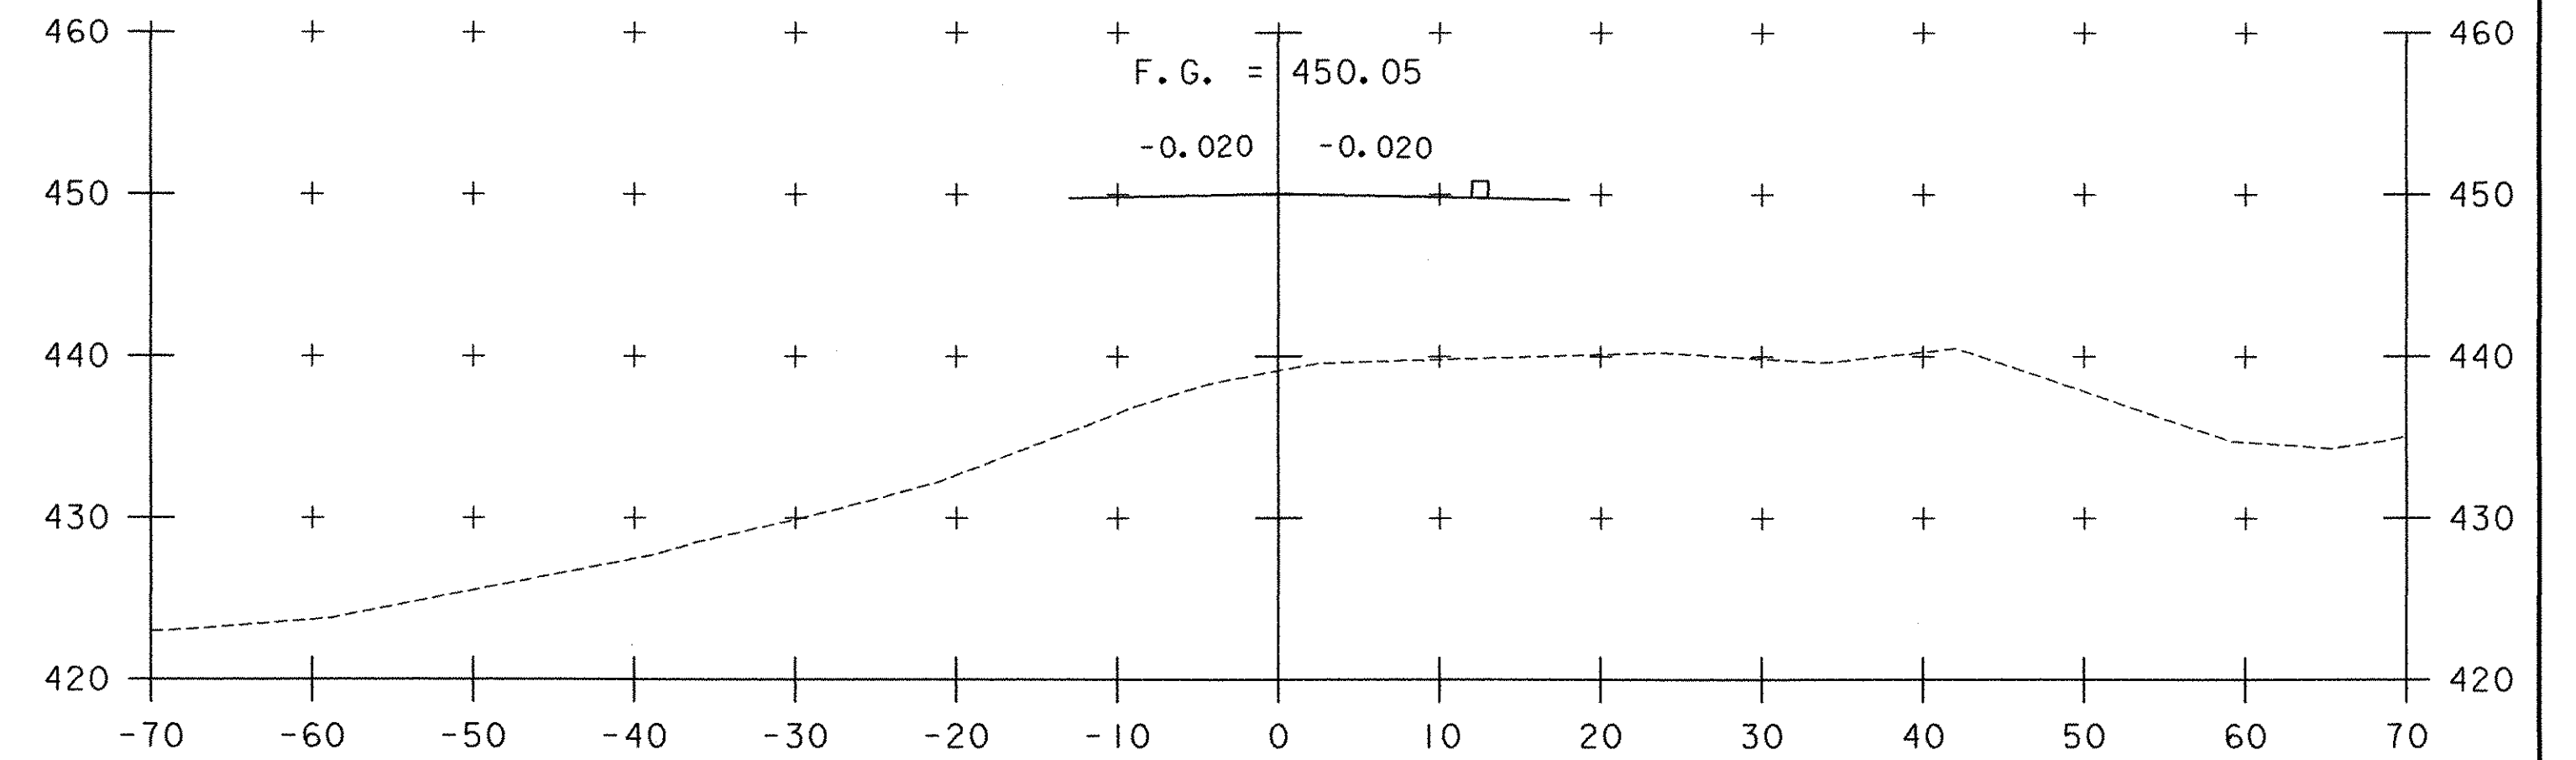


105+25

F. G. = 450.05
-0.020 -0.020

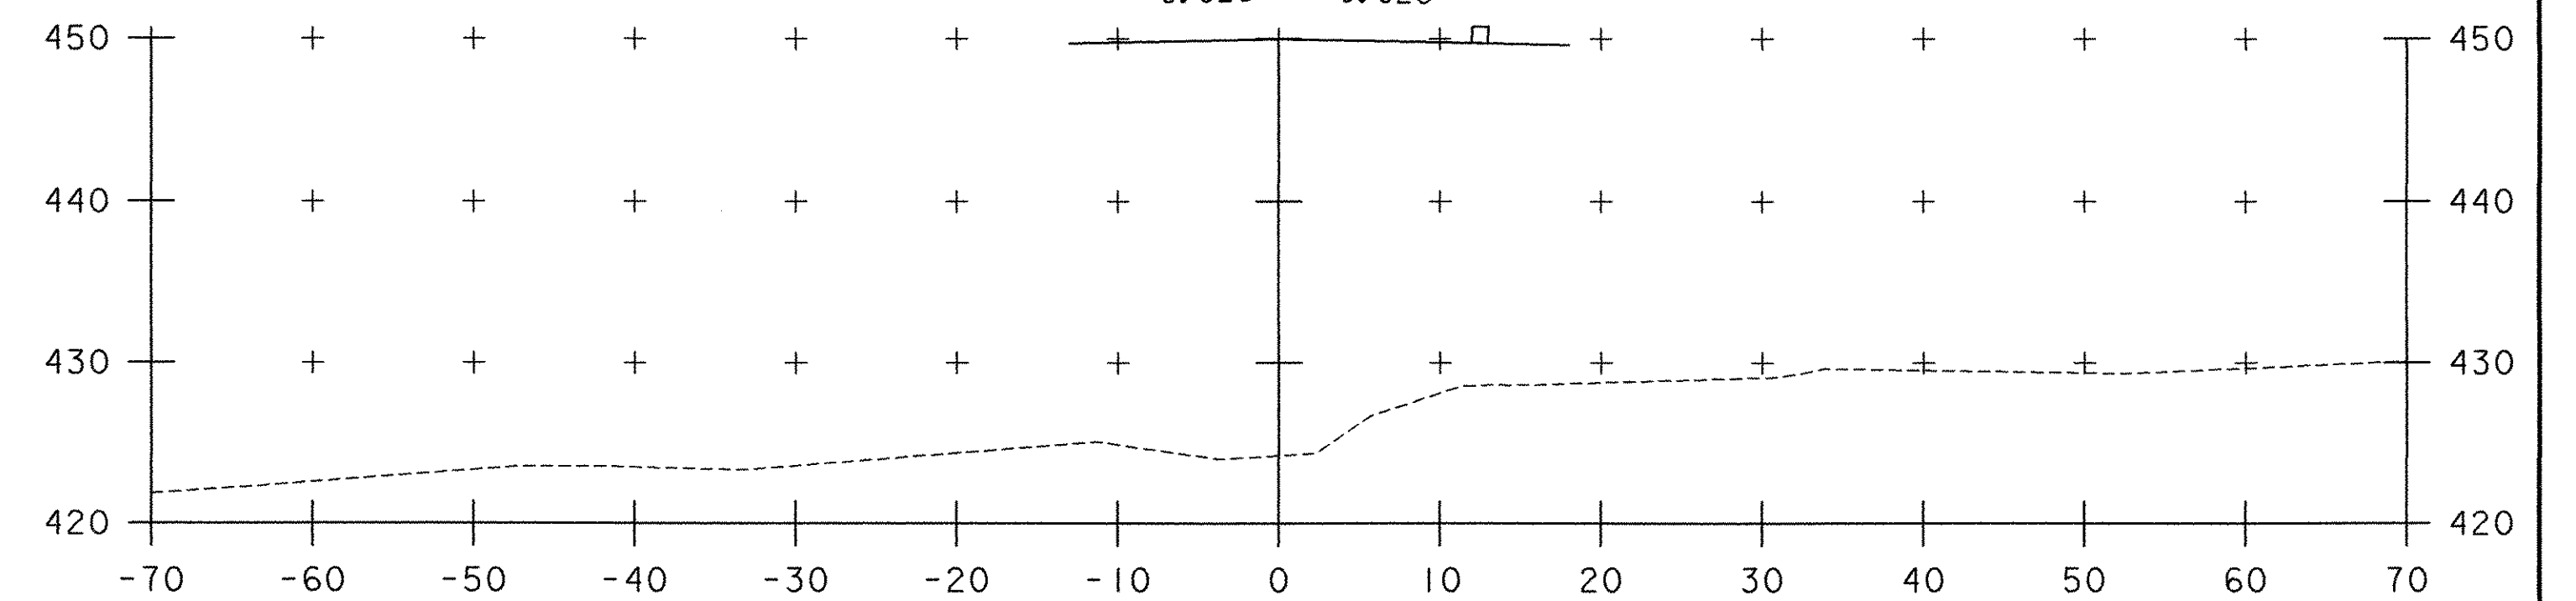

105+00

F. G. = 449.99
-0.020 -0.020

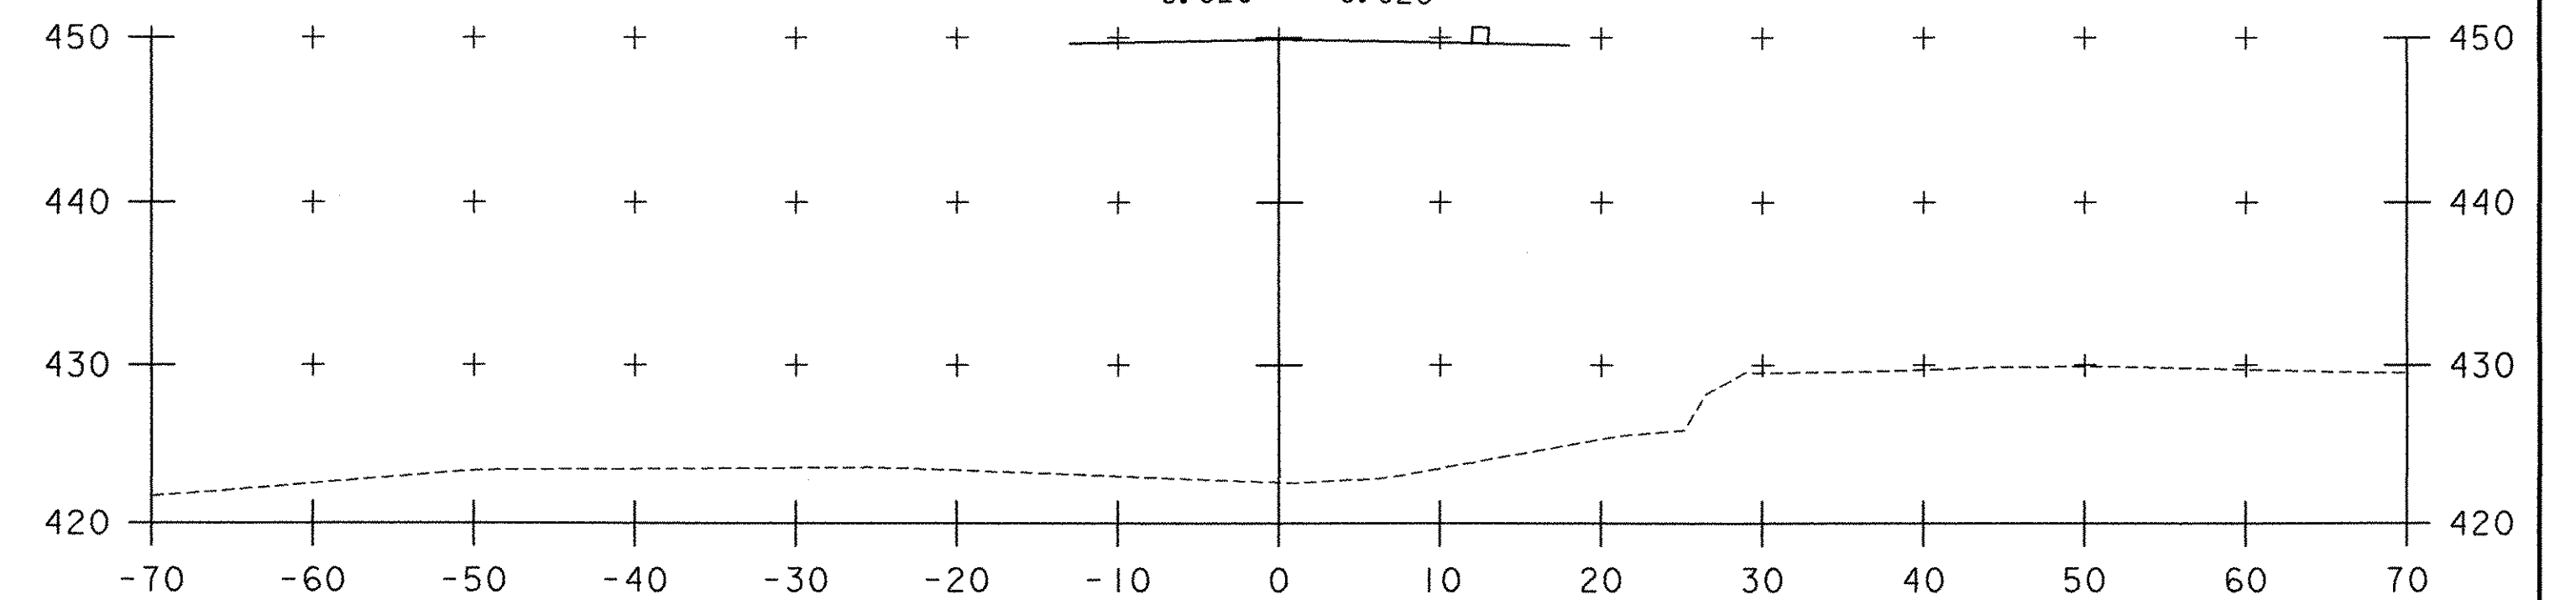


104+75

F. G. = 449.92
-0.020 -0.020


STA. 104+00 TO STA. 105+25




PROJECT NAME:	RICHFORD
PROJECT NUMBER:	BHF 0302 (3) S
FILE NAME:	... \Structures \Design \Rich-xsl.dwg
PROJECT LEADER:	MJC
DESIGNED BY:	SEB
DETOUR CROSS SECTIONS - 2	
PRINT DATE:	12/18/2007
DRAWN BY:	
CHECKED BY:	MJC
SHEET	40 OF 41

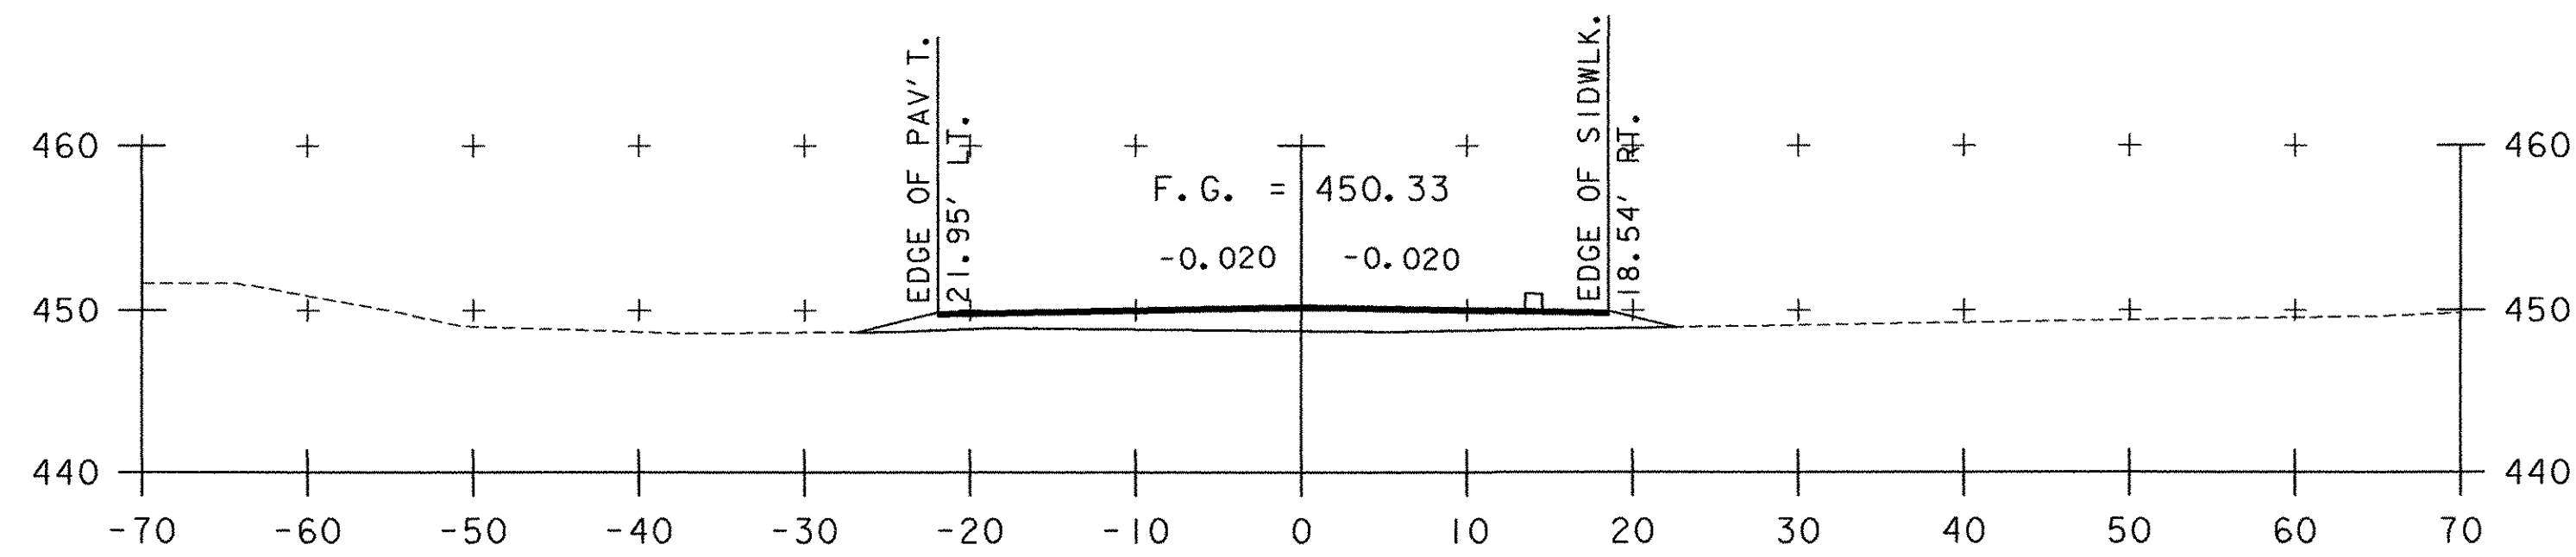


106+25

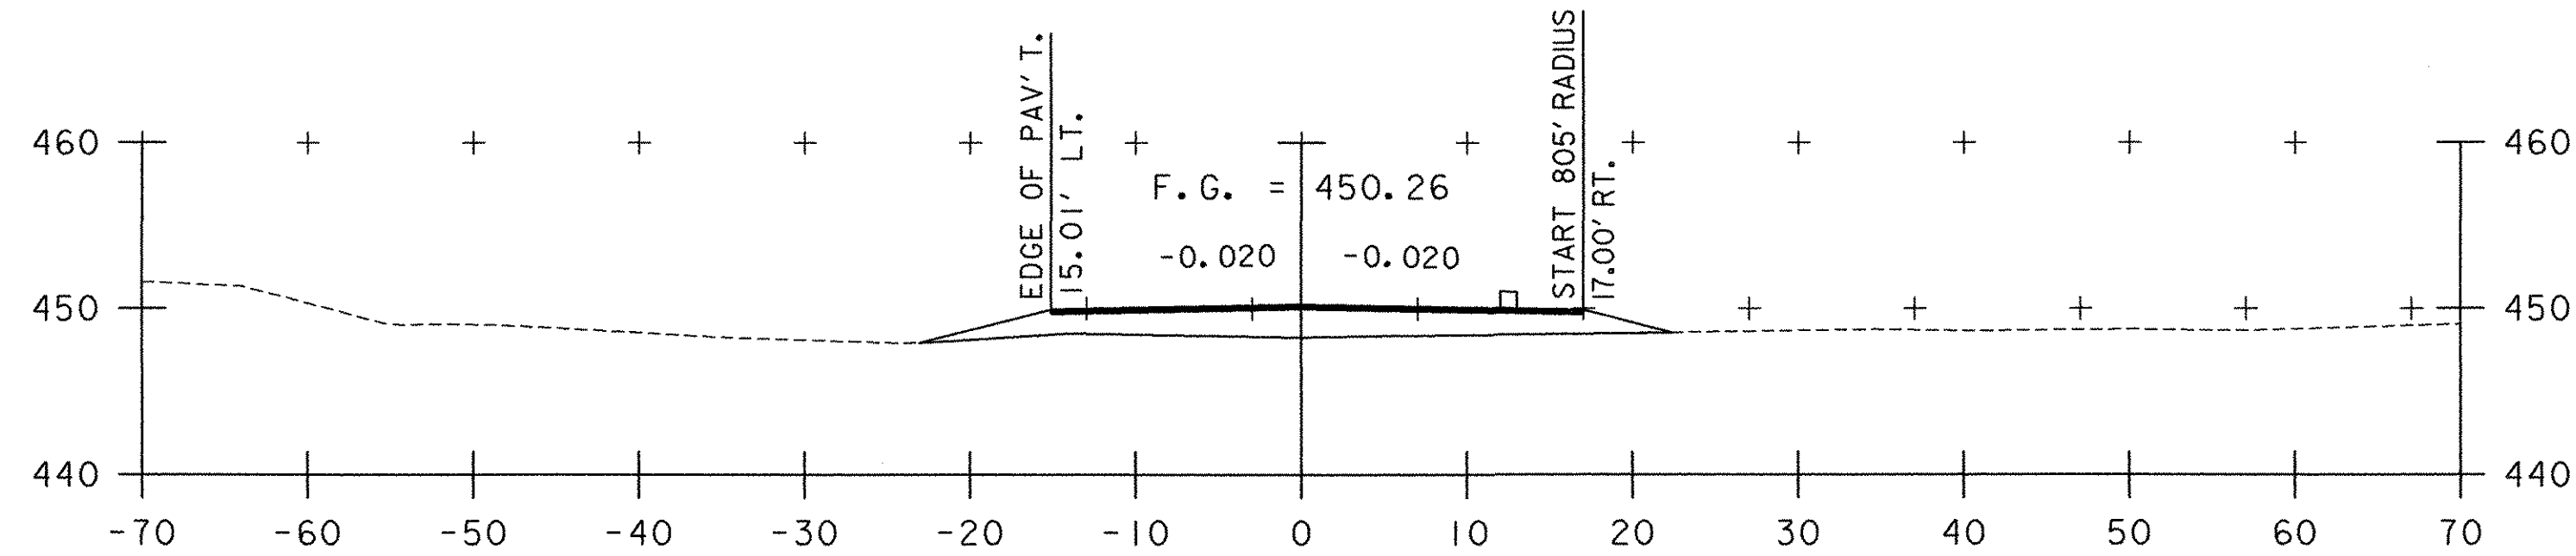


106+00

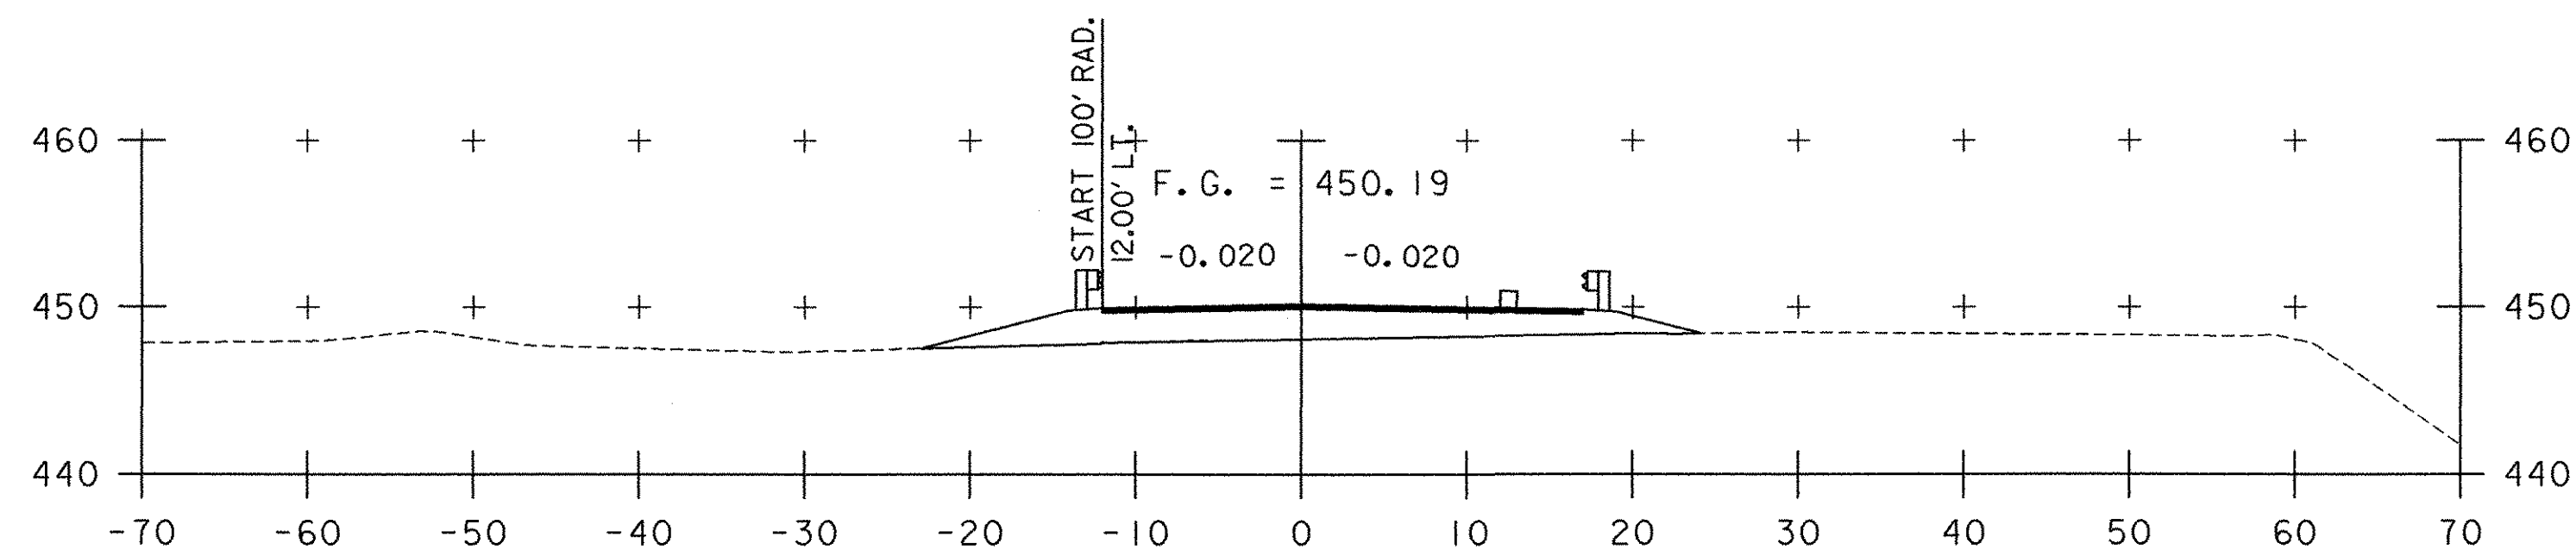


105+75

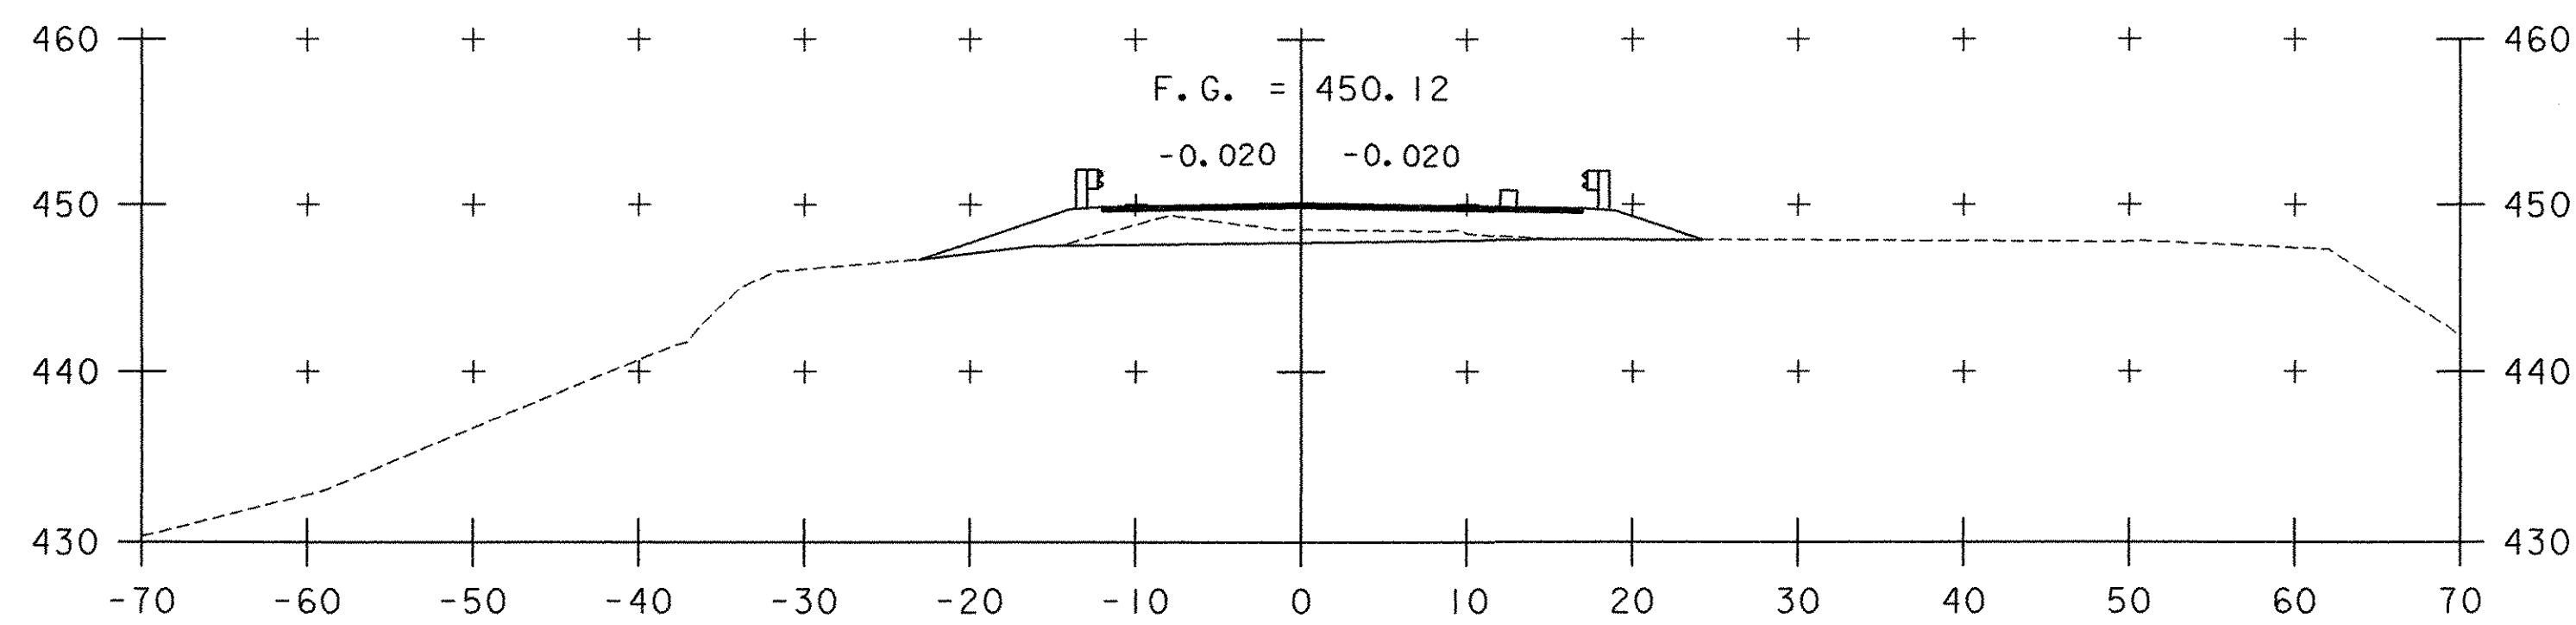


105+50

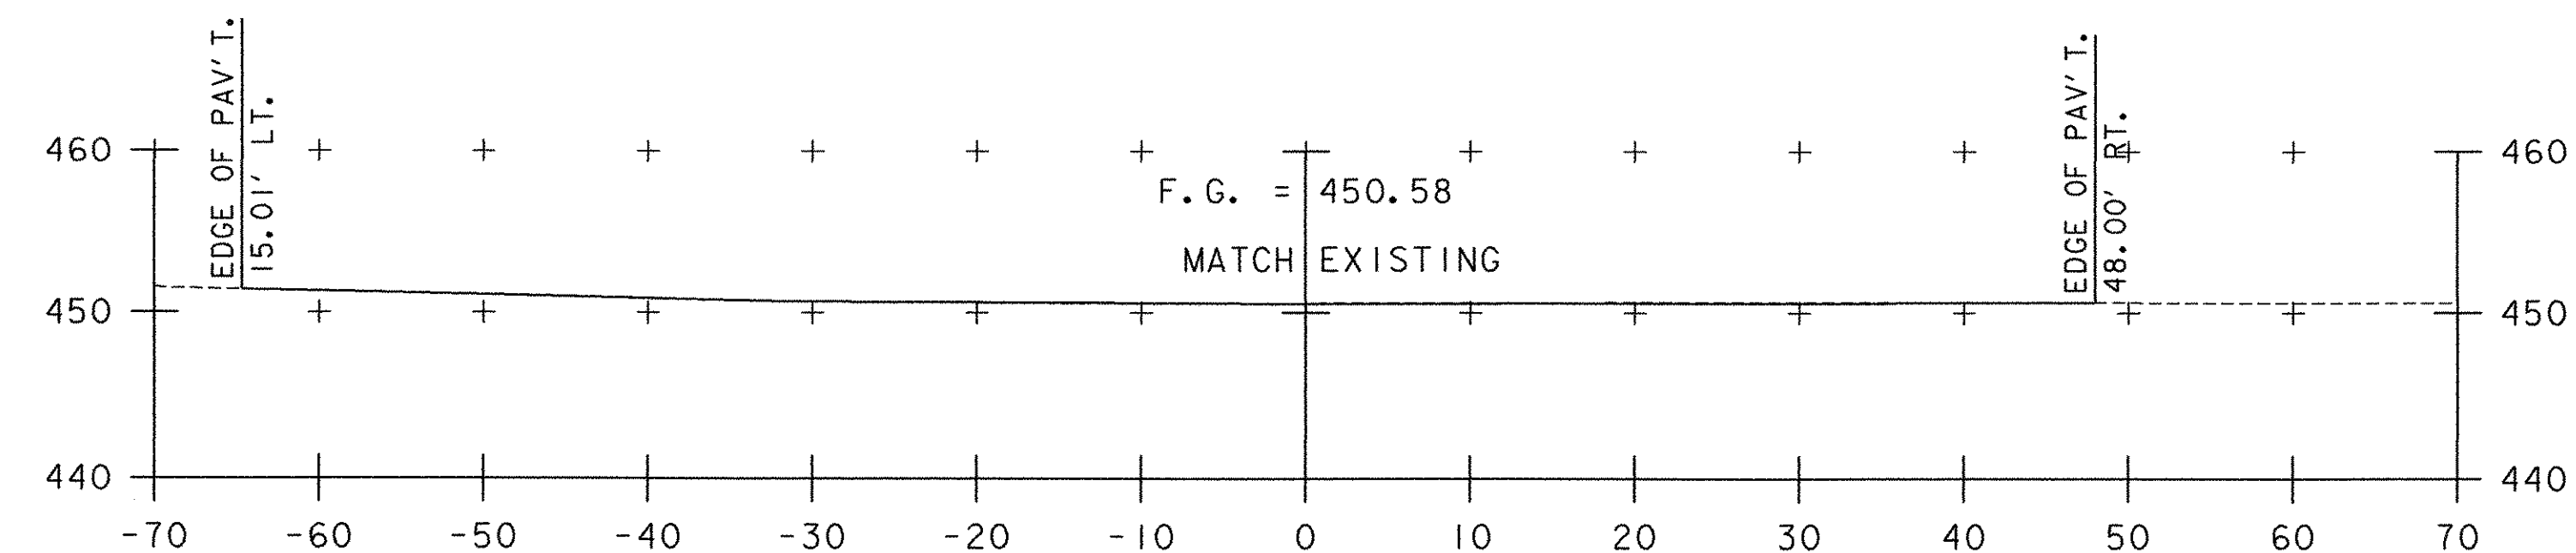


107+18.49

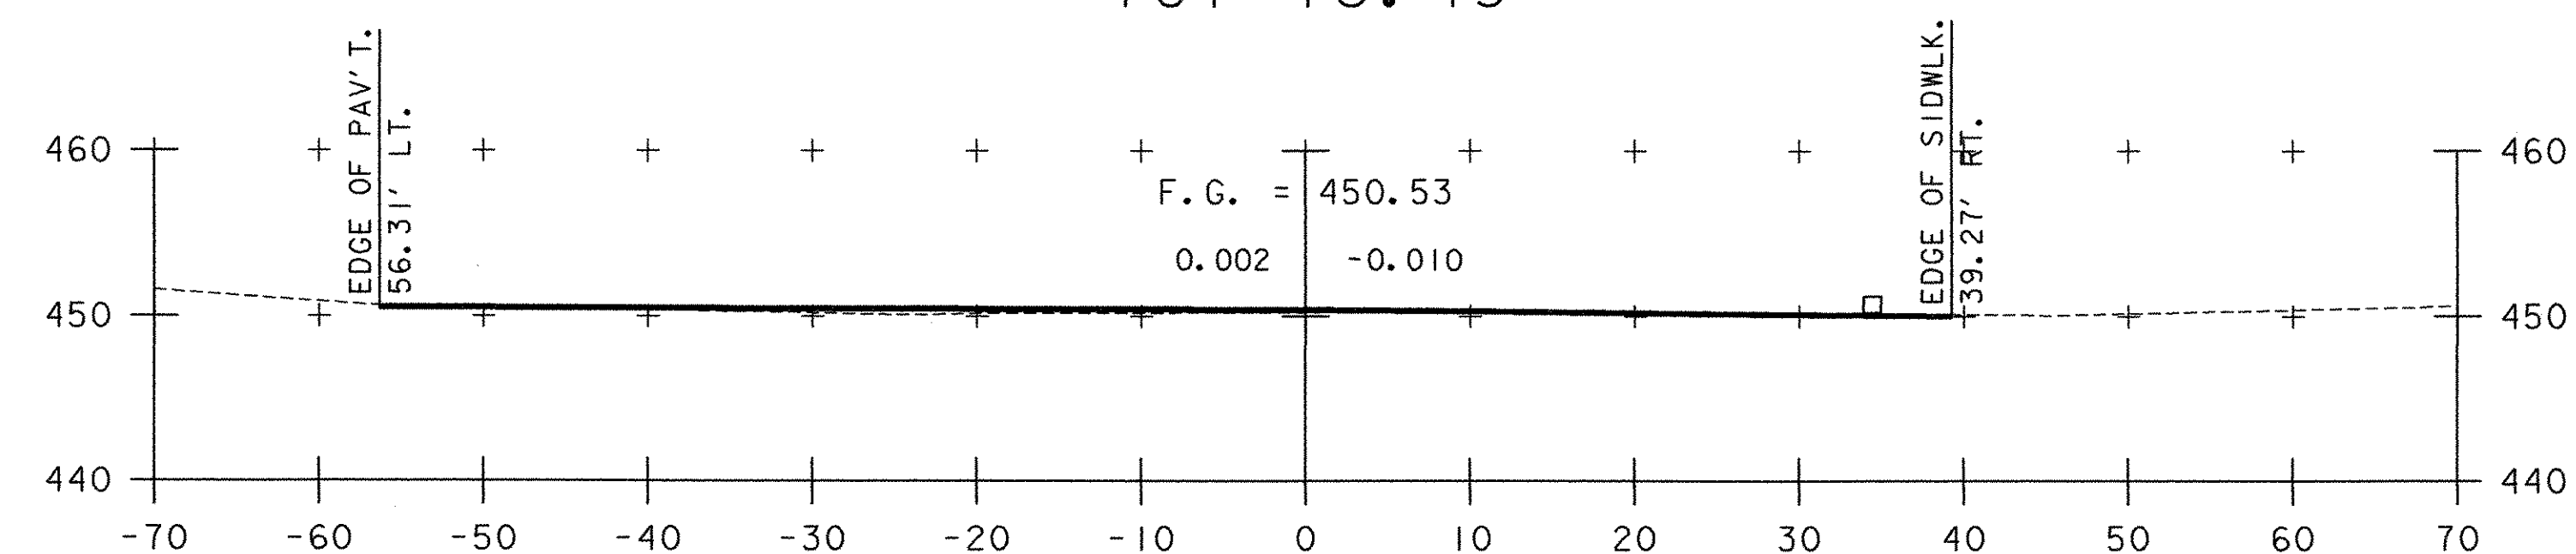

107+00

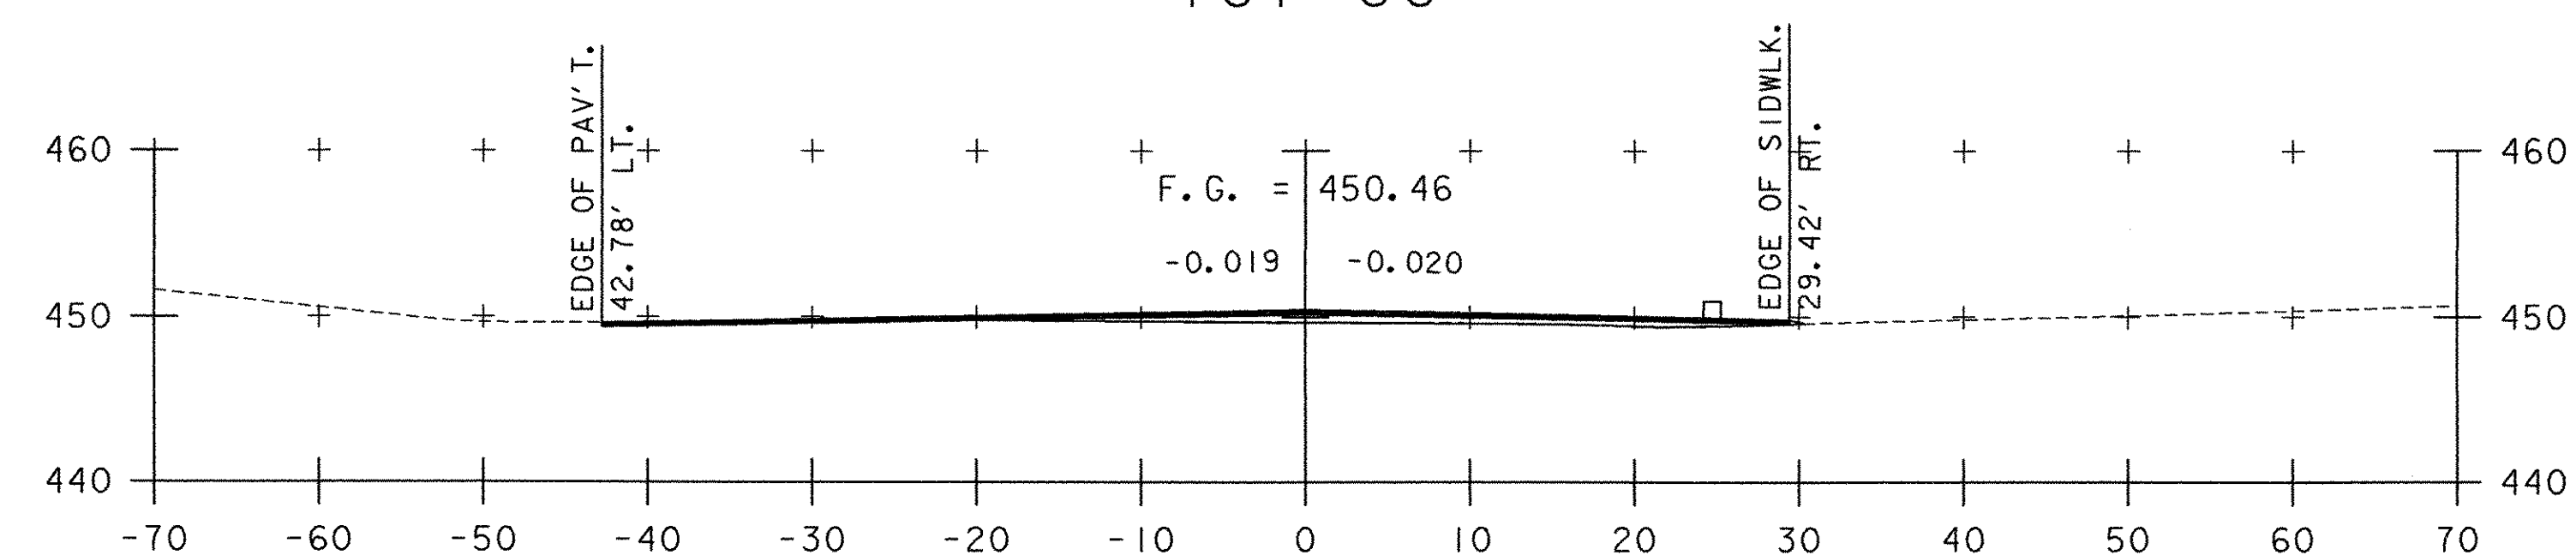

106+75

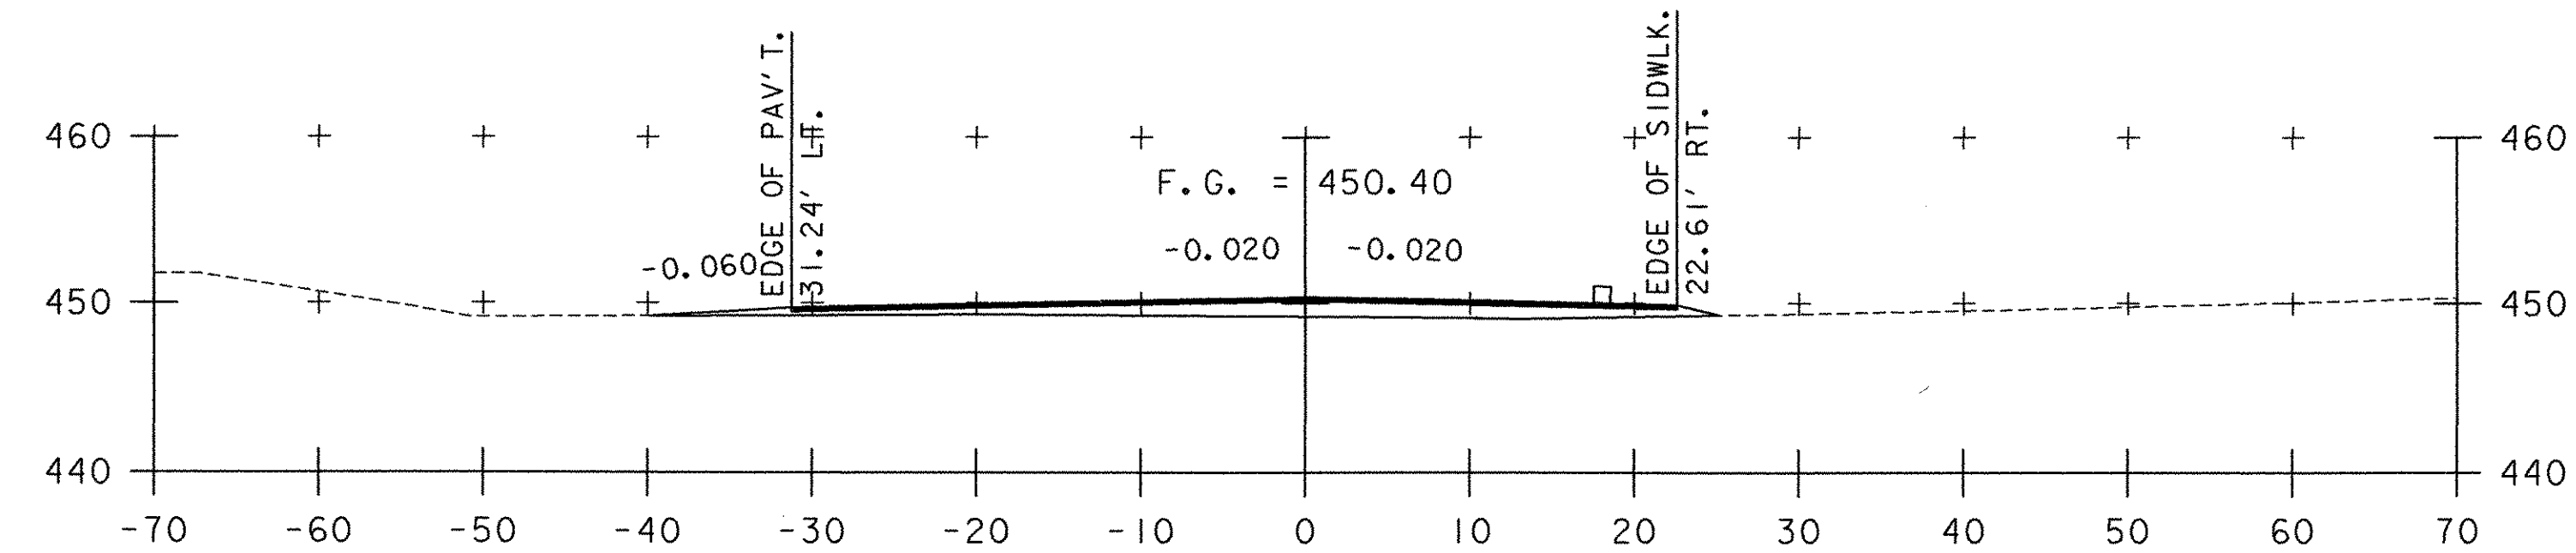


106+50




PROJECT NAME: RICHFORD
 PROJECT NUMBER: BHF 0302 (3) S
 FILE NAME: ...\Structures\Design\Rich-xsl...
 PROJECT LEADER: MJC
 DESIGNED BY: SEB
 DRAWN BY:
 CHECKED BY: MJC
 SHEET 41 OF 41

STA. 105+50 TO STA. 107+18.49

DETOUR CROSS SECTIONS - 3

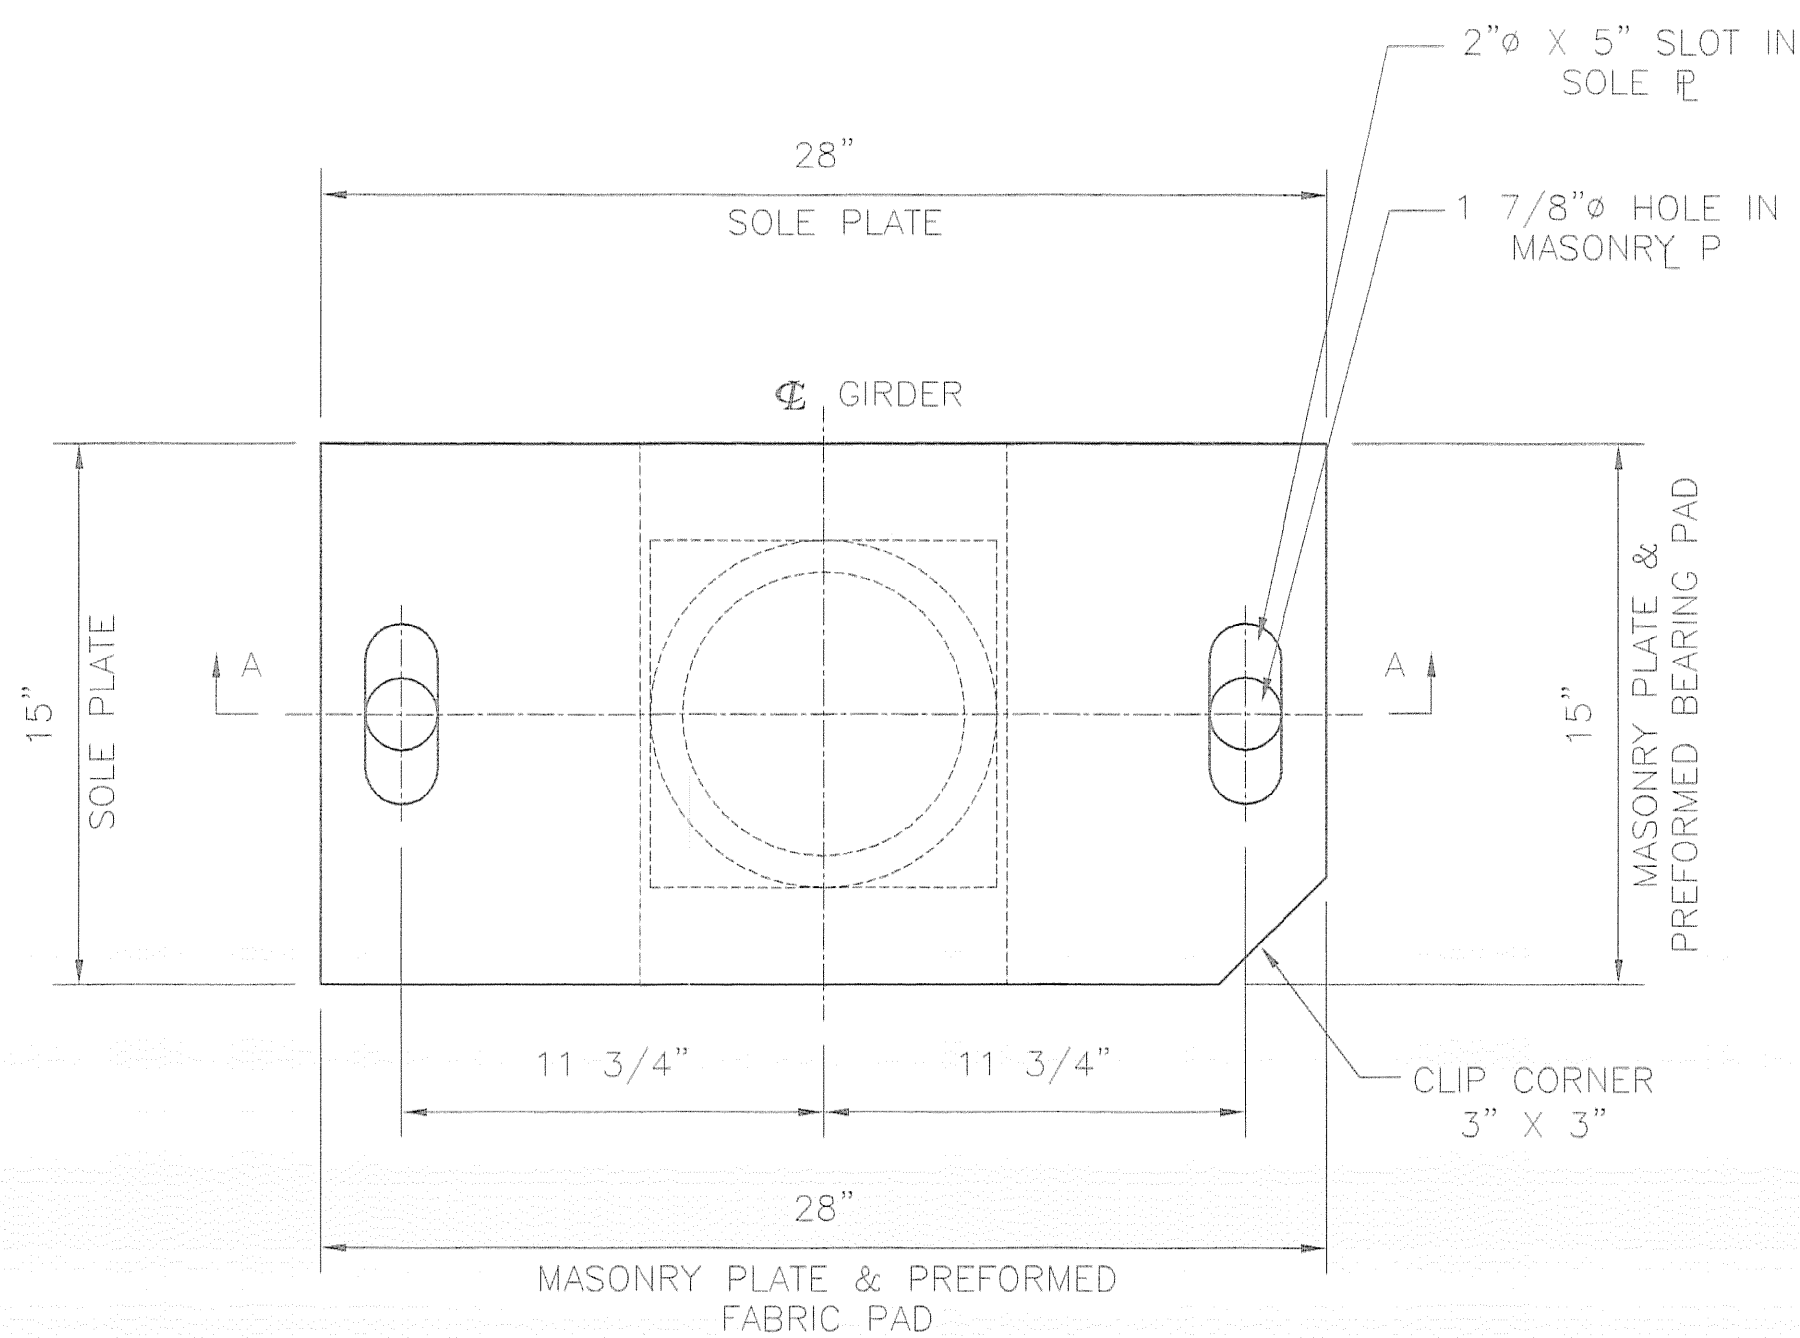


PLAN

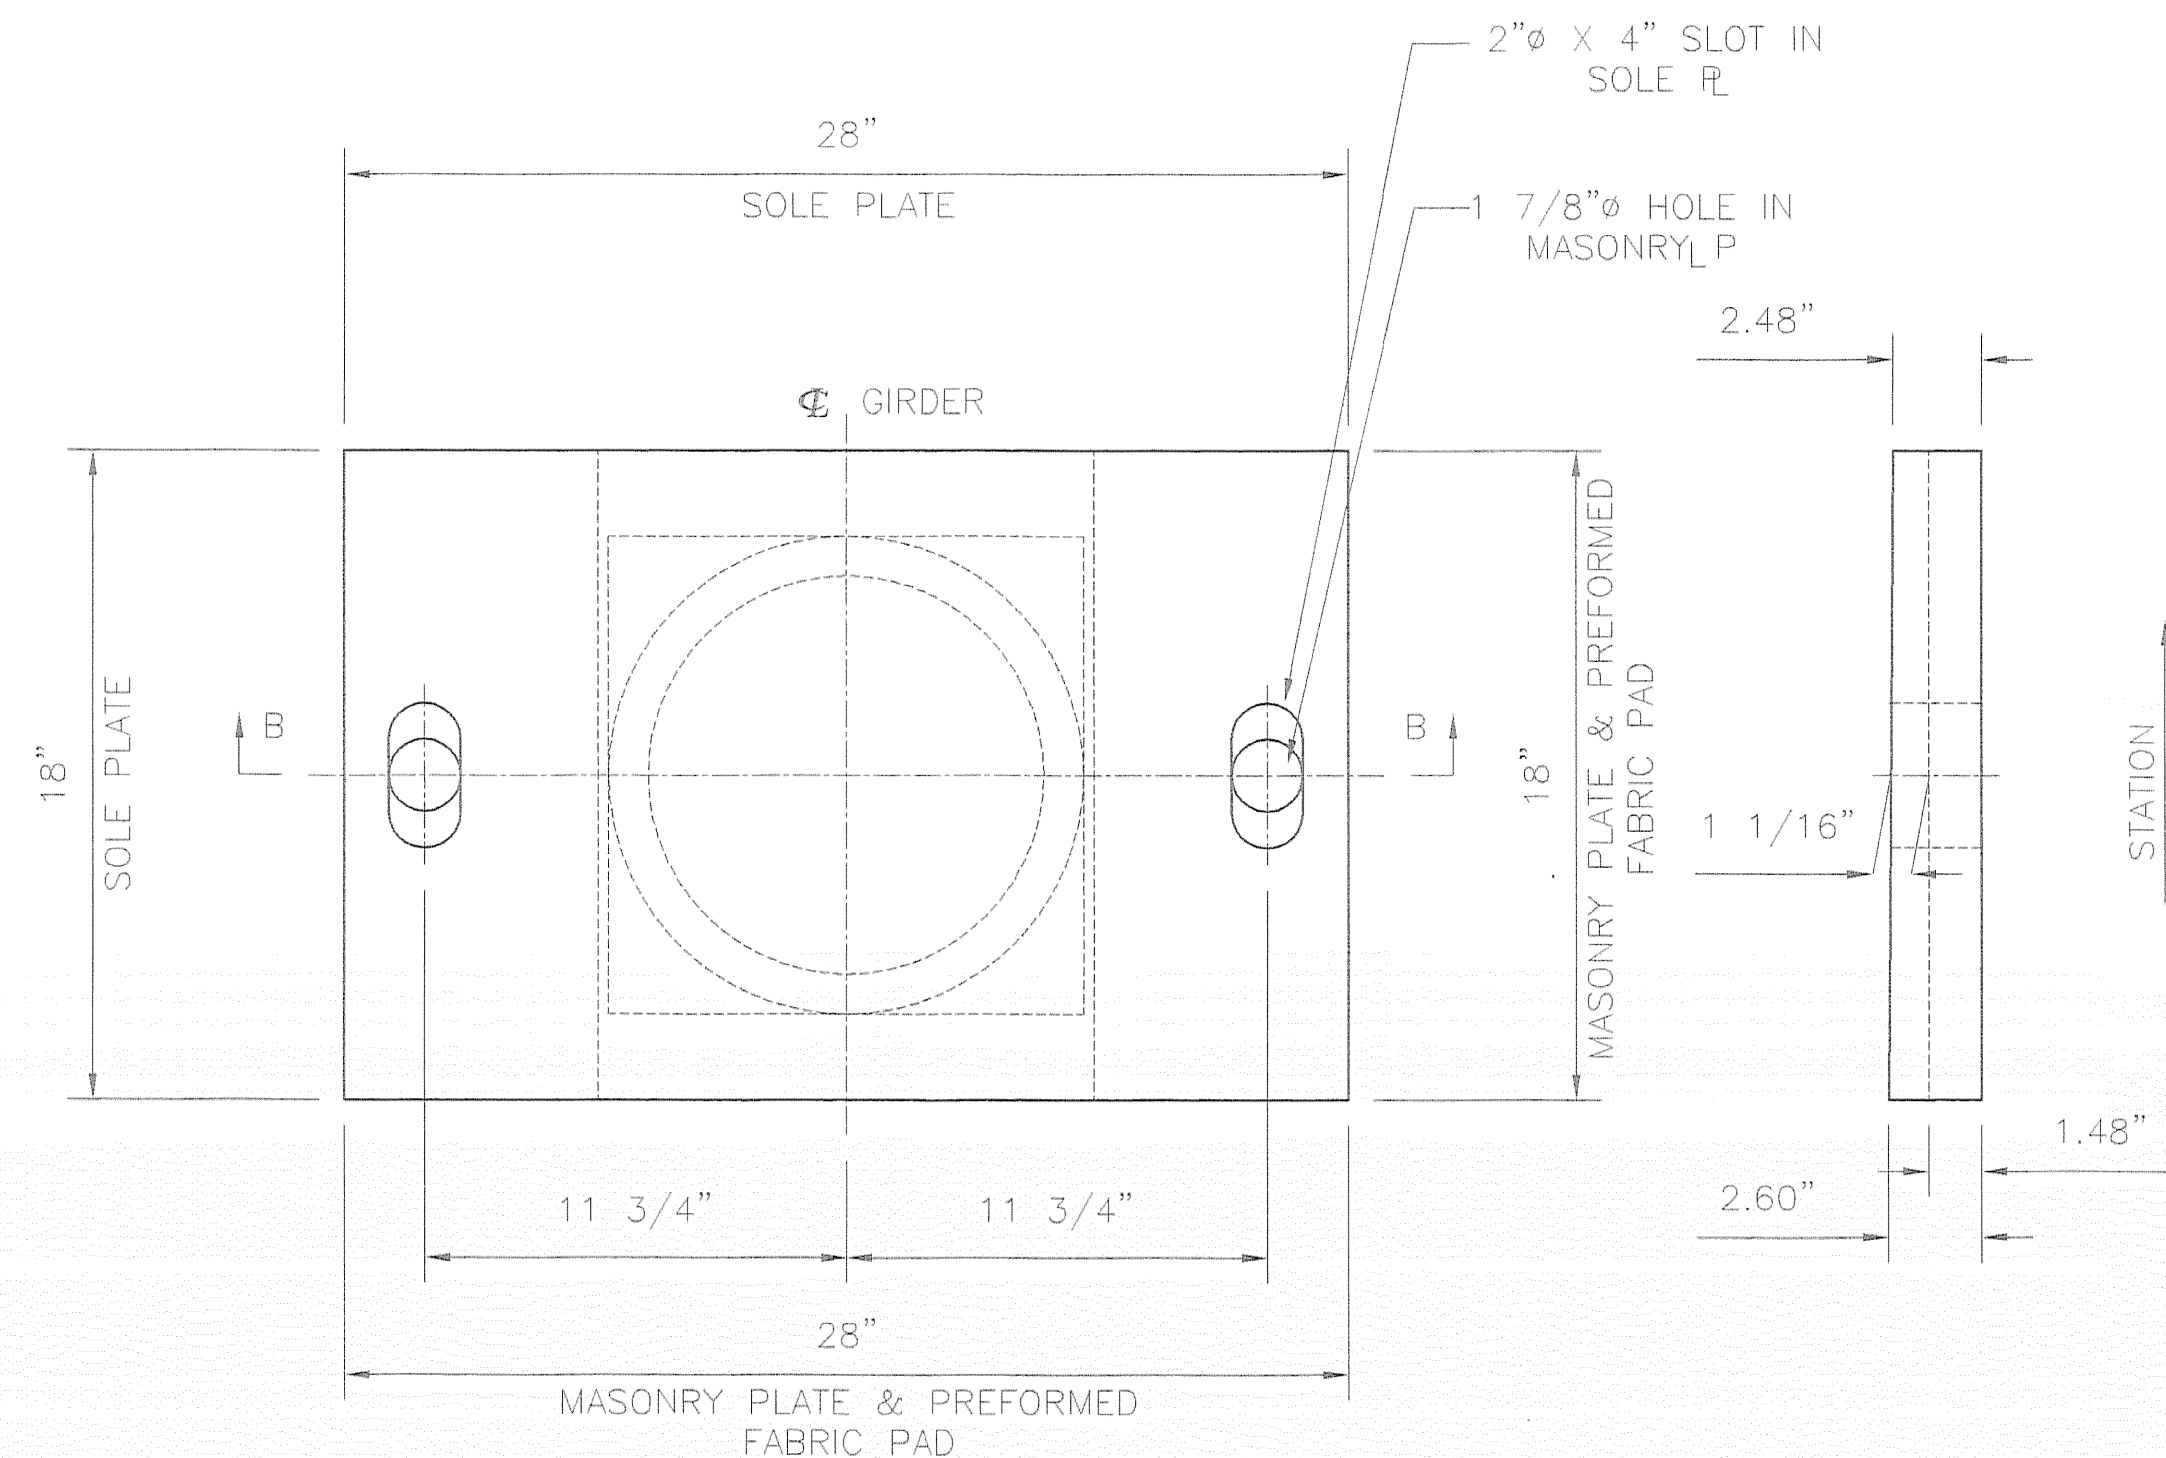


PLAN

SIDE ELEVATION

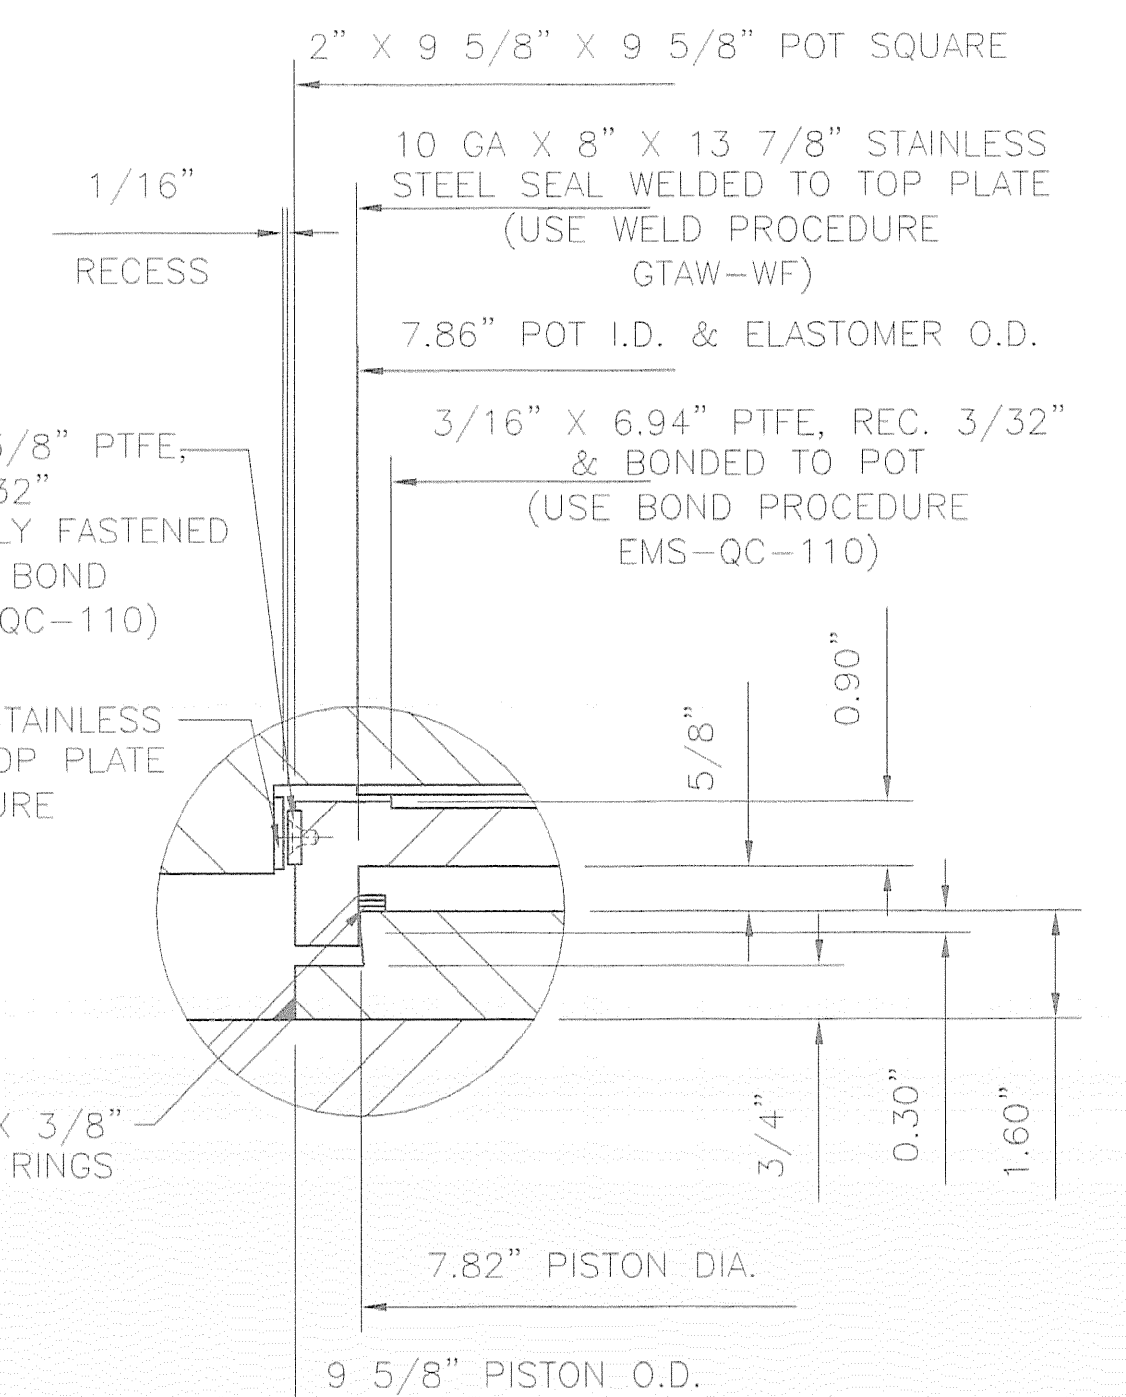

DETAIL A
N.T.S.

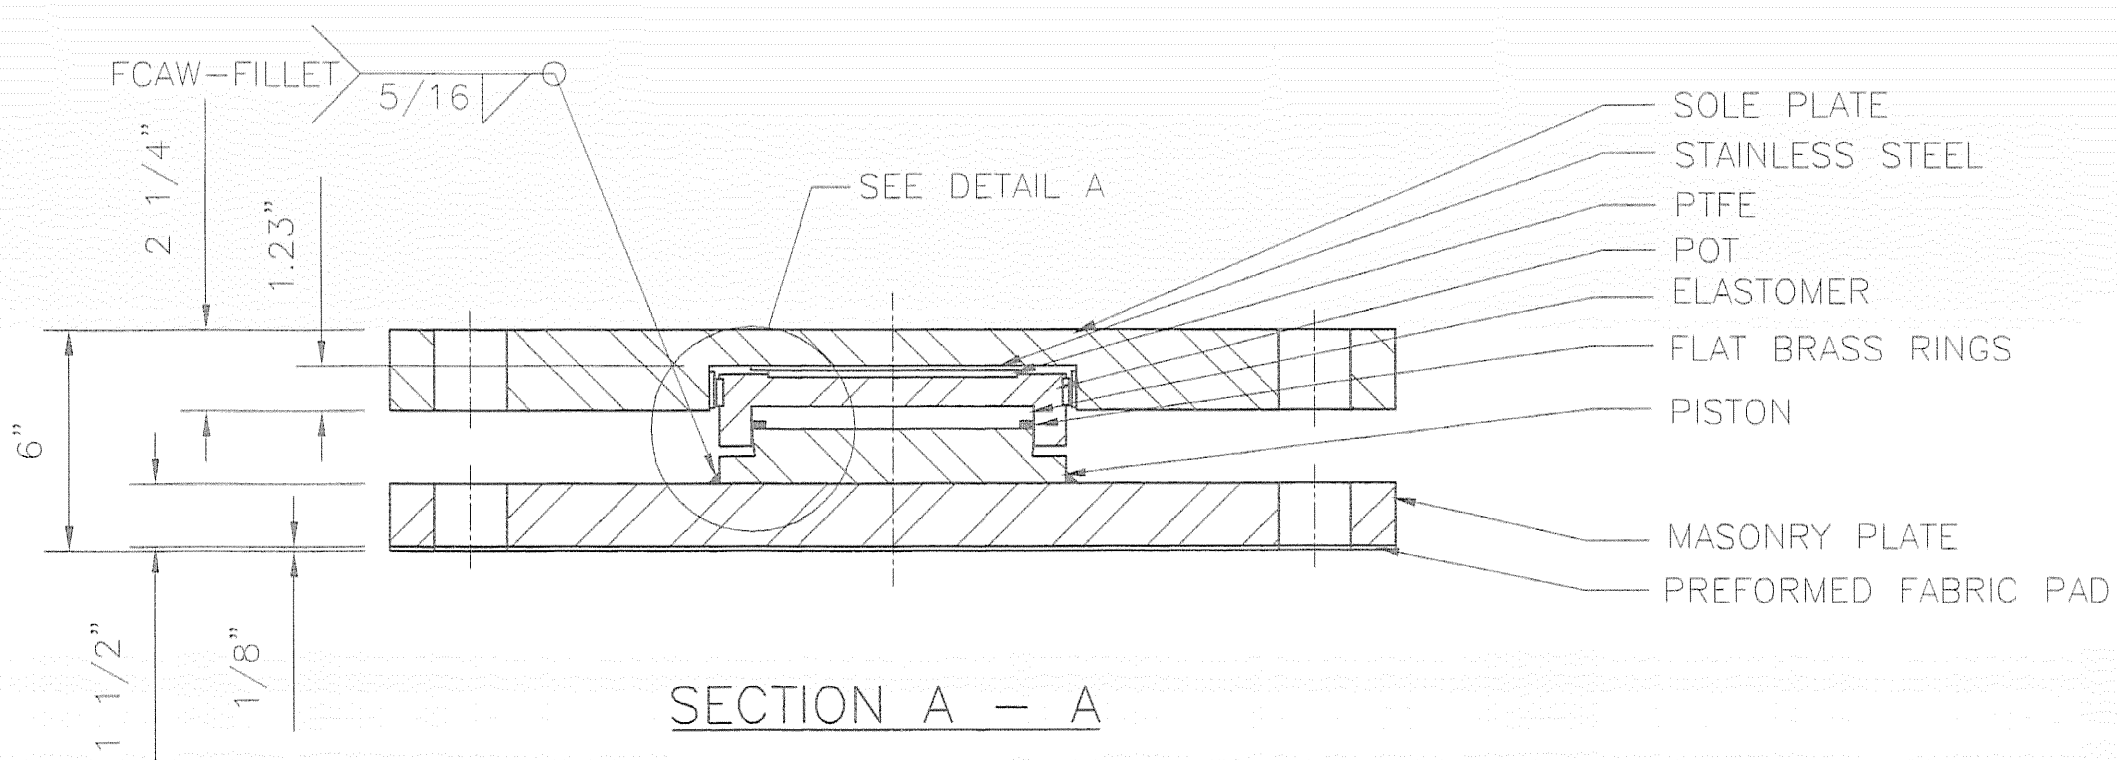


SECTION A - A

COSMEC GUIDED EXPANSION POT BEARING

QUANTITY: 2
 LOCATION: ABUTMENT 1, GIRDERS 2 & 3
 VERTICAL LOAD CAPACITY: 170 KIPS
 TRANSVERSE LOAD CAPACITY: 34 KIPS
 LONGITUDINAL LOAD CAPACITY: N/A
 MOVEMENT CAPACITY: 2 1/2"
 ROTATION CAPACITY: .020 RADIAN

BEARING NOTES

1. ALL MATERIALS USED IN THE FABRICATION OF THESE BEARINGS SHALL BE MADE IN THE U.S.A.
2. BEARINGS ARE TO BE SHIPPED AS COMPLETE UNITS, STEEL BANDED, AND SHALL BE WRAPPED TO PROTECT FROM MOISTURE AND DIRT DURING TRANSIT AND STORAGE.
3. LOCATION OF FABRICATION PLANT - 70 SOUTH STREET WALPOLE, MA 02081
4. COSMEC, INC. REPRESENTATIVE - MR. MATT McANDREWS (508) 668-6600
5. BEARINGS SHALL BE STORED IN A CLEAN, DRY, LEVEL UPRIGHT POSITION.
6. BEARINGS MUST NOT BE DISASSEMBLED
7. PROTECT PTFE & S.S. SURFACES FROM DIRT, WELD SPATTER, & ANY OTHER FOREIGN SUBSTANCES.

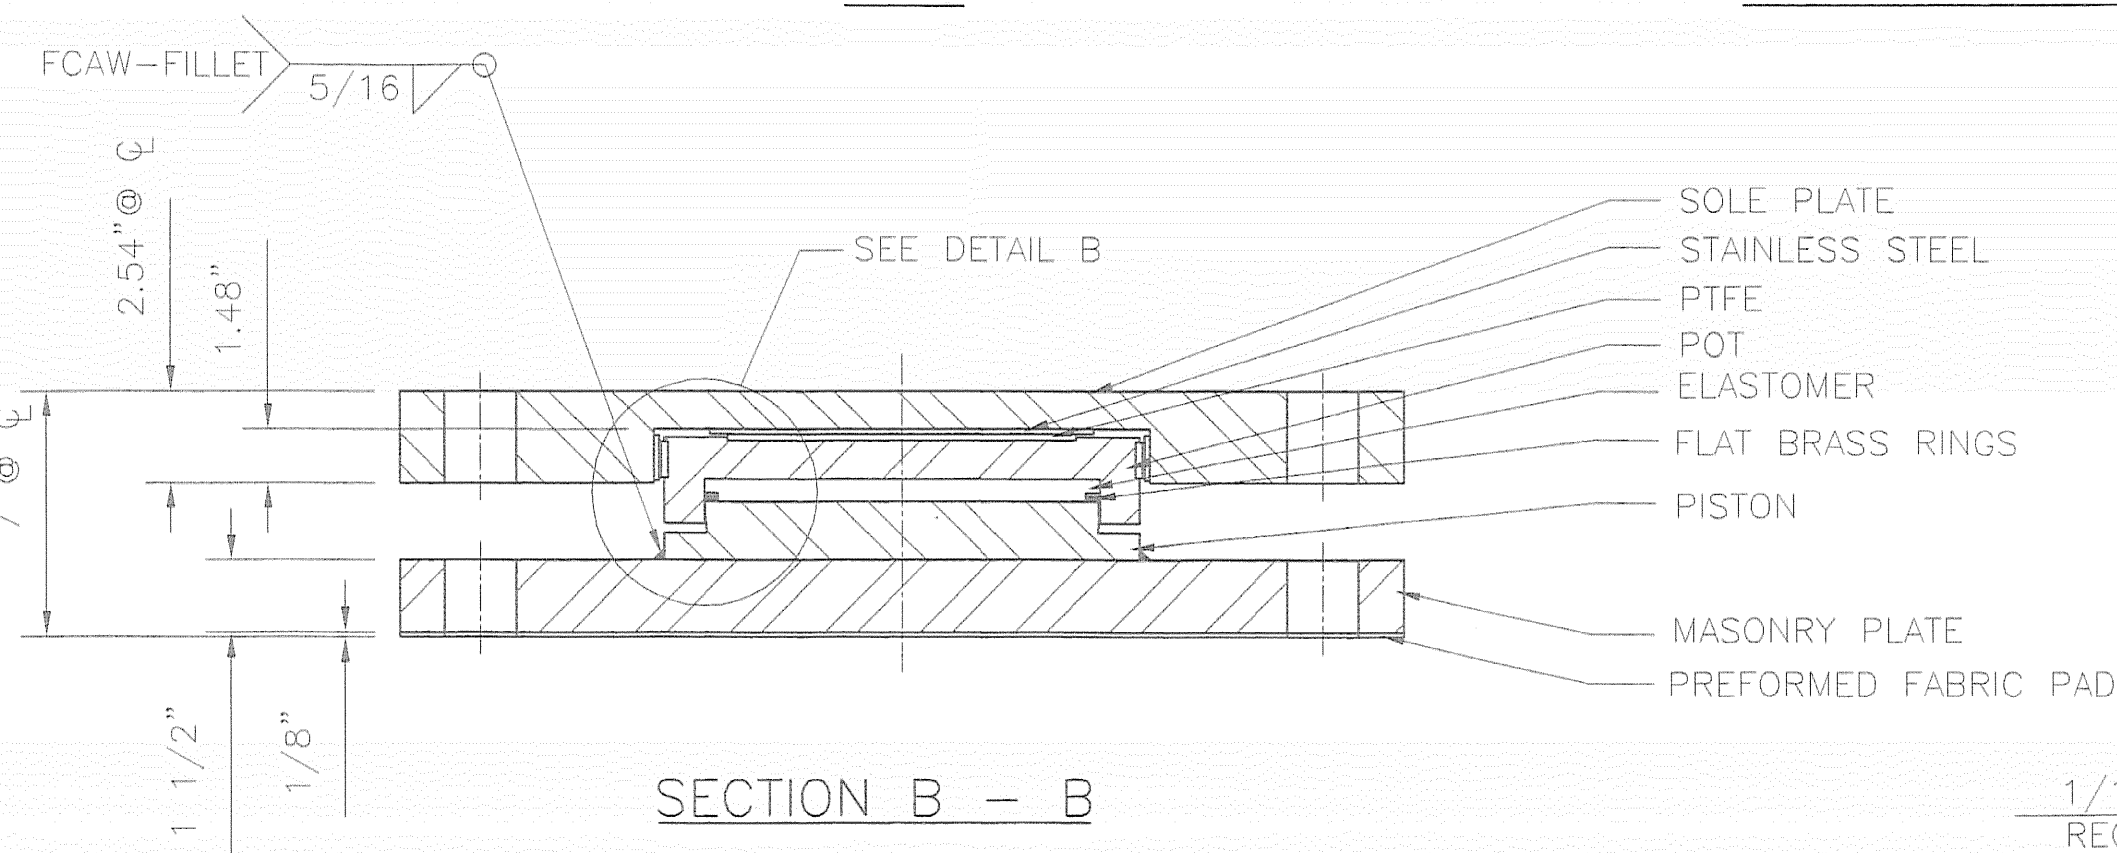


SECTION B - B

COSMEC GUIDED EXPANSION POT BEARING

QUANTITY: 2
 LOCATION: PIER, GIRDERS 2 & 3
 VERTICAL LOAD CAPACITY: 335 KIPS
 TRANSVERSE LOAD CAPACITY: 67 KIPS
 LONGITUDINAL LOAD CAPACITY: N/A
 MOVEMENT CAPACITY: 1 1/2"
 ROTATION CAPACITY: .015 RADIAN

MATERIALS

STEEL - ASTM A709 GRADE 36, ZINC METALLIZED
 STAINLESS STEEL - ASTM A240 TYPE 304, WITH 10 RMS FINISH OR LESS
 PREFORMED FABRIC PAD - AASHTO DIV. II SPEC. 18.4.9.1
 ANCHOR BOLTS - SEE ANCHOR BOLT DETAIL
 PTFE - ASTM D.4894 VIRGIN UNFILLED
 ELASTOMER - AASHTO SHORE A DUROMETER 50 ± 5 DUROMETER
 BRASS SEALING RINGS - ASTM B.36 HALF HARD

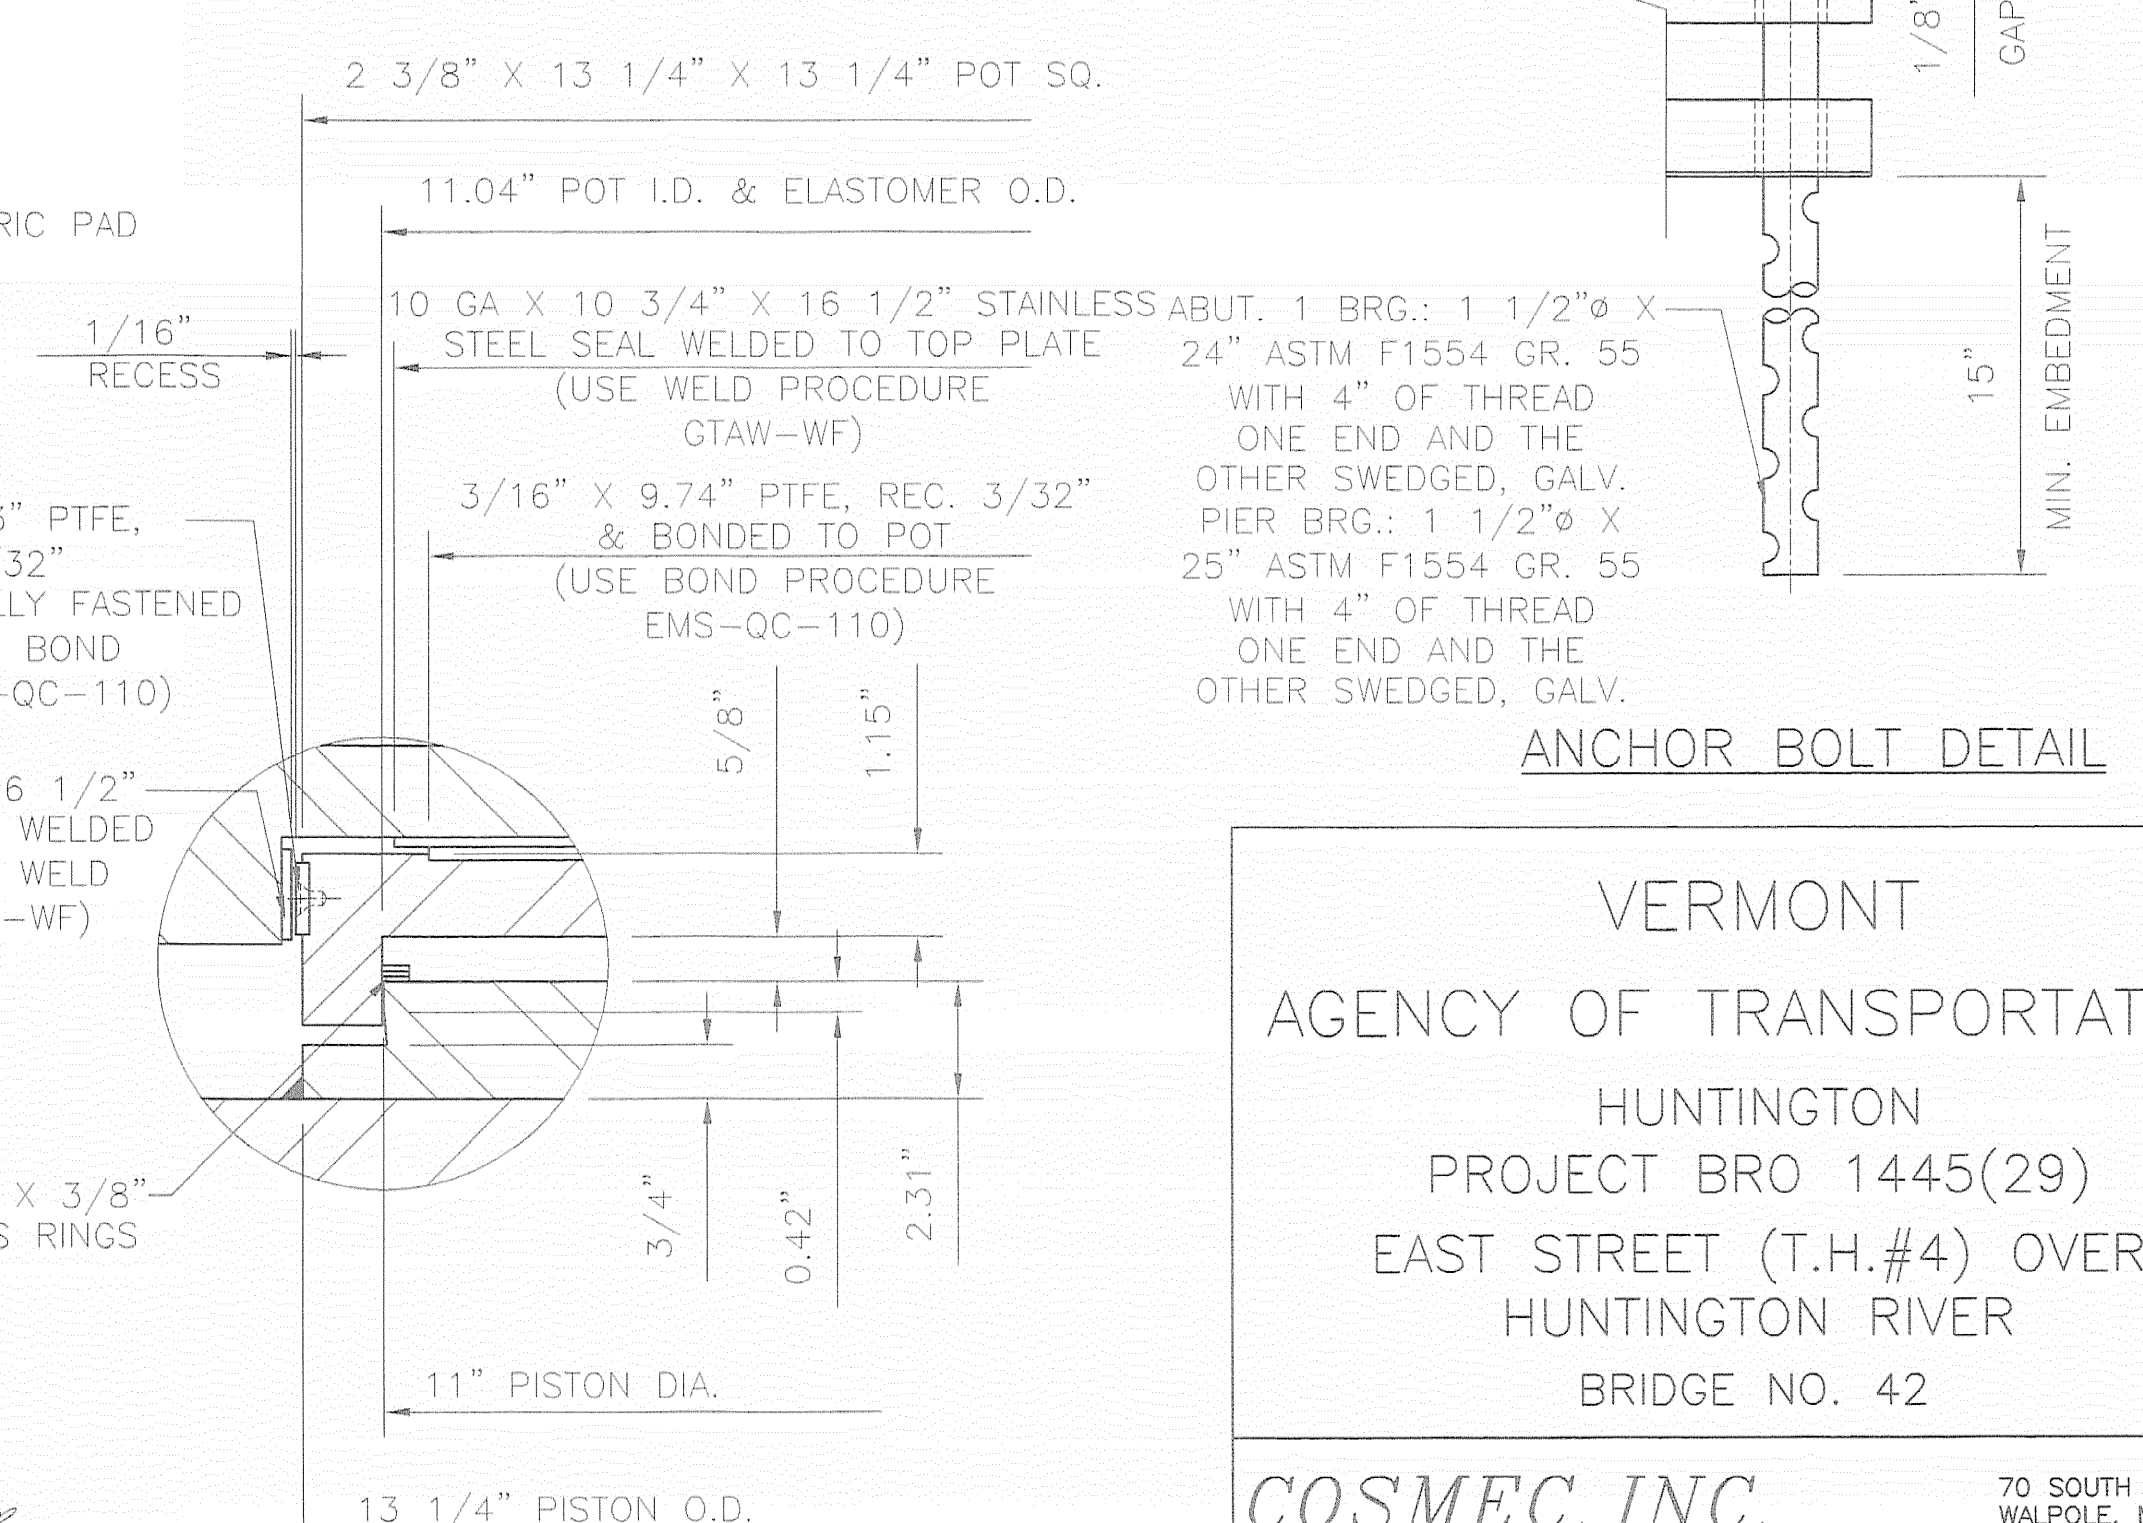

ANCHOR BOLT DETAIL

VERMONT
 AGENCY OF TRANSPORTATION
 HUNTINGTON
 PROJECT BRO 1445(29)
 EAST STREET (T.H.#4) OVER
 HUNTINGTON RIVER
 BRIDGE NO. 42


COSMEC, INC. 70 SOUTH STREET WALPOLE, MA 02081

SCALE: 3/16"=1" DRAWN BY: MRR CHECKED BY: MCM
 DATE: 11/16/06 DATE: 12/8/06


COSMEC POT BEARINGS

CUSTOMER: PARENT CONSTRUCTION INC. S.O. NUMBER: 60630 DRAWING NUMBER: 5057


REV.	BY	DATE	CHK'D	DATE

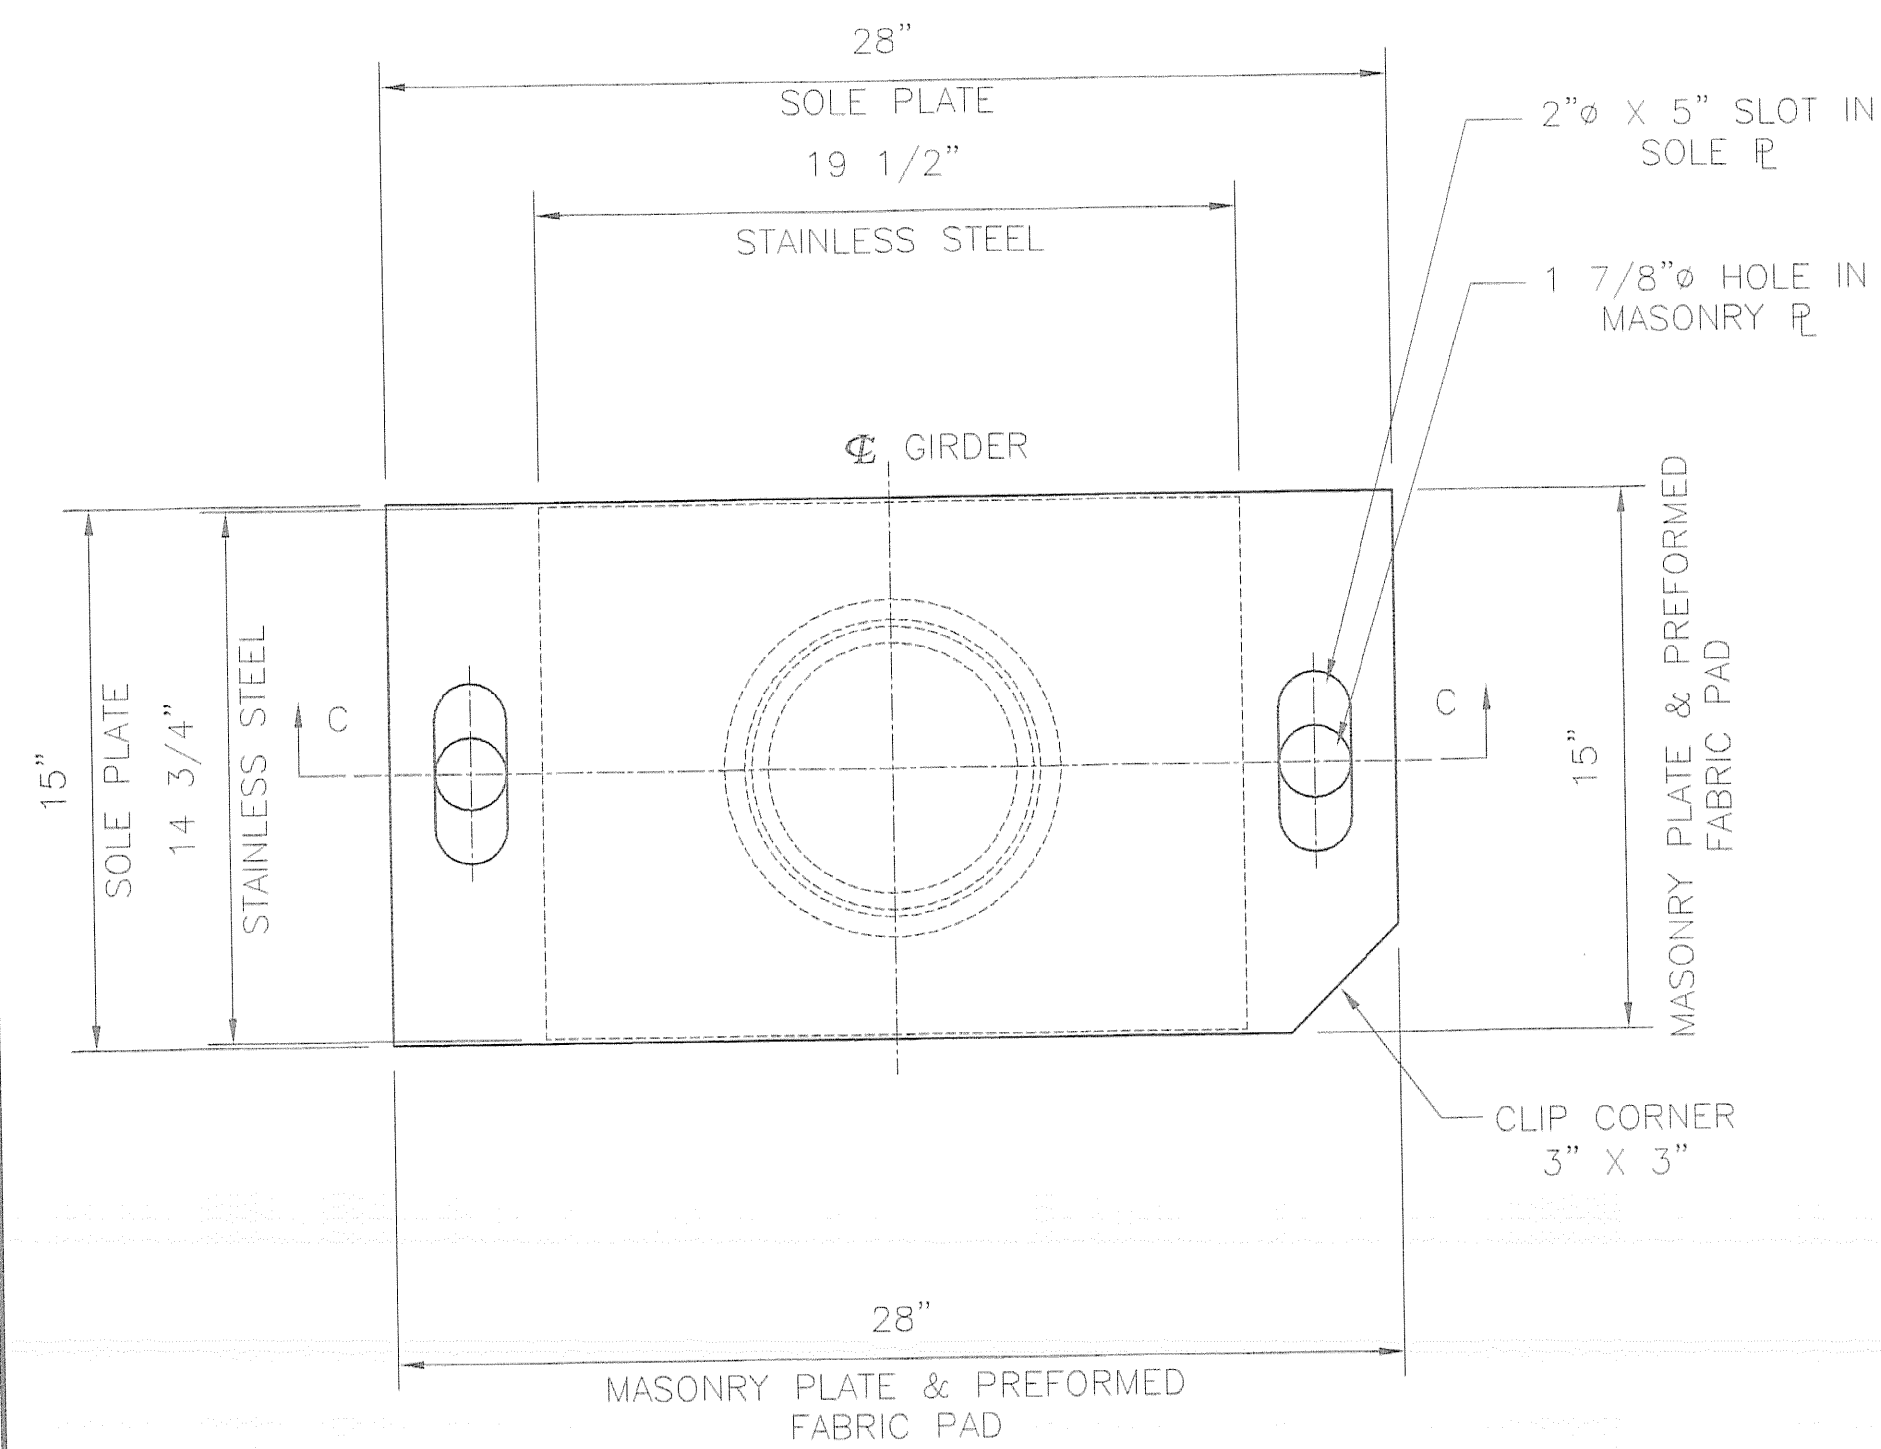


PLAN

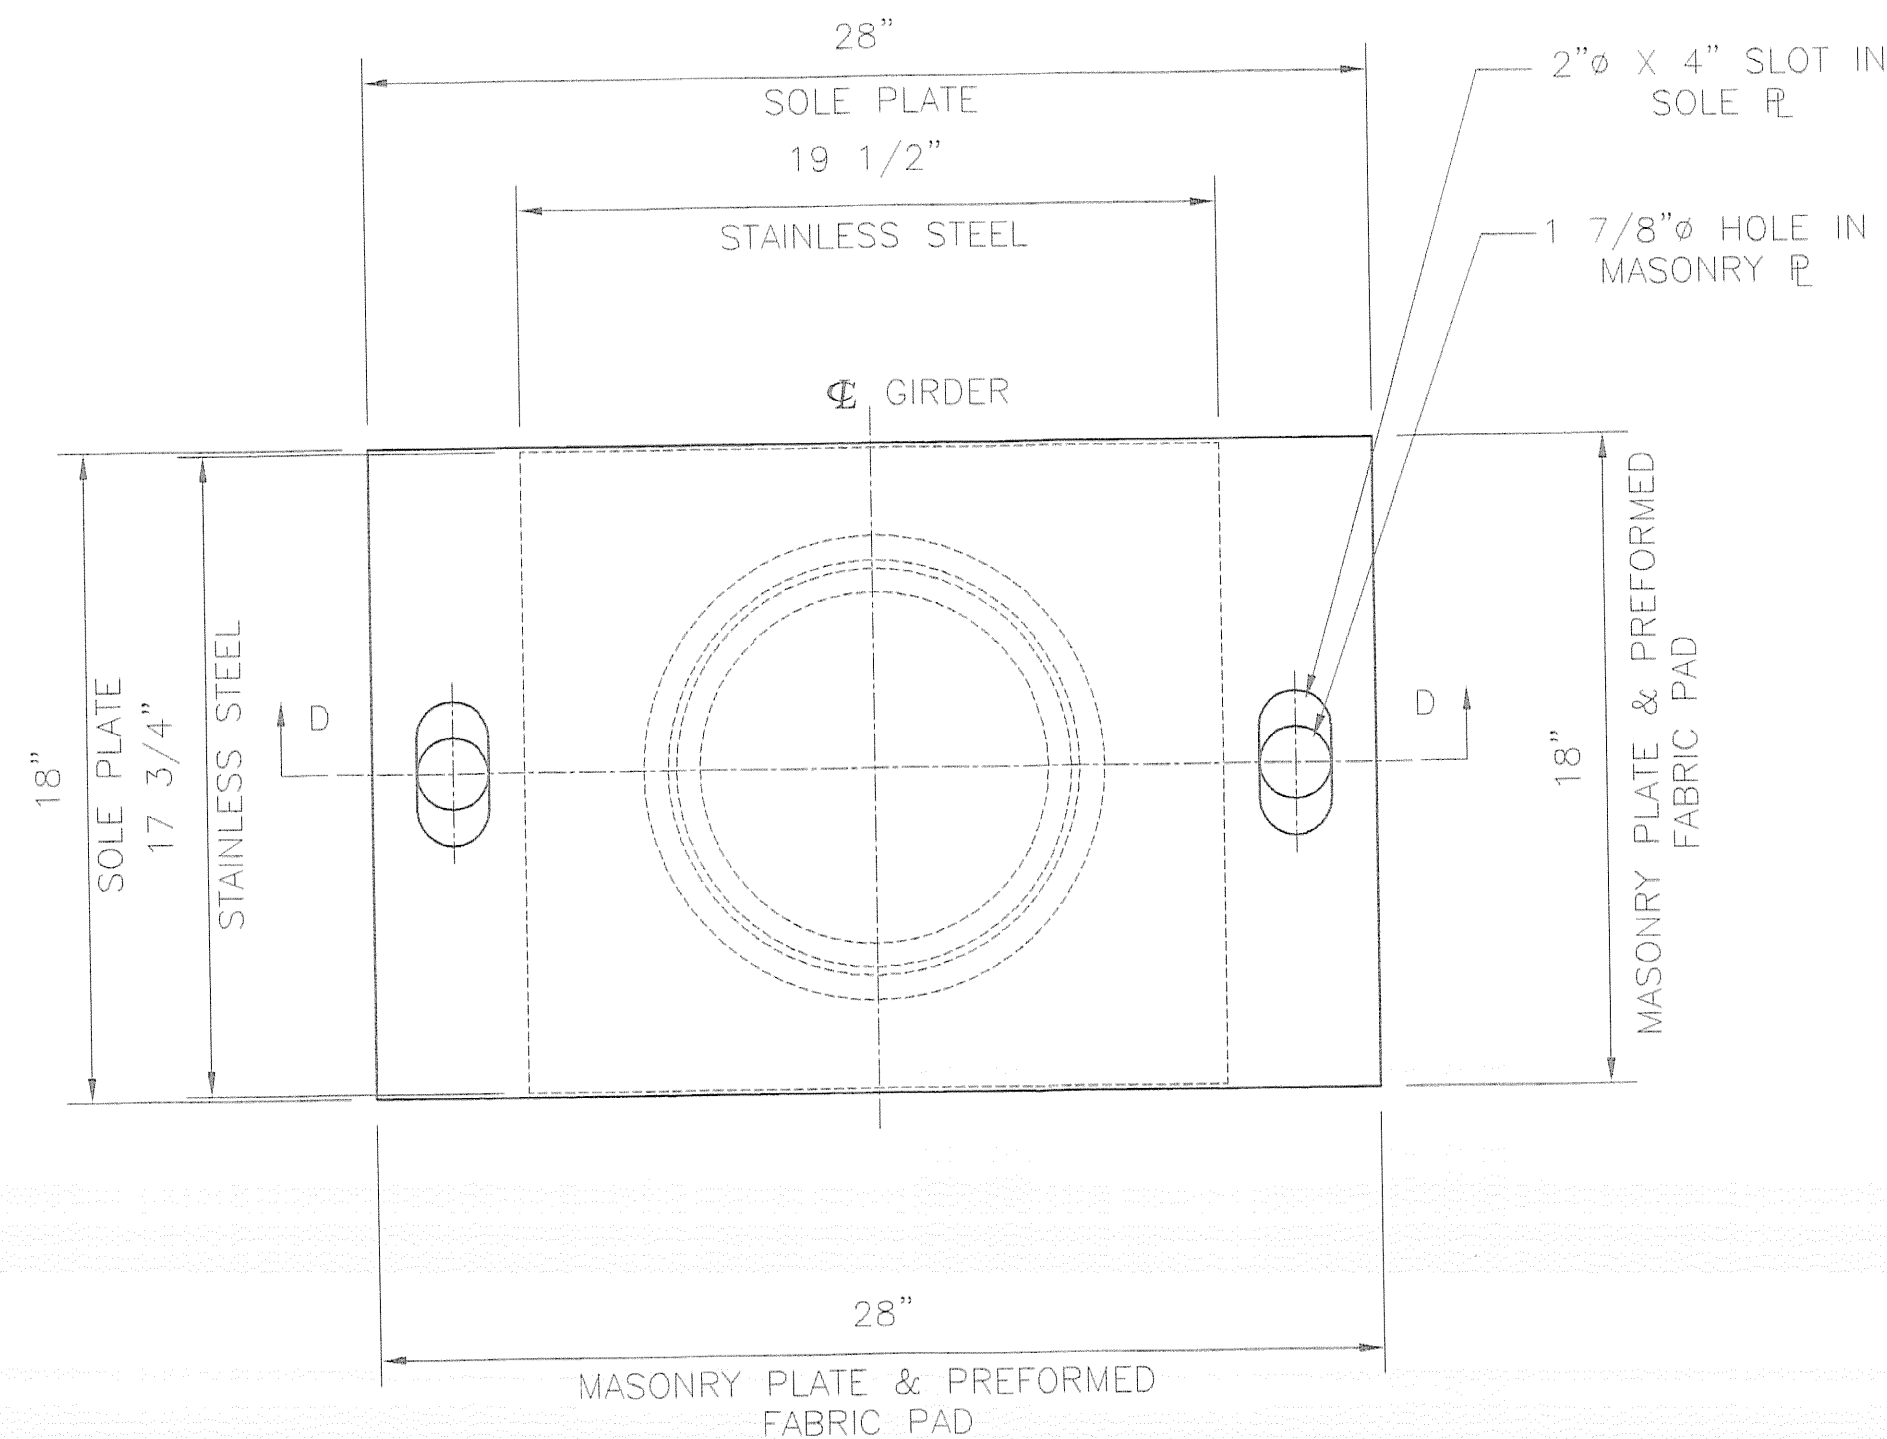


PLAN

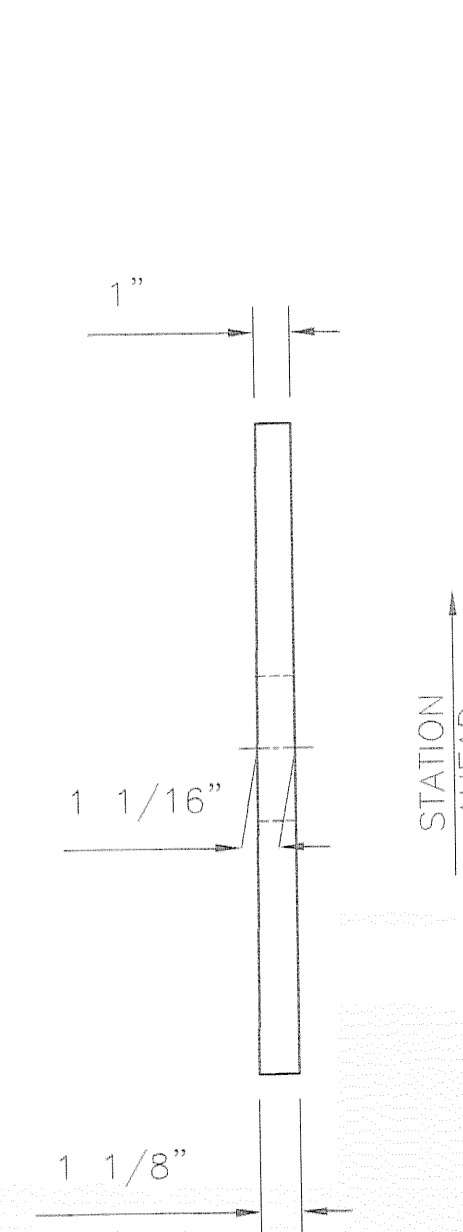

SIDE ELEVATION

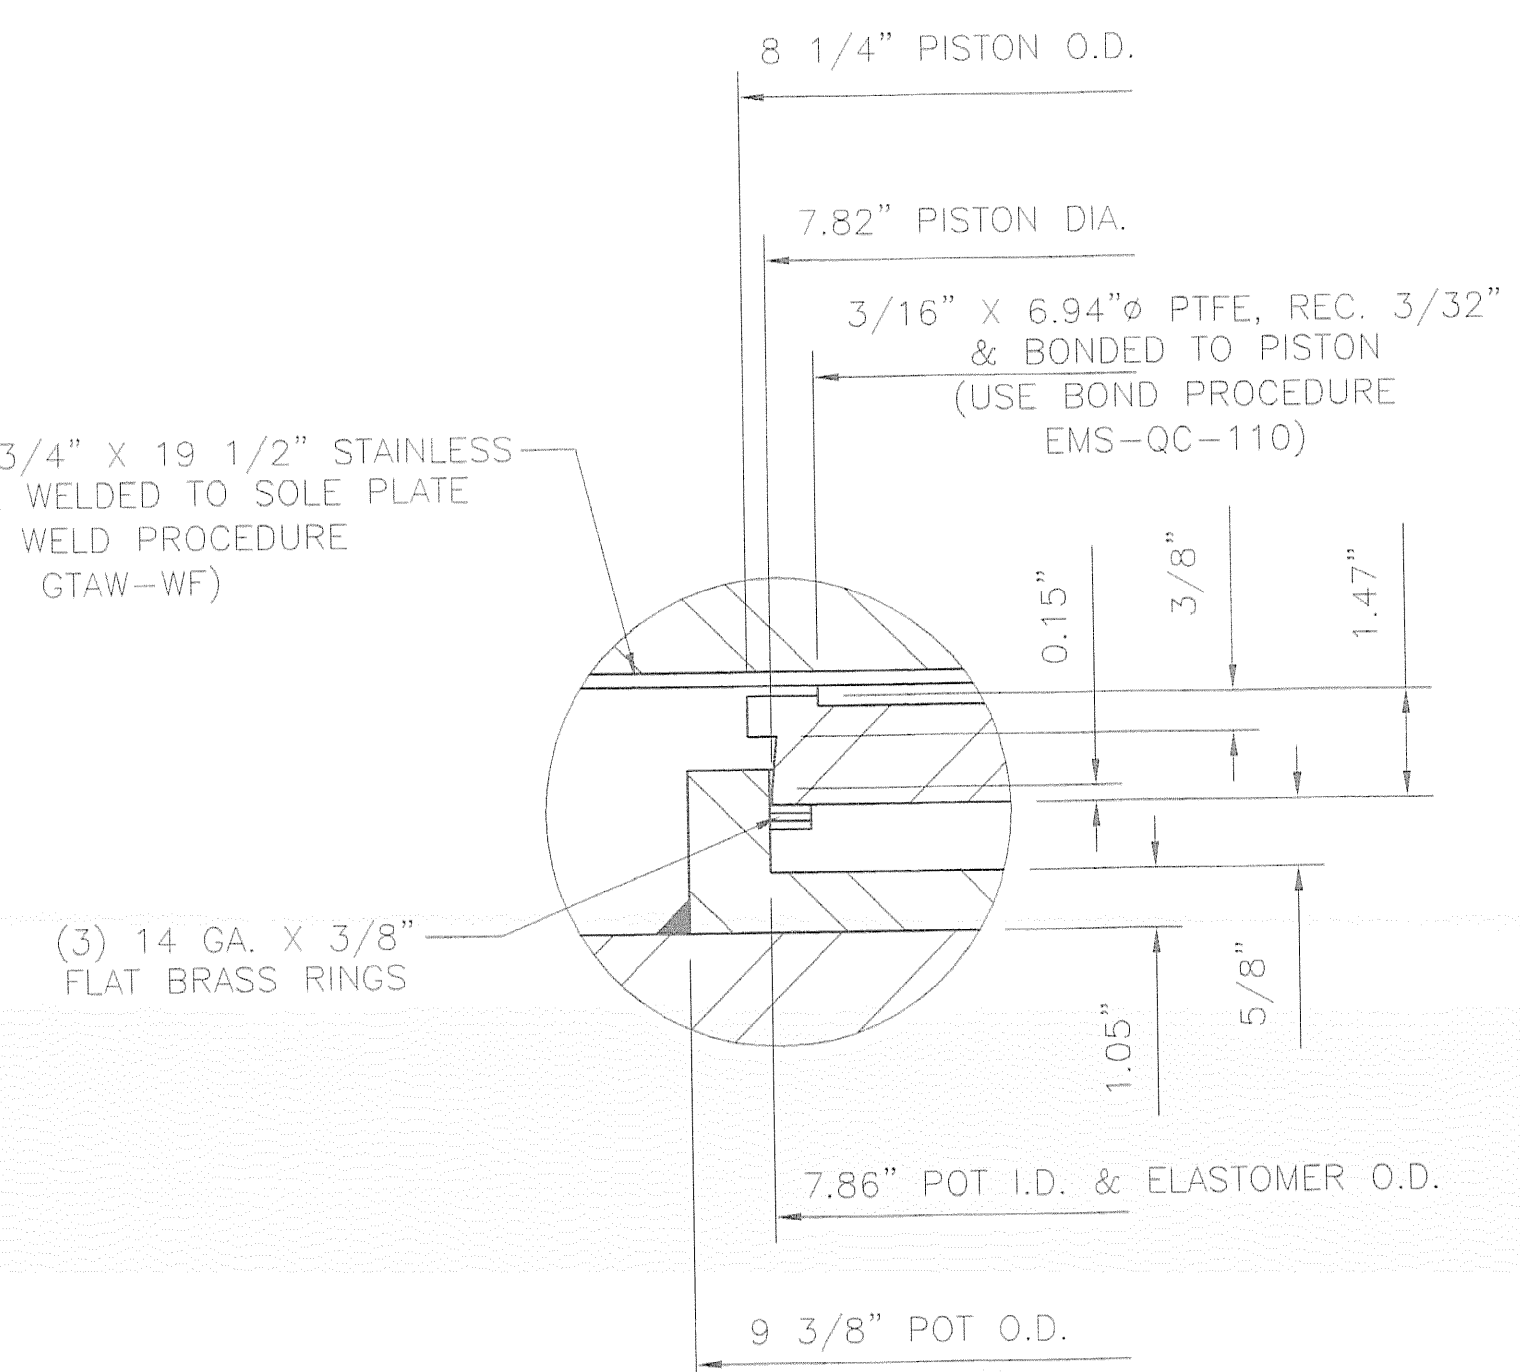

DETAIL C
N.T.S.

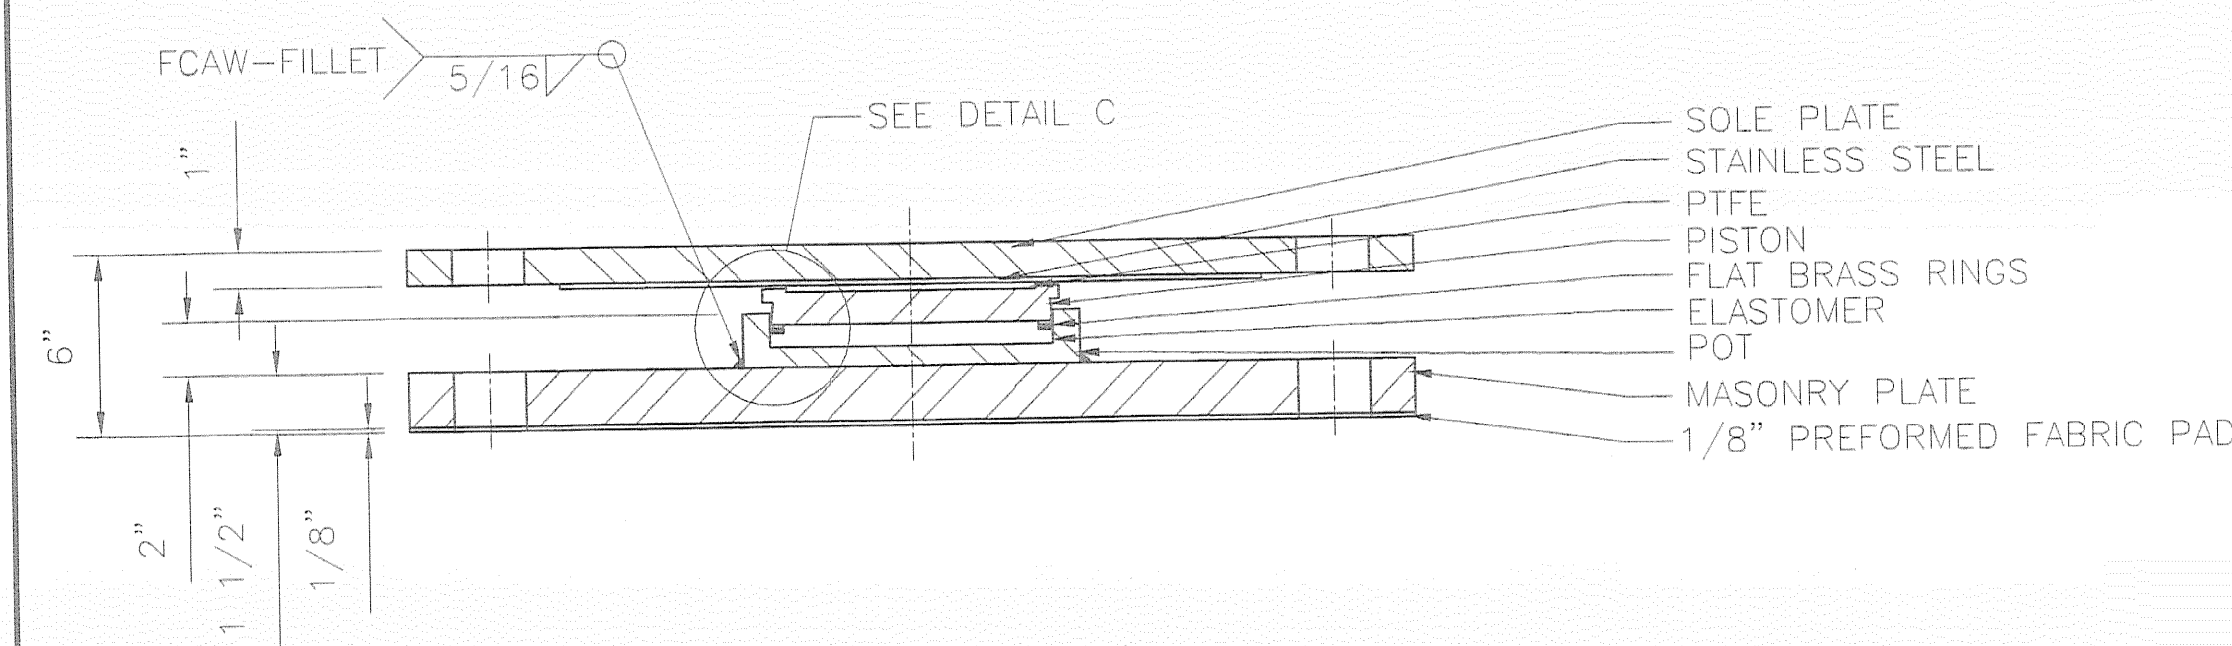


SECTION C - C

COSMEC NON-GUIDED EXPANSION POT BEARING

QUANTITY: 2
 LOCATION: ABUTMENT 1, GIRDERS 1 & 4
 VERTICAL LOAD CAPACITY: 170 KIPS
 TRANSVERSE LOAD CAPACITY: N/A
 LONGITUDINAL LOAD CAPACITY: N/A
 MOVEMENT CAPACITY: 2 1/2"
 ROTATION CAPACITY: .020 RADIAN

BEARING NOTES

- ALL MATERIALS USED IN THE FABRICATION OF THESE BEARINGS SHALL BE MADE IN THE U.S.A.
- BEARINGS ARE TO BE SHIPPED AS COMPLETE UNITS, STEEL BANDED, AND SHALL BE WRAPPED TO PROTECT FROM MOISTURE AND DIRT DURING TRANSIT AND STORAGE.
- LOCATION OF FABRICATION PLANT - 70 SOUTH STREET WALPOLE, MA 02081
- COSMEC, INC. REPRESENTATIVE - MR. MATT McANDREWS (508) 668-6600
- BEARINGS SHALL BE STORED IN A CLEAN, DRY, LEVEL UPRIGHT POSITION.
- BEARINGS MUST NOT BE DISASSEMBLED
- PROTECT PTFE & S.S. SURFACES FROM DIRT, WELD SPATTER, & ANY OTHER FOREIGN SUBSTANCES.

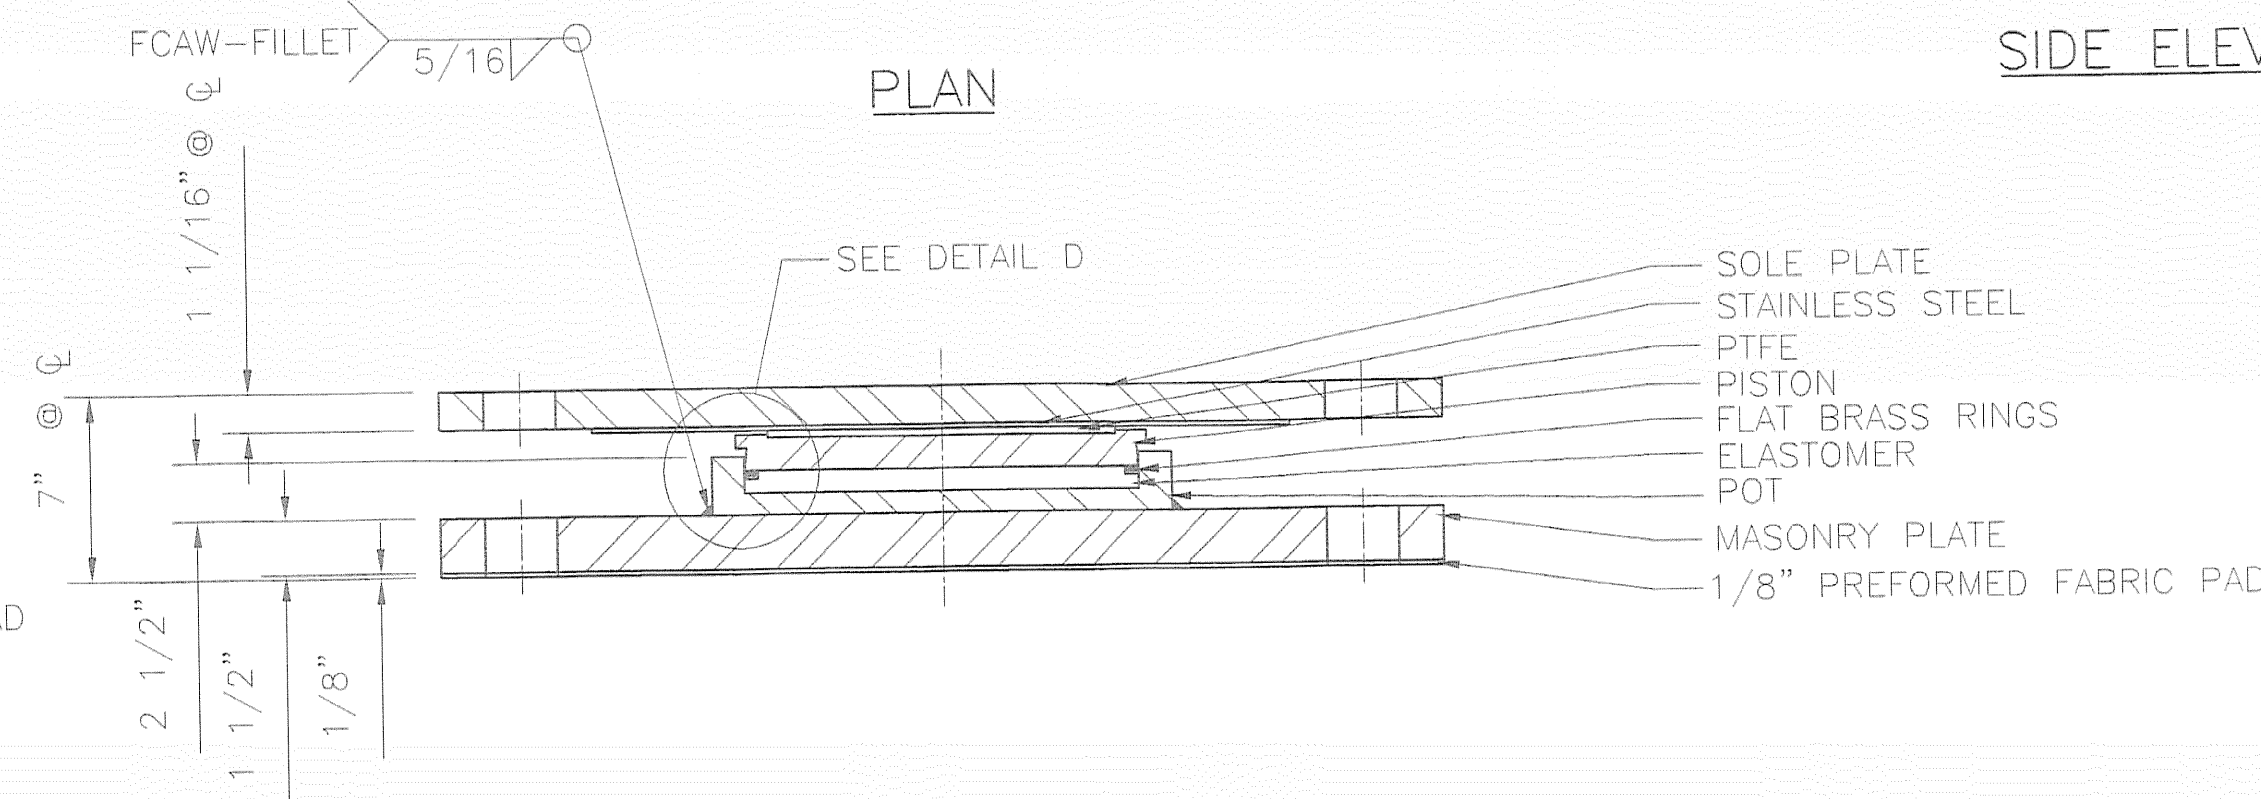


SECTION D - D

COSMEC NON-GUIDED EXPANSION POT BEARING


QUANTITY: 2
 LOCATION: PIER, GIRDERS 1 & 4
 VERTICAL LOAD CAPACITY: 335 KIPS
 TRANSVERSE LOAD CAPACITY: N/A
 LONGITUDINAL LOAD CAPACITY: N/A
 MOVEMENT CAPACITY: 1 1/2"
 ROTATION CAPACITY: .015 RADIAN

MATERIALS

STEEL - ASTM A709 GRADE 36, ZINC METALLIZED
 STAINLESS STEEL - ASTM A240 TYPE 304, WITH 20 RMS FINISH OR LESS
 PREFORMED FABRIC PAD - AASHTO DIV. II SPEC. 18.4.9.1
 ANCHOR BOLTS - SEE ANCHOR BOLT DETAIL
 PTFE - ASTM D.4894 VIRGIN UNFILLED
 ELASTOMER - AASHTO SHORE A DUROMETER 50 ± 5 DUROMETER
 BRASS SEALING RINGS - ASTM B.36 HALF HARD

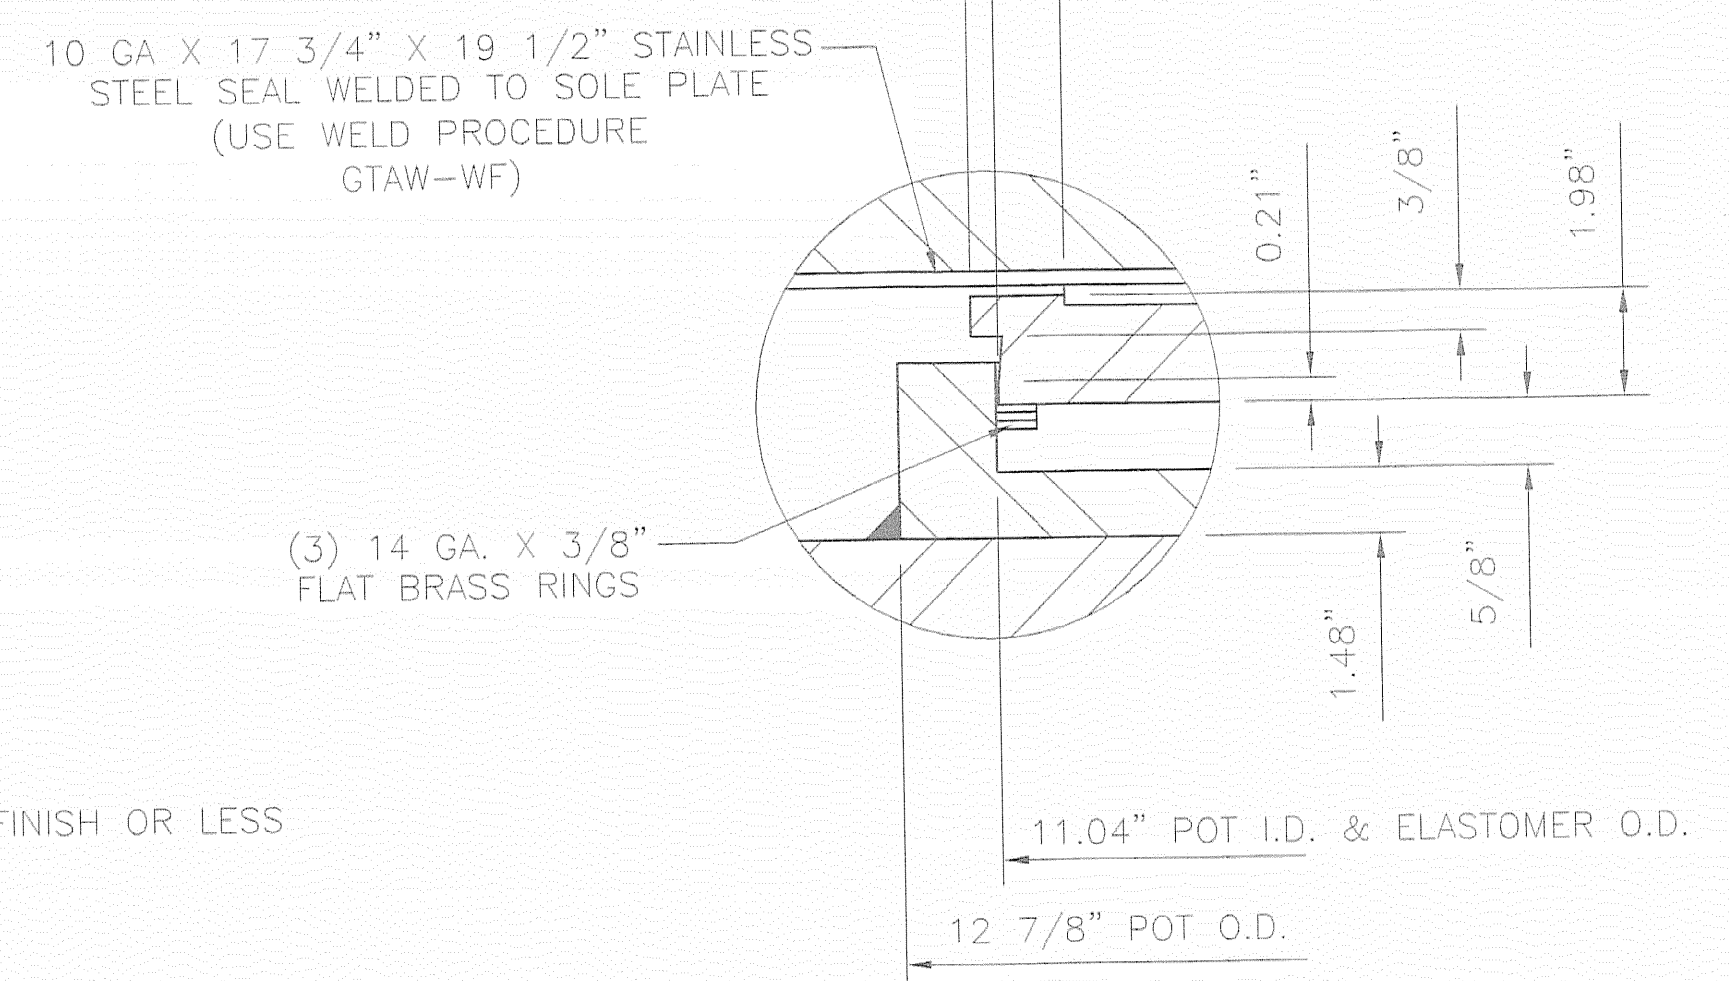

DETAIL D
N.T.S.

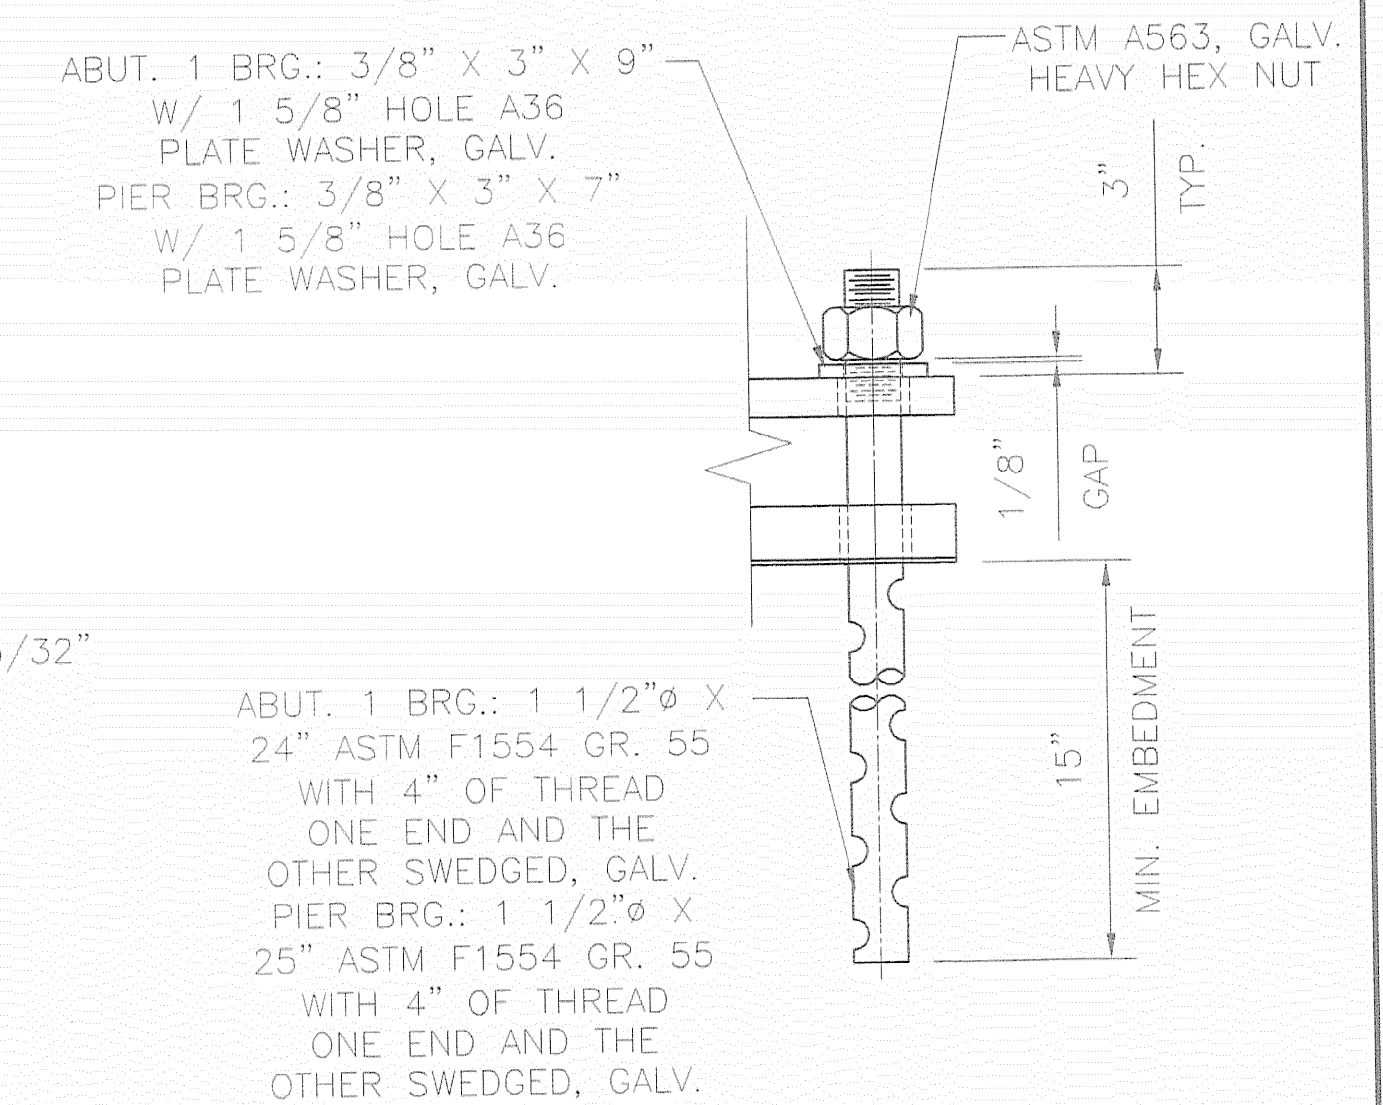

ANCHOR BOLT DETAIL


VERMONT
 AGENCY OF TRANSPORTATION
 HUNTINGTON
 PROJECT BRO 1445(29)
 EAST STREET (T.H.#4) OVER
 HUNTINGTON RIVER
 BRIDGE NO. 42

COSMEC, INC. 70 SOUTH STREET WALPOLE, MA 02081


SCALE: 3/16"=1"	DRAWN BY: MRR	CHECKED BY: MCM
DATE: 11/16/06	DATE: 11/16/06	DATE: 12/8/06

COSMEC POT BEARINGS

REV.	BY	DATE	CHK'D	DATE	CUSTOMER	S.O. NUMBER	DRAWING NUMBER	REV.
					PARENT CONSTRUCTION INC.	60630	5058	

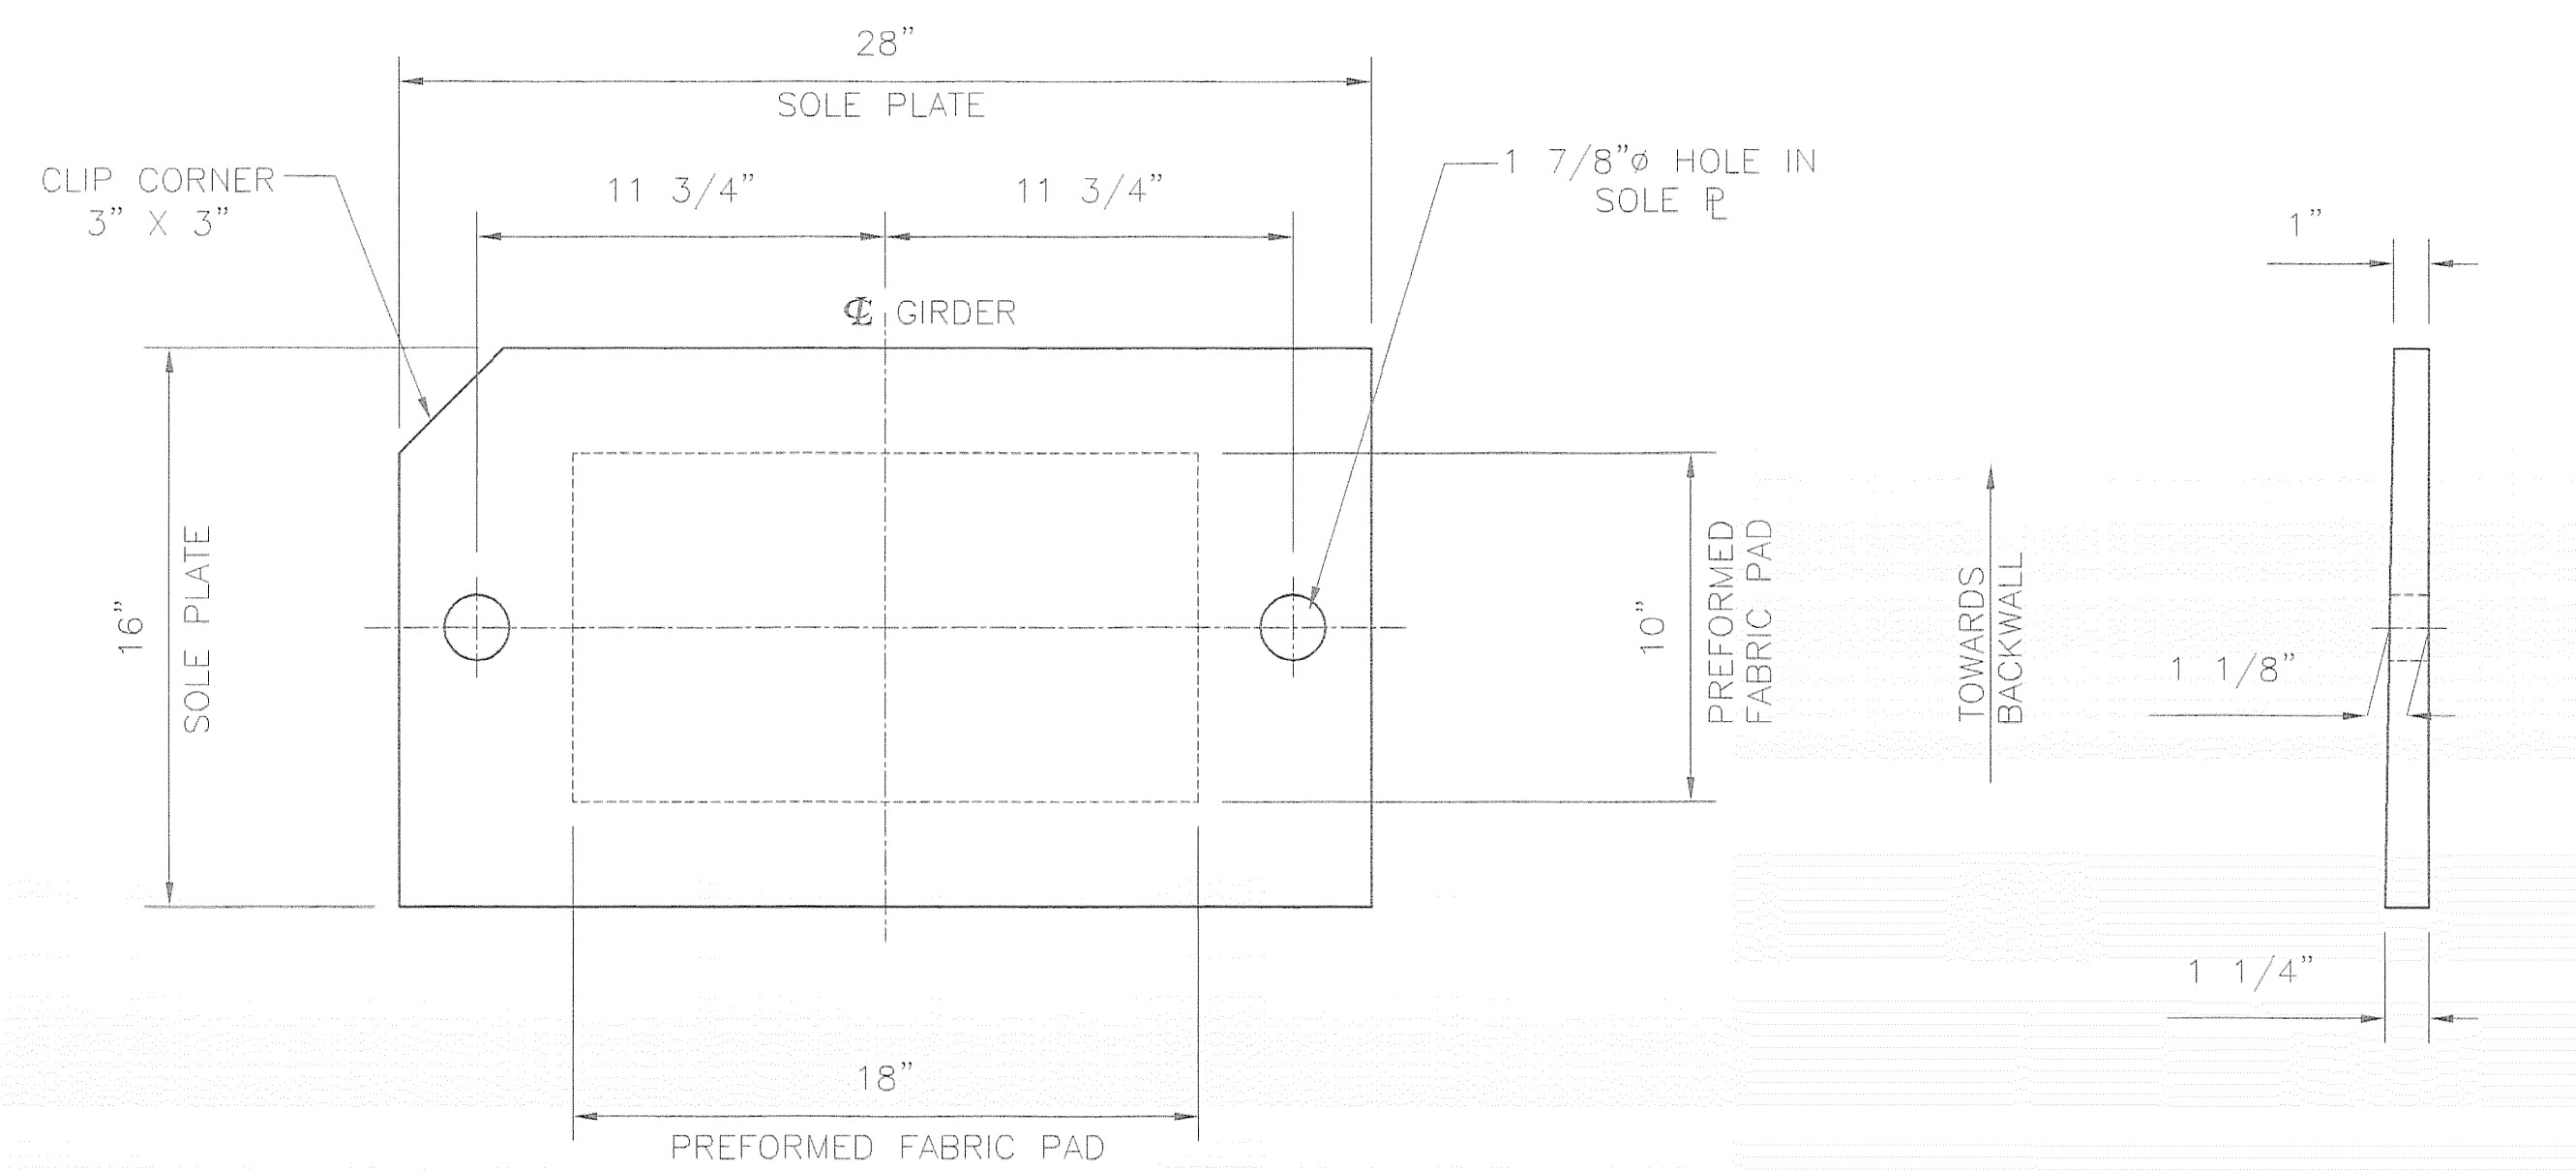

SIDE ELEVATION

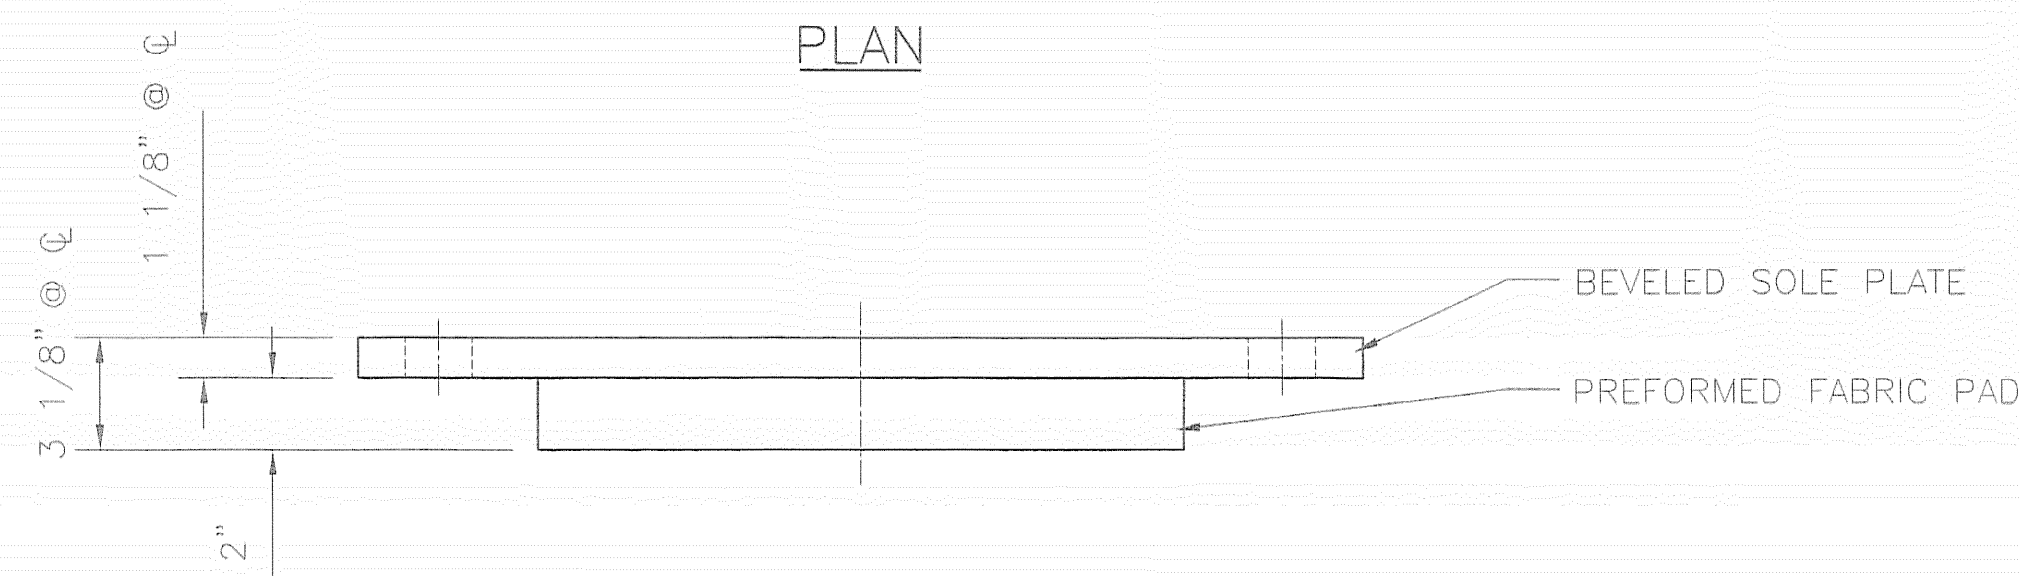

FRONT ELEVATION

**COSMEC FIXED
FABRIC
PAD BEARING**


QUANTITY: 4
 LOCATION: ABUTMENT 2, GIRDERS 1-4
 VERTICAL LOAD CAPACITY: 150 KIPS
 TRANSVERSE LOAD CAPACITY: 15 KIPS
 LONGITUDINAL LOAD CAPACITY: 15 KIPS
 MOVEMENT CAPACITY: 0"
 ROTATION CAPACITY: .016 RADIANS

BEARING NOTES

1. ALL MATERIALS USED IN THE FABRICATION OF THESE BEARINGS SHALL BE MADE IN THE U.S.A.
2. BEARINGS SHALL BE STORED IN A CLEAN, DRY, LEVEL UPRIGHT POSITION.
3. LOCATION OF FABRICATION PLANT - 70 SOUTH STREET WALPOLE, MA 02081
4. COSMEC, INC. REPRESENTATIVE - MR. MATT McANDREWS (508) 668-6600

MATERIALS

STEEL - ASTM A709 GRADE 36, ZINC METALLIZED
 PREFORMED FABRIC PAD - AASHTO DIV. II SPEC. 18.4.9.1
 ANCHOR BOLTS - SEE ANCHOR BOLT DETAIL

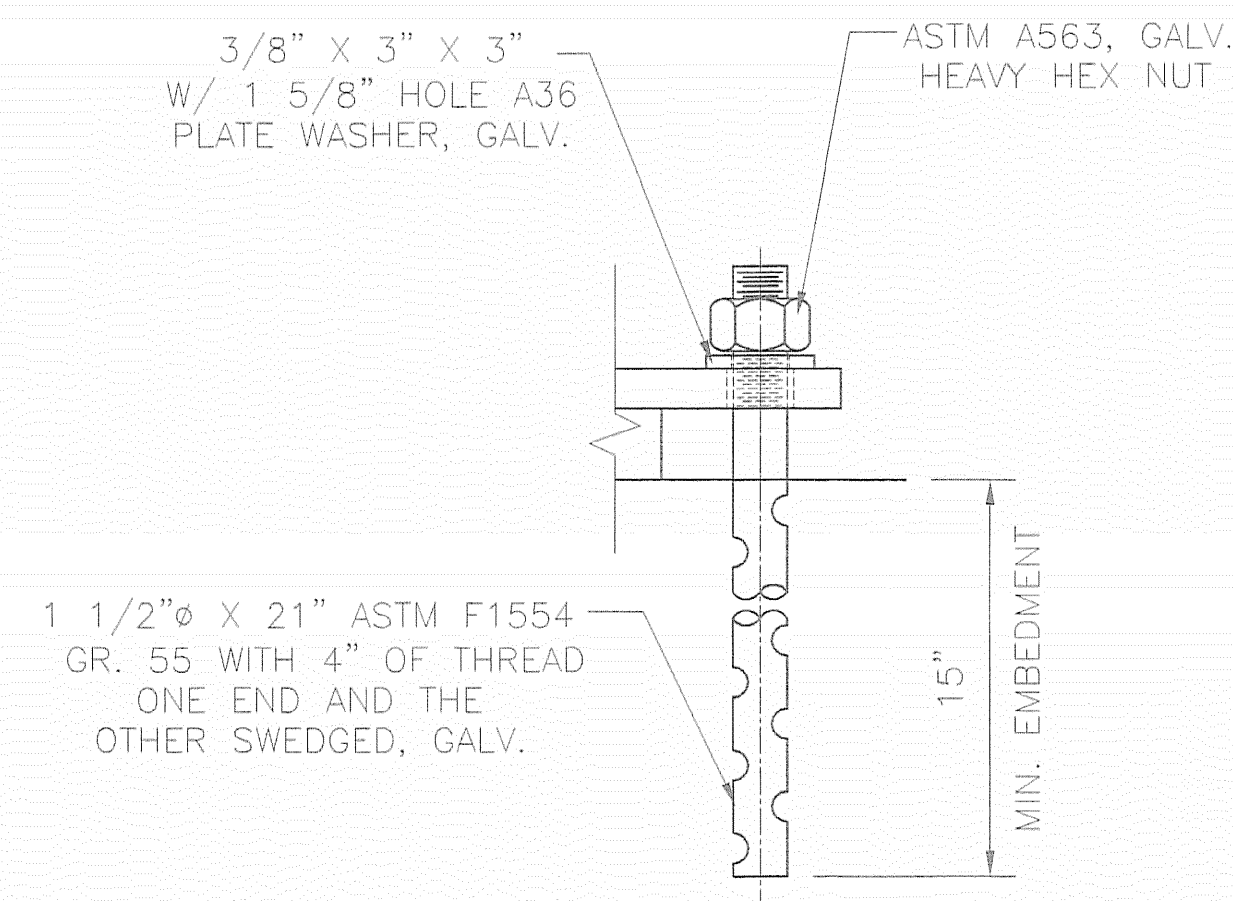

VERMONT
 AGENCY OF TRANSPORTATION
 HUNTINGTON
 PROJECT BRO 1445(29)
 EAST STREET (T.H.#4) OVER
 HUNTINGTON RIVER
 BRIDGE NO. 42

COSMEC, INC. 70 SOUTH STREET
 WALPOLE, MA 02081

SCALE: 3/16"=1" DRAWN BY: MRR CHECKED BY: MCM
 DATE: 11/16/06 DATE: 12/8/06

COSMEC FABRIC PAD BEARING

CUSTOMER: PARENT CONSTRUCTION INC. S.O. NUMBER: 60630 DRAWING NUMBER: 5059 REV.

REV.	BY	DATE	CHK'D	DATE

M. S. S. 12/27/06



State of Vermont
PDD/Structures Design Section
National Life Building - Drawer 33
Montpelier, VT 05633-5001
www.aot.state.vt.us

Agency of Transportation

[phone] 800-828-2621
[fax] 802-828-2554
[tel] 800-253-0191

DATE: December 27, 2006

Cosmec, Inc.
70 South Street
Walpole, MA 02081

Project Name: Huntington Project #: BRO 1445(29)

Structure Identification: East Street Over Huntington River
The following bearing device details [Item # 531.10, Name: Bearing Device Assembly] for the above project (Vendor's Job # 60630) transmitted with a letter from Parent Construction, Inc. dated 12/11/06 have been reviewed and are being returned herewith.

Plan Sheets Number 5057, 5058, and 5059, Welding Procedures FCAW-FILLET, GTAW-WF, and Bonding Procedure EMS-QC-110 **are approved**. If any changes are made to any of these sheets, please submit white prints for our use in record plans for this project. Otherwise, our file copy will become the record set.

You must provide written notice to this office as to the date fabrication represented by these drawings will begin. That notice must be received at least seven days prior to that date, as per Specification 506.03. Any material fabricated prior to the notification date is subject to rejection without further cause.

Sincerely,

Warren Tripp

Attachments

- cc: Resident Engineer Dale Norton, w/prints
 Shop Inspector Jeff Clark, w/prints
 Contractor Parent Construction, Inc., w/prints
 Construction Division - letter only
 Materials & Research Section (C&IA Unit) - letter only
 Files (Structures & Central)



VERMONT
AGENCY OF TRANSPORTATION
HUNTINGTON
PROJECT BRO 1445 (29)

COSMEC INC.
WELDING PROCEDURE SPECIFICATION

SPECIFICATIONS AND CODE: AASHTO-AWS D1.5
MATERIAL SPECIFICATION ASTM A709 GR 50W, GR 50, GR 35
WELDING PROCESS-----FCAW-G
MANUAL OR MACHINE-----SEMI-AUTOMATIC
POSITION OF WELDING-----1F & 2F
FILLER METAL SPECIFICATION AWS 5.20 CLASSIFICATION: E71T
MANUFACTURER: LINCOLN ELECTRIC TRADENAME: E71T OUTERSHIELD
FLUX-----INTERNAL
SHIELDING GAS-----CO2 FLOW RATE 45 CFH
SINGLE OR MULTIPLE PAS S MULTIPLE
SINGLE OR MULTIPLE ARC SINGLE
WELDING CURRENT-----DC
POLARITY: REVERSE (EP)
WELDING PROGRESSION-----
ROOT TREATMENT-----CLEANED & PREPARED BRIGHT METAL
PREHEAT AND INTERPASS TEMPERATURE-----SEE BELOW
POSTHEAT TEMPERATURE N/A
HEAT INPUT MIN.-----MAX.-----

WELDING PROCEDURE


PASS NO.	ELECTRODE SIZE	WELDING CURRENT AMPERES	TRAVEL SPEED	JOINT DETAIL
ALL	0.045	190-230	27-29	8-9

PREHEAT TEMPS.
THICKNESS T TEMP.
UP TO 3/4" 50 DEG. F
OVER 3/4" TO 1 1/2" 70 DEG. F
OVER 1 1/2" TO 2 1/2" 150 DEG. F
OVER 2 1/2" 225 DEG. F
INTERPASS TEMP: 400 DEG. F

THIS PROCEDURE MAY VARY DUE TO FABRICATION SEQUENCE, FIT-UP, PASS SIZE, ETC.
WITHIN THE LIMITATION OF VARIABLES GIVEN IN SECTION 5.

PROCEDURE NO. FCAW-FILLET
SUPPORTING PQR: FCAW-1.0-05
REVISION NO.
CONTRACTOR: COSMEC INC.
AUTHORIZED BY: DONALD VOSE

DATE: 1/31/2005

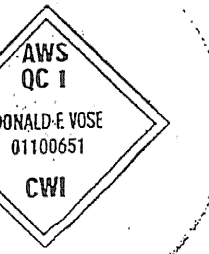

VTRANS RECEIVED
JWC
12-18-06

VERMONT
AGENCY OF TRANSPORTATION
HUNTINGTON
PROJECT BRO 1445(29)

COSMEC INC.
WELDING PROCEDURE SPECIFICATION

SPECIFICATIONS AND CODE: D1.5
MATERIAL SPECIFICATION: ASTM A240 TYPE 304 TO ASTM A709 GR 50W
WELDING PROCESS: GTAW
MANUAL OR MACHINE: MANUAL
POSITION OF WELDING: 1F & 2F
FILLER METAL SPECIFICATION: ER309L CLASSIFICATION: A5.9
MANUFACTURER: HARRIS WELCO TRADENAME:
FLUX: INTERNAL FLOW RATE: 45 CFH
SHIELDING GAS: ARGON
SINGLE OR MULTIPLE PASSES: SINGLE
SINGLE OR MULTIPLE ARC: SINGLE
WELDING CURRENT: DC
POLARITY: REVERSE (EN)
WELDING PROGRESSION:
ROOT TREATMENT: CLEANED & PREPARED BRIGHT METAL
PREHEAT AND INTERPASS TEMPERATURE: SEE BELOW
POSTHEAT TEMPERATURE: N/A
HEAT INPUT: MIN. MAX.

WELDING PROCEDURE

PASS NO.	ELECTRODE SIZE	WELDING CURRENT AMPERES	TRAVEL SPEED VOLTS	JOINT DETAIL
ALL	3/32"	130-155	14-17	LAP JOINT

16 GA THRU 10 GA
BM THICKNESS

PREHEAT TEMPS. ***PREHEAT UNTIL NO MOISTURE PRESENT
THICKNESS T TEMP.
UP TO 3/4" 100 DEG.
OVER 3/4" TO 1 1/2" 100 DEG.
OVER 1 1/2" TO 2 1/2" 100 DEG.
OVER 2 1/2" 100 DEG.

THIS PROCEDURE MAY VARY DUE TO FABRICATION SEQUENCE, FIT-UP, PASS SIZE, ETC.
WITHIN THE LIMITATION OF VARIABLES GIVEN IN SECTION 5.

SUPPORTING PQR: GTAW-WF-05
PROCEDURE NO. GTAW-WF
CONTRACTOR: COSMEC INC.
AUTHORIZED BY: DONALD VOSE
CW# 01100651 *Donald Vose*

REVISION NO. 1
DATE: 2/1/2005

VTRAOS
RECEIVED
DATE: 12-18-06



VERMONT
AGENCY OF TRANSPORTATION
HUNTINGTON
PROJECT BRO. 1445(29)

EMS-QC-110

COSMEC, INC.
70 SOUTH STREET
WALPOLE, MA 02081
PH# 508-668-6600
FAX# 508-660-1022

VTRANS

JWC

12-18-06

ENGINEERING AND MANUFACTURING STANDARD
PTFE FACING AND STEEL
OR PREFORMED FABRIC SUBSTRATE
SURFACE PREPARATION AND ADHESIVE PROCEDURE

The PTFE facing shall be prepared for bonding to a substrate material by chemically etching the face to be bonded using the sodium ammonia process.

The mating surface of the substrate shall be prepared for bonding using a three-step process as follows:

1. preliminary degrease using methyl ethyl ketone.
2. mechanically roughen to approx. 125 RMS and thoroughly brush and clean for final degreasing.
3. final degrease using methyl ethyl ketone

The PTFE and substrate mating surfaces shall be clean and dry with final degreasing performed within 30 minutes of bonding. Adhesive shall consist of a two-part epoxy adhesive system conforming to Military Specification MMM-A-134

The adhesive shall be applied to the full area of the contact surface in an even manner so as to establish a glue line not less than .002 inch nor more than .010 inch thick. Surfaces being bonded are to be assembled immediately with open assembly time not to exceed 20 minutes.

The PTFE material shall be greater in width and length than the substrate material by at least 1/8 inch when bonded. The PTFE shall be applied with contact starting at one edge and with contact progressing across entire bonded surface to eliminate air entrapment. The PTFE is to be in full contact with the steel or preformed fabric substrate. Curing of the bond shall be done under pressure of approx. 2-100 psi for 10-12 hours at approx. 70°F or other schedules as established by the manufacturer of the adhesive.

The PTFE shall be carefully trimmed to the same size as the substrate after bond curing and all bonds shall be visually inspected for bond retention.

Gleason, Carl

From: Tripp, Warren
Sent: Monday, May 05, 2008 12:44 PM
To: Gleason, Carl
Subject: FW: Intermediate Stay Plates on Richford

As noted at the end of the following e-mail, will you please confirm or correct the number of stay plates needed, based on the number on the existing trusses? As soon as we are in agreement, I will forward the information to Casco Bay so that the shop drawings can be revised. Thanks.

-----Original Message-----

From: Burbank, Scott [mailto:scott.burbank@stantec.com]
Sent: Thursday, May 01, 2008 4:14 PM
To: Tripp, Warren
Cc: mchenette@stantec.com
Subject: Intermediate Stay Plates on Richford

Warren,

I have review the steel shop drawings concerning the missing stay plates and have found the following:

Piece Marks T11, T12, T81, and T82 (Left & Right) - Add an additional intermediate stay plate top and bottom between the top end stay plate and the first intermediate plate stay plates (top & bottom) at 10'-0". Add an additional stay plate top and bottom between the intermediate stay plate located at 19'-4 1/2" and the splice. Please note that this missing intermediate stay plate is located at a clear distance of 6'-9" from the intermediate stay plate located 1'-2 1/4" from the truss joint. These dimensions are shown on the Truss Bottom Chord Elevation, located on sheet 24 of the contract drawings.

Piece Marks T31, T32, T61 and T62 (Left & Right) - Add an additional intermediate stay plate top and bottom between the intermediate stay plate located at 26'-1" (please verify this location, it is greater than 3.125 feet from the stay plate at 22'-4 1/8") and the splice. This missing intermediate stay plate is also located 6'-9" from the intermediate stay plate between the splice and the joint.

Piece marks T51 and T52 have the correct number of intermediate stay plates.

Adding these stay plates will provide three top and four bottom intermediate stay plates in bays 1 and 8. There will now be four intermediate stay plates top and bottom in bays 2 and 7. And four intermediate stay plates in bays 4 and 5. Bays 3 and 6 will still have 5 intermediate stay plates as shown on the shop drawings.

Warren could you please ask the resident to verify if the number of intermediate stay plates on the existing trusses matches the numbers above.

If you or the resident engineer of any comments or questions please call or email me.

Sincerely

Scott Burbank, P.E.
Project Engineer
Stantec
Ph: (802) 864-0223 Ext. 137
F: (802) 864-0165
scott.burbank@stantec.com
stantec.com



State of Vermont
PDD/Structures Design Section
National Life Building - Drawer 33
Montpelier, VT 05633-5001
www.aot.state.vt.us

Agency of Transportation

[phone] 802-828-2621
[fax] 802-828-3566
[tdd] 800-253-0191

April 24, 2008

Casco Bay Steel Structures, Inc.
75 Spring Hill Road
Saco, ME 04072

Project Name: Richford Project #: BHF 0302(3)S

Structure Identification: TH #2, BR. #41 over Missisquoi River

The following Structural Steel details [Item # 506.50, Structural Steel, Rolled Beam] for the above project (Vendor's Job # 361) transmitted with your letter dated 4/17/08 have been reviewed and are being returned herewith.

Sheets E1, S1, S2, S3, S4, and S5 are **approved**. Upon submitting extended weights for our approval, please submit one set of white prints for our use in the record plans for this project.


You must provide notice to our fabrication inspector, Jeff Clark, as to the date fabrication represented by these drawings will begin. That notice must be received and acknowledged at least seven days prior to that date, as per Specification 506.03. Jeff may be contacted by phone at (802)828-0044 or email at jeff.clark@state.vt.us. Any material fabricated prior to the notification date is subject to rejection without further cause.

Sincerely,

Warren Tripp, Project Manager

Attachments

cc: [X] Resident Engineer Carl Gleason, w/prints
[X] Shop Inspector Jeff Clark, w/prints
[X] Contractor Blow & Cote, Inc., w/prints
[X] Construction Divison - letter only
[X] Materials & Research Section (C&IA Unit) - letter only
[X] Files (Structures & Central)

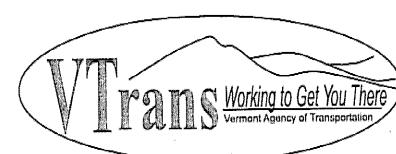



State of Vermont

PDD/Structures Design Section

National Life Building – Drawer 33
Montpelier, VT 05633-5001
www.aot.state.vt.us

Agency of Transportation

[phone] 802-828-2621
[fax] 802-828-3566
[ttd] 800-253-0191

April 21, 2008

Casco Bay Steel Structures, Inc.
75 Spring Hill Road
Saco, Me 04072

Project Name: Richford Project #: BHF 0302(3)S
Structure Identification: TH #2, BR #41 over Missisquoi River

The following shop drawings and welding procedures for the above project (Vendor's Job # 361) transmitted with your letter dated March 28, 2008, have been reviewed and are being returned herewith:

Item 506.60, Structural Steel, Sheets M 1 and M 2. These sheets are “**approved as noted**”. Upon submitting extended weights for our approval, please make appropriate changes as indicated on these “as noted” drawings and submit one set of white prints for our use in the record plans for this project.

Item 516.11, Bridge Expansion Joint, Vermont, Sheet J 1. This sheet is “**approved as noted**”. Upon receipt of this “as noted” drawing, please make appropriate changes and submit one white print for our use in the record plans for this project.

Welding procedures. Sheets #1 SW, 104, 101, 105, and 401 are “**approved**”.

You must provide notice to our fabrication inspector, Jeff Clark, as to the date fabrication represented by these drawings will begin. That notice must be received and acknowledged at least seven days prior to that date, as per Specification 506.03. Jeff may be contacted by phone at (802) 828-0044 or email at jeff.clark@state.vt.us. Any material fabricated prior to the notification date is subject to rejection without further cause.


Sincerely,

A handwritten signature in black ink that reads "Warren Tripp".

Warren Tripp, Project Manager

Attachments

- cc: Resident Engineer: Carl Gleason w/prints
 Shop Inspector: Jeff Clark w/prints
 Contractor: Blow & Cote, Inc. w/prints
 Construction Division – letter only
 Materials & Research Section (C&IA Unit) – letter only
 Files

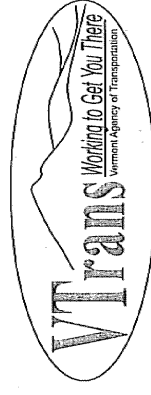

Casco Bay Steel Structures, Inc.

75 Spring Hill Road
Saco, Maine 04072

Phone: (207) 282-7360

Fax: (207) 282-1179

WELDING PROCEDURE SPECIFICATION

Material specification ASTM A709/A709M - Gr 36-50-50w (250-345-345w)
 Welding process STUD WELDER (S.W.)
 Manual or machine Machine VTRANS
 Position of welding Flat RECEIVED
 Filler metal specification NA BY JWC
 Filler metal classification NA
 Flux NA Flow rate NA
 Shielding gas NA
 Single or multiple pass Single
 Single or multiple arc Single
 Welding current DC EN 4/19/08
 Polarity DC EN
 Welding progression NA
 Post treatment Clean surface to be welded
 Preheat and interpass temperature To 3/4" 50° to 1 1/2" 70° to 1 1/2" 150° over 2 1/2" 225°
 Postheat temperature NA
 Heat input Min NA Max NA Rich Ford, VT
Br. No. 41 - Proj No. BHF-0302(C)S
C.B.S.S. 361

WELDING PROCEDURE


Pass no.	Electrode size	Welding current		Travel speed	AWS D1-1 Joint detail	AWS D1-5
		Amperes	Volts			
	STUD size		Weld Time			
1/2	350	650	35"			
5/8	350	650	35"	NA		
3/4	550	750	40"			
7/8	650	850	1.0"			

NOTE:
This procedure is only a guide to setup.

This procedure may vary due to fabrication sequence, fit-up, pass size, etc., within the limitation of variables given in applicable A.W.S. codes or contract specifications.

Procedure no. # I S.W.
 Revision no. _____
 Form III-2

Contractor Casco Bay Steel
 Authorized By [Signature]
 Date May 3-2008

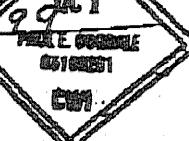

Casco Bay Steel Structures, Inc.

5 Industry Road
South Portland, Maine 04106

Phone: (207) 772-2533

Fax: (207) 772-0580

WELDING PROCEDURE SPECIFICATION


Material specification A36-A572-A588 (ASTM A36 Gr 36-50-50w)
 Welding process Flux Cored Arc welding (FCAW)
 Manual or machine SEMI-AUTO
 Position of welding FLAT-1G
 Filler metal specification AWS A5-20
 Filler metal classification E71T-1
 Flux NA
 Shielding gas 75% AR 25% CO₂ Flow rate 40 ES
 Single or multiple pass Both Electrode stick out 3/4 ± 1/4
 Single or multiple arc Single
 Welding current Direct current
 Polarity Reverse Electrode positive
 Welding progression see detail
 Root treatment see detail
 Preheat and interpass temperature To 50° (18-10°) 3/4 to 1 1/2" (19 to 38-20°)
 Postheat temperature NA
 Heat input Min NA Max NA

RICK FUND VT
 BR NO. 41 - Proj NO BHF-0302(3)S
 CSS 361

WELDING PROCEDURE

Pass no.	Electrode size	Welding current		Travel speed
		Amperes	Volts	
	1/16	25 ± 2	25 ± 1.7	11 ± 1.1
	1/8	25 ± 2	25 ± 1.7	280 ± 28

TRANS RECEIVED
 JUC
 DATE 4/17/08

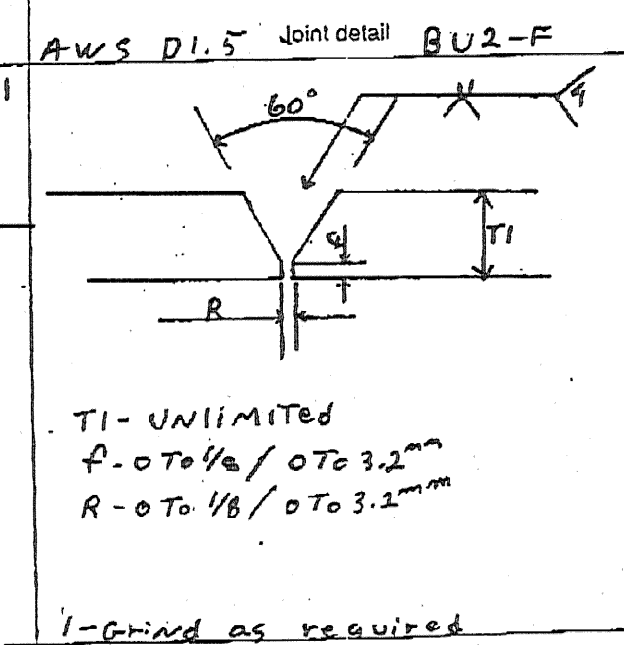

This procedure may vary due to fabrication sequence, fit-up, pass size, etc., within the limitation of variables given in applicable A.W.S. codes or contract specifications

Procedure no. 104 Contractor Casco Bay Steel
 Revision no. AWS-QC1 Authorized By Paul E. Goodale
 Form III-2 Paul E. Goodale Date 2/2/99
 BS100201
 C.W.I.

Casco Bay Steel Structures, Inc.

75 Spring Hill Road
Saco, Maine 04072

Phone: (207) 282-7360

Fax: (207) 282-1179

WELDING PROCEDURE SPECIFICATION

Material specification ASTM A709/A709M - Grade 36 (50) 50 (45) 50 W (345 W)
 Welding process Flux Cored Arc Welding (FCAW)
 Manual or machine Semi Auto
 Position of welding Flat (1F) Horizontal (2F)
 Filler metal specification AWS A5.20
 Filler metal classification E71T-1
 Flux NA
 Shielding gas 75% AR 25% CO₂ Flow rate 40 CFH ± 5
 Single or multiple pass Single and Multiple - Electrode Extension 3/8" (50) ± 6.35
 Single or multiple arc Single
 Welding current DC
 Polarity Reverse
 Welding progression
 Root treatment As per AWS specification
 Preheat and interpass temperature To 3/8" (9.5) (10) - 3/4" (19) To 1/2" (12.7) (10) - 1/4" (6.3) (10) To 3/16" (4.8) (10)
 Postheat temperature NA
 Heat input Min NA Max NA
 Richford, VT
 B.V.M.C. 41 - Proj No. BHF-0302(3)S
 C.B.S.S. 361

(METRIC)

Pass no.	Electrode size	Welding current		Travel speed	Joint detail
		Amperes	Volts		
1/16	1/16	205	28.8	11.6	1F
		247.5	26.8	10.4	
		302.5	30.8	12.8	
1/8	1/8	205	28.8	294.6	2F
		247.5	26.8	264.2	
		302.5	30.8	325.12	

To 1/2" (12.7) VTRANS RECEIVED
 To 3/8" (9.5) W/APP
 APR 9 8 1998
 4/17/08

This procedure may vary due to fabrication sequence, fit-up, pass size, etc., within the limitation of variables given in applicable A.W.S. codes or contract specifications

Procedure no. 101 Contractor Casco Bay Steel
 Revision no. 1 Authorized By A.C. Goodale
 Form III-2 Date 3/23/07

Casco Bay Steel Structures, Inc.
 5 Industry Road
 South Portland, Maine 04106

Phone: (207) 772-2533

Fax: (207) 772-0580


WELDING PROCEDURE SPECIFICATION

Material specification A36-A572-A588 (ASTM 709 GR 36-50-50w)
 Welding process Flux Cored Arc welding (FCAW)
 Manual or machine Semi-AUTO
 Position of welding Flat
 Filler metal specification EWS 5.20
 Filler metal classification E71T-1
 Flux NA
 Shielding gas 75% AR 25% CO₂ Flow rate 40 F5
 Electrode stick out 3/4" EVO
 Single or multiple pass Single
 Single or multiple arc Single
 Welding current Direct Current
 Polarity Reverse Electrode Positive
 Welding progression see Detail
 Root treatment None
 Preheat and interpass temperature None
 Postheat temperature None
 Heat input Min NA Max NA

RICA Ford, VT
 B-41C-41- Proj No. BHF-0302(3)S
 C 855 361

WELDING PROCEDURE

Pass no.	Electrode size	Welding current		Travel speed	AWS D1.5
		Amperes	Volts		
1/16	280	28	17	17 IPM ± 1.7	Filler
1.6	280	28	17	143.2 ± 43.2	Filler

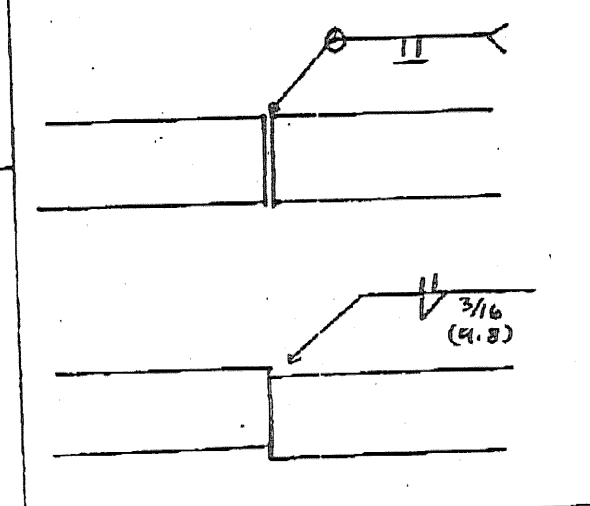

This procedure may vary due to fabrication sequence, fit-up, pass size, etc., within the limitation of variables given in applicable A.W.S. codes or contract specifications

Procedure no. 105 Contractor Casco Bay Steel
 Authorized By [Signature]
 Revision no. AWC

Casco Bay Steel Structures, Inc.
 5 Industry Road
 South Portland, Maine 04106

Fax: (207) 772-0580

Casco Bay Steel Structures, Inc.
5 Industry Road
South Portland, Maine 04106

Fax: (207) 772-0580

Phone: (207) 772-2533

WELDING PROCEDURE SPECIFICATION

Material specification ASTM A102 Gr 36-50 (250-345-345W)
 Welding process Shielded Metal Arc Welding (SMAW)
 Manual or machine Manual
 Position of welding Flat (PF) Horizontal (HF)
 Filler metal specification AWS/A51-A5.5
 Filler metal classification E7018-R018 C/C2-7028
 Flux NA
 Shielding gas NA
 Single or multiple pass Single and multiple
 Single or multiple arc Single
 Welding current AC/DC
 Polarity Straight/Reverse
 Root treatment Meet AWS specification
 Preheat and interpass temperature 50°(10°) 50°(10°) 300°(150°) 100°(50°) 150°(75°) 200°(100°) 250°(125°) 325°(165°) over 250°(125°) 325°(165°)
 Postheat temperature NA
 Heat input Min NA Max NA



Rich Ford, VT
By MC-41 - Proj No BHF-0302(3)S
C.B.S.S 361

(Metric)

Pass no.	Electrode size	Welding current		Travel speed	AWS D1.5	Joint detail	Filler
		Amperes	Volts				
AS	7/32 (3.2)	70-170	22-26	AS	1F		Filler
	5/32 (3.9)	120-225	22-26				
	3/16 (4.8)	170-300	24-27				
RF	7/32 (3.2)	90-160	22-26	RF	2F		Filler
	5/32 (3.9)	120-225	22-26				
	3/16 (4.8)	180-290	24-27				
RF	7/32 (3.2)	170-270	22-26	RF	3/16 to 3/8 (5 to 10)		Filler
	5/32 (3.9)	170-270	22-26				
	3/16 (4.8)	210-330	24-27				

This procedure may vary due to function sequence, fit-up, pass size, etc., within the limitation of variables given in applicable codes or contract specifications

Procedure no. 401
 Revision no. 1
 Contractor Casco Bay Steel
 Authorized By Paul E. Hordale
 Date 3/2/00

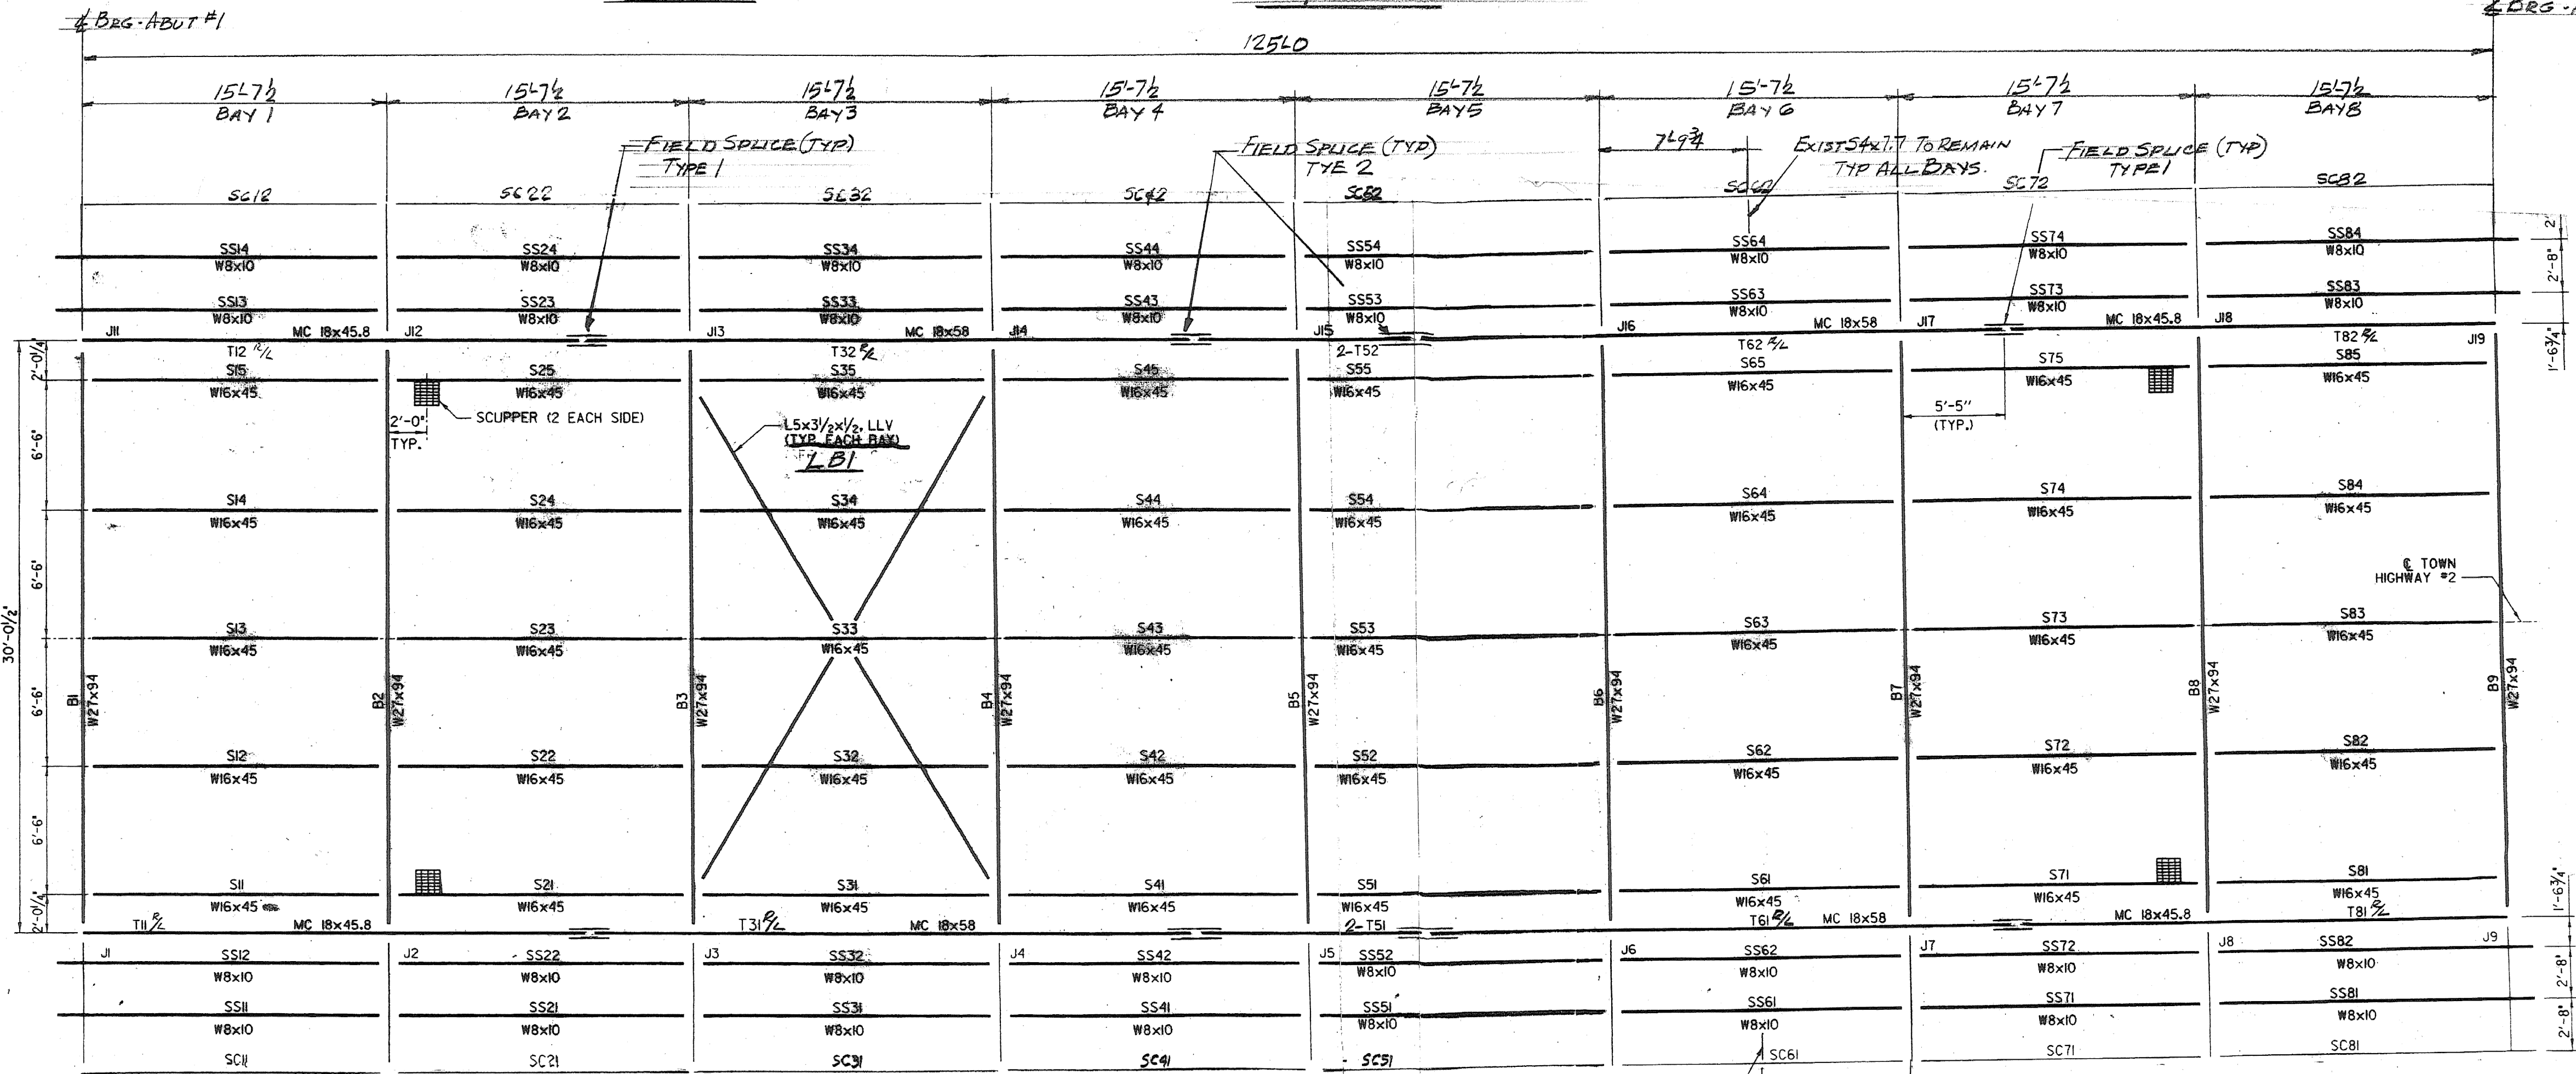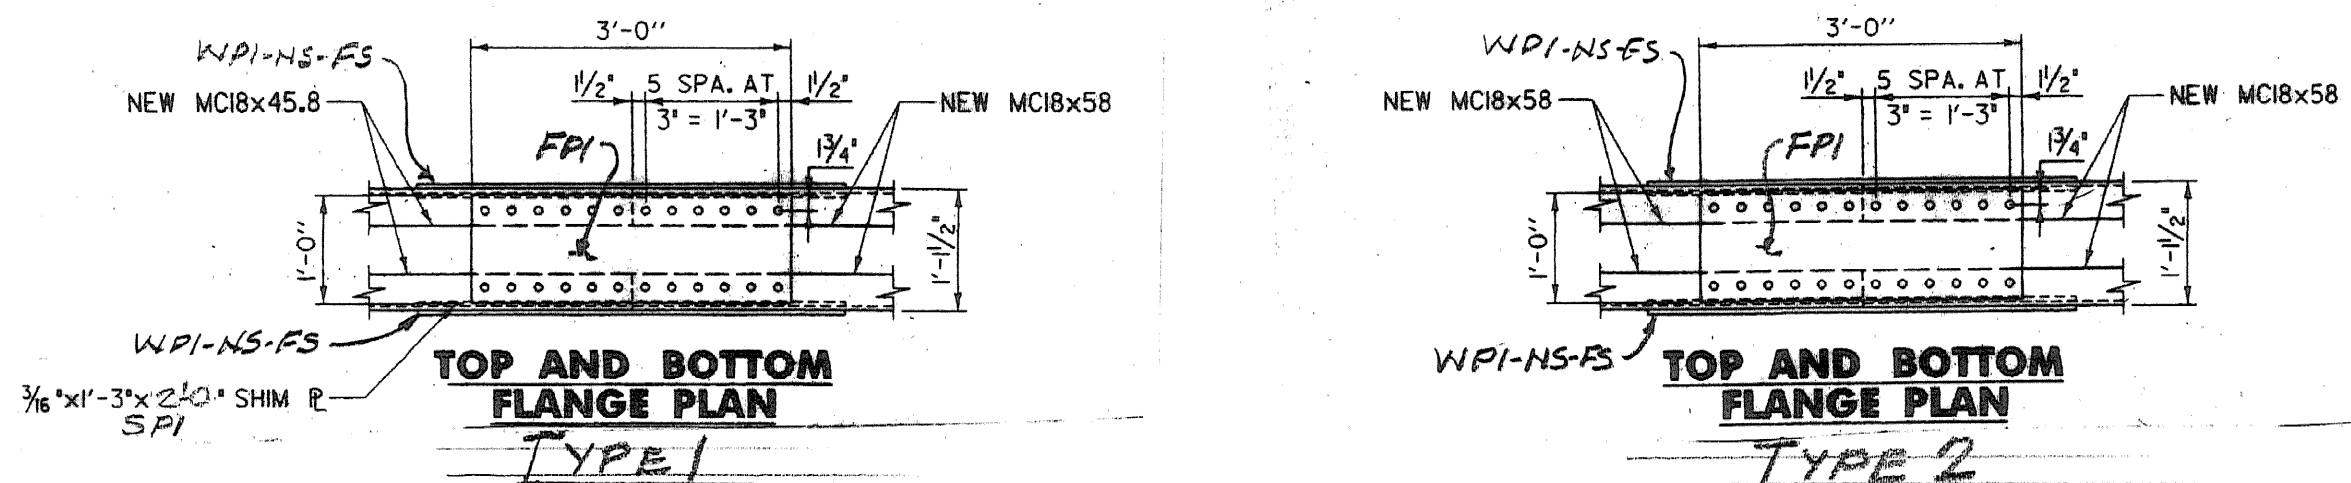

FRAMING PLAN

- LEGEND
 J = JOINT
 S = FLOOR STRINGER (NEW W16x45)
 B = BEAM (NEW W27x94)
 T = TRUSS BOTTOM CHORD (SEE PLAN)
 SS = SIDEWALK STRINGER (NEW W8x10)
 SC = EXISTING SIDEWALK CHANNEL (C7)
 — = NEW FRAMING MEMBER
 - - - = EXISTING FRAMING MEMBER TO BE RETAINED

SHOP DRAWINGS ARE REVIEWED UNLESS NOTED OTHERWISE

NO EXCEPTION TAKEN

REVISE AS NOTED

RESUBMISSION NOT REQUIRED

REVISE AS NOTED

RESUBMISSION

REJECTED

DATE 4/23/08

SIGNATURE Michael Clavitt

REVIEW BY: [Signature] DATE: [Blank]


DESIGNER: [Signature] DATE: [Blank]

CONTRACTOR: [Signature] DATE: [Blank]


FOR THE PURPOSE OF VERIFYING CONFORMANCE WITH DESIGN, CONTRACTOR IS RESPONSIBLE FOR DIMENSIONS, FABRICATION, AND CONSTRUCTION METHODS. COORDINATION OF SUB-TASKS, DETAILED DESIGN OF COMPONENTS, AND ERRORS OR OMISSIONS ON SHOP DRAWINGS.

Per Blow & Cote, Inc., all circled dimensions have been verified and they have released to fabricate using these dimensions. If all verification of existing holes for W27 and existing plates and angles can be verified prior to fabrication Casco Bay Steel Structures will shop drill. If not, Blow & Cote will field drill these holes.


OUT FOR APPROVAL	3/19/08									
OUT FOR APPROVAL	4/17/08									
ISSUED TO SHOP										
FIELD & OFFICE										
App'l Comments	4/17/08									
REV. REMARKS	DATE	DWN	CHK	APP	Q.A.	NO.	DIA.	LGT	TYPE	WASHER
PROJECT NO. BHF-0302(3) S STATE PROJECT NO.										
MATERIAL:		ELECTRODES:		HOLES:		SHOP BOLTS:				
SURFACE PREP. & PAINT:										
DESCRIPTION: FRAMING PLAN										
JOB: IMPROVEMENTS										
BRIDGE No. 41 ON TH No. 2										
RICHFORD, VT.										
CUSTOMER: BLOW & COTE INC.										
DRAWN BY: JPF DATE: 3-08										
CHKD BY: CR										
APPROV BY: [Signature]										
Q.A.										
CASCO BAY STEEL STRUCTURES, INC.										
75 SPRING HILL ROAD SACO, MAINE 04072										
PHONE (207) 282-7360 FAX. (207) 282-1179										
JOB NO. 361 DRG. NO. E1										
REV. [Signature]										

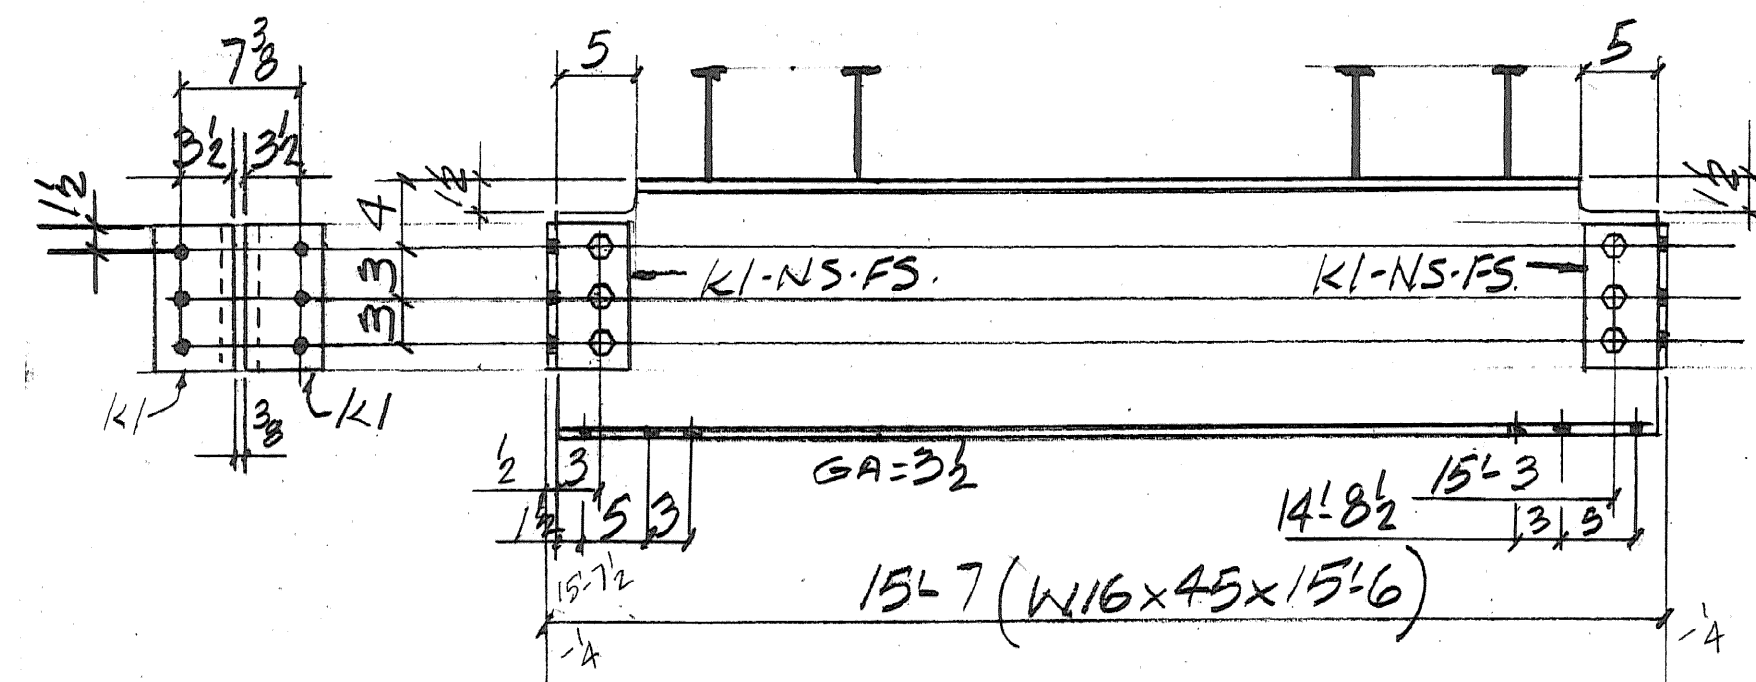

STRINGERS-S11-S21-S31-S41-S51-S61-S71-S81
 S15-S25-S35-S45-S55-S65-S75-S85
 MAKE ONE OF EACH

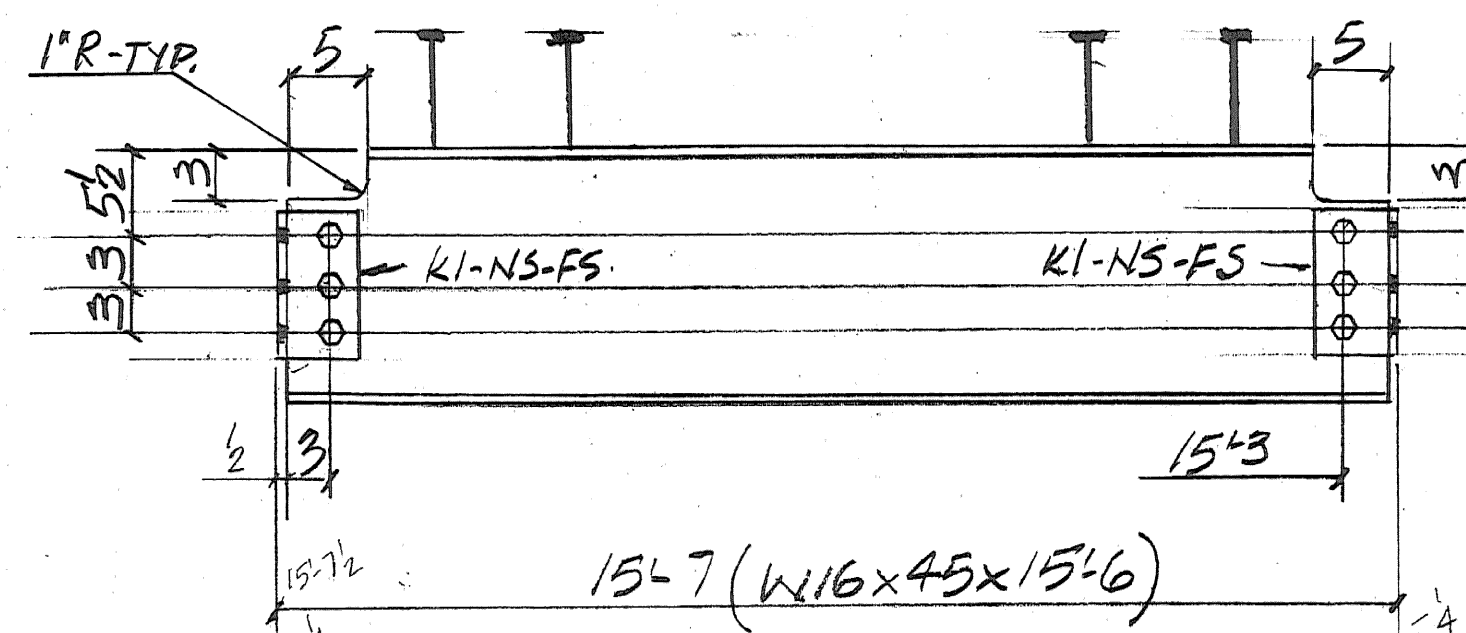


STRINGERS-S12-S22-S32-S42-S52-S62-S72-S82
 S14-S24-S34-S44-S54-S64-S74-S84
 MAKE ONE OF EACH

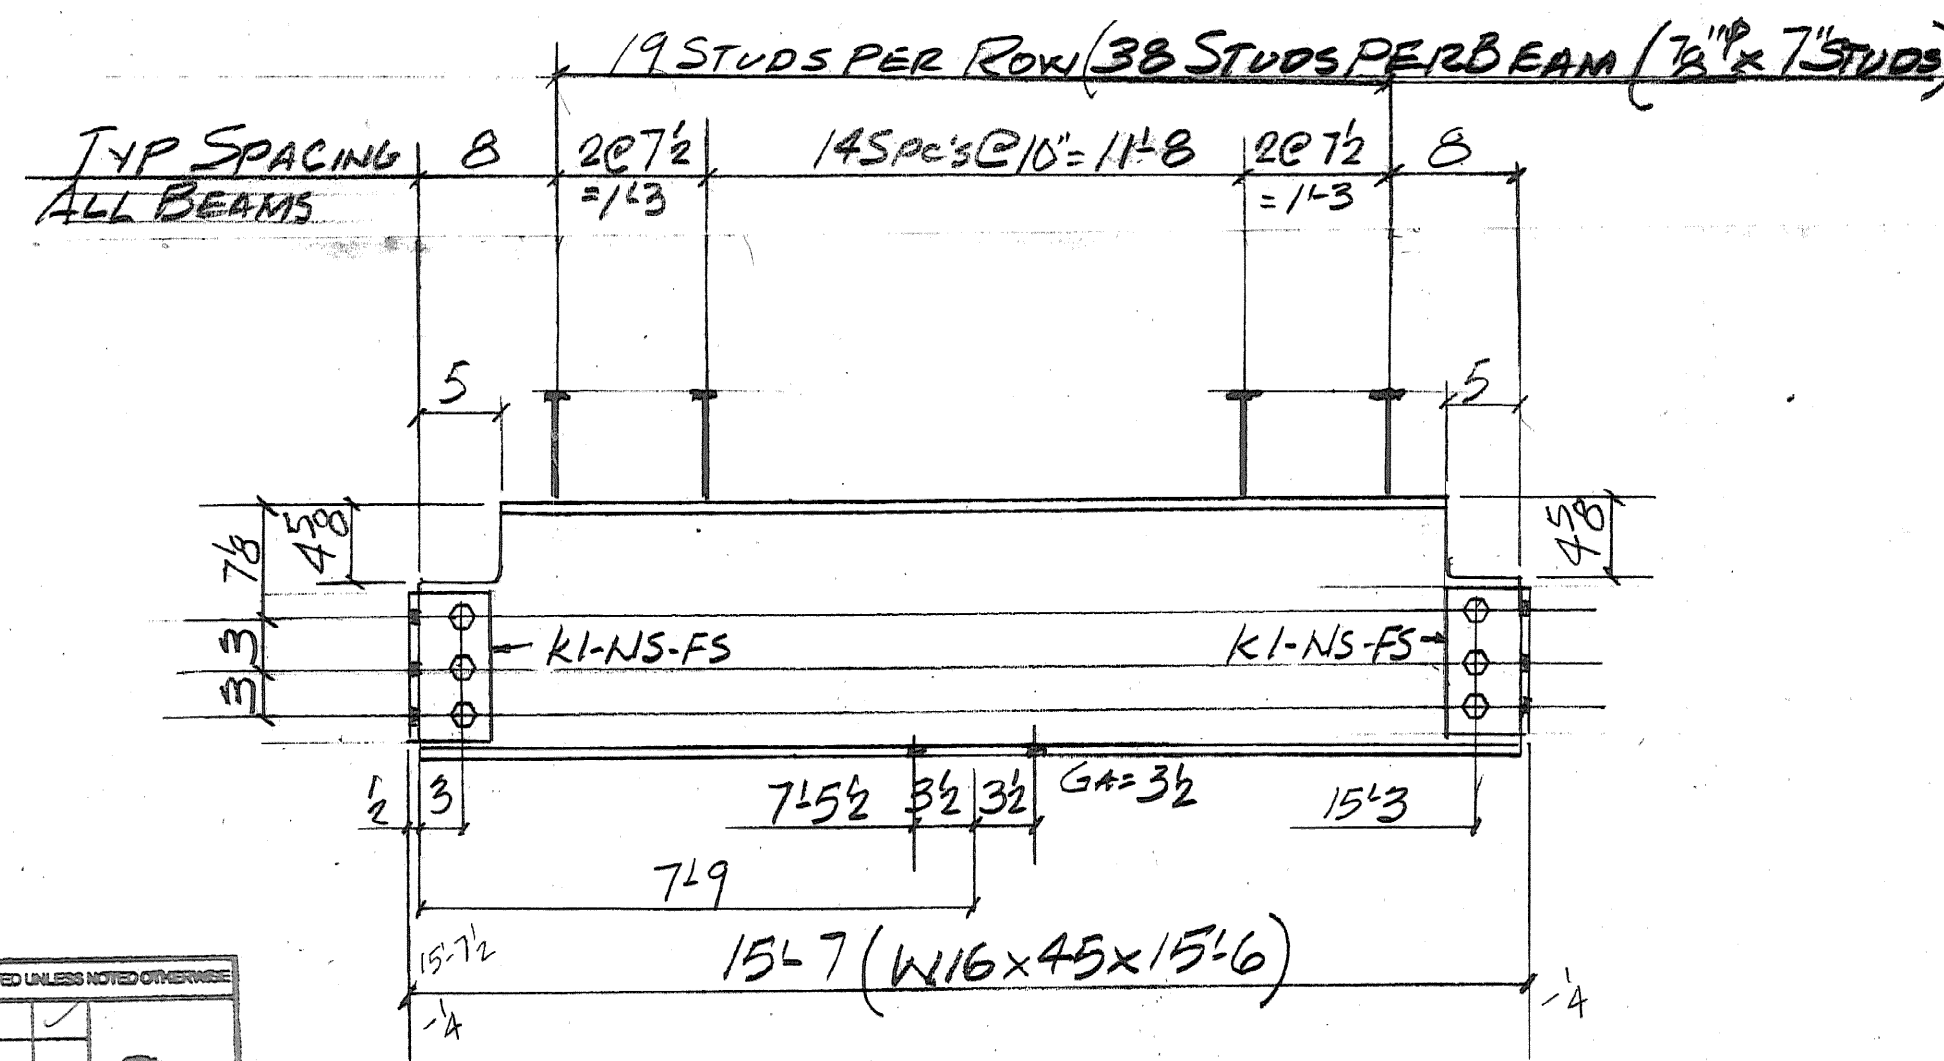

STRINGERS-S13-S23-S33-S43-S53-S63-S73-S83
 MAKE ONE OF EACH

SHOP DRAWINGS ARE REVIEWED UNLESS NOTED OTHERWISE
 NO EXCEPTION TAKEN
 REVISE AS NOTED
 PERMISSION NOT REV. NOTED
 REVISE AS NOTED
 PERMISSION NOT REV. NOTED
 REVISED
 DATE 4/23/08
 SIGNATURE: *Medical Abbott*
 REVIEW BY: _____ PURPOSE OF SUBMITTAL: _____
 DESIGN CONTROL: _____ DESIGNER'S RESPONSIBILITY: _____
 METHODS: _____ COORDINATION: _____ CONSTRUCTION: _____
 DETAIL DESIGN OF COMPONENTS AND ERRORS OR OMISSIONS ON SHOP DRAWINGS

- 2-SIDED CONN. TO BEAMS
- CONN. TO BEAMS B1&B9
- DOT. FLG. TO DRIVING PL.
- DOT. FLG. TO DRIVING PL.

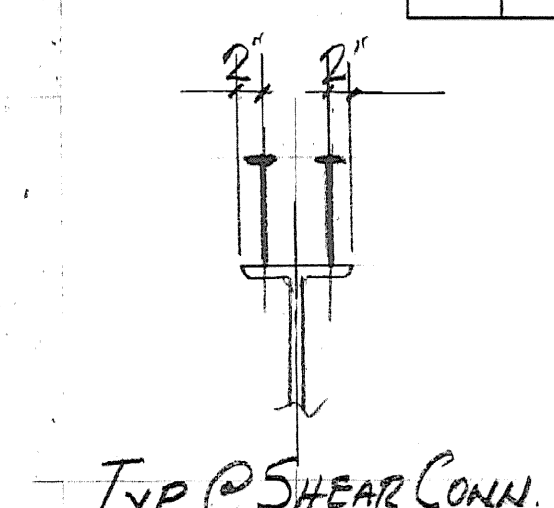

ABM INFO		SHOP BILL		JOB NO.	DRG. NO.				
PAGE	LINE	NO.	DESCRIPTION	FT	IN	ASSEM. MARK	SHIPPING MARK	REMARKS	WEIGHT
	1		W16x45	15	6			S11	
								S21	
								S31	
								S41	
								S51	
								S61	
								S71	
								S81	
								S15	
								S25	
								S35	
								S45	
								S55	
								S65	
								S75	
								S85	
								S12	
								S22	
								S32	
								S42	
								S52	
								S62	
								S72	
								S82	
								S14	
								S24	
								S34	
								S44	
								S54	
								S64	
								S74	
								S84	
								S13	
								S23	
								S33	
								S43	
								S53	
								S63	
								S73	
								S83	
			W16x45	15	6				
			150 3/4" SHEAR CONN	7		SHOP			
			160 L5x5x3/8	9		K1			
			240 3/8" A325-TC BOLTS	2 1/2		SHOP			
			FIELD BOLTS (A325-TC-GALV.)						
			210 3/8" BOLTS	2 1/2					
			60 DO	2 1/2					
			128 DO	2 1/2					
			64 DO	2 1/2					
			PHY ITEM 506.50						

OUT FOR APPROVAL 3/19/08
 OUT FOR APPROVAL 4/17/08
 ISSUED TO SHOP
 FIELD & OFFICE

1 ADDED STUDS 4-16-08 JPF


REV.	REMARKS	DATE	DNW	CHK	APP	Q.A.	NO.	DIA.	LGT	TYPE	WASHER

PROJECT NO. BHF-0302(3) 5 STATE PROJECT NO.
 MATERIAL: A325-TC BOLTS ELECTRODES: — HOLES: 1/8" DIA. SHOP BOLTS: 3/8" A325 TYPE: GALV.
 SURFACE PREP. & PAINT: SHERWIN WILLIAMS-CORDTHANE 1 GALVAPAC ONE PACK ZINC PRIMER 3.5 TO 4 MILS DFT

DESCRIPTION:	STRINGER DETAILS	DRAWN BY	DATE
JOB:	IMPROVEMENTS	JPF	3-08
	BRIDGE No. 41 ON TH No. 2	CHKD BY	
	RICHFORD, VT.	APPROV BY	
		Q.A.	

CUSTOMER: BLOW & COTE INC.
CASCO BAY STEEL STRUCTURES, INC. JOB NO. 361 DRG. NO. S3
 75 SPRING HILL ROAD SACO, MAINE 04072
 PHONE (207) 282-7360 FAX (207) 282-1179

Per Blow & Cote, Inc., all circled dimensions have been verified and they have released to fabricate using these dimensions. If all verification of existing holes for W27 and existing plates and angles can be verified prior to fabrication Casco Bay Steel Structures will shop drill. If not, Blow & Cote will field drill these holes.

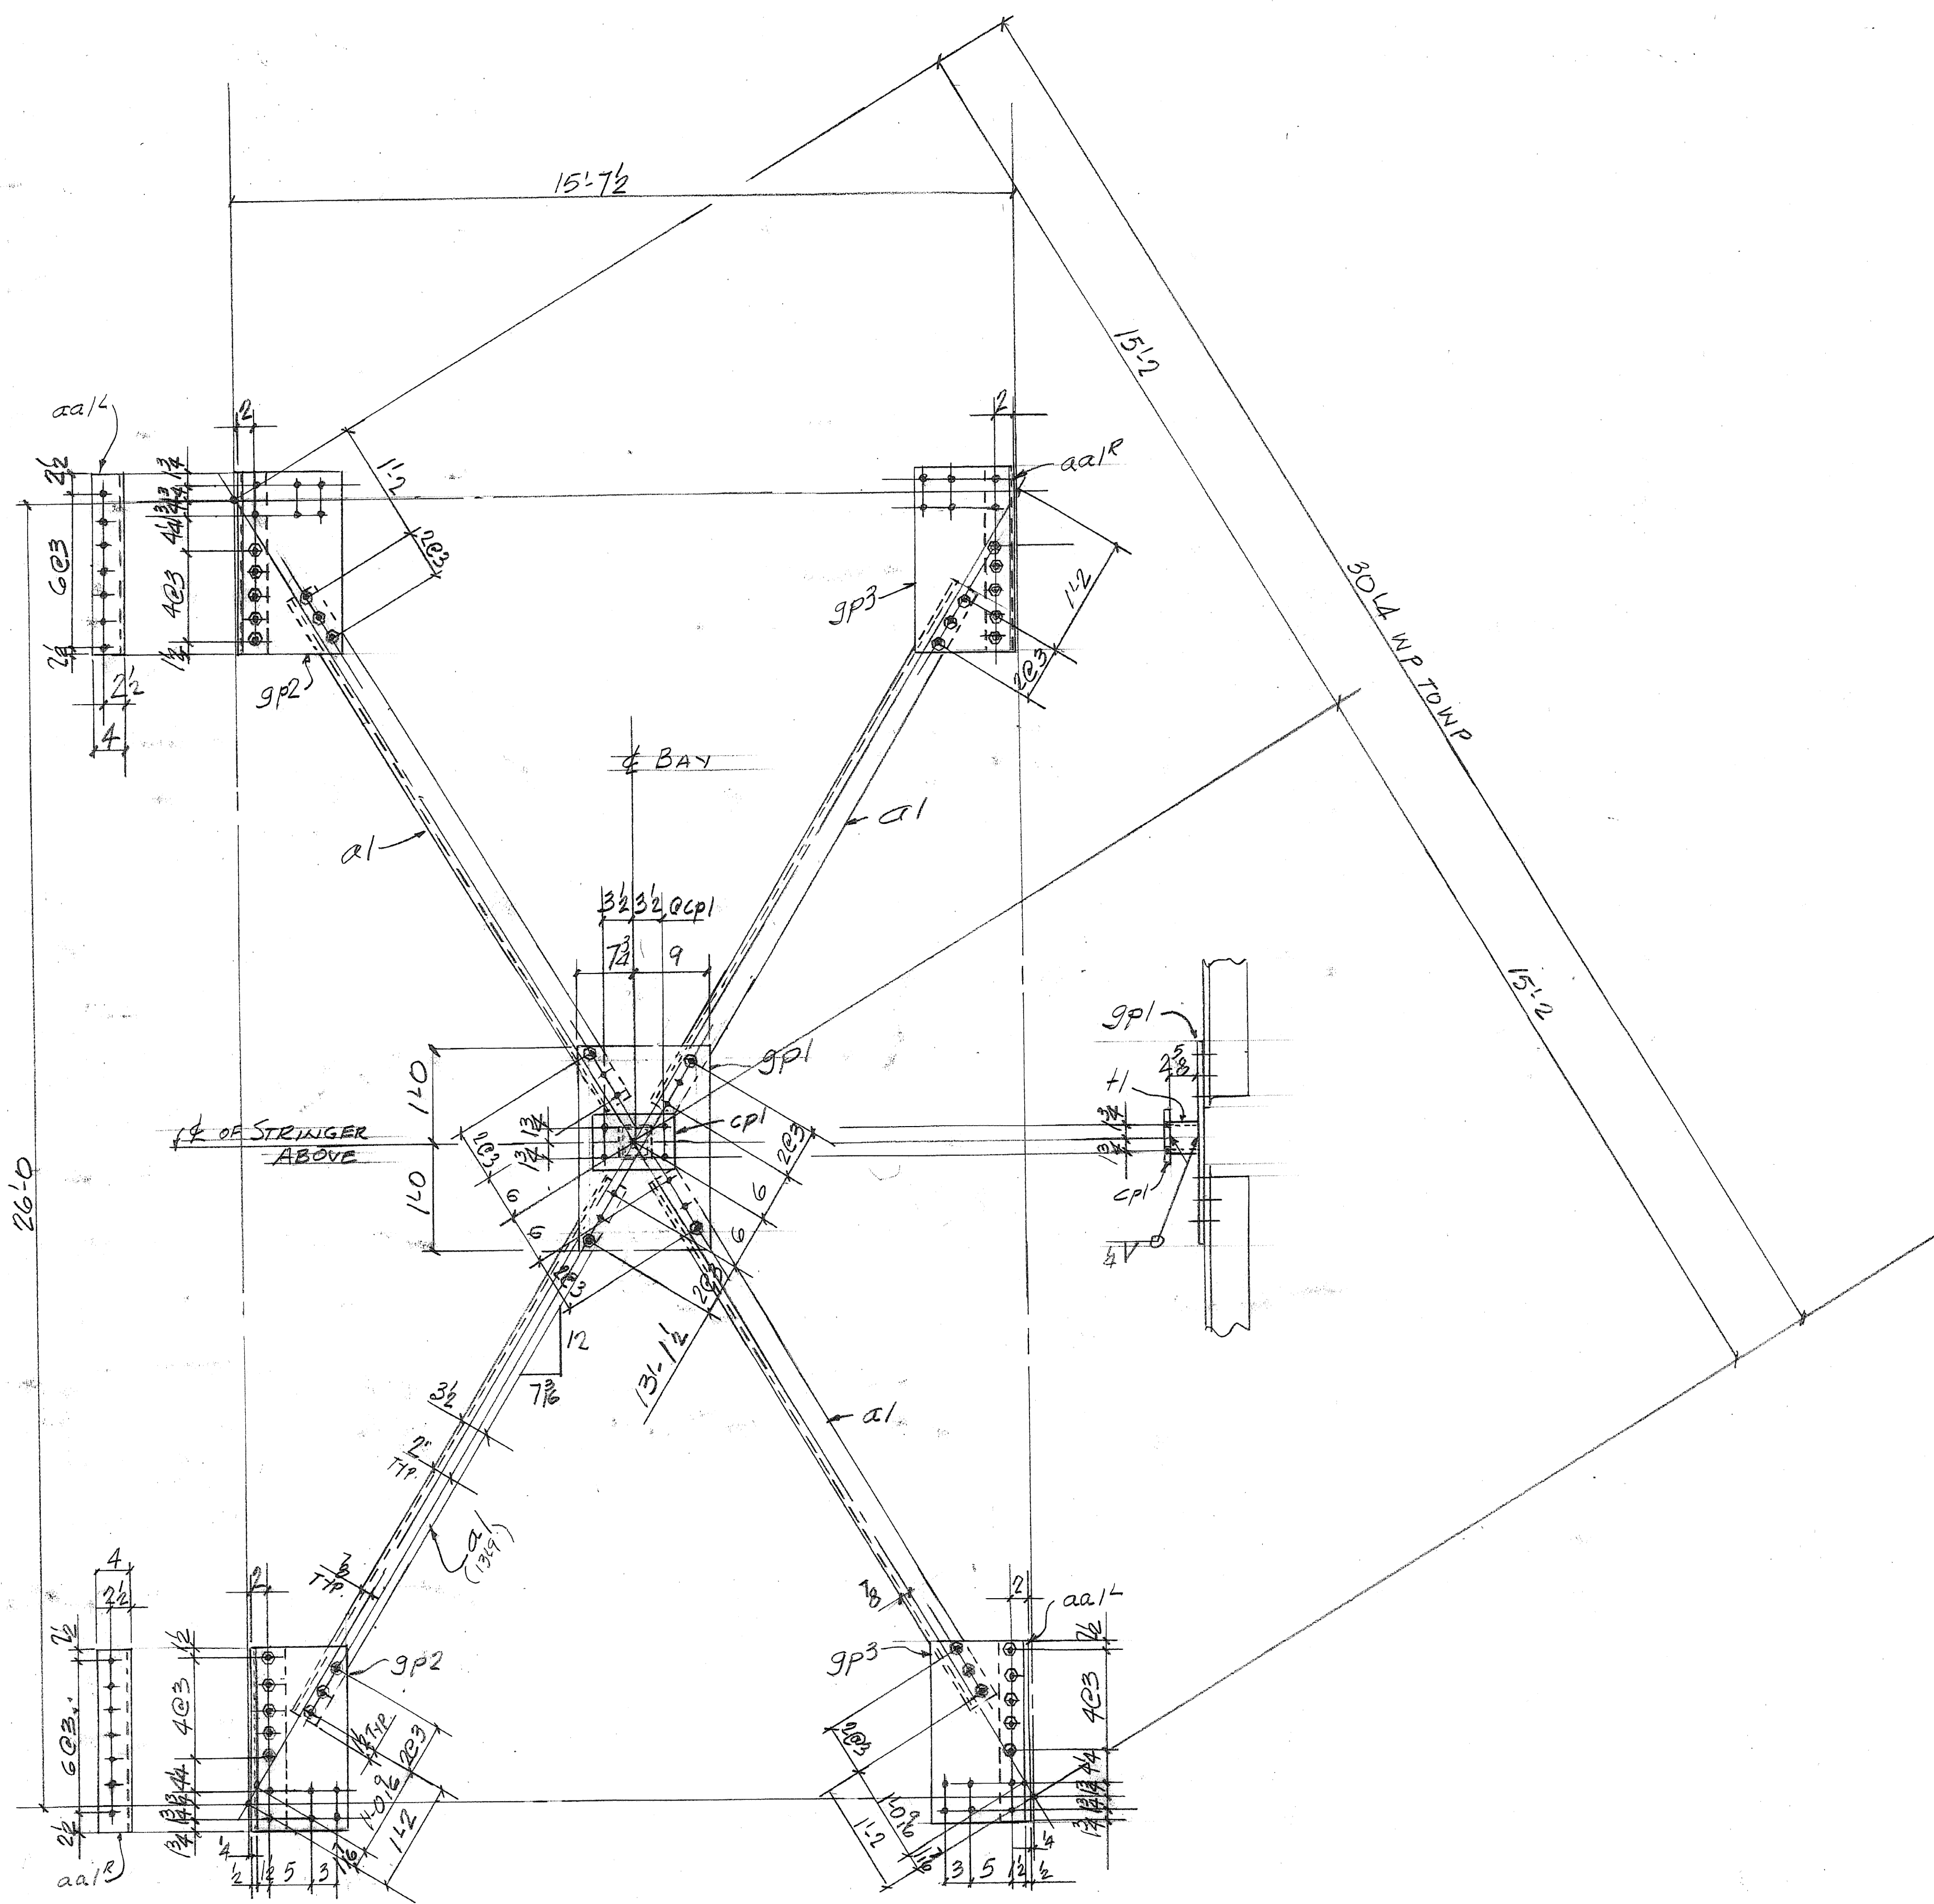

LBI-8-REQ'D

Per Blow & Cote, Inc., all circled dimensions have been verified and they have released to fabricate using these dimensions. If all verification of existing holes for W27 and existing plates and angles can be verified prior to fabrication Casco Bay Steel Structures will shop drill. If not, Blow & Cote will field drill these holes.

SHOP DRAWINGS ARE REVIEWED UNLESS NOTED OTHERWISE

NO EXCEPTION TAKEN	<input checked="" type="checkbox"/>
REVISE AS NOTED	<input type="checkbox"/>
RESUBMISSION NOT REQUIRED	<input type="checkbox"/>
REVISE AS NOTED	<input type="checkbox"/>
RESUBMISSION	<input type="checkbox"/>
REJECTED	<input type="checkbox"/>

DATE: 4/25/08

SIGNATURE: *Mickael Chant*

REVIEW BY: [Signature] TITLE: [Blank]

REVISION: [Blank]

REASON: [Blank]

DATE: [Blank]

DATE: [Blank]

ABM INFO		SHOP BILL				JOB NO.	DRG. NO.		
PAGE	LINE	NO.	DESCRIPTION	FT	IN	ASSEM. MARK	SHIPPING MARK	REMARKS	WEIGHT
	8		BRACING	30	01		LBI		
	32		L5x3 1/2x2	13	9	a1			
	8		1 1/2 x 10 3/4	2	0	gp1			
	16		1 1/2 x 12	1	11	gp2			
	16		DO	1	11	gp3			
	16		L4x3 1/2x3/8	1	11	aa1R			
	16		DO	1	11	aa1L			
	8		1 1/2 x 7	10		gp1			
	8		T5 4x4x3/8	2 1/2		f1			
	288		1/2" A325-TC BOLTS	2 1/2		SHOP		"NEW GALV.	
FIELD BOLTS (A325-TC-GALV.)									
	124		2" BOLTS	2 1/2				"NEW GALV.	
	98		DO	3				DO	
PAY ITEM 506.50									

CONN TO BEAM (D/B)
BRACING TO GUSSET
CONN TO POST STRANGERS
2 STEEL CONN. TO BEAMS

OUT FOR APPROVAL	3/19/08									
OUT FOR APPROVAL	4/17/08									
ISSUED TO SHOP										
FIELD & OFFICE										
App's Comments 4/17/08										
REV. REMARKS	DATE	DWN	CHK	APP	Q.A.	NO.	DIA.	LGT	TYPE	WASHER
PROJECT NO. BHF-0302 (3)5 STATE PROJECT NO.										
MATERIAL: A572-50 ELECTRODES: 505 PROC HOLES: 1/8" HP SHOP BOLTS: 1/2" A325 TC-GALV.										
SURFACE PREP. & PAINT:										
SHERWIN WILLIAMS-COROTHANE 1 GALVAPAC ONE PACK ZINC PRIMER 3.5 TO 4 MILS DFT										
DESCRIPTION: LATERAL BRACING								DRAWN BY	DATE	
JOB: IMPROVEMENTS BRIDGE No. 41 ON TH No. 2 RICHFORD, VT.								UPF	3-08	
								CHKD BY		
								APPROV BY		
								Q.A.		
CUSTOMER: BLOW & COTE INC.										
CASCO BAY STEEL STRUCTURES, INC.								JOB NO.	DRG. NO.	
75 SPRING HILL ROAD SACO, MAINE 04072								361	55	
PHONE (207) 282-7360 FAX (207) 282-1179								REV.	A	

Casco Bay Steel Structures, Inc.

75 Spring Hill Road
Saco, Maine 04072

Phone: (207) 282-7360


Fax: (207) 282-1179

WELDING PROCEDURE SPECIFICATION

Material specification ASTM-A709/A709M-Gr36-50-50w(250-345-345W)
 Welding process STUD WELDER (S.W.)
 Manual or machine Machine
 Position of welding Flat
 Filler metal specification NA
 Filler metal classification NA
 Flux NA
 Shielding gas NA Flow rate NA
 Single or multiple pass single
 Single or multiple arc single
 Welding current DC EN
 Polarity DC EN
 Welding progression NA
 Root treatment Clean surface to be welded
 Preheat and interpass temperature To 34-50° 3/4" to 1 1/2" 70° 1 1/2" to 2 1/2" 150° over 2 1/2" 225°
 Postheat temperature NA
 Heat input Min NA Max NA

Rick Ford, VT
Br. No. 41- Proj. No. BHF-0302(3)S
C 855 361

WELDING PROCEDURE

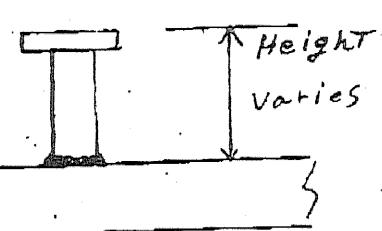Pass no.	Electrode size	Welding current		Travel speed	Joint detail
		Amperes	Volts		
	STUD size		Weld TIME		
1/2	350	35	NA		
	650	35			
5/8	350	35			
	650	35			
3/4	550	40			
	750	40			
7/8	650	1.0			
	850	1.0			

Note:
This procedure is only a guide to setup.

This procedure may vary due to fabrication sequence, fit-up, pass size, etc., within the limitation of variables given in applicable A.W.S. codes or contract specifications.

Procedure no. # I S.W.
 Revision no. _____
 Form III-2

Contractor Casco Bay Steel
 Authorized By [Signature]
 Date May 3-1999




WELDING PROCEDURE SPECIFICATION

Material specification A36-A572-A578 (ASTM A36 or 36-50-50w)
 Welding process Flux Cored Arc welding (FCAW)
 Manual or machine semi-AUTO
 Position of welding FLAT-1G
 Filler metal specification AWS A5-20
 Filler metal classification E71T-1
 Flux NA
 Shielding gas 75% AR 25% CO₂ Flow rate 40 SS
 Single or multiple pass Both Electrode STICK OUT 3/4 - 1/4
 Single or multiple arc Single
 Welding current Direct Current
 Polarity Reverse Electrode positive
 Welding progression See Detail
 Root treatment see side 1, backside 2 - grind - then weld
 Preheat and interpass temperature To 50-50 (10-10) 3/4 to 1/2 (10-20)
 Postheat temperature NA
 Heat Input Min NA Max NA
 RICH FWD UT
 BY UC 41 - Proj No BHF-0302(S)S
 C 855 361

WELDING PROCEDURE

Pass no.	Electrode size	Welding current		Travel speed
		Amps	Volts	
	1/16	280 ±28	25 ±1.7	11 ±1.1
	1/8	280 ±28	25 ±1.7	280 ±28

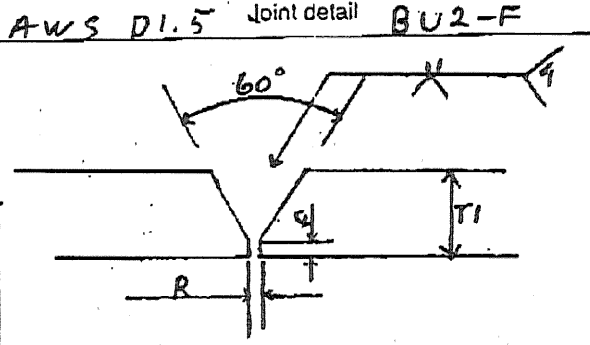AWS D1.5 Joint detail BU2-F

 T- UNLIMITED
 T-0 to 1/8 / 0 to 3.2 mm
 R-0 to 1/8 / 0 to 3.2 mm
 1-grind as required

This procedure may vary due to fabrication sequence, fit-up, pass size, etc., within the limitation of variables given in applicable A.W.S. codes or contract specifications

Procedure no. 104 Contractor Casco Bay Steel
 Revision no. AWS-OC1 Authorized By Paul E. Goodale
 Form #2 Paul E. Goodale Date 2/2/99
 BSI00201
 C.W.I.

Casco Bay Steel Structures, Inc.

75 Spring Hill Road
Saco, Maine 04072

Phone: (207) 282-7360

Fax: (207) 282-1179

WELDING PROCEDURE SPECIFICATION

Material specification ASTM A709/A709M - Grade 36 (50) 50 (45) 50 W (346W)
 Welding process Flux Cored Arc Welding
 Manual or machine SEMI AUTO
 Position of welding Fillet (1F) Horizontal (2F)
 Filler metal specification AWS A5.20
 Filler metal classification E71T-1
 Flux NA
 Shielding gas 75% AR 25% CO2 Flow rate 40 CFH ± 3
 Single or multiple pass SINGLE and MULTIPLE - Electrode Extension 9/8" ± 4 (5.8) ± 6.35
 Single or multiple arc SINGLE
 Welding current DC
 Polarity Reverse
 Welding progression _____
 Root treatment AWS specification
 Preheat and interpass temperature to 3/4" (19) 50 (10) - 3/4" (19) 70 (80) to 1/2" (13) 150 (65)
 Postheat temperature NA
 Heat input Min NA Max NA

RICH FORD, VT
 BR NO. 41 - Proj No BHF-0302(3)S
 C 855 361

(METRIC)

Pass no.	Electrode size	Welding current		Travel speed	Joint detail
		Amperes	Volts		
1/16	1/16	205	28.8	11.6	1F
		247.5	26.8	10.4	
		302.5	30.8	12.8	
1.6	1.6	205	28.8	294.6	2F
		247.5	26.8	264.2	
		302.5	30.8	325.12	


Joint detail: Fillet

Diagram:

RECEIVED BY: JUC
 DATE: 4/17/08

This procedure may vary due to fabrication sequence, fit-up, pass size, etc., within the limitation of variables given in applicable A.W.S. codes or contract specifications

Procedure no. 101 Contractor Casco Bay Steel
 Revision no. _____ Authorized By Paul E. Goodale
 Date 3/23/08

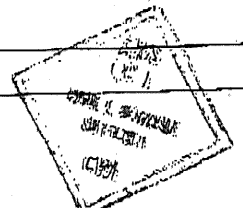

Casco Bay Steel Structures, Inc.

5 Industry Road
South Portland, Maine 04106

Phone: (207) 772-2533

Fax: (207) 772-0580


WELDING PROCEDURE SPECIFICATION

Material specification A36-A572-A588 (ASTM 709 GR 36-50-50W)
 Welding process Flux Cored Arc welding (FCAW)
 Manual or machine Semi-AUTO
 Position of welding FLAT
 Filler metal specification AWS 5.20
 Filler metal classification E71T-1
 Flux NA
 Shielding gas 75% AR 25% CO₂ Flow rate 40 F5
 Single or multiple pass Single Electrode stick out 3/4" ± 1/4"
 Single or multiple arc SINGLE
 Welding current Direct Current
 Polarity Reverse Electrode Positive
 Welding progression see Detail
 Root treatment None AWS Weld from one side only
 Preheat and interpass temperature 2 to 3/4-50° (19-10°) + 3/4 to 1 1/2-90° (19 to 38-20°)
 Postheat temperature NA
 Heat Input Min NA Max NA

Rich Ford, VT
 B.P. No. 41 - Proj No. BHF-0302(3)S
 C.B.S.S. 361

WELDING PROCEDURE

Pass no.	Electrode size	Welding current		Travel speed	AWS D1.5	Filler
		Amperes	Volts			
	1/16	280 ± 28	25 ± 1.7	17 IPM ± 1.7	Square groove joint detail	BUTT
	1.6	280 ± 28	25 ± 1.7	432 ± 43.2		

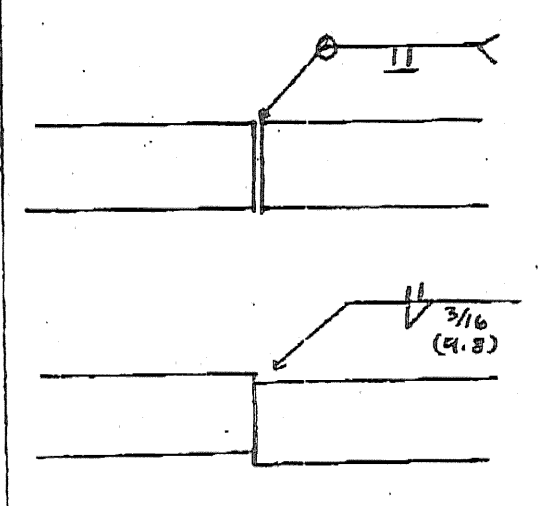

This procedure may vary due to fabrication sequence, fit-up, pass size, etc., within the limitation of variables given in applicable A.W.S. codes or contract specifications.

Procedure no. 1.05 Contractor Casco Bay Steel
 Revision no. AWC Authorized By J.P. [Signature]

Casco Bay Steel Structures, Inc.

5 Industry Road
South Portland, Maine 04106

Fax: (207) 772-0580

Phone: (201) 114-4533

WELDING PROCEDURE SPECIFICATION

ASTM A109 Gr 36-50-50W (250-345-345W)
 Material specification: SAILED Metal Arc Welding (SMAW)
 Welding process: Manual
 Position of welding: Flat (F) Horizontal (HF)
 Filler metal specification: AWS/A51-A5.5
 Filler metal classification: E7018-R1B E₆₃-T02B
 Shielding gas: NA Flow rate: NA
 Single or multiple pass: Single and multiple
 Single or multiple arc: Single
 Welding current: AC/D
 Polarity: Straight/Reverse
 Preheat and interpass temperature: 70°(160°) to 140°(280°) to 210°(400°) 150°(300°)
 Postheat temperature: NA
 Heat input: Min NA Max NA
 RICH FORD, VT
 Box No. 41 - Proj No. BHF-0302(3)S
 C855 361

Pass no.	Electrode size	Welding current		Travel speed	AWS D1.5	Joint detail
		Amperes	Volts			
A5	2018 1/8 (3-2)	70-170	22-26	AS	IF	
	5/32 (3-9)	120-225	22-26			
	3/16 (4-8)	170-300	24-27			
REQ	2018 1/8 (3-2)	90-160	22-26	RF	2F	
	5/32 (3-9)	120-225	22-26			
	3/16 (4-8)	180-290	24-27			
REQ	2018 1/8 (3-2)	170-270	22-26	RF	2F	
	5/32 (3-9)	170-270	22-26			
	3/16 (4-8)	210-330	24-27			

This procedure may vary due to fabrication sequence, fit-up, pass size, etc., within the limitation of variables given in applicable codes or contract specifications.

Procedure no. 401
 Revision no. 001
 Form 11-2
 Contractor: Casco Bay Steel
 Authorized By: Paul E. Hordale
 Date: 3/2/00

TRANS RECEIVED
 CKD BY: JUC
 RESUBMIT APPROVE
 BY: WBJ Date: 4/17/08

Contractor is Field Verify width Between Top of Existing CURBS

SHOP BILL				JOB NO. 351	DRG. NO. J1				
ABM INFO	PAGE	LINE NO.	DESCRIPTION	FT	IN	ASSEM MARK	SHIPPING MARK	REMARKS	WEIGHT
		1	EXP JOINT	26	03		EJ1		
		1	L8x4x2	13	5	aa1			
		1	DO	13	5	ab1			
		1	DO	13	5	aa2			
		1	DO	13	5	ab2			
		2	BAR 5/8x1/4	13	3/2	ba1		FURNISH EQUAL LENGTHS	
		2	DO	13	3/2	bb1		DO	
		5	R2x6	10		bea			
		5	DO	1		beb			
		5	R2x8	10		bfa			
		5	DO	1		bfb			
		56	3/4" HEX BOLTS	22		ma1		W/HEAVY HEX NUTS & PLASTIC CAPS	
		48	3/4" ANC STUDS	10		mc1			
		1	PERFORMED FABRIC TROUGH 5/8x2x6	27	04	mf1		3PLY PER SUBJECT 707.07	
		2	BUTYL RUBBER TAPE 1/2x3	27	04	mg1		PER SUBJECT 707.07	
		20	1" HEADON ROVS 1	1		TS1		A307	
		20	DO	7		TS2		A307	
		80	1" HEX NUTS					FIELD	
		80	R3/8x3	3				W1	R. WASH
		5	R2x8	9		API			
		20	3/4" ANC STUDS	10		mc1			
		6	L4x4x1/2	1		sa1			
		12	3/4" BOLTS	3		shop			

PAY ITEM: S16.11




OUT FOR APPROVAL	3/29/08
OUT FOR APPROVAL	
ISSUED TO SHOP	
FIELD & OFFICE	

REV.	REMARKS	DATE	DWN	CHK	APP	Q.A.	NO.	DIA.	LGT	TYPE	WASHER
PROJECT NO. BHF-0302(3)S STATE PROJECT NO.											
MATERIAL: A307 ELECTRODES: SEE PROC HOLES: AS NOTED SHOP BOLTS: 3/8" A325 GALV.											
SURFACE PREP. & PAINT:											


GALVANIZE PER SUB SECT. 506.15

DESCRIPTION: EXP. JOINT ABUT. #1	DRAWN BY: JPF	DATE: 3-08
JOB: IMPROVEMENTS BRIDGE No. 41 ON TH. No. 2 RICHFORD, VT.	CHKD BY: CR	APPROV BY:
	Q.A.	

CUSTOMER: BLOW & COTE INC.	JOB NO. 361	DRG. NO. J1
CASCO BAY STEEL STRUCTURES, INC.	75 SPRING HILL ROAD SACO, MAINE 04072	PHONE (207) 282-7360 FAX (207) 282-1179
	REV. 1	

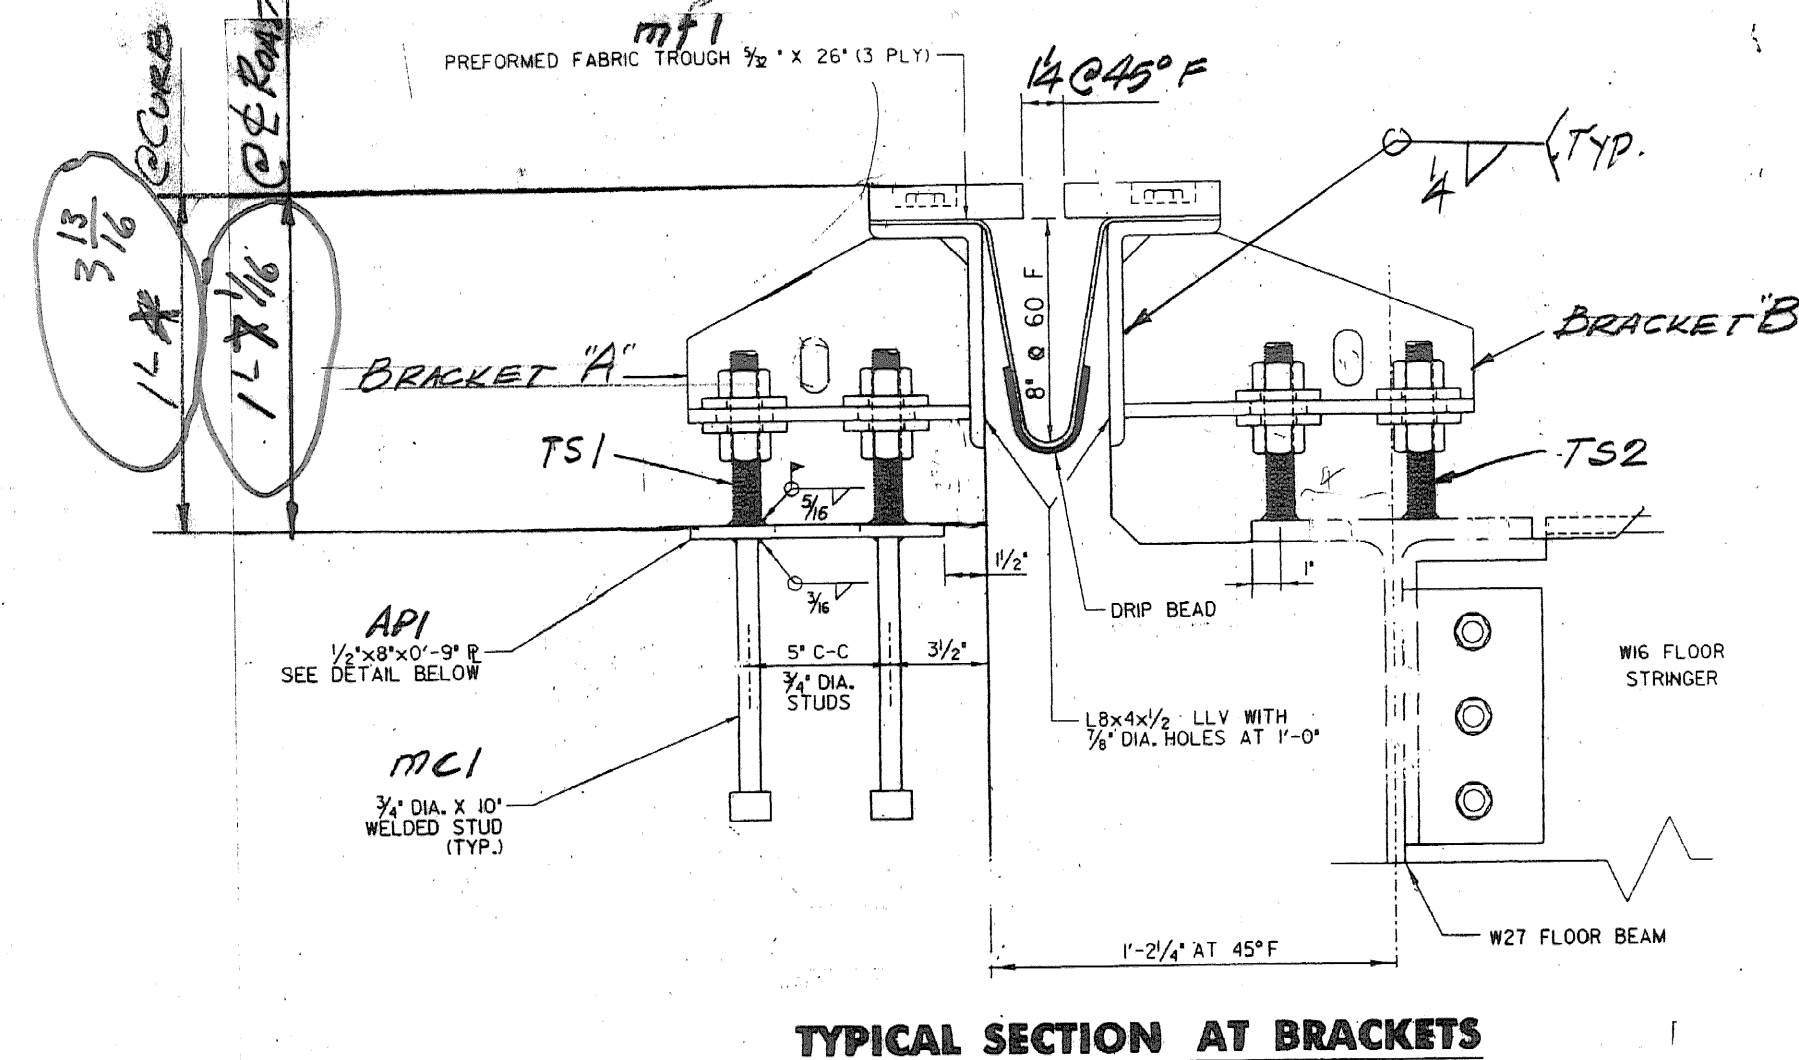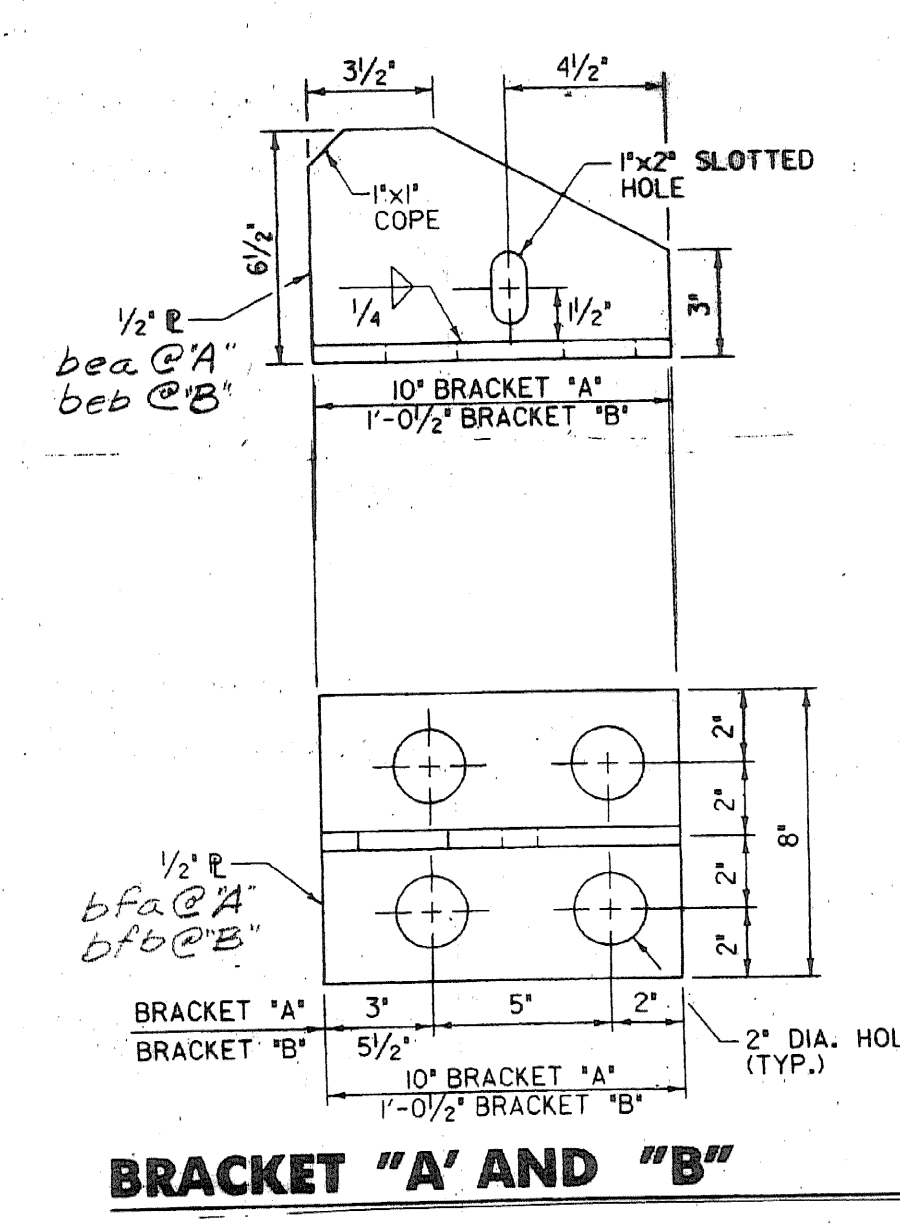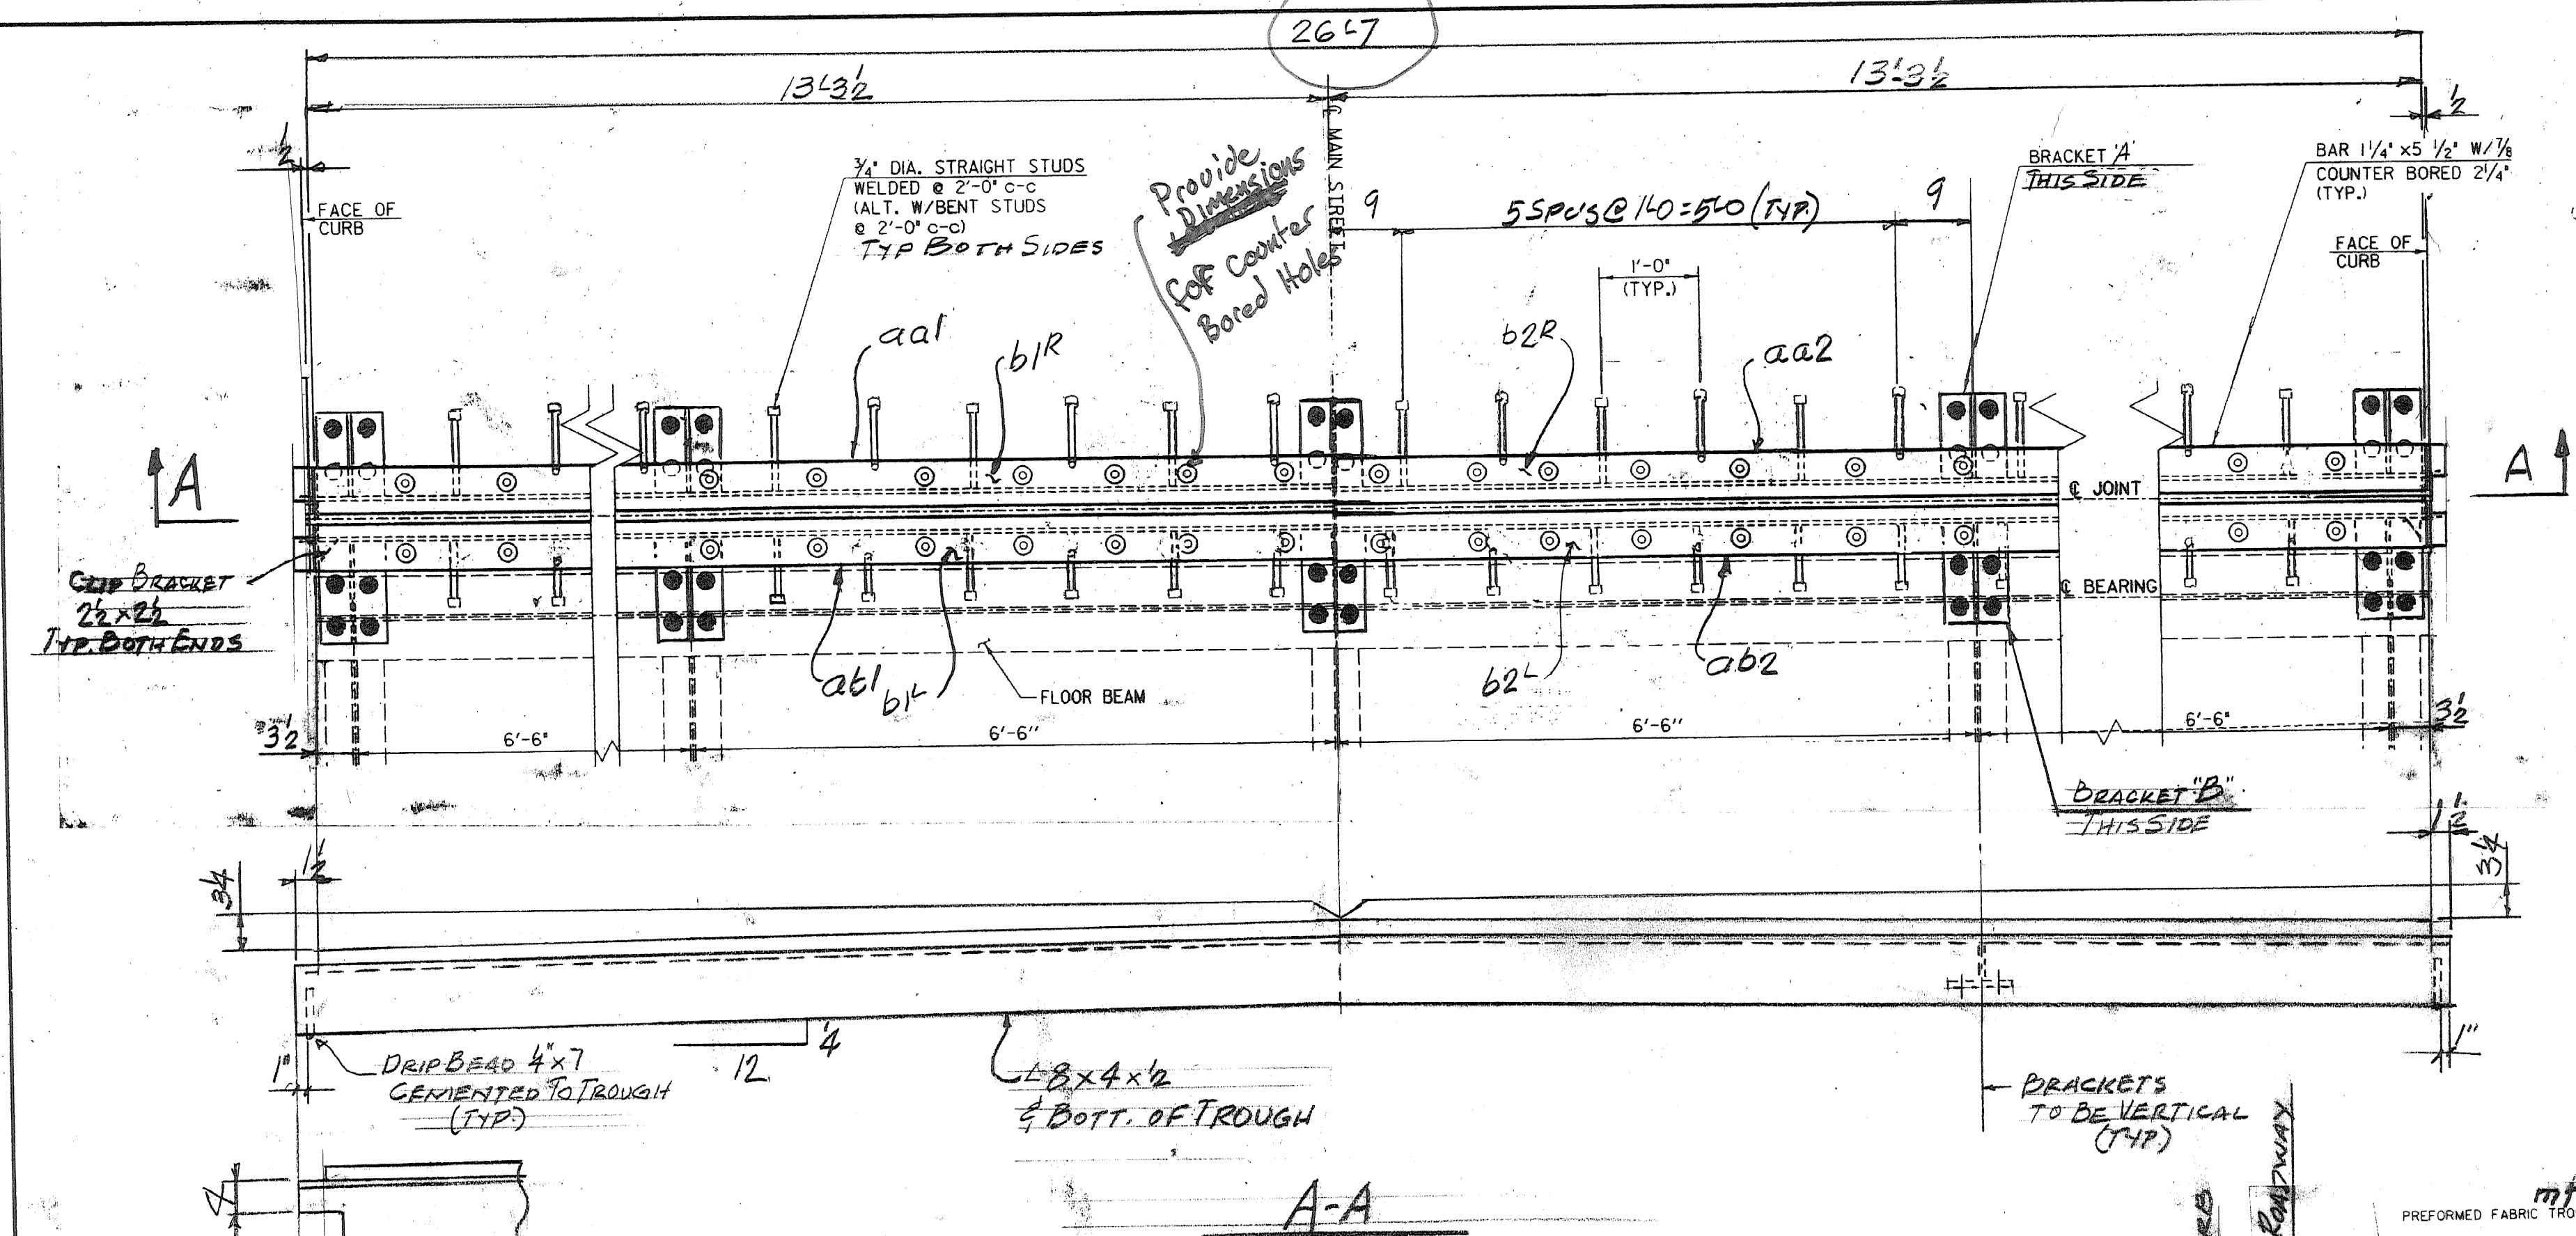


TYPICAL SECTION AT BRACKETS

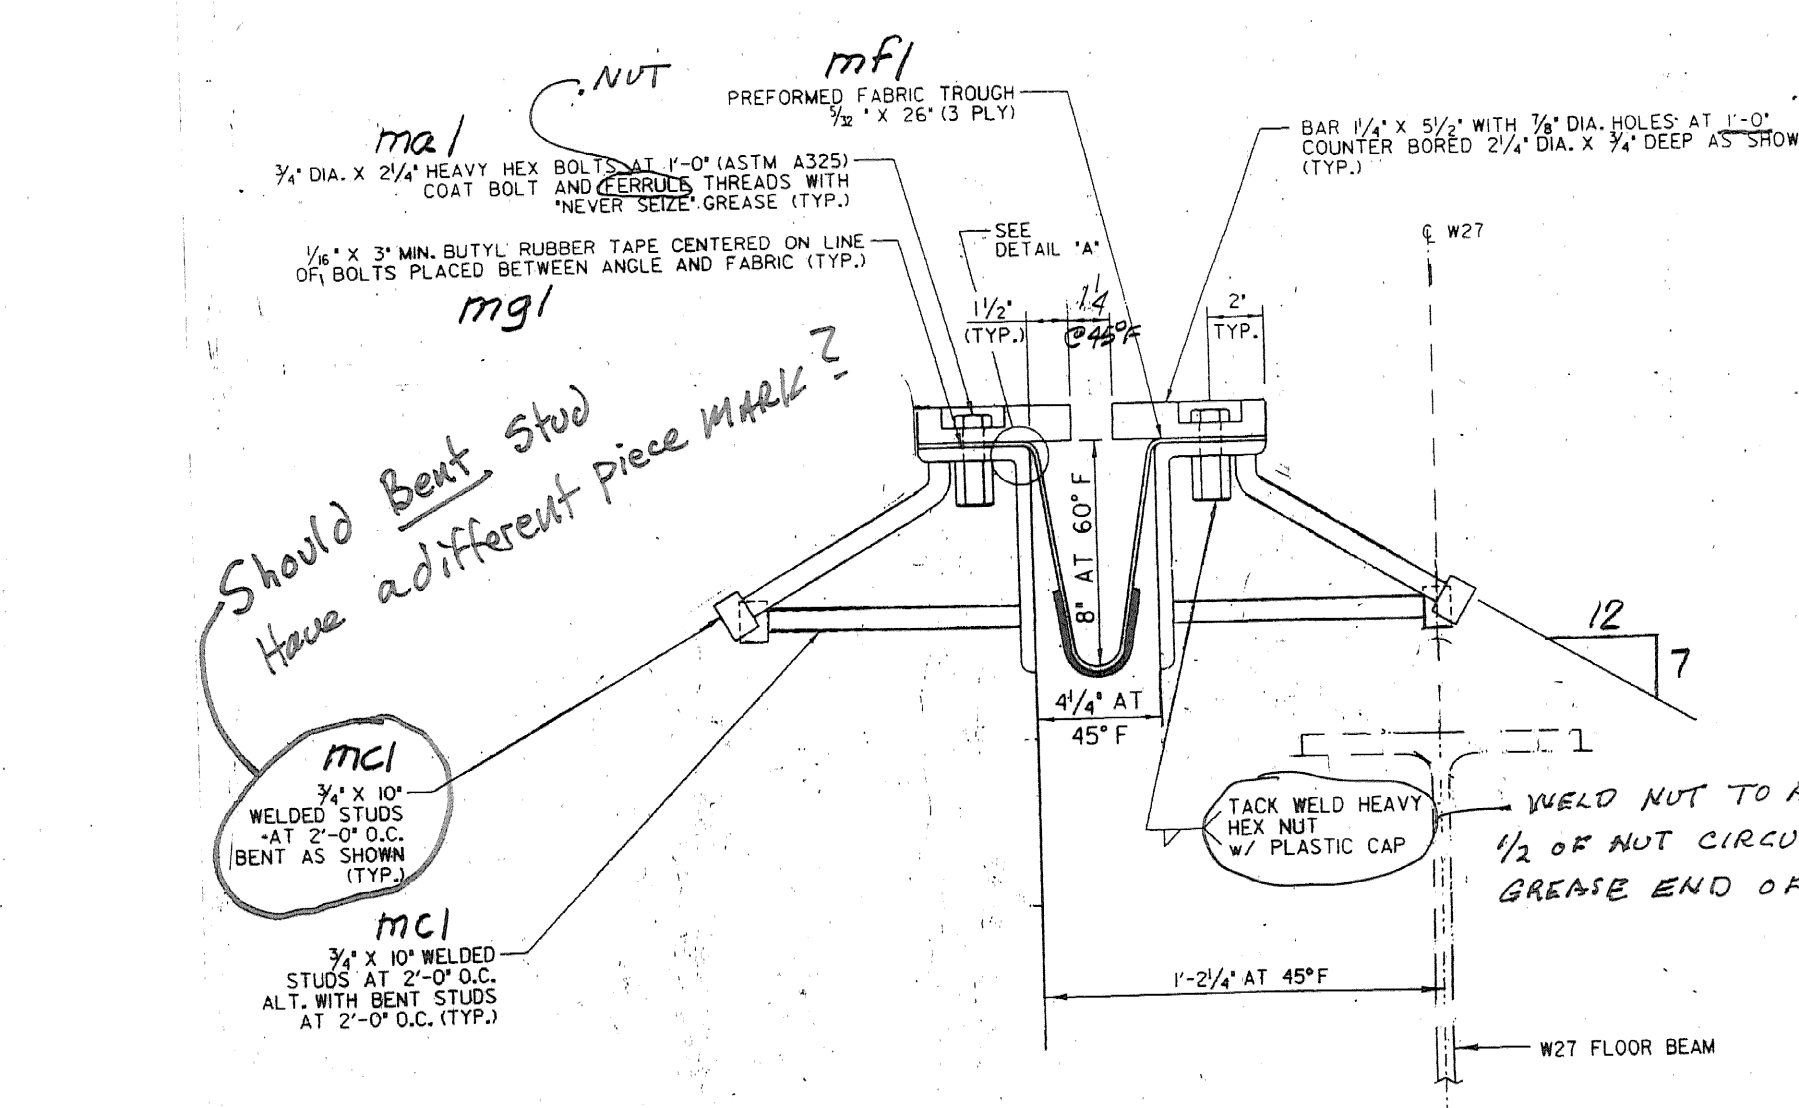

TYPICAL SECTION BETWEEN BRACKETS


TYP. DETAIL @ ab1 & ab2

EJ1 ONE REQ'D (@ ABUT. #1)

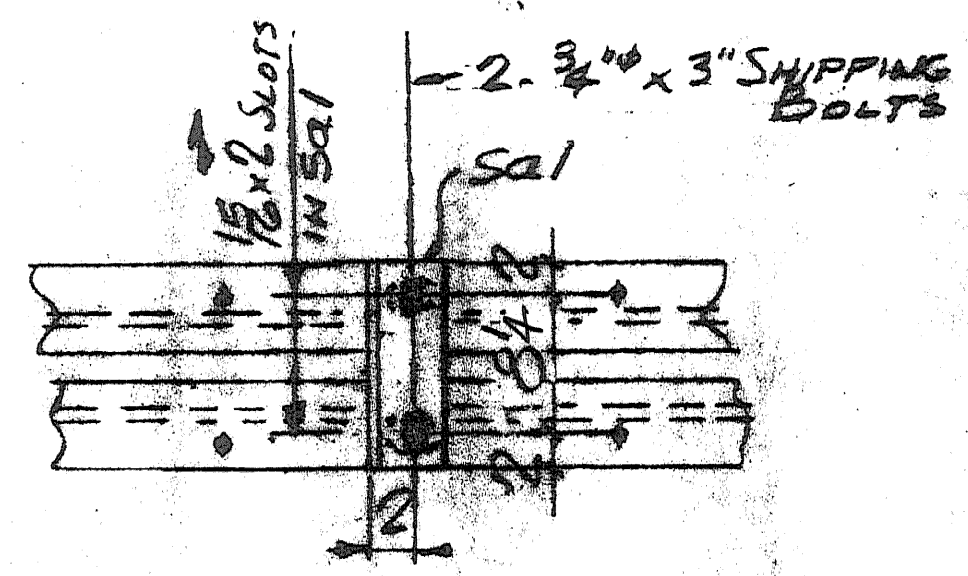


SHIPPING DEVICE SPACED 5\"/>


NO EXCEPTION TAKEN	
REVISE AS NOTED	
RESUBMISSION NOT REQUIRED	
REVISE AS NOTED	
RESUBMISSION REQUIRED	
REJECTED	
DATE: 4/17/08	
SIGNATURE: [Signature]	

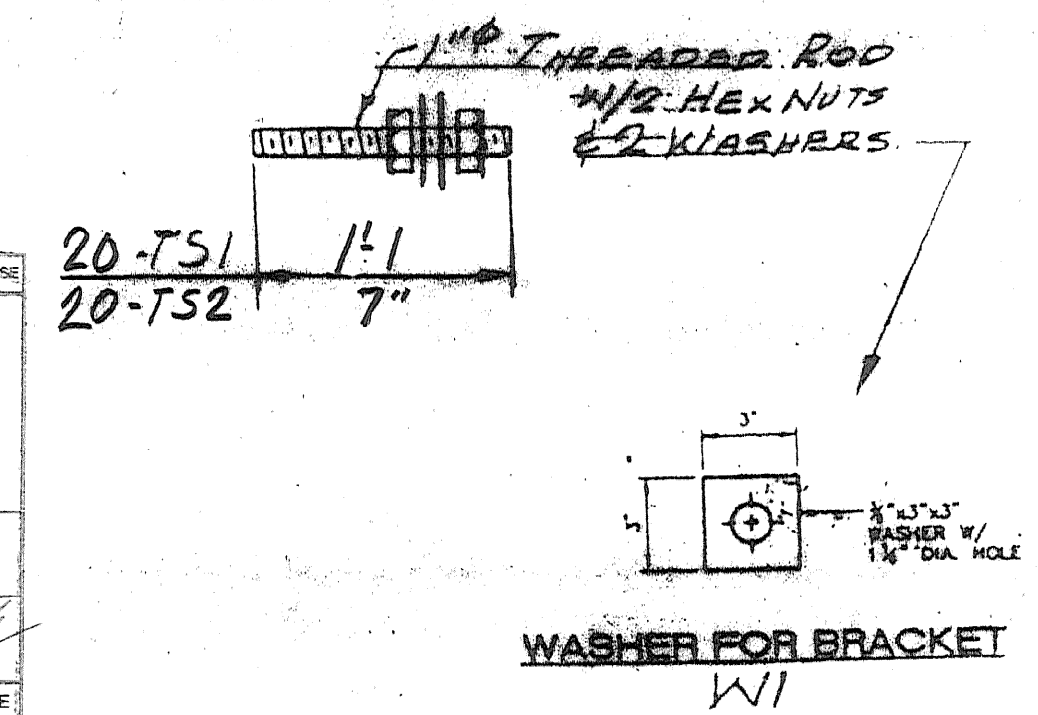


WASHER FOR BRACKET W1

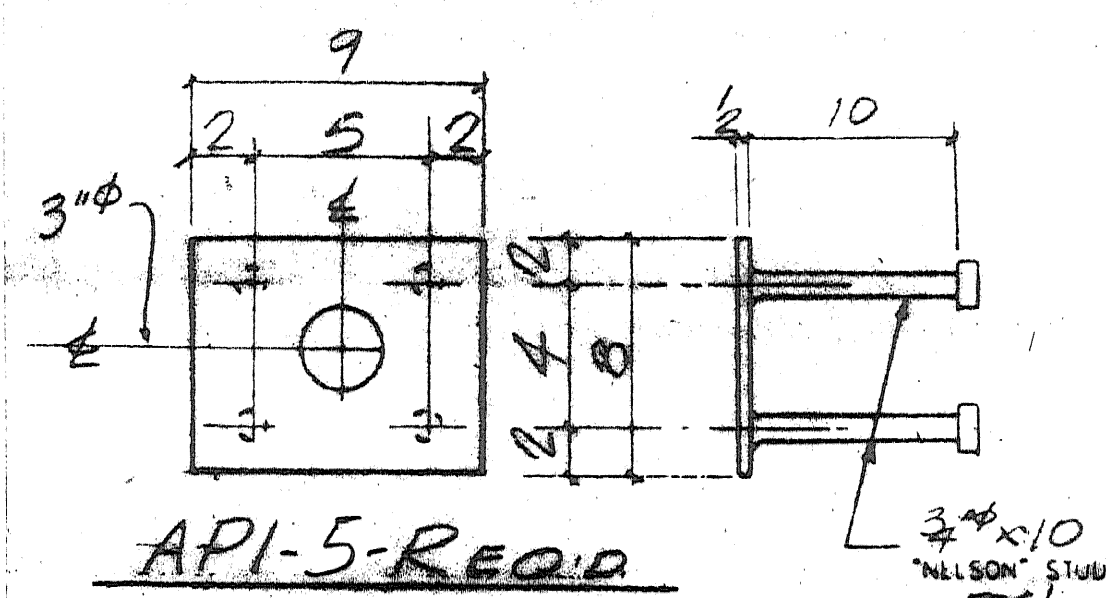






API-5 REQ'D

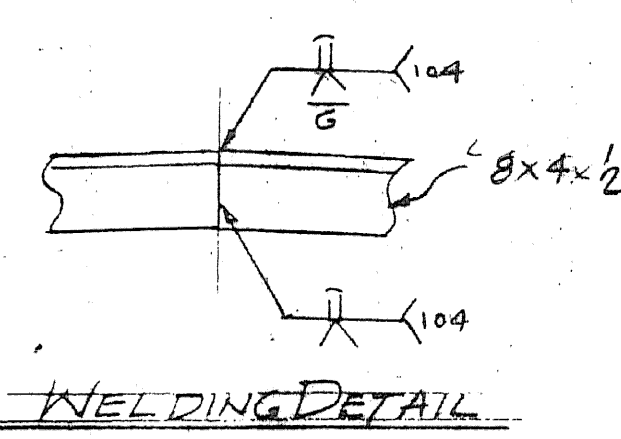

WELDING DETAIL

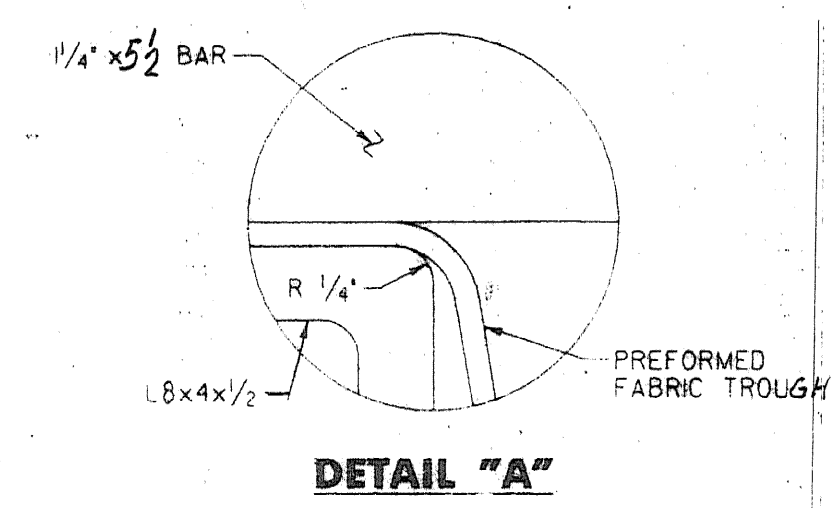

DETAIL "A"

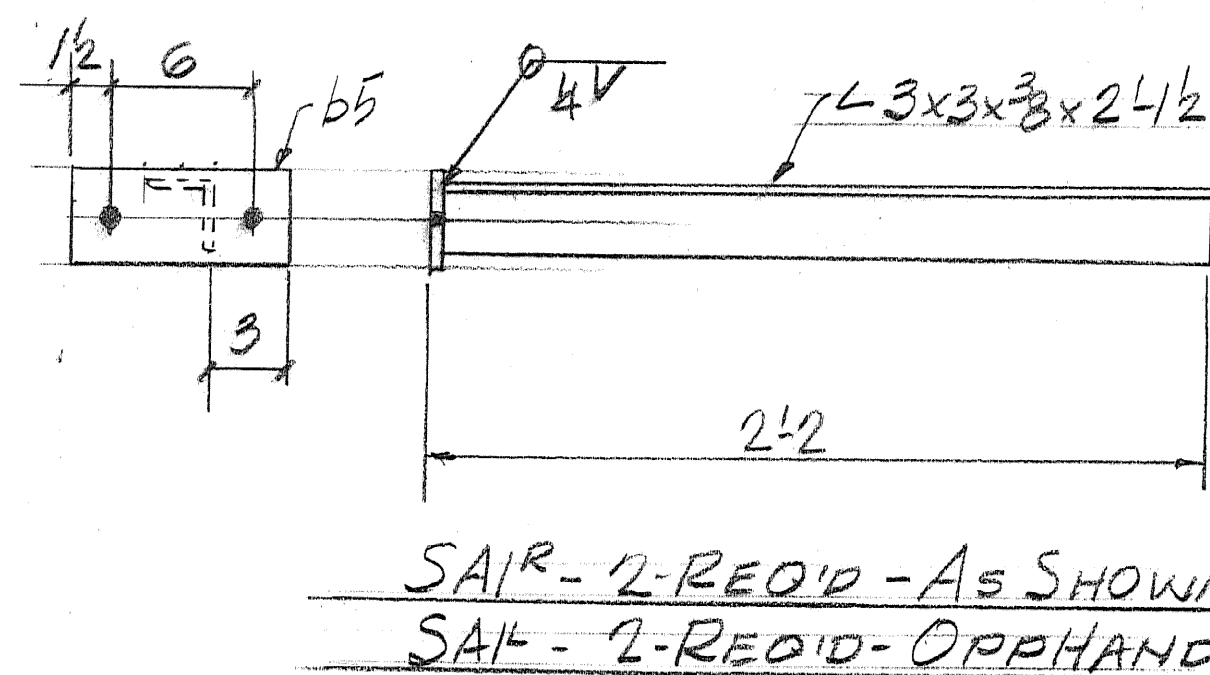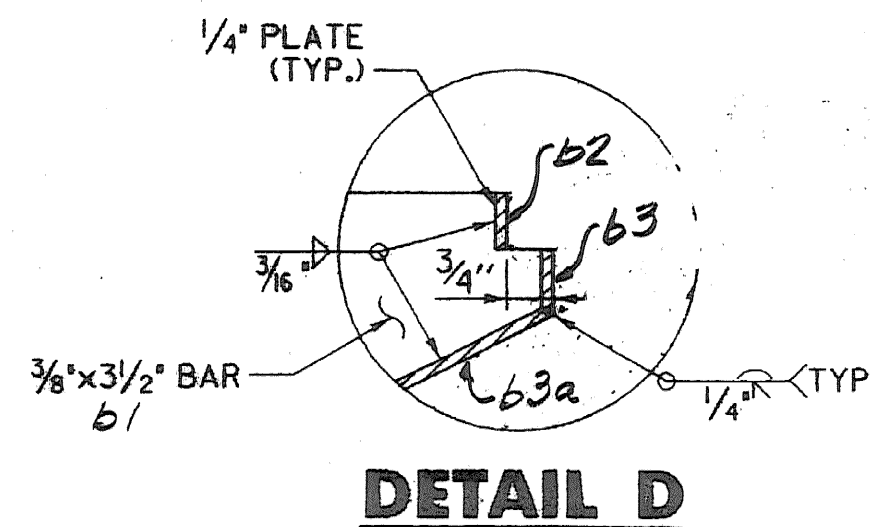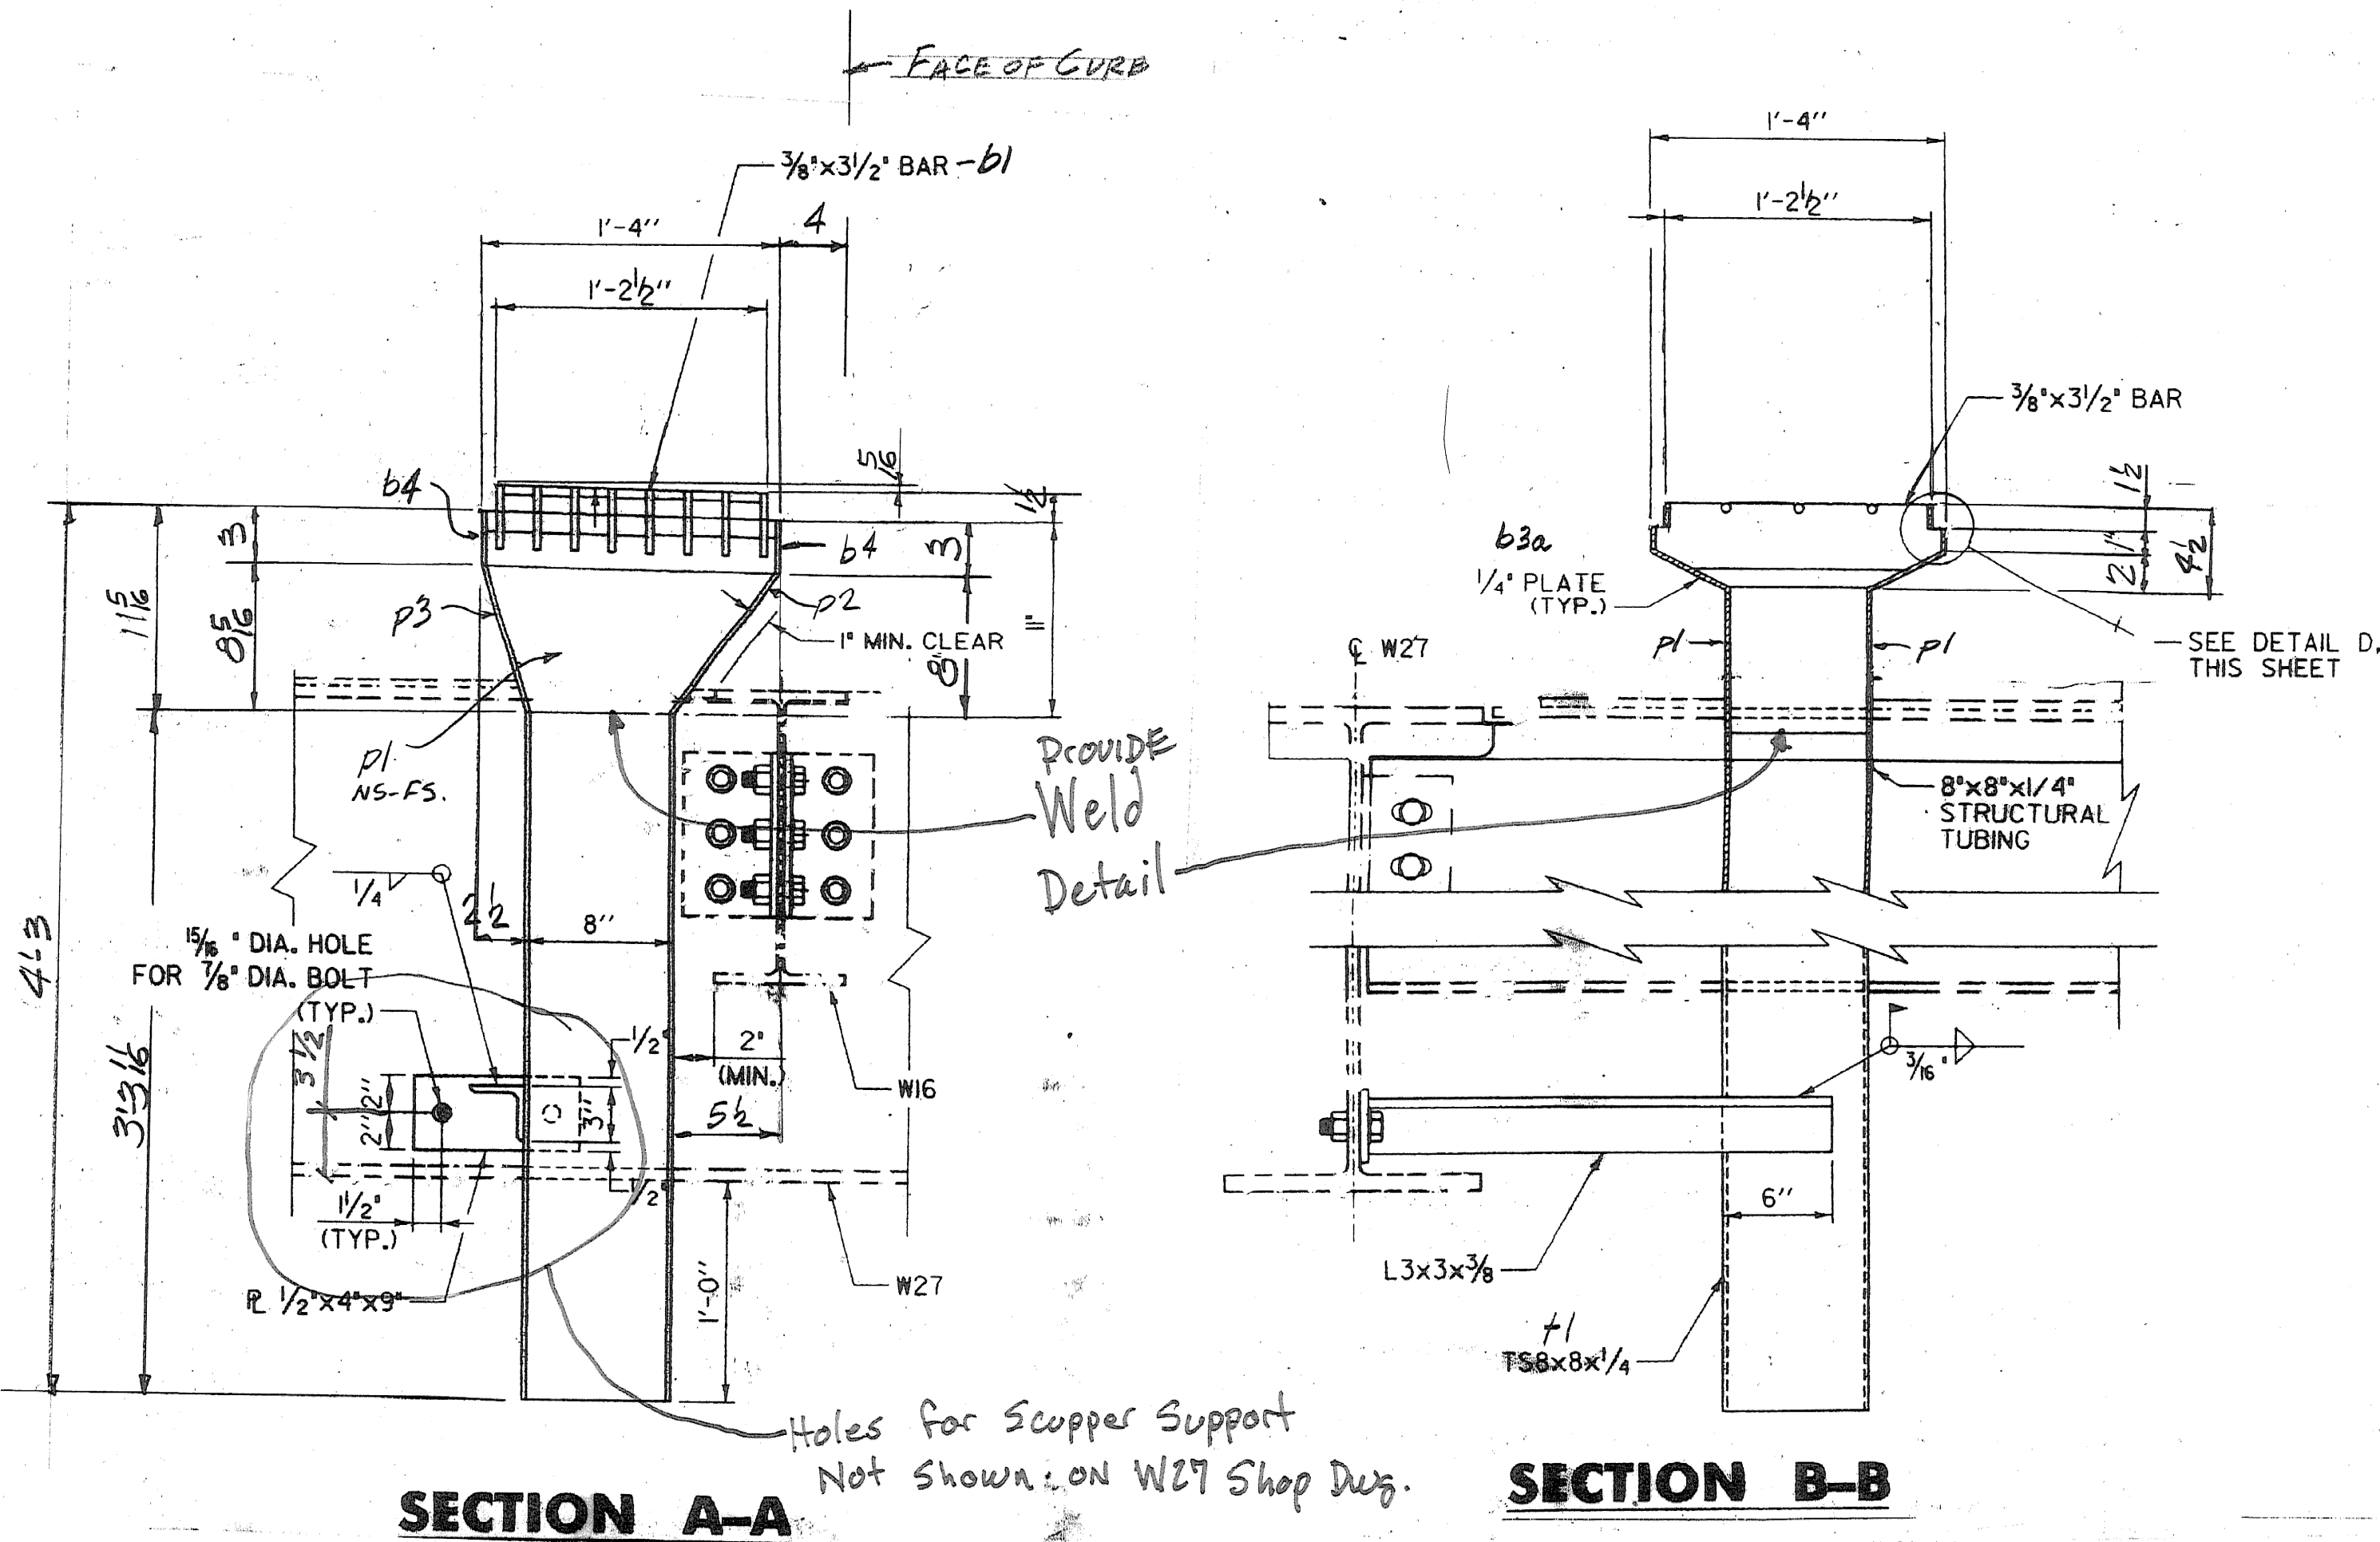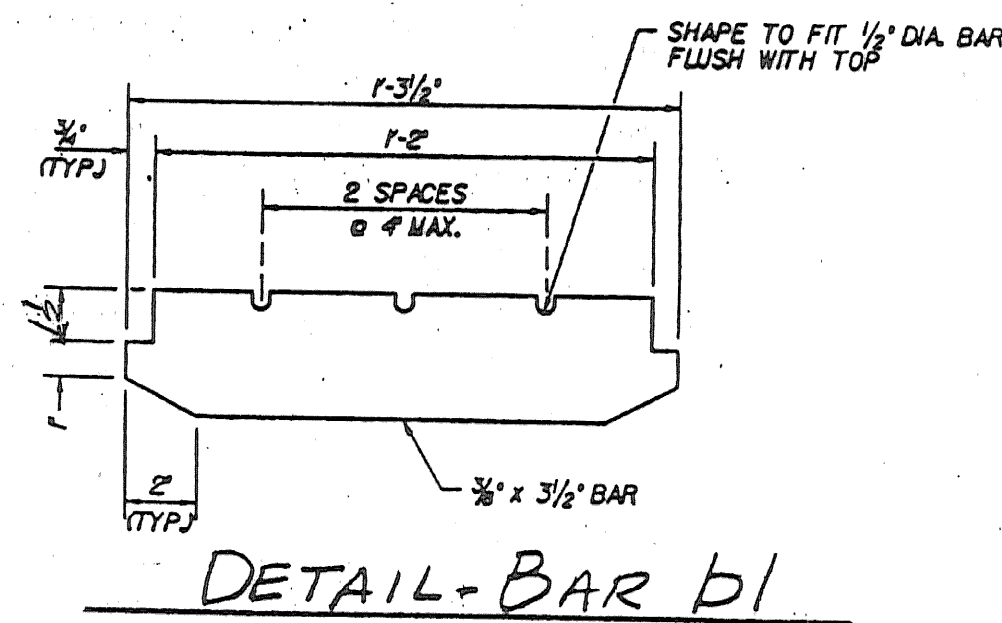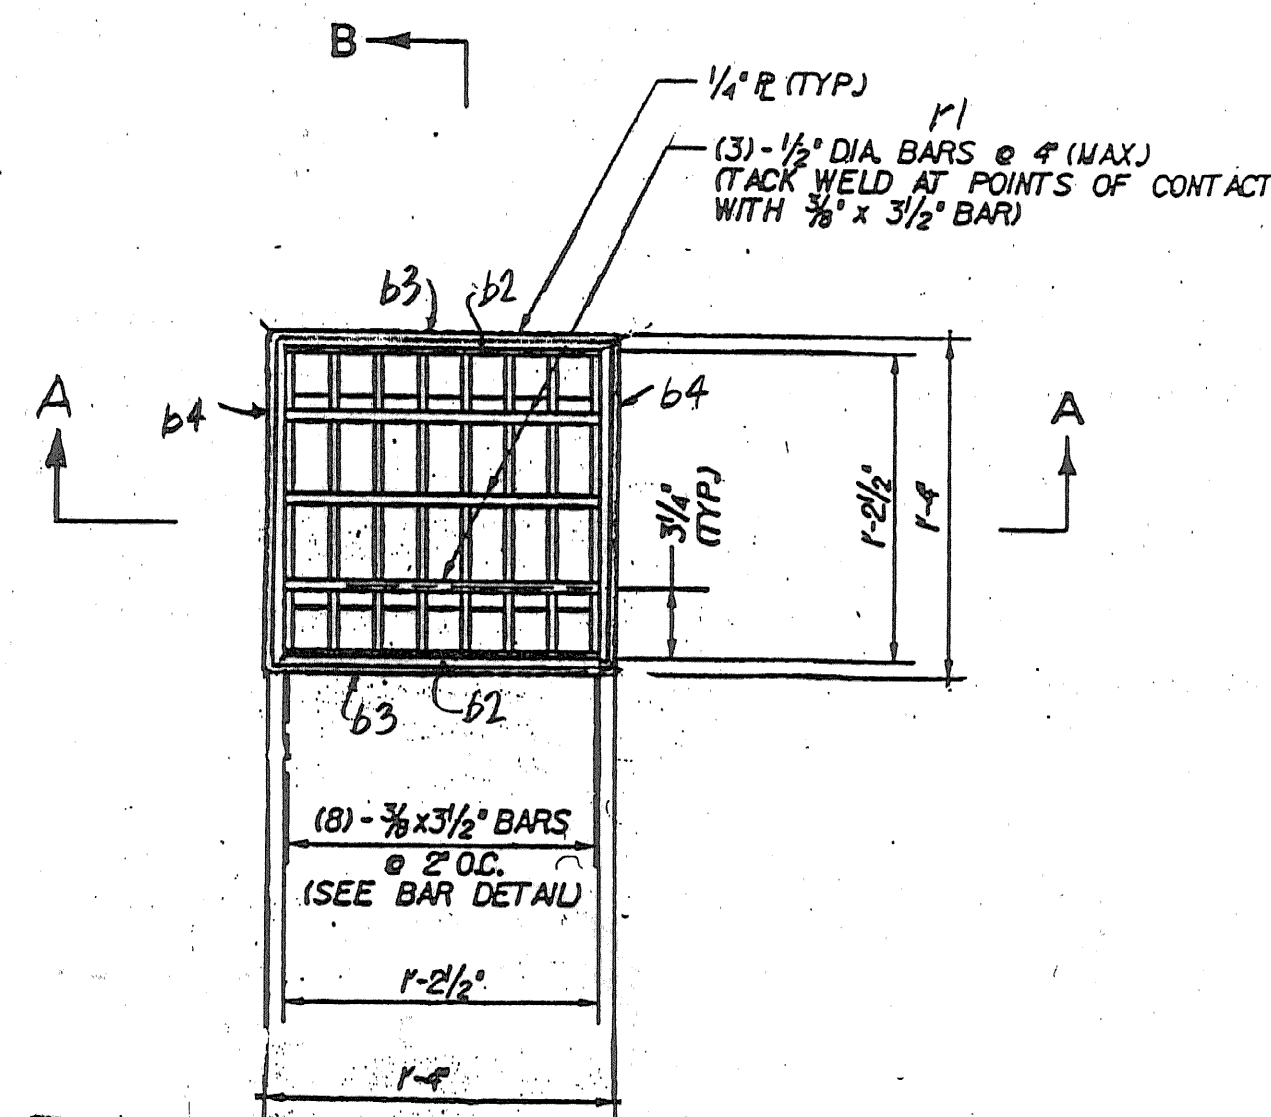

SAIR - 2-REQ'D - AS SHOWN
 SAI - 2-REQ'D - OPP HAND

ABM INFO		SHOP BILL				JOB NO.	DRG. NO.		
PAGE	LINE	NO.	DESCRIPTION	FT	IN	ASSEM. MARK	SHIPPING MARK	REMARKS	WEIGHT
	4		SCUPPERS	4	3		SCI		
		4	75 8x8x4	3	3/16	71		PER SUBJECT 74.11	
		32	BAR 3/2 x 3/8	1	3/2	b1			
		8	BAR 1/2 x 4	1	2/2	b2			
		8	BAR 1\"/>						
		8	BAR 3/4 x 4	1	4	b3a			
		8	BAR 3 x 4	1	3/2	b4			
		12	1/2\"/>						
		8	PL 4 x 3 3/8	1	3/2	p1			
		4	PL 4 x 7/2		9/16	p2			
		4	PL 4 x 7/2		8 1/8	p3			
	2		L3x3x3/8	2	1/2		SAIR		
	2		DO	2	1/2		SAIR		
	4		BAR 4x2		9	b5			
	8		2\"/>						
PAY ITEM: 506.60									

OUT FOR APPROVAL	3/28/08								
ISSUED TO SHOP									
FIELD & OFFICE									


REV.	REMARKS	DATE	DWN	CHK	APP	Q.A.	NO.	DIA.	LGT	TYPE	WASHER	
PROJECT NO. BHF-0302(3) STATE PROJECT NO.												
MATERIAL: AASHTO M270-GR20 ELECTRODES: SEE PROC HOLES: 15 1/8\"/>												
SURFACE PREP. & PAINT:												
GALVANIZE PER SUBJECT. 506.15, PART (a)												
DESCRIPTION: SCUPPERS							DRAWN BY	DATE				
JOB: IMPROVEMENTS							JPF	3-08				
BRIDGE No. 41 ON TH No. 2							CHKD BY	CR				
RICHFORD, VT.							APPROV BY	Q.A.				
CUSTOMER: BLOW & COTE INC.												
CASCO BAY STEEL STRUCTURES, INC.							JOB NO.	DRG. NO.				
75 SPRING HILL ROAD SACO, MAINE 04072							361	M1				
PHONE (207) 282-7360 FAX (207) 282-1179							REV.	A				

SHOP DRAWINGS ARE REVIEWED UNLESS NOTED OTHERWISE:
 NO EXCEPTION TAKEN
 REVISE AS NOTED
 RESUBMISSION NOT REQUIRED
 REVISE AS NOTED
 RESUBMISSION REQUIRED
 REJECTED
 DATE: 4/17/08
 SIGNATURE: Scott Bunnell


SCUPPER - SCI - REQ'D

Holes for Scupper Support
 Not shown on W27 Shop Draw.

SAIR - 2-REQ'D - AS SHOWN
 SAI - 2-REQ'D - OPP HAND

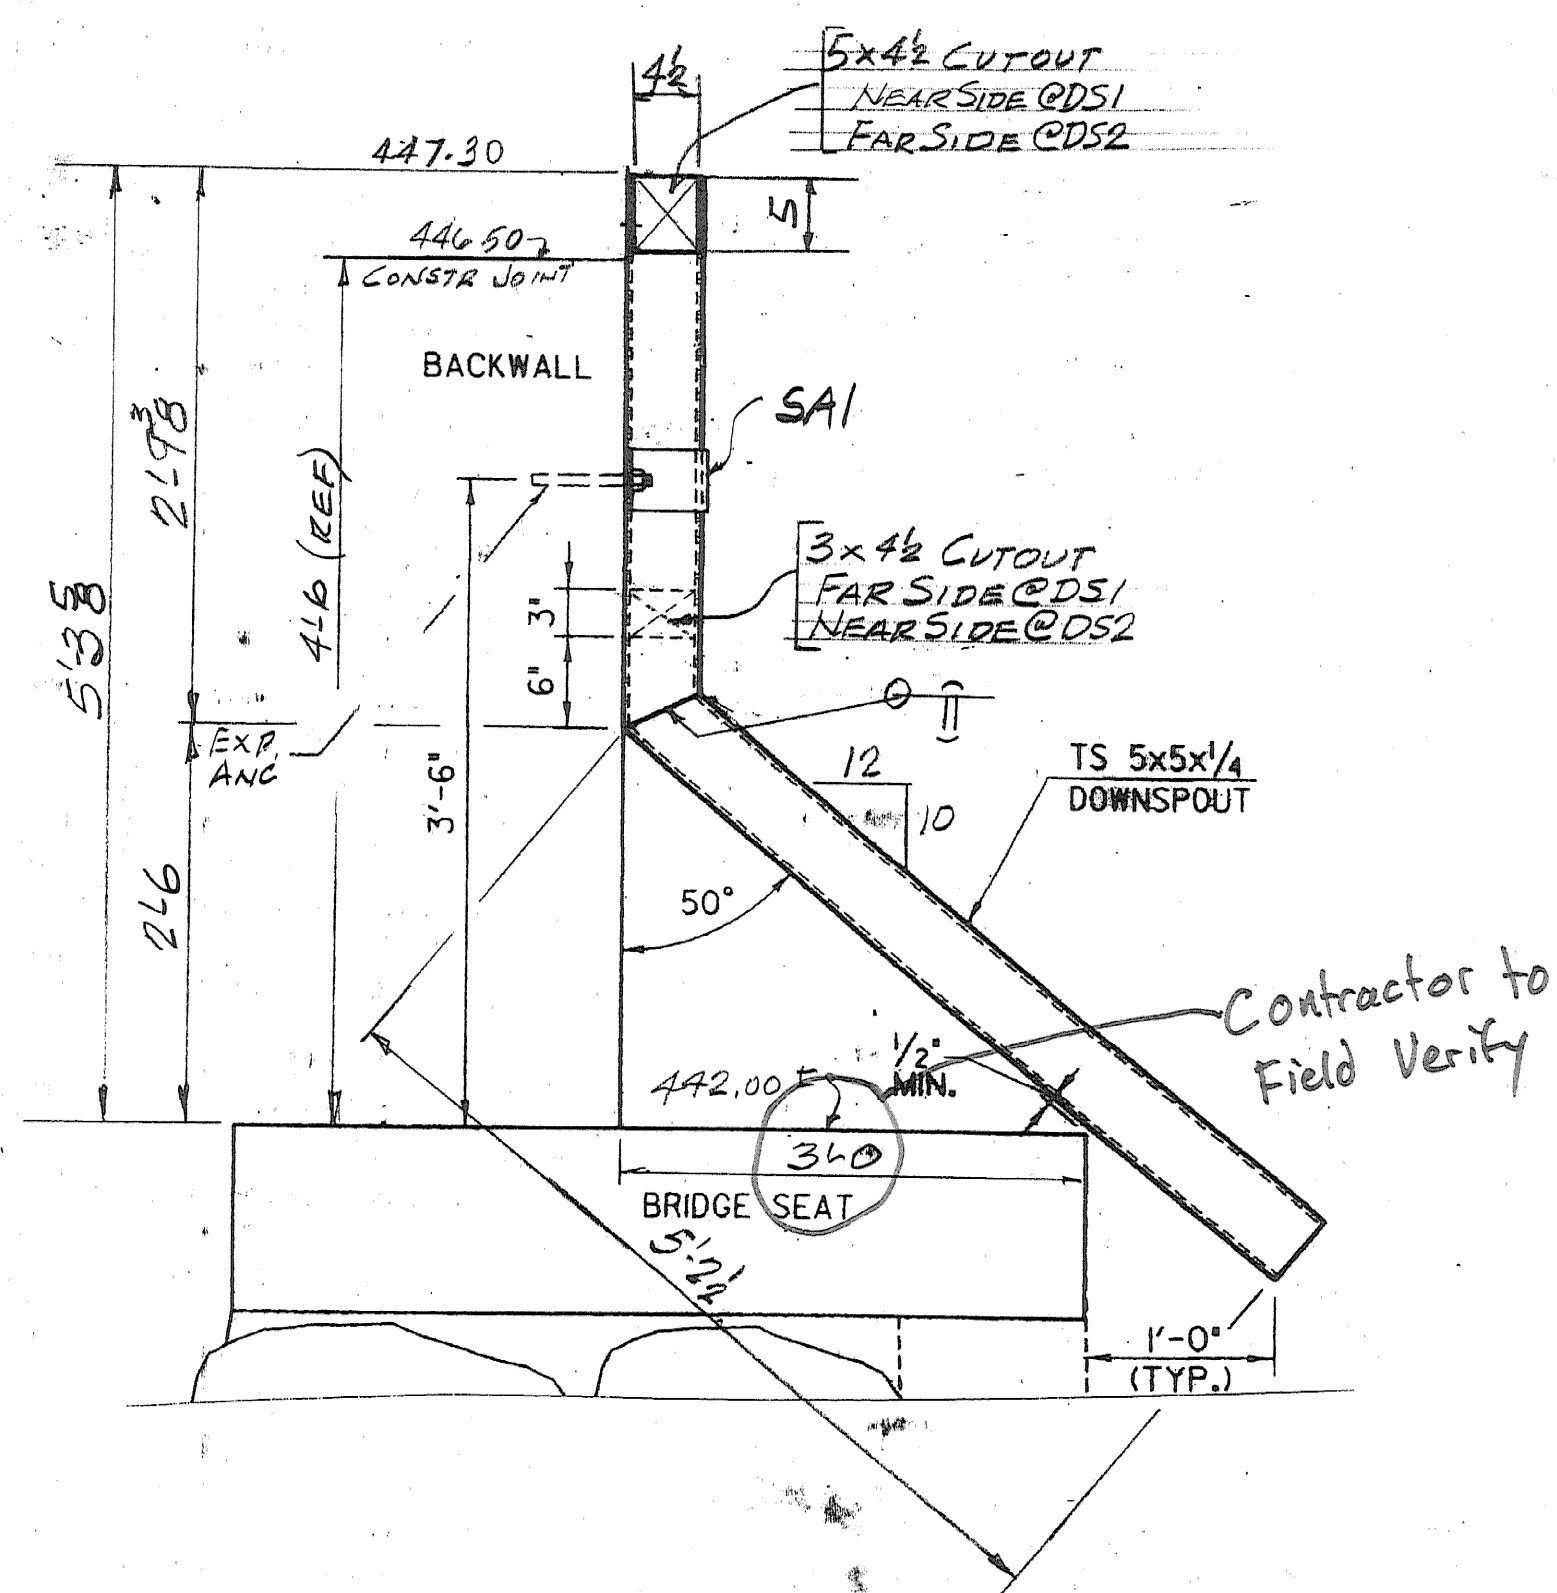


DS1-ONE REQ'D (@ NORTH END ABUT. #1)
DS2-ONE REQ'D (@ SOUTH END ABUT. #1)

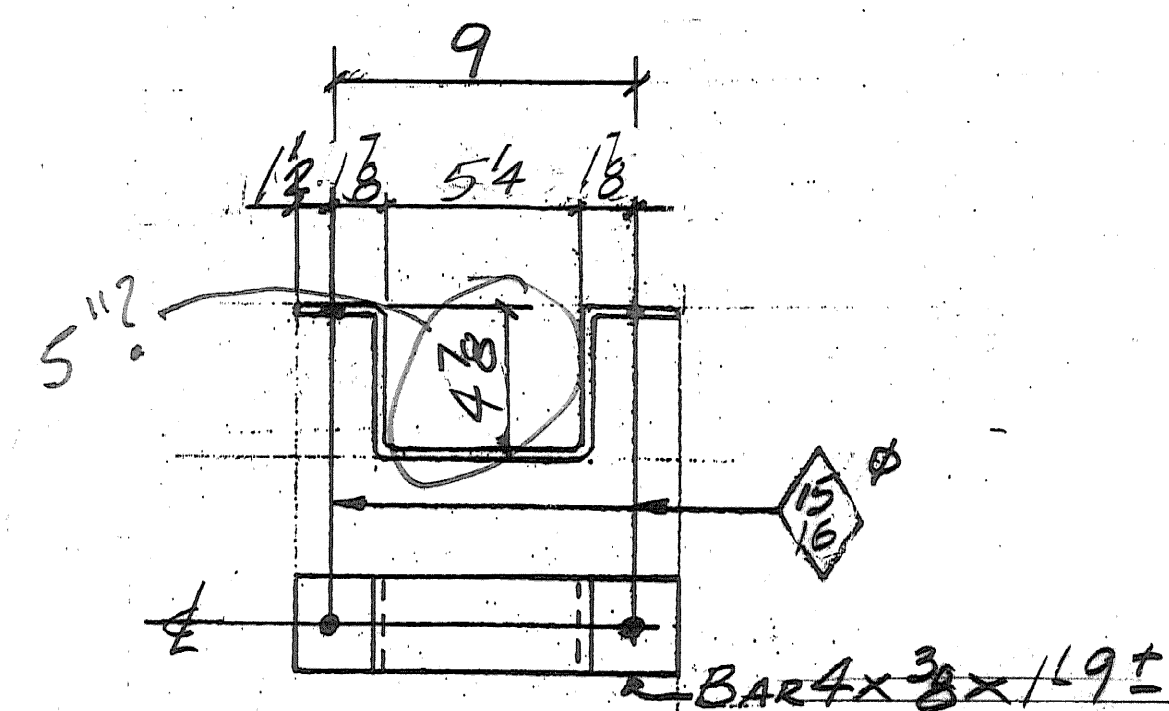

SAI-2-REQ'D

INCLUDE
4-3/4\"/>

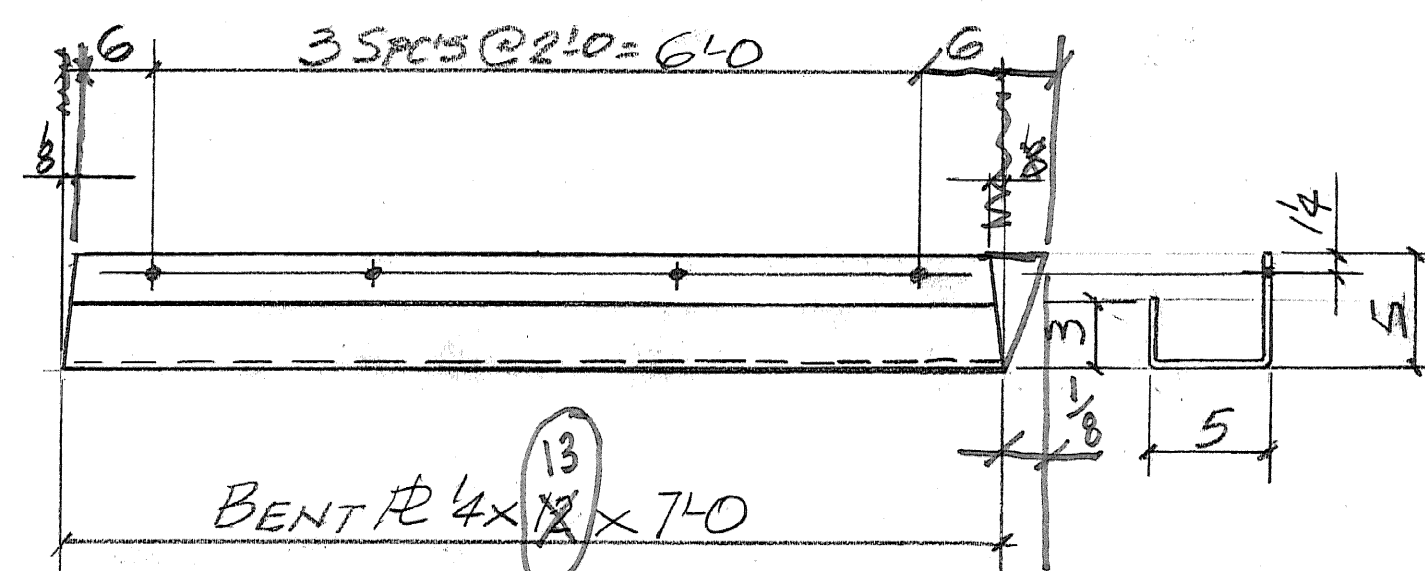

GUTTER-GI-2-REQ'D.

INCLUDE
8-3/4\"/>

SHOP DRAWINGS ARE REVIEWED UNLESS NOTED OTHERWISE

NO EXCEPTION TAKEN	
REVISE AS NOTED	
RELEASE/ISSUE NOT REQUIRED	<input checked="" type="checkbox"/>
REVISE AS NOTED	
RELEASE/ISSUE REQUIRED	
REJECTED	
DATE	4/17/08
SIGNATURE	<i>Scott Beal</i>

REVIEW BY STANTEC IS FOR THE SOLE PURPOSE OF ASCERTAINING GENERAL CONFORMITY WITH DESIGN. CONTRACTOR IS RESPONSIBLE FOR DIMENSIONS, FABRICATION AND CONSTRUCTION METHODS. COORDINATION OF SUB-TASKS, DETAIL DESIGN OF COMPONENTS AND ERRORS OR OMISSIONS ON SHOP DRAWINGS.

ABM INFO		SHOP BILL		JOB NO.	DRG. NO.				
				351	M2				
PAGE	LINE	NO.	DESCRIPTION	FT	IN	ASSEM MARK	SHIPPING MARK	REMARKS	WEIGHT
	1		DOWNSPOUT	8	0		DS1		
	1		DO	8	0		DS2		
	2		TS 5x5x4	8	0	F1		PER SUBJECT DRAWING	
	2		BAR 4x3	1	9		SAI BEND		
	2		R 4x12	7	0		GI BEND		
	12		3/4\"/>						

PAY ITEM: 506.60

OUT FOR APPROVAL	3/20/08								
OUT FOR APPROVAL									
ISSUED TO SHOP									
FIELD & OFFICE									

REV.	REMARKS	DATE	DWN	CHK	APP	Q.A.	NO.	DIA.	LGT	TYPE	WASHER
	PROJECT NO. BHF-0302(3) S STATE PROJECT NO.										
	MATERIAL: A36 STD										
	ELECTRODES: SEE PROC.										
	HOLES: 1/8\"/>										
	SHIP BOLTS: -										
	SURFACE PREP. & PAINT:										

GALVANIZE PER SUBJECT, 506.15 - PART (a)

DESCRIPTION: <u>DOWNSPOUTS</u>	DRAWN BY	DATE
JOB:	JPF	3-08
	CHKD BY	CR
	APPROV BY	
	Q.A.	

CUSTOMER: <u>BLOW & COTE INC.</u>	JOB NO.	DRG. NO.
CASCO BAY STEEL STRUCTURES, INC.	361	M2
75 SPRING HILL ROAD SACO, MAINE 04072	PHONE (207) 282-7360	FAX (207) 282-1179
	REV.	△



State of Vermont
PDD/Structures Design Section
National Life Building - Drawer 33
Montpelier, VT 05633-5001
www.aot.state.vt.us

(phone) 802-828-2621
(fax) 802-828-3566
(ttd) 800-253-0191

Agency of Transportation

DATE: October 17, 2008

Highway Safety Corp.
239 Commerce Street
P. O. Box 358
Glastonbury, CT 06033

Project Name: Richford Project #: BHF 0302(3)S

Structure Identification: TH #2, Br. #41 over Missisquoi River

The following bridge railing details [Item # 900.640, Special Provision (Box Beam Guard Rail, Truss) and Item # 900.640, Special Provision (Bridge Railing, Truss)] for the above project (Vendor's Job No 1660) transmitted to us with a letter from F. R. Lafayette dated October 15, 2008 have been reviewed and are being returned herewith.

Sheets 1 through 4 of 4 are approved or approved "as noted". Upon receipt of these drawings please make appropriate changes and submit white prints for our use in the record plans for this project.

Copies of the previously approved Welding Procedures W-1658A, W 1658B, and W 1660A are enclosed.

You must provide notice to our fabrication inspector, Jeff Clark, as to the date fabrication represented by these drawings will begin. That notice must be received and acknowledged at least seven days prior to that date, as per Specification 506.03. Jeff may be contacted by phone at (802)828-0044 or email at jeff.clark@state.vt.us. Any material fabricated prior to the notification date is subject to rejection without further cause.

Sincerely,

Warren Tripp

Warren Tripp

Attachments

cc: [X] Resident Engineer Carl Gleason w/prints
[X] Shop Inspector Jeff Clark w/prints
[X] Contractor: Blow & Cote, Inc. w/prints
[X] Subcontractor: F. R. Lafayette, Inc. w/prints
[X] Construction Division - letter only
[X] Materials & Research Section (C&LA Unit) - letter only
[X] Wayne Symonds
[X] Files




Highway Safety Corporation
Glastonbury, CT

Welding Procedure Specification

Material specification ASTM A36, A572 gr 50, A709 Gr 36, ASTM A709 Gr 50, A500 gr B
 Welding process Gas Metal Arc Welding (GMAW)
 Manual, semi-automatic, or automatic Semi-Automatic
 Position of welding Horizontal (2F)
 Filler metal specification AWS A5.18
 Filler metal classification ER70S-3
 Electrode and manufacturer Lincoln Electric Lincoln Weld L-50
 Flux and manufacturer N/A
 Shielding gas 85% Argon / 15% CO2 Flow rate 19-27 L / min
 Single or multiple pass Single
 Single or multiple arc Single
 Welding current DC
 Polarity Reverse
 Welding progression Stringers
 Root treatment None
 Preheat and interpass temperature Base Metal up to 3/4" (50°F) ; over 3/4-1 1/2" (70°F)
 Postheat treatment None
 Electrode extension 3/4" ± 1/4"

WELDING PROCEDURE

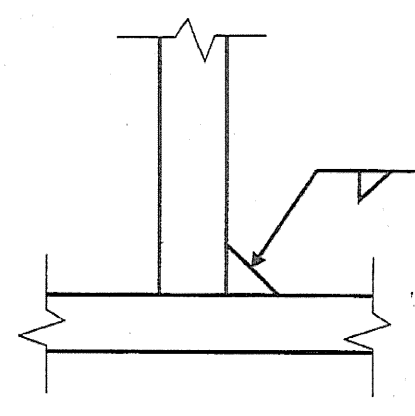Weld size	Pass no.	Electrode size	Welding parameters		Travel speed	Joint detail
			Amperes	Volts		
1/8"	1	0.045" ± 30	300 A ± 30	29 V ± 2	28 ipm ± 2	 <p>TYPICAL ALL FILLET WELDS</p>
3/16"	1	0.045" ± 30	300 A ± 30	29 V ± 2	28 ipm ± 2	
5/16"	1	0.062" ± 25	275 A ± 25	25 V ± 2	8-10 ipm	

CK'D BY JWC
 VTRANS RECEIVED
 SEP 14 2008
 APPROVED JWC
 DATE 9/10/08

This procedure may vary due to fabrication sequence, fit-up, pass size, etc. within the limitation of variables given in section 5 of latest edition AWS D1.5

WPS no. W-1658A Fabricator Highway Safety Corporation
 Revision no. 0 Authorized by Paul Radice
 Supporting POR no. Pre-qualified Date 7/28/08
 Project Name Richford, VT Project Number BHF 0302(3)S


Highway Safety Corporation

Glastonbury, CT

Welding Procedure Specification

Material specification ASTM A500 Gr B
 Welding process Gas Metal Arc Welding (GMAW)
 Manual, semi-automatic, or automatic Semi-Automatic
 Position of welding Horizontal (2F)
 Filler metal specification AWS A5.18
 Filler metal classification ER70S-3
 Electrode and manufacturer Lincoln Electric Lincoln Weld L-50
 Flux and manufacturer N/A
 Shielding gas 85% Argon / 15% CO2 Flow rate 19-27 L / min
 Single or multiple pass Single
 Single or multiple arc Single
 Welding current DC
 Polarity Reverse
 Welding progression Stringers
 Root treatment None
 Preheat and interpass temperature Base Metal up to 3/4" (60°F) ; over 3/4-1 1/2" (70°F)
 Postheat treatment None
 Electrode extension 3/4" ± 1/4"

WELDING PROCEDURE

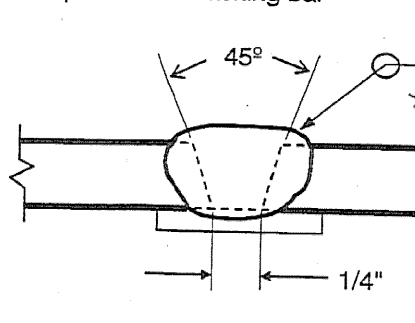Weld size	Pass no.	Electrode size	Welding parameters		Travel speed	Joint detail
			Amperes	Volts		
	1	0.045"	300 A ± 30	29 V ± 2	14 ipm ± 2	full penetration groove weld with permanent backing bar 
VIKAS RECEIVED CHECKED BY: _____ DATE: _____ SEP 4 2008 APPROVED BY: <u>AS</u> DATE: <u>9/8/08</u> BY: _____						


This procedure may vary due to fabrication sequence, fit-up, pass size, etc. within the limitation of variables given in section 5 of latest edition AWS D1.5

WPS no. W-1658B Fabricator Highway Safety Corporation
 Revision no. 0 Authorized by Paul Radice
 Supporting PQR no. Pre-qualified Date 7/29/08
 Project Name Richford, VT Project Number BHF 0302(3)S

Highway Safety Corporation
Glastonbury, CT
Welding Procedure Specification

Material specification ASTM A36, A709 Gr. 36
 Welding process Gas Metal Arc Welding (GMAW)
 Manual, semi-automatic, or automatic Semi-Automatic
 Position of welding Horizontal
 Filler metal specification AWS A5.18
 Filler metal classification ER70S-3
 Electrode and manufacturer Lincoln Electric Lincoln Weld L-50
 Flux and manufacturer N/A
 Shielding gas 85% Argon / 15% CO2 Flow rate 19-27 L / min
 Single or multiple pass Single
 Single or multiple arc Single
 Welding current DC
 Polarity Reverse
 Welding progression Stringers
 Root treatment None
 Preheat and interpass temperature Base Metal up to 3/4" (50°F) ; over 3/4-1 1/2" (70°F)
 Postheat treatment None
 Electrode extension 3/4" ± 1/4"


WELDING PROCEDURE

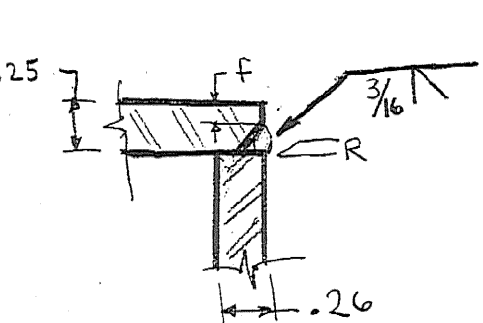Weld size	Pass no.	Electrode size	Welding parameters		Travel speed	Joint detail
			Amps	Volts		
3/16"	1	0.045"	300 A ± 30	29 V ± 2	28 ipm ± 2	BTC - PH - GF  $R = 0 + \frac{1}{8} - \frac{1}{16}$ $F = \frac{1}{8} \times \frac{1}{16}$


TRANS RECEIVED
 JWC
 SEP 08 2008
 APPROVED
 9/9/08

This procedure may vary due to fabrication sequence, fit-up, pass size, etc. within the limitation of variables given in section 5 of latest edition AWS D1.1 and D1.5.


WPS no. W-1660A Fabricator Highway Safety Corporation
 Revision no. 0 Authorized by Paul Radice
 Supporting PQR no. Pre-qualified Date 9/9/08
 Project Name Richford, VT Project Number BHF 0302(3)S

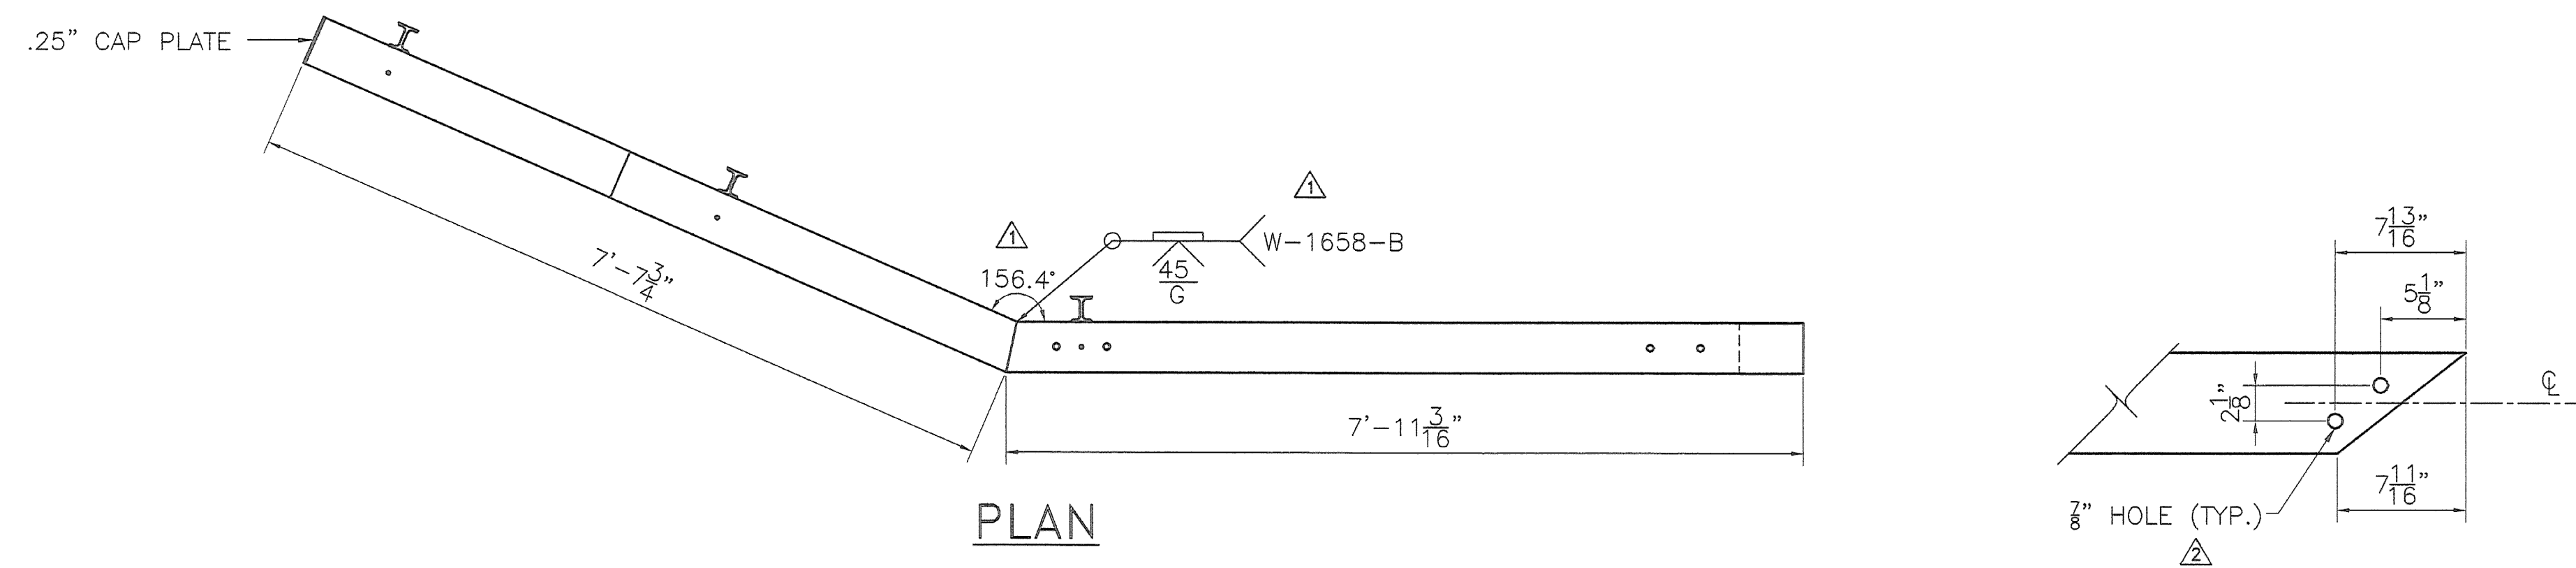


PLAN

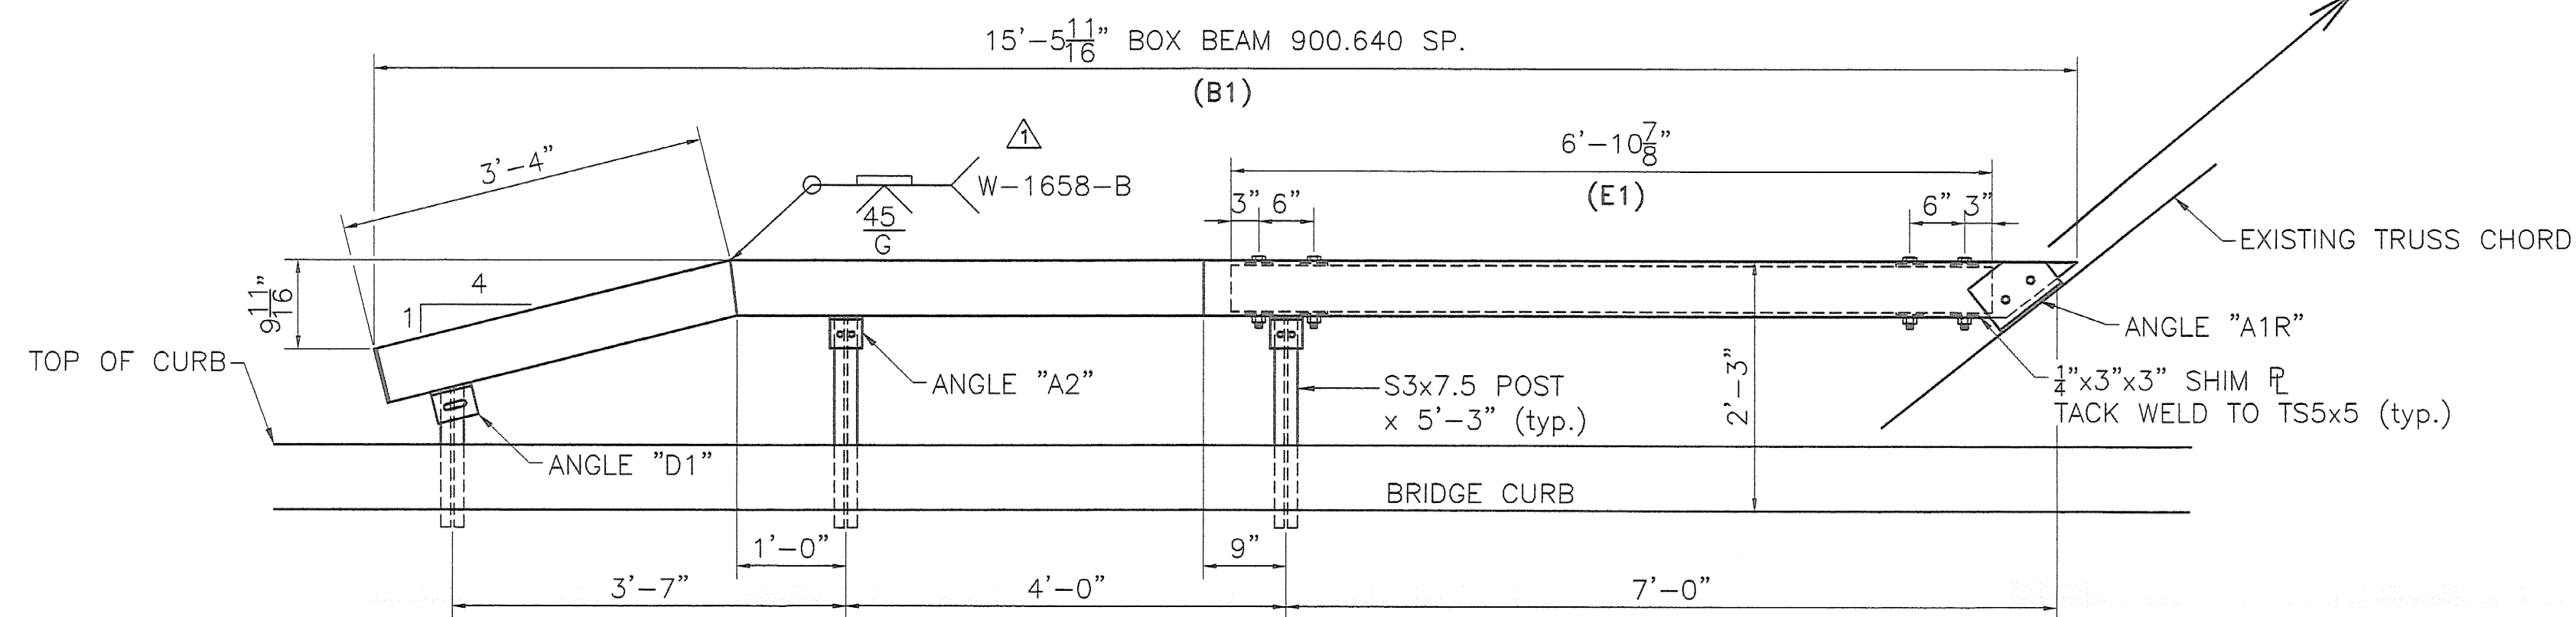

NE CORNER

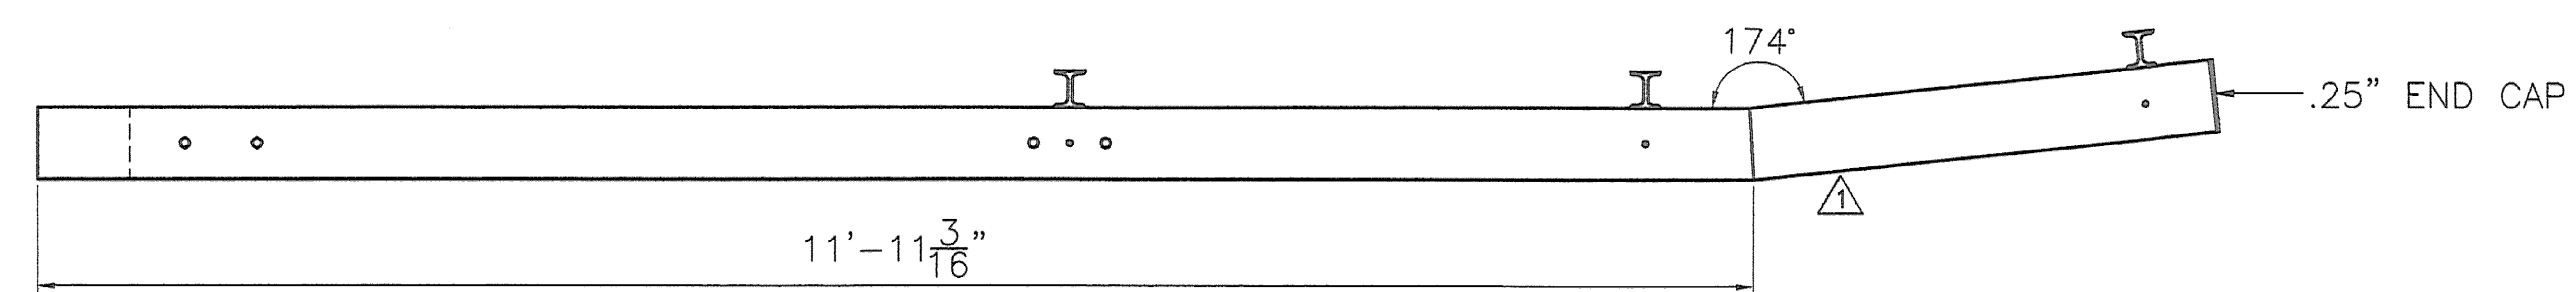

PLAN

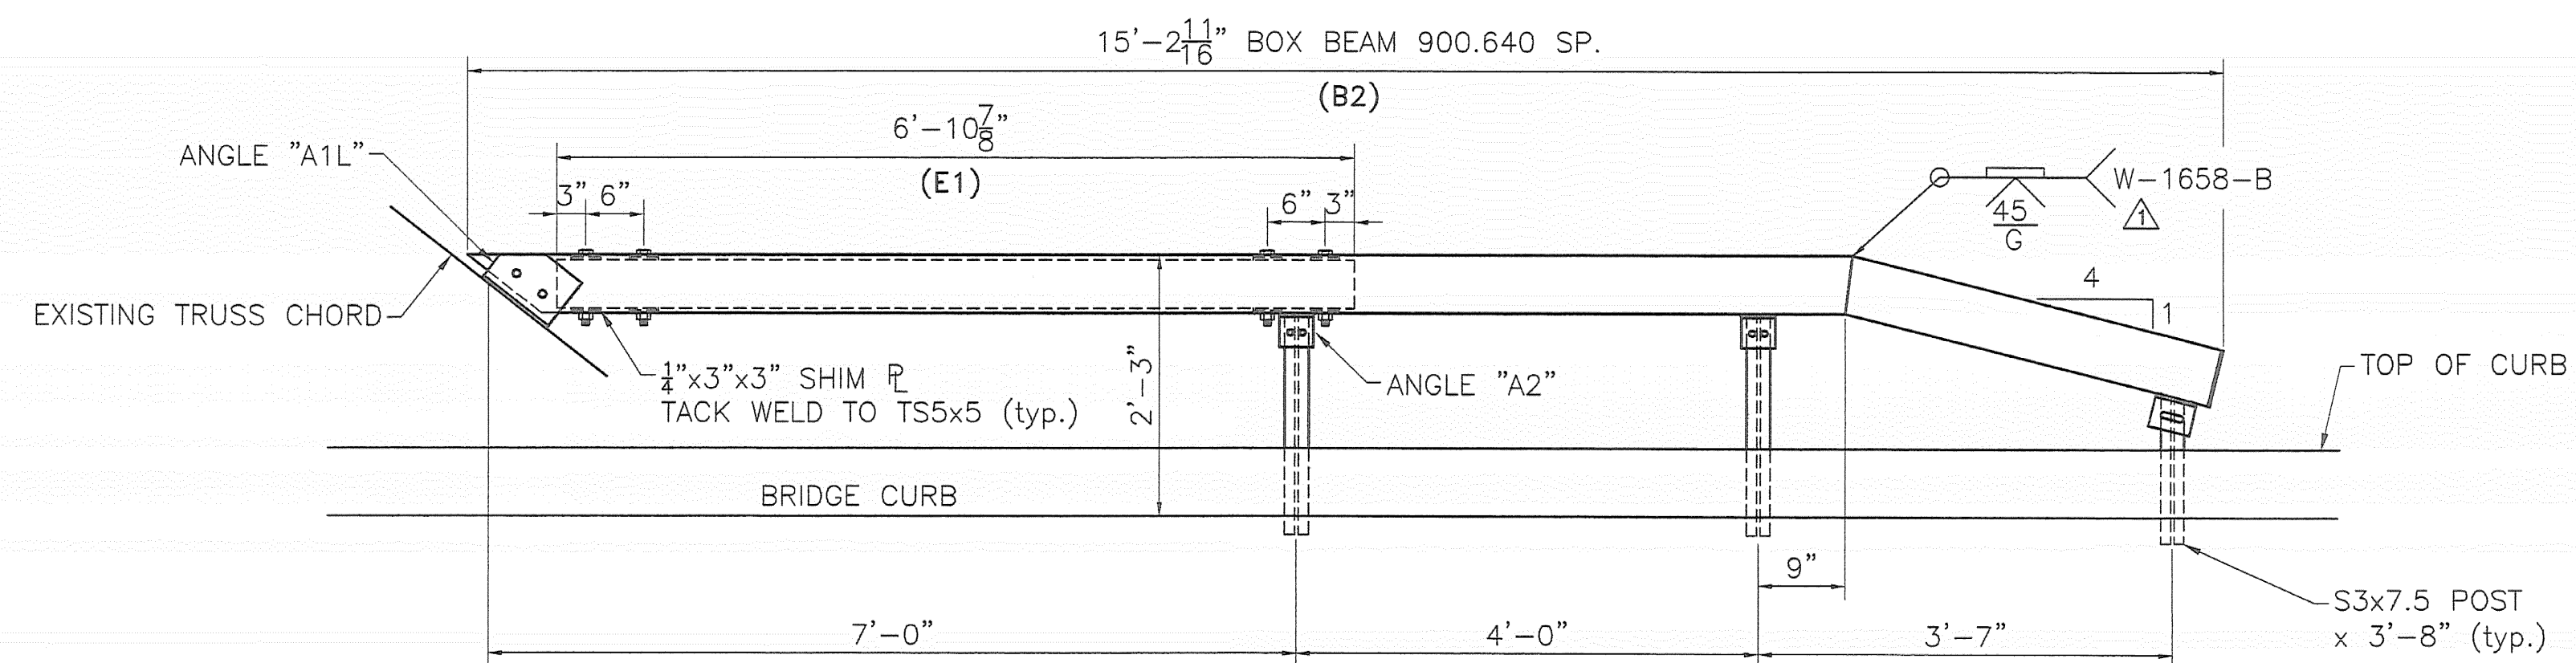

NW CORNER

BILL OF MATERIAL					
Mk.	Qty.	Description	Size/Shape	Length/Qty. per unit	Material
	4	DRIVEN POST	S3x7.5	5'-3"	M270 Gr. 36
	2	DRIVEN POST	S3x7.5	3'-8"	M270 Gr. 36
A1R	1	CONNECTION ANGLE	L6x6x.375	8.5"	M270 Gr. 36
A1L	1	CONNECTION ANGLE	L6x6x.375	8.5"	M270 Gr. 36
A2	4	SHELF ANGLE	L5x3.5x.375	3.5"	M270 Gr. 36
D1	2	END ANGLE	L5x3.5x.375	4.5"	M270 Gr. 36
	2	WELDED END CAP	5.688x.25	5.688	M270 Gr. 36
	6	BENT CAP PLATE	.25"x2.5"	3"	M270 Gr. 36
B1	1	ANGLED BOX BEAM	TS 6x6x.187	15'-5.687"	A500 Gr. B
B2	1	ANGLED BOX BEAM	TS 6x6x.187	15'-2.687"	A500 Gr. B
E1	2	BOX BEAM	TS 5x5x.25	6'-10.875"	A500 Gr. B
	12	HEX BOLT W/HEX NUT & 2 WASHERS	.75" DIA.	7.5"	A325
	2	HEX BOLT W/HEX NUT & 2 WASHERS	.75" DIA.	8"	A307
	4	HEX BOLT W/HEX NUT & 2 WASHERS	.375" DIA.	7.5"	A307
	4	HEX BOLT W/HEX NUT & WASHER	.875" DIA.	3"	A325
	6	HEX BOLT W/HEX NUT	.50" DIA.	1.5"	A307
	16	SHIM PLATE	.25"x3"	3"	A36

REVISIONS		
No.	Remarks	Date
0	Initial submittal	9-16-08
1	Per engineer's comments	10-6-08
2	As built changes	10-15-08



HIGHWAY SAFETY CORP.
GLASTONBURY, CT



RAILING REPLACEMENT
ITEM 900.640 SPECIAL PROVISION
RICHFORD, VERMONT
PROJECT NO. BHF 0302 (3) S

1660



GENERAL CONTRACTOR: F.R. LAFAYETTE

DRAWN: MHM
CHECKED: P Radice
DATE: 7/30/08
SCALE: N.T.S.
MISC REFERENCE NO.:
SIZE: D
REVISION: A
SHEET NO.: 1 of 4

BILL OF MATERIAL					
Mk.	Qty.	Description	Size/Shape	Length/Qty per unit	Material
	10	DRIVEN POST	S7x7.5	5'-3"	M270 Gr. 36
	2	DRIVEN POST	S7x7.5	3'-8"	M270 Gr. 36
A2	8	SHELF ANGLE	L5x3.5x.375	3.5"	M270 Gr. 36
A2X	2	SHELF ANGLE	L5x3.5x.375	3.5"	M270 Gr. 36
A3R	1	SLOTTED CONNECTION ANGLE	L6x6x.375	8.5"	M270 Gr. 36
A3L	1	SLOTTED CONNECTION ANGLE	L6x6x.375	8.5"	M270 Gr. 36
D1	2	END ANGLE	L5x3.5x.375	4.5"	M270 Gr. 36
	2	END CAP	5.688x.25	5.688	M270 Gr. 36
	12	BENT CAP PLATE	.25"x2.5"	3"	M270 Gr. 36
B3	1	ANGLED BOX BEAM	TS 6x6x.187	27'-5.063"	A500 Gr. B
B4	1	ANGLED BOX BEAM	TS 6x6x.187	27'-5.063"	A500 Gr. B
E2	2	BOX BEAM	TS 5x5x.25	7'-1.25"	A500 Gr. B
	12	HEX BOLT W/HEX NUT & 2 WASHERS	.75" DIA.	7.5"	A325
	2	HEX BOLT W/HEX NUT & 2 WASHERS	.75" DIA.	8"	A307
	8	HEX BOLT W/HEX NUT & 2 WASHERS	.375" DIA.	7.5"	A307
	4	HEX BOLT W/HEX NUT & WASHER	.875" DIA.	3"	A325
	12	HEX BOLT W/HEX NUT	.50" DIA.	1.5"	A307
	16	SHIM PLATE	.25"x3"	3"	A36

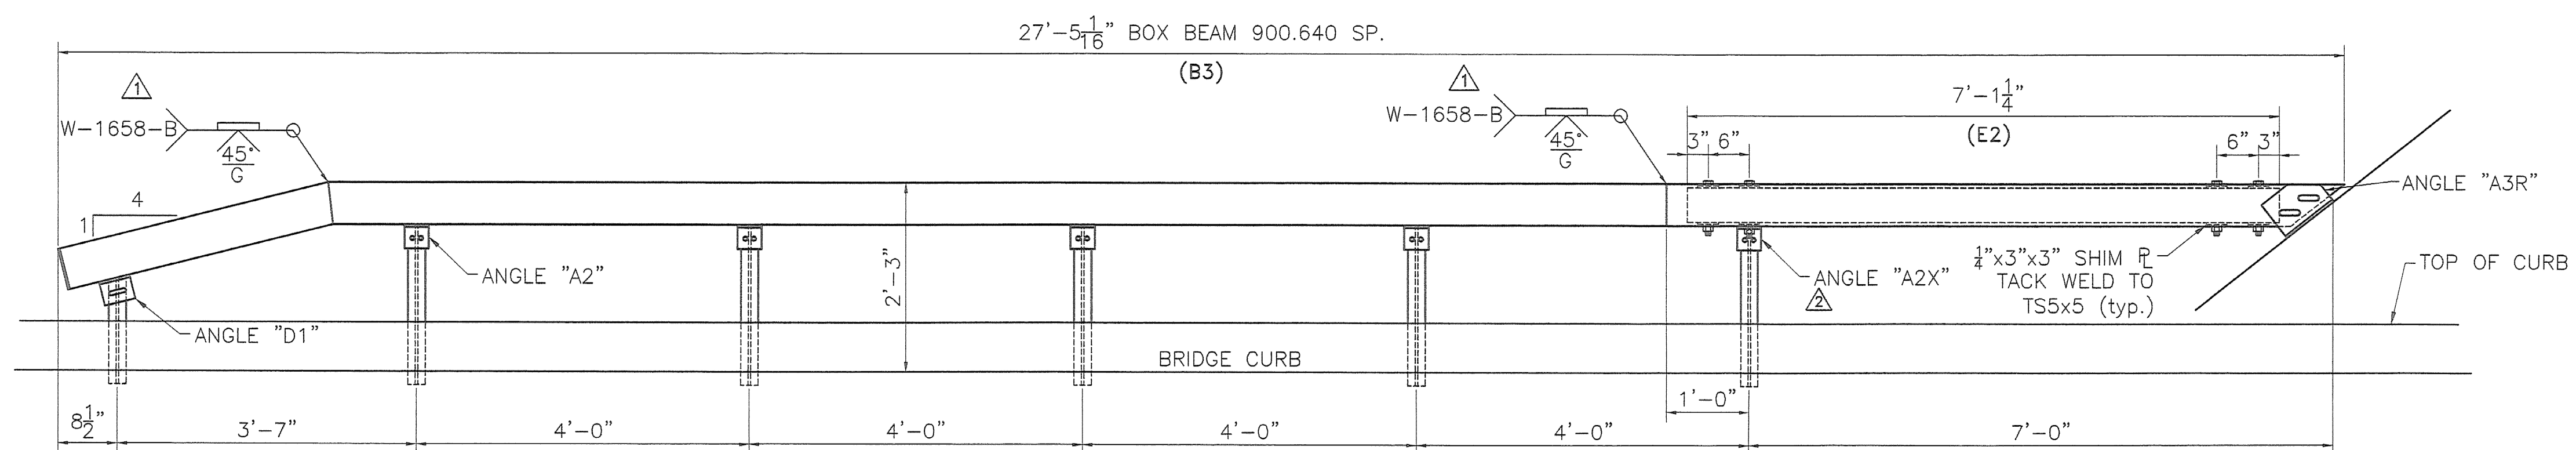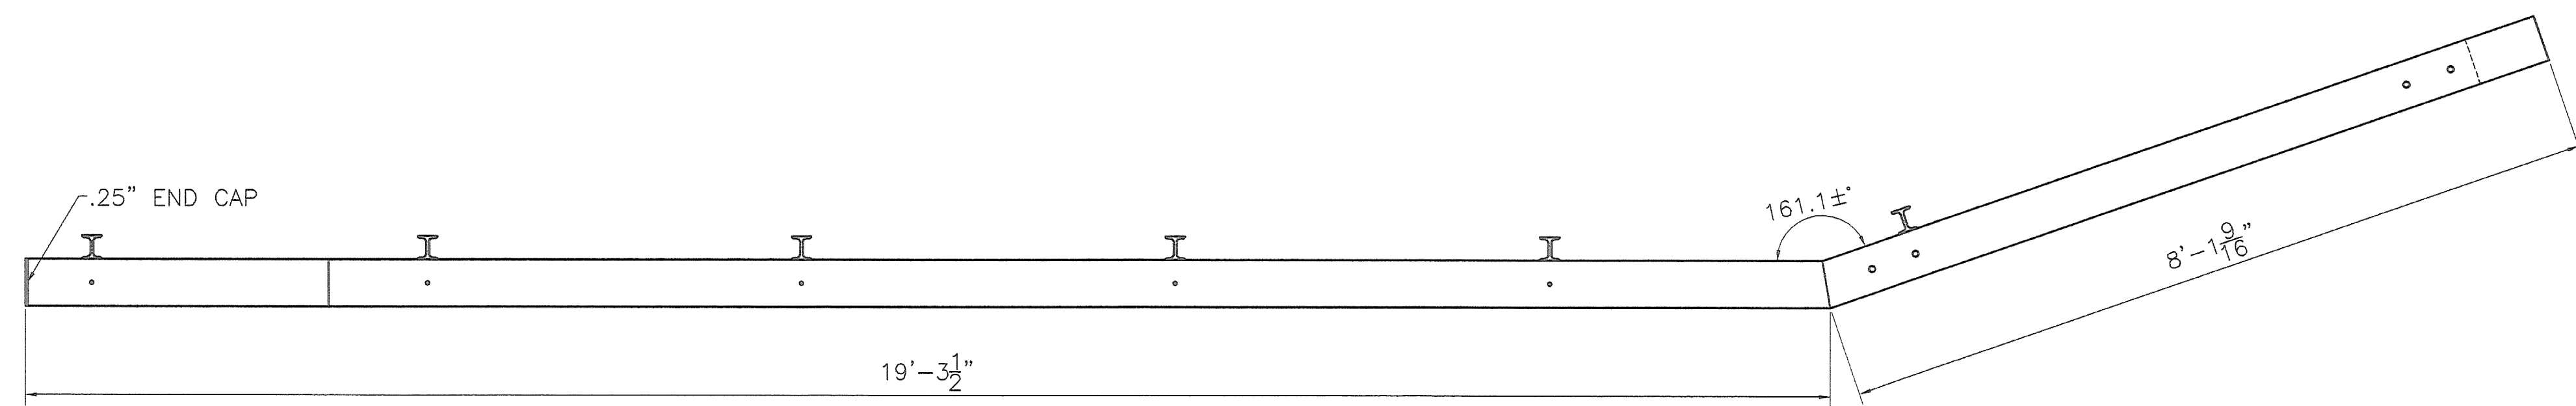

SW CORNER

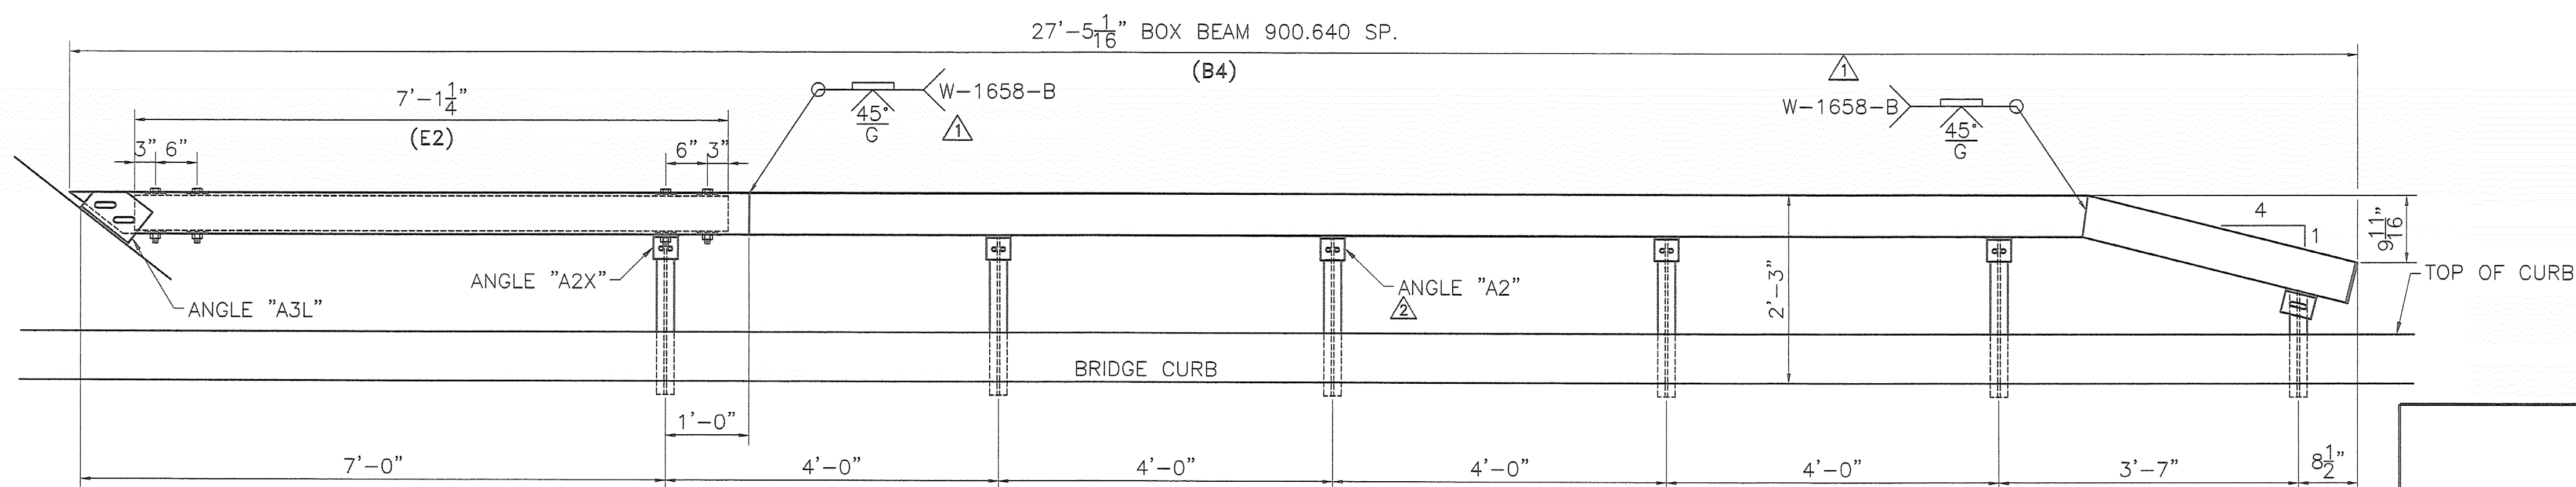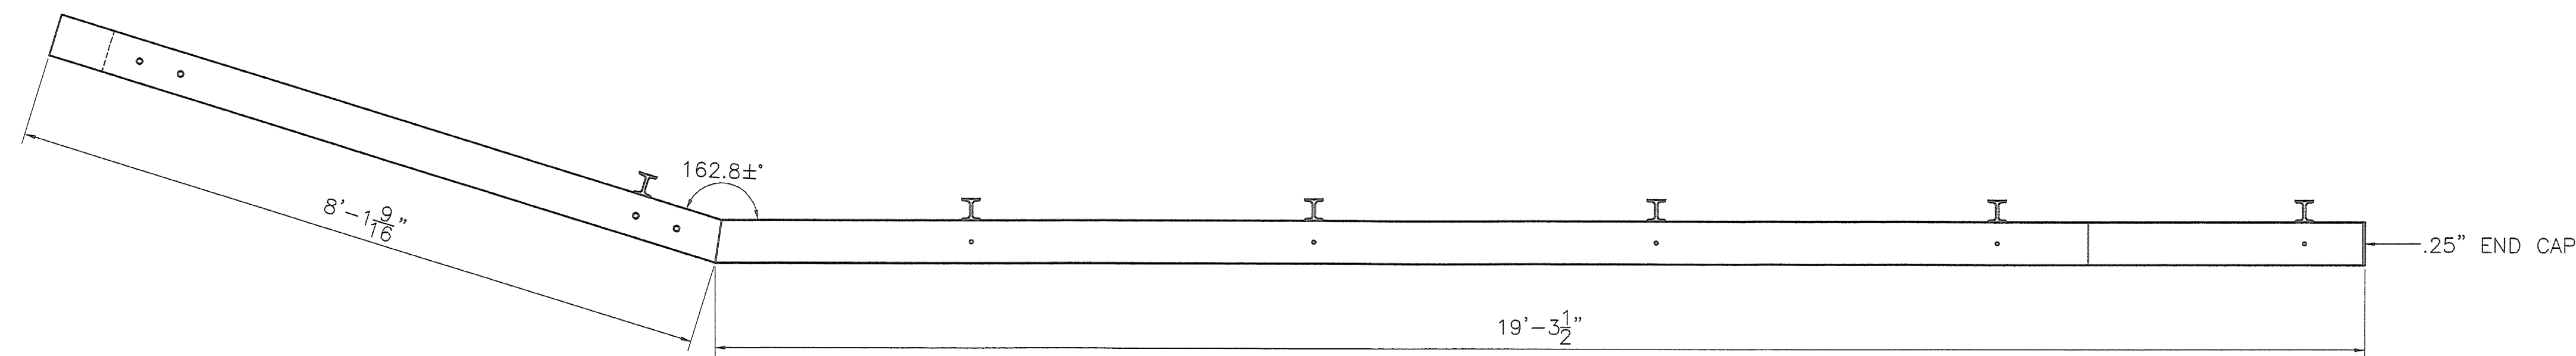

SE CORNER

REVISIONS		
No.	Remarks	Date
0	Initial submittal	9-16-08
1	Per engineer's comments	10-6-08
2	As built changes	10-15-08





HIGHWAY SAFETY CORP.
GLASTONBURY, CT

RAILING REPLACEMENT
ITEM 900.640 SPECIAL PROVISION
RICHFORD, VERMONT
PROJECT NO. BHF 0302 (3) S

GENERAL CONTRACTOR: F.R. LAFAYETTE
DRAWN: MHM
CHECKED: P Radice
DATE: 7/30/08
SCALE: N.T.S.
HSC REFERENCE NO.: 1660
SIZE: D REVISION: 2
SHEET NO.: 2 of 4

BILL OF MATERIAL					
Mk.	Qty.	Description	Size/Shape	Length/Qty. per unit	Material
A4	4	CONNECTION ANGLE	L5x3.5x.375	6"	M270 Gr. 36
A5	14	CONNECTION ANGLE	L5x3.5x.375	8"	M270 Gr. 36
A6	14	CONNECTION ANGLE	L5x3.5x.375	4"	M270 Gr. 36
A7	12	CONNECTION ANGLE	L5x3.5x.375	14"	M270 Gr. 36
A8	12	CONNECTION ANGLE	L5x3.5x.375	14"	M270 Gr. 36
A9	8	CONNECTION ANGLE	L3.5x3.5x.375	6"	M270 Gr. 36
B5	4	BENT PLATE	9'x.375"	24.375"	M270 Gr. 36
B6	4	END TUBE W/WELDED CAP	TS 6x3x.375"	20'-0"	A500 Gr. B
B7	2	TUBE	TS 6x3x.375"	19'-2"	A500 Gr. B
	8	SPLICE TUBE W/2 WELDED NUTS	TS 5x2x.313"	1'-8"	A500 Gr. B
	32	SPLICE HEX BOLT W/WASHER	.625" DIA.	1.75"	A307
	4	HEX BOLT W/HEX NUT & WASHER	.75" DIA.	4.5"	A307
	26	HEX BOLT W/HEX NUT & WASHER	.75" DIA.	8"	A307
	88	HEX BOLT W/HEX NUT & WASHER	.75" DIA.	2"	A307
	8	HEX BOLT W/HEX NUT & WASHER	.875" DIA.	2.25"	A325
	8	HEX BOLT W/HEX NUT & WASHER	.875" DIA.	3"	A325

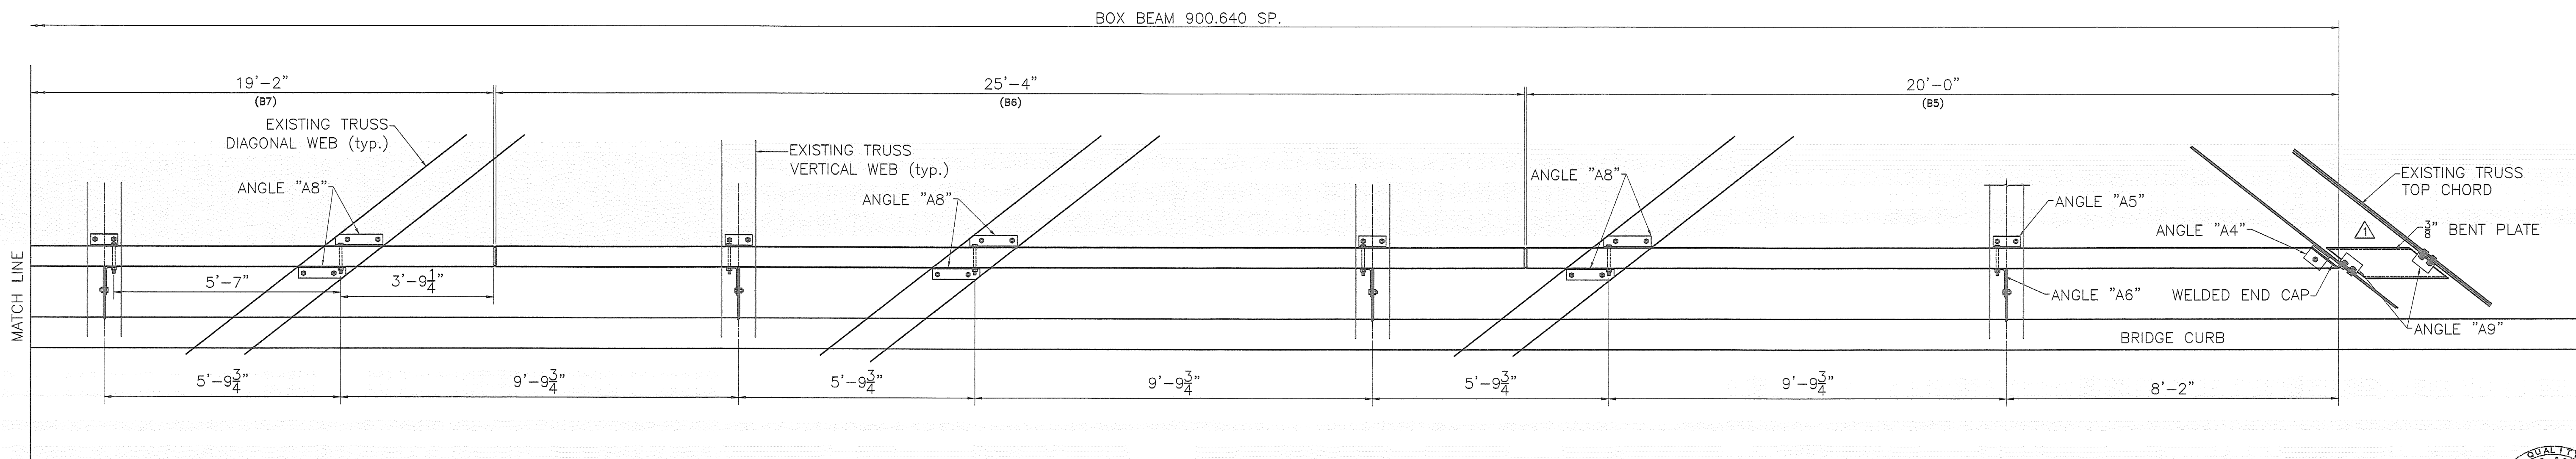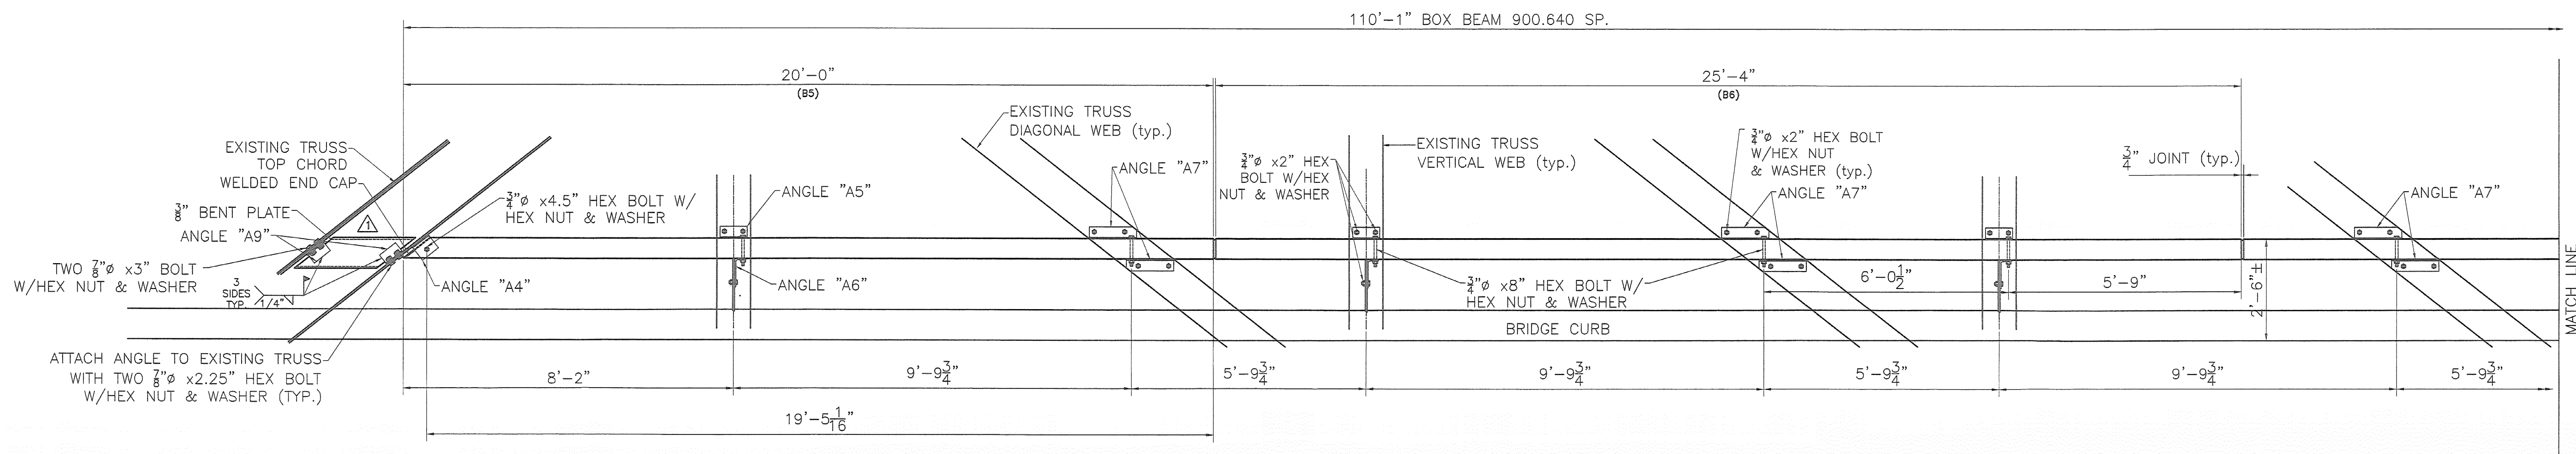

- NOTES:
- BOX BEAM SHALL BE SHOP PAINTED IN ACCORDANCE WITH VT DOT SEC. 513 COLOR 14062.
 - ALL WORK AND MATERIAL SHALL CONFORM TO SECTION 525.
 - ALL BRIDGE RAIL CONNECTION HARDWARE SHALL BE INCIDENTAL TO ITEM 900.640 SPECIAL PROVISION (BRIDGE RAILING, TRUSS).
 - TUBING SHALL MEET THE REQUIREMENTS OF SUBSECTION 732.03. ALL OTHER SHAPES AND PLATES SHALL BE AASHTO M 270M/M 270 GRADE 36.
 - ALL EXPOSED CUT OR SHEARED EDGES SHALL BE ROUNDED TO $\frac{1}{16}$ " RADIUS AND BE FREE OF BURRS.
 - SECTIONS OF BRIDGE RAIL SHALL BE ATTACHED TO A MINIMUM OF TWO (2) TRUSS MEMBERS.
 - ANY BENDING OF BRIDGE RAIL SHALL BE BY SHOP PROCEDURE ONLY.
 - ALL HOLES FOR CONNECTING ANGLES TO BRIDGE TUBES WILL BE SHOP DRILLED.

WEST RAIL ELEVATION
EAST ELEVATION SIMILAR

REVISIONS		
No.	Remarks	Date
0	Initial submittal	9-16-08
1	Per engineer's comments	10-6-08
2	As built changes	10-15-08




HIGHWAY SAFETY CORP.
GLASTONBURY, CT

RAILING REPLACEMENT
ITEM 900.640 SPECIAL PROVISION
RICHFORD, VERMONT
PROJECT NO. BHF 0302 (3) S


GENERAL CONTRACTOR: F.R. LAFAYETTE

SCALE: N.T.S.
SHEET NO. 3 of 4


DATE: 7/30/08
DRAWN: MHM
CHECKED: P Radice
REVISION: 2

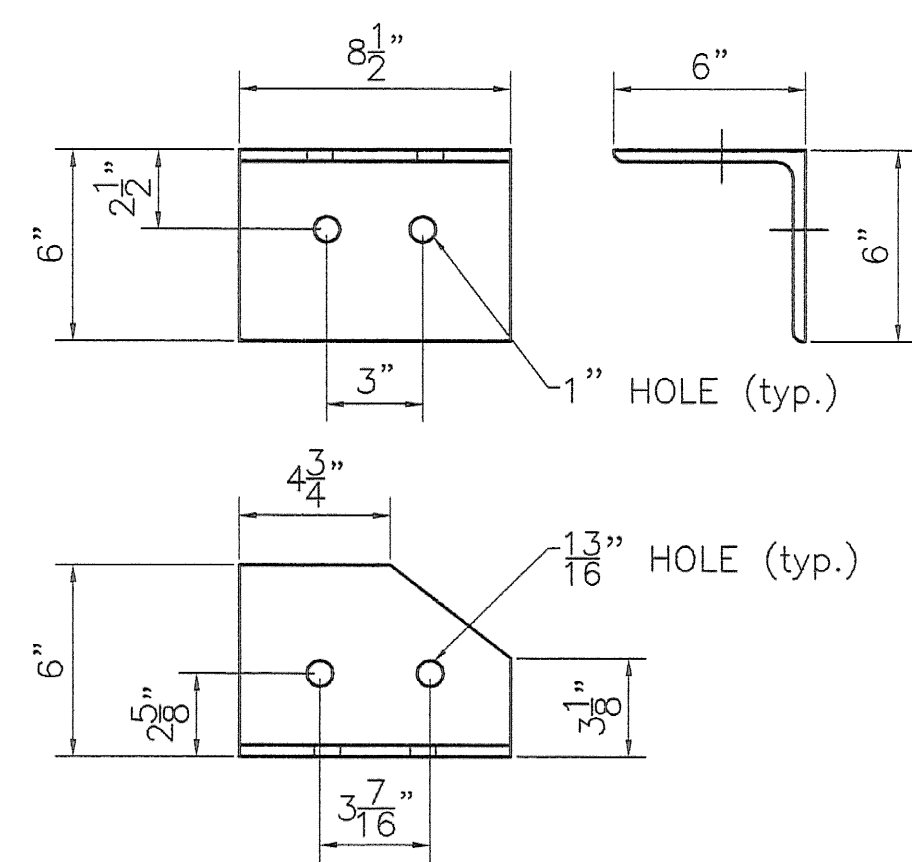


L 6x6x $\frac{3}{8}$ " - "A1R"
△

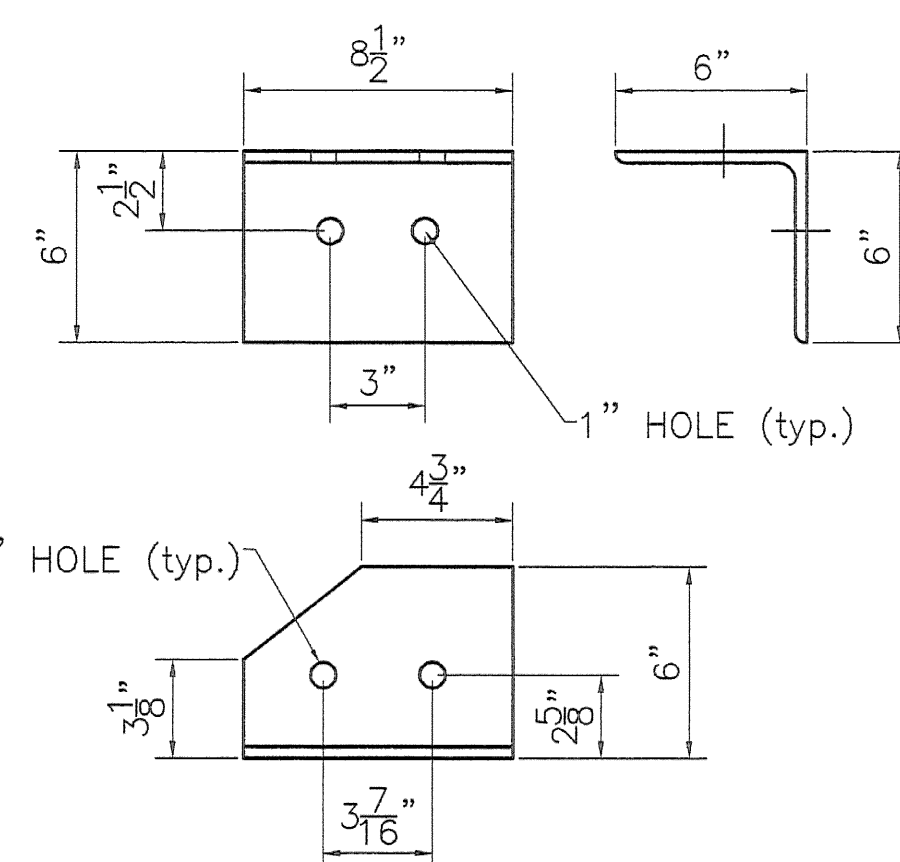


L 6x6x $\frac{3}{8}$ " - "A1L"
△

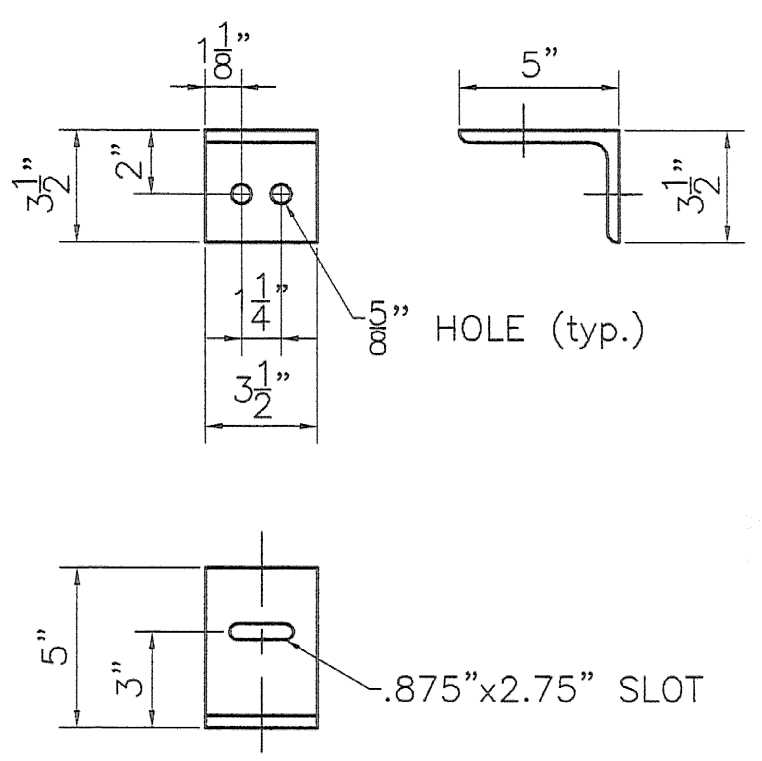


L 5x3 $\frac{1}{2}$ "x $\frac{3}{8}$ " - "A2X"
△

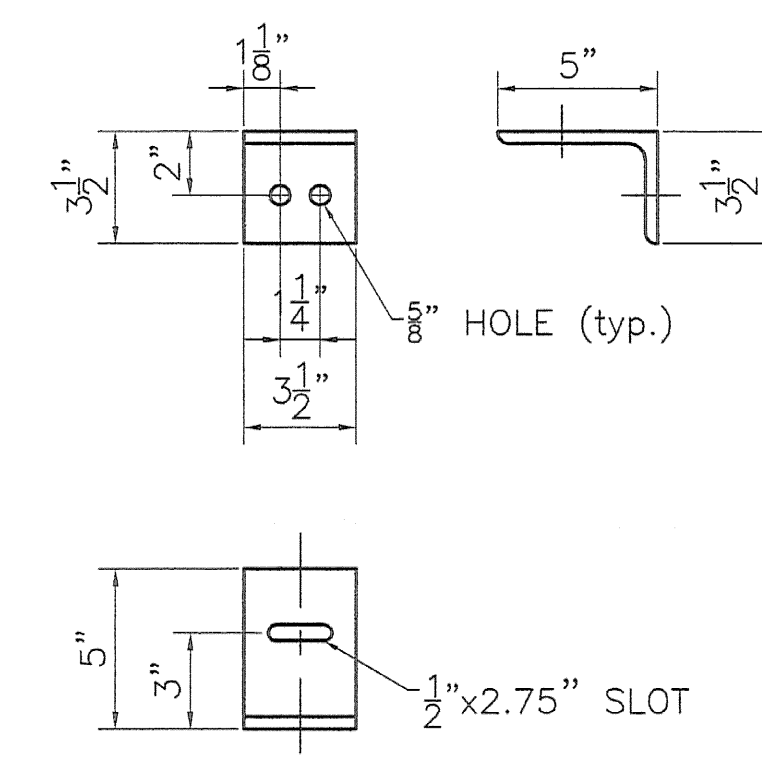


L 5x3 $\frac{1}{2}$ "x $\frac{3}{8}$ " - "A2"
△

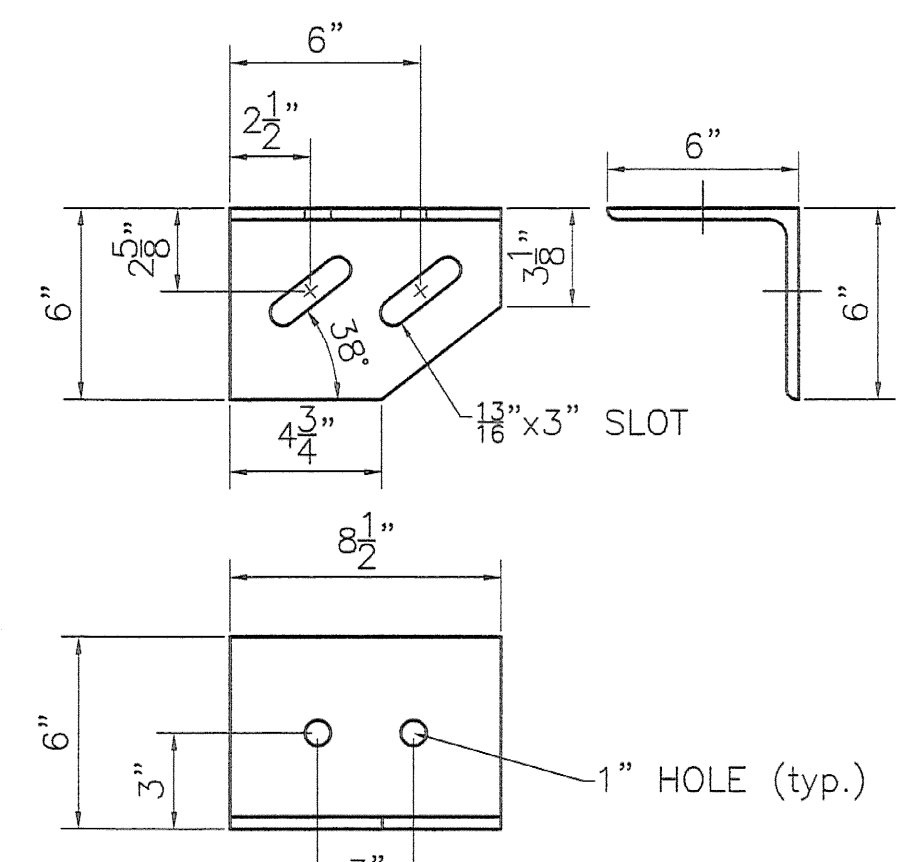


L 6x6x $\frac{3}{8}$ " - "A3L"
△

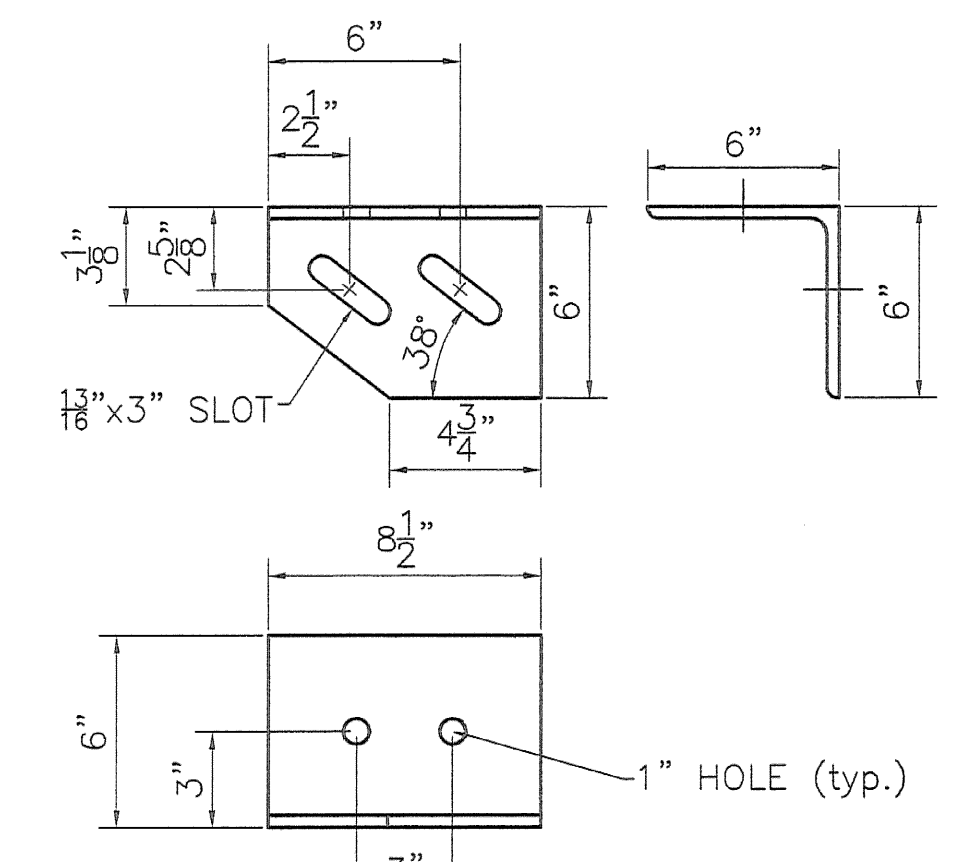


L 6x6x $\frac{3}{8}$ " - "A3R"
△

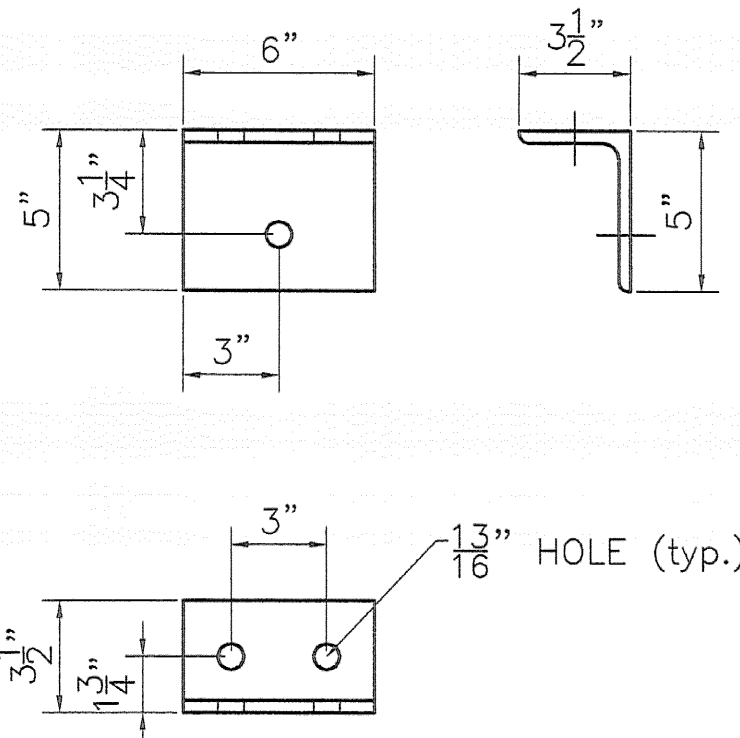


L 5x3 $\frac{1}{2}$ "x $\frac{3}{8}$ " - "A4"
△

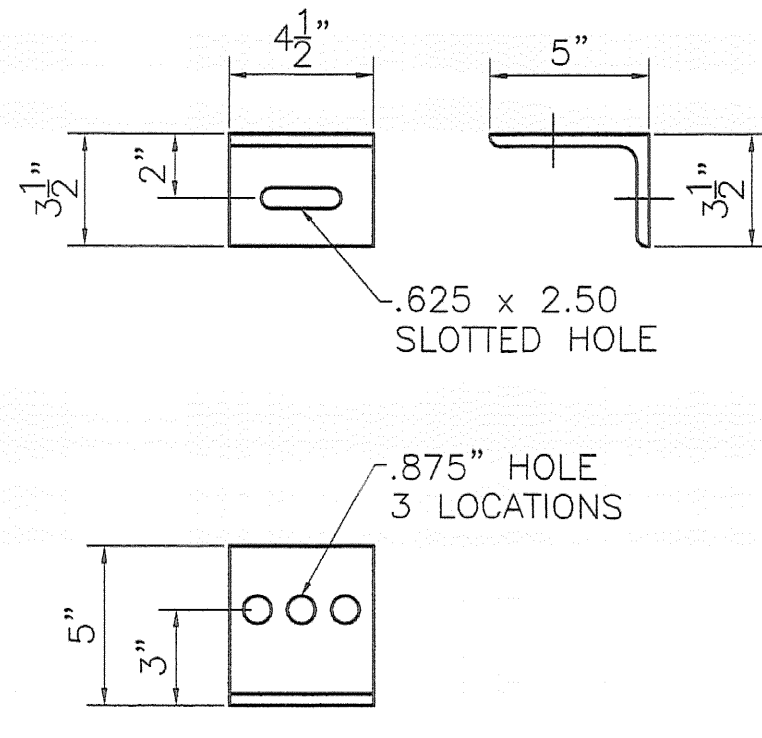


L 5x3 $\frac{1}{2}$ "x $\frac{3}{8}$ " - "D1"
△

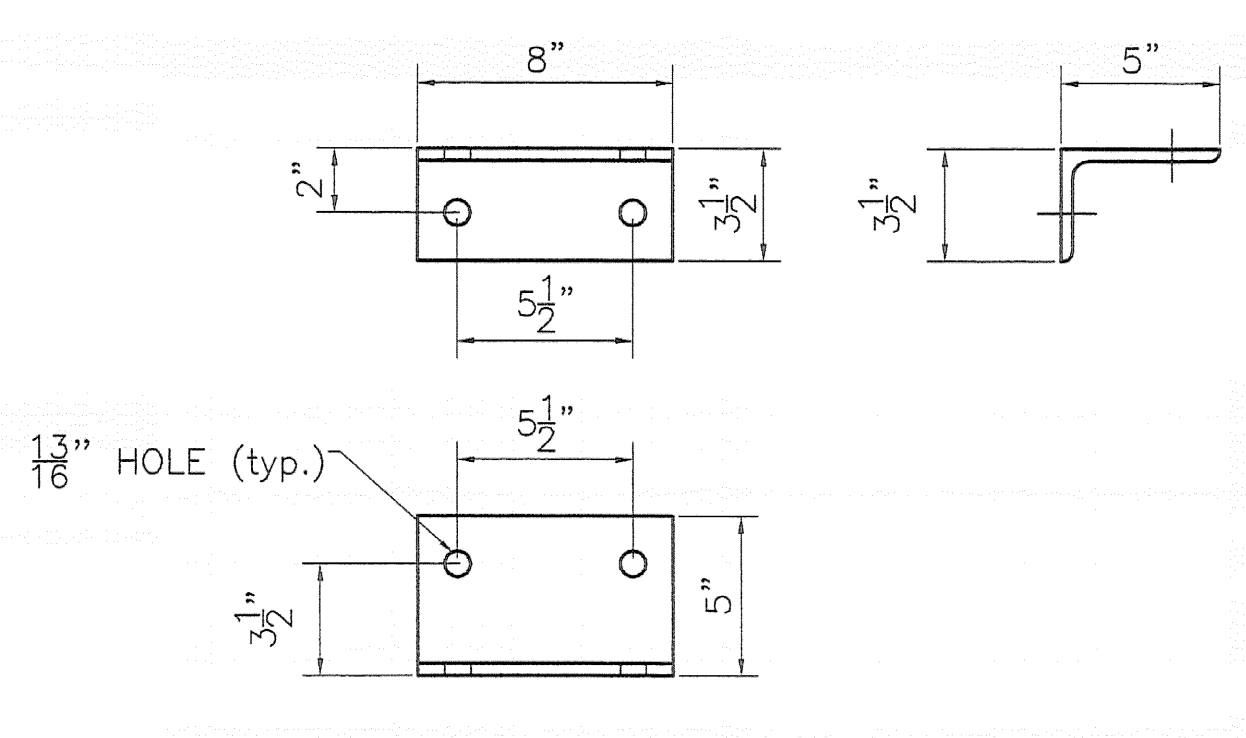


L 5x3 $\frac{1}{2}$ "x $\frac{3}{8}$ " - "A5"
△

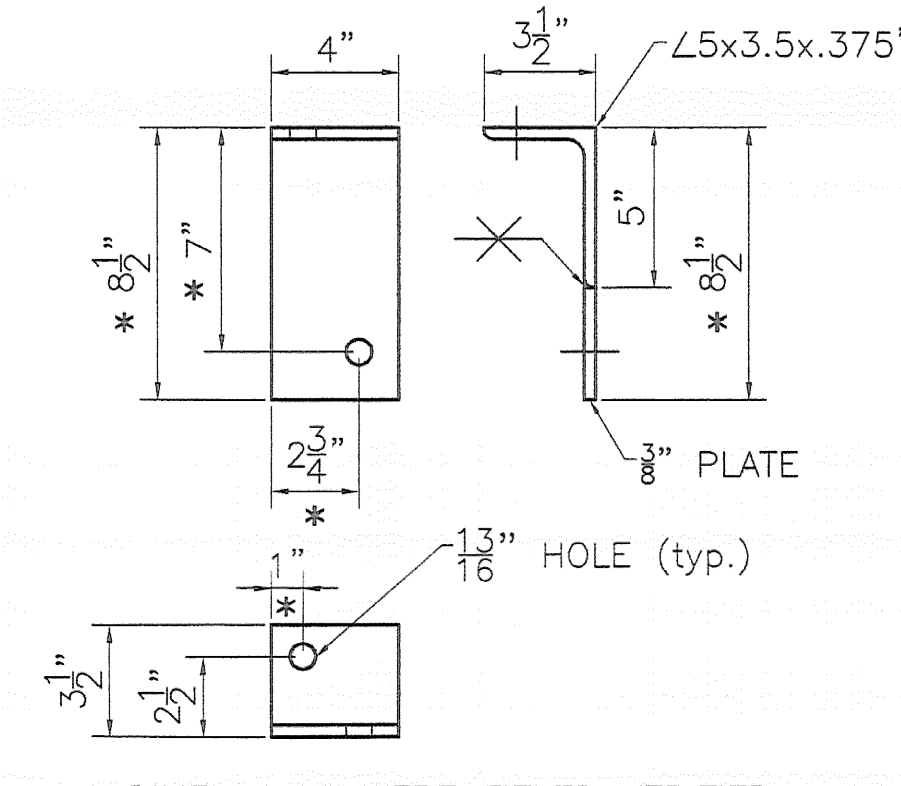


L 5x3 $\frac{1}{2}$ "x $\frac{3}{8}$ " - "A6"
△

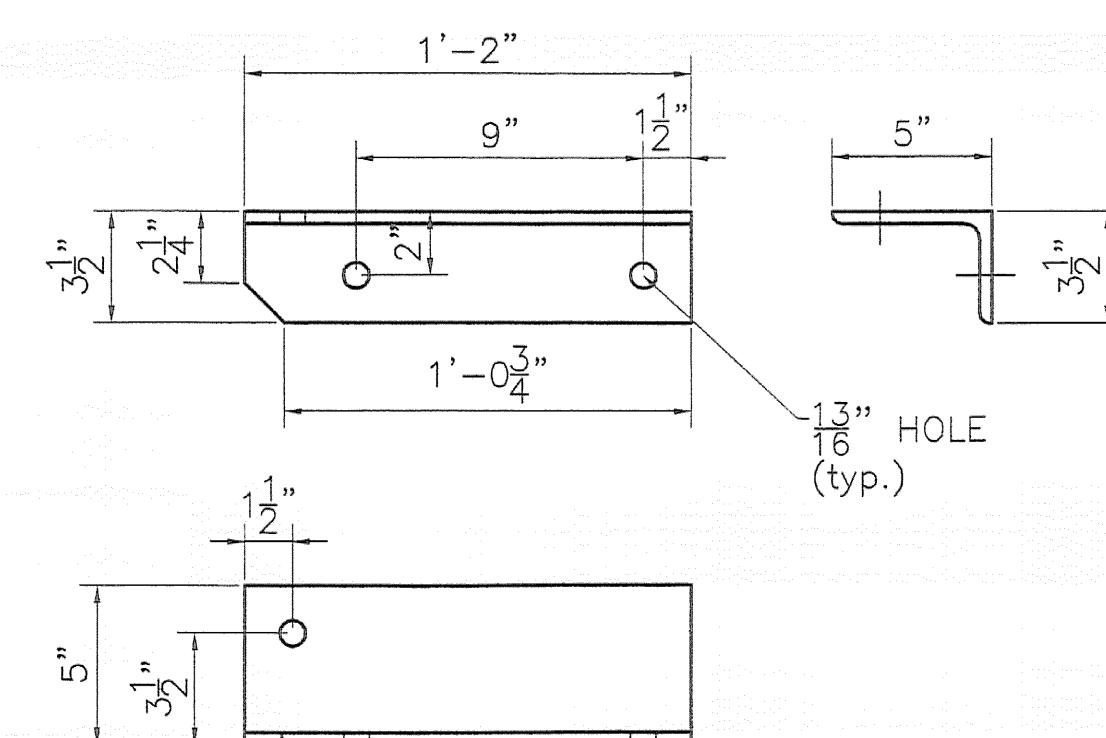


L 5x3 $\frac{1}{2}$ "x $\frac{3}{8}$ " - "A7"
△

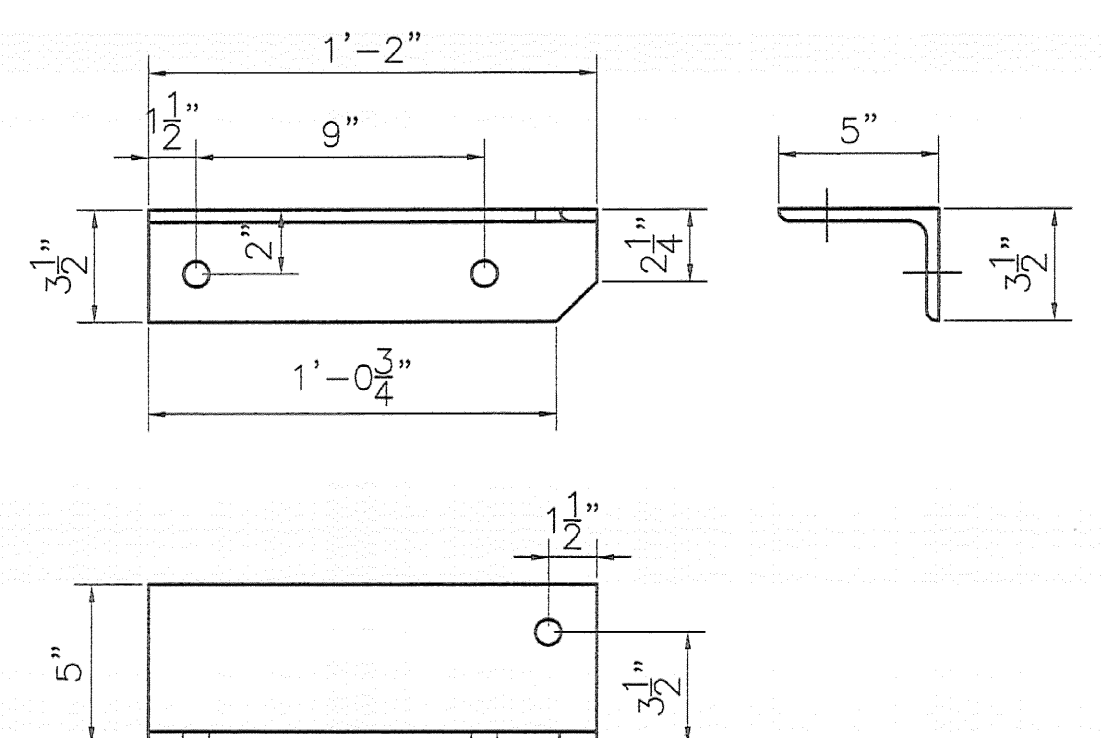


L 5x3 $\frac{1}{2}$ "x $\frac{3}{8}$ " - "A8"
△

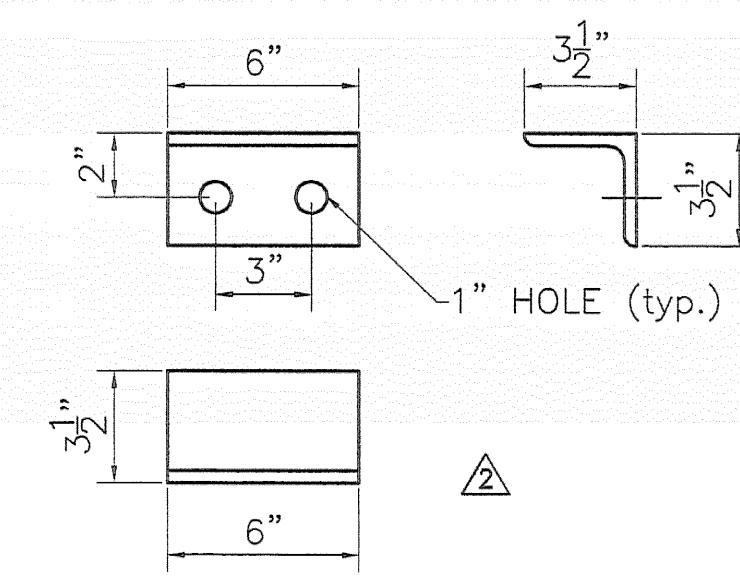


L 3 $\frac{1}{2}$ "x3 $\frac{1}{2}$ "x $\frac{3}{8}$ " - "A9"
△

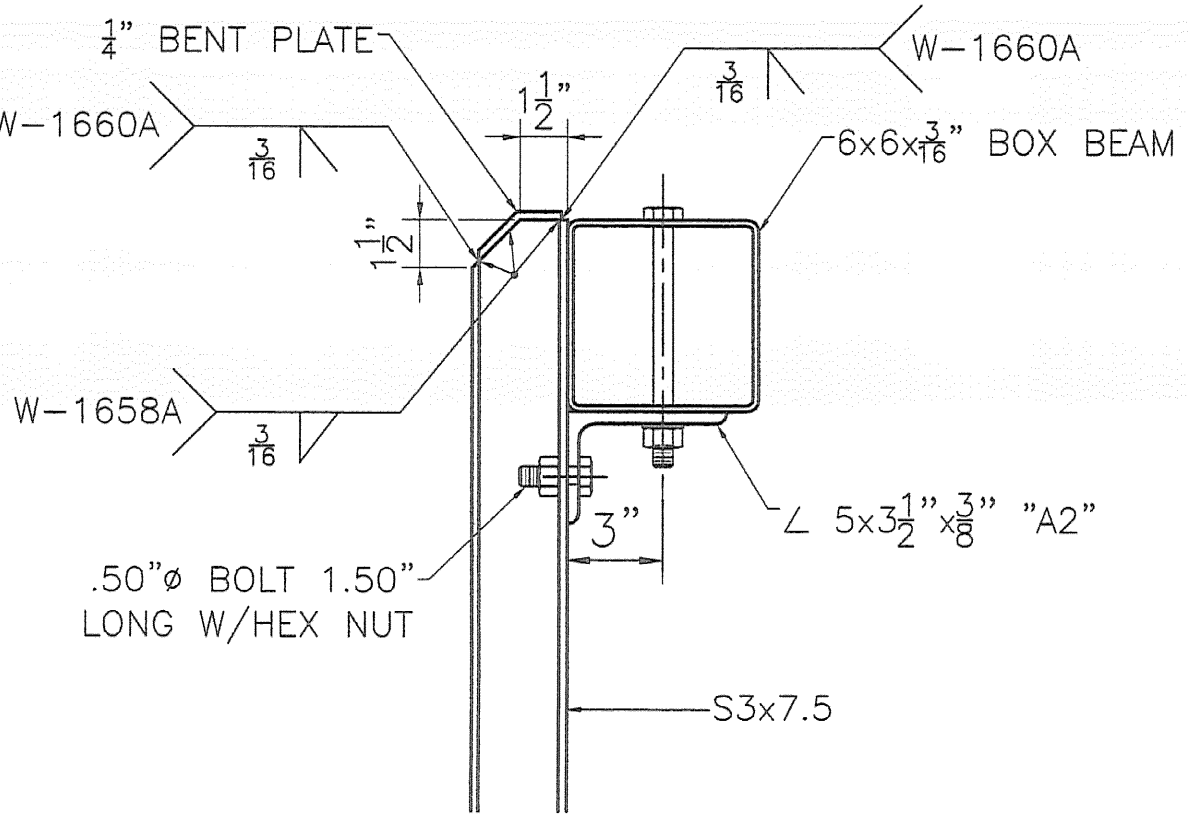


POST SECTION
△

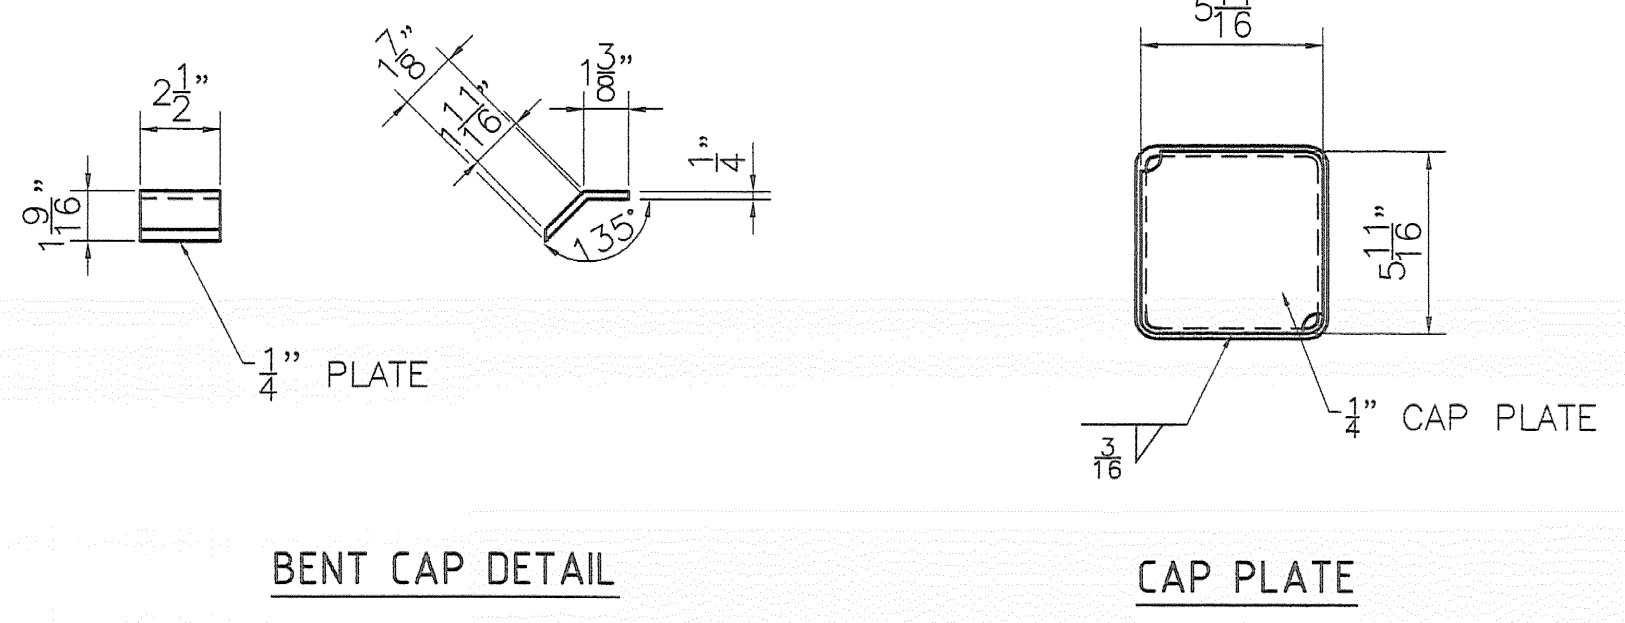



BENT CAP DETAIL

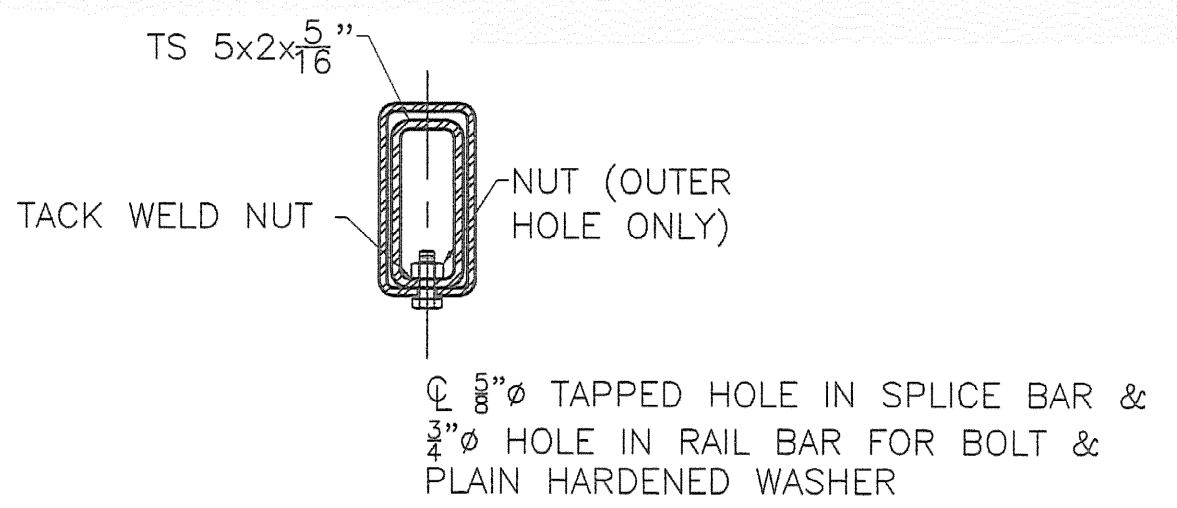

RAIL SPLICE SECTION

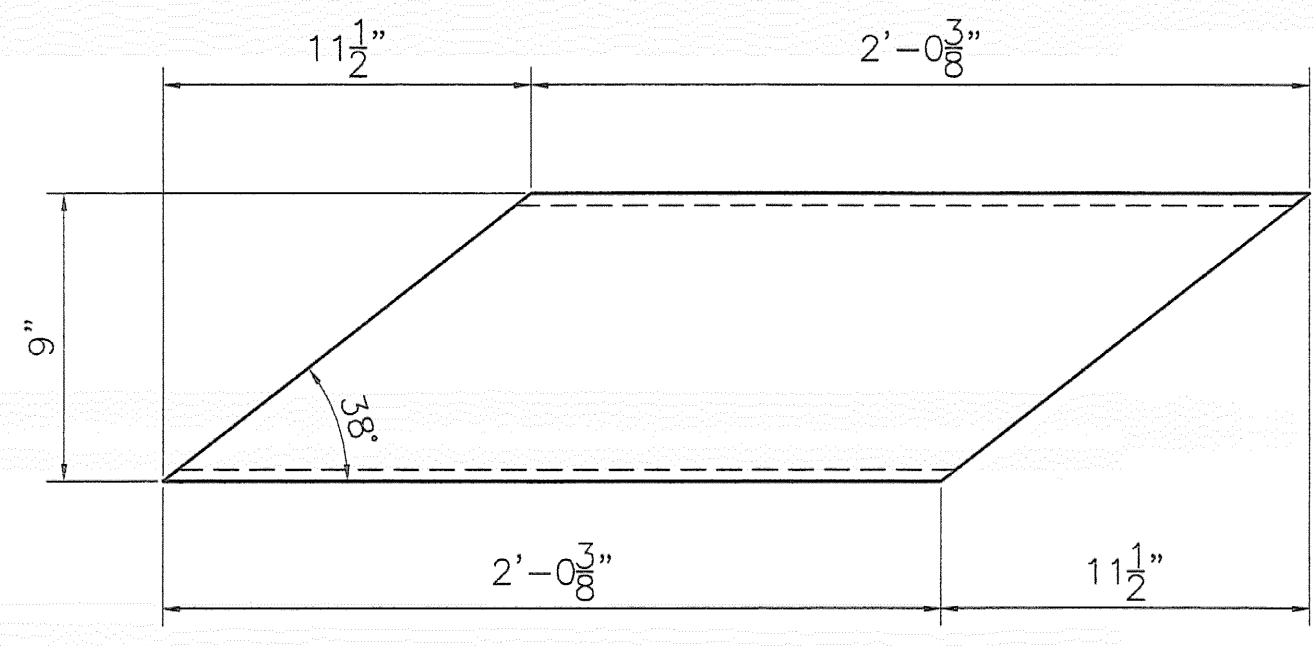

BENT PLATE
△

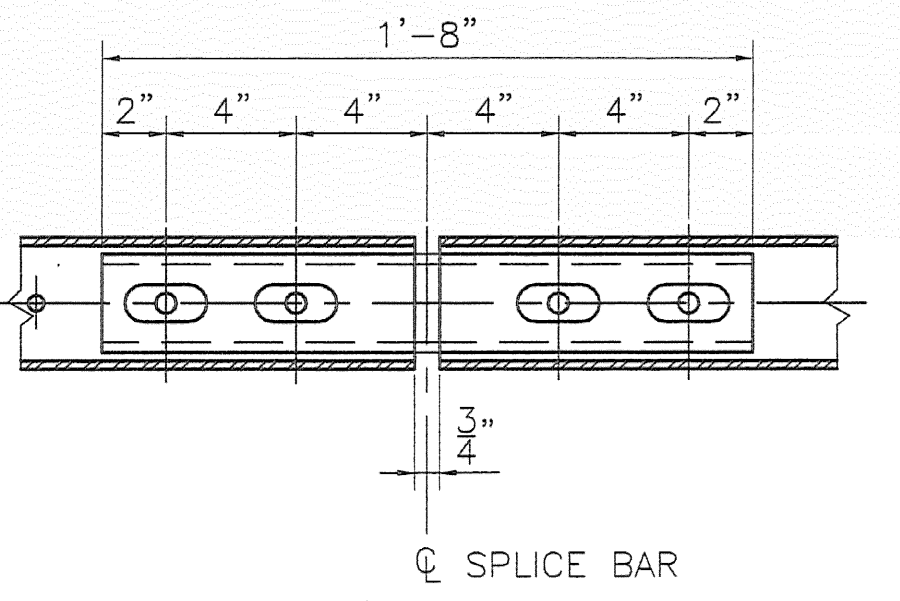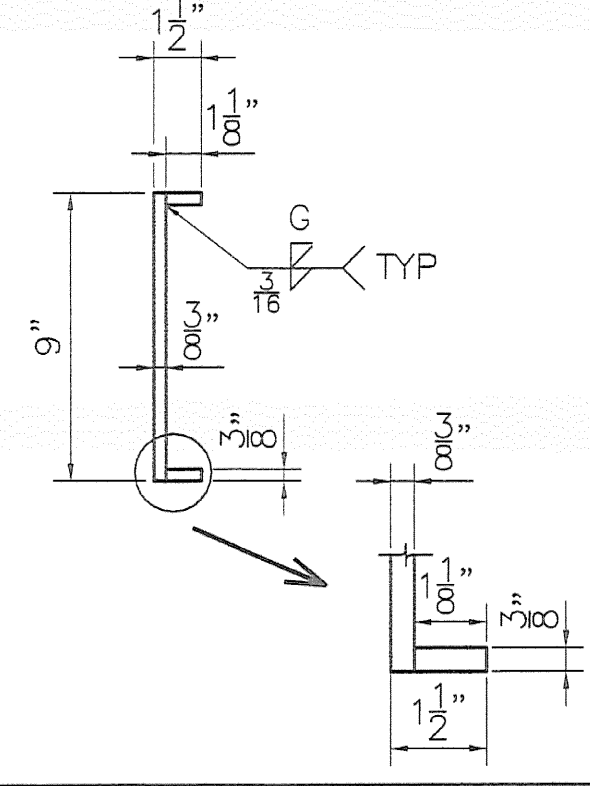

BRIDGE RAIL BAR SPLICE DETAIL

* DIMENSIONS WERE FIELD VERIFIED BY THE G.C., ON SEPT., 08

REVISIONS		
No.	Remarks	Date
0	Initial submittal	9-16-08
1	Per engineer's comments	10-6-08
2	As built changes	10-15-08

HIGHWAY SAFETY CORP.
GLASTONBURY, CT

RAILING REPLACEMENT
RICHFORD, VERMONT
PROJECT NO. BHF 0302 (3) S

GENERAL CONTRACTOR: F.R. LAFAYETTE

DRAWN: MHM
CHECKED: P Radice
DATE: 7/30/08
SCALE: N.T.S.
HSC REFERENCE NO.: 1660
SIZE: D
SHEET NO.: 4 of 4



