


**PLAN**  
SCALE 1" = 10'-0"

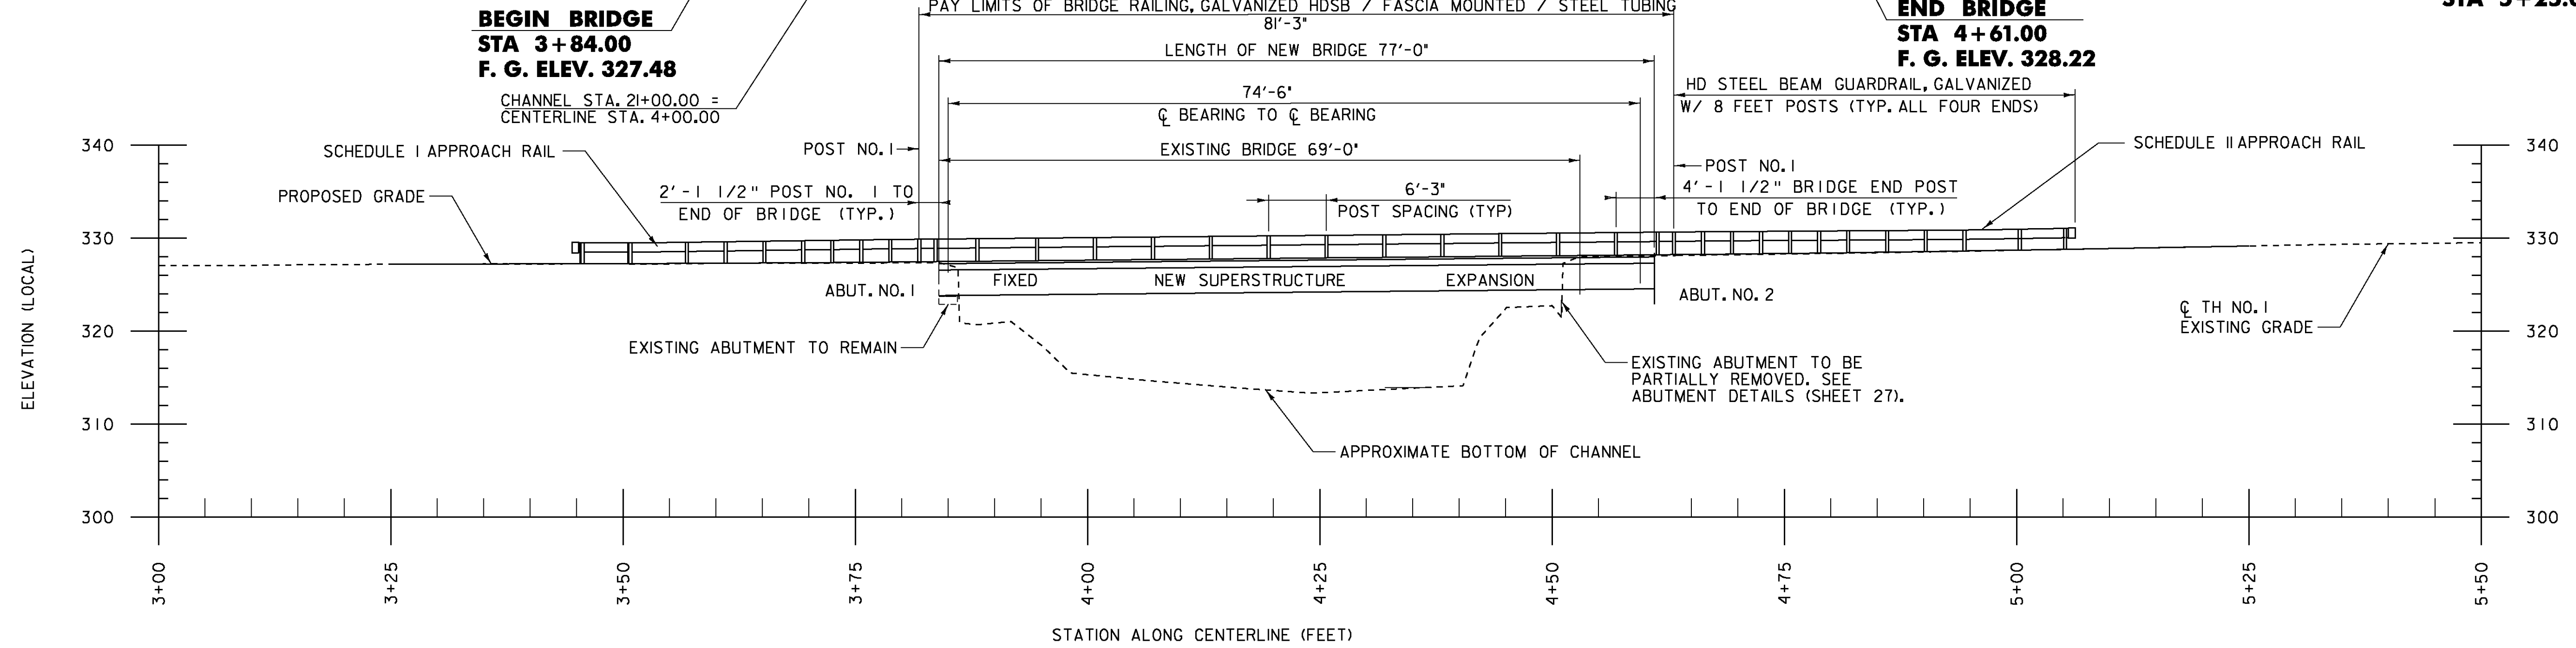

**ELEVATION**  
SCALE 1" = 10'-0"

**EXISTING LEGEND**

EDGE OF RIVER	
EDGE OF ROAD	
ROW	
GUARD RAIL	
TREE LINE	
UTILITY POLE	
SIGN	
TREES	
OVERHEAD UTILITIES	
CENTERLINE ROAD	

**DuBois & King**  
INC.  
engineering planning management development

**DATUM**  
VERTICAL ASSUMED  
HORIZONTAL ASSUMED

<b>STATE OF VERMONT AGENCY OF TRANSPORTATION</b>	
Town Of <b>STOWE</b>	Bridge No. <b>3</b>
Highway No. <b>T.H. 1</b>	Log Sta. _____ Surv. Sta. _____
<b>MOSCOW ROAD OVER MILLER BROOK PLAN AND ELEVATION</b>	
Designed By <b>R.H. BARNES</b>	Drawn By <b>S.J. BIJOLLE</b>
Checked By <b>E.P. DETRICK</b>	Bridge Design Supervisor <b>J.W. TUCKER</b>
Date <b>5/09</b>	Date <b>5/09</b>
PROJECT <b>STOWE</b>	PROJECT NO. <b>BHO 1446 (30)</b>
I.G.C. Info. ... \DGN\z99j24bdr.dgn	
D & K DWG NO. _____	Sheet <b>14</b> of <b>37</b>

PLOTTED 12/21/2009