


DATUM
 VERTICAL ASSUMED
 HORIZONTAL ASSUMED

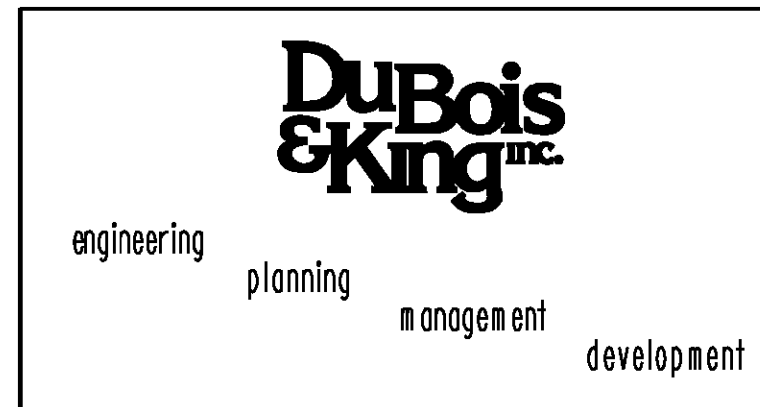

STA. 1+25 TO STA. 2+50
 PLOTTED 10/22/2009

STATE OF VERMONT AGENCY OF TRANSPORTATION			
Town Of	STOWE	Bridge No.	3
Highway No.	T.H. 1	Log Sta.	
		Surv. Sta.	
MOSCOW ROAD OVER MILLER BROOK ROADWAY CROSS SECTIONS 1			
Designed By	R.H. BARNES	Drawn By	S.J. BIJOLLE
Checked By	E.P. DETRICK	Bridge Design Supervisor	J.W. TUCKER
Date	5/09	Date	5/09
PROJECT	STOWE	PROJECT NO.	BHO 1446 (30)
I.G.C. Info.	...\\DGN\z99j244xsl.dgn		
D & K DWG NO.	Sheet 31 of 37		