



Accepted ✓
 Accepted as Noted
 Accepted Noted Resubmit
 Rejected, Revise Resubmit
 Rejected - Unacceptable

Checking is only for conformance with the design concept of the Project and compliance with the information given in the Contract Documents. The Engineer assumes no liability for errors or omissions that may be contained herein. The Contractor, by approving and submitting these documents, verifies their accuracy as stipulated on the Contractor's Shop Drawing Stamp.

Date 7/2/10 By *[Signature]* DuBOIS AND KING

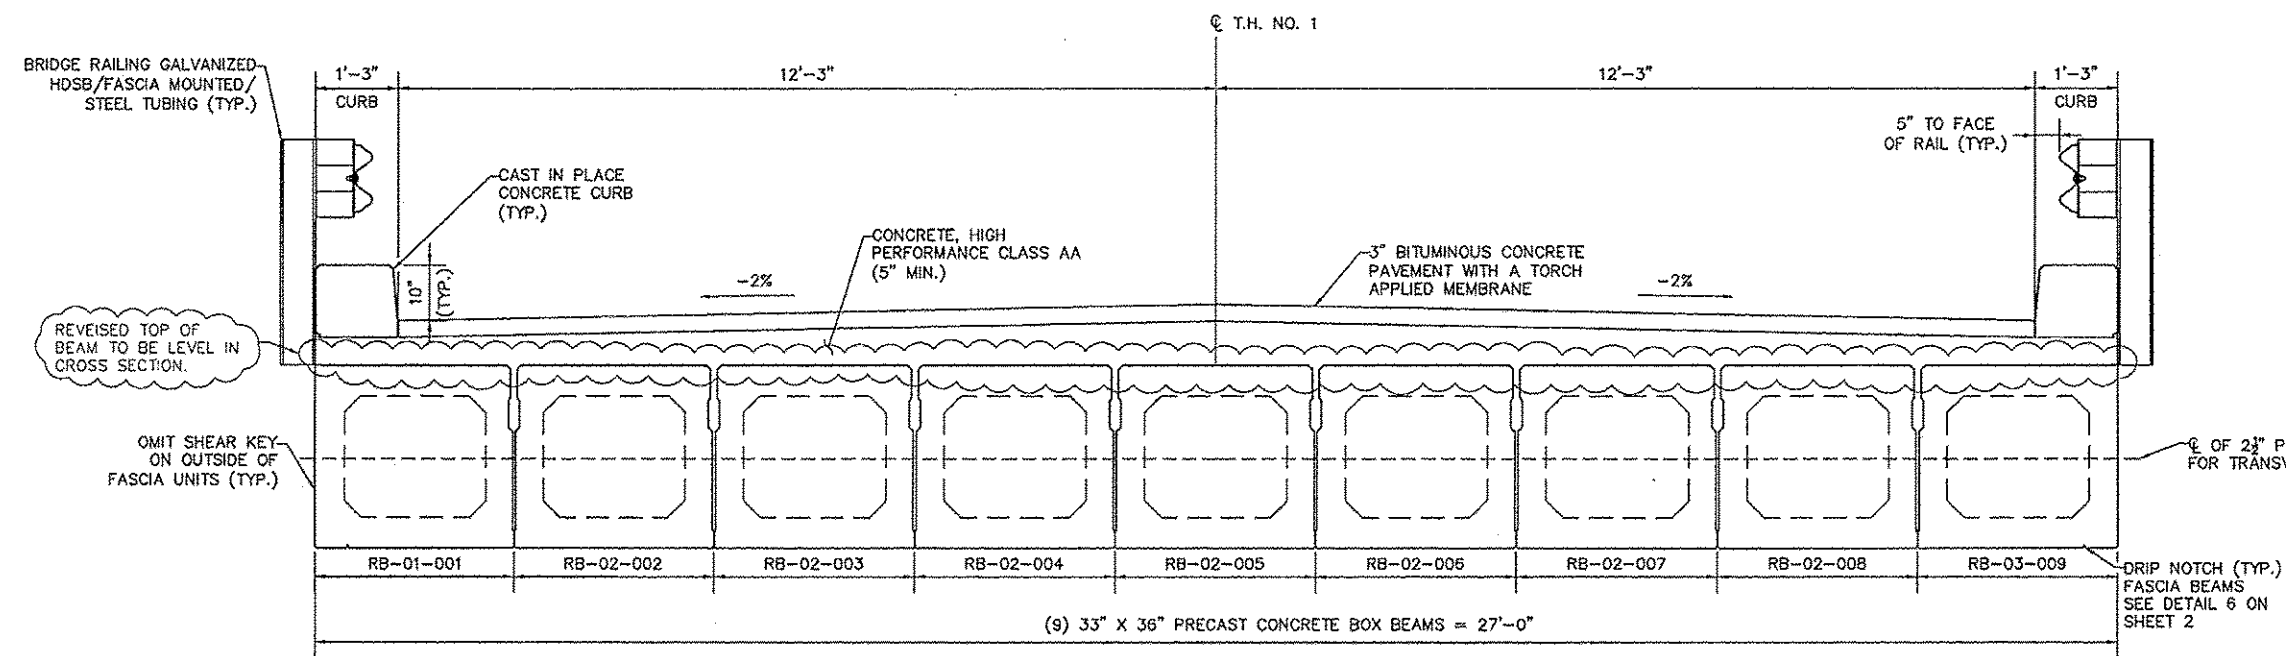

TRANSVERSE SECTION
 SCALE: 3/4" = 1'-0"

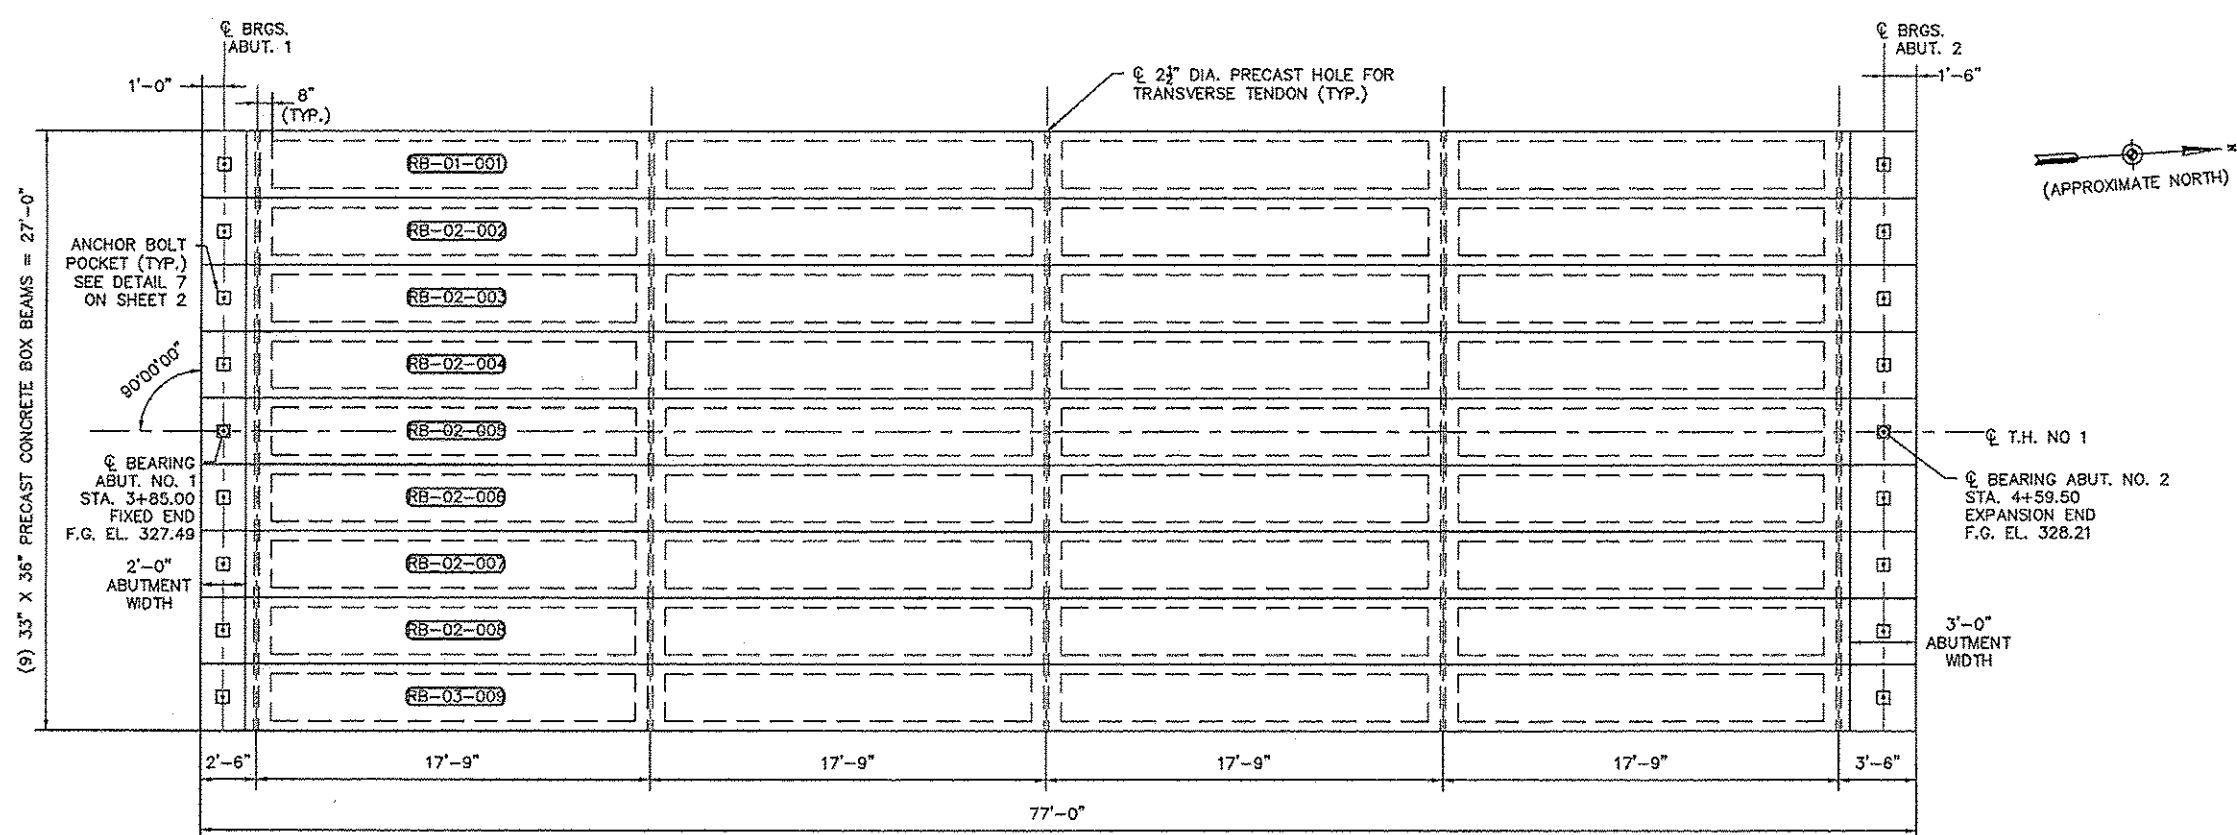

BEAM LAYOUT PLAN
 SCALE: 3/4" = 1'-0"

Hoyle, Tanner & Associates, Inc.
 125 College Street, 4th Floor Burlington, VT 05401
 Tel: (802)860-1331 Fax: (802)860-6499 www.hoyletanner.com
 © Copyright 2010 Hoyle, Tanner & Associates, Inc.

DRAWN BY: NAR CHECKED BY: LRS DATE: JUNE 2010 PROJECT NO: 122426.75

W.E. DAILEY INC.
 PRECAST CONCRETE PRODUCTS
 TEL: (802) 442-4418 FAX: (802) 442-4719

STATE OF VERMONT AGENCY OF TRANSPORTATION
STOWE, VT
 MOSCOW ROAD (T.H. NO. 1) OVER MILLER BROOK BRIDGE #3
 PROJECT NO. BHO 1446(30)

SHEET 1 OF 5