


INDEX OF SHEETS

SEE PRELIMINARY INFORMATION SHEET, SHEET 2

STATE OF VERMONT AGENCY OF TRANSPORTATION

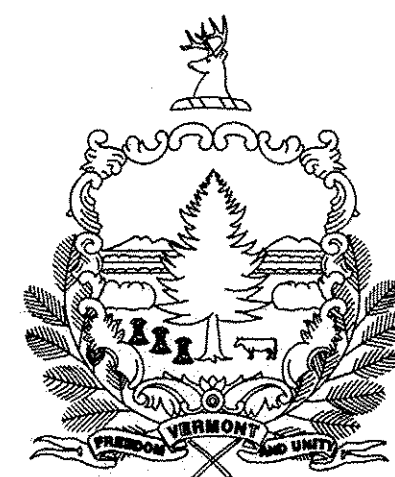


PROPOSED IMPROVEMENT BRIDGE PROJECT TOWN OF BROWNINGTON COUNTY OF ORLEANS

ROUTE NO : T.H. 2 CL.2 BRIDGE NO : BR 8


PROJECT LOCATION : BEGINNING AT THE INTERSECTION OF T.H. 2 AND VT 58 AND
EXTENDING NORTHERLY ALONG T.H. 2 FOR 0.06 MILES.

PROJECT DESCRIPTION : REPLACEMENT OF THE EXISTING BRIDGE WITH A NEW STRUCTURE,
INCLUDING RELATED CHANNEL AND APPROACH ROADWAY WORK.

LENGTH OF STRUCTURE : 125.66 FEET.
LENGTH OF ROADWAY : 187.67 FEET.
LENGTH OF PROJECT : 313.33 FEET.

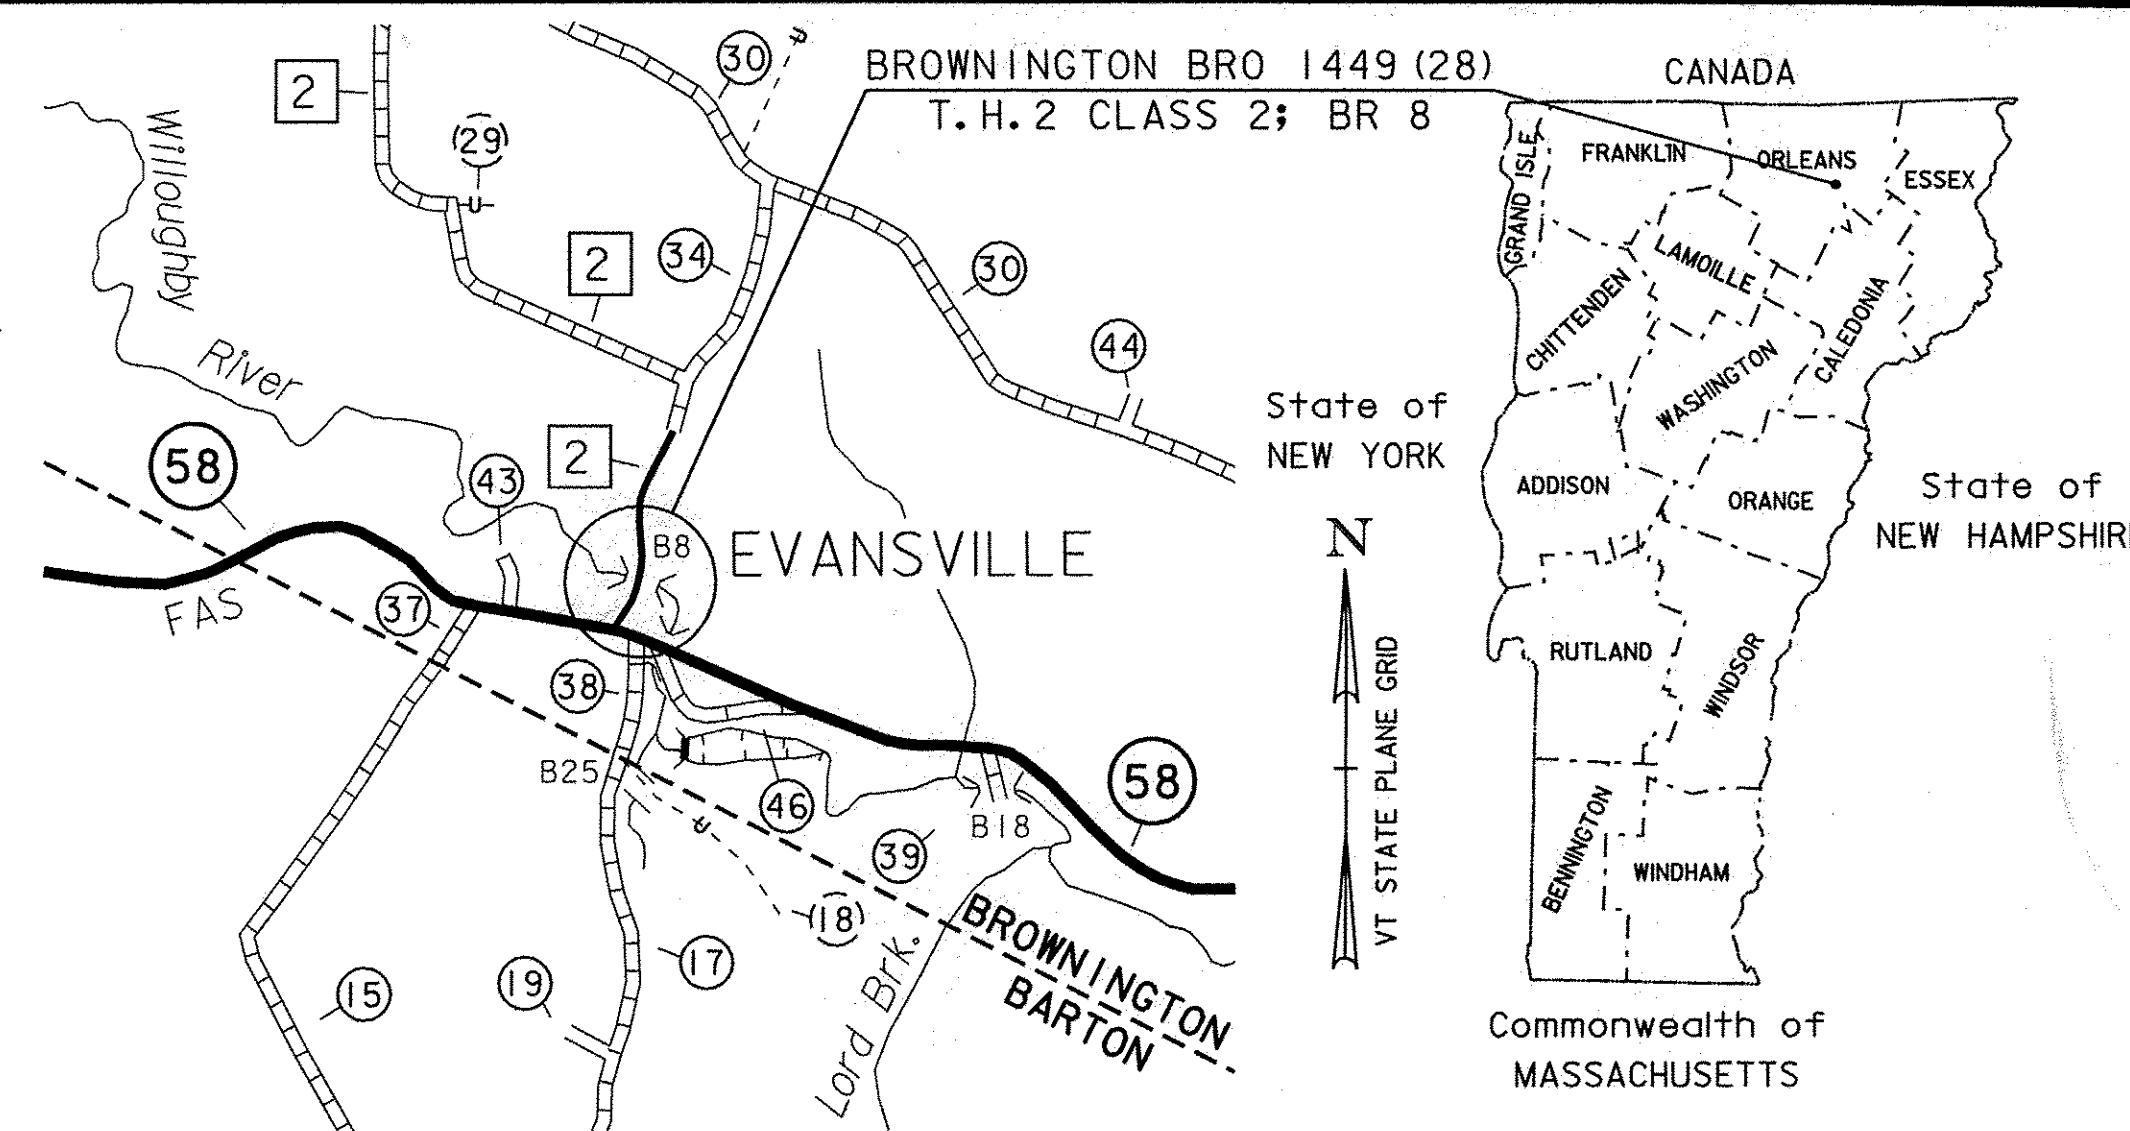

LOCATION MAP

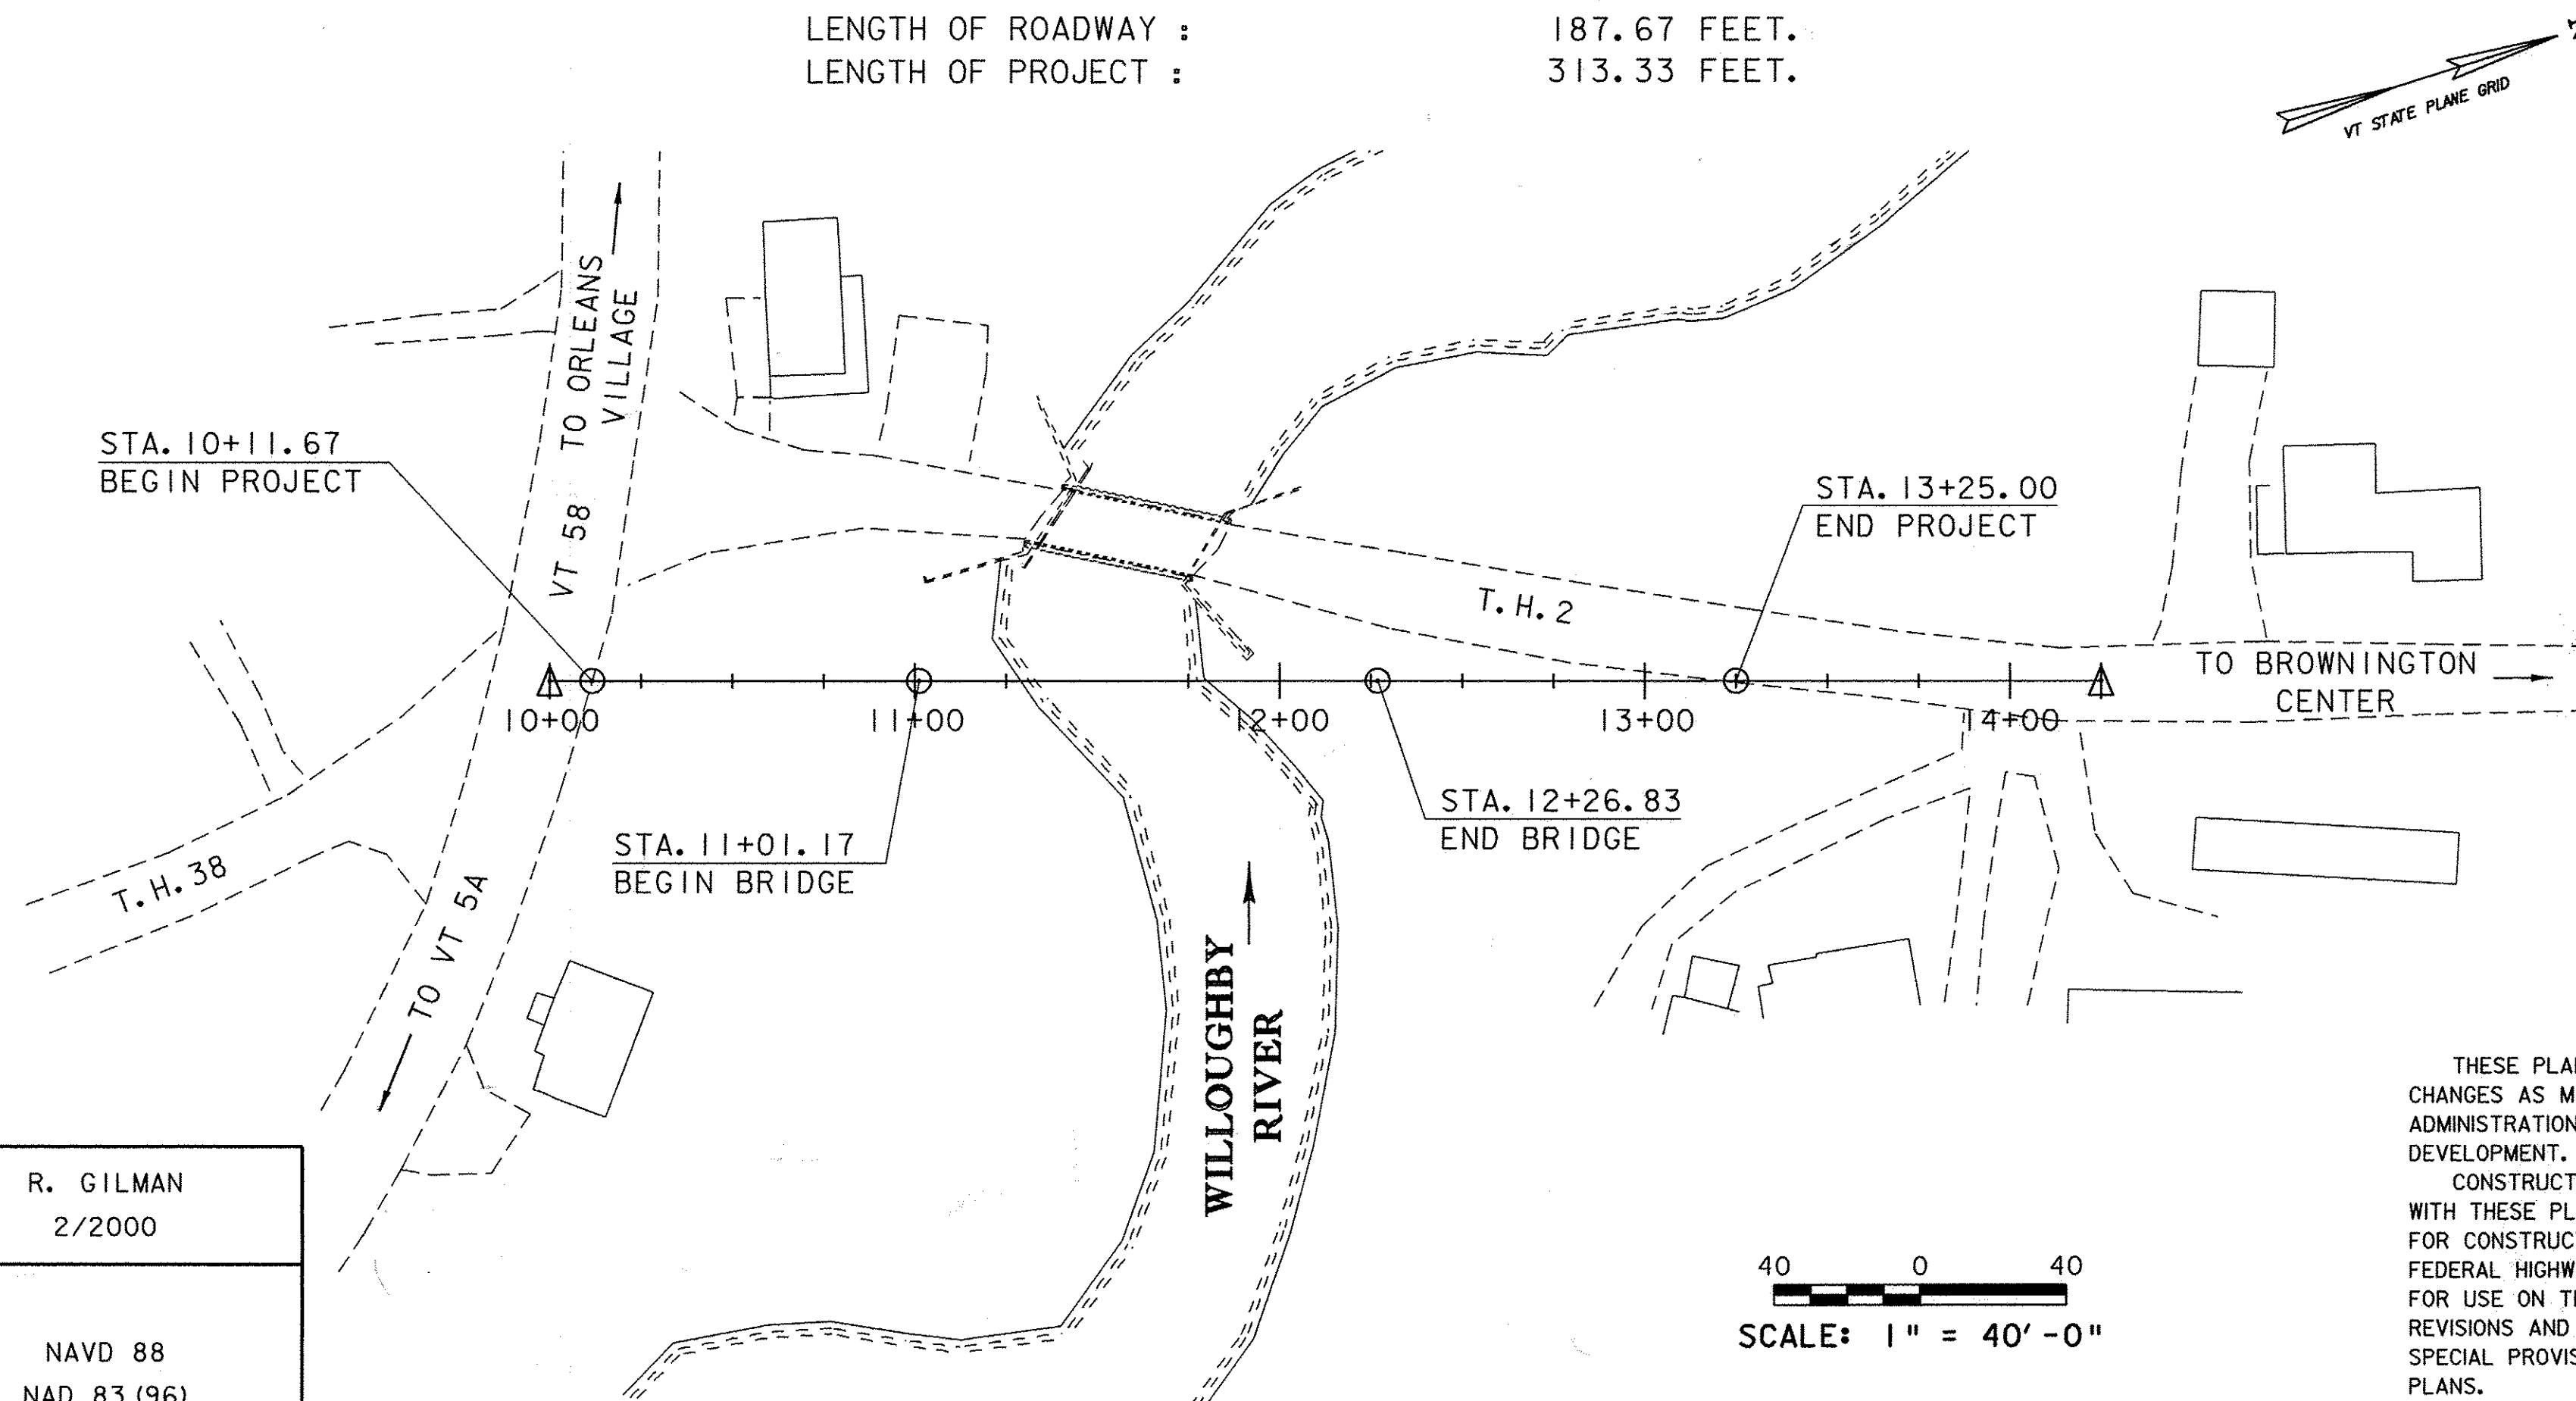


CONVENTIONAL SYMBOLS

COUNTY LINE	
TOWN LINE	
LIMITS OF ACCESS	
POINT OF ACCESS	
FENCE LINE	
STONE WALL	
TRAVELED WAY	
GUARD RAIL	
RAILROAD	
SURVEY LINE	
CULVERT	
POWER POLE	
TELEPHONE POLE	
TREES	
CONTROL OF ACCESS	
PROPERTY LINE	
R.O.W. TAKING LINE	
SLOPE RIGHTS	
TOP OF CUT	
TOE OF SLOPE	

SURVEYED BY : R. GILMAN
SURVEYED DATE : 2/2000

DATUM
VERTICAL NAVD 88
HORIZONTAL NAD 83 (96)

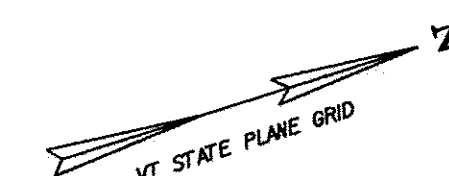

SCALE: 1" = 40'-0"

RECORD PLANS

CONTRACTOR: AUSTIN CONSTRUCTION INC.-CONCORD, VT

RESIDENT ENGINEER: SHANE MORIN

CONSTRUCTION BEGAN: JULY 1, 2009

CONSTRUCTION COMPLETE: AUGUST 12, 2010

RECORD PLANS BY: SHANE MORIN & AMOS KEMPTON

I HEREBY CERTIFY THAT ALL THE CONSTRUCTION REQUIRED BY THIS SET OF DRAWINGS HAS BEEN ACCOMPLISHED AS INDICATED HEREIN.

BY *Shane Morin* RESIDENT ENGINEER

DATE 8/2/2011

NOTE: Any further information concerning final quantities, amounts or other details relative to this project may be found at Central Files in the electronic archives.

THESE PLANS ARE SUBJECT TO SUCH ENGINEERING CHANGES AS MAY BE REQUIRED BY THE FEDERAL HIGHWAY ADMINISTRATION OR THE DIRECTOR OF PROGRAM DEVELOPMENT.

CONSTRUCTION IS TO BE CARRIED ON IN ACCORDANCE WITH THESE PLANS AND THE STANDARD SPECIFICATIONS FOR CONSTRUCTION DATED 2006, AS APPROVED BY THE FEDERAL HIGHWAY ADMINISTRATION ON JUNE 15, 2006 FOR USE ON THIS PROJECT, INCLUDING ALL SUBSEQUENT REVISIONS AND SUCH REVISED SPECIFICATIONS AND SPECIAL PROVISIONS AS ARE INCORPORATED IN THESE PLANS.

DIRECTOR OF PROGRAM DEVELOPMENT

APPROVED *R.R. Whitcomb* DATE 12-22-08

PROJECT MANAGER : R.R. WHITCOMB

PROJECT NAME : BROWNINGTON

PROJECT NUMBER : BRO 1449 (28)

SHEET 1 OF 58 SHEETS