


EXISTING ABUTMENT EXCAVATIONS & REMOVALS
(NOT TO SCALE)

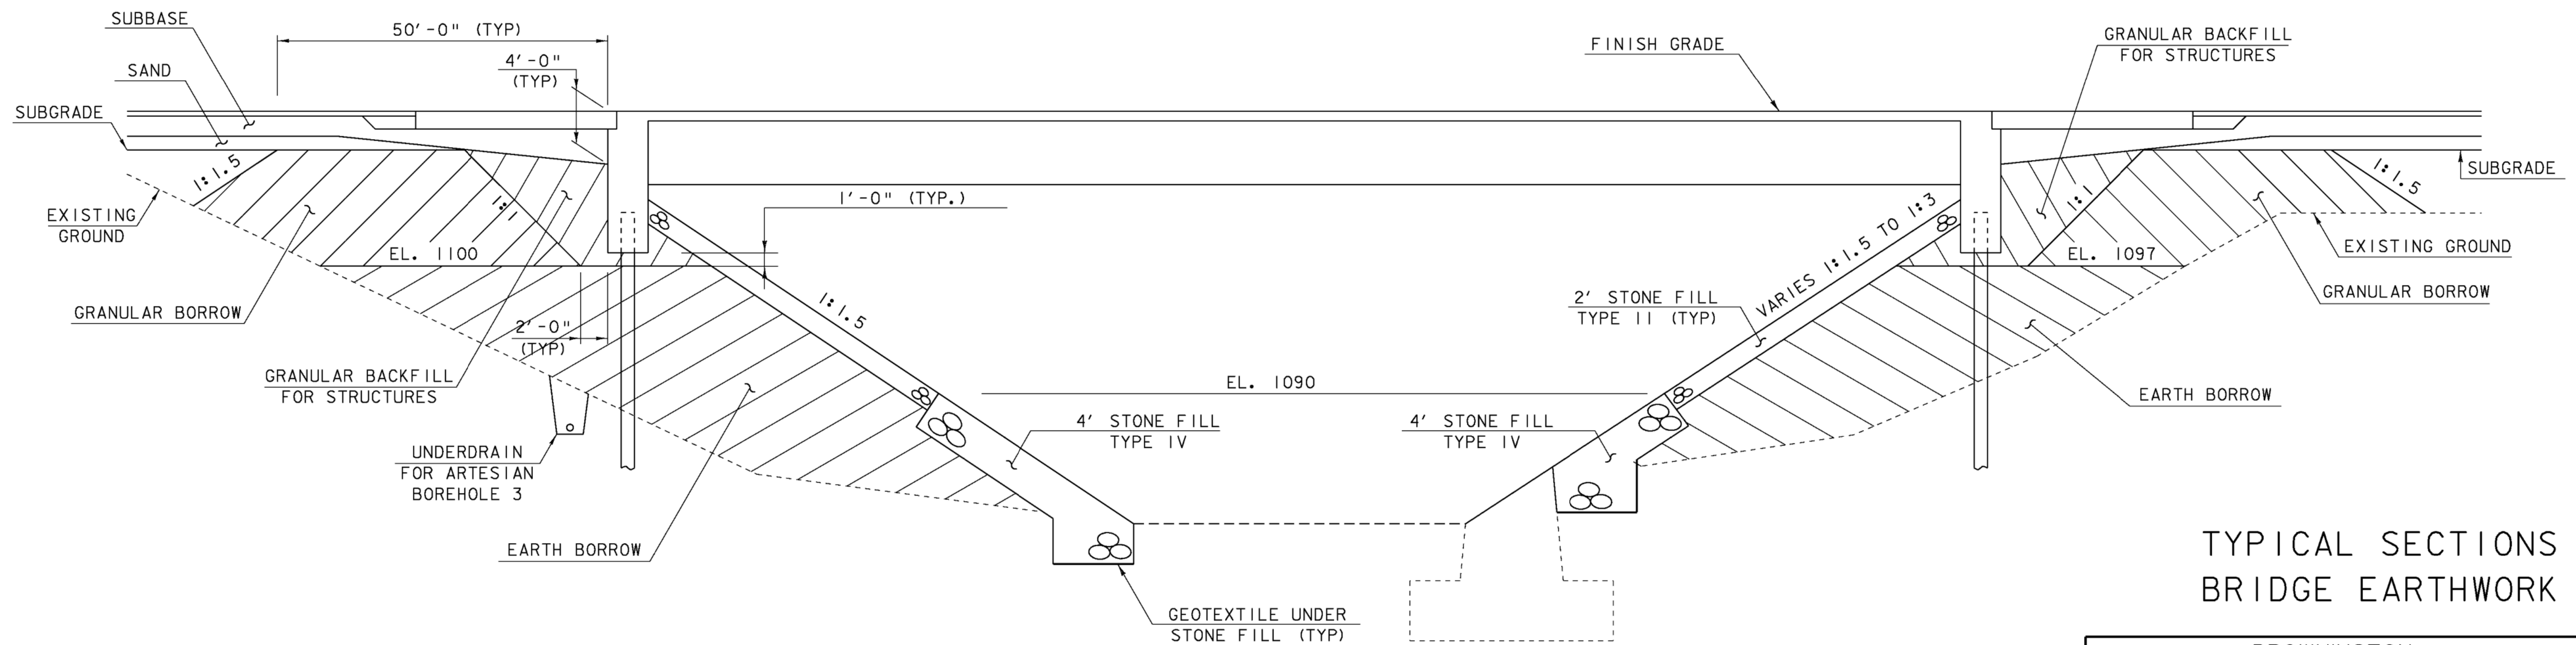

NEW ABUTMENT FILLS
(NOT TO SCALE)

TYPICAL SECTIONS
BRIDGE EARTHWORK

PROJECT NAME: BROWNINGTON
PROJECT NUMBER: BRO 1449 (28)

FILE NAME: sj246ty3.1
PROJECT MANAGER: R. WHITCOMB
DESIGNED BY: T. LACKEY
99j246/str/sj246typ.dgn

PLOT DATE: 19-DEC-2008
DRAWN BY: T. LACKEY
CHECKED BY: R. WHITCOMB
SHEET 6 OF 58