



Superelevation:

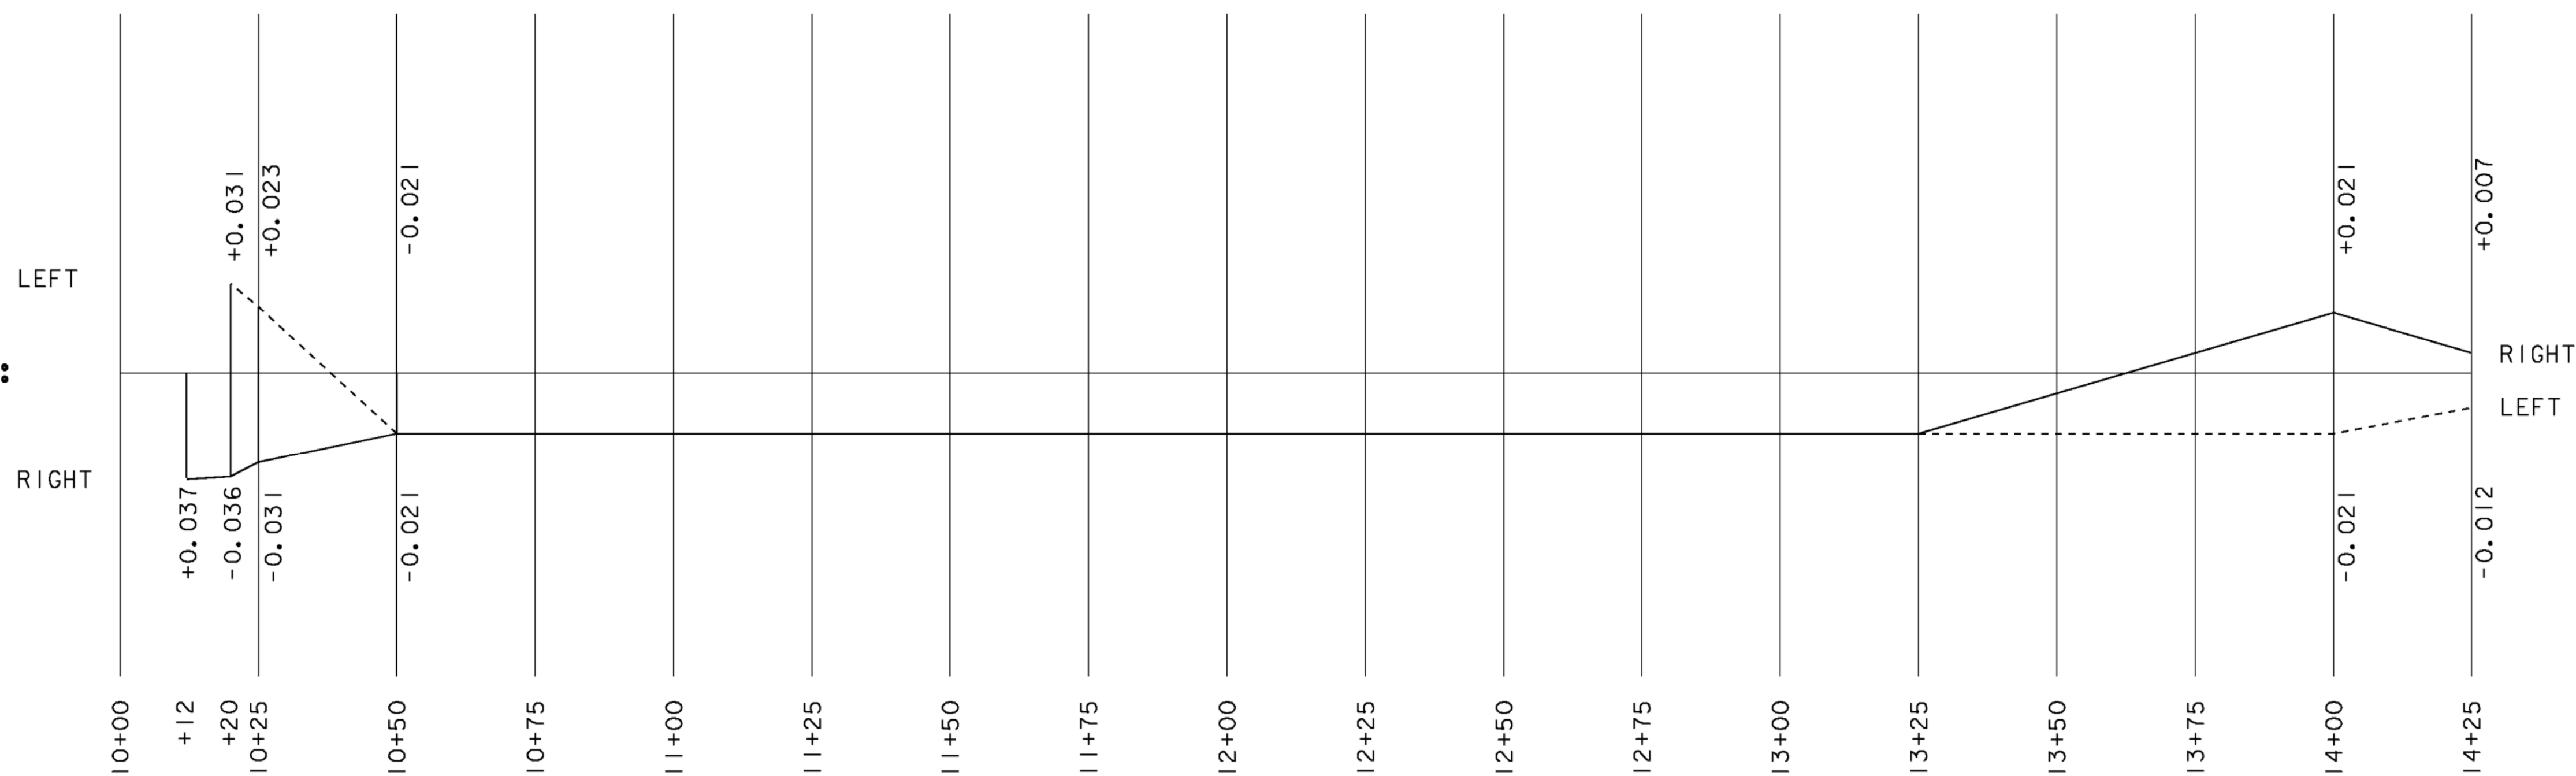


SUPERELEVATION

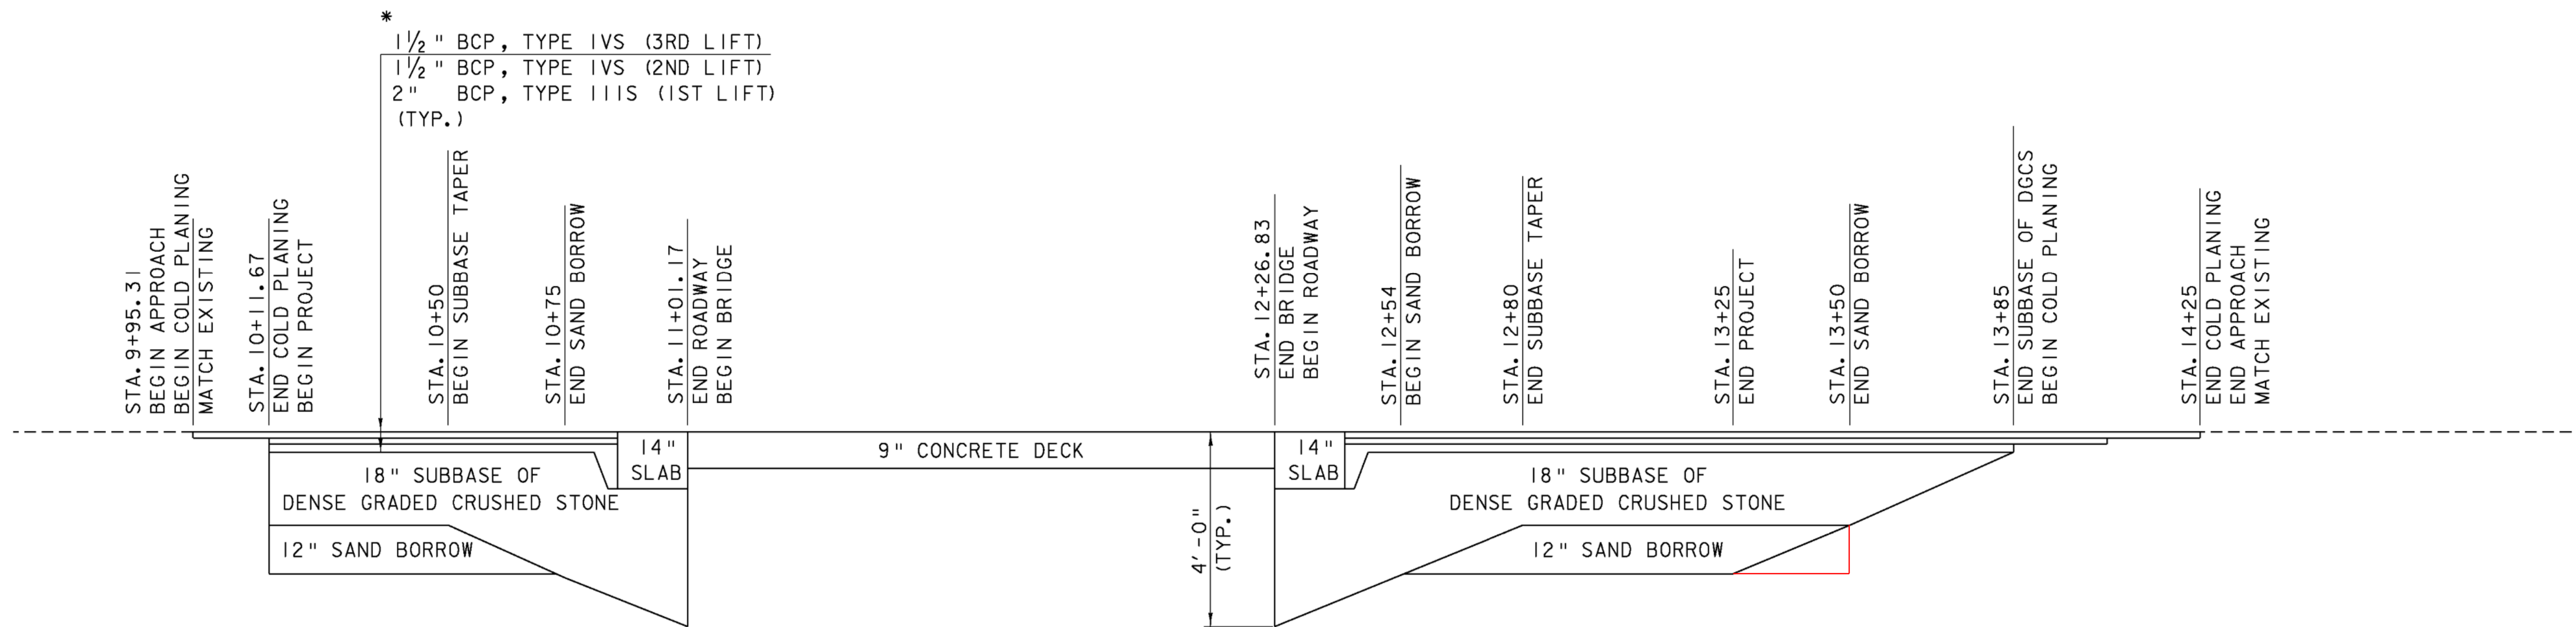

* BCP SHALL BE READ AS BITUMINOUS CONCRETE PAVEMENT AND SHALL BE PAID FOR UNDER SPECIAL PROVISION BITUMINOUS CONCRETE PAVEMENT, SMALL QUANTITY)

MATERIAL TRANSITION DETAIL

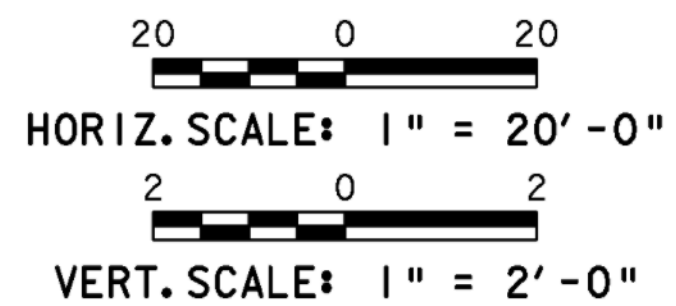

MAINLINE SUPERELEVATION & MATERIAL TRANSITION

PROJECT NAME: BROWNINGTON
 PROJECT NUMBER: BRO 1449 (28)

FILE NAME: sj246pf2.1
 PROJECT MANAGER: R. WHITCOMB
 DESIGNED BY: T. LACKEY
 99J246/str/sj246xs.dgn

PLOT DATE: 19-DEC-2008
 DRAWN BY: T. LACKEY
 CHECKED BY: R. WHITCOMB
 SHEET 15 OF 58