



ABUTMENT NO. 1 ELEVATION

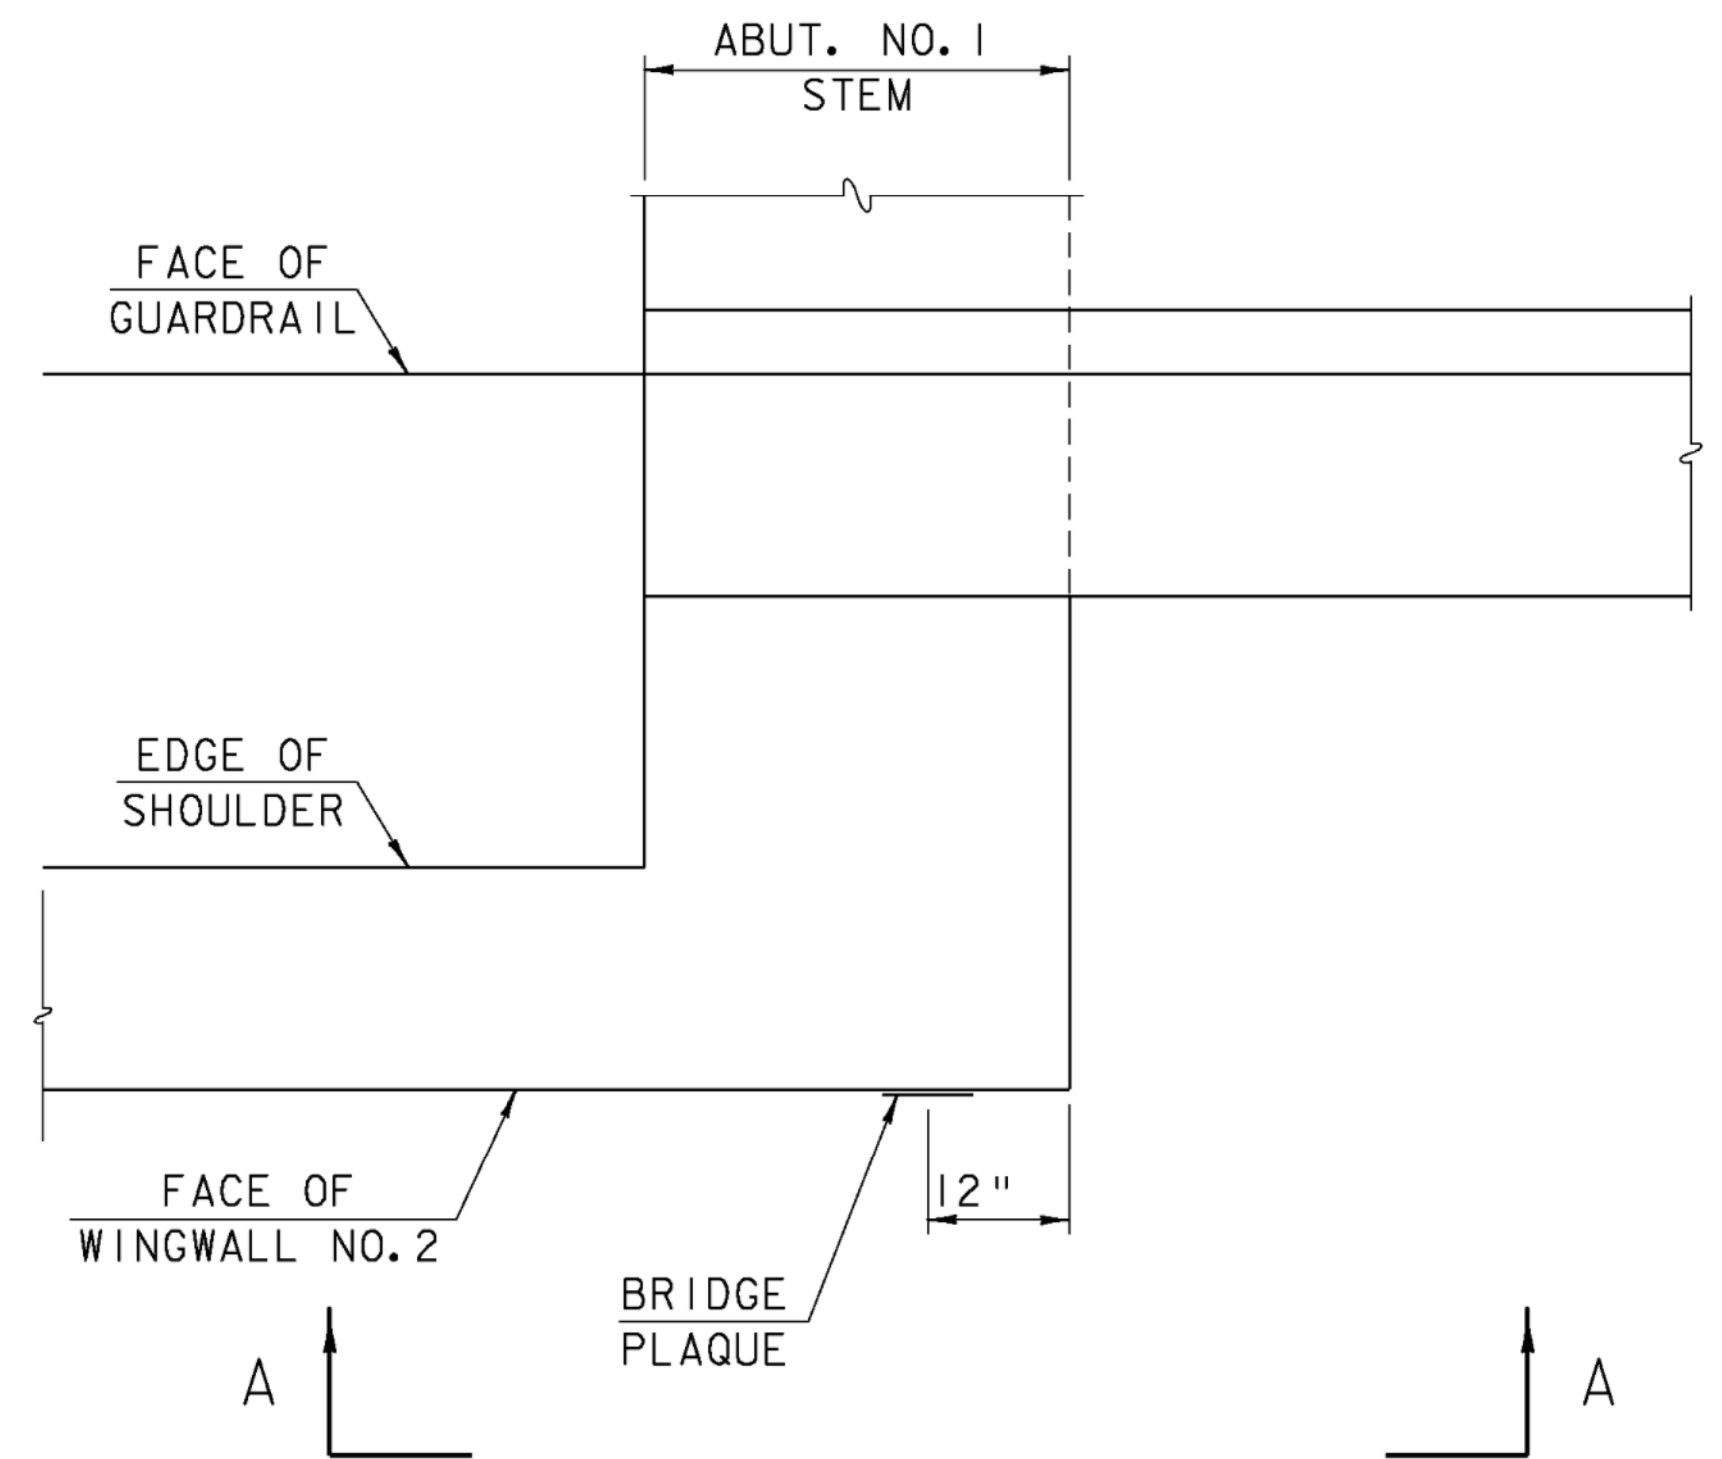

BRIDGE PLAQUE PLAN

NOT TO SCALE

GIRDER SEAT ELEVATIONS TOP OF LEVELING PLATES	
GIRDER 1	1105.91
GIRDER 2	1106.04
GIRDER 3	1106.04
GIRDER 4	1105.91

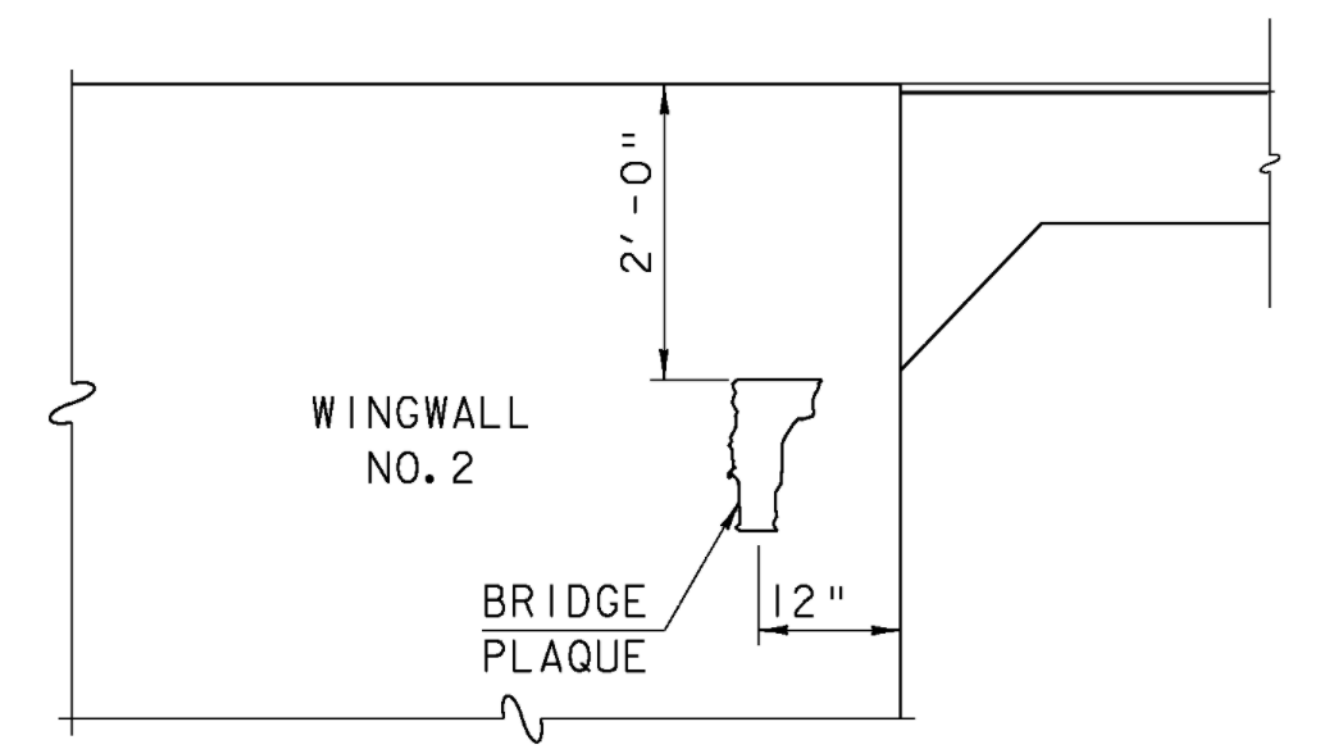


BRIDGE PLAQUE VIEW "A-A"

NOT TO SCALE


BRIDGE PLAQUE NOTES

1. VTRANS WILL SUPPLY THE BRIDGE PLAQUE.
2. INSTALL THE PLAQUE AS SHOWN OR AS DIRECTED BY THE ENGINEER.
3. INCLUDE PAYMENT FOR INSTALLATION IN ITEM 900.608, SPECIAL PROVISION (HIGH PERFORMANCE CONCRETE, CLASS A LOW CEMENT).

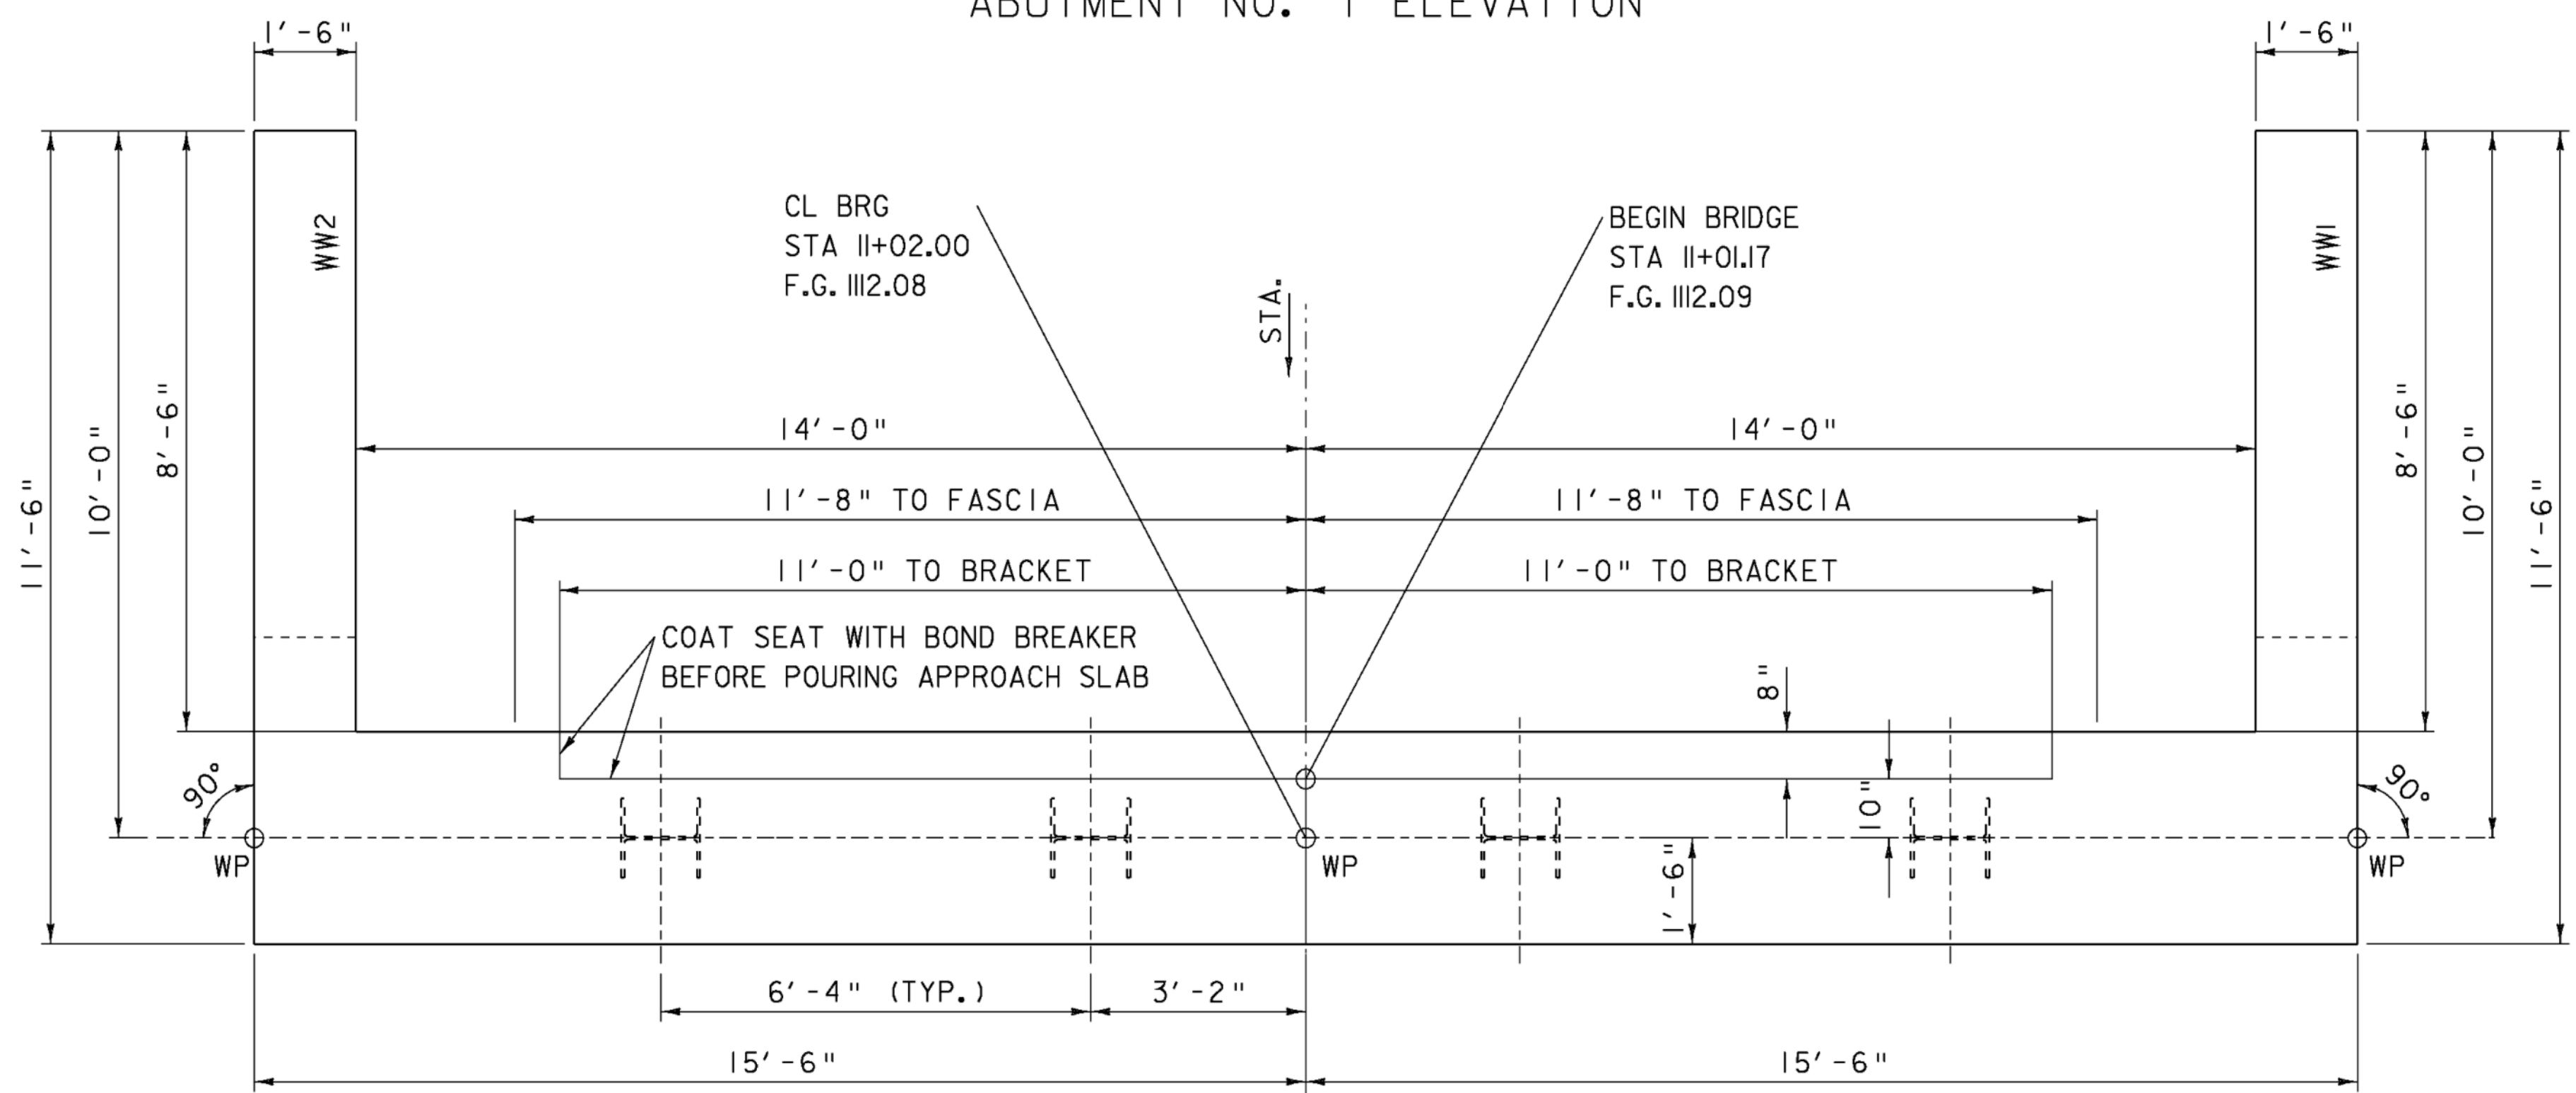

ABUTMENT NO. 1 PLAN

SCALE 1/2" = 12"

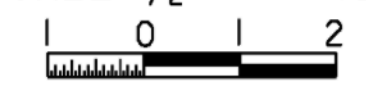

NOTE:

NF = NEAR FACE  
 FF = FAR FACE  
 EF = EACH FACE  
 ▲ = CUT TO FIT IN FIELD  
 3" COVER UNLESS OTHERWISE SPECIFIED ON THE PLANS.  
 2'-2" BAR LAP UNLESS OTHERWISE SPECIFIED ON THE PLANS.

SUBSTRUCTURE ABUTMENT 1

PROJECT NAME:	BROWNINGTON	PLOT DATE:	19-DEC-2008
PROJECT NUMBER:	BRO 1449 (28)	DRAWN BY:	C.MOONEY
FILE NAME:	sj246s07.1	DESIGNED BY:	T. LACKEY
PROJECT LEADER:	R. WHITCOMB	CHECKED BY:	R. WHITCOMB
99J246/str/sj246str.dgn		SHEET	38 OF 58