



11+75


F.G. = 1111.12

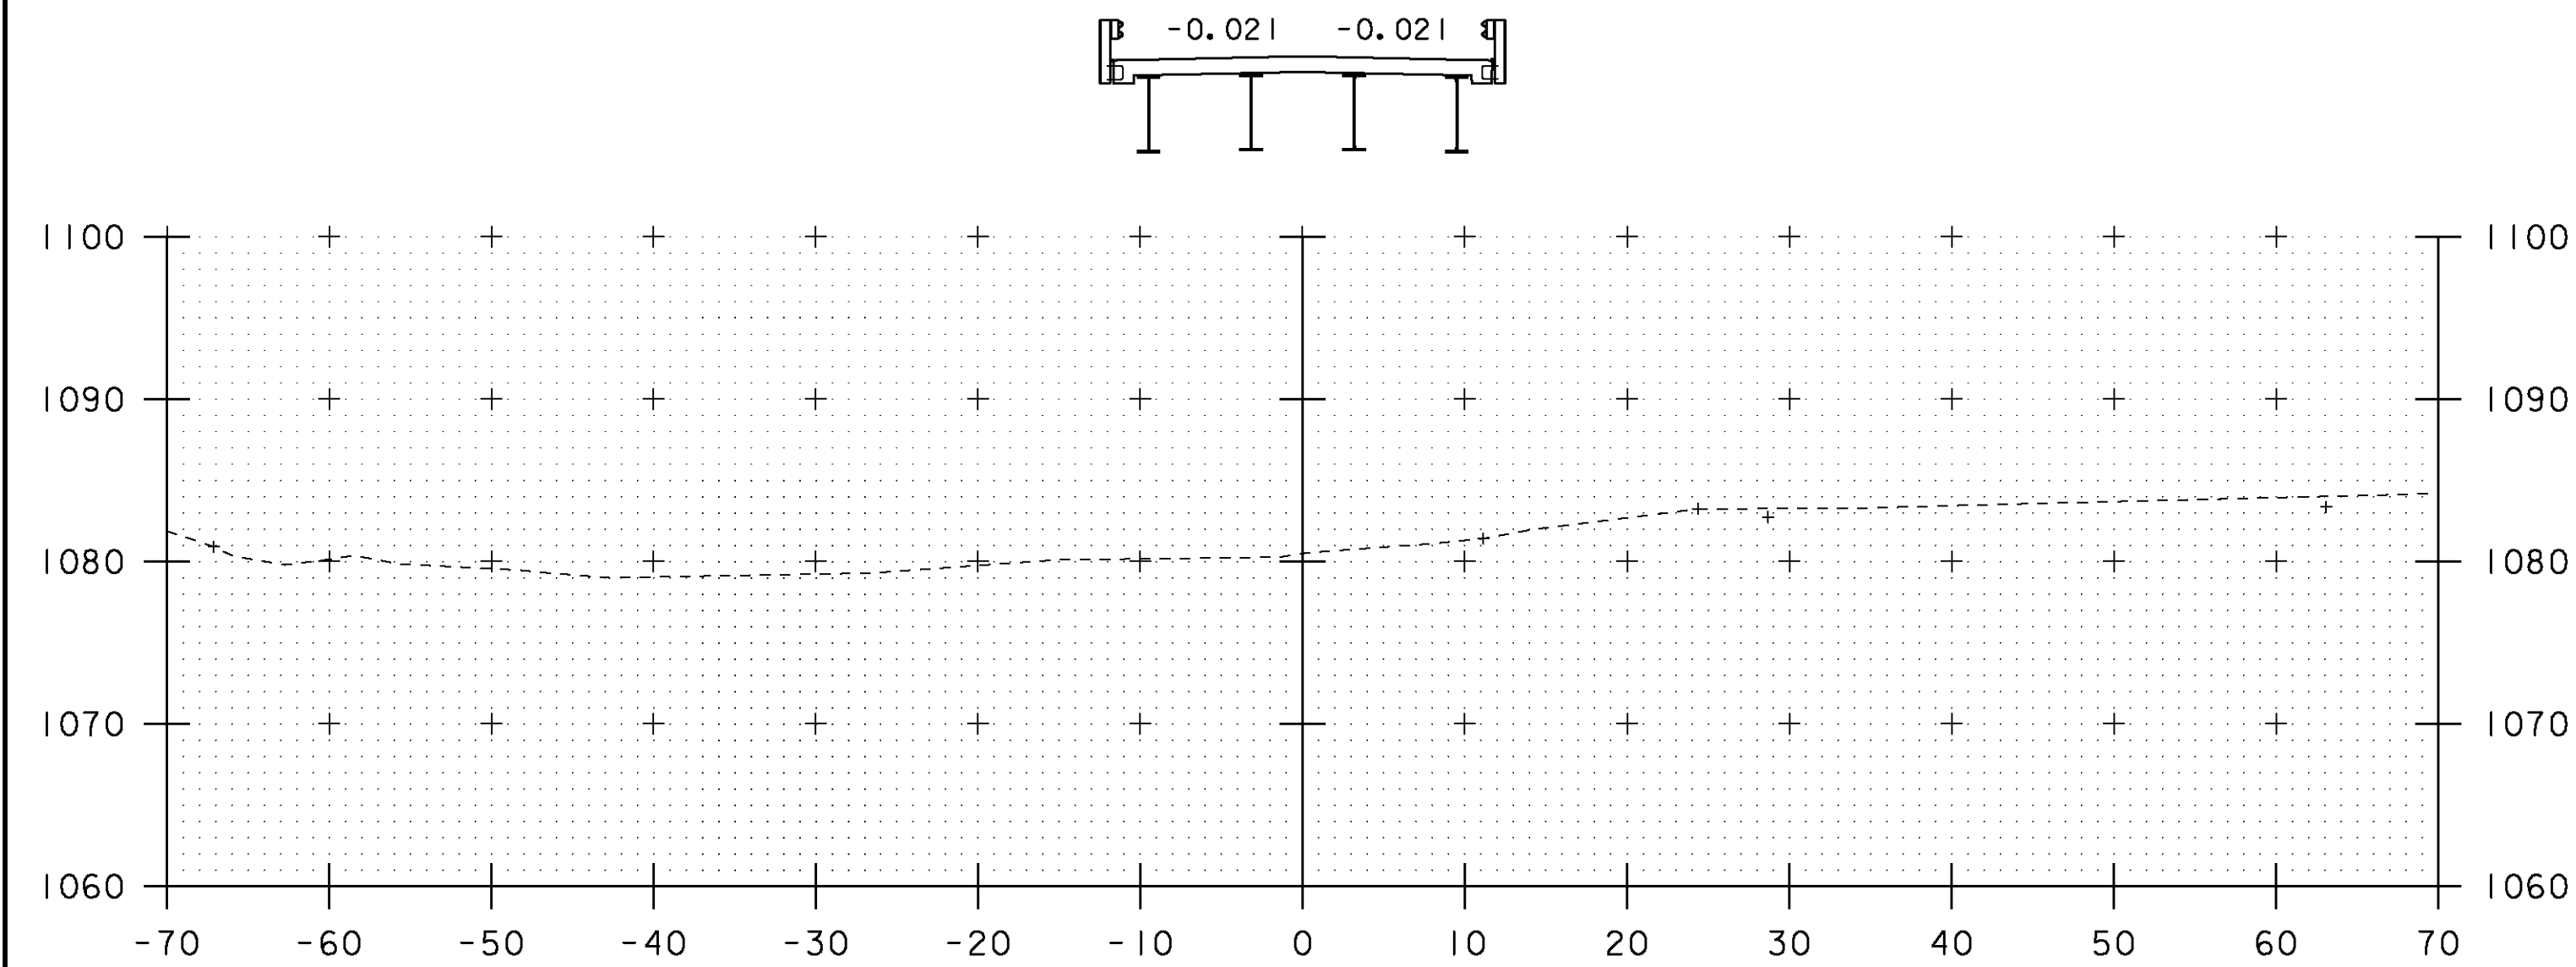


11+50

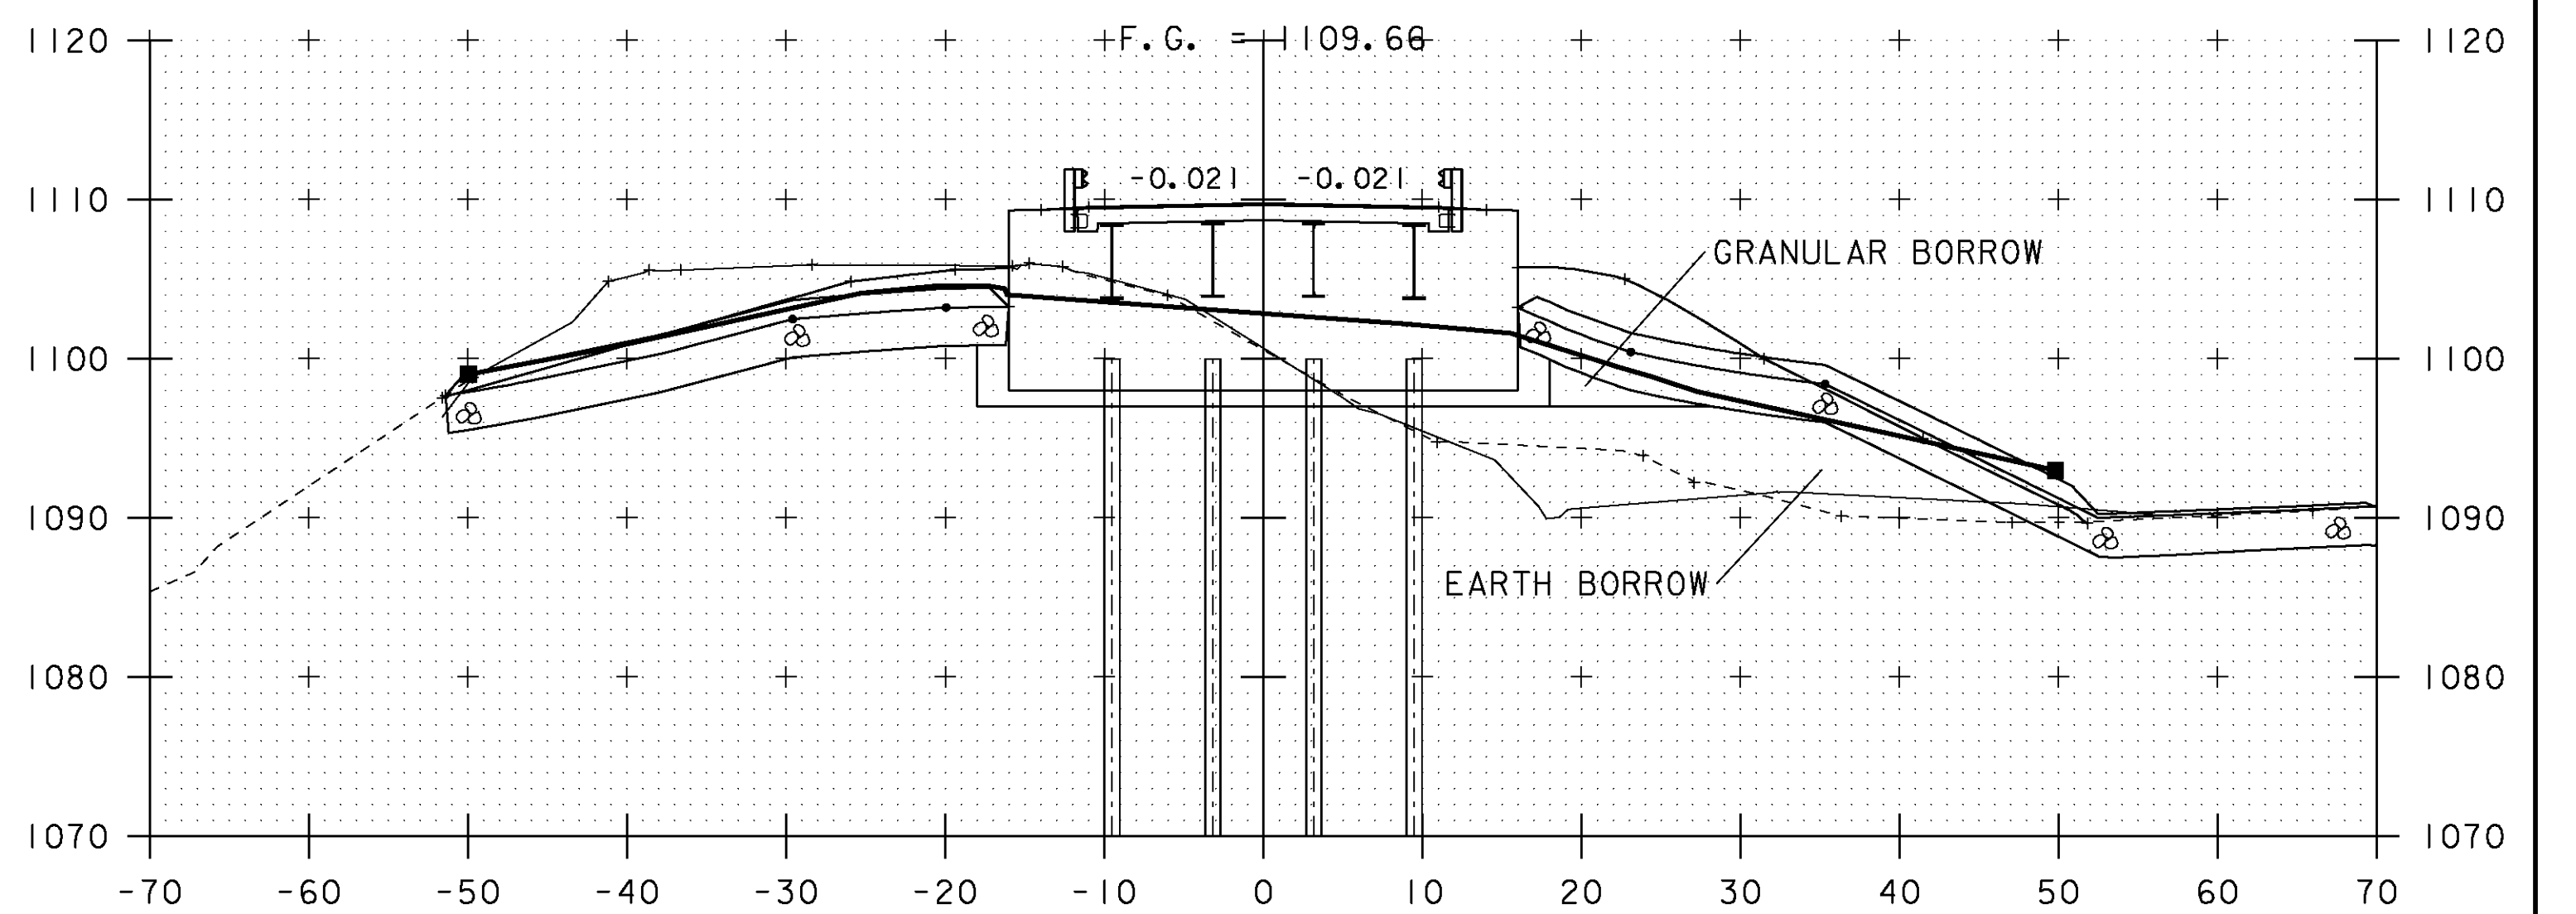

12+25

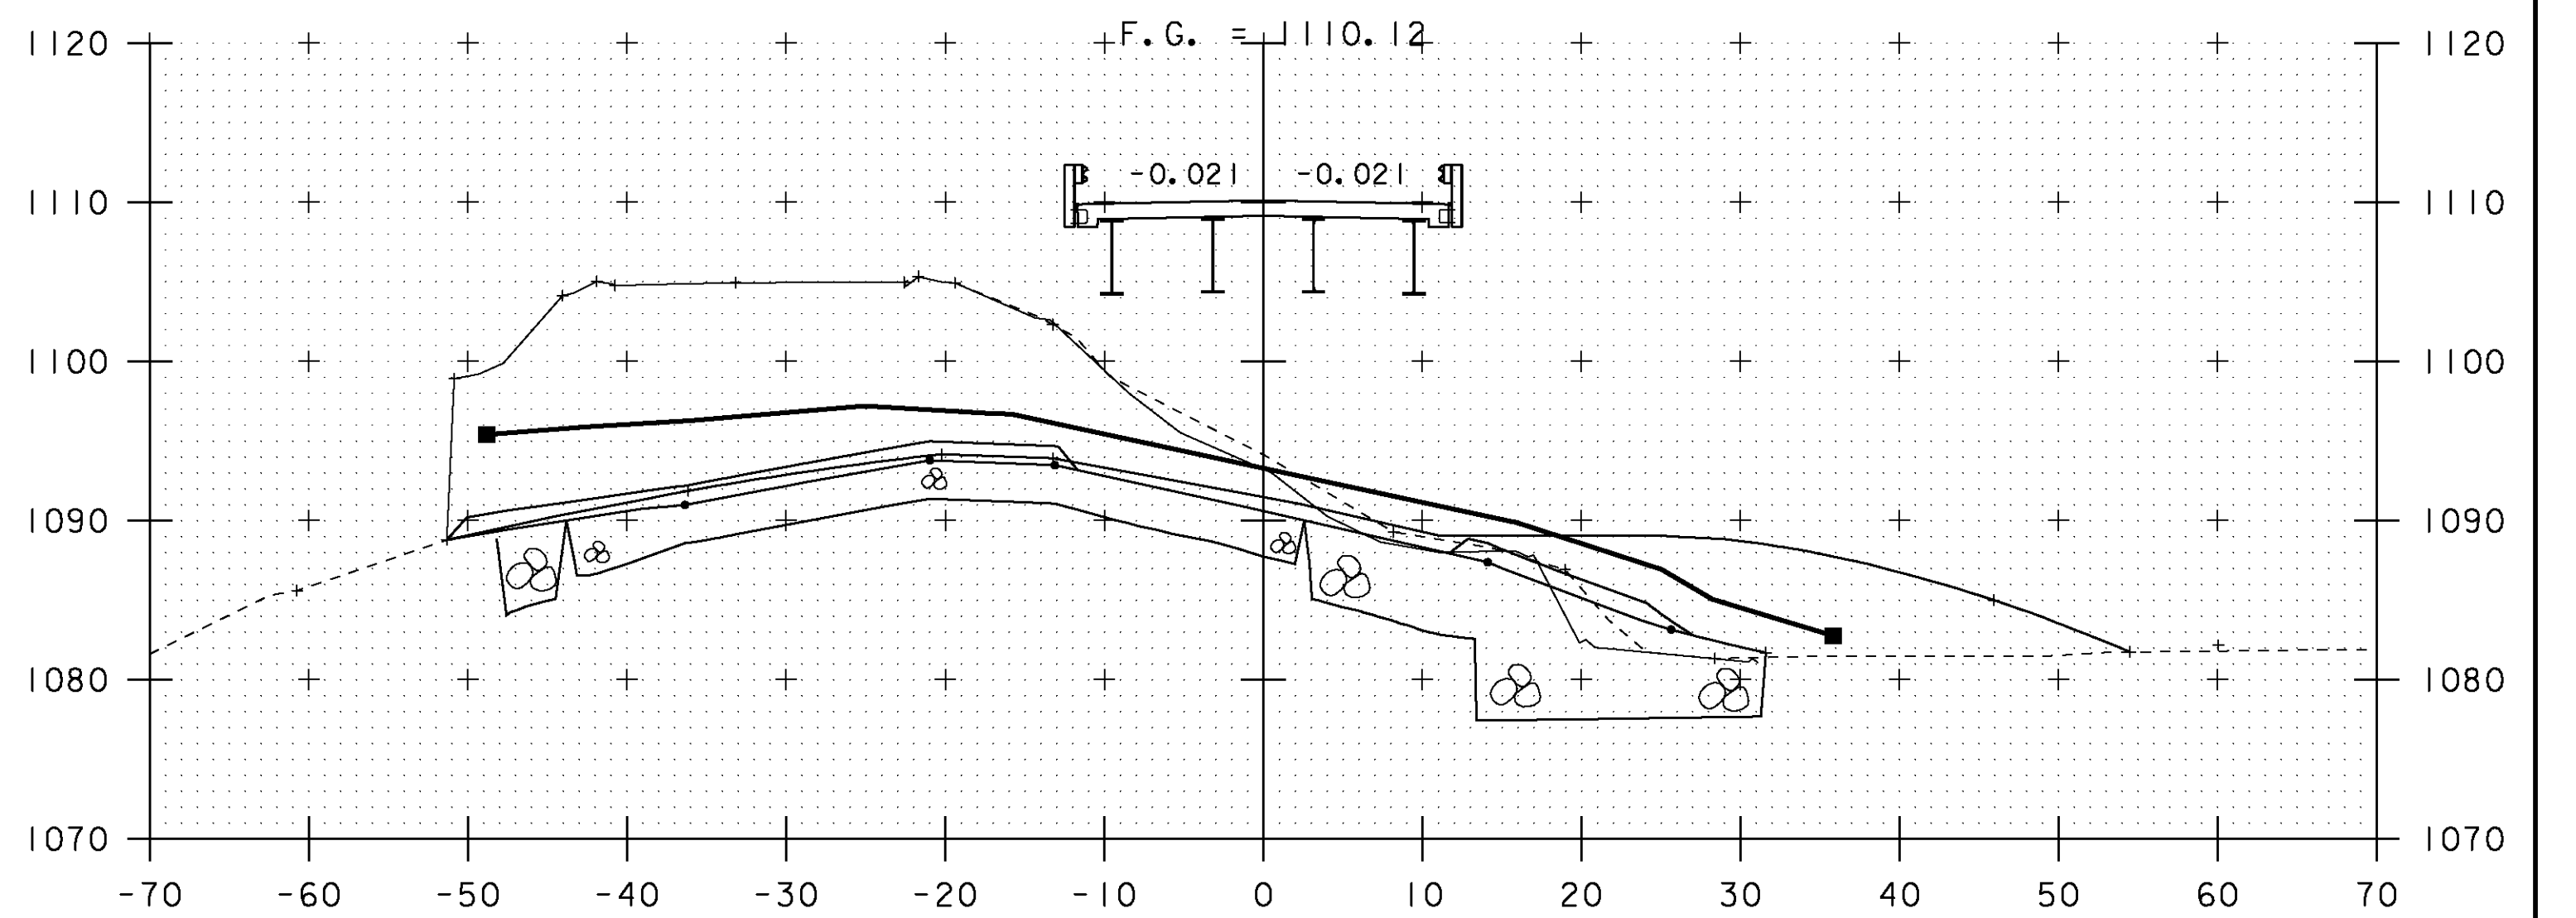

12+00

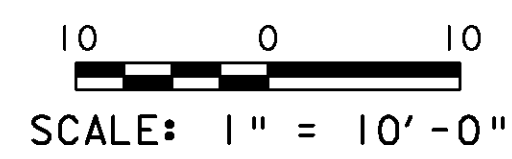

STA. 11+50 TO STA. 12+25

PROJECT NAME: BROWNINGTON	PROJECT NUMBER: BRO 1449 (28)
FILE NAME: sj246final	PLOT DATE: 23-FEB-2010
PROJECT LEADER: C. MOONEY	DRAWN BY: C. MOONEY
DESIGNED BY: T. LACKEY	CHECKED BY: -----
ROADWAY SECTIONS - 3	SHEET 3 OF 14