



12+27

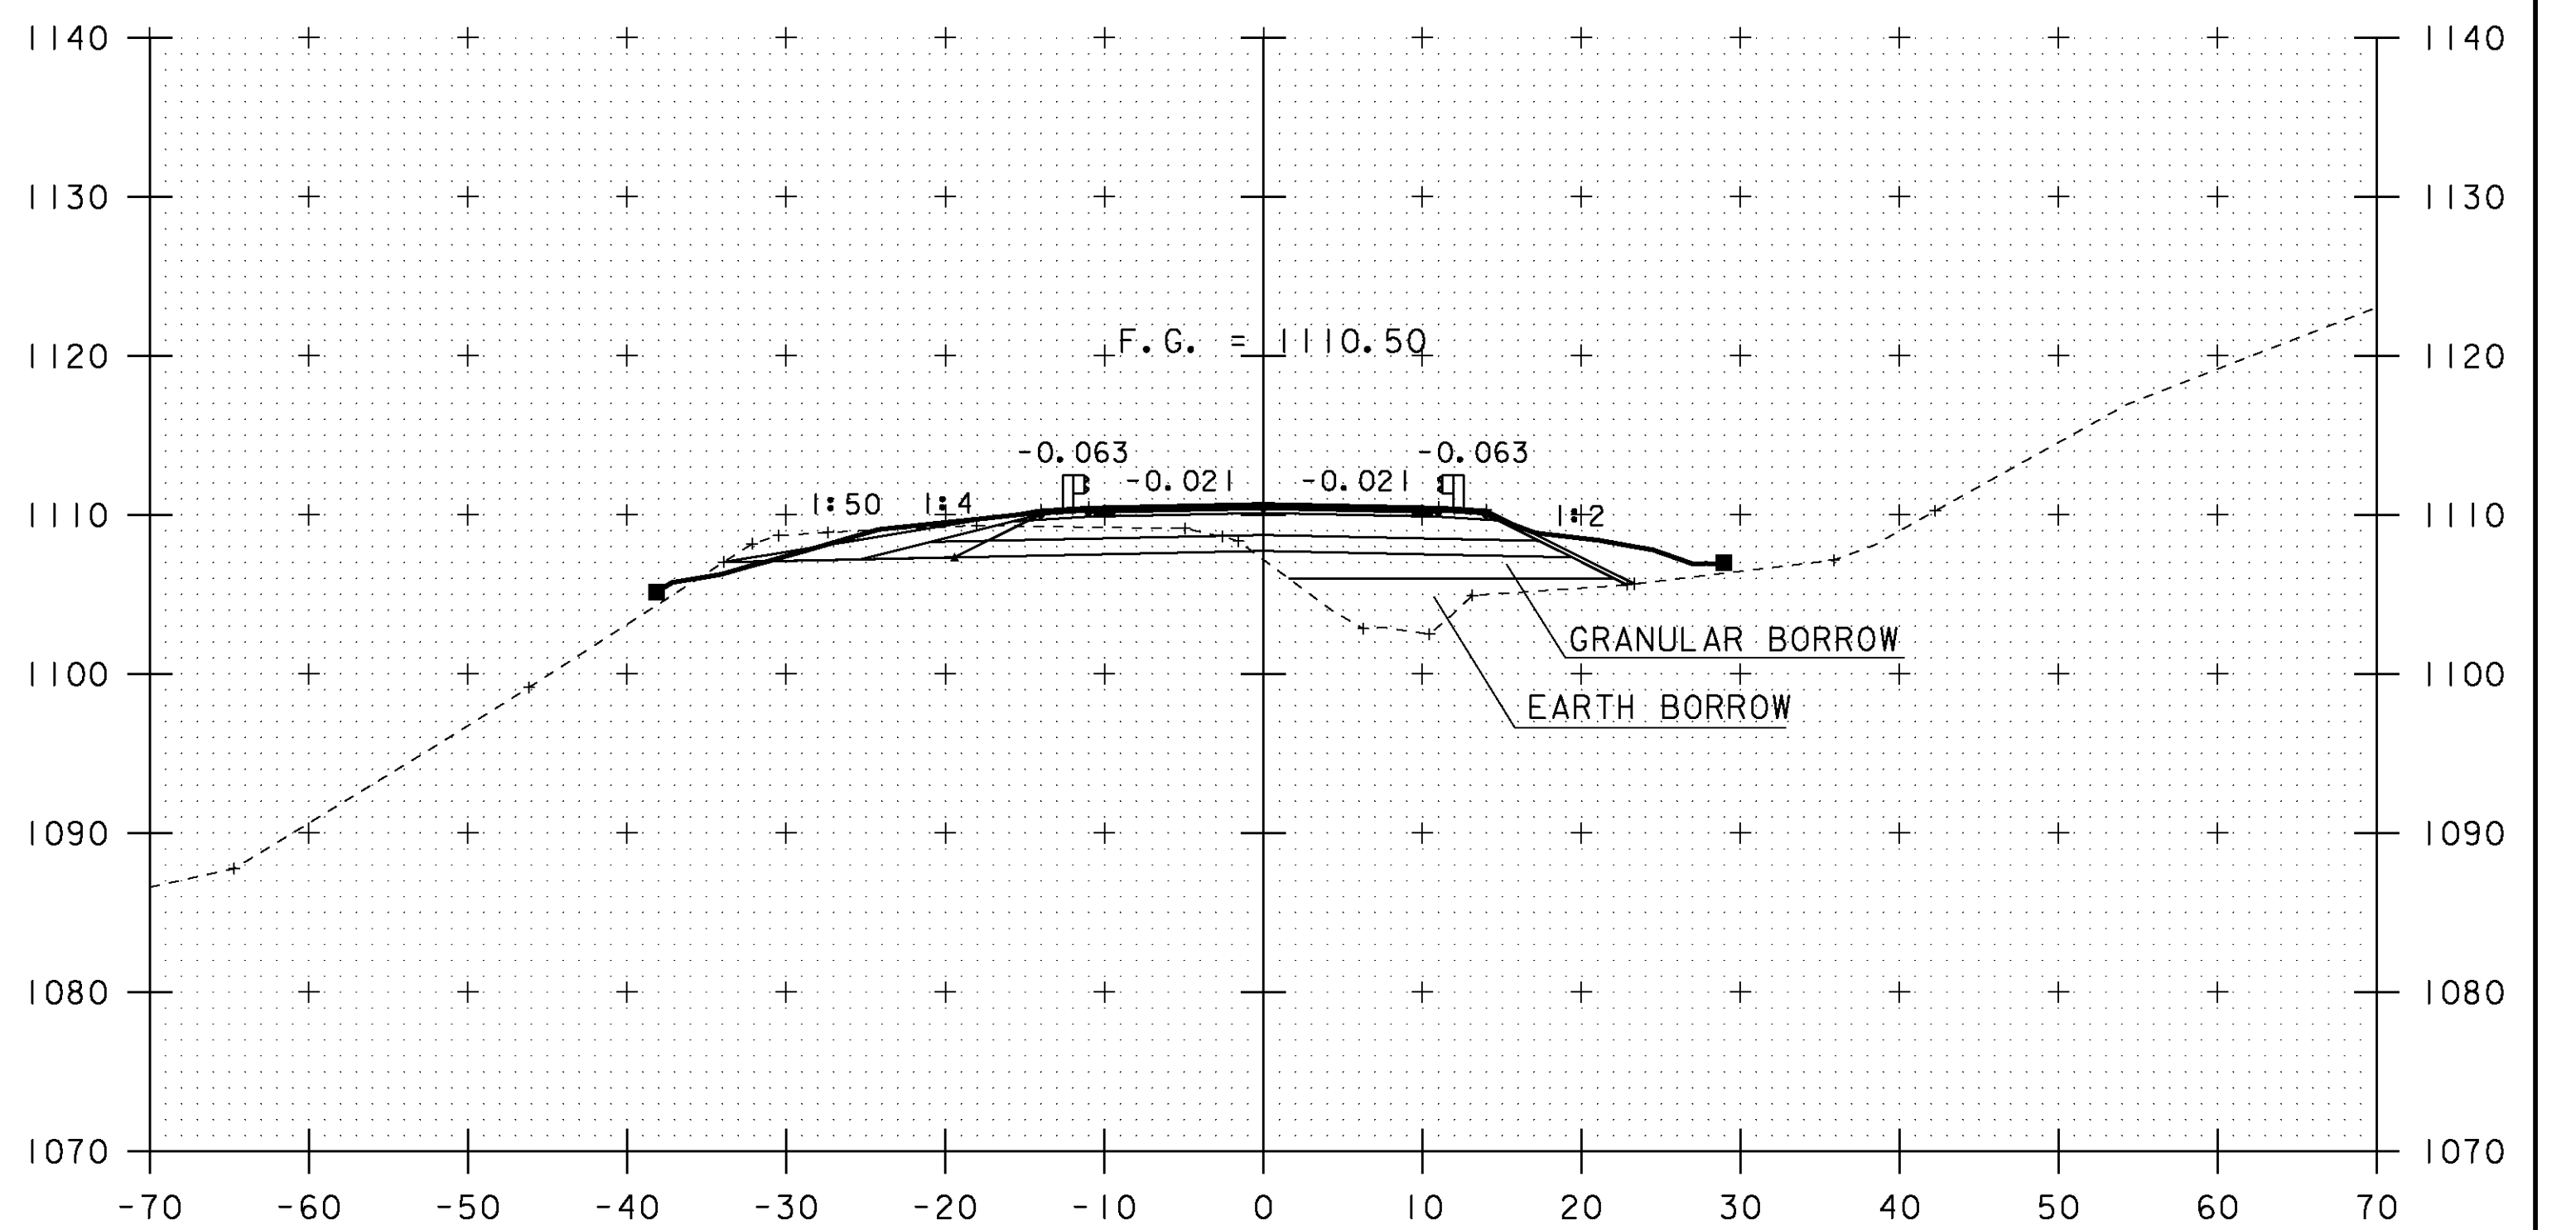


12+80

12+83 END GRANULAR BORROW

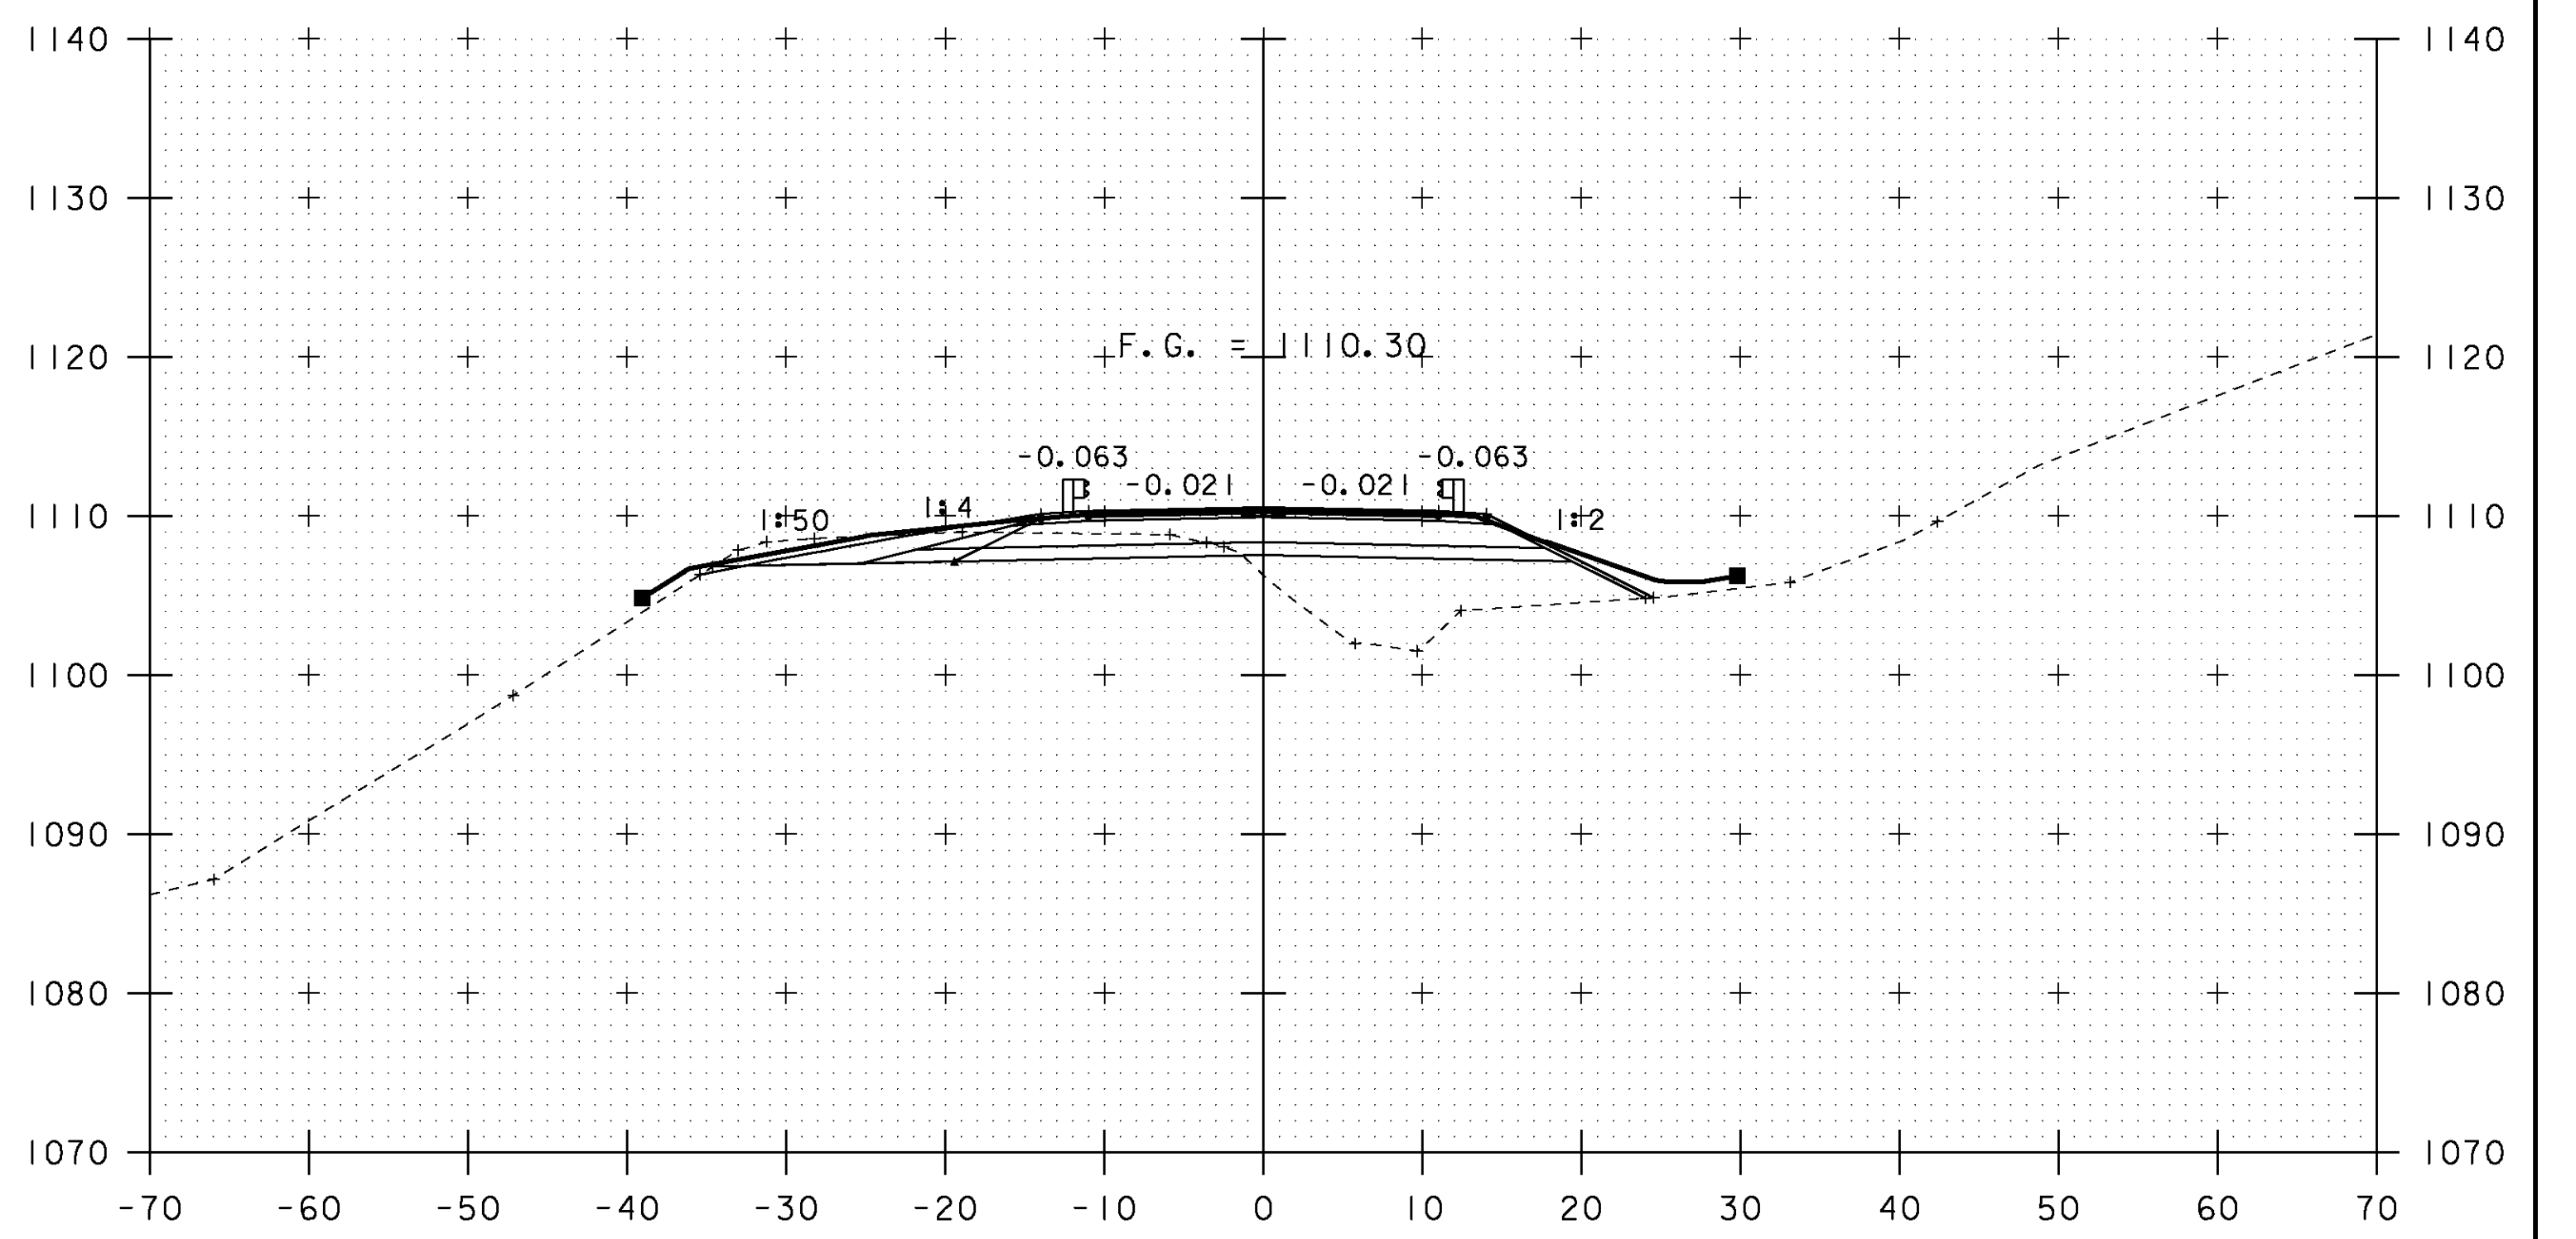

12+75

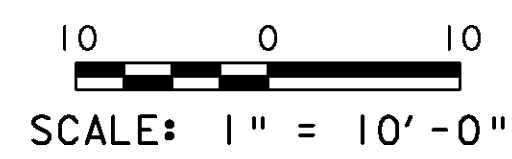

STA. 12+27 TO STA. 12+80

PROJECT NAME: BROWNINGTON	PLOT DATE: 23-FEB-2010
PROJECT NUMBER: BRO 1449 (28)	DRAWN BY: C. MOONEY
FILE NAME: sj246-final	DESIGNED BY: T. LACKEY
ROADWAY SECTIONS - 4	CHECKED BY: -----
	SHEET 4 OF 14