



13+25


13+25 END PROJECT

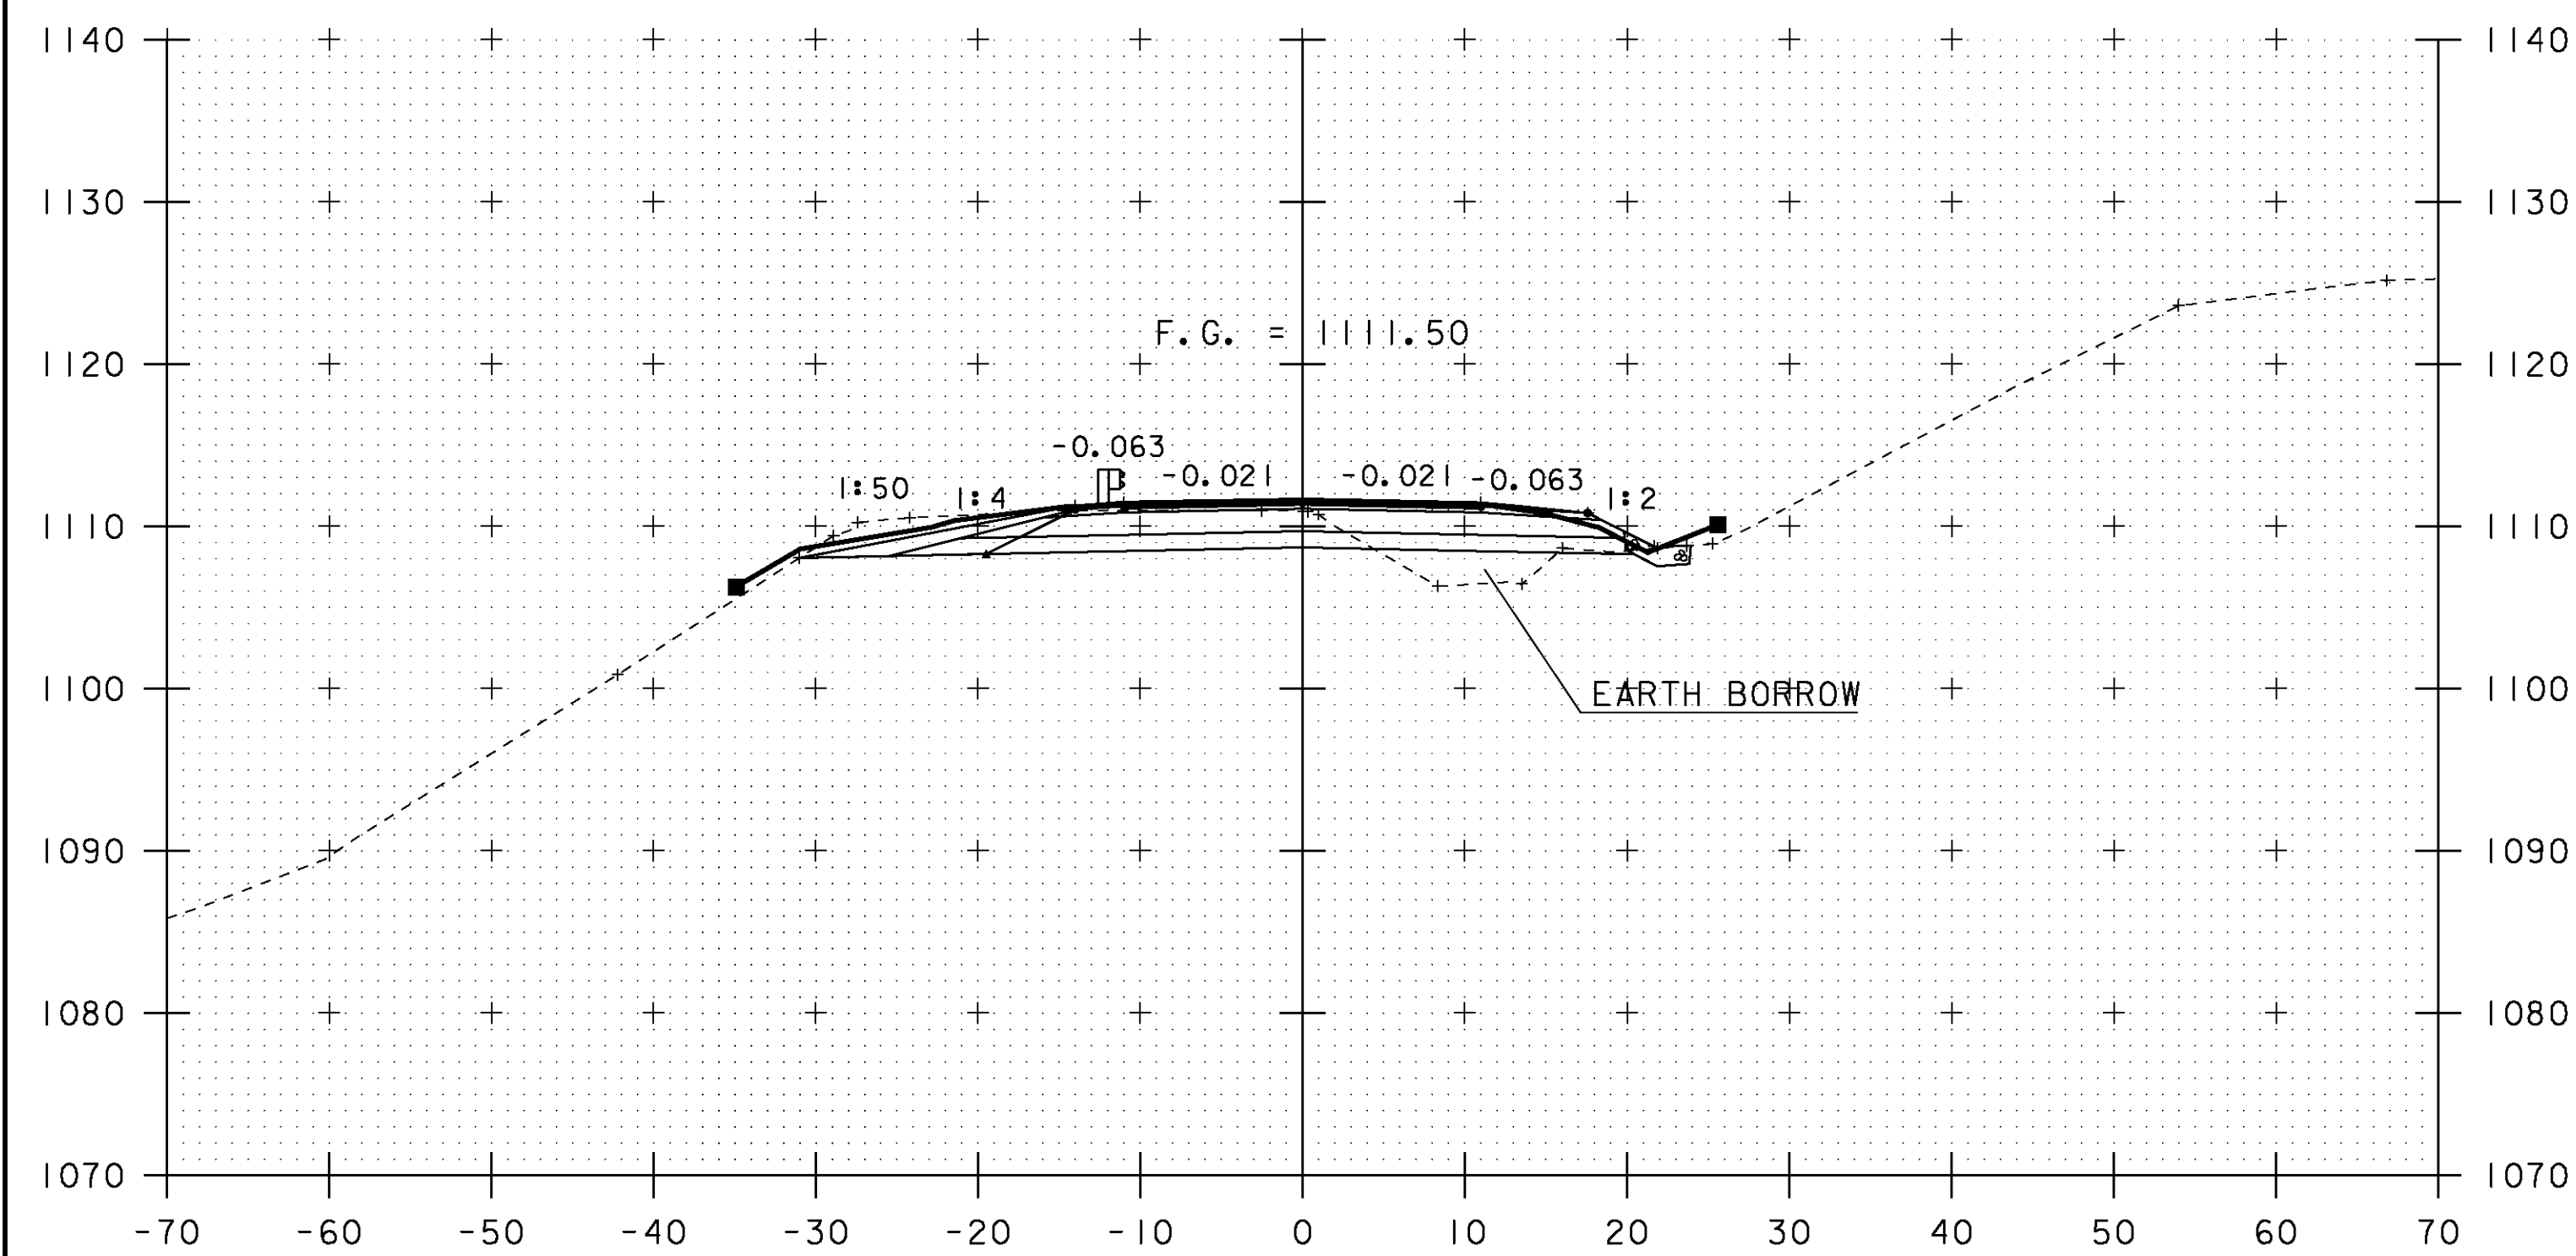


13+00

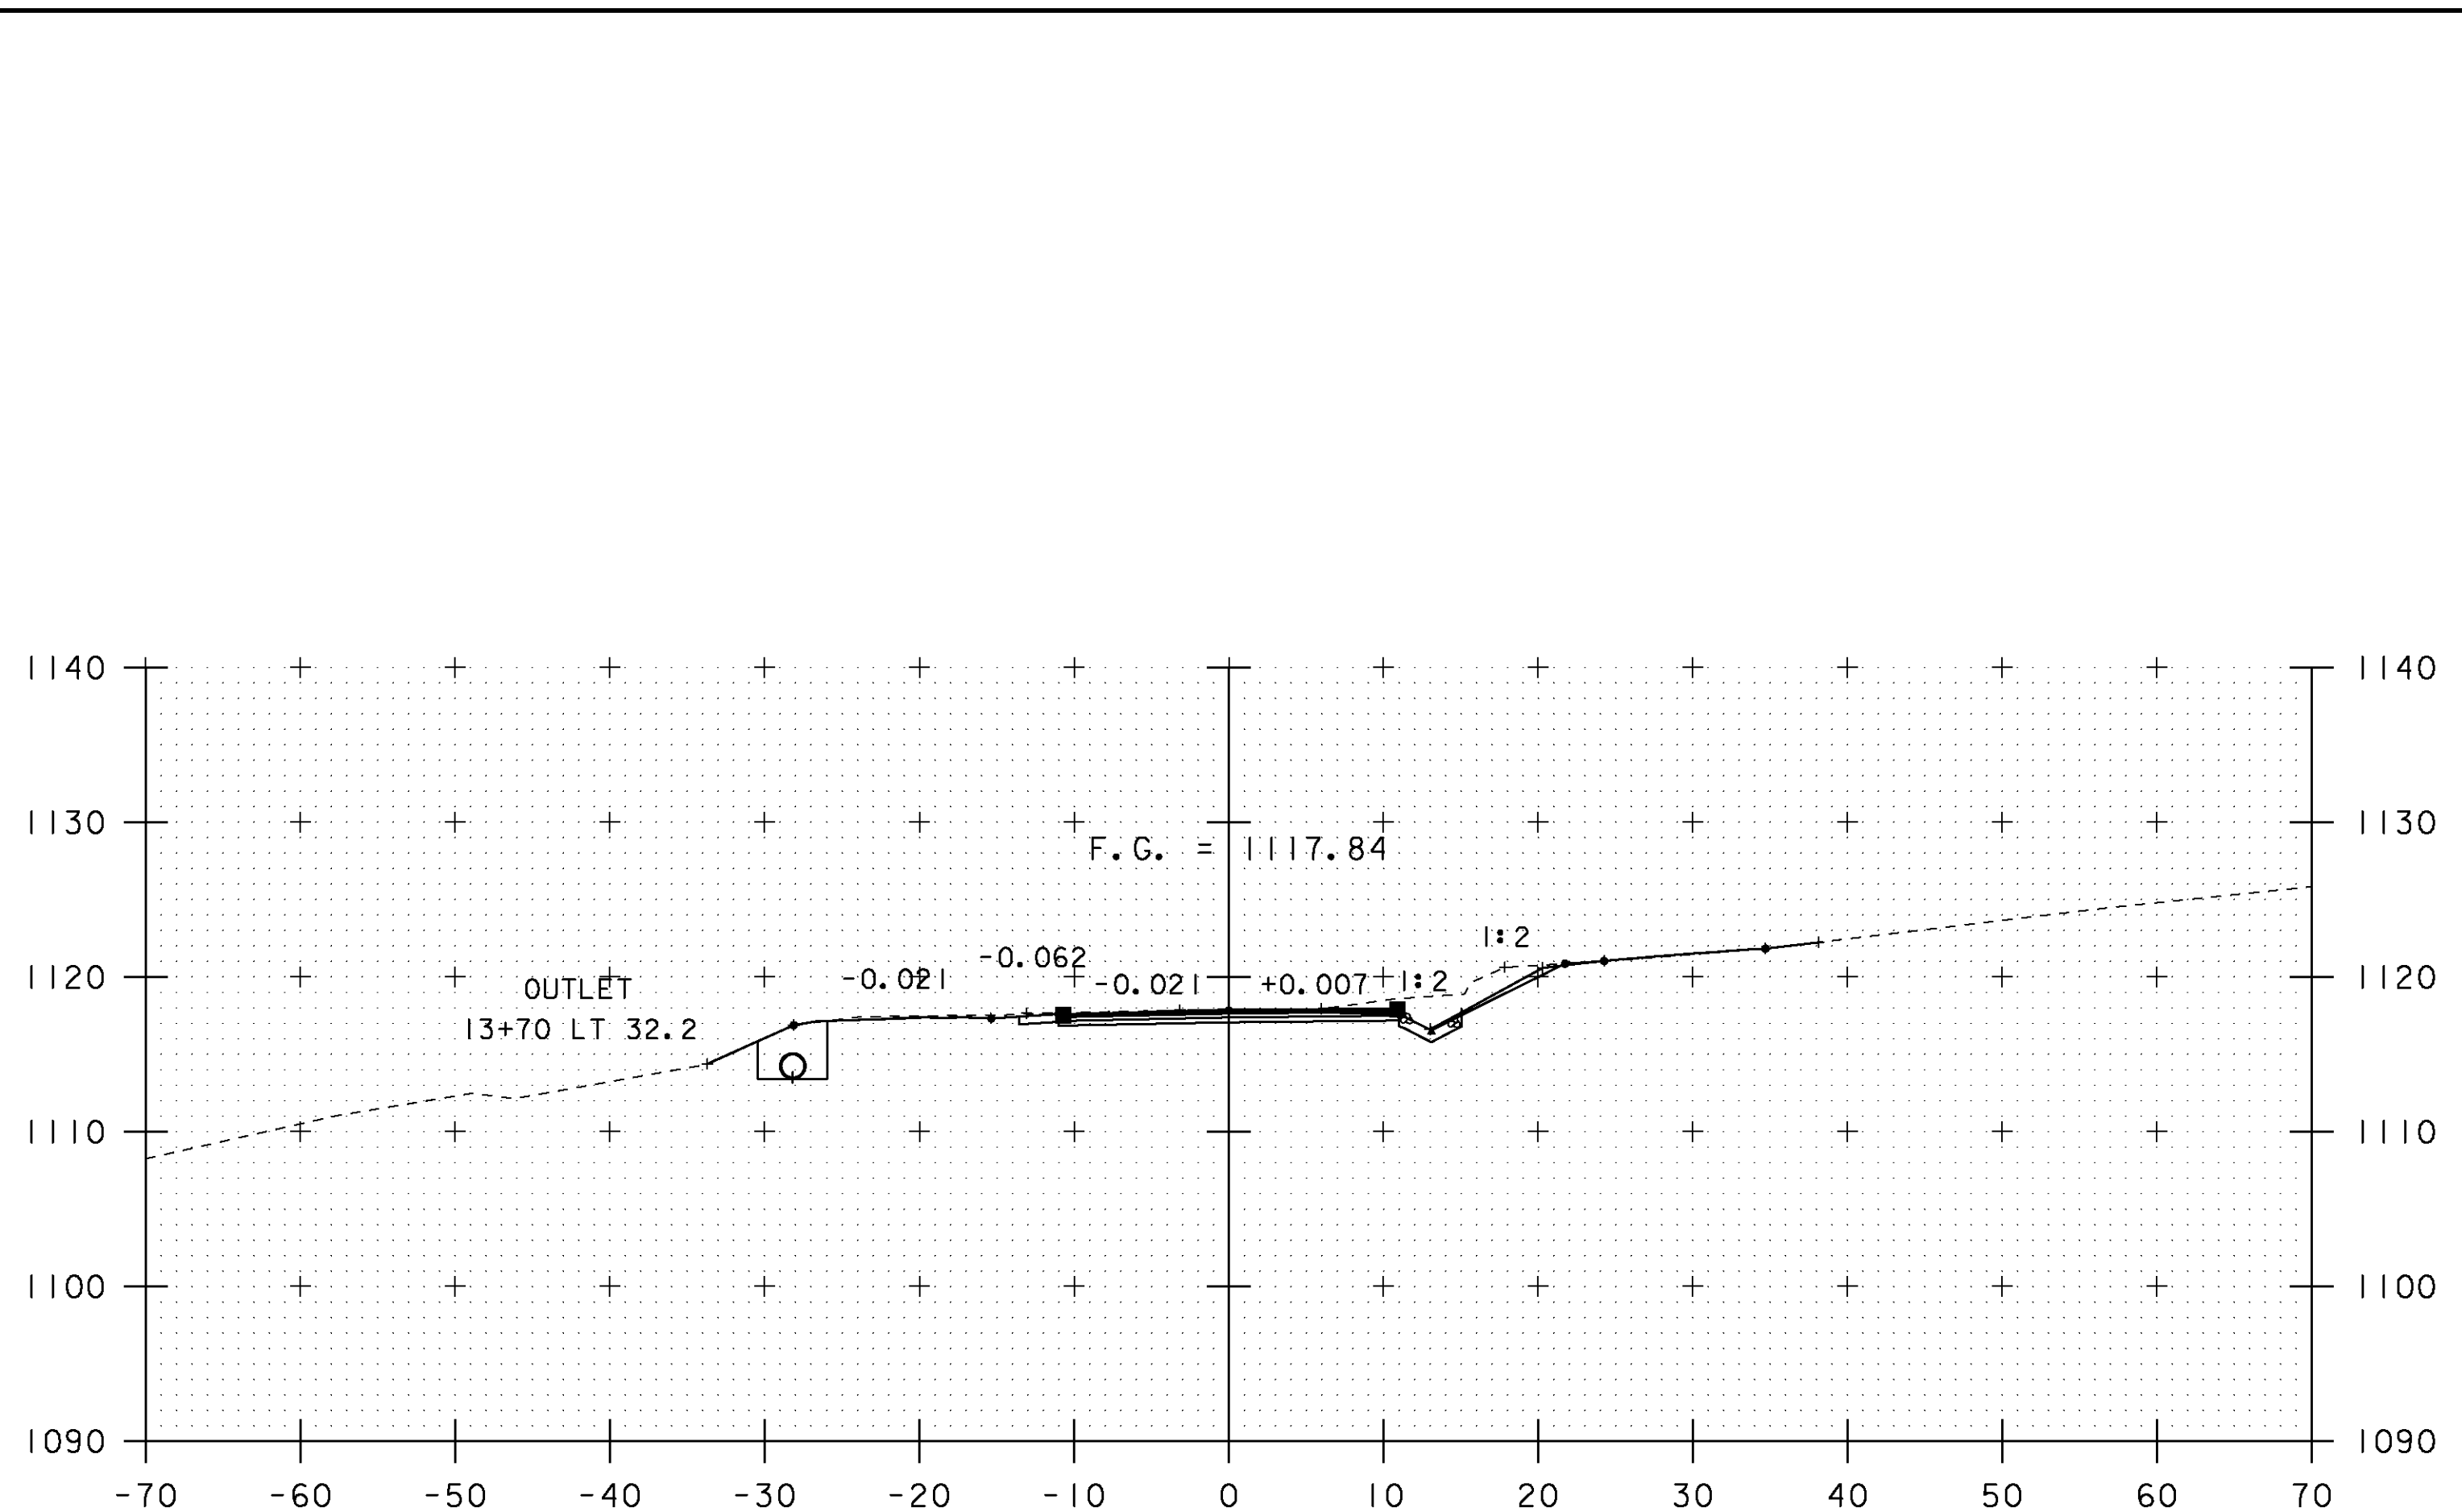

13+75

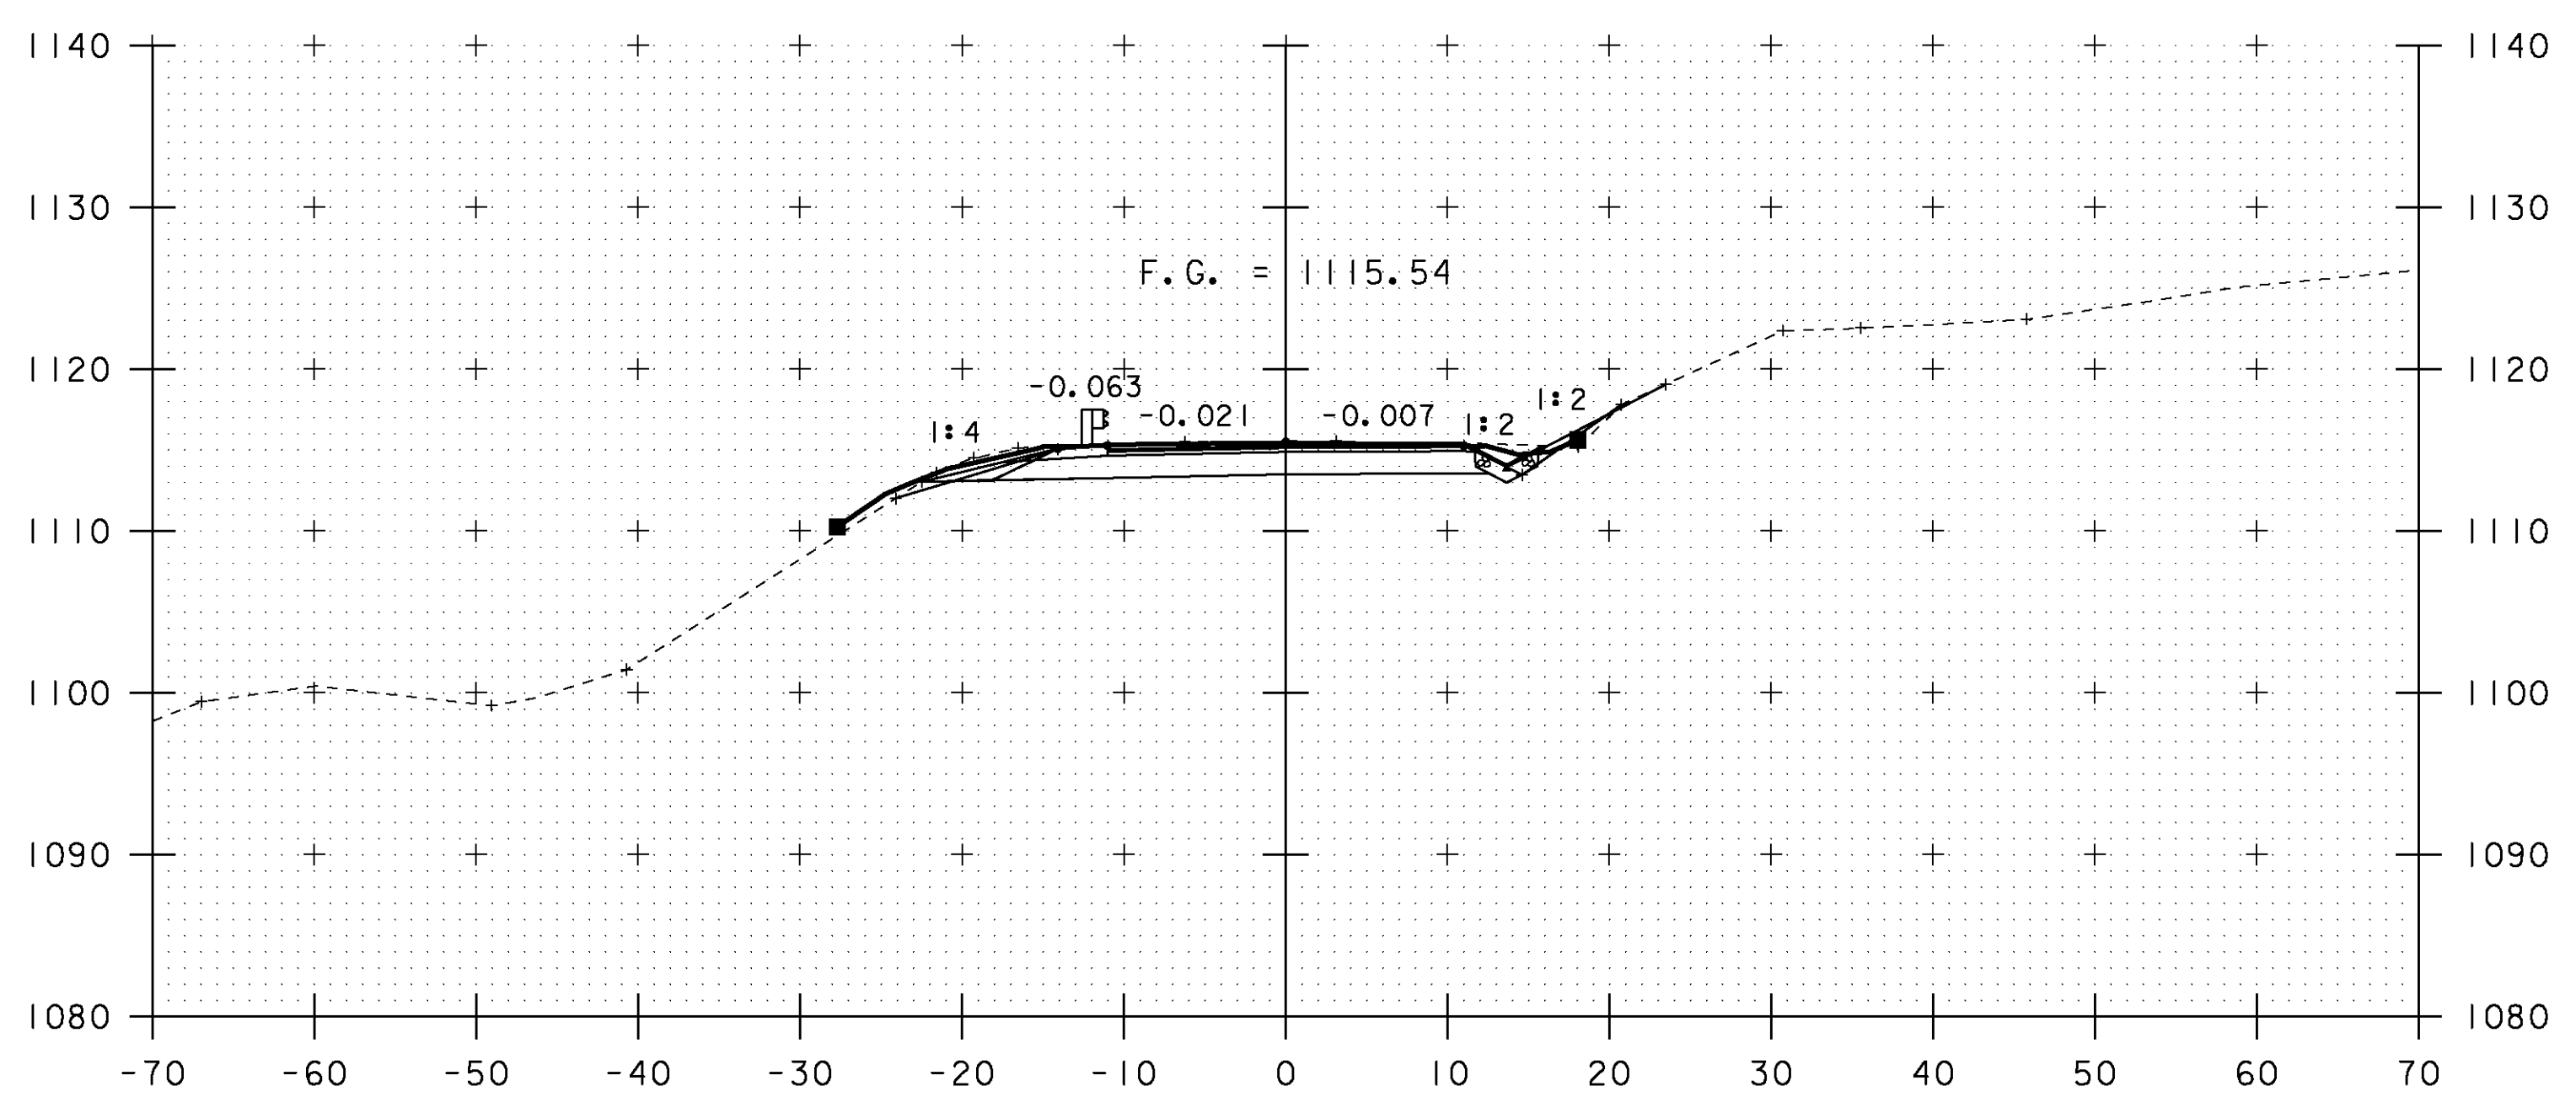

13+50

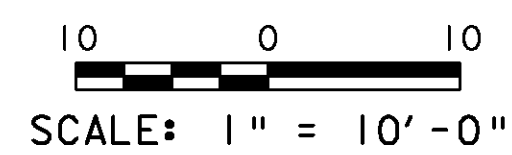

STA. 13+00 TO STA. 13+75

PROJECT NAME: BROWNINGTON	PLOT DATE: 23-FEB-2010
PROJECT NUMBER: BRO 1449 (28)	DRAWN BY: C. MOONEY
FILE NAME: sj246-final	CHECKED BY: -----
PROJECT LEADER: C. MOONEY	SHEET 5 OF 14
DESIGNED BY: T. LACKEY	
ROADWAY SECTIONS - 5	