



14+28

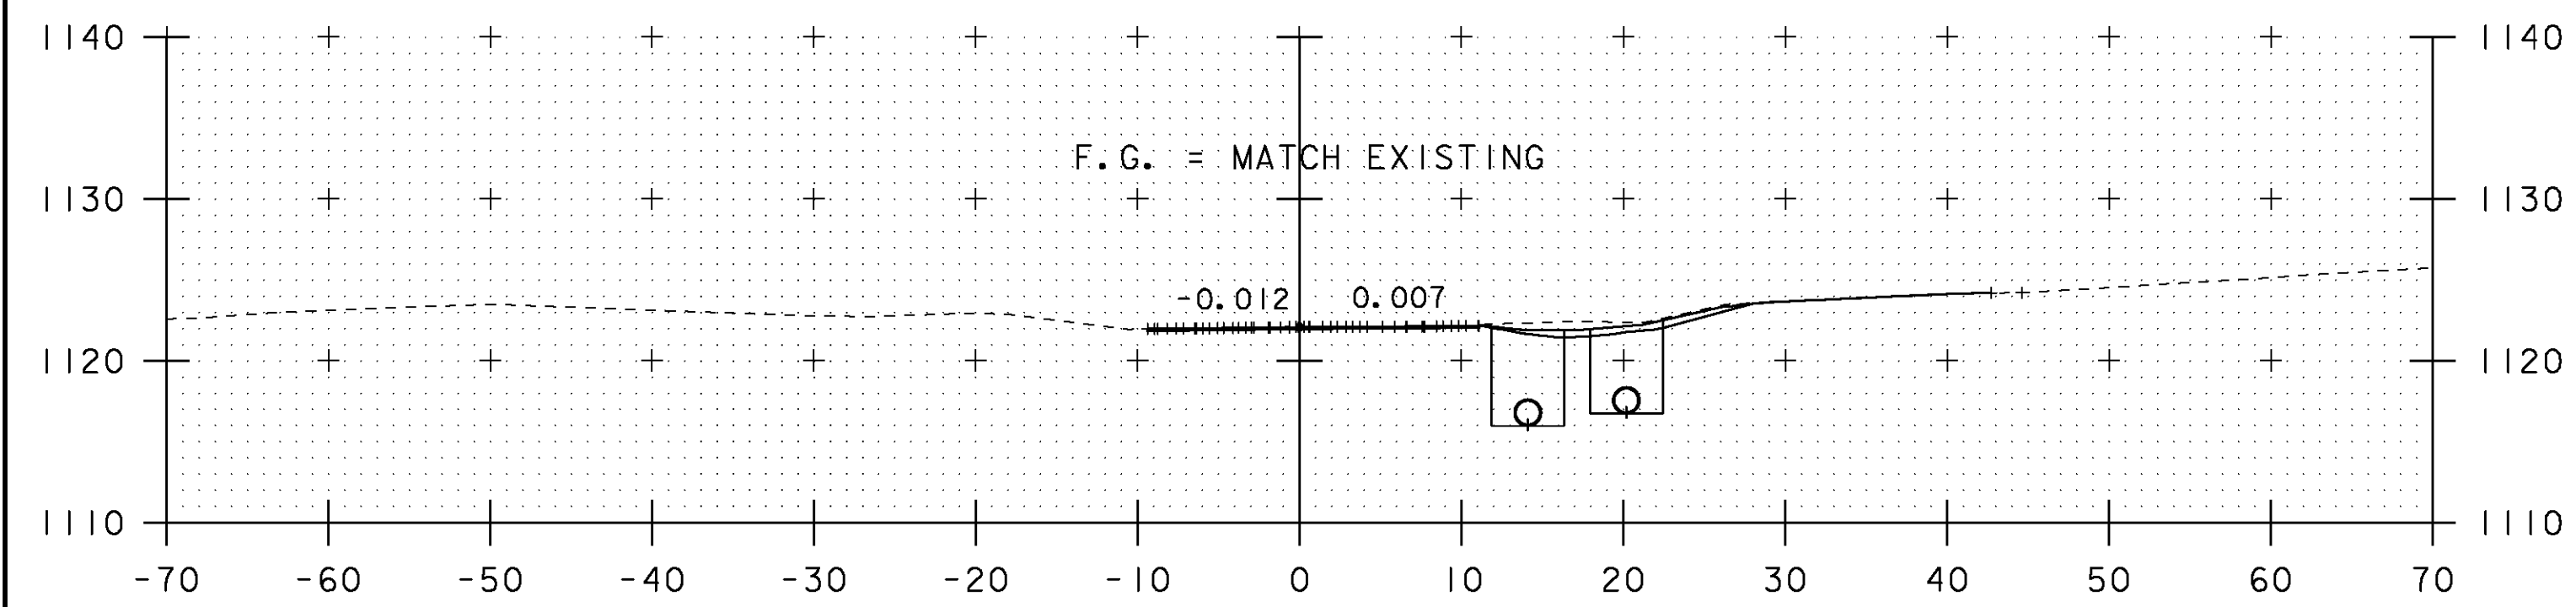


14+25


14+25
END COLD PLANING
END APPROACH

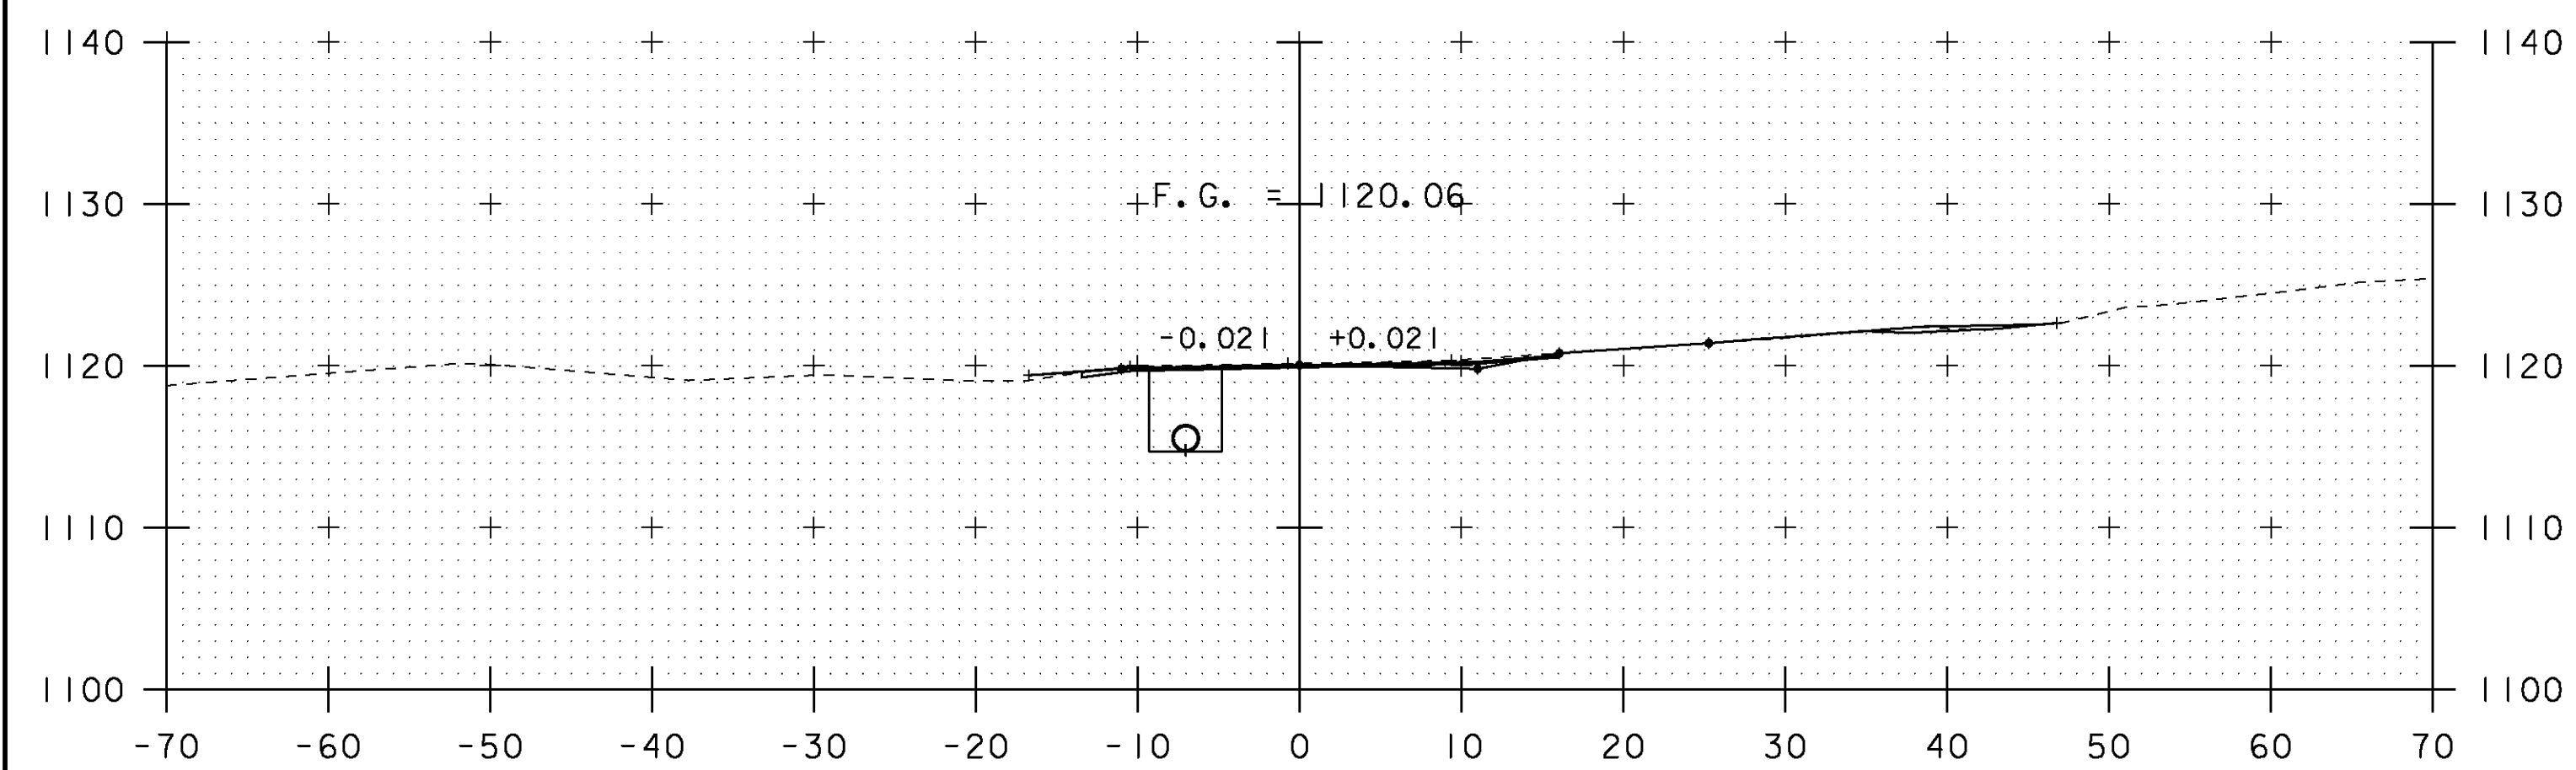

14+00

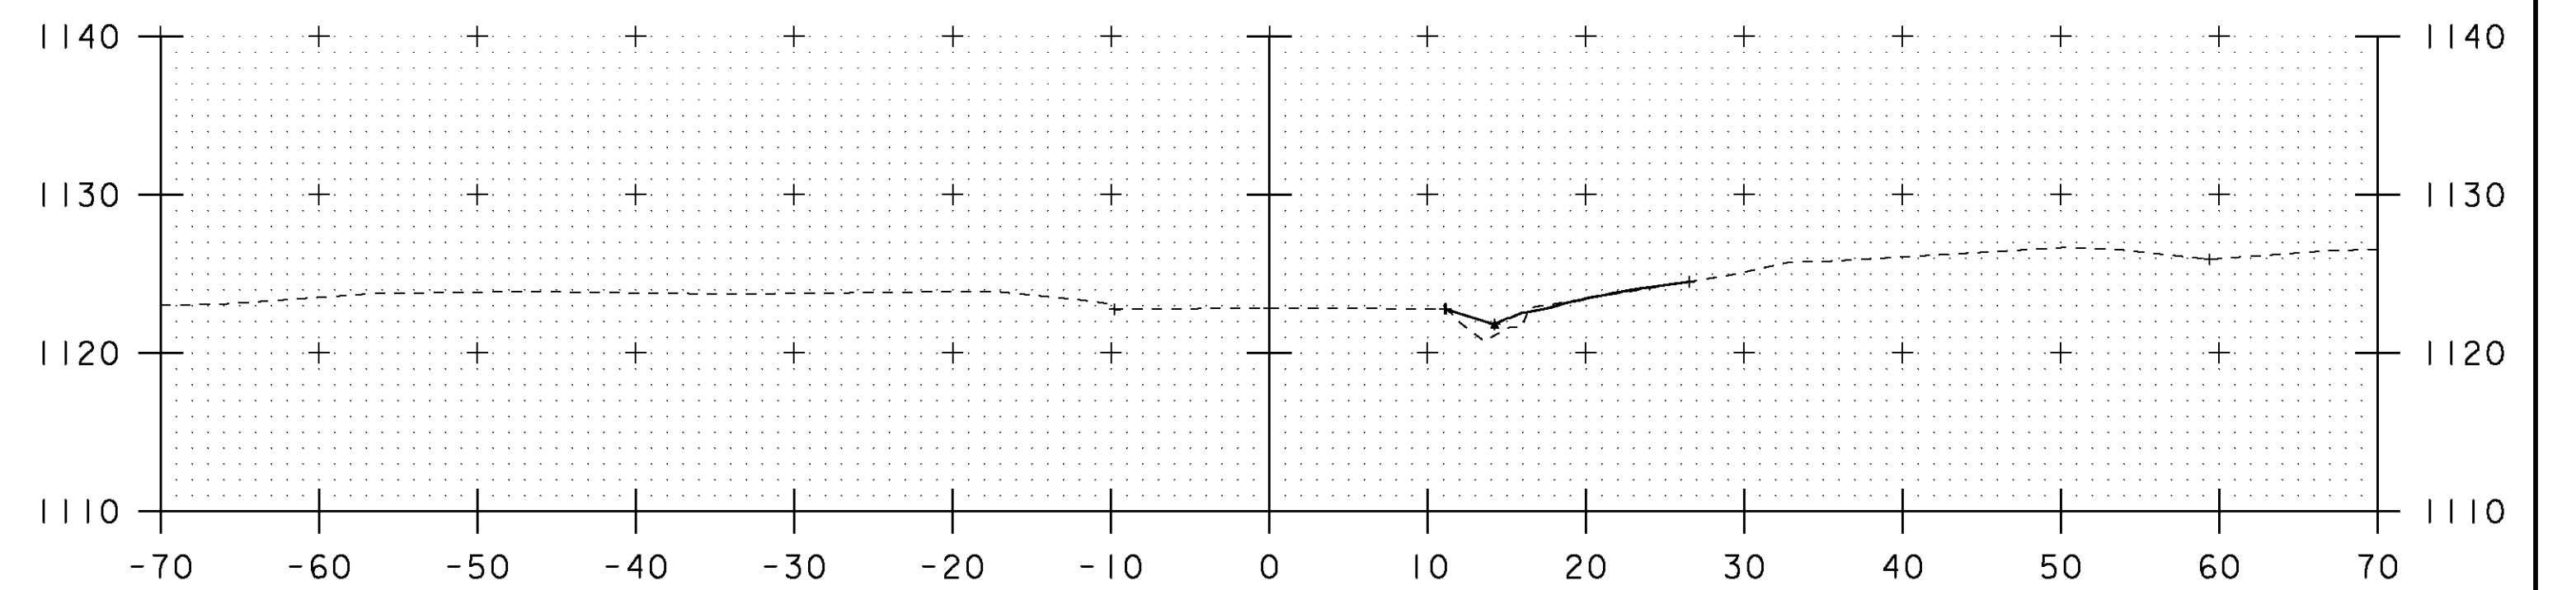

14+37

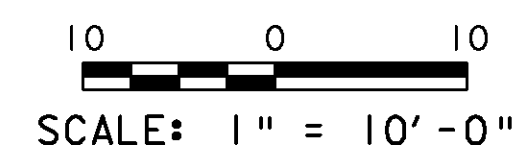

STA. 14+00 TO STA. 14+37

PROJECT NAME: BROWNINGTON	
PROJECT NUMBER: BRO 1449 (28)	
FILE NAME: sj246final	PLOT DATE: 23-FEB-2010
PROJECT LEADER: C. MOONEY	DRAWN BY: C. MOONEY
DESIGNED BY: T. LACKEY	CHECKED BY: -----
ROADWAY SECTIONS - 6	SHEET 6 OF 14