


51+75

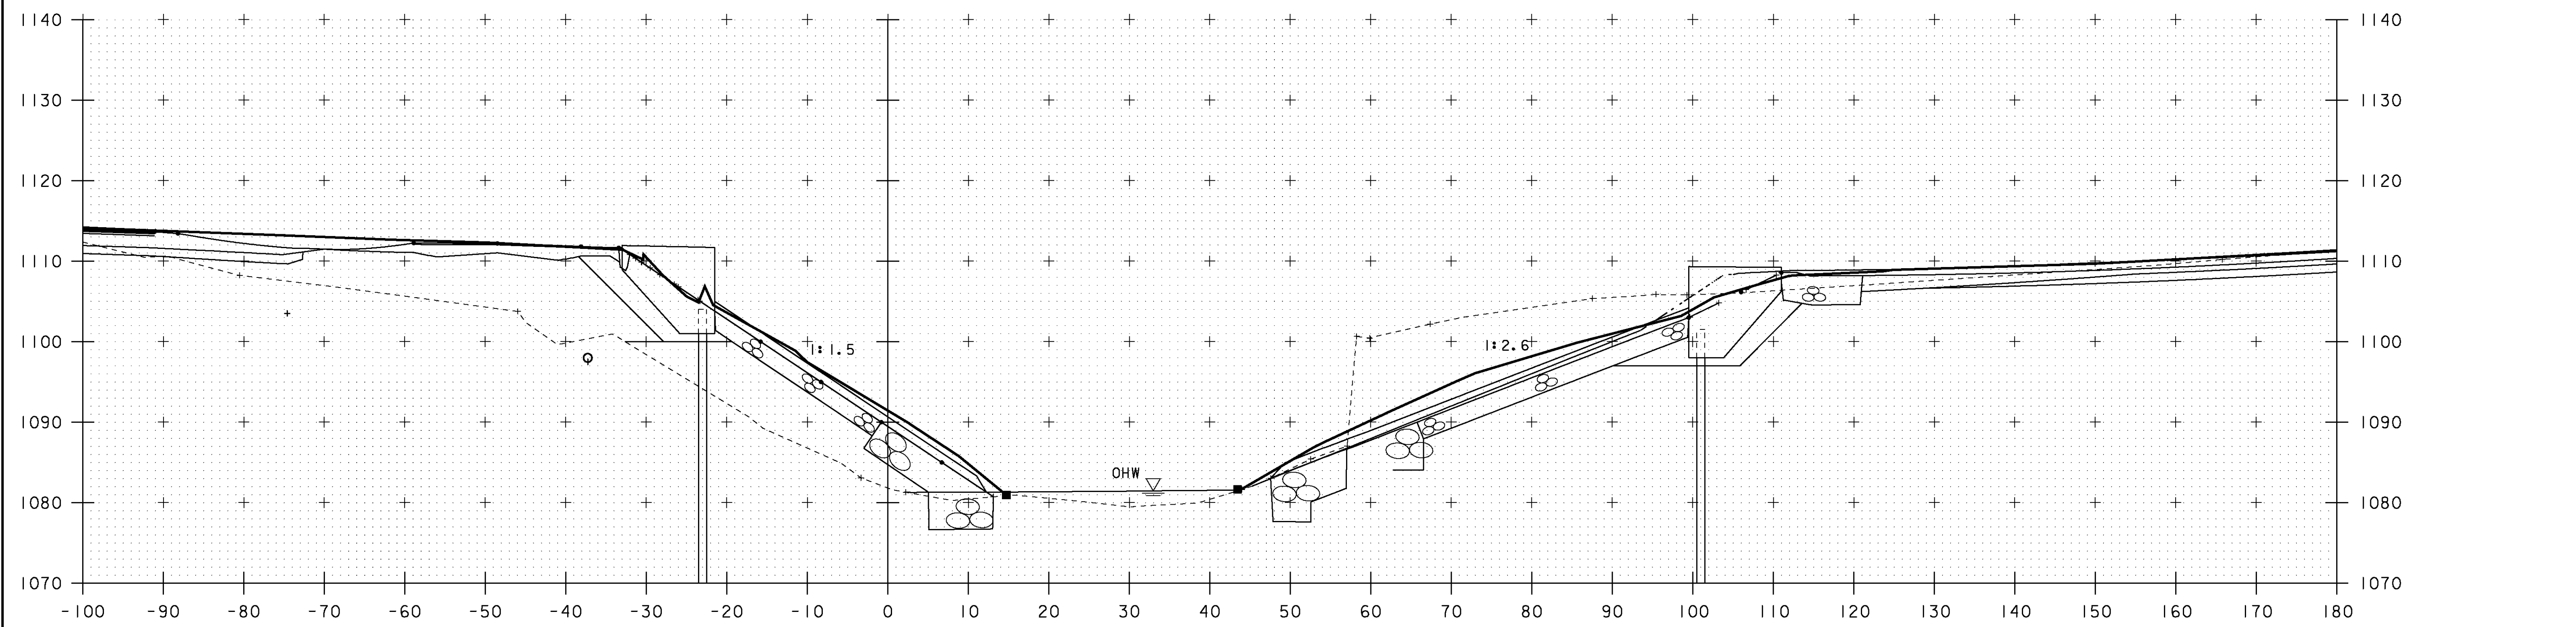

51+66

STA. 51+66 TO STA. 51+75

PROJECT NAME: BROWNINGTON	PROJECT NUMBER: BRO 1449 (28)
FILE NAME: sj246final	PLOT DATE: 23-FEB-2010
PROJECT LEADER: C. MOONEY	DRAWN BY: C. MOONEY
DESIGNED BY: T. LACKEY	CHECKED BY: -----
CHANNEL SECTIONS - I	SHEET II OF 14