


52+25

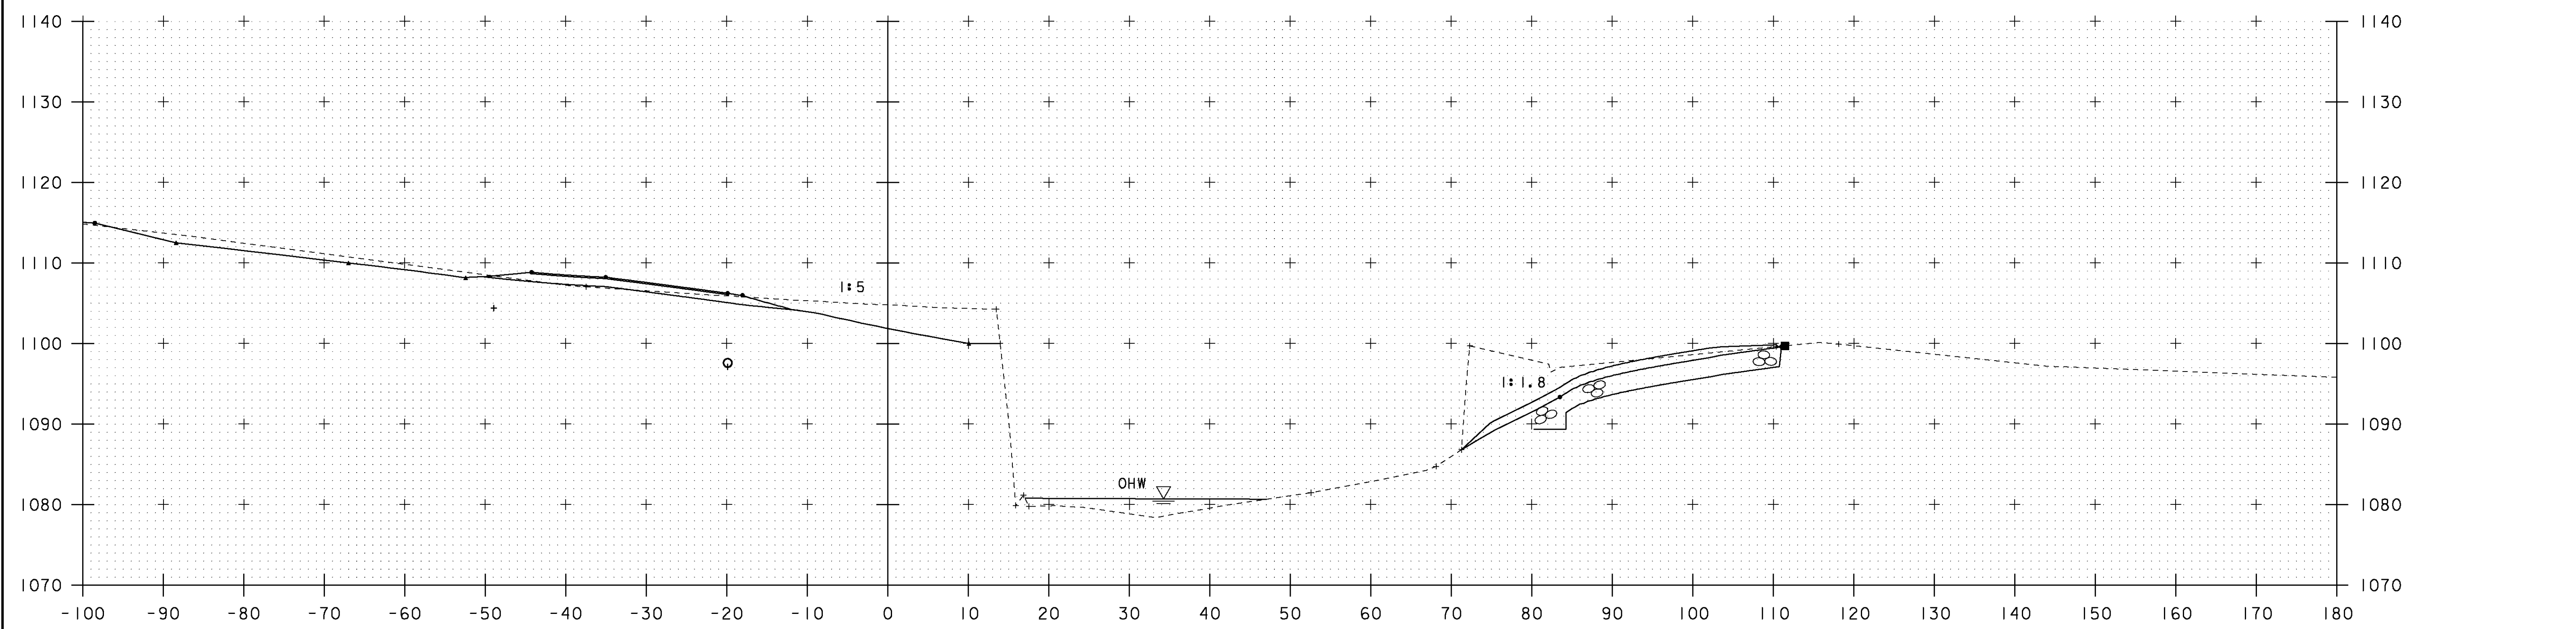

52+00

51+96
 END
 UNCLASSIFIED CHANNEL EXCAVATION
 STONE FILL, TYPE II
 STONE FILL, TYPE IV
 GEOTEXTILE UNDER STONE FILL
 GRUBBING MATERIAL

52+02
 END
 UNCLASSIFIED CHANNEL EXCAVATION
 STONE FILL, TYPE II
 STONE FILL, TYPE IV
 GEOTEXTILE UNDER STONE FILL
 GRUBBING MATERIAL

STA. 52+00 TO STA. 52+25

PROJECT NAME: BROWNINGTON
 PROJECT NUMBER: BRO 1449 (28)

FILE NAME: sj246Final
 PROJECT LEADER: C. MOONEY
 DESIGNED BY: T. LACKEY
 CHANNEL SECTIONS - 1

PLOT DATE: 23-FEB-2010
 DRAWN BY: C. MOONEY
 CHECKED BY: -----
 SHEET 12 OF 14