



NOTE - FOR ELEVATIONS AT BRIDGE SEAT SEE STATE DRAWS  
 PLAN  
 90°





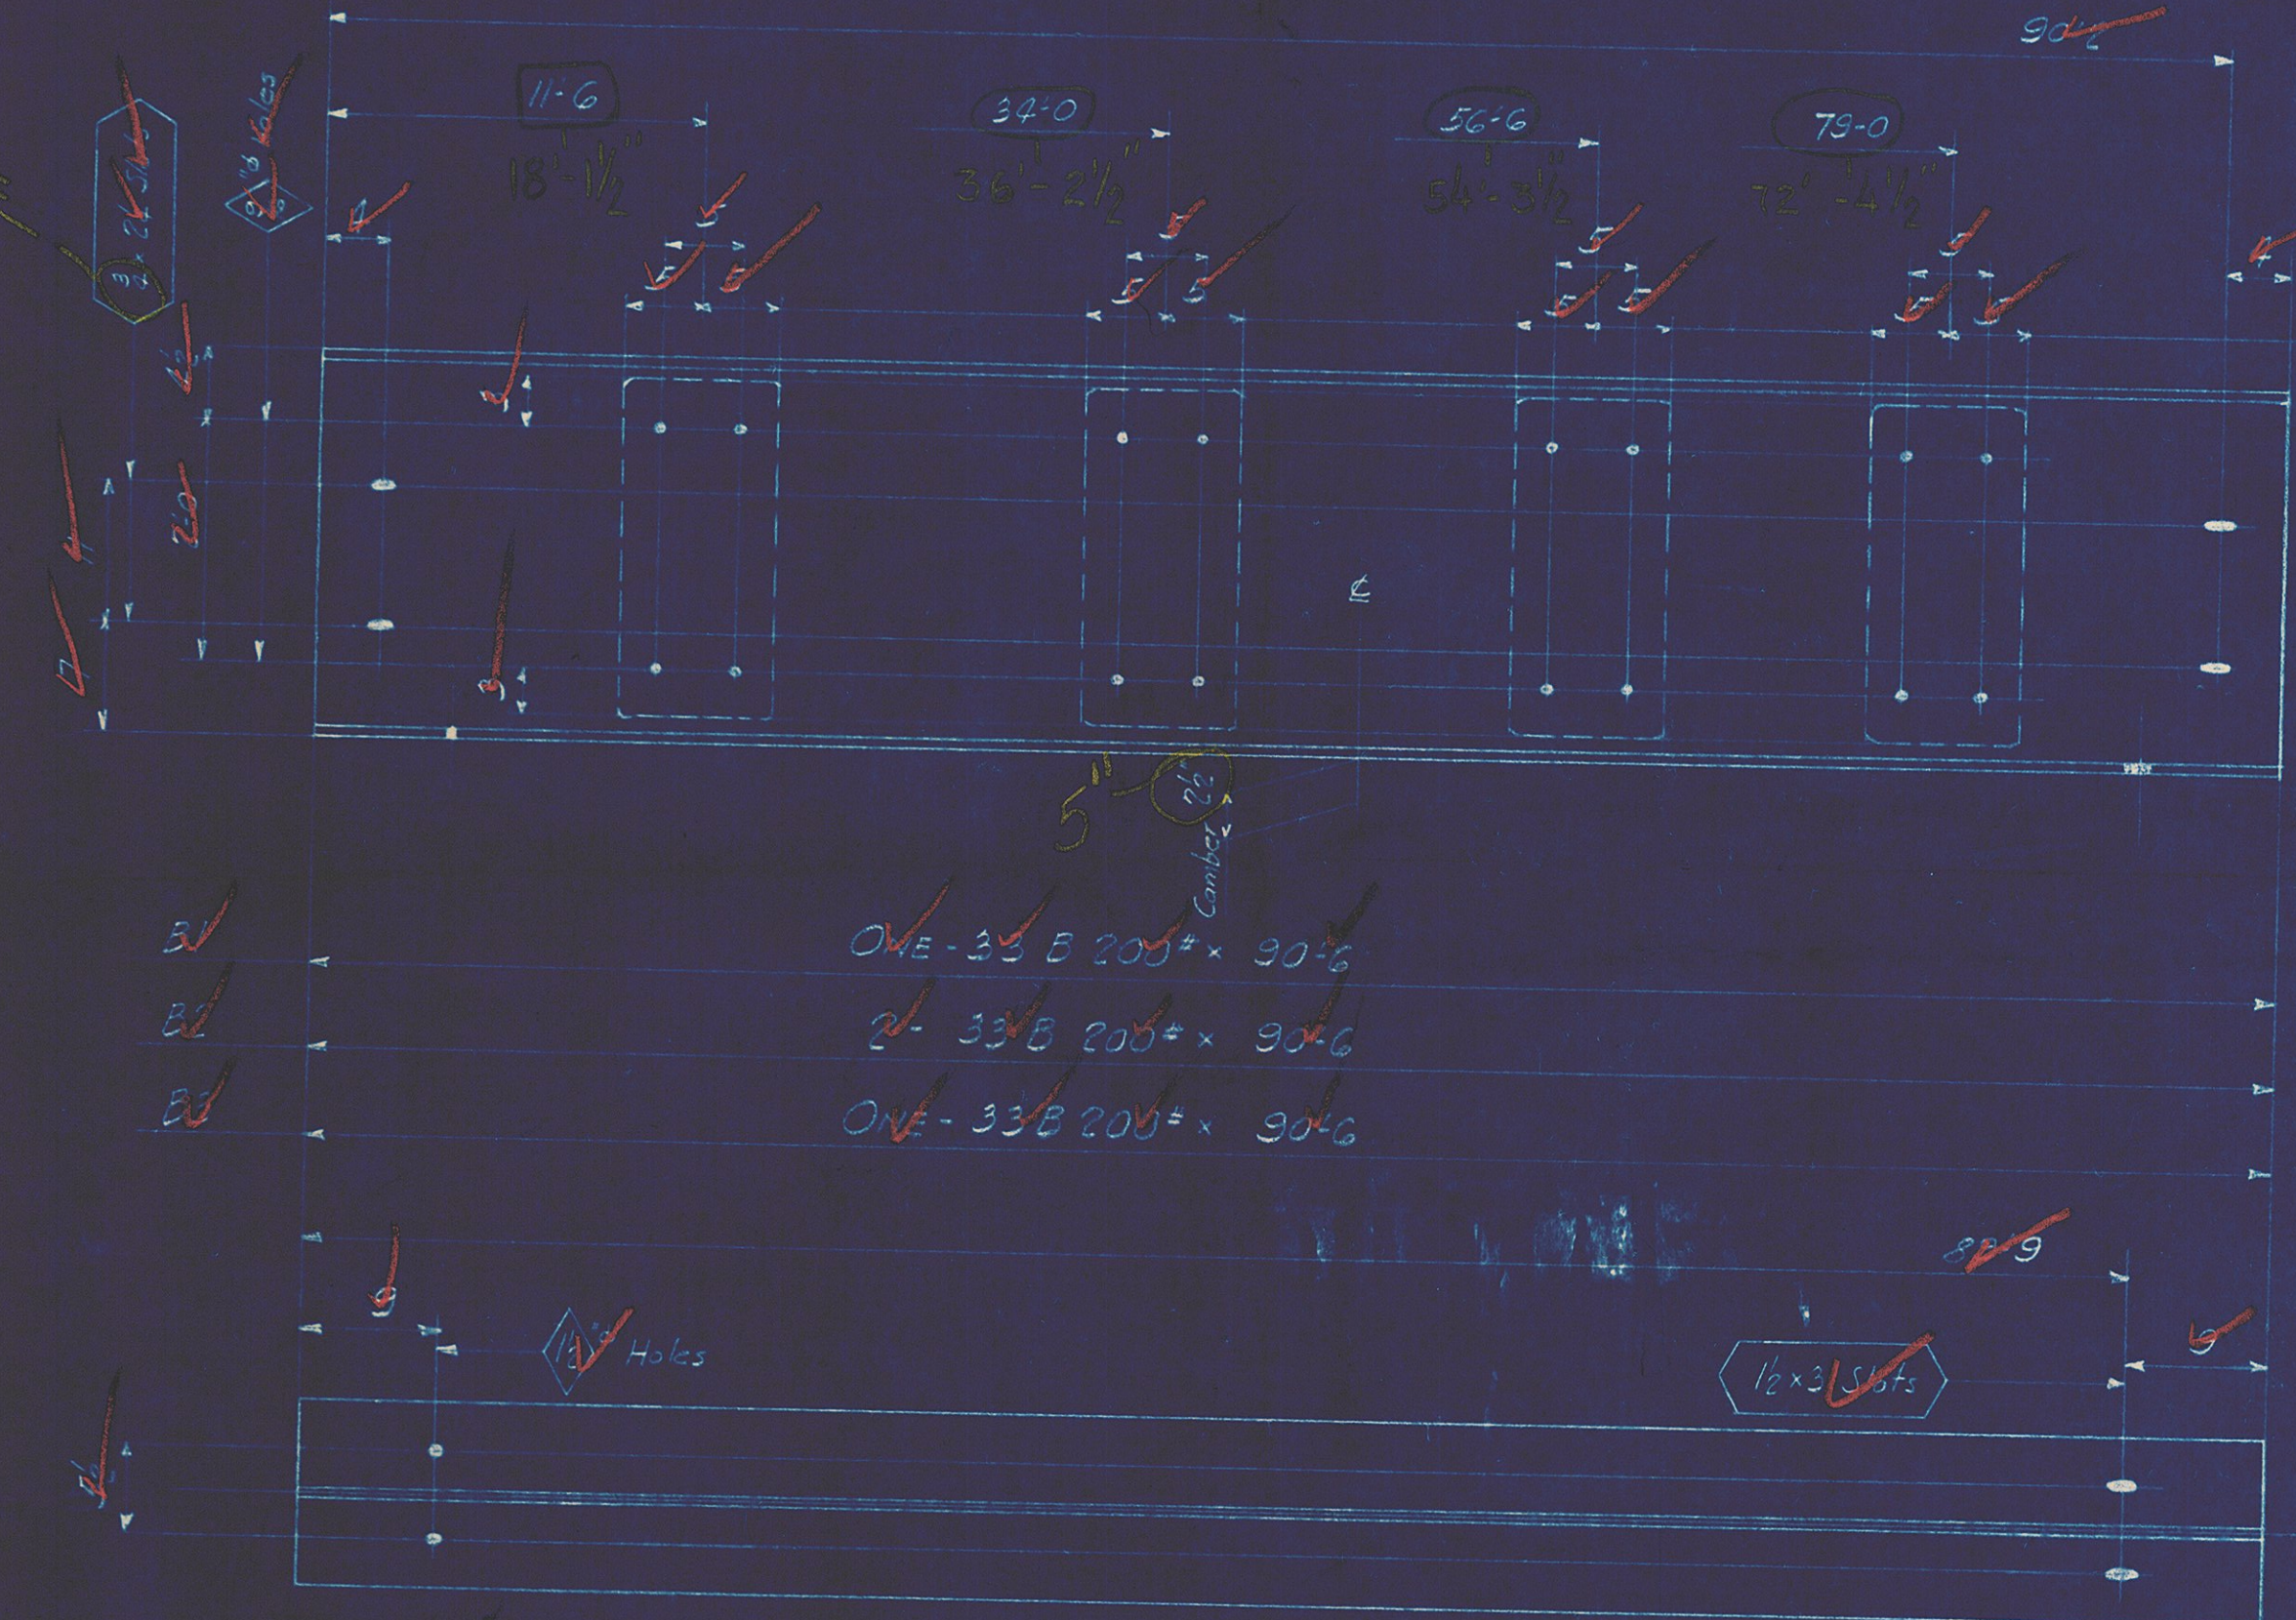


ONE - 33 B 200# x 30#  
 ONE - 33 B 200# x 30#  
 ONE - 33 B 200# x 30#


No PAINT  
 THESE AREAS (NS. FOR B1, Both Sides For B2, FS. FOR B3)

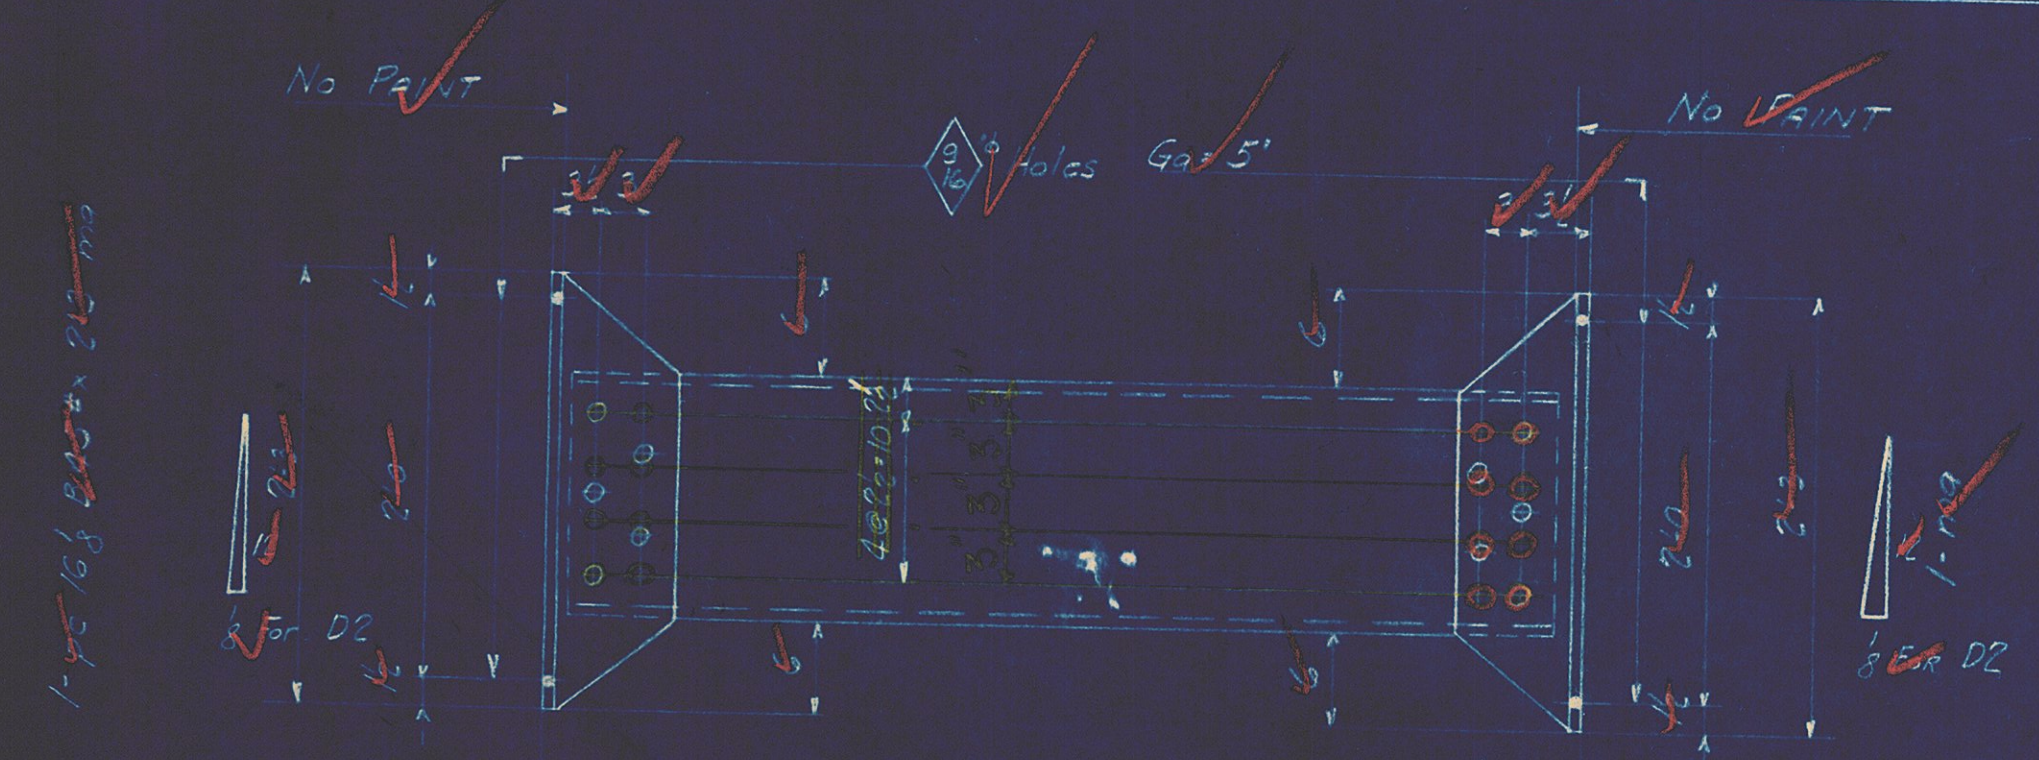

4- 15# 33# x 5-3/4 (Cut 4 1/2)  
 4- 15# 33# x 5-3/4 (Cut 4 1/2)  
 4- 15# 33# x 5-3/4 (Cut 4 1/2)

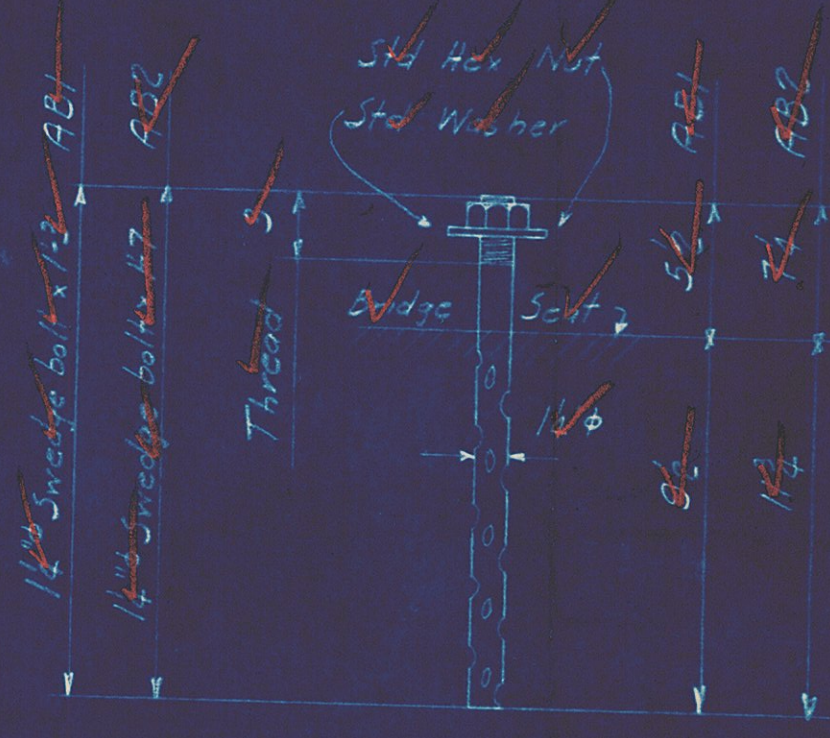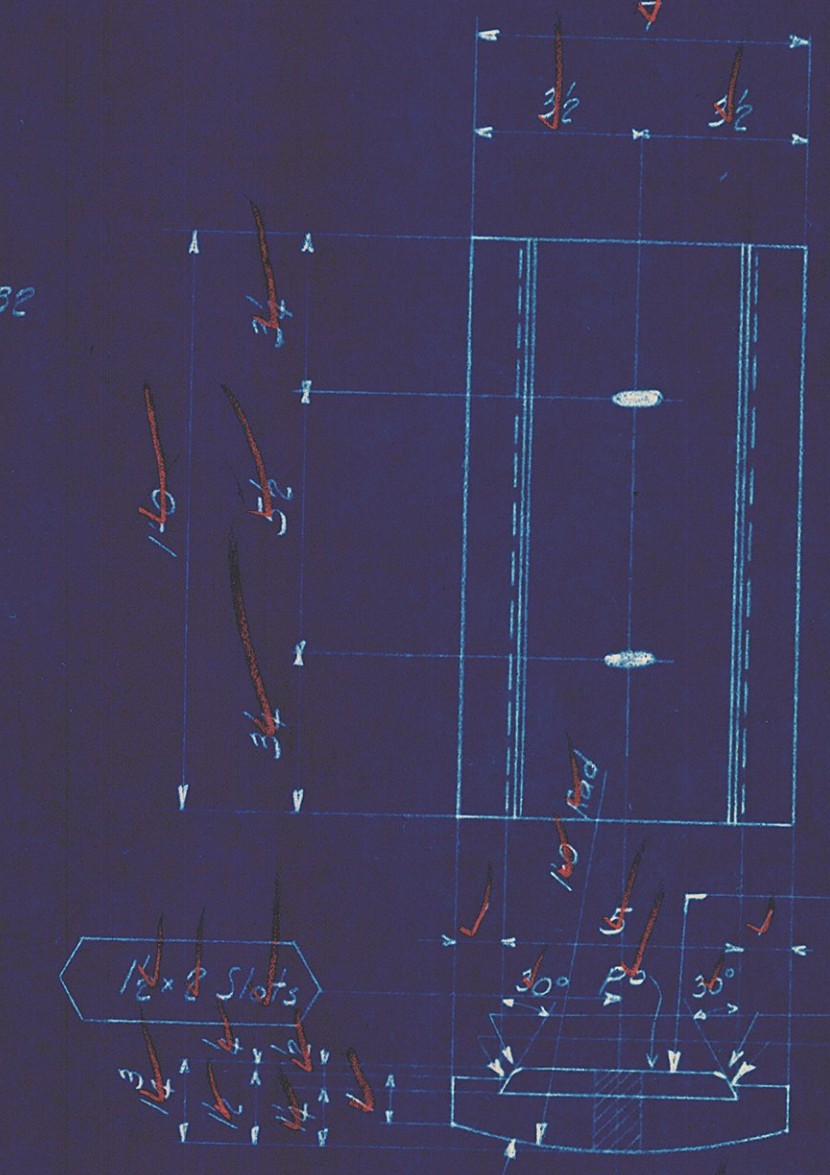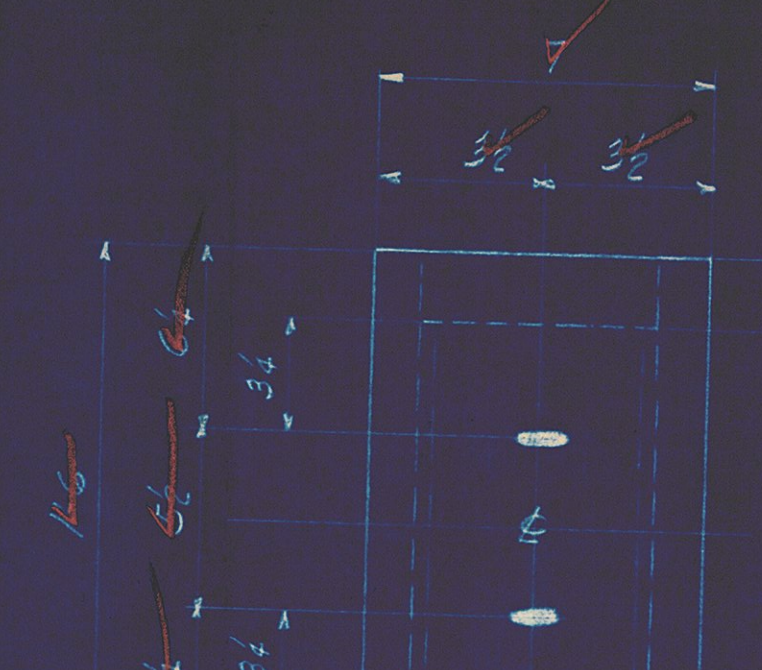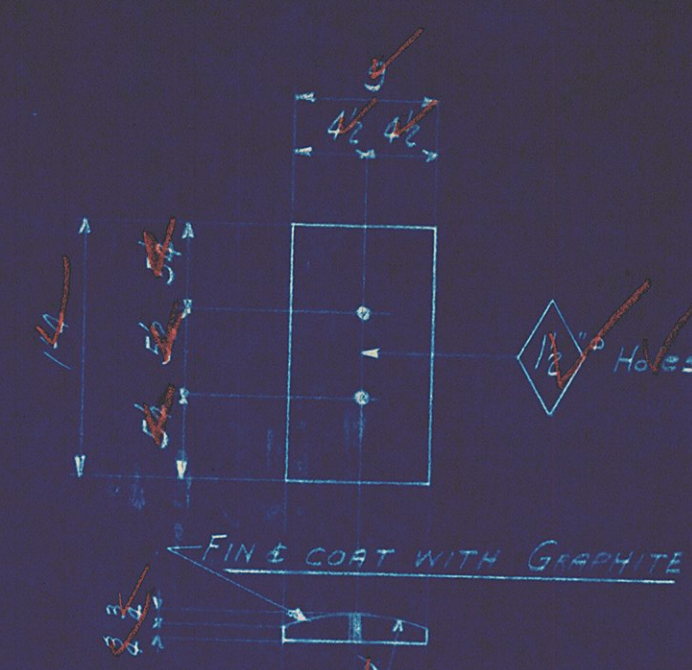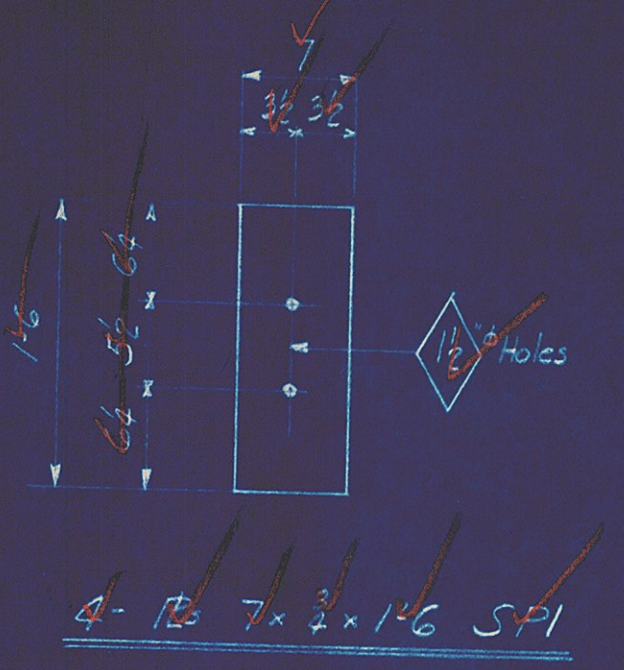

8- ANCHOR BOLTS AB1  
 8- DO DO AB2

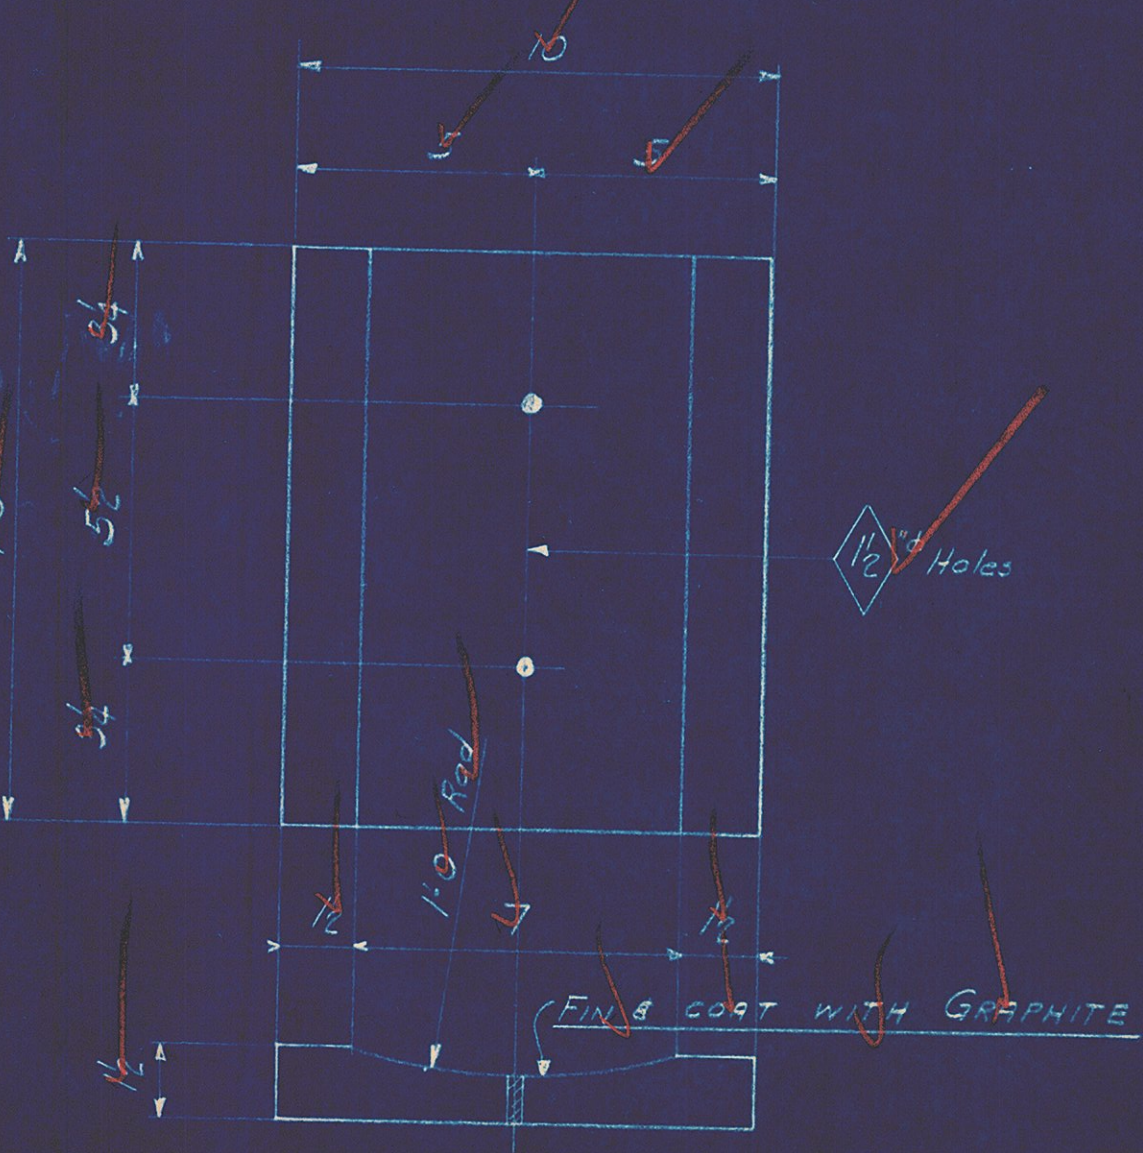

NOTES -  
 SPI & SP2 are to be welded to Beams in field using 1/2\"/>

L.M.B.  
 9/27/39

TEMP.	
SUPT.	
LAYOUT	
FITTER	
SHOP INSP.	
P.C. WK.	
B. SMITH	
MCH.	
ERECT.	
O. INSP.	

STEEL DETAILS & PLAN  
 VENEER PLANT BRIDGE  
 HANNOCK, VT.  
**BETHLEHEM STEEL COMPANY**  
 FABRICATED STEEL CONSTRUCTION  
 Drawings at Buffalo - Fabrication at Buffalo  
 IN CHARGE: [Signature] MADE BY: [Signature]  
 CHECKED BY: [Signature] TRACED BY: [Signature]  
 REVISED: [Signature] LAST ASSEM. MK: [Signature]

SHOP CONTACT SURFACES No PAINT SHOP NO. CONTRACT H.K. 702 SHEET 1