


MOTOR CONTROLS RH  LH   
 OPTIONAL SERVICE RH  LH   
 DOOR As Viewed From Inside Looking Out

*X Michael J. White*  
 This signature certifies that all dimensions on this print have been reviewed and coordinated with the building and also releases for fabrication.

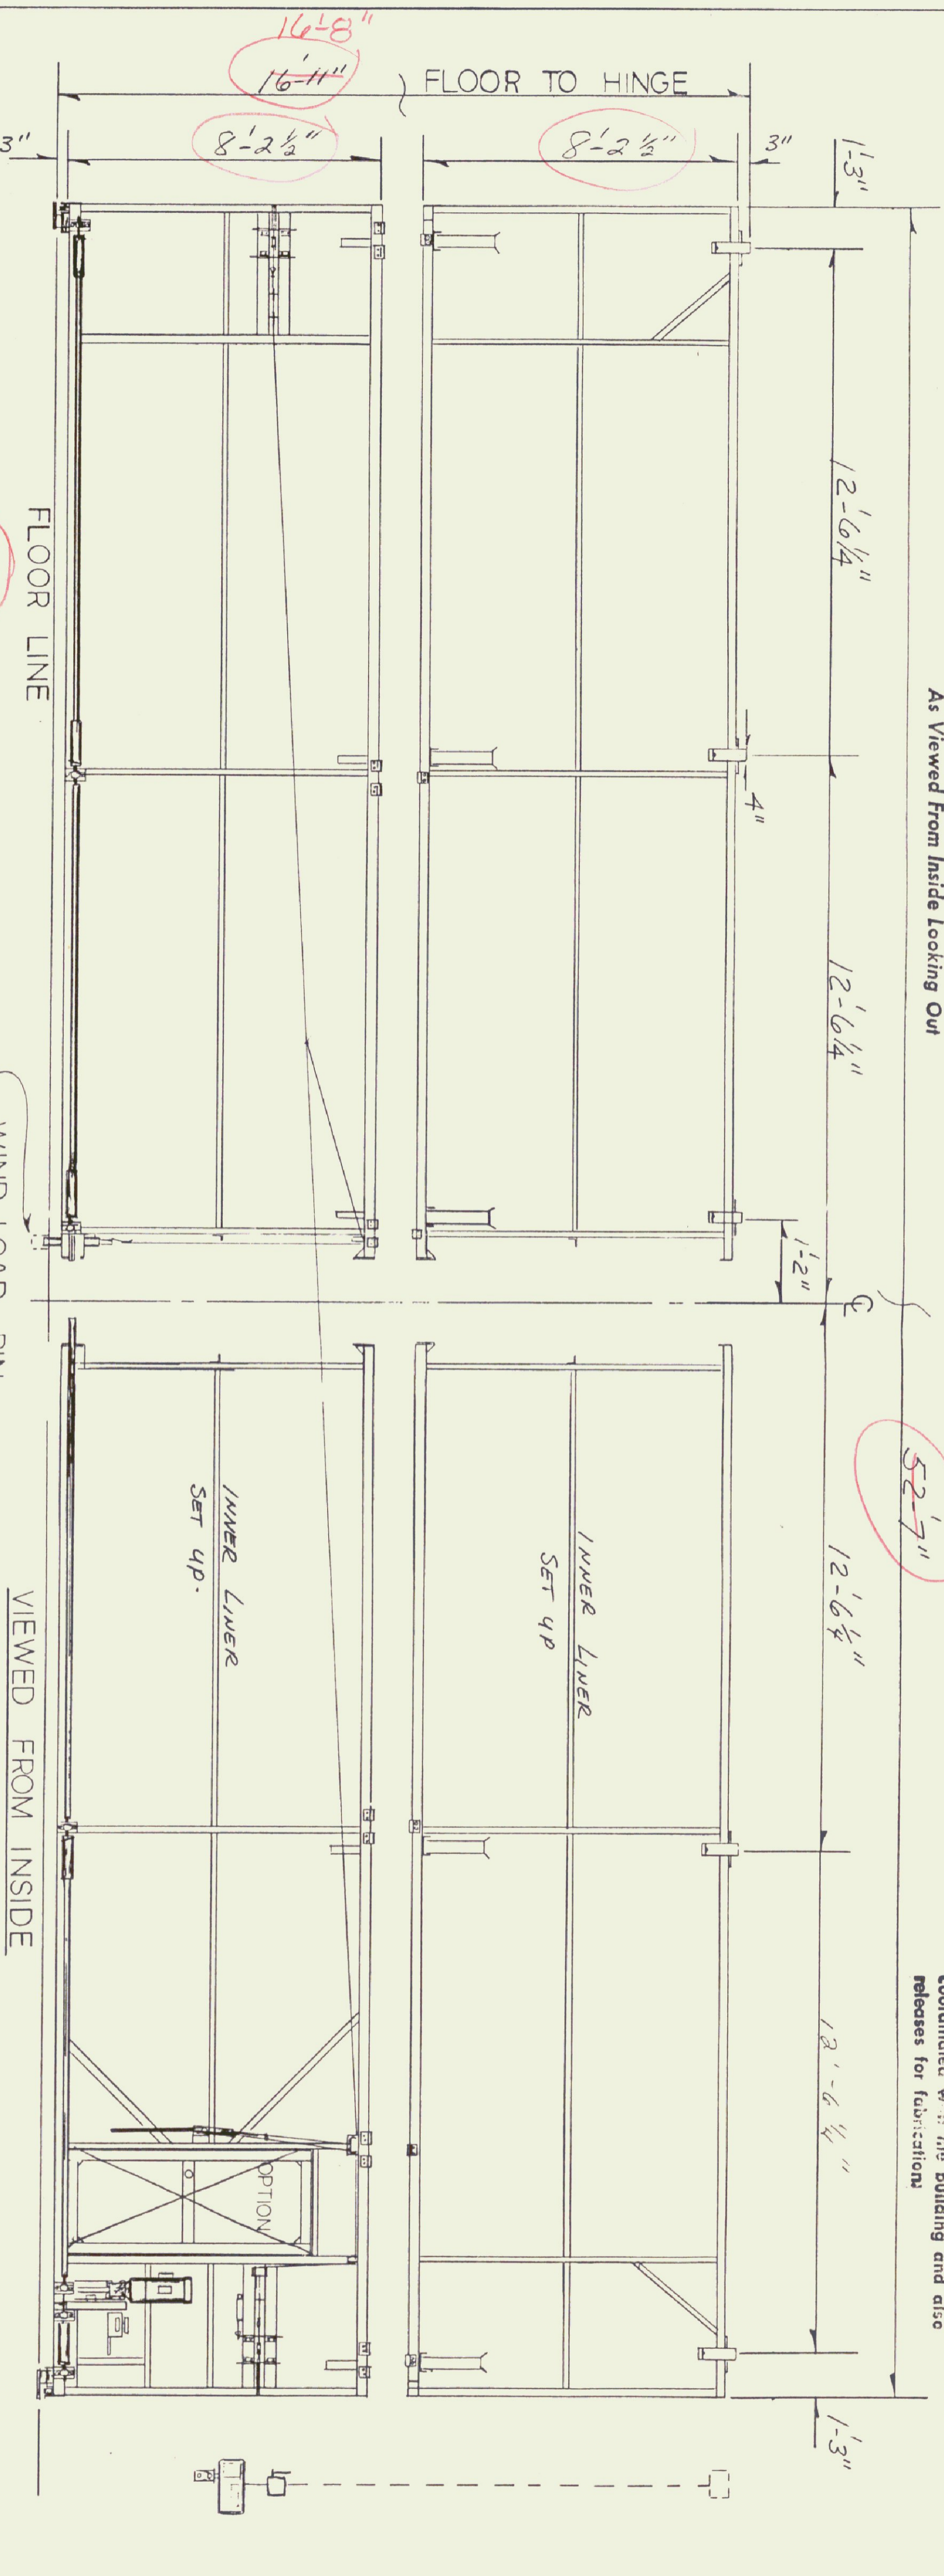

SHEET LENGTH

*8'-6 1/2\"/>*

SEE PAGE 54 IN THE INSTALLATION INSTRUCTION MANUAL FOR METHODS OF SHEETING DOOR.

COVERING FOR DOOR; NOT SUPPLIED BY WILSON  
 USE STRUCTURAL SHEETING WITH 1/4\"/>

NOT SUPPLIED BY WILSON

SPECIFICATIONS

- 5 HINGE
- 5 PICK UP
- COLD WEATHER
- 3-BARROW CONTROL / U.S.O.
- Zinside Liner Set up

USE OF ARCHITECTURAL TYPE SHEETING IS PROHIBITED

SHOP DRAWING REVIEW

- No Exception Taken
- Revise and Resubmit
- Make Corrections Noted
- Comments Attached

This check is only for review of general conformance with the design concept of the project and general compliance with the information given in the contract documents. The contractor is responsible for confirming and correlating all quantities and dimensions and performing his work in a satisfactory manner.

CHENETTE ENGINEERING, INC.  
 Date *3/14/91* By *MK*

WILSON INDUSTRIAL DOORS, INC.  
 P. O. Box 372 ELKHORN, WISCONSIN 53121 • DU 045446 1-800-558-5974

NAME: *State of Vermont Dept. of State Buildings*  
 ADDRESS: *2000 Rikers Ave, Montpelier, VT. 05602*

SIZE: *52'-1\"/>*

DATE: *3/11/91*