


USE OF ARCHITECTURAL TYPE SHEETING IS PROHIBITED

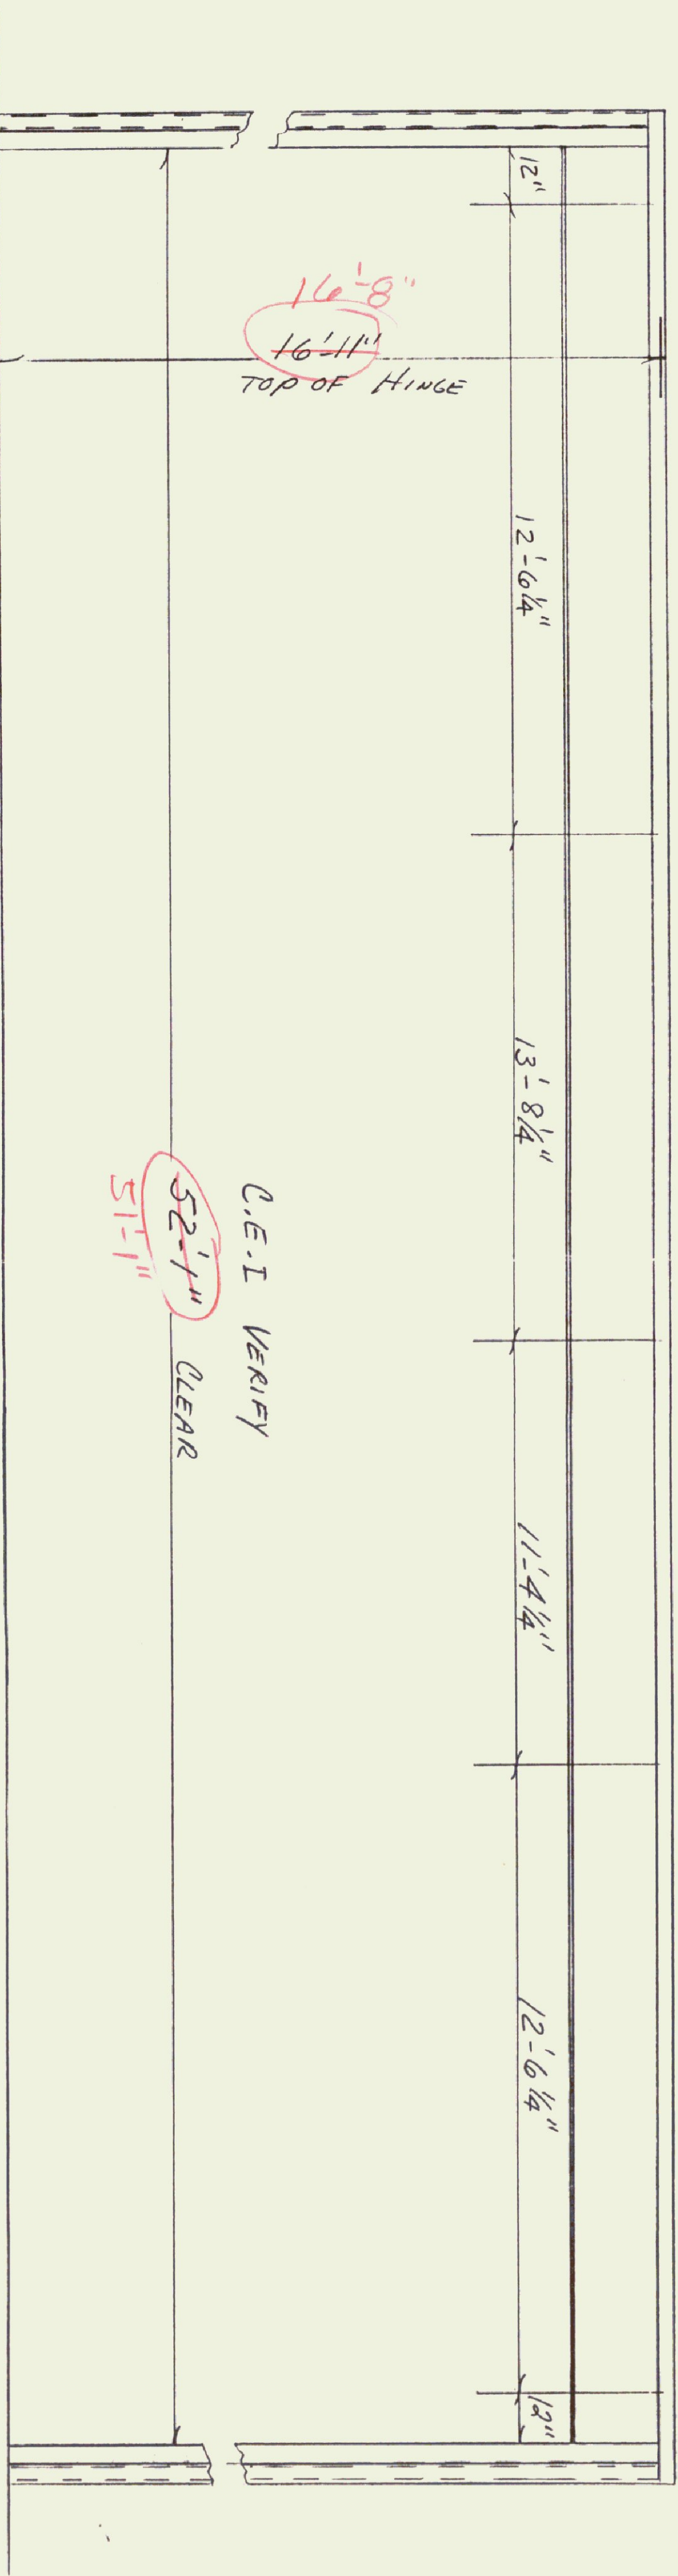

L 6X4X 3/8  
3/8" x 4" PLATE  
52'-1"  
51'-1"  
O.E.I. - FIELD VERIFY

X *Metal drafts*

This signature certifies that all dimensions on this print have been reviewed and coordinated with the building end also releases for fabrication.

MOTOR CONTROLS RH  LH   
 OPTIONAL SERVICE RH  LH   
 DOOR As Viewed From Inside Looking Out

SHOP DRAWING REVIEW!

No Exception Taken  
 Revise and Resubmit  
 Make Corrections Noted  
 Comments Attached  
 This check is only for review of general conformance with the design concept of the project and general compliance with the information given in the contract documents. The contractor is responsible for confirming and correlating all quantities and dimensions and performing his work in a satisfactory manner.

CHENETTE ENGINEERING, INC.  
 Date 3/14/91 By MLC