
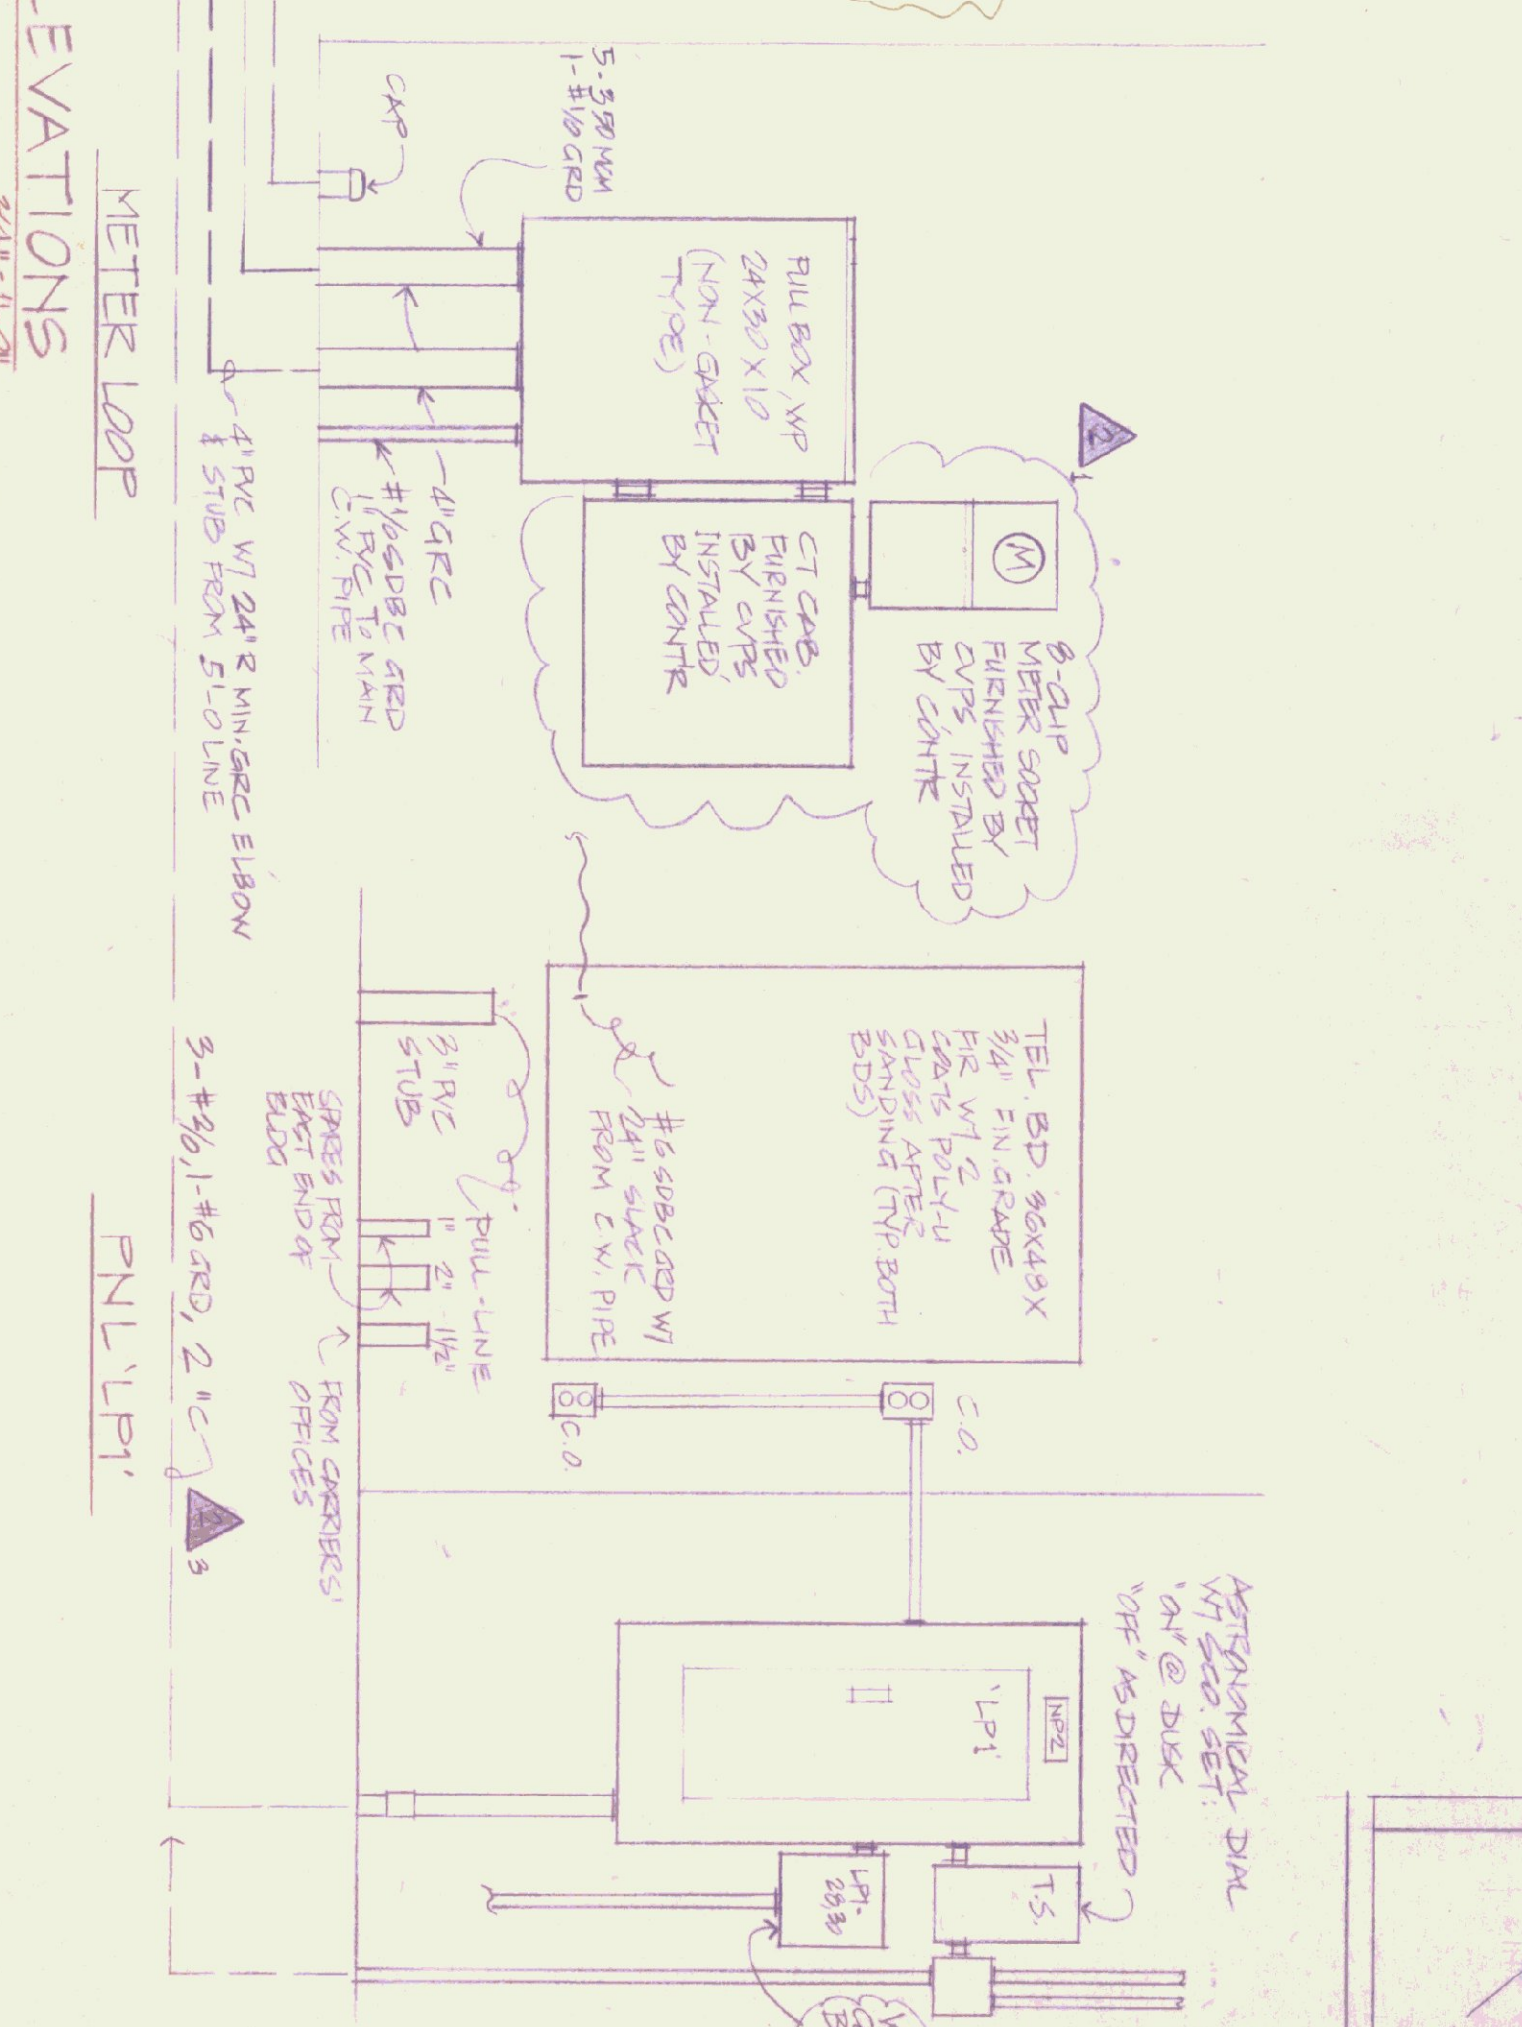
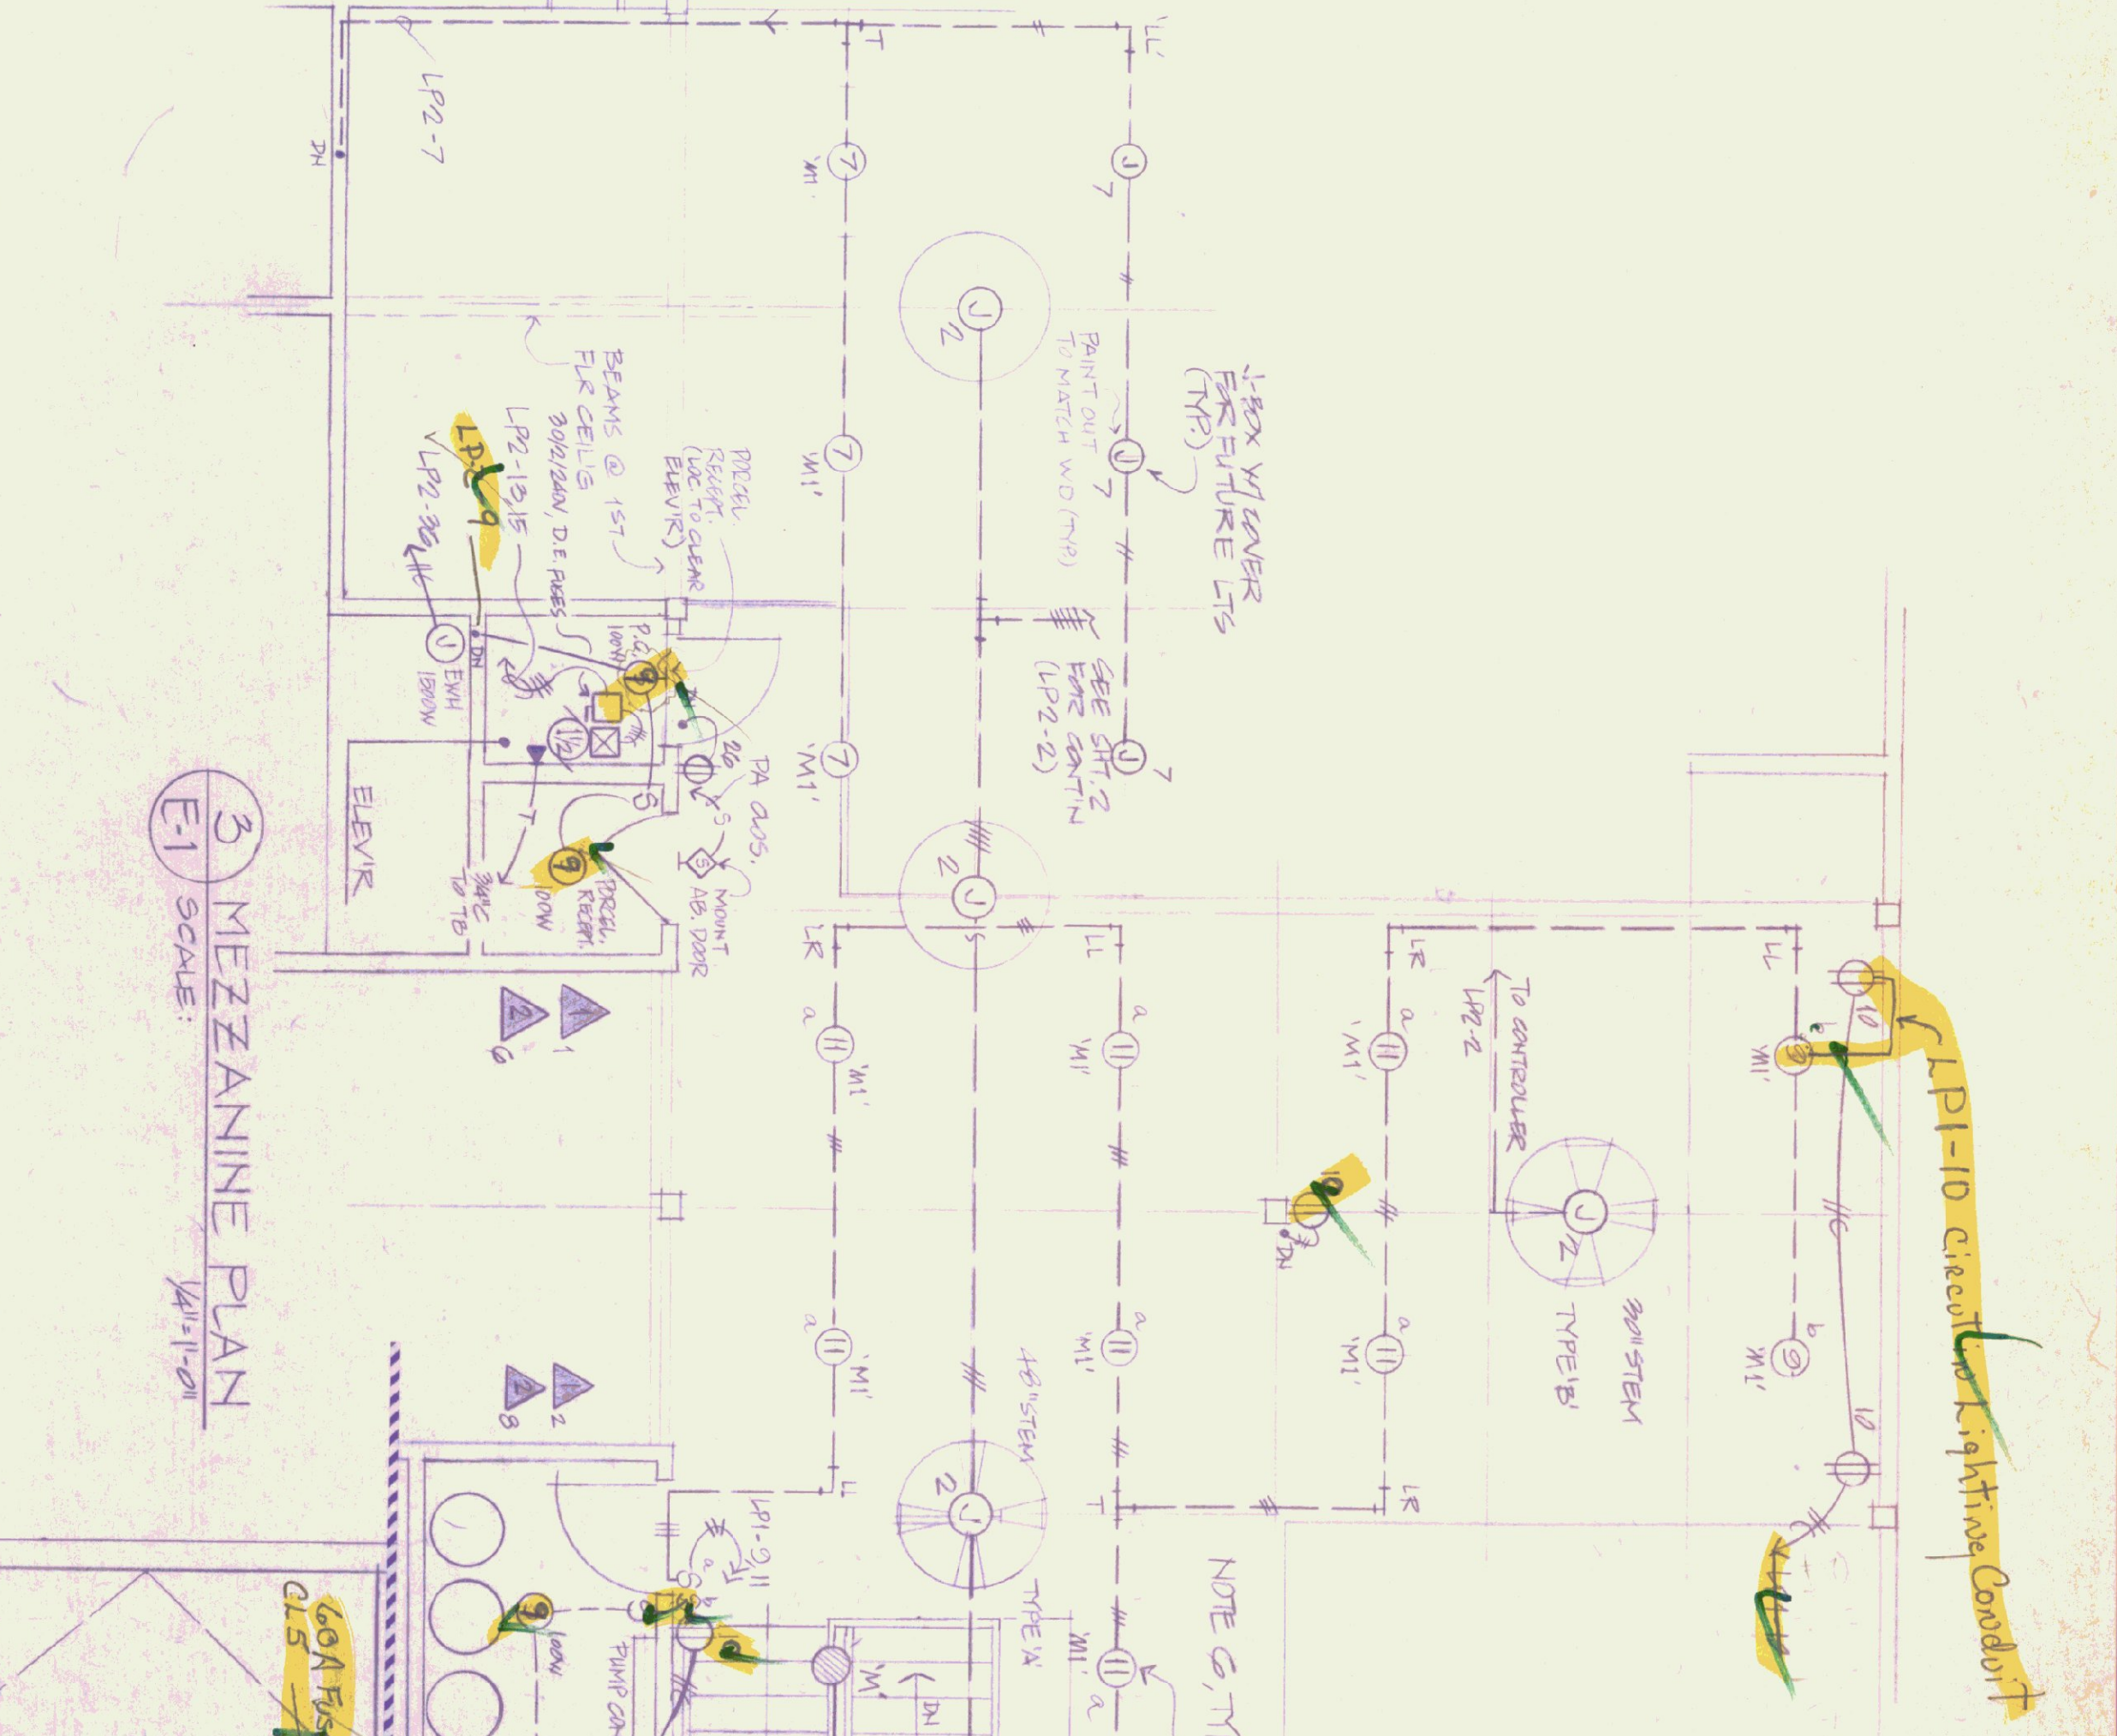
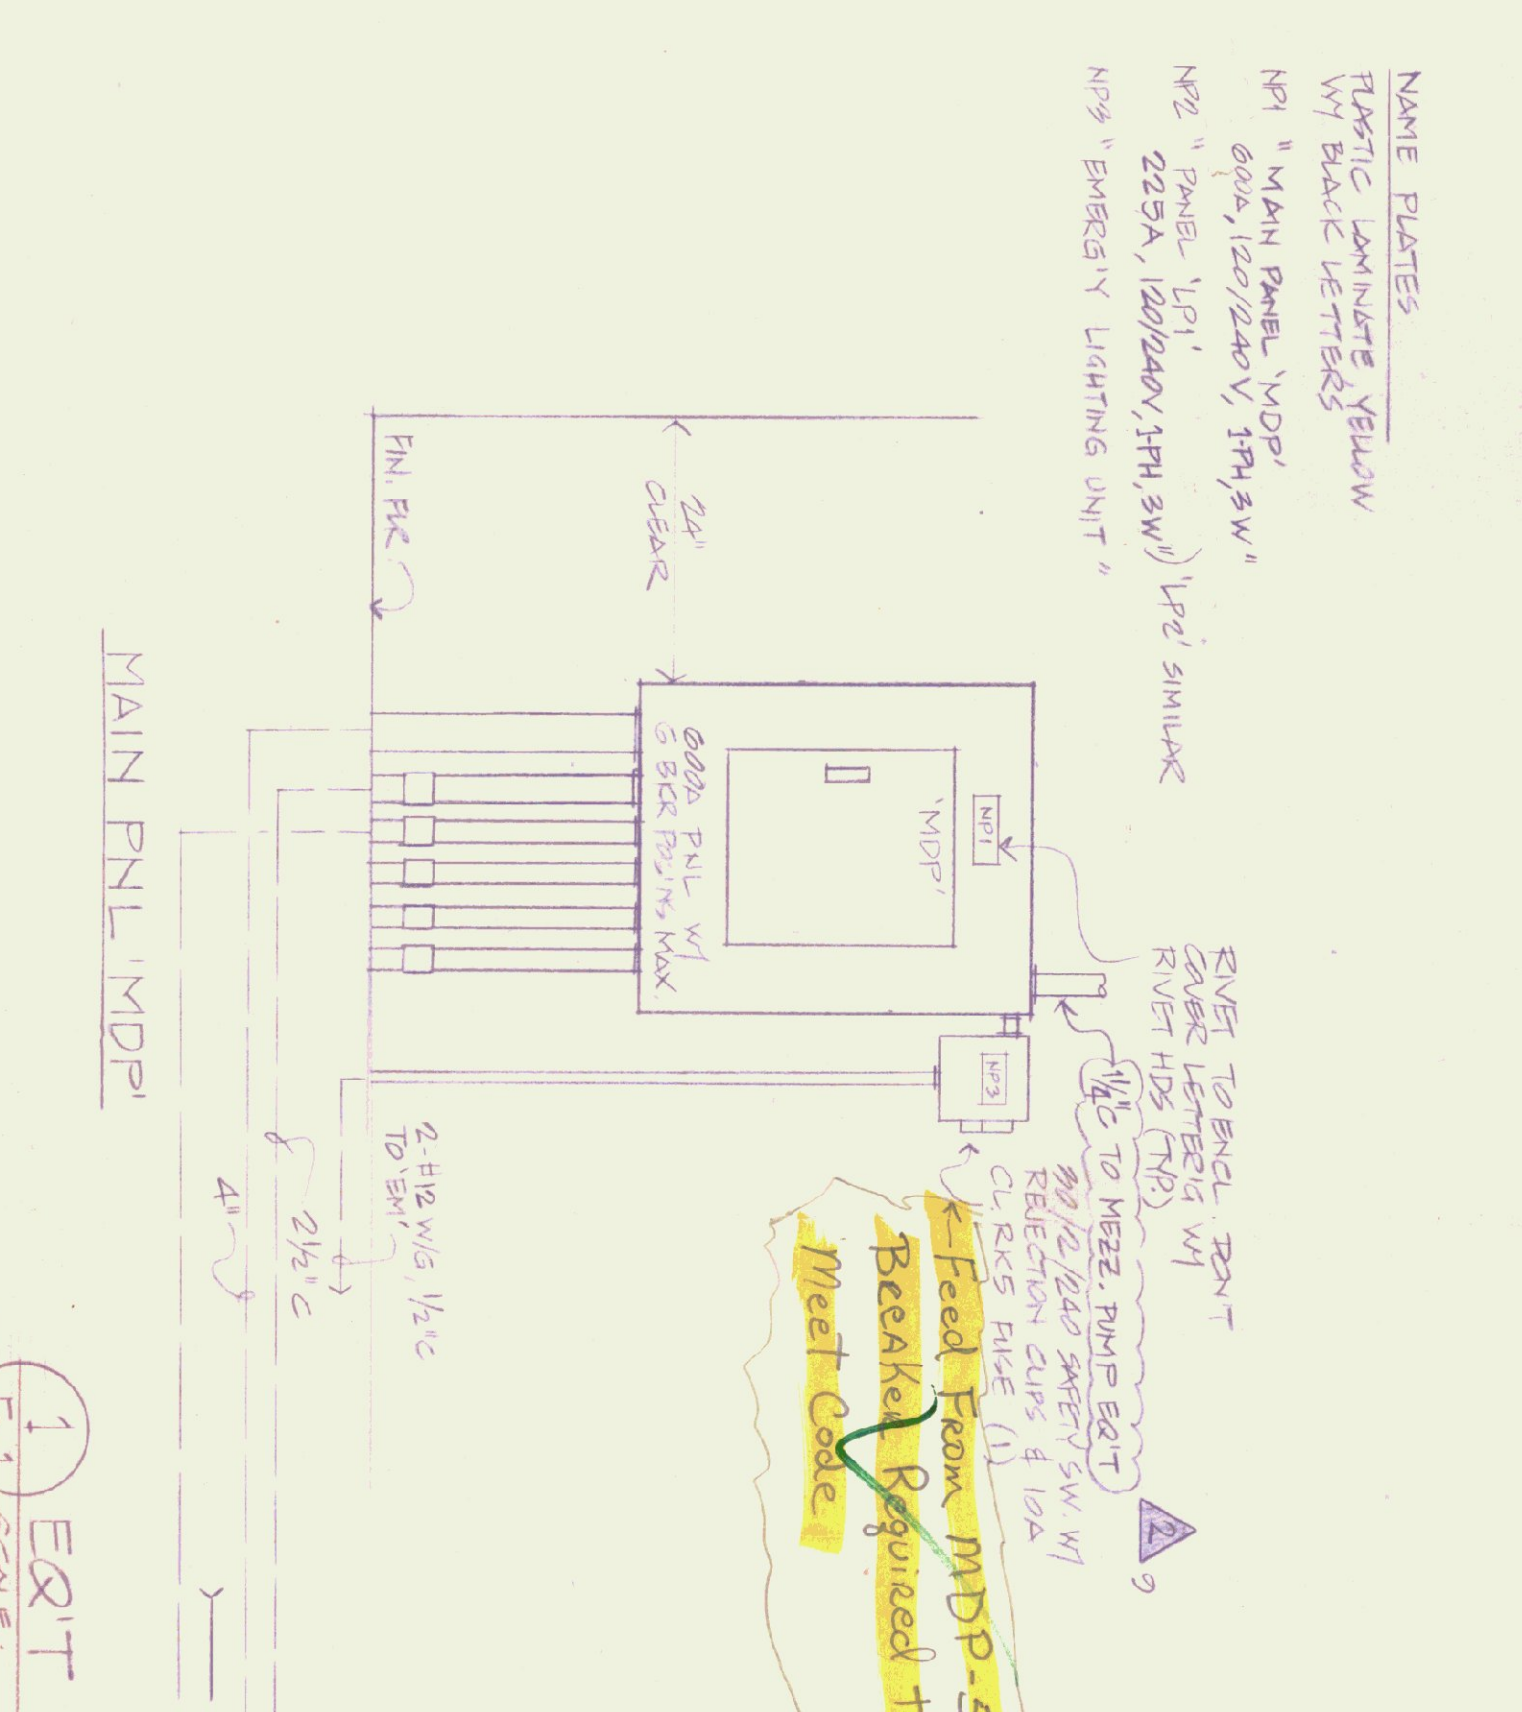


Type	Description	Lamps	Equal to	Light fixture	Light fixture
A	FLUORESCENT 2-AMP WARM-AROUND WITH PRISMATIC ACRYLIC DIFFUSER	2-F40W	LITHONIA SC240		LITHONIA SC240
B	OPEN				
C	SIMILAR TO 'A', 4 LAMPS	4-F40W	LITHONIA SC240		LITHONIA SC240
D	FLUORESCENT 24 X 48 SURFACE WITH 4 LAMPS, 1/2 X 1/2 X 1/2 ALUM. EGGCRATE DIFFUSER, PAINT AS DIR'D	4-F40W	DAY-BRITE DAYLUM		DAY-BRITE DAYLUM
E	SIMILAR TO 'D', 24 X 48, 2-LAMP	2-F40W			
F	SAME AS 'E', BUT WITH 2 SINGLE LAMP BALLASTS	2-F40W	LITHONIA C140		LITHONIA C140
G	FLUORESCENT OPEN STRIP, 1-LAMP	1-F40W	LITHONIA C240		LITHONIA C240
H	FLUORESCENT OPEN STRIP, 1-LAMP	1-F40W	LITHONIA C240		LITHONIA C240
I	WALL MOUNTED SINGLE-LAMP FLUOR. METAL BOX SHIELD, BRONZE FIN.	1-F40W			LITHONIA CM-4281
J	SAME AS 'I', BUT WITH 10-TEMP BALLASTS	2-F40W			LITHONIA CM-4281
K	WALL-MOUNTED SINGLE-LAMP FLUOR. OPEN ACRYLIC WARM-AROUND DIFF. R.	1-F40W			PRESCOLITE 3887
L	EXTERIOR INCAN. WALL BRACKET, 6 IN. DIA., BRONZE FIN.	A19 91W			PRESCOLITE 1165-383
M	INCAN. PENDANT 6-IN. CYLINDER 130W PL.	PAC-38			PRESCOLITE 1122-950
N	SAME AS 'M'	R-30, 75W			
O	INCAN. PENDANT, 5-IN. CYLINDER BRONZE FIN.	R-30			PRESCOLITE 1192-910
P	FLUORESCENT SINGLE-LAMP VANDAL PROOF, POLY CARB LENS	F40W			RECALL 7140
Q	SAME AS 'P' BUT WITH 10-TEMP BALLAST				

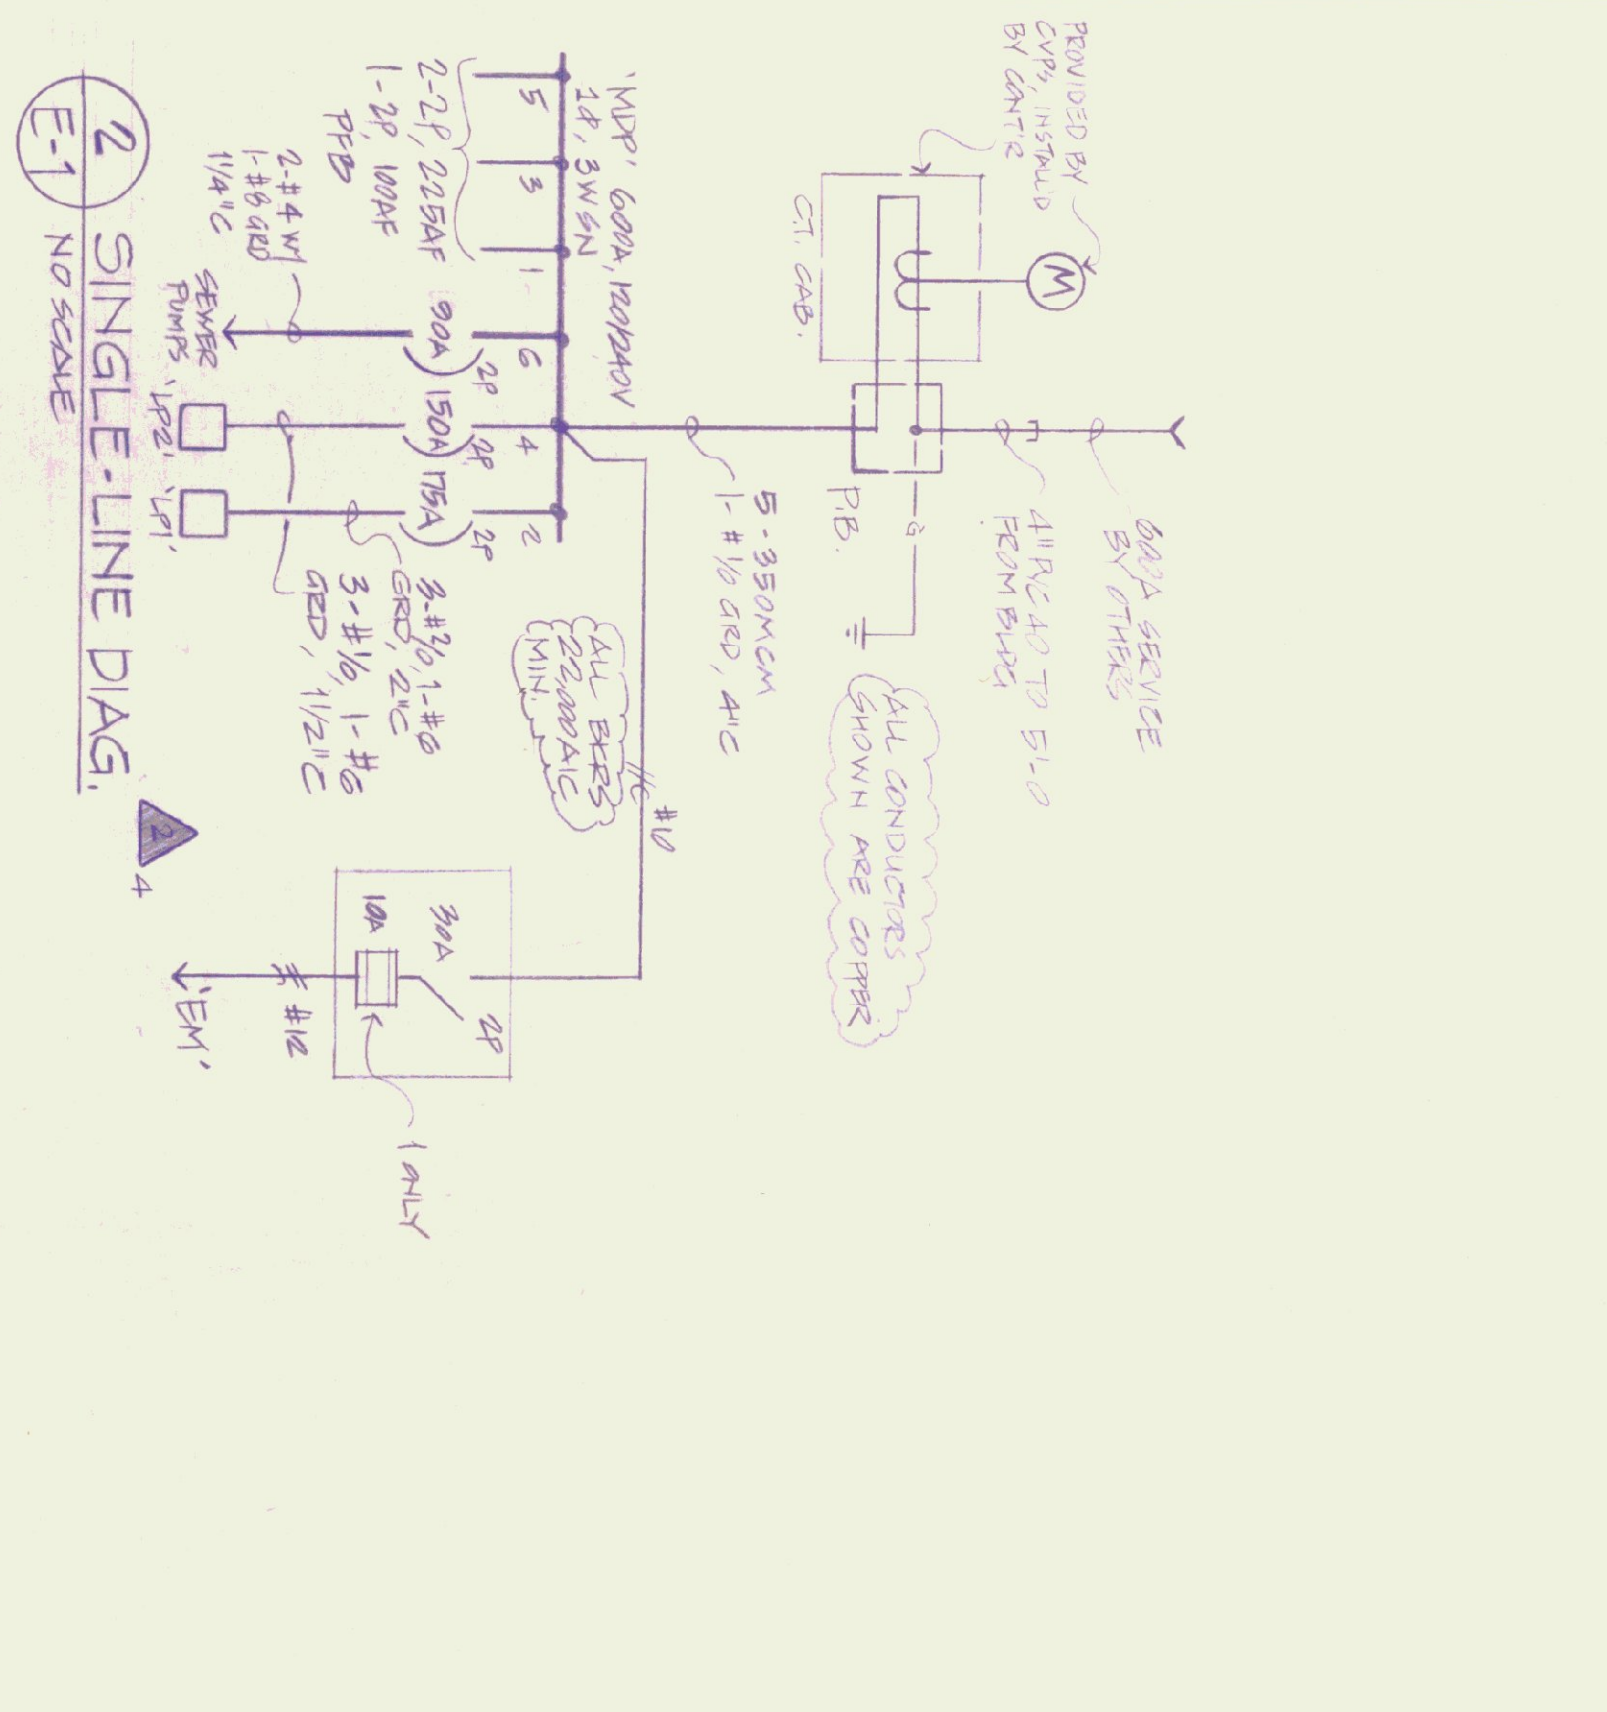

SYMBOL LEGEND

- 1. Branch circuits concealed in ceiling or wall, 2 No. 12 wires in raceway unless otherwise noted. (Each branch indicates number of wires when more than two)
- 2. Branch circuit as shown concealed in floor or ground.
- 3. Auxiliary circuit (1 telephone, 5 sound bell).
- 4. Home run to panelboard or cabinet (No. of wires = No. circuit).
- 5. Fluorescent light fixture, ceiling mounted, with circuit number inside and type designation outside.
- 6. Fluorescent fixture, wall mounted, as above.
- 7. Fluorescent strip fixture, ceiling mounted, as above.
- 8. Fluorescent strip fixture, wall mounted, as above.
- 9. Incandescent fixture, ceiling mounted, as above.
- 10. Incandescent fixture, wall mounted, as above.
- 11. Exit light, ceiling mounted, directional arrow as required.
- 12. Exit light, wall mounted, as above.
- 13. Junction box installed in floor or ceiling.
- 14. Junction box installed in wall.
- 15. Duplex convenience outlet, 20, 3W grounding type, 115V/100V.
- 16. Duplex outlet as shown, SPLIT WIRING.
- 17. Convenience outlet installed in floor.
- 18. Special purpose outlet, rating as noted.
- 19. Clock outlet.
- 20. Telephone outlet.
- 21. Telephone outlet installed in floor.
- 22. Wall switch, single-pole (P = pilot light), +48V (L) ON.
- 23. Wall switch, double-pole.
- 24. Dimmer, rating as noted.
- 25. Panelboard, power.
- 26. Panelboard or local center, lighting.
- 27. Telephone cabinet.
- 28. Electric motor with HP noted.
- 29. Functional HP motor less than 1/8 HP.
- 30. Safety switch, HP-rated, non-reversible unless otherwise noted.
- 31. Magnetic motor starter, across-the-line unless otherwise noted.
- 32. Manual motor starter.
- 33. Dry-type transformer, rating as noted.
- 34. Fire alarm bell station.
- 35. Fire alarm bell with bell diameter noted.
- 36. Fire alarm connection panel.
- 37. Fire alarm control cabinet.
- 38. Fire alarm detector, temperature type.
- 39. Fire alarm detector, smoke type.
- 40. Signal outlet installed in ceiling (L = Intermittent, S = standby, TV = television, M = microphone, PA = public address, V = volume control).
- 41. Signal outlet installed in floor.
- 42. Bell.
- 43. Signal outlet installed in wall.
- 44. Bell.
- 45. Pub. station.
- 46. Buzzer.
- 47. TYPED PROVIDED BY MECH.
- 48. CELL'S FAN, CONTRACTOR PROVIDED
- 49. TYPE 'A' 501, HUNTER 20210/20200
- 50. TYPE 'B' 501, HUNTER 20210/20200
- 51. COMPLETE W/ VARIABLE SPEED CONTROL

ISSUE RECORD

NOI DATE	DESCRIPTION	NOI	PROVIDER
1/23/24	REVISIONS	1	
1/23/24	REVISED	2	
1/23/24	REVISED	3	
1/23/24	REVISED	4	
1/23/24	REVISED	5	
1/23/24	REVISED	6	
1/23/24	REVISED	7	
1/23/24	REVISED	8	
1/23/24	REVISED	9	
1/23/24	REVISED	10	
1/23/24	REVISED	11	
1/23/24	REVISED	12	
1/23/24	REVISED	13	
1/23/24	REVISED	14	
1/23/24	REVISED	15	
1/23/24	REVISED	16	
1/23/24	REVISED	17	
1/23/24	REVISED	18	
1/23/24	REVISED	19	
1/23/24	REVISED	20	

STATE OF VERMONT
DIVISION OF STATE BUILDINGS
AGENCY OF ADMINISTRATION
MONTPELIER, VERMONT

RUTLAND TERMINAL BUILDING AIR 23-2024
MEZZ. ELEC. PLAN & DETS.
RUTLAND STATE AIRPORT
CLARENDON, VERMONT


DATE: 1/23/24
DRAWN BY: [Signature]
SCALE: AS NOTED
APPROVED BY: [Signature]
REVISIONS: 1-11-2-84
REVISED: 1-23-24
DWG. NO.: E-1
14 OF 20

VOLTS 120/240		MAIN BRK	
PHASE	LOSS ONLY	PHASE	LOSS ONLY
BRK TYPE	BRK TYPE	BRK TYPE	BRK TYPE
BRK F.I.C.	BRK F.I.C.	BRK F.I.C.	BRK F.I.C.
1	2	3	4
5	6	7	8
9	10	11	12
997	998	999	1000

VOLTS 120/240		MAIN BRK	
PHASE	LOSS ONLY	PHASE	LOSS ONLY
BRK TYPE	BRK TYPE	BRK TYPE	BRK TYPE
BRK F.I.C.	BRK F.I.C.	BRK F.I.C.	BRK F.I.C.
1	2	3	4
5	6	7	8
9	10	11	12
125	126	127	128
129	130	131	

ISSUE	REVISION	NO
NO DATE	DESCRIPTION	PRINTS
12/1/84	REVISIONS	
12/20/84	SNIPSON YELLOW HITE FOR A	1
	ADDITIONAL CORRECTIONS - 1	2
	SNIPSON YELLOW HITE	
	SIMPSON YELLOW HITE	
	KCE-1 YELLOW HITE	7

P - To Panel
 T - Thermostat
 TS - Time Switch
 EM - Emergency Light Panel
 Z - Zone Valve
 T - Junction Box
 PA - Public Address System
 Tel - Telephone Board
 All Conduits 3/4" Except as Noted

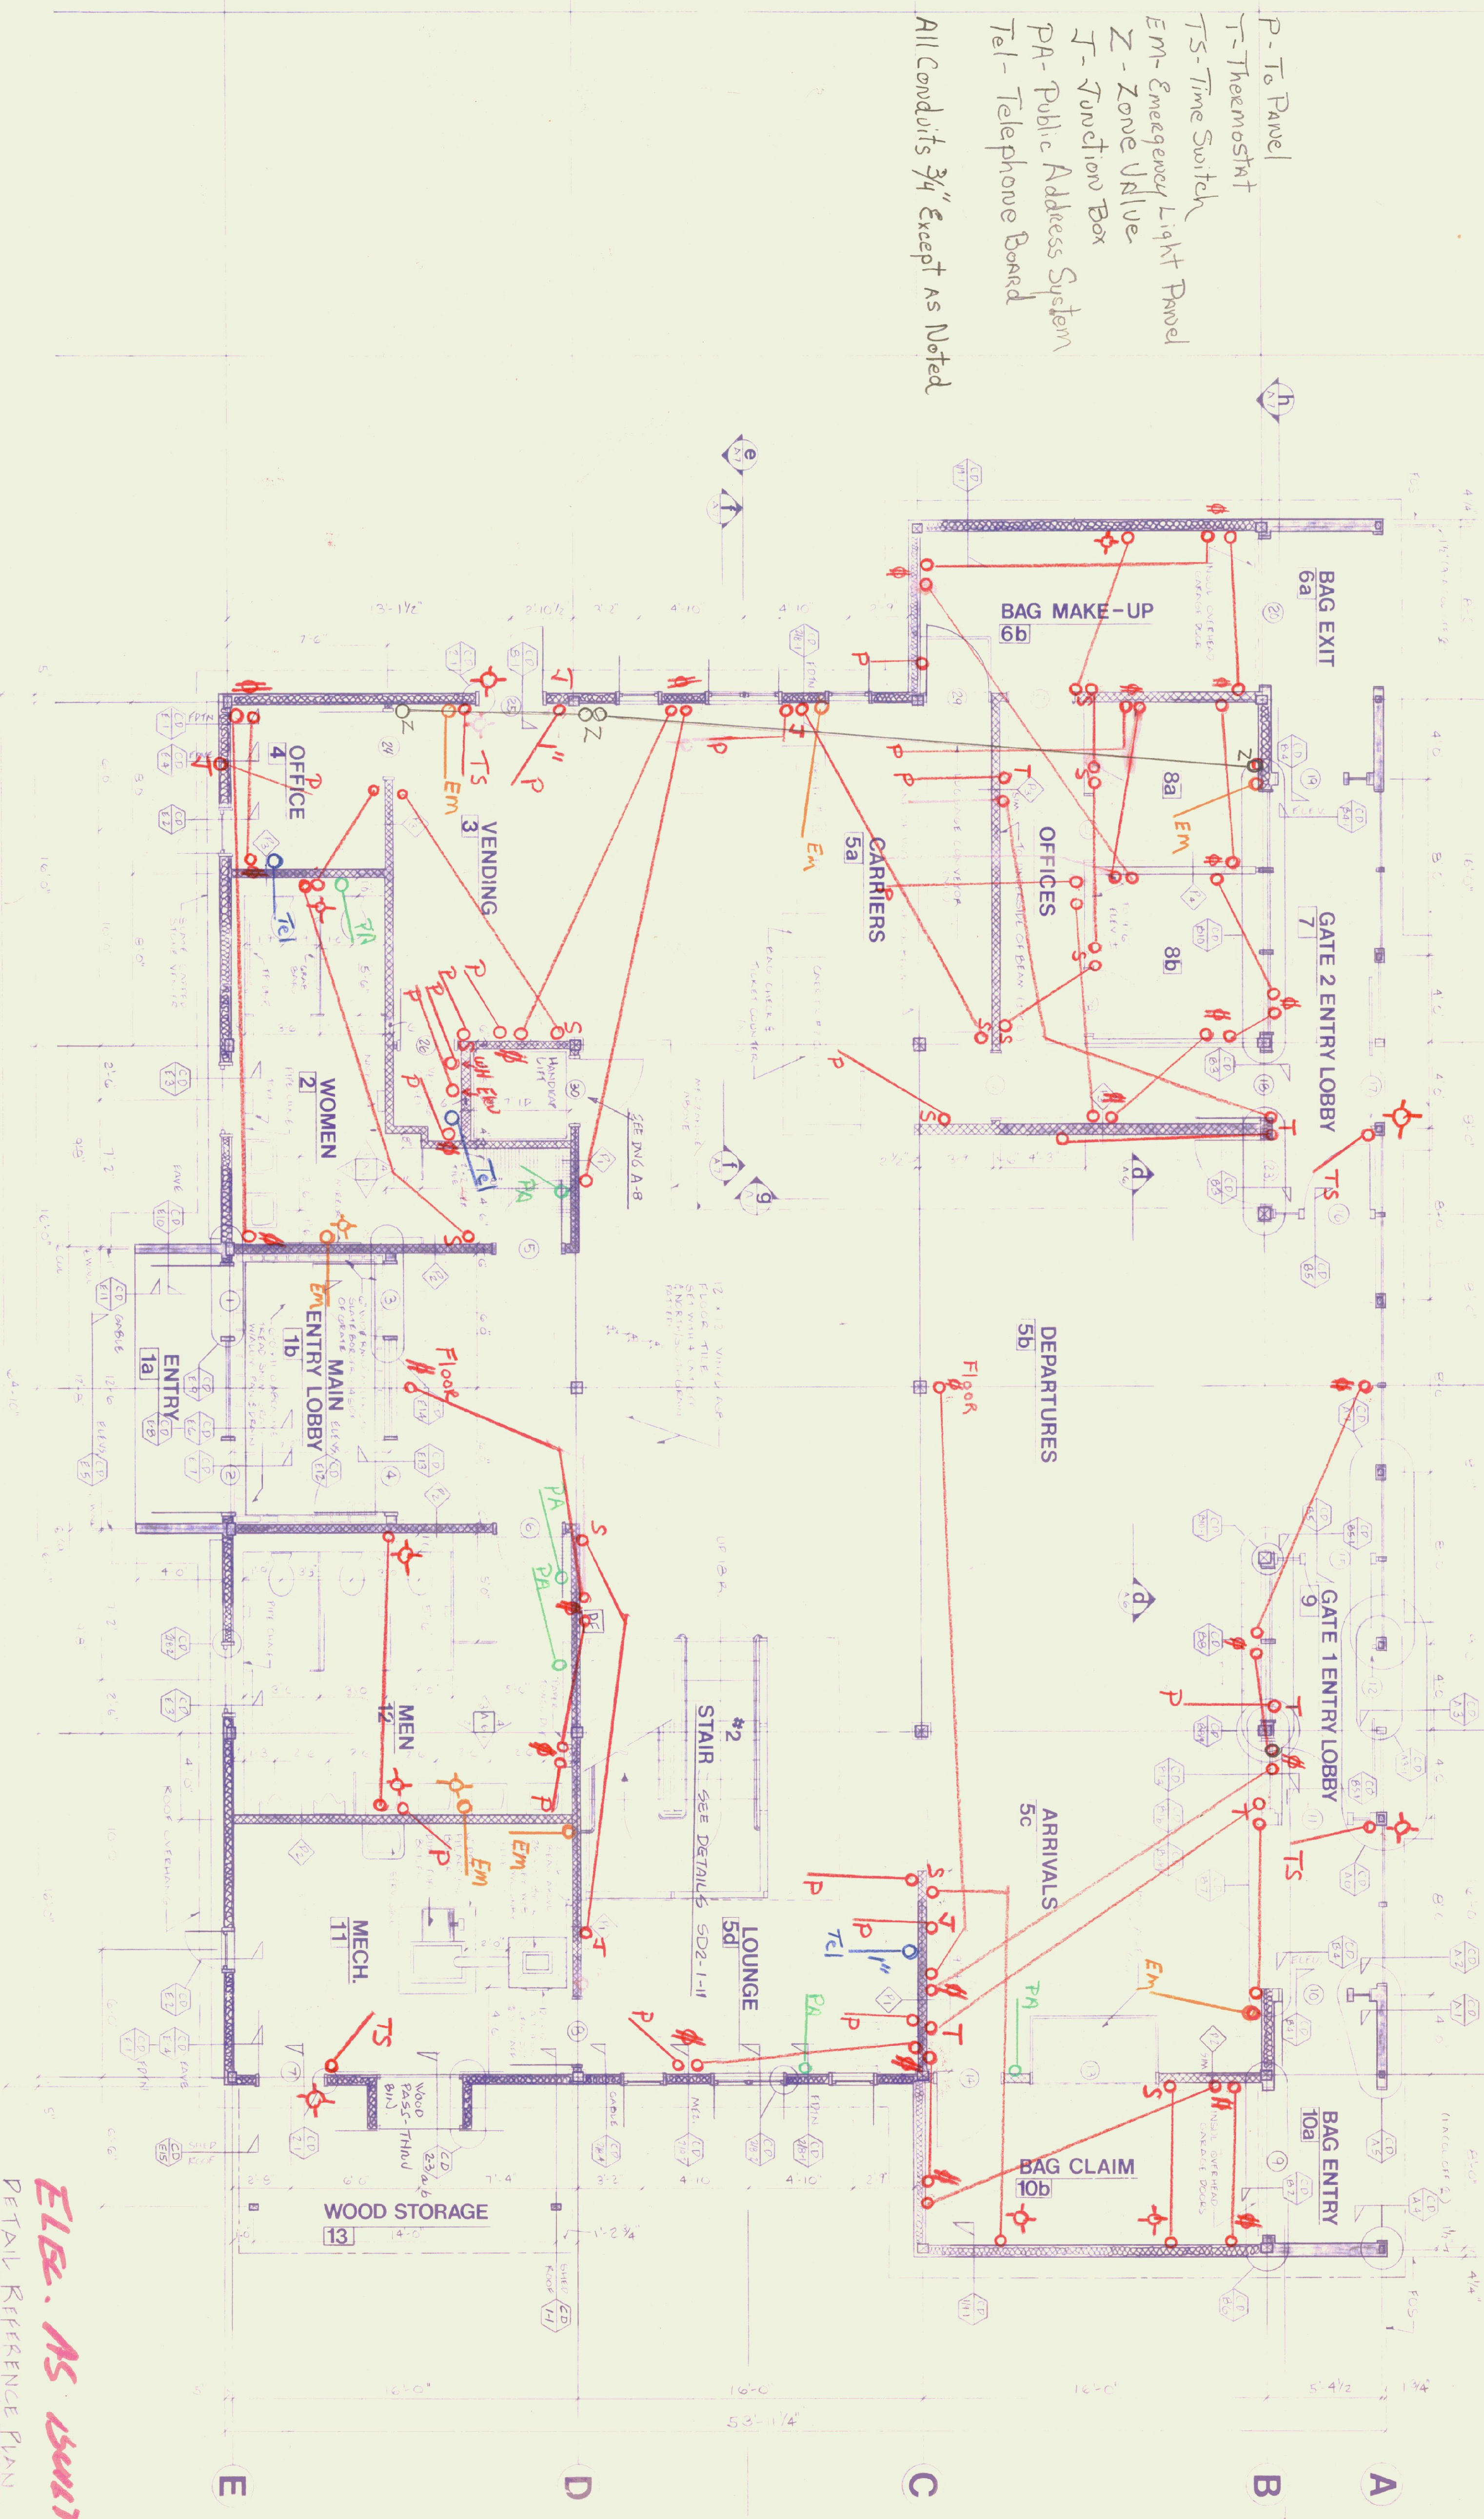


ELB. AS UNIT

DETAIL REFERENCE PLAN


STATE OF VERMONT
 DIVISION OF STATE BUILDINGS
 ADMINISTRATION
 MONTPELIER, VERMONT

RUTLAND TERMINAL BUILDING AIR 23-2024
FIRST FLOOR PLAN

REVISIONS
 NO DATE
 1 2/1/84
 2 12/20/84
 3
 4
 5 2/20

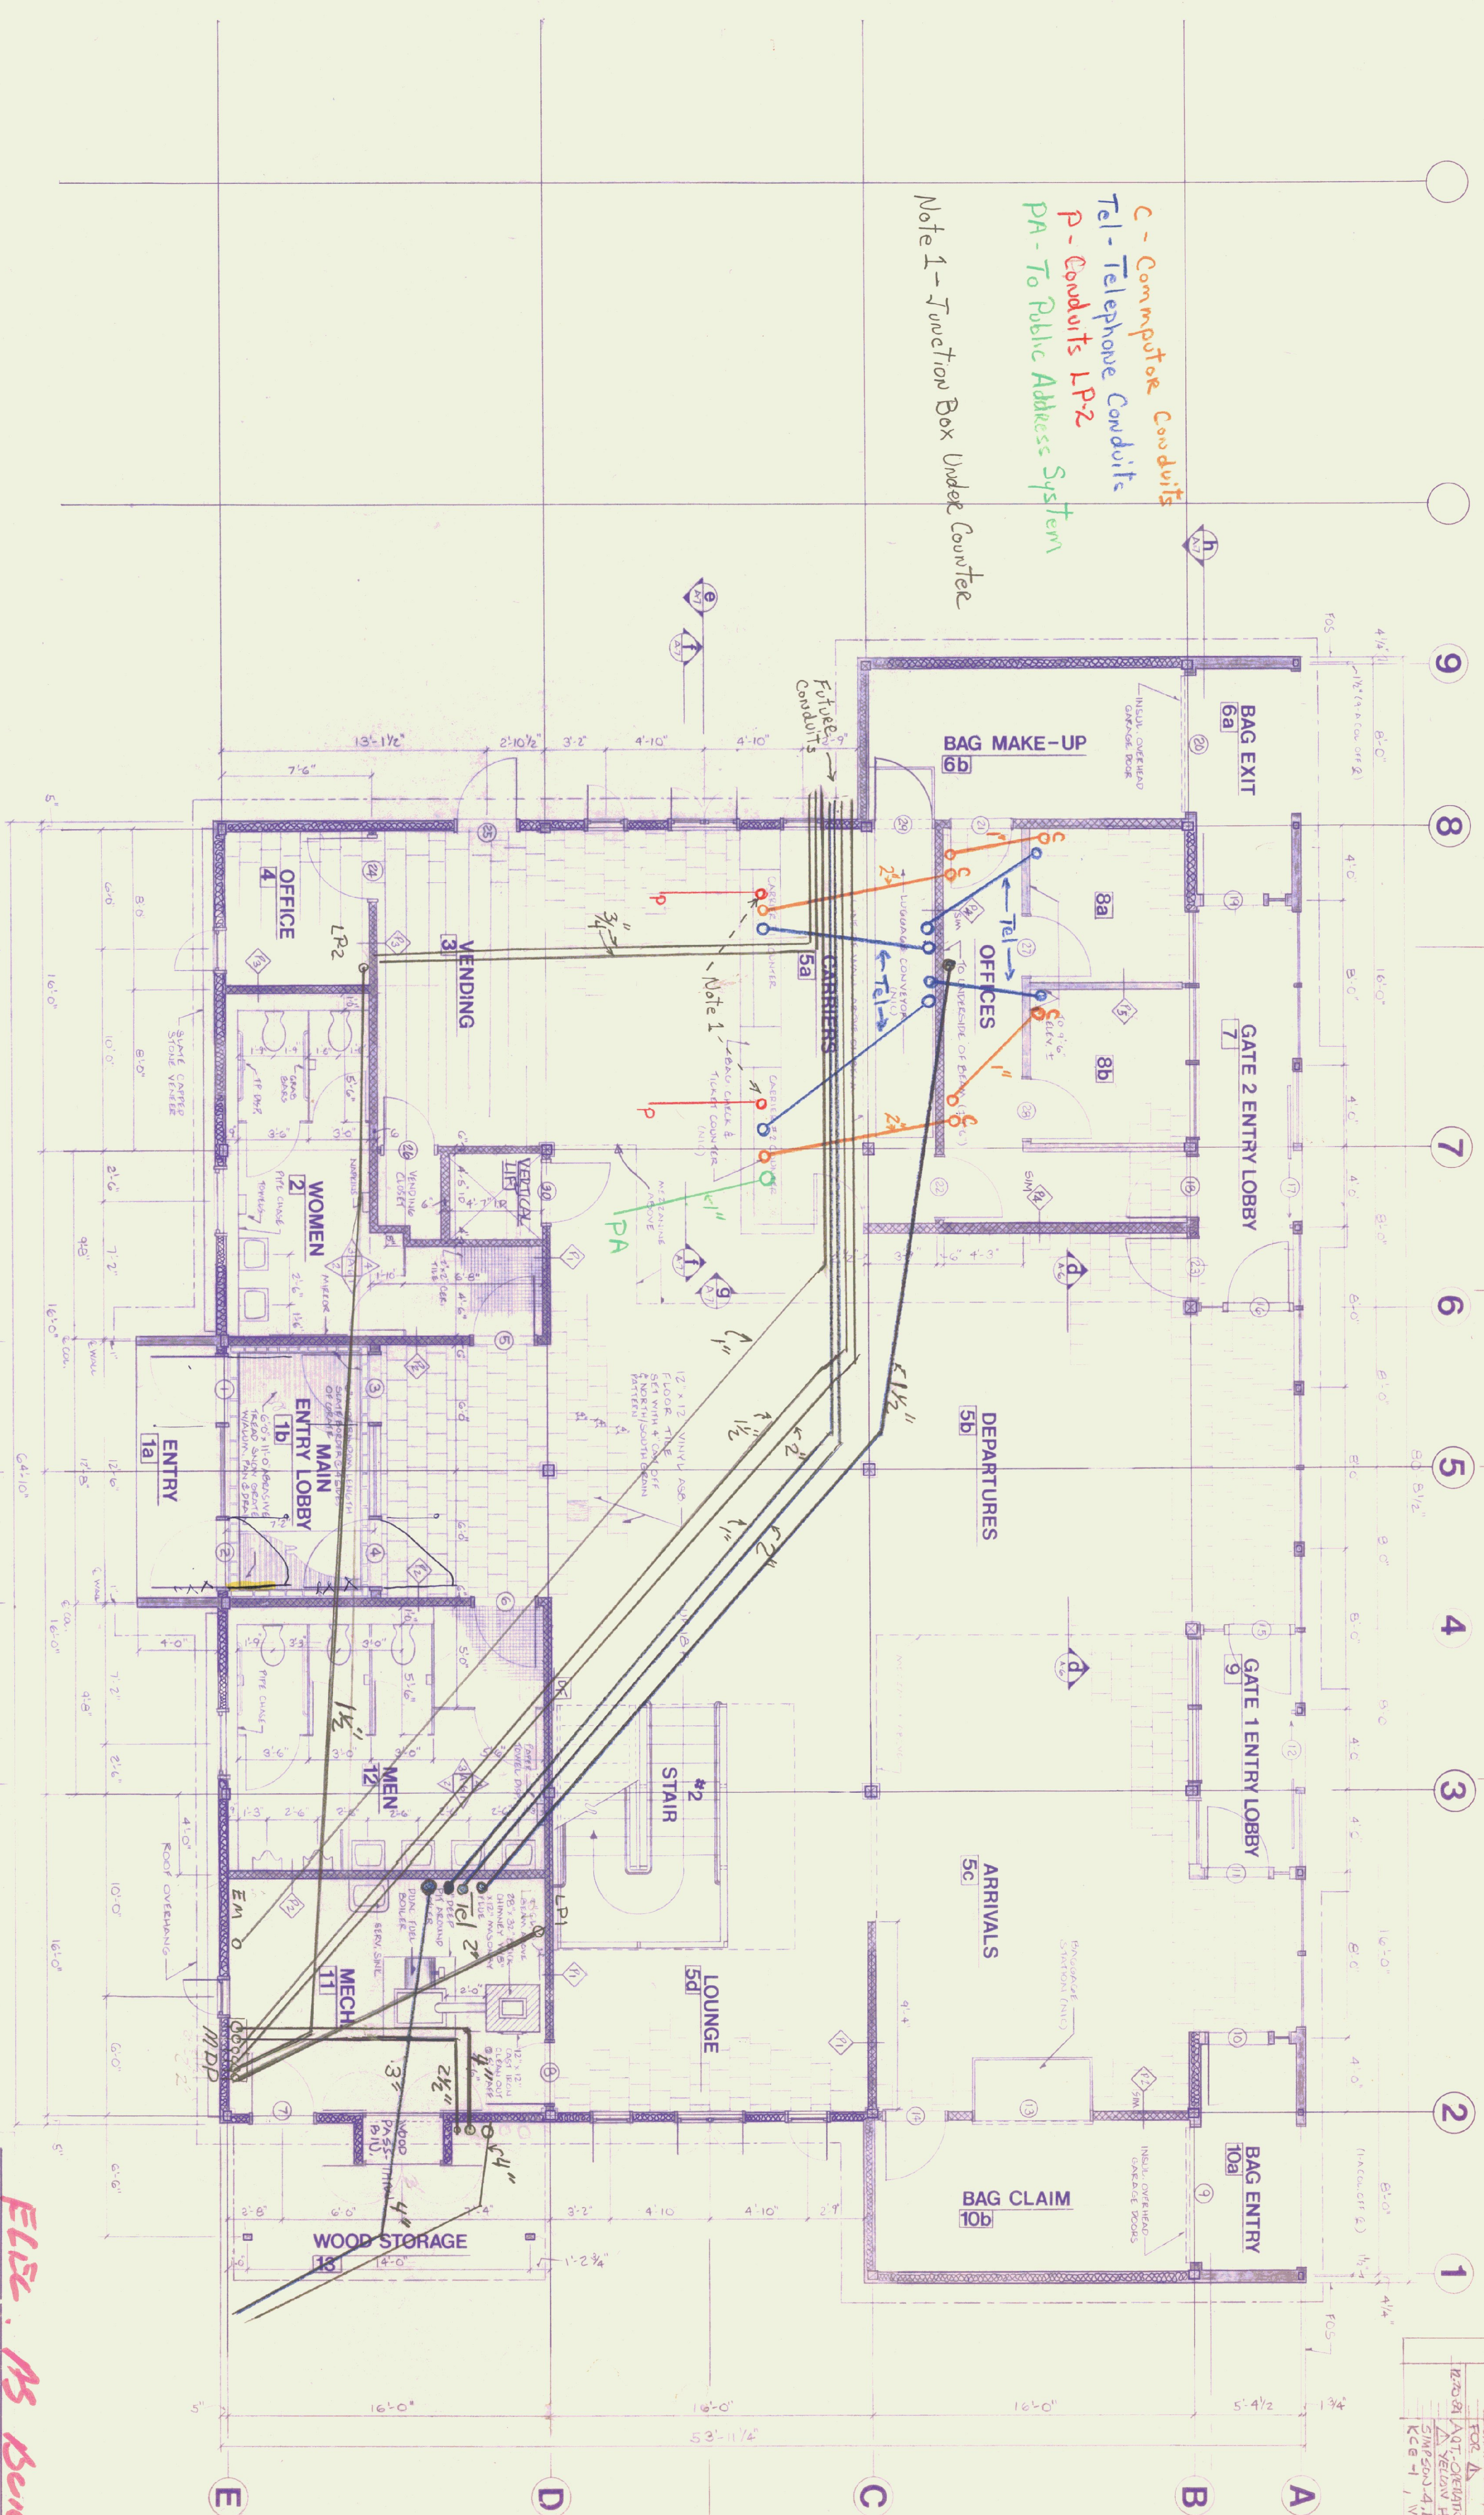

NO.	DATE	DESCRIPTION	BY
1	12/11/24	REVISIONS	SMITHSON-REYNOLDS
2	12/20/24	ADD ORIGINATING FIRM	SMITHSON-REYNOLDS
3	12/20/24	REVISIONS - 1	SMITHSON-REYNOLDS
4	12/20/24	REVISIONS - 1	SMITHSON-REYNOLDS
5	12/20/24	REVISIONS - 1	SMITHSON-REYNOLDS
6	12/20/24	REVISIONS - 1	SMITHSON-REYNOLDS
7	12/20/24	REVISIONS - 1	SMITHSON-REYNOLDS

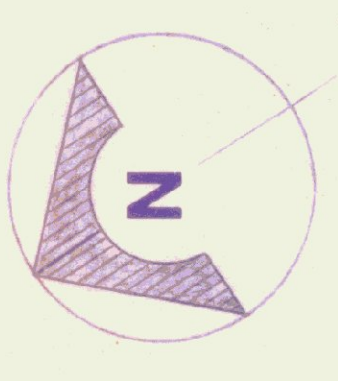

ELIZ. MS BENT

STATE OF VERMONT
 DIVISION OF STATE BUILDINGS
 AGENCY OF ADMINISTRATION
 MONTPELIER, VERMONT
 AIR 23-2024
 PLAN