



THE OVERHANG DOOR IN THIS BAY RESOLVED TO BAY 4-5 AND CHANGED TO 18'-2 WIDE

18'-2 OVER

FLOOR PLAN SCALE 1/4" = 1'-0"

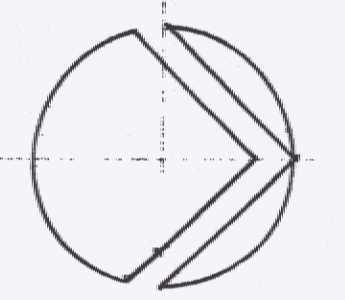

Poor Quality

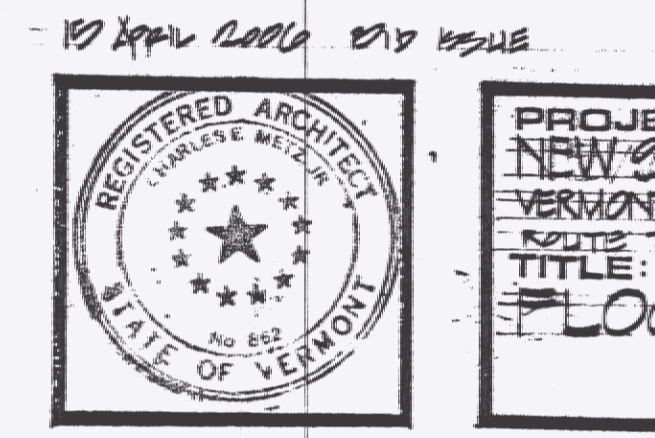

PROJECT: NEW VERMONT ROUTE 2 TITLE: FLOOR PLAN
 CHARLES E. MITCHELL ARCHITECT THE GRIST MILL BRADFORD VT