


12

ROOF SYSTEM NOT BY AFS

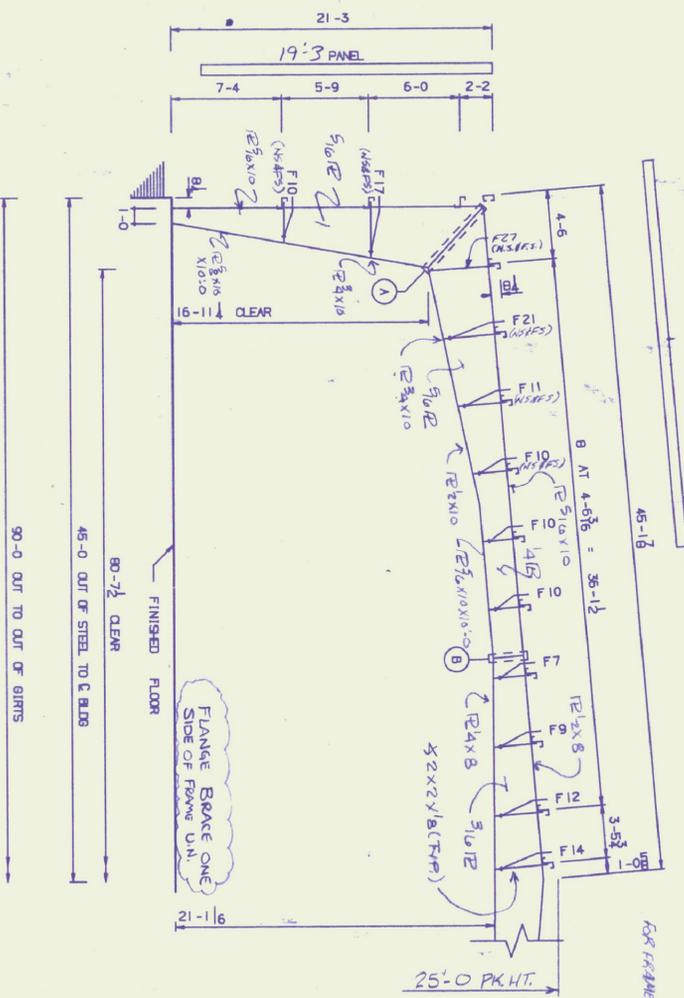


CROSS SECTION
COLUMN LINES 2-4

SLIDE NO.	SIZE	DEPTH
A	28-08 X 2 1/4	4-0
B	16-08 X 2 1/4	2-0

LIVE LOAD (ROOF) ... 50.00 PSF
 LIVE LOAD (FRAME) ... 50.00 PSF
 WIND LOAD ... 90.00 MPH
 SNOW LOAD ... 60.00 PSF
 DEMO LOAD ... 60.00 PSF
 STRUCTURAL COLLATERAL LOAD ... 15.00 PSF
 BUILDING CODE ... 1997 BOCA

NOTE: FASTENERS TO ATTACH TRIM TO ROOF SYSTEM OR ROOF SYSTEM TO PURCHASERS ARE NOT BY AFS

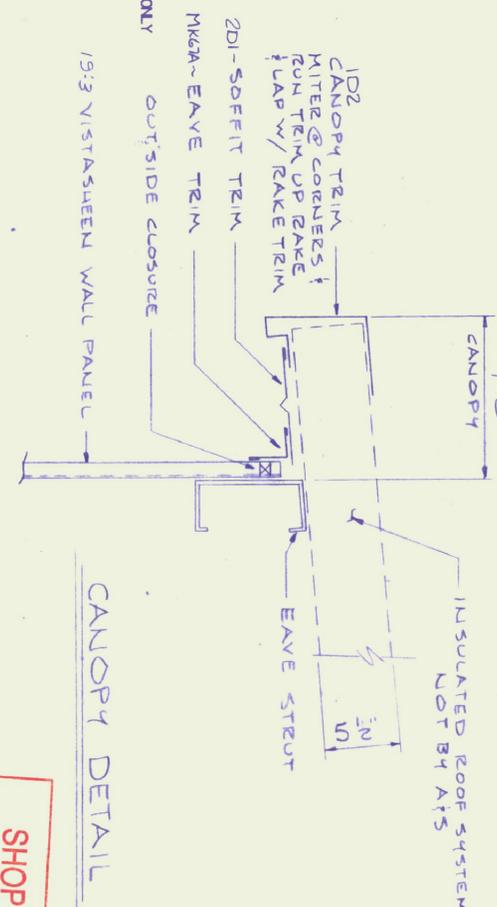

CANOPY DETAIL

FOR FRAME LINE 4

MEMBER	DL	LL	WL
LEFT COL VERN	35.9	17.6	-10.3
LEFT COL HRI	47.4	23.5	-9.8
RIGHT COL VERN	-35.9	-17.5	3.1
RIGHT COL HRI	47.4	23.5	-8.0

FOR FRAME LINES 2-3

MEMBER	DL	LL	WL
LEFT COL VERN	13.4	34.9	-20.6
LEFT COL HRI	18.6	46.0	-18.8
RIGHT COL VERN	-13.4	-34.9	8.3
RIGHT COL HRI	18.6	46.0	-15.4

NOTE: THE FOLLOWING LOAD COMBINATION CASES WERE USED IN DESIGNING THE BUILDING.
 CASE 1: D + LL
 CASE 2: D + LL + WL
 CASE 3: D + LL + WL + W/2
 CASE 4: D + LL + W/2 + WL/2
 THE FOUNDATION DESIGNER SHOULD FACTOR AND COMBINE THE REACTIONS AS REQUIRED.



(TOP) SECTION THRU ENDWALL @ COLUMN LINE 4

SHOP DRAWING REVIEW

No Exception Taken
 Make Corrections Noted
 Revise and Resubmit
 Comments Attached

This check is only for review of general compliance with the design concept of the project and general compliance with the information given in the contract documents. The contractor is responsible for confirming and correlating all quantities and dimensions and performing the work in a satisfactory manner.

CHENETTE ENGINEERING, INC.
 By: *[Signature]*
 Date: 1/28/91

PRINT RECORD

NO.	TO	FOR	DATE

DESCRIPTION: CROSS SECTION
 SIZE: 90' X 60' X 21'-3" LL-50PSF, WL=90QPH, 1/12
 CUSTOMER: DELPHIA CONSTRUCTION CO.
 LOCATION: BERLIN, VT

DRW BY: *[Signature]* CAP
 CHECKED BY: *[Signature]* NONE
 DATE: 1/90
 SCALE: NONE
 ENGINEER: *[Signature]*
 JOB NO.: 290-662
 DWG NO.: E3
 ISSUE: 0

REV	DATE	DESCRIPTION	BY	QD.
0	1/29	FOR CONST	<i>[Signature]</i>	1/29
1	1/29	FOR REWIT	<i>[Signature]</i>	1/29

ERECTOR NOTE:
 ALL HIGH-STRENGTH BOLTS TO BE TIGHTENED BY THE TURN OF THE NUT METHOD. (SEE SPECIFICATION FOR STRUCTURAL JOINTS USING A325 BOLTS)



NOTICE TO BUILDING OFFICIAL:
 APPLICATION OF SEAL IS FOR METAL BUILDING ONLY AND DOES NOT REPRESENT THE PROFESSIONAL OF RECORD.