

# NEW TERMINAL BUILDING, APRON, PARKING LOTS, ACCESS DRIVE FOR BARRÉ-MONTPELIER AIRPORT VERMONT BERLIN,

## FEDERAL-AID AIRPORT PROJECT

### NO. 9-43-005-5905

CIVIL AERONAUTICS ADMINISTRATION  
APPROVED DATE:


CHIEF AIRPORT DIVISION  
DISTRICT AIRPORT ENGINEER

VERMONT AERONAUTICS COMMISSION  
APPROVED DATE:

*[Signature]* DIRECTOR

CITIES OF BARRÉ & MONTPELIER  
APPROVED DATE:

*[Signature]* MAYOR OF CITY OF BARRÉ  
*[Signature]* MAYOR OF CITY OF MONTPELIER

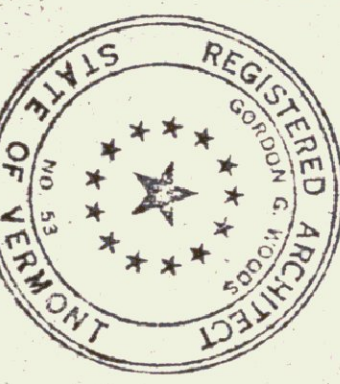

"AS-COMSTRUCTED PLANS"  
I hereby certify that all construction required by this sheet has been accomplished as indicated herein.  
Date *10/16/62*  
*Gordon G. Woods*  
Architect

NEW TERMINAL BUILDING, NEW APRON, PARKING ACCESS ROAD FOR BARRÉ-MONTPELIER AIRPORT VERMONT	
GORDON G. WOODS ARCHITECTS & ENGINEERS ST. JOHNSBURY, VERMONT	
DATE	SEPT. 28
CHECKED BY	FS
DRAWING NO.	586
SCALE	AS BUILT PLANS

DEP. IN CH. AT A.O.T.