



WEST ELEVATION
SCALE: 1/8" = 1'-0"

SOUTH ELEVATION
SCALE: 1/8" = 1'-0"

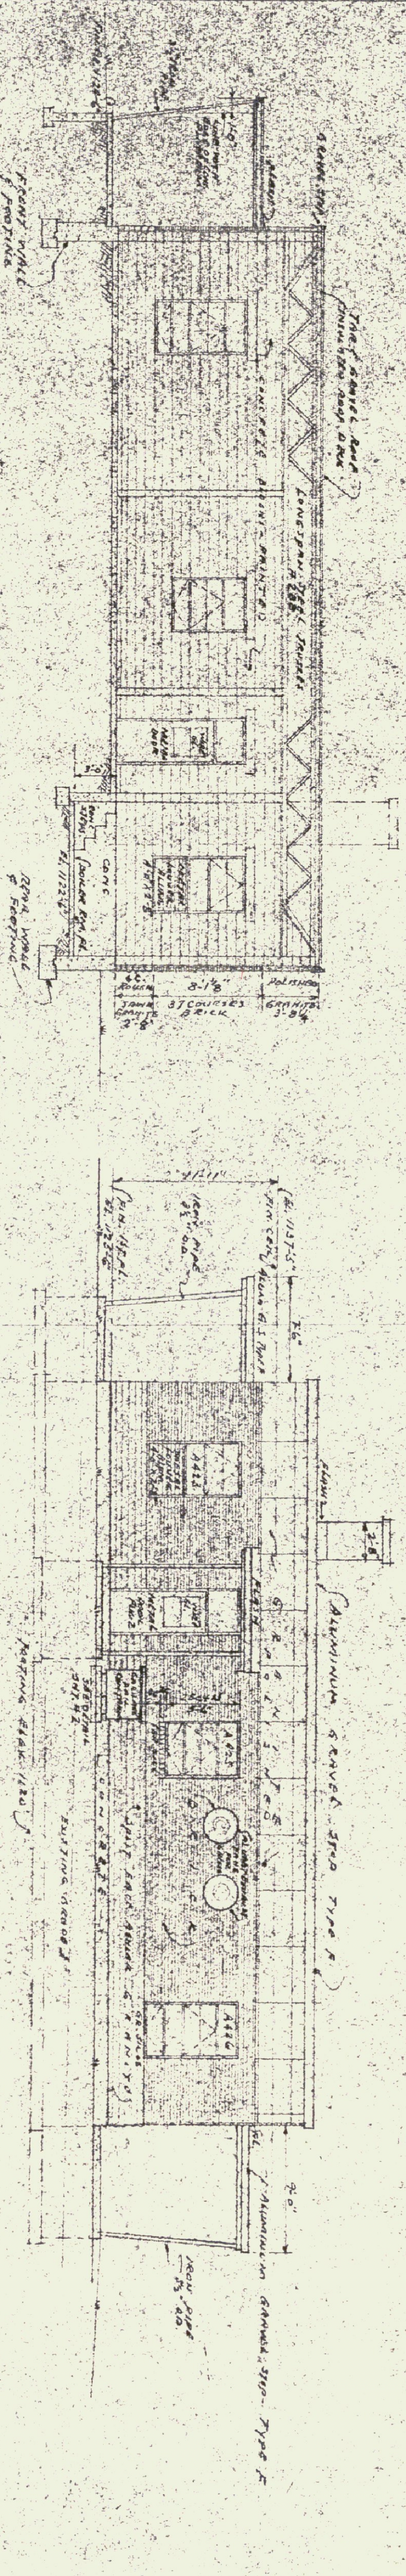

SECTION THRU CATERINA KITCHEN & BOILER RM.
SCALE: 1/8" = 1'-0"


EAST ELEVATION
SCALE: 1/8" = 1'-0"

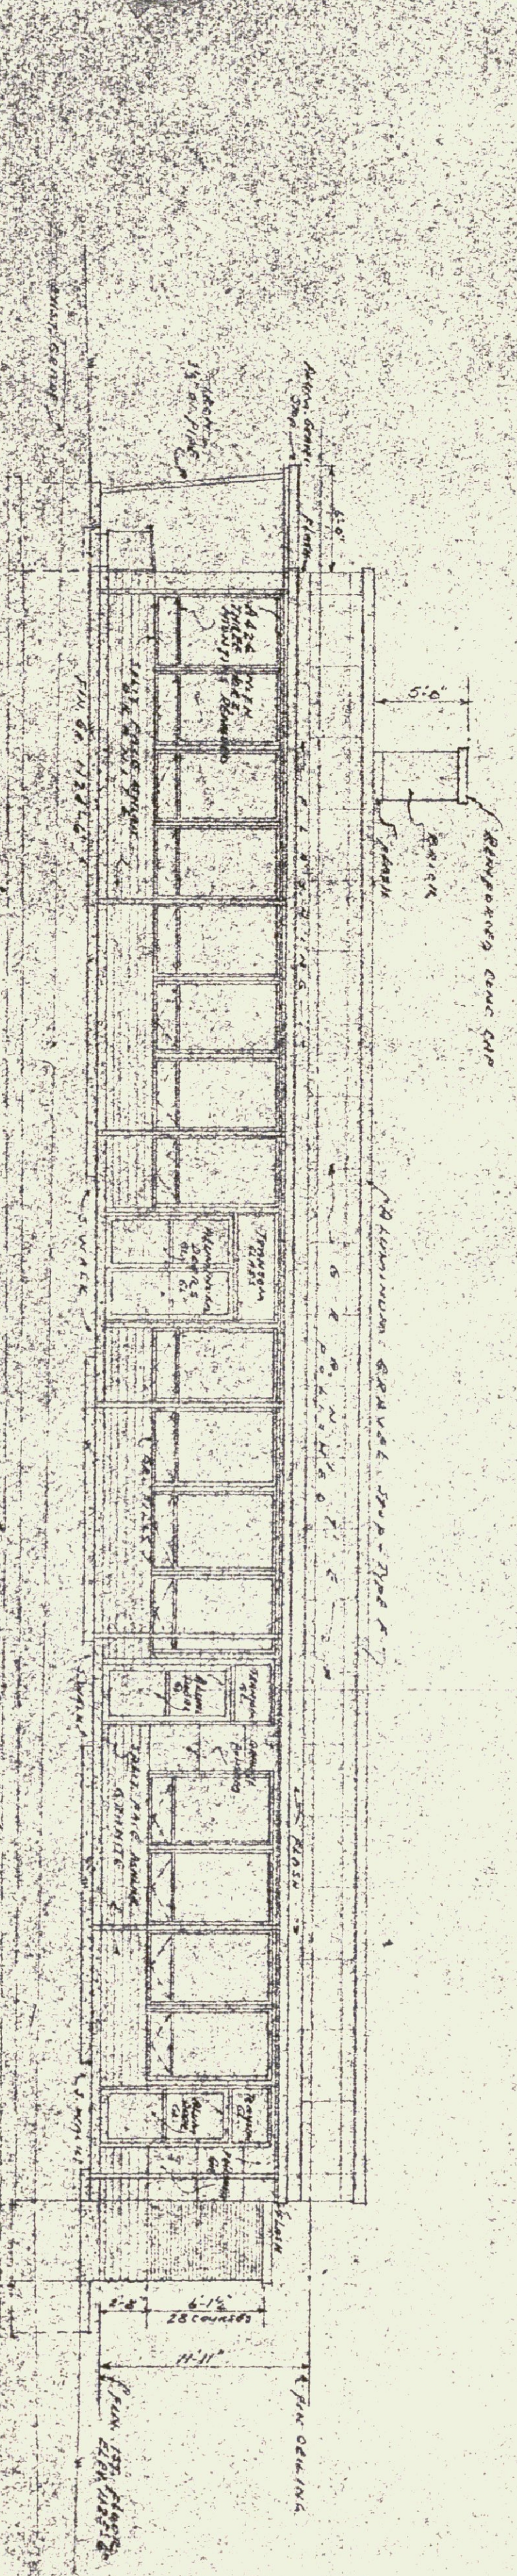

FRONT ELEVATION (RUNWAY)
SCALE: 1/8" = 1'-0"

"AS-CONSTRUCTED" PLANS
I hereby certify that all construction required by this sheet has been accomplished as indicated hereon.
Date *10/1/58*
Gordon G. Woods,
Architect

SCHEDULE 2: 1/2"

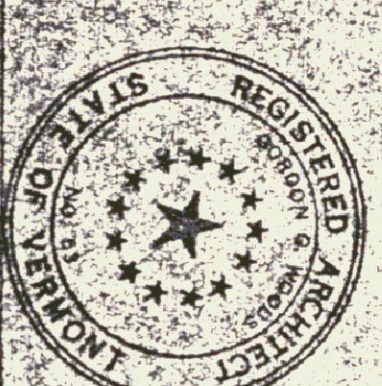

NEW TERMINAL BUILDING	DATE
BARRÉ MONTPELLIER AIRPORT	10/1/58
VERMONT	586
GORDON G. WOODS	DATE
ARCHITECT & ENGINEERS	10/1/58
ST. JOHNSBURY, VERMONT	586