


MAIN ROOF & ROOFS FOR PLATFORM FRAMING

SCALE: 1/8" = 1'-0"

NOTE: ALL WOOD JOISTS TO BE COVERED WITH 1/2" MINIMUM DIMENSION

NOTE: PROVIDE BRACKETS FOR ALL WALL BRACKETS & BEAMS ALL

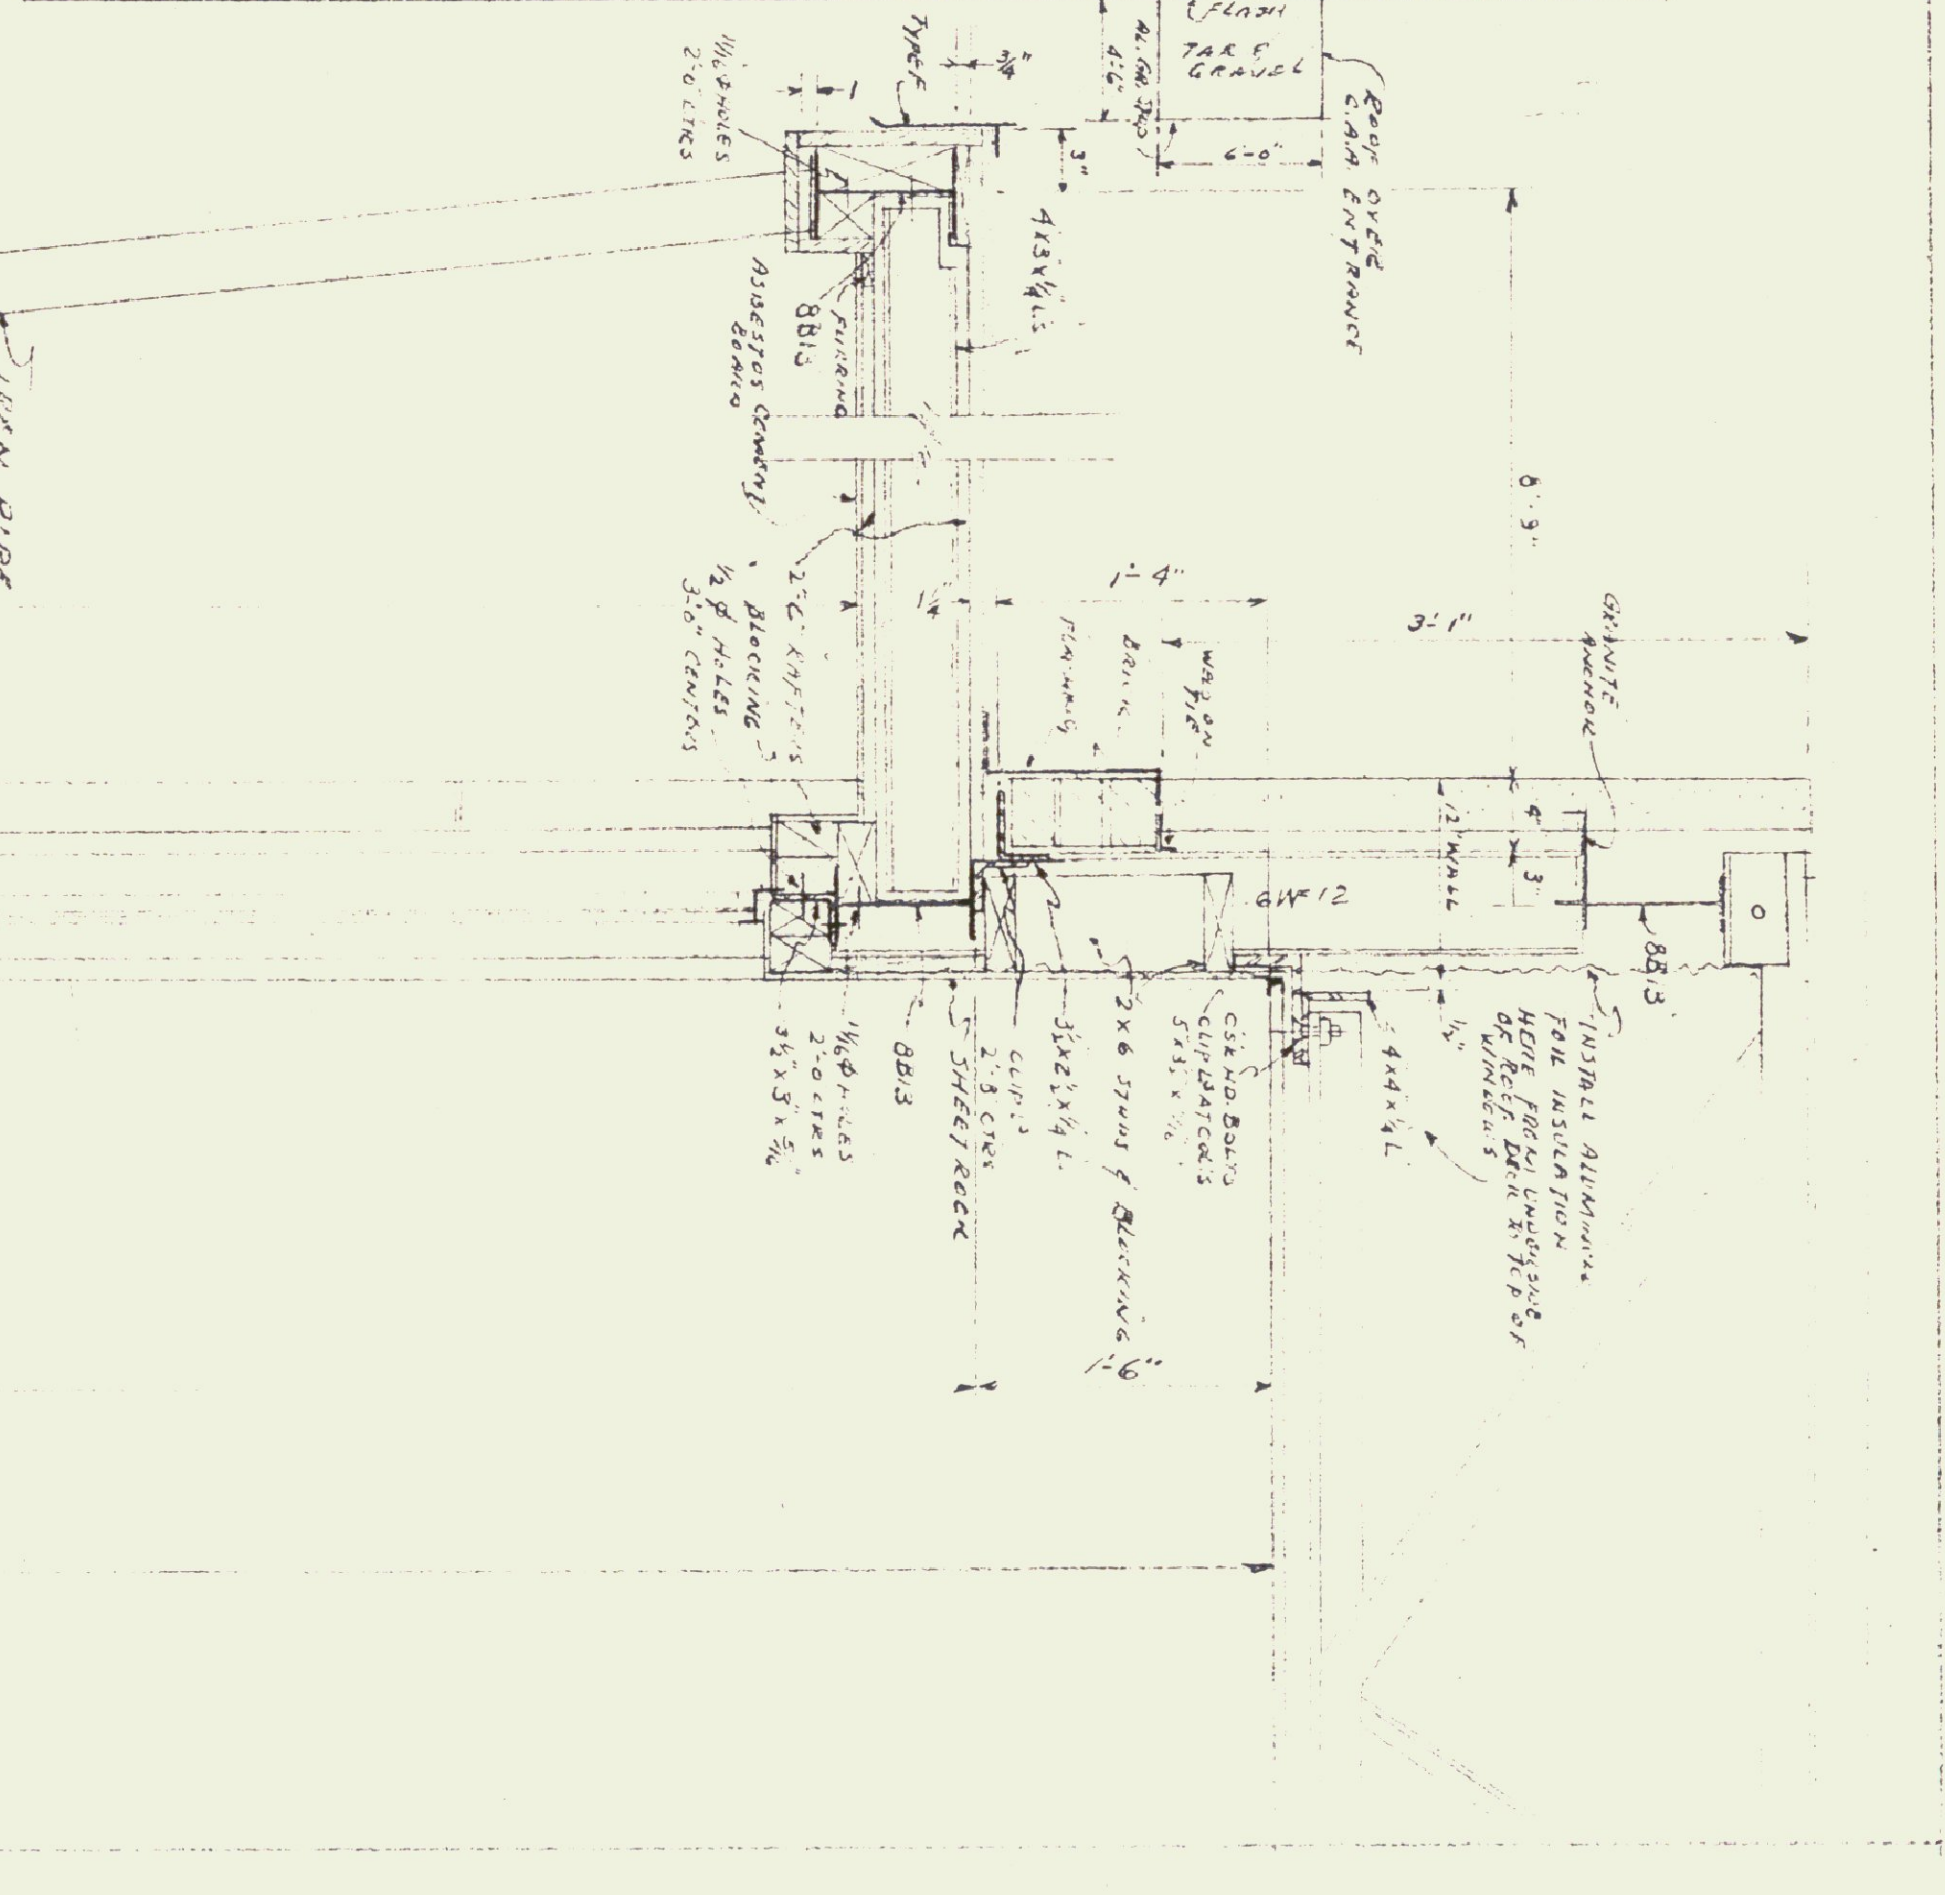

NEW TERMINAL BUILDING
FOR
BARRÉ-MONTELLIER AIRPORT
VERMONT

GORDON G. WOODS
ARCHITECTS & ENGINEERS
ST. JOHNSBURY, VERMONT

DATE: 1/18/42
SHEET NO. 586

"AS-CONSTRUCTED" PLANS

I hereby certify that all construction required by this sheet has been accomplished as indicated hereon.

Date: 1/18/42
Gordon G. Woods,
Architect