

RADIATION SCHEDULE

NO.	QUA.	TYPE	MFG.	MODEL	SIZE (HGT. x L)	RATING PER HOUR	TOTAL CAP. KW/HR	REMARKS
A	3	FINUED RAD. TYPE Q	HEKMAN-NEILON	SER. B, Y3018	8'-0" x 0'-0"	1209	9.7	1/2"
B	1	"	"	"	9'-0" x 0'-0"	"	10.5	1/2"
C	2	"	"	"	10'-0" x 0'-0"	"	12.7	1/2"
D	2	"	"	"	1'-0" x 0'-0"	"	1.2	1/2"
E	1	CONVECTID. TYPE E	"	STANDARD CO.	4" x 24" x 20"	"	4.5	1/2"
F	1	"	"	"	4" x 28" x 20"	"	5.0	1/2"
G	2	"	"	"	4" x 36" x 20"	"	4.0	1/2"
H	1	DMT VENTILATOR	"	HERNELL-COOL	NO. 6700	146.7	146.7	1/2" @ 2.50
I	1	"	"	"	NO. 5000	157.2	157.2	1/2" @ 2.50
J	1	"	"	"	NO. 3000	82.4	82.4	1/4"
K	1	"	"	"	NO. 2000	54.9	54.9	1/4"
L	1	CONSOLE HEATER	"	"	NO. 1220	15.5	15.5	1/4"
M	1	HAIRED RAD. TYPE Q	HERNELL-COOL	NO. 7700 18"	5'-0" x 0'-0"	1209	9.7	1/2"

RADIATION SCHEDULE

FIRST FLOOR PLAN


SCALE: 1/8" = 1'-0"

"AS-CONSTRUCTED" PLANS

I hereby certify that all construction required by this sheet has been accomplished as indicated herein.

Date: 10/10/60
 Gordon G. Woods,
 Architect

NOTE
 PROVIDE AIR MAKE LOUVERS - MASONRY WALL TYPE. HEAVY DOWSE REWORK. IN THESE SECTIONS WHERE FT. LOUVER SIZES ARE GIVEN.

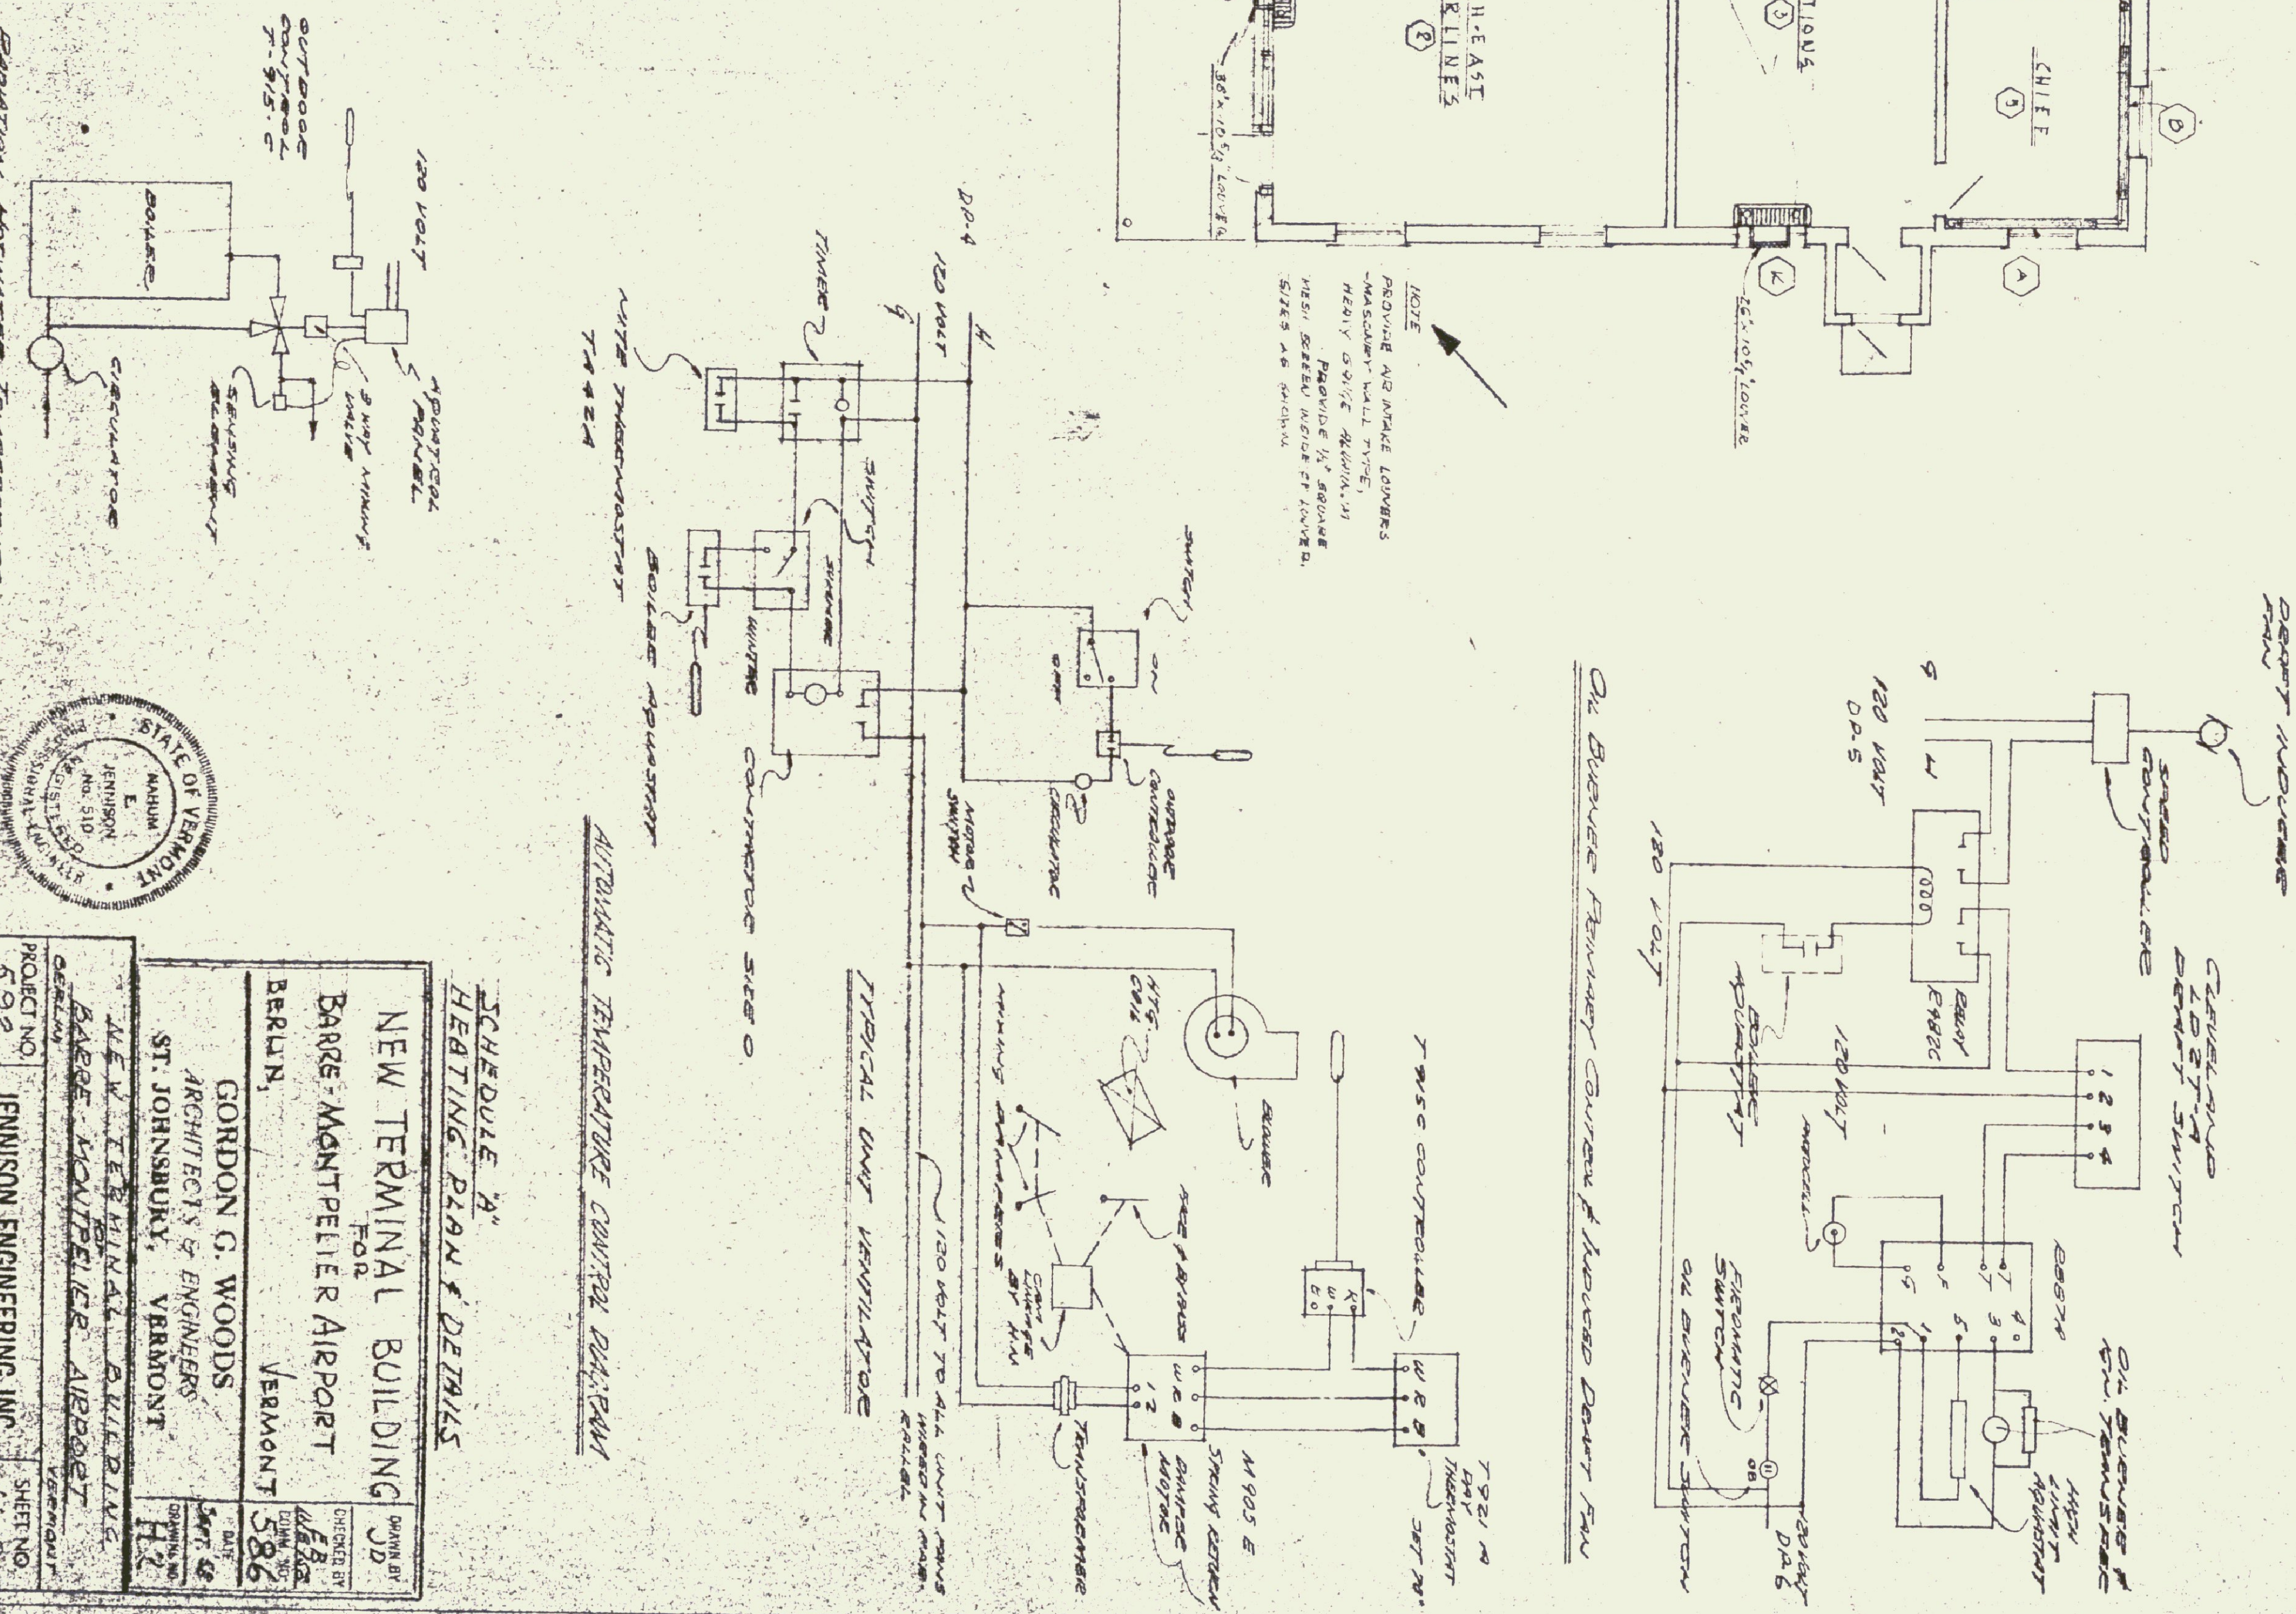

AUTOMATIC TEMPERATURE CONTROL DIAGRAM


SCHEDULE "A" HEATING PLAN & DETAILS

NEW TERMINAL BUILDING
 FOR
BARRE-MONTPELIER AIRPORT
 VERMONT

GORDON G. WOODS
 ARCHITECTS & ENGINEERS
 ST. JOHNSBURY, VERMONT

NEW TERMINAL BUILDING
 BARRE-MONTPELIER AIRPORT
 VERMONT

JENNISON ENGINEERING INC.
 CONSULTING ENGINEERS
 15 CENTER ST. BURLINGTON, VT. TEL. 260-3300

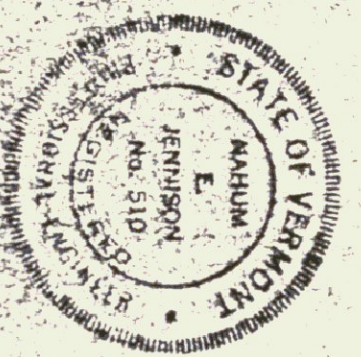

PROJECT NO. 592
 DRAWN BY: J. W. BROWN, No. 118
 E. M. SAWYER, No. 794
 DATE: 9-29-60