
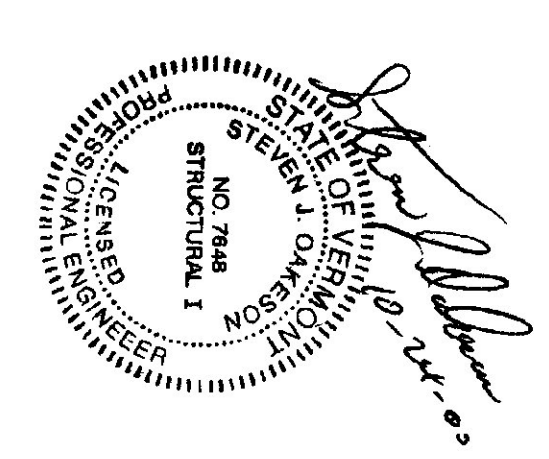


Frame Member Schedule	Mem.	Part	Width	Thick.	Webthk	Depth	Depth	Approx. Lqth	A325 Bolt Connection & Plate Schedule	Frame Clearances
1	CR005	5"	1345	1345	1345	8"	8"	11'-6 5/8"	ID Qty Bolt Dia. Length Thick. Out In Bolt	Horiz. Clearance between members 1 and 8: 34'-4 3/4"
2	BEX002	5"	1050	26.1050	8 1/2"	8 1/2"	8 1/2"	18'-11 3/8"	A 4 1/2" 1 1/2" 3/8" 1	Vert. Clearance at member 1: 14'-9 5/16"
3	BEX002	5"	1050	26.1050	8 1/2"	8 1/2"	8 1/2"	18'-11 3/8"	B 6 3/4" 2" 1/2" 1/2" 2	Vert. Clearance at member 8: 14'-9 5/16"
4	CR005	5"	1345	1345	1345	8"	8"	11'-6 5/8"	C 4 1/2" 1 1/2" 3/8" 1	Vert. Clearance at member 9: 20'-6 1/16"
5	BEX002	5"	1345	1345	1345	8"	8"	17'-6 1/16"	Denoted with hexagon	Finished Floor Elevation = 0'-0" (unless Noted Otherwise)
6	BEX002	5"	1345	1345	1345	8"	8"	17'-6 1/16"	Denoted with circle	

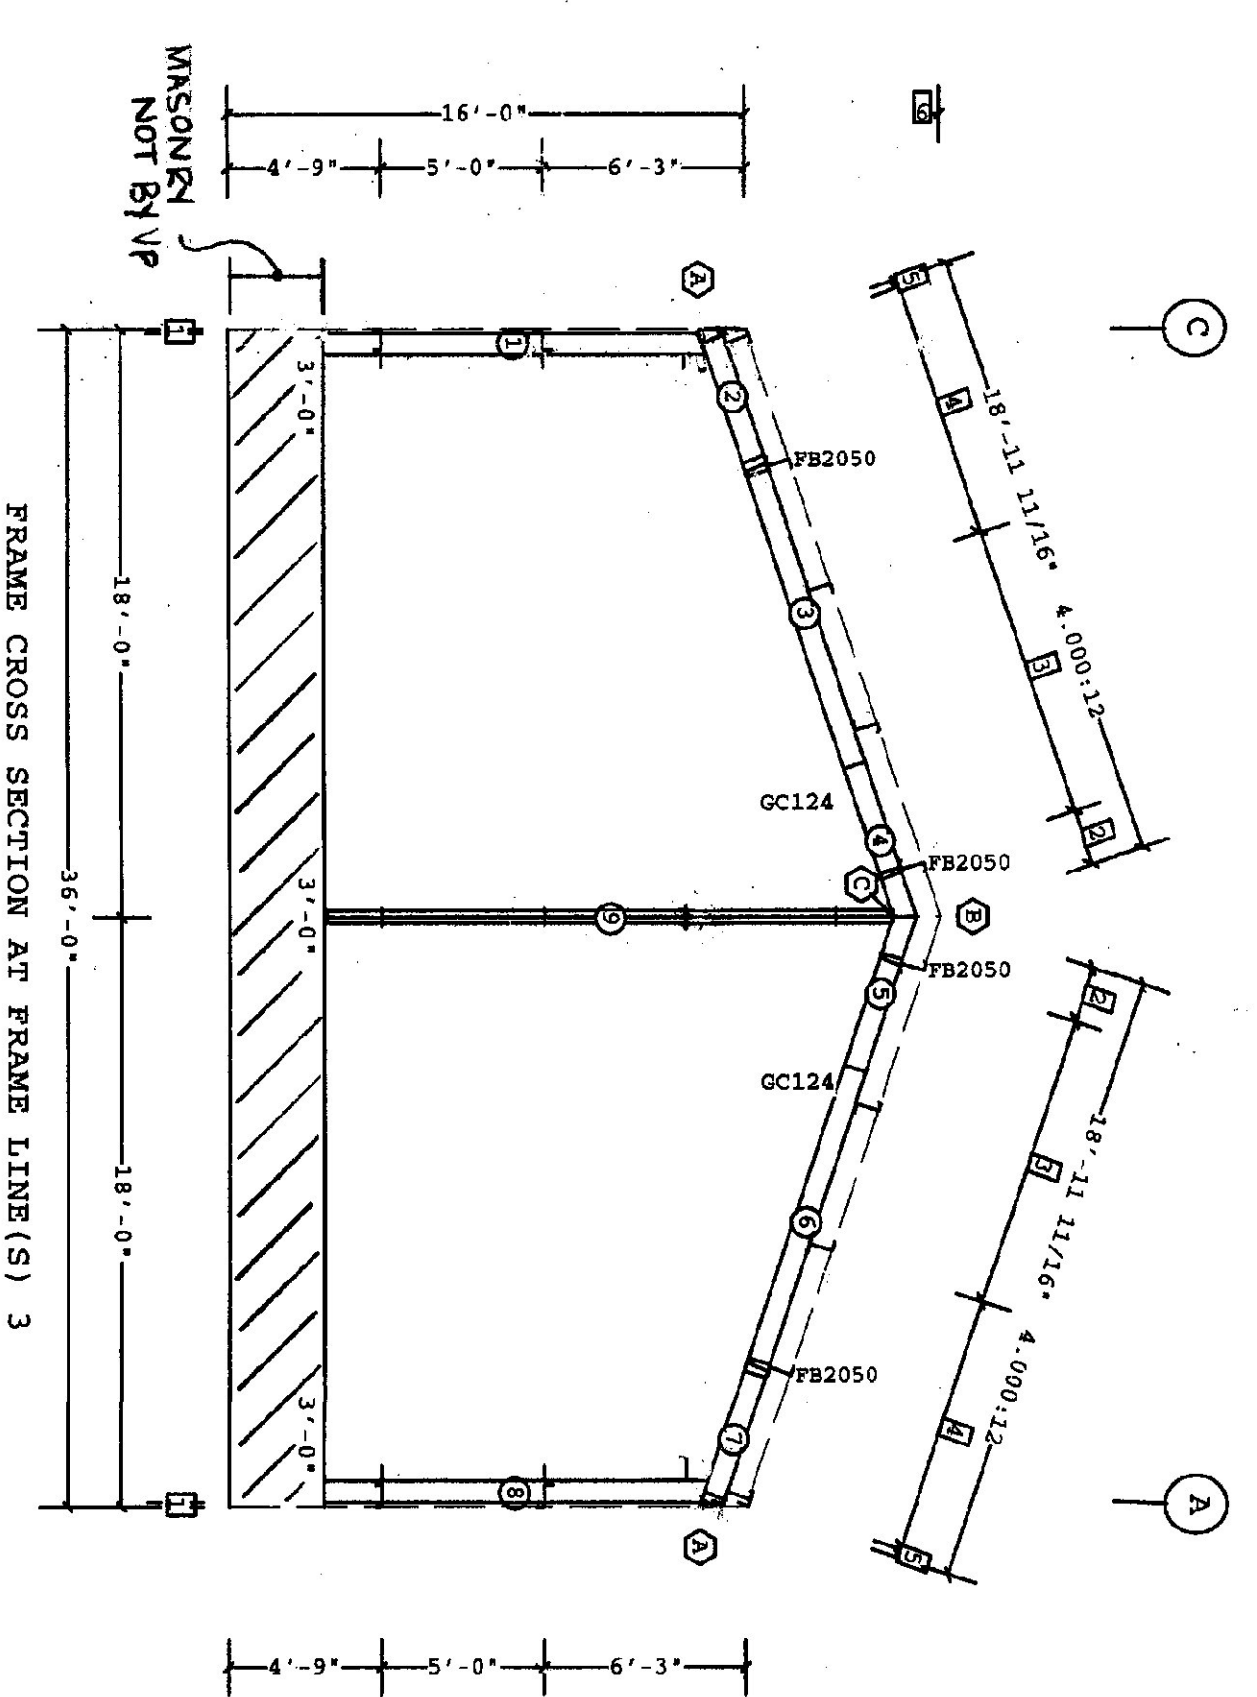

- Dimension Key
- [1] 1 5/8"
  - [2] 1'-8 13/16"
  - [3] 2 3/4"-6"
  - [4] 2 3/4"-11 7/8"
  - [5] 3 1/16"
  - [6] 23'-0"
- Denoted with rectangle

1. USE 1/2" DIA. A193 BOLTS FROM FOUNDRY TO FRAME, GIRTS TO FRAME. AND GIRTS TO CLIP CONNECTION MEMBERS NOTED OTHERWISE. END USE BOLTS FROM STEEL MANUFACTURER.		VP REF.: Single Frame - Storage Along Wall & Frame 3	
THIS DRAWING IS THE PROPERTY OF THE ENGINEER. IT IS TO BE USED ONLY FOR THE PROJECT AND SITE SPECIFICALLY IDENTIFIED HEREON. IT IS NOT TO BE REPRODUCED, COPIED, OR TRANSMITTED IN ANY FORM OR BY ANY MEANS, ELECTRONIC OR MECHANICAL, INCLUDING PHOTOCOPYING, RECORDING, OR BY ANY INFORMATION STORAGE AND RETRIEVAL SYSTEM, WITHOUT THE WRITTEN PERMISSION OF THE ENGINEER.		BUILDING CODE: SBORCA WIND SPEED: 70.00 mph SEISMIC HAZARD CATEGORY: 1 SHOW REPEATER CATEGORY: 1 BUILDING USE: STORAGE STRUCTURE	
FOR CONSTRUCTION		FRAME CROSS SECTION AT FRAME LINE(S) 3	
DATE	BY	DATE	BY
10/23/2000	VP	10/15/04	VP
PROJECT: VP BUILDINGS, INC. 1300 PRAYER CLUB CIRCLE MEMPHIS TN 38125		DRAWING: M20012201-01081-VP	
SCALE: AS SHOWN		DATE: 10/22/00	
TIME: 12:00:00		TIME: 12:00:00	
VERSION: 2.0		TIME: 4:07:20	