


- Part Mark Key
 (1) 003J0408414
 (2) DN0300017
 (3) JBC1
 (4) JBC1
 (5) JCP052090
 (6) GFA106
 (7) GFA200
 Denoted with hexagon


Framed Opening Locations

Id	Width	Height	Sill Ht.	Frame To	Dimen.
PO1	3'-0"	4'-0"	4'-9"	1	Jamb-L, 6'-3"
PO2	3'-0"	4'-0"	4'-9"	2	Jamb-L, 1'-9"

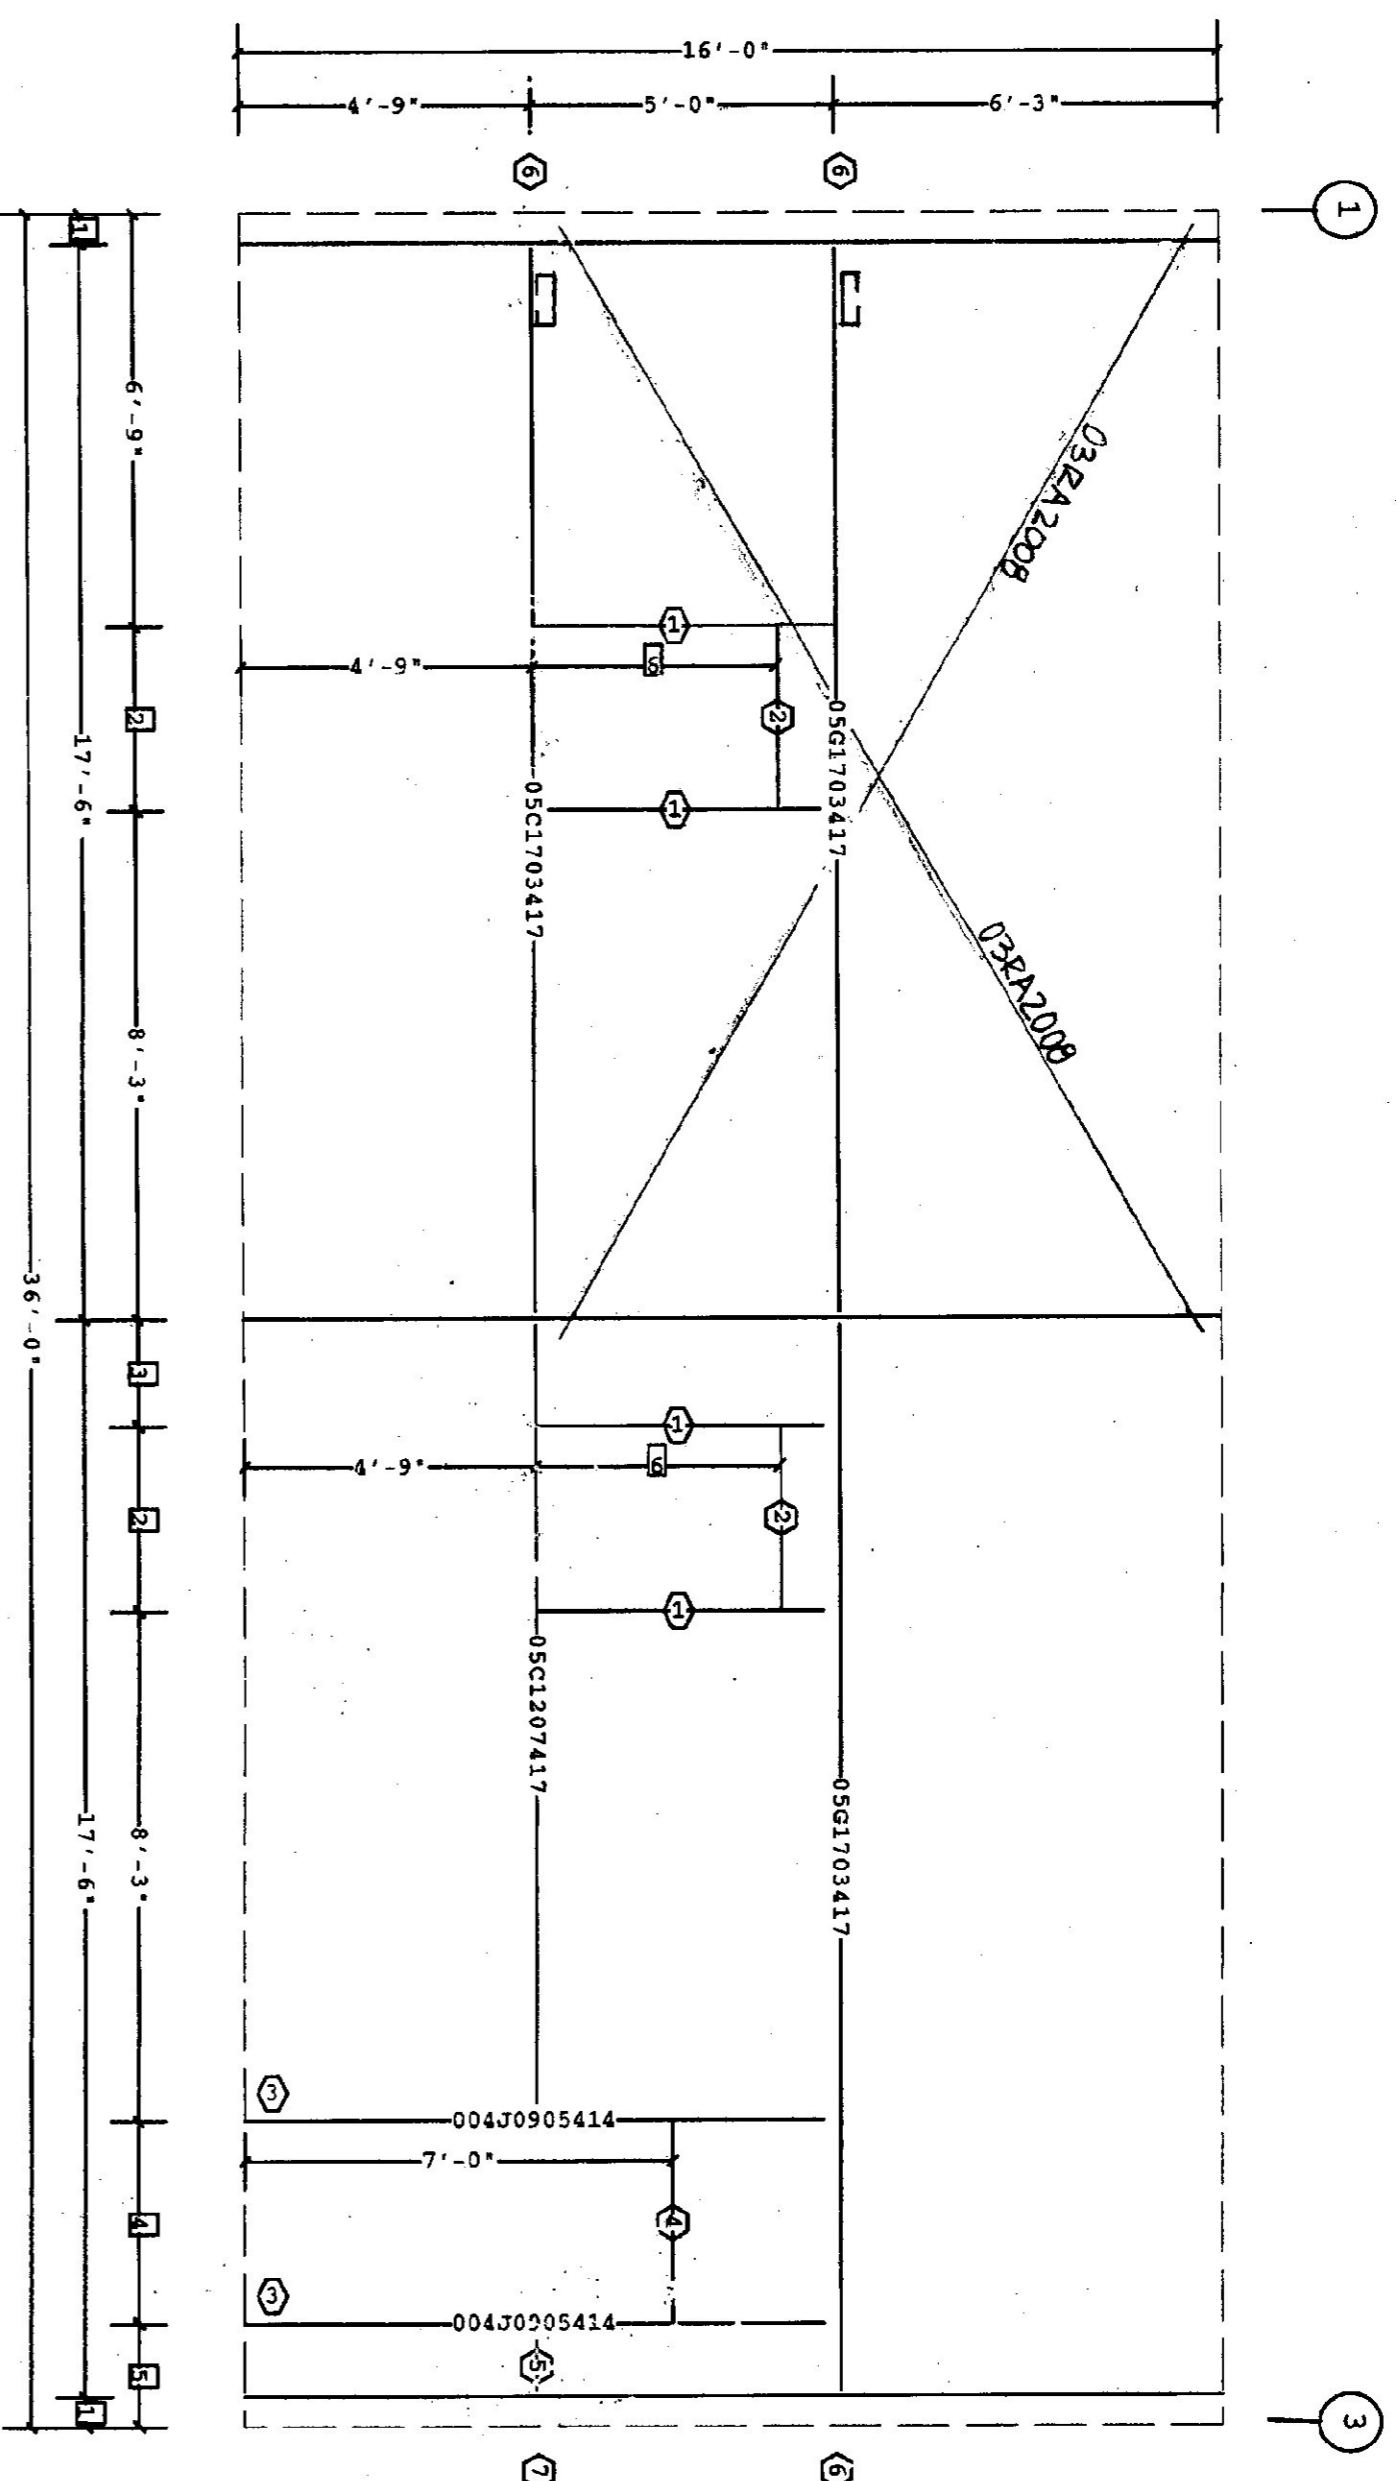

- Dimension Key
 [1] 9'-0"
 [2] 3'-9"
 [3] 1'-9"
 [4] 3'-4"
 [5] 1'-8"
 [6] 4'-0"
 Denoted with rectangle

SECONDARY ELEVATION AT C

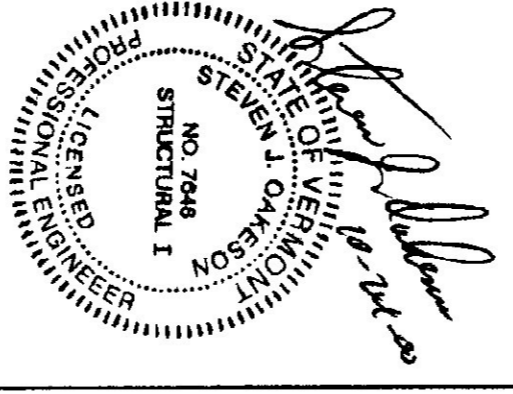

Handwritten signature and date: S.J. Oakerson 10/22/00

<p>1. UNLESS NOTED, USE 1/2" DIAMETER A-315 BOLTS FOR GIRT LAF, GIRT TO FRAME, FRAME BRACE TO FRAME, FRAME BRACE TO GIRT, JAMB AND FRAME CONNECTIONS AND FRAME TO FRAME CONNECTIONS. ALL CONNECTIONS SHALL BE INSTALLED IN ACCORDANCE WITH THE REQUIREMENTS OF THE WALL STRUCTURAL AND ROOF SHEET. REMOVAL OR ALTERATION OF WALL BRACING WITHOUT PRIOR AUTHORIZATION IS PROHIBITED.</p>	<p>THE VP BUILDINGS & REAL ESTATE GROUP, INC. IS THE DESIGNER OF RECORD FOR THIS PROJECT. THE DESIGNER'S RESPONSIBILITY IS LIMITED TO THE DESIGN OF THE STRUCTURE AS SHOWN ON THESE DRAWINGS. THE DESIGNER DOES NOT WARRANT THE ACCURACY OF ANY INFORMATION PROVIDED HEREON. THE DESIGNER SHALL NOT BE RESPONSIBLE FOR ANY DAMAGE TO PERSONS OR PROPERTY CAUSED BY THE USE OF THIS DRAWING OR FOR ANY OTHER CAUSE. THE DESIGNER SHALL NOT BE RESPONSIBLE FOR ANY DAMAGE TO PERSONS OR PROPERTY CAUSED BY THE USE OF THIS DRAWING OR FOR ANY OTHER CAUSE.</p>	<p>VP BUILDINGS, INC. 3300 PLAZER CLUB CIRCLE MEMPHIS TN 38125</p>	<p>Building Code: 980304 Live Load: (not specified) 20.00 psf Wind Speed: 70.00 mph Wind Exposure: C Roof Snow: 49.00 psf Seismic Hazard Group: Group 1 Building Hazard Group: Group 1</p>	<p>FOR CONSTRUCTION</p> <table border="1"> <thead> <tr> <th>NO.</th> <th>DATE</th> <th>BY</th> <th>DESCRIPTION</th> </tr> </thead> <tbody> <tr> <td>1</td> <td></td> <td></td> <td></td> </tr> </tbody> </table>	NO.	DATE	BY	DESCRIPTION	1				<p>SECONDARY ELEVATION AT C</p> <p>DESIGNED BY: E.P. MALL, E. ARCHITECTS, INC. PROJECT: HERRINGVILLE/ELCOM STATE AIRPORT LOCATION: HERRINGVILLE, VERMONT DRAWING NO: MFD012201-01.001</p>	<p>VP BUILDINGS 10/23/2000 10:16:02</p>	<p>DATE: 10/22/00 TIME: 12:00:00 USER: JBO PLOT: 10/22/00</p>
NO.	DATE	BY	DESCRIPTION												
1															