

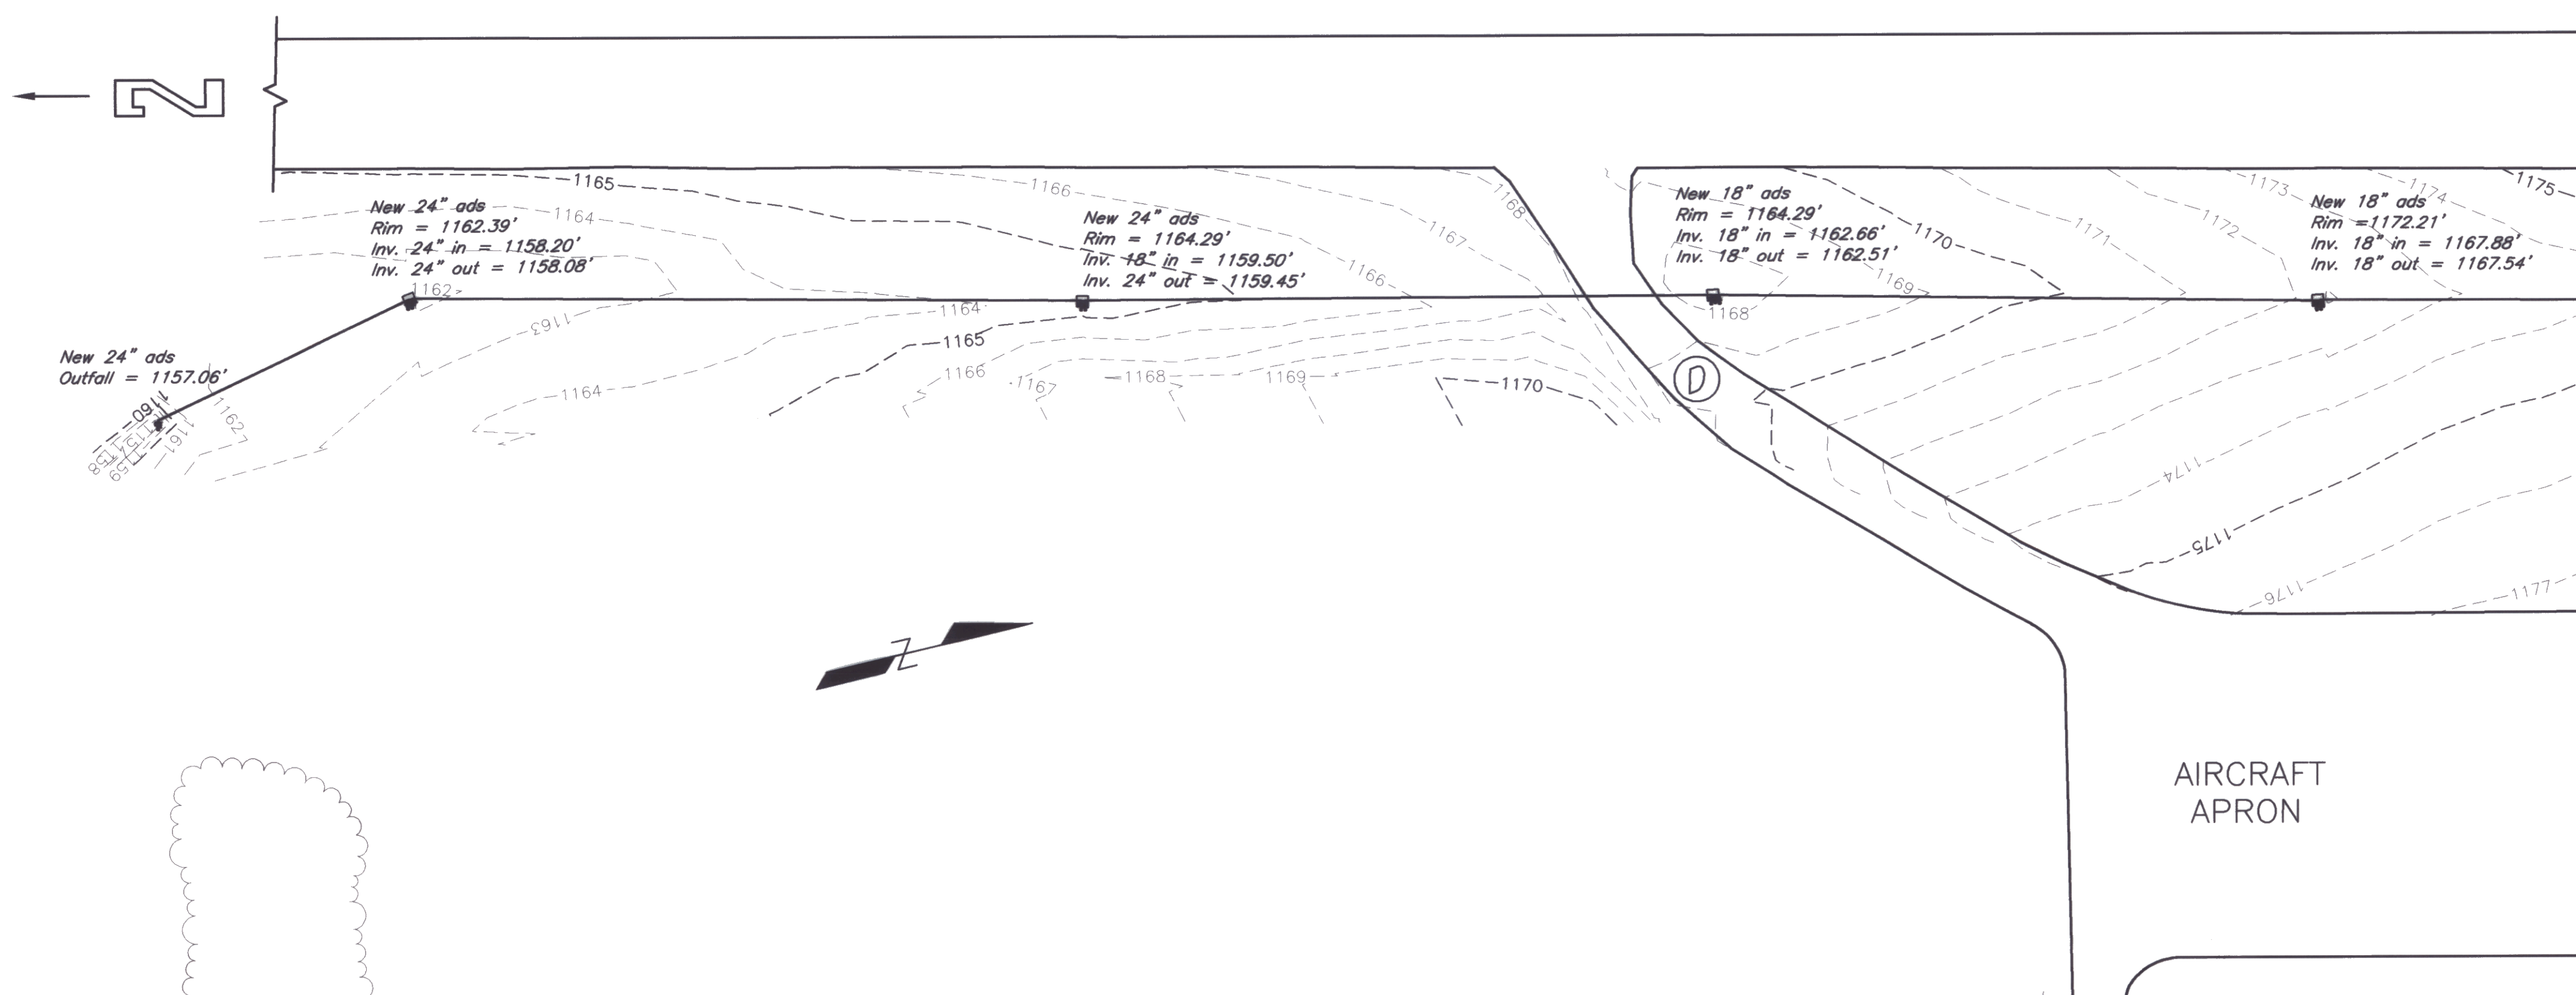


MATCH LINE

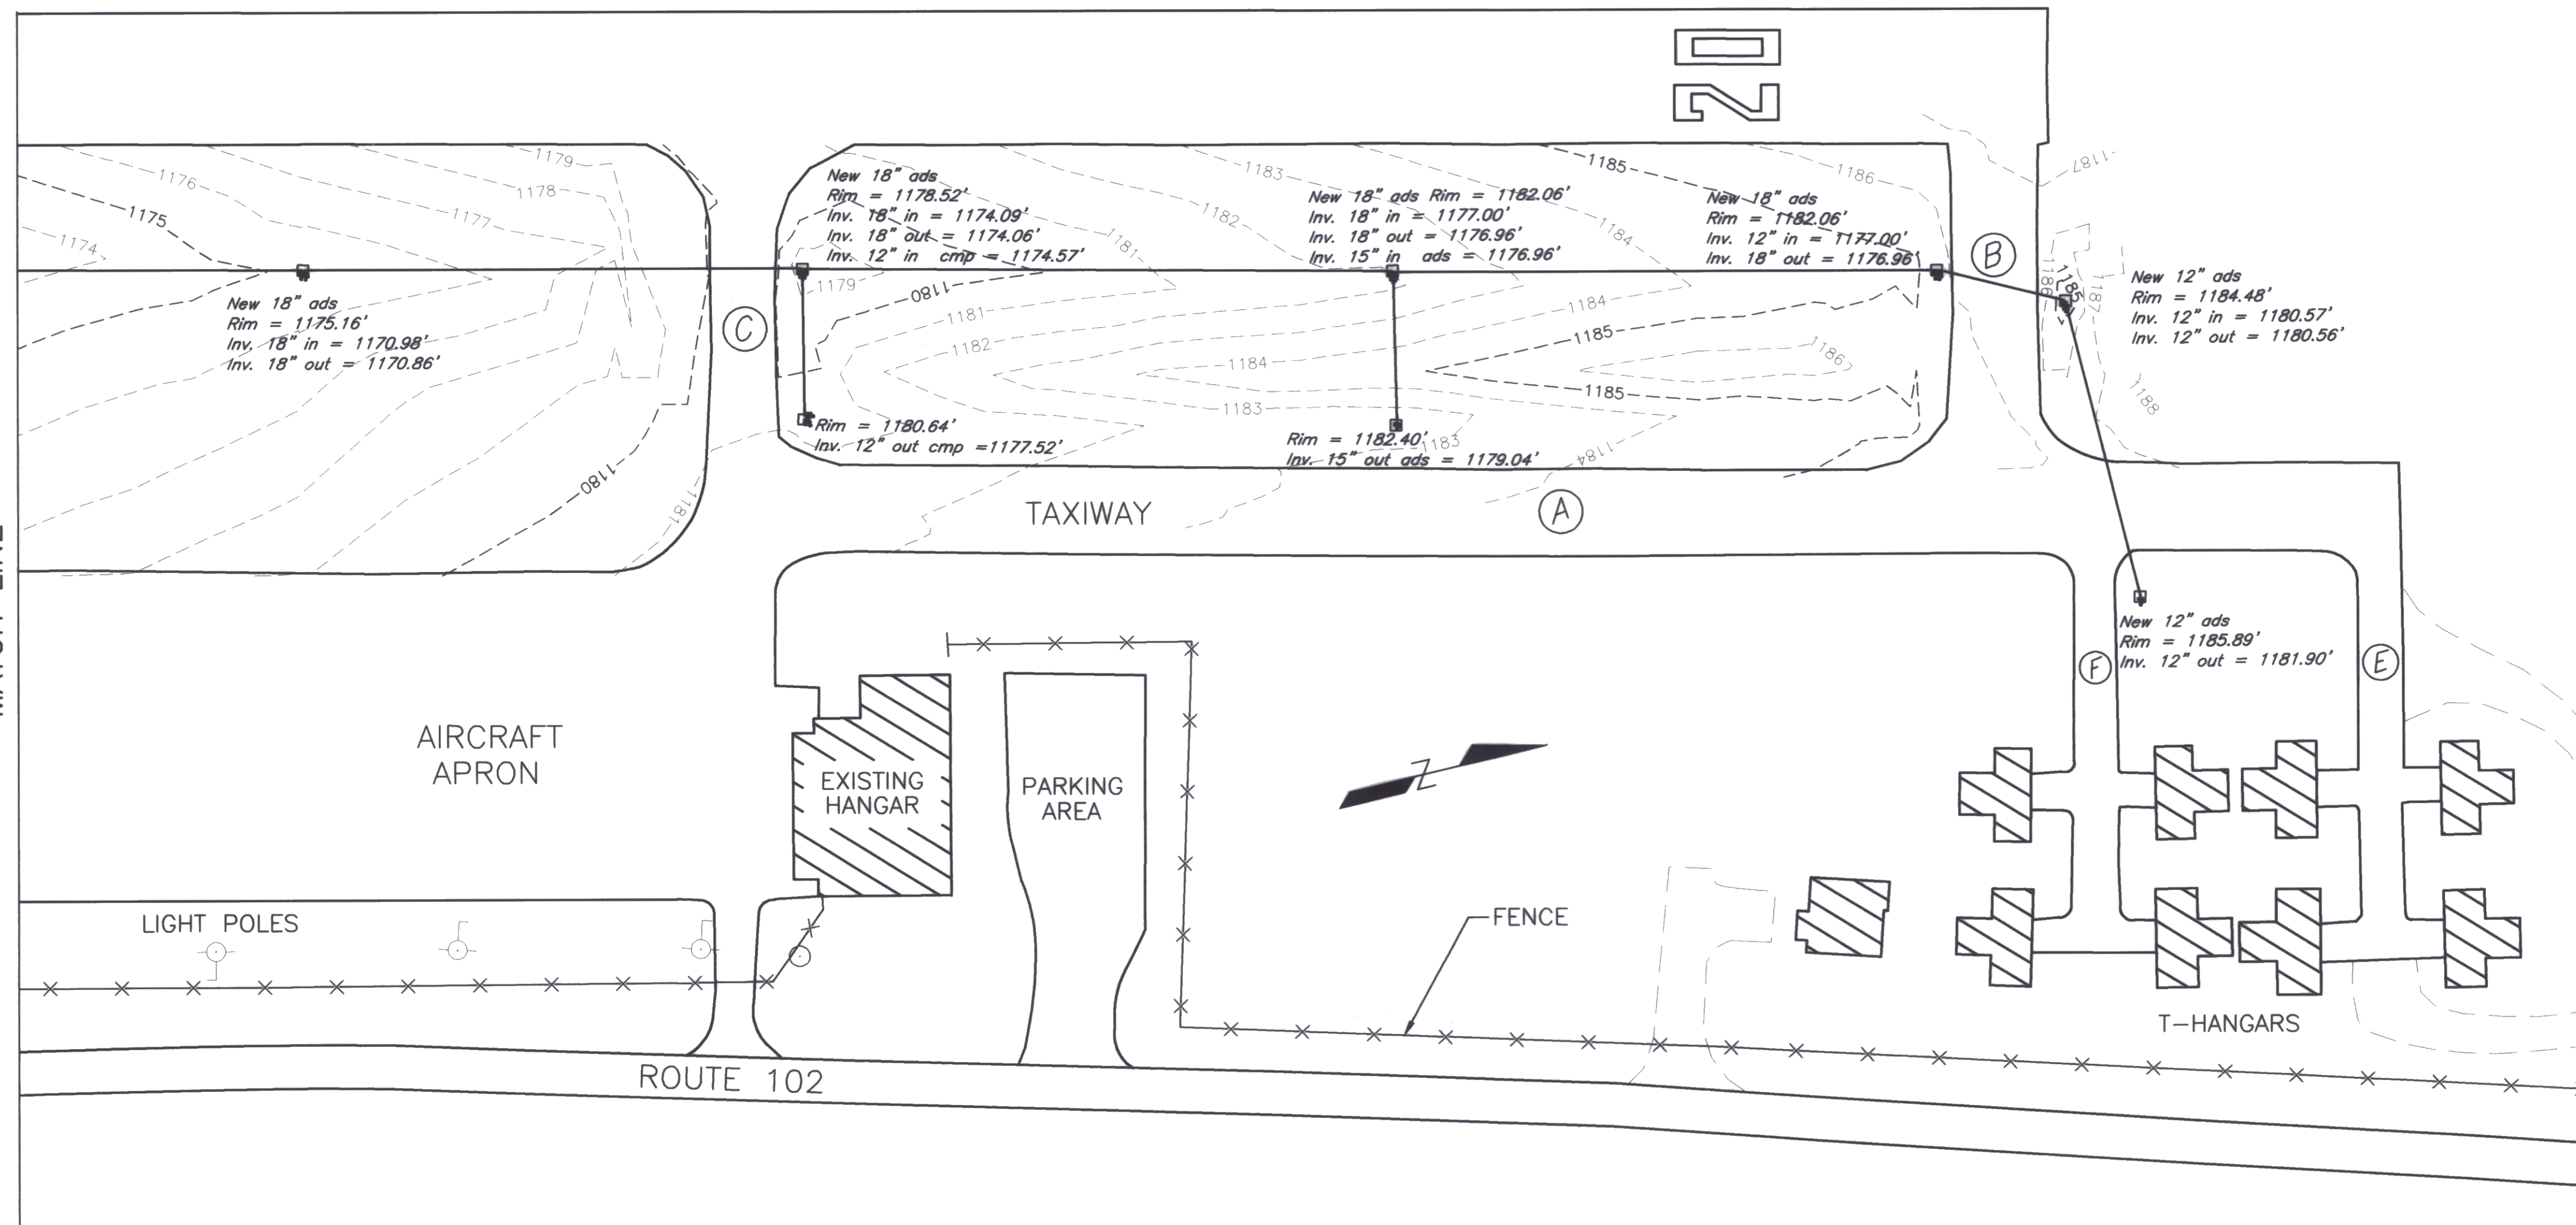


MATCH LINE

AS-BUILT TOPOGRAPHIC  
INFORMATION FROM  
FIELD OBSERVATIONS TAKEN  
5/22/01 BY DUBOIS AND  
KING, INC.

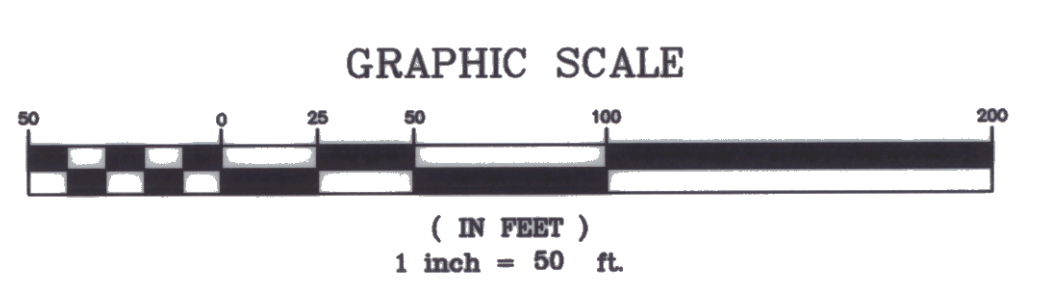

**AS-BUILT**

| NO. | DATE | REVISIONS | BY | CK'D |
|-----|------|-----------|----|------|
|     |      |           |    |      |
|     |      |           |    |      |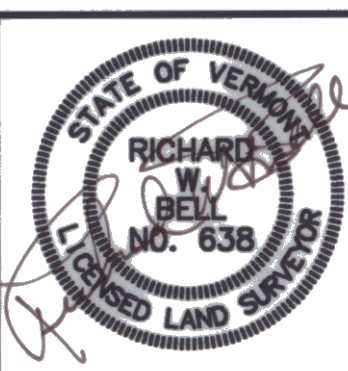
**DuBois & King inc.**  
engineering    planning    management    development

STATE OF VERMONT  
AGENCY OF TRANSPORTATION  
CALEDONIA COUNTY STATE AIRPORT  
TAXIWAY DRAINAGE  
SITE PLAN

|                   |                         |
|-------------------|-------------------------|
| DRAWN BY<br>SJW   | DATE<br>AUG. 2001       |
| CHECKED BY<br>JAA | PROJ. NO.<br>N17151     |
| PROJ. ENG.<br>JAA | DRAW. NO.<br>C171510002 |
| SHEET 1 OF 1      |                         |