

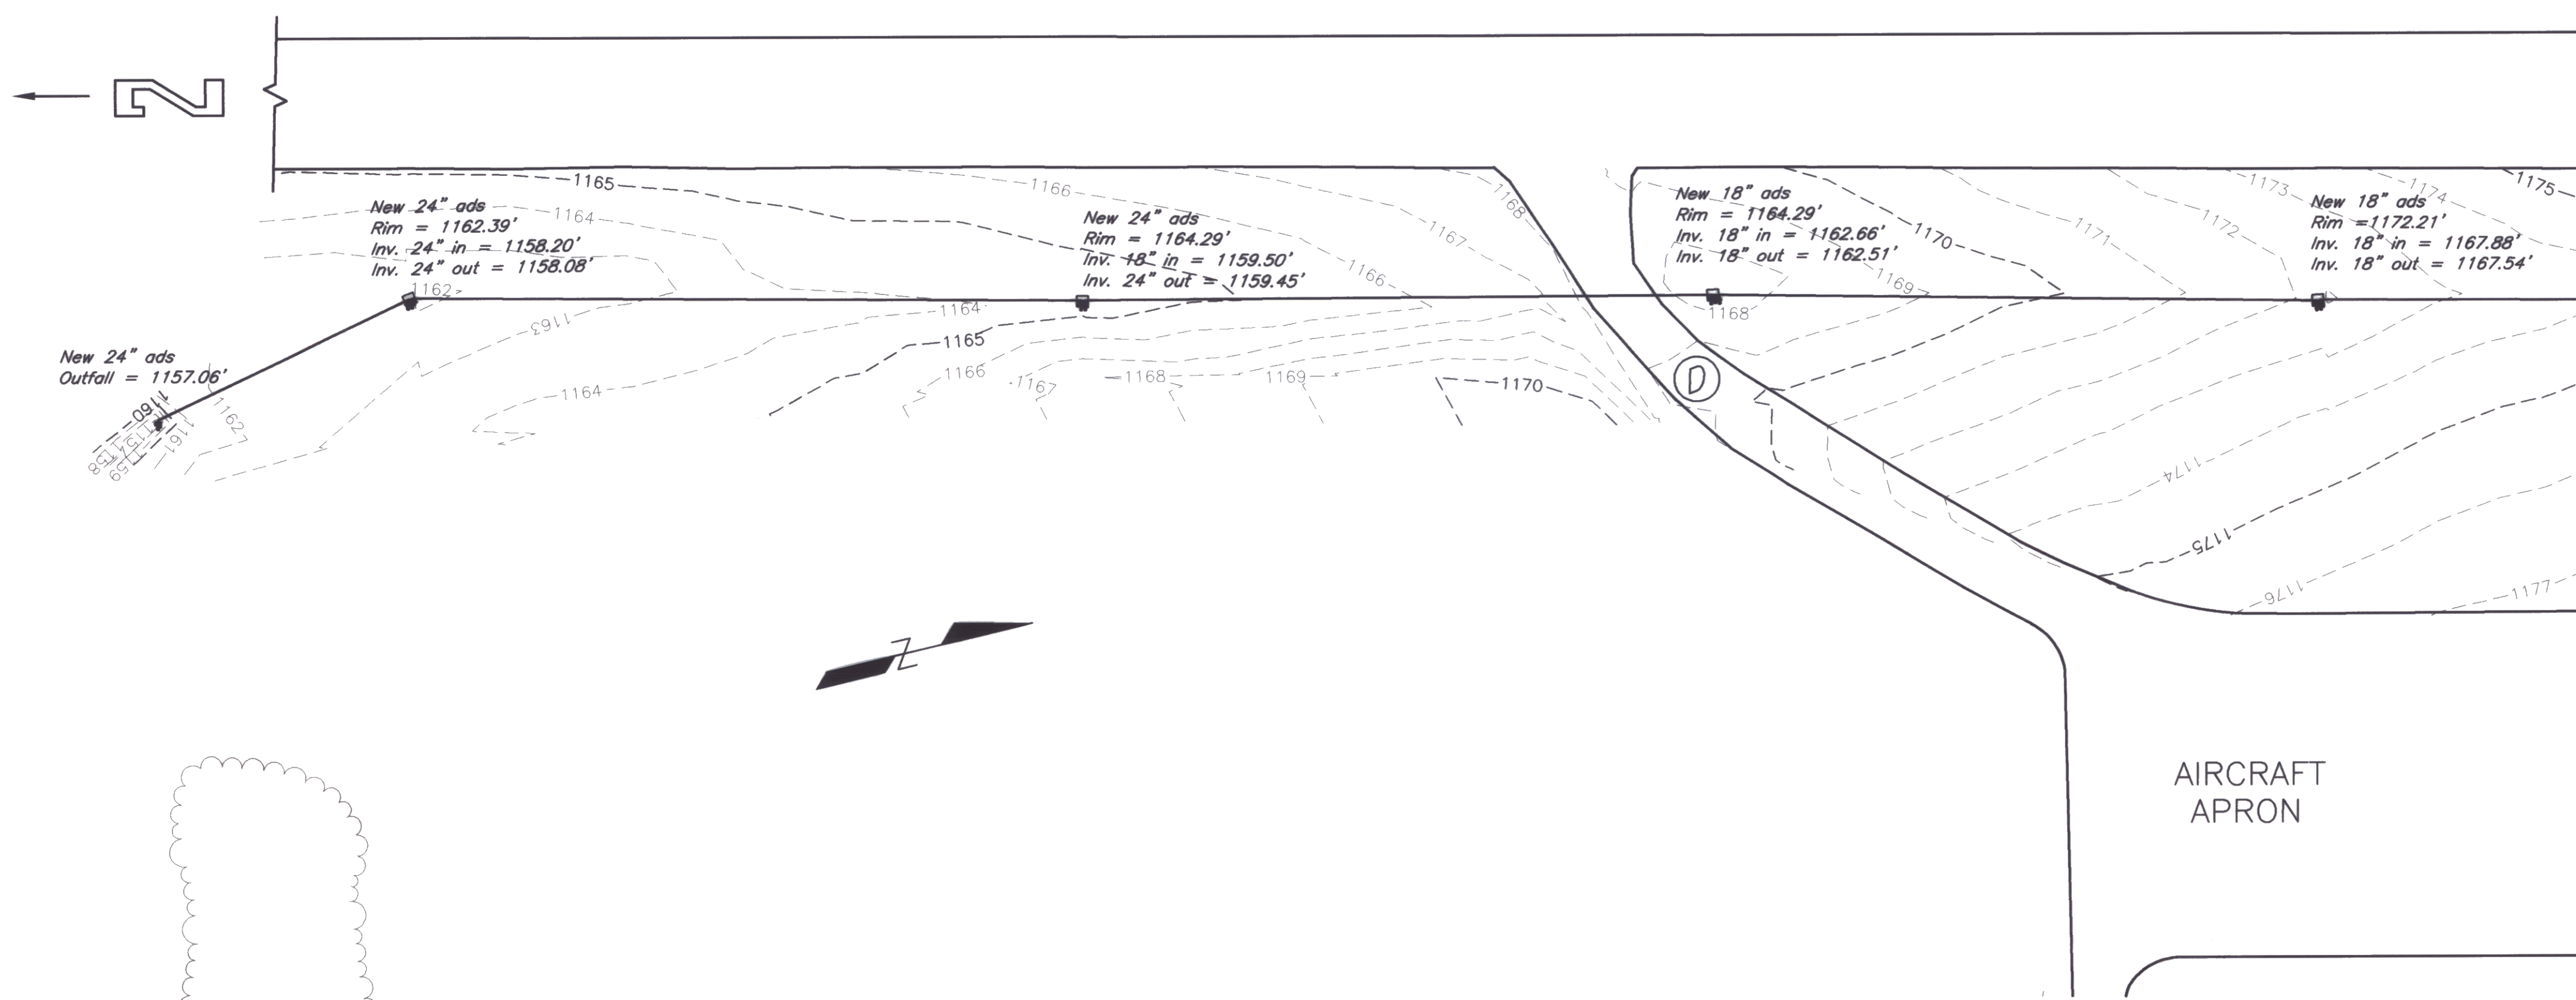


MATCH LINE

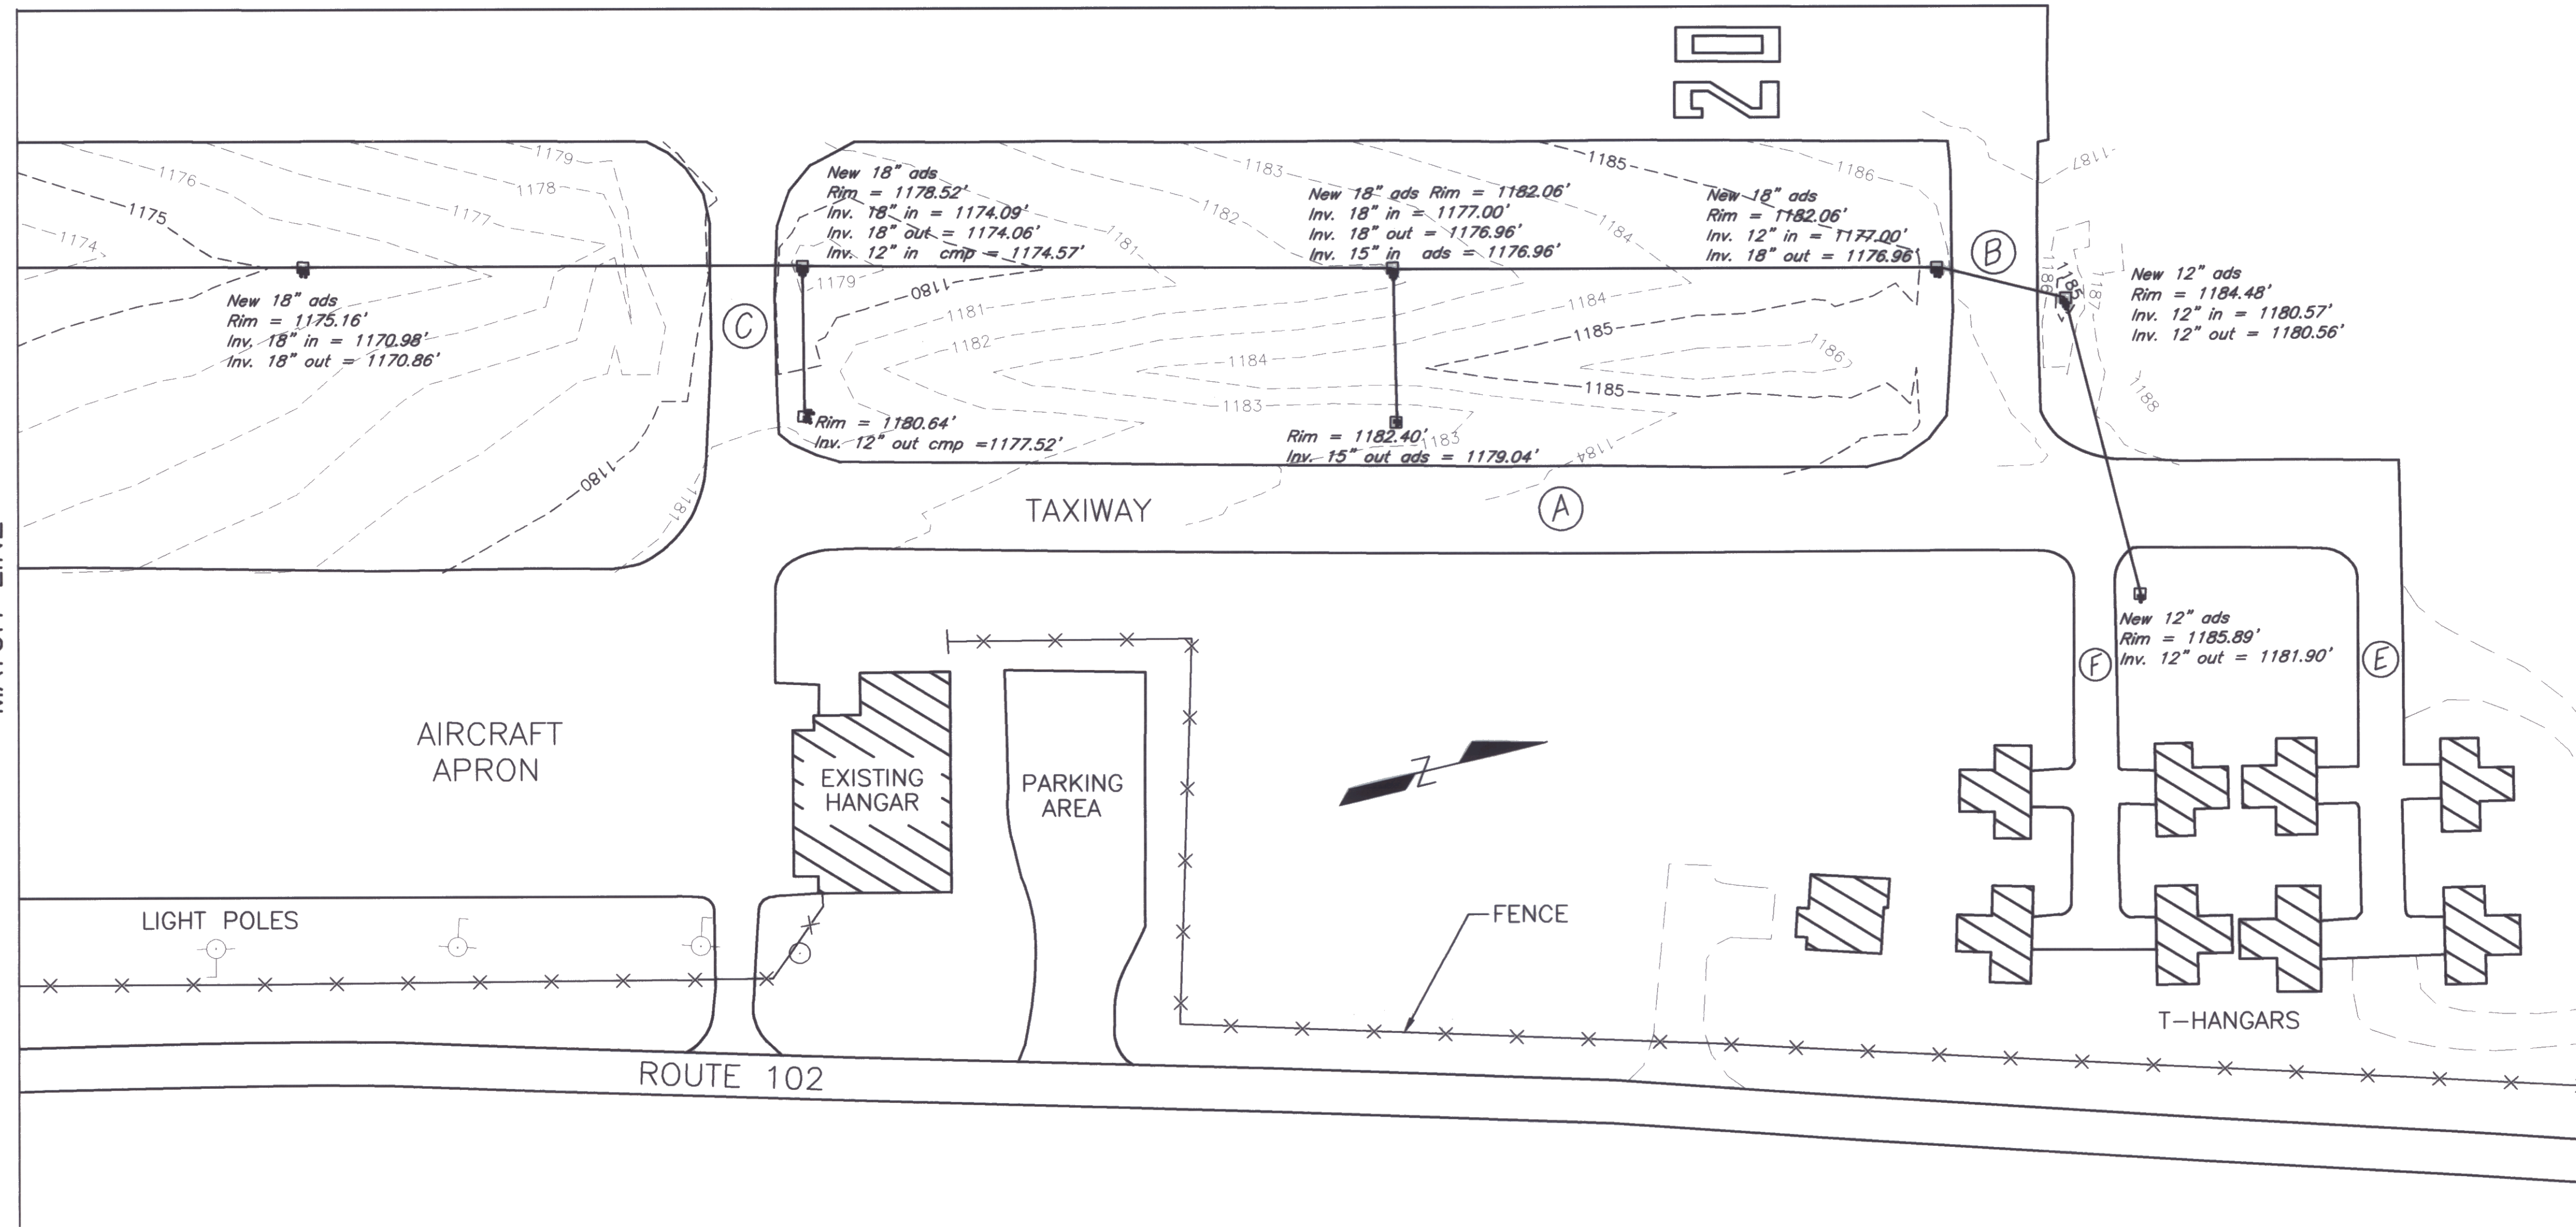


MATCH LINE

AS-BUILT TOPOGRAPHIC
 INFORMATION FROM
 FIELD OBSERVATIONS TAKEN
 5/22/01 BY DUBOIS AND
 KING, INC.

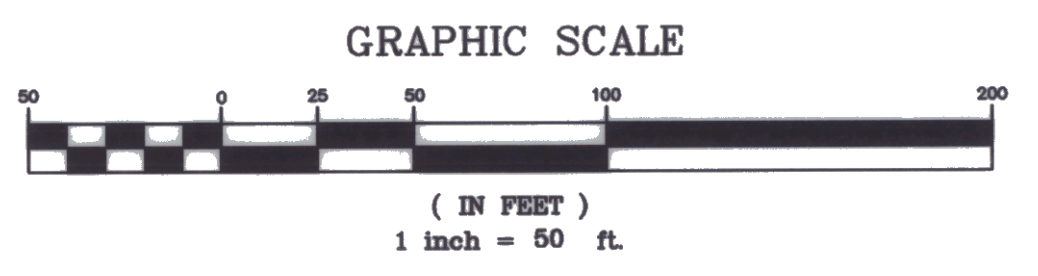

AS-BUILT

NO.	DATE	REVISIONS	BY	CK'D

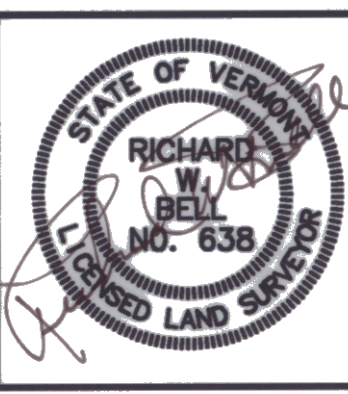

DuBois & King inc.
 engineering planning management development

STATE OF VERMONT
 AGENCY OF TRANSPORTATION
 CALEDONIA COUNTY STATE AIRPORT
 TAXIWAY DRAINAGE
 SITE PLAN

DRAWN BY SJW	DATE AUG. 2001
CHECKED BY JAA	PROJ. NO. N17151
PROJ. ENG. JAA	DRAW. NO. C171510002
SHEET 1 OF 1	