

SITE PLAN
1" = 20'

2,000 GALLON UNDERGROUND STEEL TANK
"GASBOY" HAND OPERATED PUMP FOR SUMP TESTING
2" VENT, 12' HIGH
4" FILL PIPE
AUGAS 100LL HOSE REEL ON CONCRETE PAD
SITE DRAIN

ABANDONED 12,000 GALLON UNDERGROUND STEEL TANK
4" FILL PIPE
2" VENT, 12' HIGH
24" DIA. MAINWAY
ABANDONED 3,000 GALLON UNDERGROUND STEEL TANK


SITE DRAIN

AUTOMOBILE PARKING

TO AIRPORT ROAD



VICINITY MAP
1" = 1 MILE

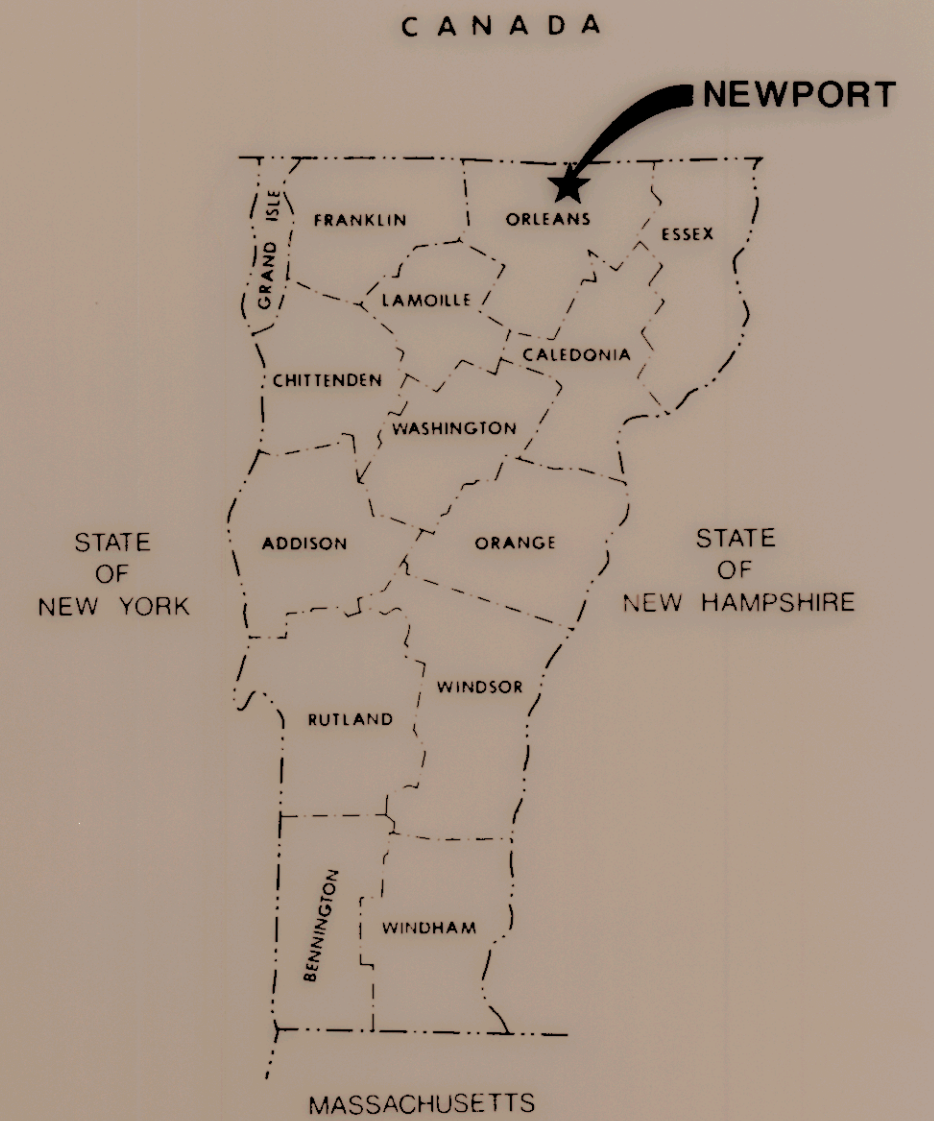

LOCATION MAP
NOT TO SCALE

NOTE: THIS DRAWING REPRESENTS EXISTING FEATURES ON THE DATE OF THE SITE INSPECTION BY DURRESNE-HENRY. IT IS A COMPILATION DRAWING BASED ON INFORMATION PROVIDED BY THE VERMONT AGENCY OF TRANSPORTATION, THE SYSTEM OPERATOR, AND VERIFIED BY FIELD INSPECTION.



VERMONT AGENCY OF TRANSPORTATION
FUEL SYSTEM STUDY
NEWPORT STATE AIRPORT

NEWPORT, VERMONT

DH Duresne-Henry Precision Park No. Springfield, Vermont 05150 Inc.	Client No. 217016 Proj. Manager T.S. REEVES Proj. Designer T.S. REEVES Drawn By W. HAZLETT Checked By P.N. ANDREWS Scale AS SHOWN Approved Date FEBRUARY 1, 1988	Sheet 9 of 11 D 11.174
---	---	---



Rev.	Description	By	Date